WASC FIRE (BATTERY)   WASCA   2   1/2   1/4   1/4							JEDIJI E	IRE SC	MRING FIYTH	DIII
Memory   March   Mar						T			WIDING TIXTO	1 6
### AMERIC COST FULLY   WINDS CLOSE FULLY   1				Acceptable Manufacturer		Acceptable Manufacturer			Туре	Item
CLOSET RUSH WALK, IN HIGH   CLOSE RUSH WALK, IN HIGH   CLOSE RUSH WALK, SOLIT CAP, BOTTOM CONTENT.   CLOSE RUSH WALK, SOLIT CAP, BOTTOM CONTENT, IN HIGH   CLOSE RUSH WALK, SOLIT CAP, BOTTOM CONTENT, WALK SOLIT CAP, BOTTOM CONTENT, BOTTO	FRONT, LESS COVER, MOLDED CHECK HINGES, STAINLESS	H SEAT: SEAT: BLACK, ELONGATED, OPEN FRONT, LE SOLID PLASTIC, STAINLESS STEEL CHECK H	EXPOSED, POLISHED CHROME PLATED, SENSOR OPERATED DIAPHRAGM TYPE FLUSH VALVE WITH SEAT BUMPER, 25MM (1") SCREWDRIVER ANGLE STOP, MOTORIZED ACTUATOR, AUTOMATIC SENSOR WITH MANUAL PUSH BUTTON OVERRIDE, VACUUM BREAKER ADJUSTABLE TAIL PIECE, OPTIONAL 24 HR COURTESY FLUSH, FLUSH CONNECTION & COUPLING FOR 40MM (1 1/2") TOP SPUD WITH 11 1/2" TALL OUTLET TUBE, WALL AND SPUD ESCUTCHEINS. BATTERY OPERATED C/W 4 'AA' CELL BATTERIES, SENSOR BOX C/W COVER, VANDAL RESISTANT SCREWS, FLUSH	Z, DELTA 81T201BT	VITREOUS CHINA, SIPHON JET, ELONGATED RIM, TOP SPUD FOR FLUSH VALV BOLT CAP, BOTTOM OUTLET, FLOOR-MOUNTED, 10" OR 12" ROUGH-IN, MIN	AMERICAN STANDARD MADERA 2234 001 KOHLER WELLCOMME K-4350 MANSFIELD BALTIC 1311NS		1	VALVE	WC-1
With Flushing system   With Students   With	CHECK HINGES, STAINLESS	BEMIS 1950 CENTOCO STEEL OR SOLID BRASS INSERT POST.	FLUSH VALVE WITH SEAT BUMPER, 25mm (1") SCREWDRIVER ANGLE STOP, MOTORIZED ACTUATOR, AUTOMATIC SENSOR WITH MANUAL PUSH BUTTON OVERRIDE, VACUUM BREAKER ADJUSTABLE TAIL PIECE, OPTIONAL 24 hr COURTESY FLUSH, FLUSH CONNECTION & COUPLING FOR 40mm (1 1/2") TOP SPUD WITH 24" TALL OUTLET TUBE, WALL AND SPUD ESCUTCHEINS. BATTERY OPERATED C/W 4 'AA' CELL BATTERIES, SENSOR BOX C/W COVER, VANDAL	ZURN	RIM, TOP SPUD FOR FLUSH VALVE, BOLT CAP, BOTTOM OUTLET, FLOOR-MOUNTED, 12" ROUGH-IN, MIN 2" TRAP WAY, MAXIMUM 6 litres (1.5	MADERA 3043.001 KOHLER HIGHCREST K-4302 MANSFIELD ADRIATIC 1319 ZURN	3   1 1/2	) 1	CLOSET FLUSH VALVE, 16" HIGH,	WC-2
SN2024—A-IR-STD—TMA—NSD CMPORENTS TO BE STANLESS STEEL SUITABLE FOR FOUR (4) USERS. STANDARD PEDESTAL HEIGHT, CVM BACKSPLANSER. MICHAEL STANDARD PEDESTAL HEIGHT, CVM BACKSPLANSER. SPANHARD, CVM BACKSPLANSER. SPANHARD, COLOR BY AGENTICAL STANDARD PEDESTAL HEIGHT, COLOR BY AGENTICAL STANDARD AND AGENT AND AGENT A			REFER TO SPEC FOR AUTOMATIC URINAL FLUSHING SYSTEM. PROVIDE FLOOR MOUNTED WALL CARRIER.		SHIELDS, INTEGRAL TRAP, BACK OUTLET, WALL-MOUNTED, BACK SUPPLY SPUD, MIN 2" TRAP WAY, MAXIMUM 1.9 litres (0.5 gal) PER FLUSH. C/W FLOOR MOUNTED CARRIER  PROVIDE 400 mm (16") LONG x 20¢ (3/4"), STAINLESS STEEL FLEXIBLE	WASHBROOK 6515.005 KOHLER BARDON K-4904-ER	2   1 1/2		URINAL WITH FLUSHING SYSTEM	U-1
SN2023-A-IR-STD-TMA-NSD SN2023					COMPONENTS TO BE STAINLESS STEEL. SUITABLE FOR FOUR (4) USERS. STANDARD PEDESTAL HEIGHT. C/W BACKSPLASH. TRIM: INFRARED CONTROLLED, AT EACH INDIVIDUAL USER, MOLDED SPRAYHEAD, STOP VALVES, HORIZONTAL SWING CHECK VALVES, THERMOSTATIC MIXING VALVE PRESET AT 40°C. NO SOAP DISPENSER. SUITABLE FOR 120 V/1/60 COMPLETE WITH CLASS II 120/24V PLUG IN	BRADLEY SENTRY SN2024-A-IR-STD-TMA-NSD -BS	1 1/2 1 1/4	1/2 1/2		WF-1
HUNG LAV FAUCET HANDS FREE (BATTERY)  MURRO 0955-001EC KOHLER BRENHAM K-1997 ZURN Z5344  SUPPLY OPENING, OVERFLOW. SIZE: 559 mm x 540 mm (22 x 21 1/4"). C/W SHROUD/KNEE CONTACT GUARD  SUPPLY OPENING, OVERFLOW. SIZE: 559 mm x 540 mm (22 x 21 1/4"). C/W SHROUD/KNEE CONTACT GUARD  SUPPLY OPENING, OVERFLOW. SIZE: 559 mm x 540 mm (22 x 21 1/4"). C/W SHROUD/KNEE CONTACT GUARD  SUPPLY OPENING, OVERFLOW. SIZE: 559 mm x 540 mm (22 x 21 1/4"). C/W SHROUD/KNEE CONTACT GUARD  SUPPLY OPENING, OVERFLOW. SIZE: 559 mm x 540 mm (22 x 21 1/4"). C/W SHROUD/KNEE CONTACT GUARD  SUPPLY OPENING, OVERFLOW. SIZE: 559 mm x 540 mm (22 x 21 1/4"). C/W SHROUD/KNEE CONTACT GUARD  SUPPLY OPENING, OVERFLOW. SIZE: 559 mm x 540 mm (22 x 21 1/4"). C/W SHROUD/KNEE CONTACT GUARD  SUPPLY OPENING, OVERFLOW. SIZE: 559 mm x 540 mm (22 x 21 1/4"). C/W SHROUD/KNEE CONTACT GUARD  SUPPLY OPENING, OVERFLOW. SIZE: 559 mm x 540 mm (22 x 21 1/4"). C/W SHROUD/KNEE CONTACT GUARD  HOUSING WITH FLUSH STAINLESS STEEL COVER FOR SOLENOID AND CONTROLLER. SENSOR ACTIVATES IN PRESENCE OF PERSON'S HANDS IN					COMPONENTS TO BE STAINLESS STEEL. SUITABLE FOR THREE (3) USERS. STANDARD PEDESTAL HEIGHT. C/W BACKSPLASH. TRIM: INFRARED CONTROLLED, AT EACH INDIVIDUAL USER, MOLDED SPRAYHEAD, STOP VALVES, HORIZONTAL SWING CHECK VALVES, THERMOSTATIC MIXING VALVE PRESET AT 40°C. NO SOAP DISPENSER. SUITABLE FOR 120 V/1/60 COMPLETE WITH CLASS II 120/24V PLUG IN	BRADLEY SENTRY SN2023-A-IR-STD-TMA-NSD -BS	1 1/2 1 1/4	1/2 1/2		WF-2
	ARRIER	PROVIDE FLOOR MOUNTED WALL CARRIER	BODY. ADJUSTABLE SENSING RANGE AND TIME OUT, CHROME FINISH. VANDAL RESISTANT AERATOR HAVING INTEGRAL FLOW CONTROL FOR 0.5gpm (1.9 I/min) @ 413 kPa (60 psi) MAX. UNDER COUNTER PLASTIC SURFACE MOUNTED HOUSING WITH FLUSH STAINLESS STEEL COVER FOR SOLENOID AND CONTROLLER. SENSOR ACTIVATES IN PRESENCE OF PERSON'S HANDS IN	MOEN COMMERCIAL	SUPPLY OPENING, OVERFLOW. SIZE: 559 mm x 540 mm (22 x 21 1/4").	MURRO 0955-001EC KOHLER BRENHAM K-1997	1 1/4 1 1/4	1/2 1/2	HUNG LAV FAUCET HANDS FREE	L-1
SH-1 BARRIER FREE SHOWER 1/2 1/2 PIPING ROUGHIN ONLY						PIPING ROUGHIN ONLY		R 1/2 1/2		SH-1
FD-1 FLOOR DRAIN  NOTED 1 1/2 ZURN ZN415B MIFAB F1100-C CONTOUR C2000-R6 WATTS FD-100-C-A  GENERAL DUTY CAST IRON BODY, ADJUSTABLE HEAD, NICKEL BRONZE STRAINER, INTEGRAL SEEPAGE PAN, AND CLAMPING COLLAR. USE SQUARE STRAINER IN TILED AREAS AND ROUND STRAINER ELSEWHERE. C/W TRAP PRIMER					STRAINER, INTEGRAL SEEPAGE PAN, AND CLAMPING COLLAR. USE SQUARE STRAINER IN TILED AREAS AND ROUND STRAINER ELSEWHERE. C/W TRAP	MIFAB F1100-C CONTOUR C2000-R6	NOTED 1 1/2		FLOOR DRAIN	FD-1

GRIL	LE SCHEDULE				
Item	Туре	Equalizing Grid	Volume Damper	Acceptable Manufacturer	Description
D1	SQUARE CEILING DIFFUSER	YES	NONE	EH PRICE SCDA	MULTICONE, FULLY ADJUSTABLE, 24x24, STEEL CEILING DIFFUSER W/ROUND NECK. SUITABLE FOR LAY-IN T-BAR CEILING, OR DRYWALL CEILING WHEN C/W FRAME. PROVIDE FIRE STOP FLAP & FIRE BLANKET.
R1	CEILING RETURN GRILLE (NON-DUCTED)	NO	NONE	EH PRICE 80-CH	1/2x1/2x1/2 ALUMINUM EGGCRATE CORE, C/W CHANNEL BORDER FOR LAY-IN T-BAR CEILING.
E1	EXHAUST GRILLE (DUCTED)	NO	NONE	EH PRICE 80-FA	1/2x1/2x1/2 ALUMINUM EGGCRATE CORE, C/W 1 1/4" FLAT BORDER & SCREWED FASTENING FOR SURFACE MOUNTING.

1. ACCEPTABLE MANUFACTURERS: EH PRICE, NAILOR, TITUS, KRUEGER, CARNES, METALAIRE, TUTTLE & BAIL	_EY
2. GRILLE COLOURS ARE SELECTED BY ARCHITECT FROM STANDARD COLOUR CHART, UNLESS OTHERWISE I	NOTED.
3. PAINT INTERIOR OF DUCTWORK BEHIND GRILLE MATT BLACK (WHERE VISIBLE THRU GRILLE).	

Item	Туре	Acceptable Manufacturer	Description
H1	CONVECTOR	ENG-A C-3W	16ga STEEL CABINET WITH ALL MOUNTING HARDWARE. ELEMENT TO BE 4x4 ALUMINUM FINS ON 1/20 COPPE TUBE WITH 50 FINS/FT. PROVIDE STAMPED GRILLES ON FRONT INLET & OUTLET. SURFACE MOUNTED ON WALL WITH TOP OF UNIT AT 42" AFF. MANUAL CONTROL W/ DAMPER & OPERATOR
H2	RADIANT CEILING PANEL	ENG-A AIRTEX HEF-2	EXTRUDED ALUMINUM PANEL WITH EXPOSED TEXTURED FACE AND CONTINUOUS ALUMINUM SADDLES ON BACK TO HOLD 1/2" COPPER TUBING BONDED TO SADDLE. PANEL FINISH COMPLETED IN FACTORY (NO FIELD APPLIED PAINT). PANEL SUITABLE FOR T-BAR INSTALLATION.

<u>SUM</u>	P PUMP SC	HEDL	<u>JLE</u>					
Item	Туре	Capacity USgpm	Head ft	Size hp	Speed rpm	Electrical Voltage	Manufacturer & Model	Remarks
SP-2	SANITARY SUMP PUMP — DUPLEX	20	35	2@2	3450	208/3/60	MYERS WGL20	DUPLEX PUMPS TO BE COMPLETE WITH CONTROL PANEL, FLOATS, HIGH LEVEL ALARM WITH AUDIBLE SIGNAL AND TEST BUTTON. PROVIDE 36" DIAMETER FIBERGLASS SUMP WITH SEALED HEAVY DUTY LID.

Item	Description	ltem	Description
	ITEM TO BE REMOVED	<del>                                      </del>	STRAINER
<del></del>	CUT EXISTING & CONNECT NEW PIPING		SCREWED OR WELDED P
	POTABLE COLD WATER	—————————————————————————————————————	BALL VALVE
··	POTABLE HOT WATER	•	PENDENT HEAD
···	POTABLE HOT WATER RECIRC.	0	UPRIGHT PENDENT HEAD
-SAN-EX	EXISTING SAN ABOVE FLOOR	$\triangleright$	SIDEWALL HEAD
-SAN-EX	EXISTING SAN BELOW FLOOR	FHC	FIRE HOSE CABINET
- — SAN — —	SANITARY ABOVE FLOOR	FEC	RECESSED CABINET MOU FIRE EXTINGUISHER
	SANITARY BELOW FLOOR	<b>▼</b> FE	WALL MOUNTED FIRE EXTINGUISHER
STM-EX	EXISTING STM ABOVE FLOOR	o <sup>co</sup>	FLOOR CLEANOUT
STM-EX	EXISTING STM BELOW FLOOR	——-1 co	LINE CLEANOUT
— -V- — -	VENT	GФ	THERMOSTAT (WITH GUAF WHERE INDICATED)
SP	SPRINKLER		SUPPLY AIR DUCT
—HWS-—	HEATING WATER SUPPLY		RETURN/EXHAUST AIR D
	HEATING WATER RETURN	-	ACOUSTIC DUCT LINING
FD <b>O</b> F →	FLOOR DRAIN	<b>—</b> BD	BALANCING DAMPER
- 79 <sub>p</sub>	TRAP PRIMER	FSD	FIRE/SMOKE DAMPER
	TEE CONNECTION	─ BDD	BACK DRAFT DAMPER
<b>c</b> —	PIPE DOWN	}	RECTANGULAR DUCTWORK
<b>o</b> —	PIPE UP		RIGID ROUND DUCT
<del></del>	FLEXIBLE CONNECTION	Type Size Capacity	DIFFUSER/GRILLE SIZE ( TYPE & CAPACITY (cfm)
<u></u>	REDUCER/INCREASER	Type Size / cfm Capacity	HYDRONIC HEATING SIZE
N >	CHECK VALVE	EX	EXISTING DUCT (SIZE AS INDICATED)
	UNION		

### GENERAL NOTES

- A. ALL DRAWINGS ARE TO BE READ IN CONJUNCTION WITH THE PREPARED SPECIFICATION.
- B. SANITARY VENT PIPING IS NOT SHOWN. PROVIDE ALL NECESSARY VENT PIPING FROM ALL FIXTURES FOR A COMPLETE SYSTEM TO ALL LOCAL PLUMBING CODE & LOCAL AUTHORITY REQUIREMENTS, CONNECTED TO EXISTING VENTS OR NEW VENTS AS REQUIRED. CO—ORDINATE VENT LOCATION(S) WITH GENERAL CONTRACTOR. MAINTAIN MIN 14'—0" FROM ANY AIR INLET. INSTALL VENT PIPING HIGH IN JOIST SPACE.
- C. UPON COMPLETION OF THE PROJECT THE CONTRACTORS SHALL PROVIDE THE FOLLOWING CERTIFICATES BEFORE CONFORMANCE LETTERS ARE ISSUED BY THE CONSULTANT:
- CONSULTANT:


   POTABLE WATER TEST (SEE SPEC 15142/22 11 16 PART 3)

   BACKFLOW TEST CERTIFICATE(S) FOR ALL TESTABLE DEVICES

   COPY OF MANDATORY TSSA/CSA-B149 GAS PRESSURE TEST TAG

   TSSA CERTIFICATE OF AUTHORIZATION FOR SPLIT AIR CONDITIONING SYSTEMS (EXCEEDING 5 TONS)

  ALL CERTIFICATES ARE TO BE SUBMITTED TOGETHER IN A SINGLE PACKAGE.

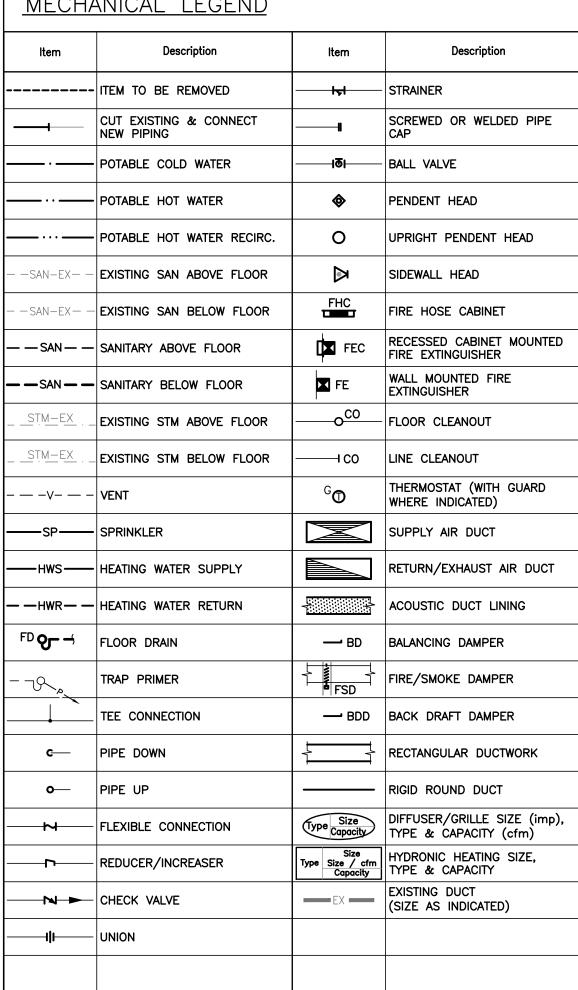



The contractor shall verify all dimensions and report all errors and discrepancies to the Consultant before commencement of the work.


The drawings show general arrangement of services. Follow as closely as actual building construction will permit. Obtain approval for relocation of service from Consultant before commencement of the work.

The drawings do not indicate all offsets fitting and accessories which may be required. Provide the same to meet the required conditions.

Drawings and specifications, etc., prepared and issued by the consultant are the property of the consultant and must be returned at the completion of the project. These documents are not to be duplicated or copied without the consent of the Consultant.

Do not scale this drawing.

55 Northland Road, Waterloo, ON N2V 1Y8 Phone: 519-725-3555 Fax: 519-725-2515 Website: deiassociates.ca Project Number: 20152

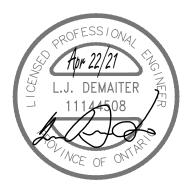



SUNNYSIDE PUBLIC SCHOOL HVAC & WASHROOM UPGRADE


1042 Weber Street E. Kitchener, ON N2A 1B6

DRAWING TITLE:

MECHANICAL LEGEND & SCHEDULES

PROJECT NO:	SCALE:	
A20002.7	AS NOTED	)
DRAWN:	DRAWING NO:	REV.
AH		
CHECKED:		
AH	M101	
DATE:		
FEB 2021		



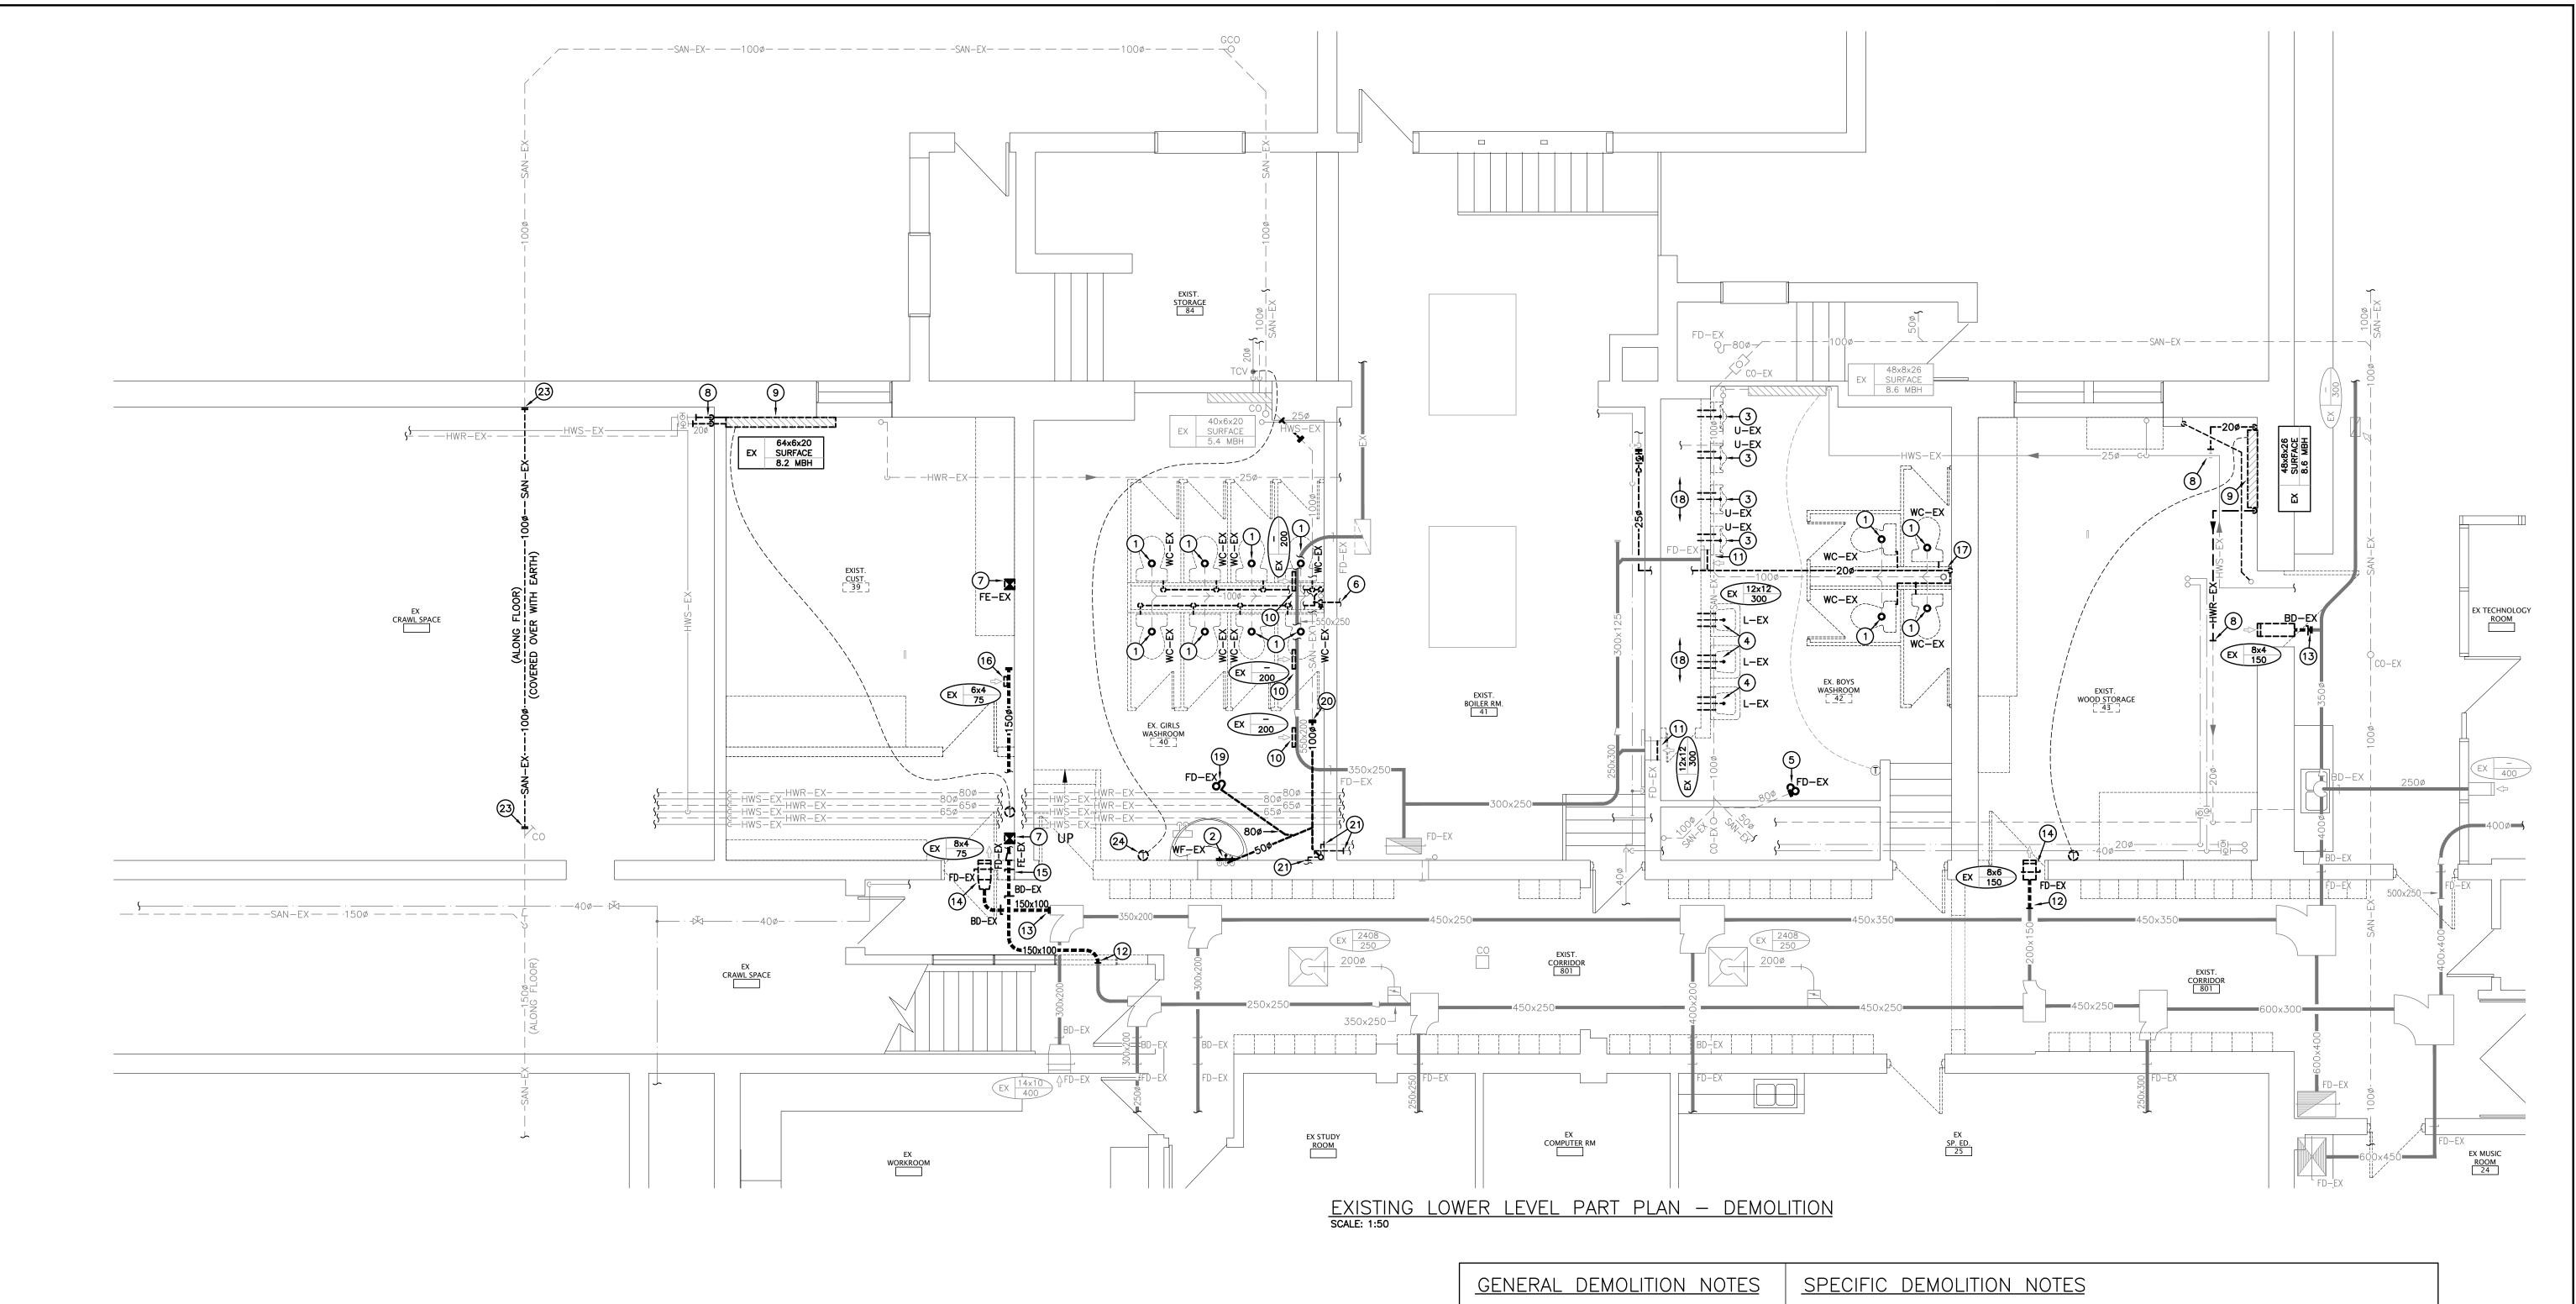

- A. EXISTING MECHANICAL ITEMS NOT SHOWN SHALL REMAIN UNLESS NOTED OTHERWISE.
- B. EXISTING MECHANICAL ITEMS SHOWN BUT NOT NOTED AS BEING REMOVED OR RENOVATED SHALL REMAIN AS PRESENTLY INSTALLED AND OPERATING.
- C. THIS CONTRACTOR SHALL BE RESPONSIBLE FOR VERIFYING ON SITE ALL LOCATIONS AND SIZES OF ALL SERVICES & EQUIPMENT PRIOR TO THE COMMENCEMENT OF WORK.
- D. ALL OPENINGS THAT RESULT FROM THE REMOVAL OF EQUIPMENT OR SERVICES SHALL BE NEATLY PATCHED WITH SUITABLE NEW MATERIALS TO SUIT EXISTING CONSTRUCTION.
- E. PLUMBING VENTS ARE NOT INDICATED OR IDENTIFIED. REMOVE ALL REDUNDANT VENTS WHILE MAINTAINING INTEGRITY OF EXISTING SYSTEMS TO REMAIN.
- . REMOVAL OF EXISTING PIPING, OR DUCT SYSTEMS INCLUDES REMOVAL OF ALL HANGERS, INSULATION, FITTINGS, ETC.
- G. MAINTAIN INTEGRITY OF EXISTING SYSTEMS THAT ARE TO REMAIN OR BE MODIFIED.
- I. INSTALL NEW SYSTEM OR SERVICES WHERE REQUIRED TO MAINTAIN SYSTEM OPERATION PRIOR TO DEMOLITION
- OF EXISTING SERVICES.

  THIS CONTRACTOR IS TO REMOVE & REPLACE CEILINGS
- AS REQUIRED FOR REMOVAL/REPLACEMENT OF SERVICES.

- 1. EXISTING WC TO BE REMOVED COMPLETE. EXISTING SAN TO BE CUT, CAPPED BELOW FLOOR AND REMOVED COMPLETE. EXISTING CW TO BE REMOVED AS INDICATED.
- 2. EXISTING WF TO BE REMOVED COMPLETE. EXISTING H&CW TO BE CUT, CAPPED IN WALL AND REMOVED COMPLETE. EXISTING SAN TO BE REMOVED COMPLETE.
- SAN & CW TO BE CUT AND REMOVED COMPLETE.

  4. EXISTING LAV TO BE REMOVED COMPLETE. EXISTING

3. EXISTING URINAL TO BE REMOVED COMPLETE. EXISTING

- SAN, H&CW TO BE CUT AND REMOVED COMPLETE.

  5. EXISTING FD TO BE REMOVED COMPLETE. SAN TO BE
- CUT, CAPPED BELOW FLOOR AND REMOVED COMPLETE.

  6. EXISTING CW TO BE CUT, CAPPED AT SOURCE AND
- REMOVED COMPLETE.

  7. EXISTING FIRE EXTINGUISHER TO BE RELOCATED.
- 8. EXISTING HWS AND/OR HWR TO BE CUT AND REMOVED BEYOND COMPLETE.
- 9. EXISTING HYDRONIC HEATER AND ASSOCIATED THERMOSTAT TO BE DISCONNECTED AND REMOVED
- 10. EXISTING GRILLE TO BE REMOVED COMPLETE.
  RESULTING OPENING IN DUCT TO BE PATCHED AND
  MADE AIR TIGHT.
- 11. EXISTING GRILLE TO BE REMOVED COMPLETE. REPAIR OPENING IN WALL AS REQUIRED TO SUIT NEW DUCT CONNECTION. FIRE DAMPER TO REMAIN.
- 12. EXISTING DUCT TO BE CUT AND REMOVED AS INDICATED.
- 13. EXISTING DUCT TO BE CUT, CAPPED AND REMOVED COMPLETE.

- 14. EXISTING GRILE AND ASSOCIATED FIRE DAMPER TO BE REMOVED COMPLETE. PATCH WALL TO MATCH
- 15. EXISTING FIRE DAMPER AND ASSOCIATED DUCT TO BE REMOVED COMPLETE. PATCH WALL TO MATCH ADJACENT WALL CONSTRUCTION.
- 16. EXISTING GRILLE AND ASSOCIATED DUCT TO BE REMOVED COMPLETE.

ADJACENT WALL CONSTRUCTION.

- 17. EXISTING CW SERVING REMOVED WC'S TO BE REMOVED BACK INTO BOILER ROOM AND CAPPED AT SOURCE.
- 18. ALL EXISTING PIPING AND EQUIPMENT ASSOCIATED WITH WASHROOM FIXTURES TO BE REMOVED. CAP SAN
- BELOW FLOOR. CAP WATER PIPING AT SOURCE.

  19. EXISTING FD TO BE REMOVED COMPLETE.
- 20. EXISTING SAN BELOW FLOOR TO BE CUT, CAPPED AND REMOVED COMPLETE TO SUIT NEW EXCAVATION OF
- 21. EXISTING SAN ABOVE FLOOR TO BE CUT AND REMOVED COMPLETE. TO SUIT NEW ROUTE OF SAN. REFER TO RENOVATION PLANS.
- 22. EXISTING SECTION OF SAN TO BE CUT AND REMOVED COMPLETE. REFER TO RENOVATION PLANS.
- 23. EXISTING SECTION OF SAN TO BE CUT AND REMOVED COMPLETE. PROVIDE CAPS ON EACH END OF EXISTING SAN THAT IS TO REMAIN. REMAINING SAN TO BE ABANDONED IN PLACE.
- 24. EXISTING THERMOSTAT TO BE RELOCATED.





PROJECT NORTH

The contractor shall verify all dimensions and report all errors and discrepancies to the Consultant before commencement of the work.

commencement of the work.

The drawings show general arrangement of services. Follow as closely as actual building construction will permit. Obtal approval for relocation of service from Consultant before commencement of the work.

The drawings do not indicate all offsets fitting and accessories which may be required. Provide the same to meet the required conditions.

Drawings and specifications, etc., prepared and issued by the consultant are the property of the consultant and must be returned at the completion of the project. These documents are not to be duplicated or copied without the consultant.

Do not scale this drawing.


© 2021 DEI & Associates Inc.

Consulting Engineers

MECHANICAL | ELECTRICAL | AQUATIC

FOR Northland Poad, Waterloo, ON Nov 198

55 Northland Road, Waterloo, ON N2V 1Y8
Phone: 519-725-3555 Fax: 519-725-2515
Website: deiassociates.ca
Project Number: 20152

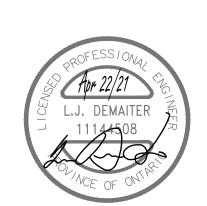



SUNNYSIDE PUBLIC SCHOOL HVAC & WASHROOM UPGRADE

1042 Weber Street E.
Kitchener, ON

N2A 1B6

DRAWING TITLE:

LOWER LEVEL PART PLAN
DEMOLITION


PROJECT NO:
A20002.7


DRAWN:
AH

CHECKED:
AH


DATE:
FEB 2021



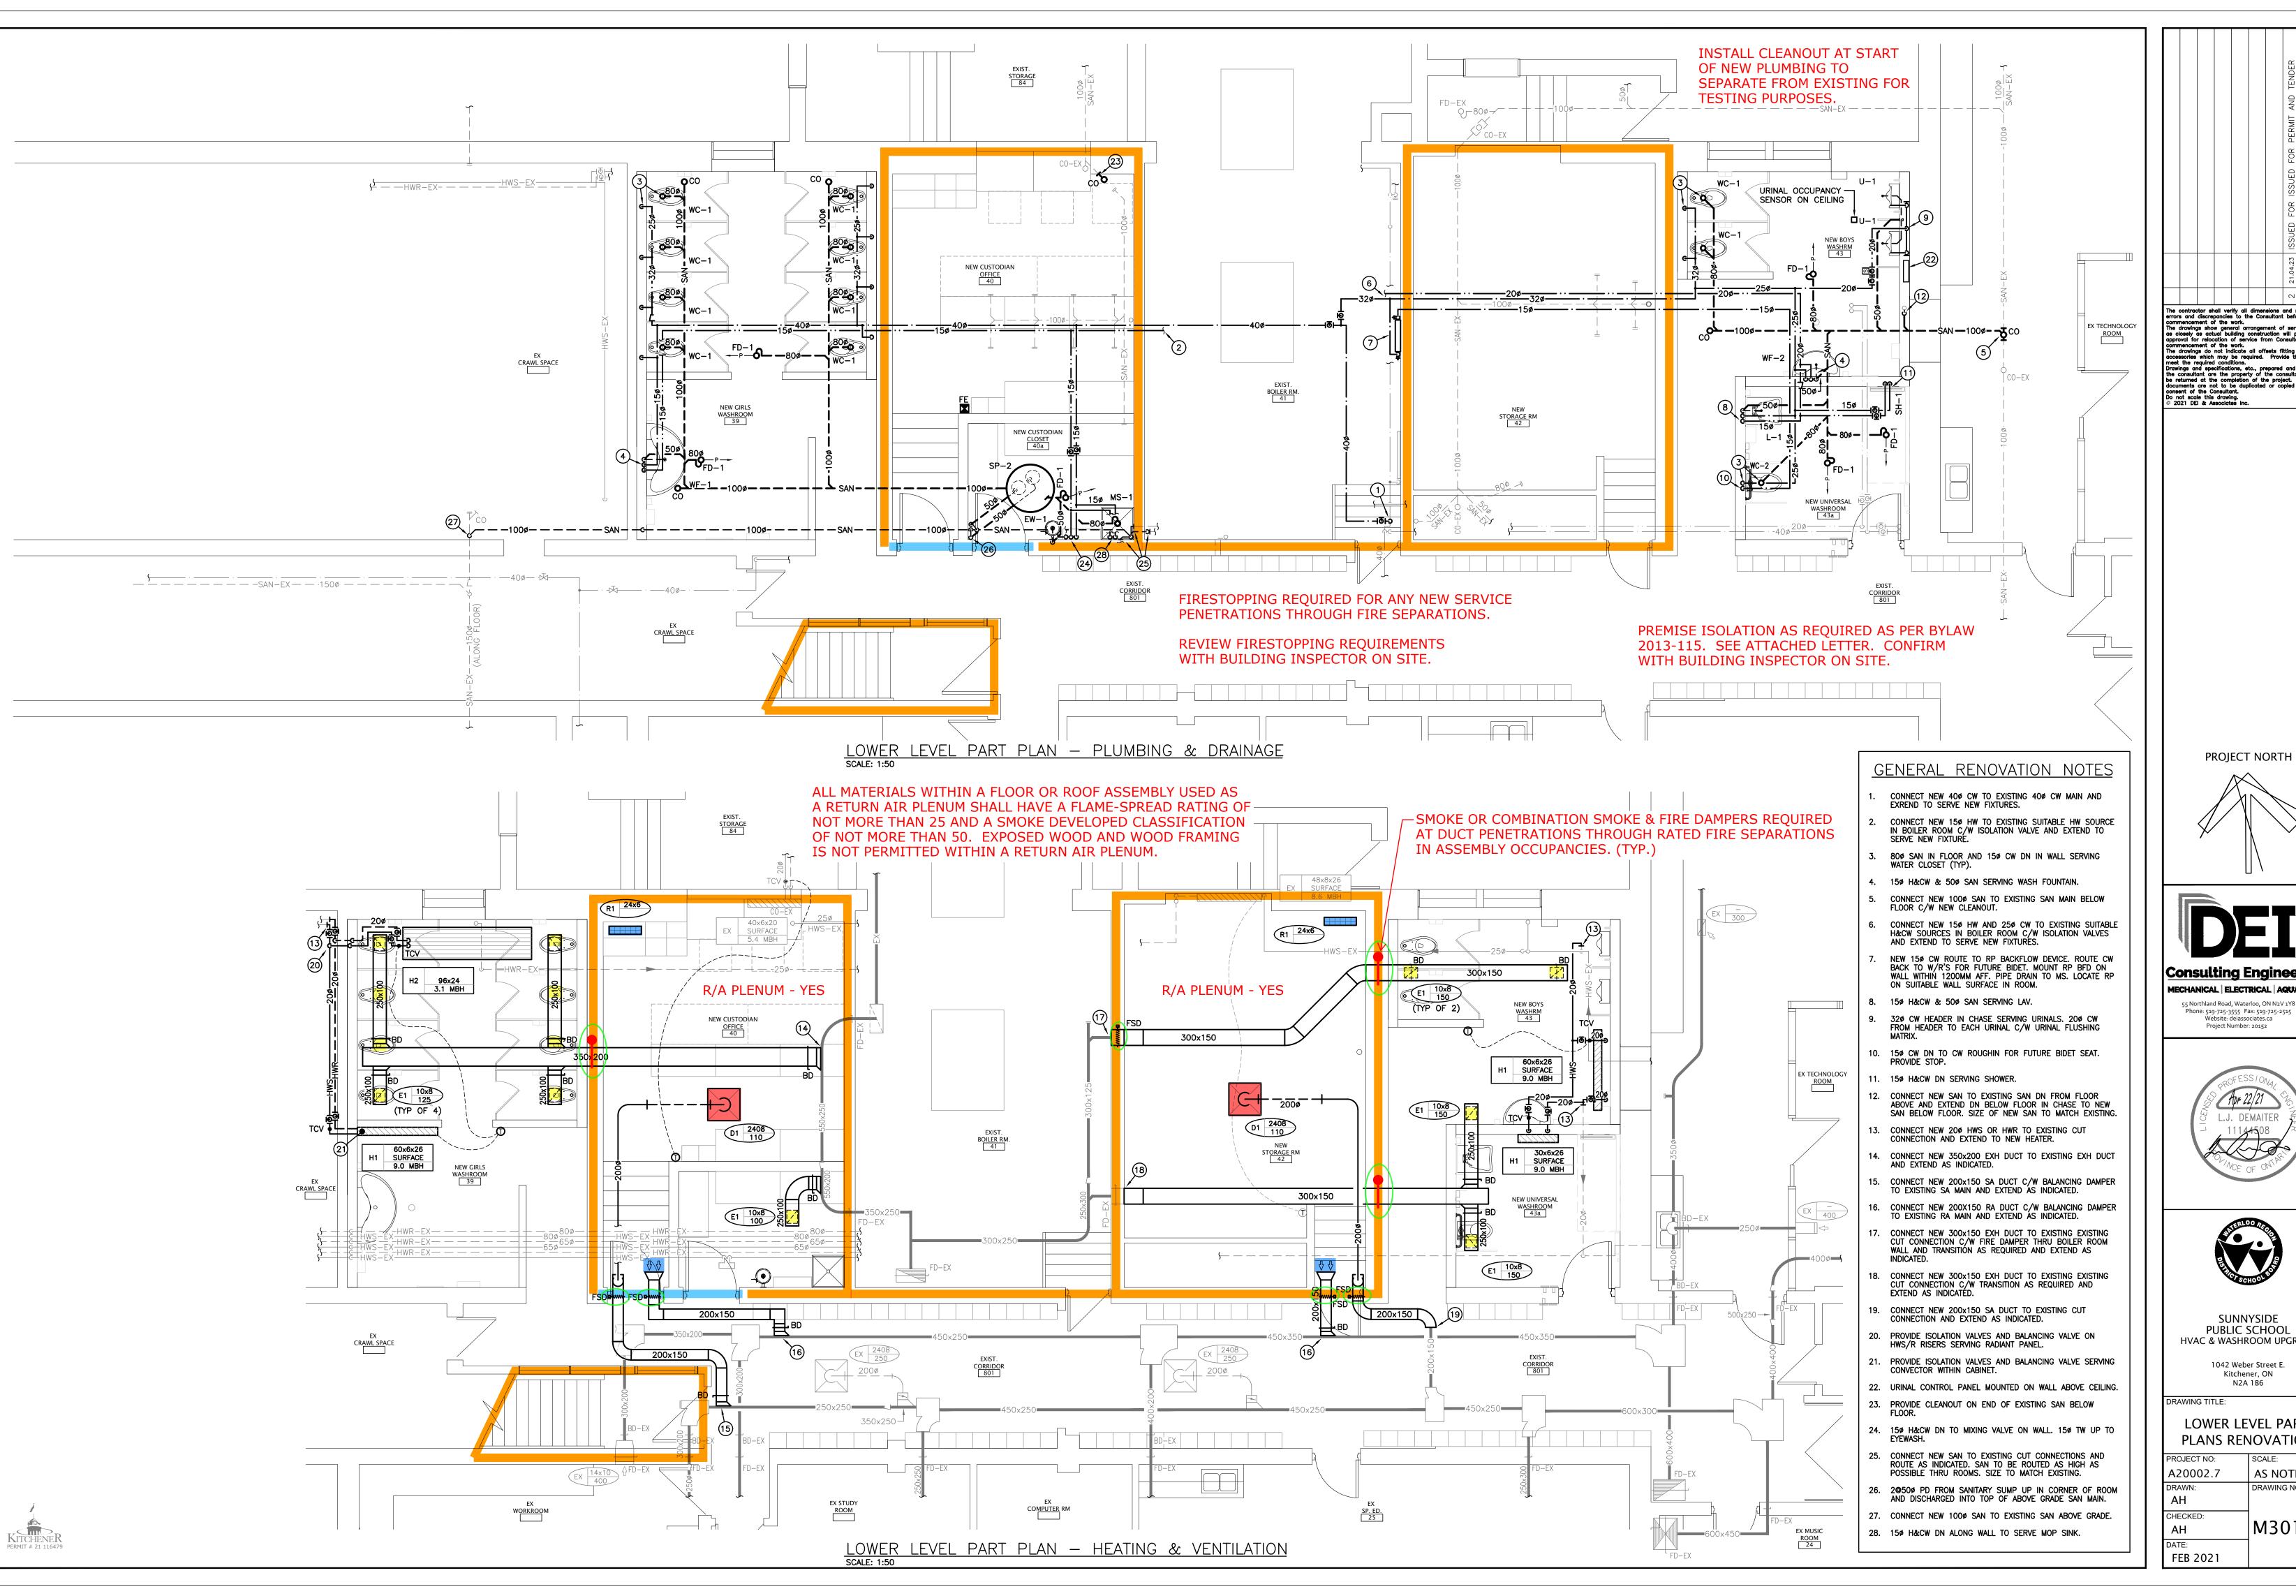


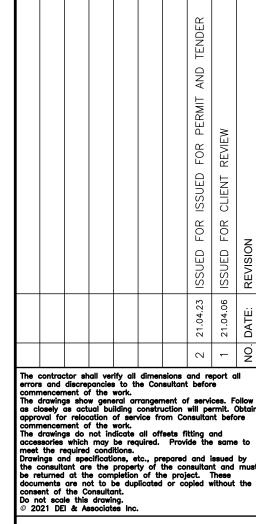

PROJECT NORTH

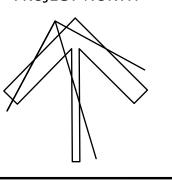

Consulting Engineers MECHANICAL | ELECTRICAL | AQUATIC

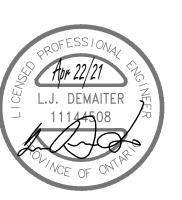




SUNNYSIDE PUBLIC SCHOOL HVAC & WASHROOM UPGRADE

1042 Weber Street E. Kitchener, ON N2A 1B6

RAWING TITLE:

LOWER LEVEL PART PLANS RENOVATION

PROJECT NO: SCALE: A20002.7 AS NOTED DRAWING NO: REV

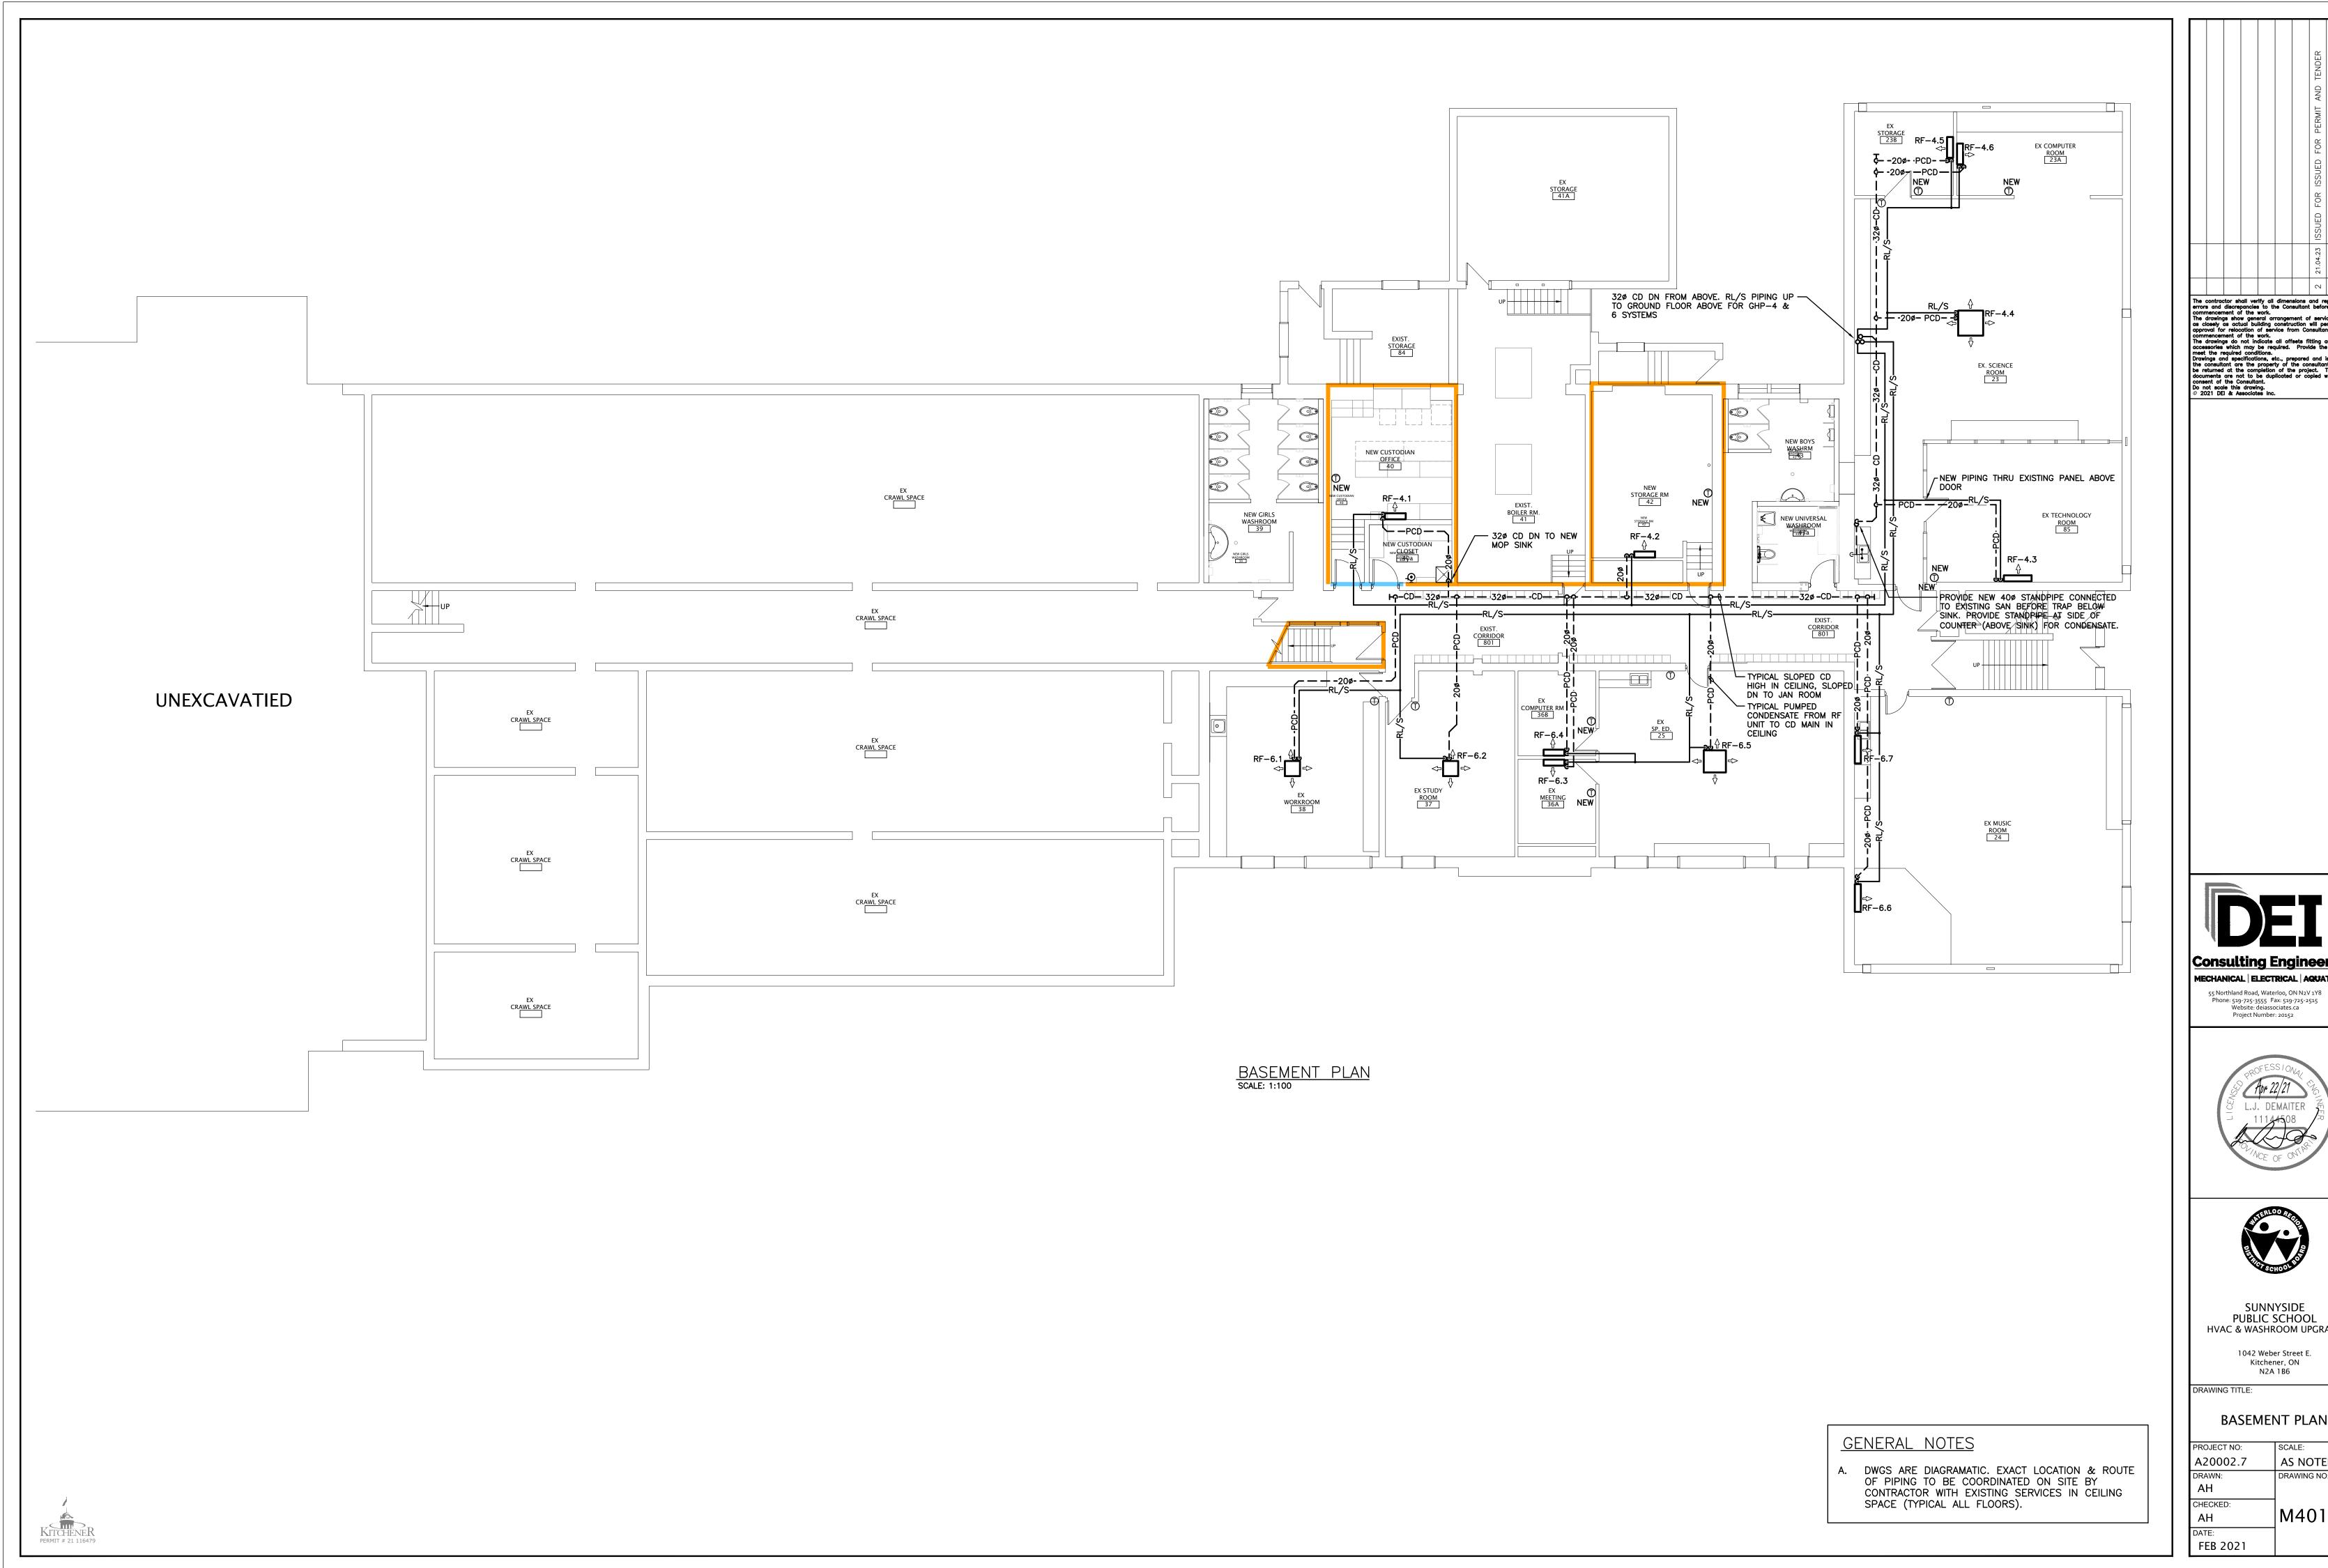

The contractor shall verify all dimensions and report all errors and discrepancies to the Consultant before commencement of the work.


The drawings show general arrangement of services. Follow as closely as actual building construction will permit. Obtain approval for relocation of service from Consultant before commencement of the work.

The drawings do not indicate all offsets fitting and accessories which may be required. Provide the same to meet the required conditions.

Drawings and specifications, etc., prepared and issued by the consultant are the property of the consultant and must be returned at the completion of the project. These documents are not to be duplicated or copied without the consent of the Consultant.

Do not scale this drawing.

Consulting Engineers MECHANICAL | ELECTRICAL | AQUATIC

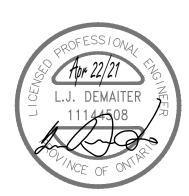





SUNNYSIDE PUBLIC SCHOOL HVAC & WASHROOM UPGRADE

1042 Weber Street E. Kitchener, ON N2A 1B6

**BASEMENT PLAN** 


PROJECT NO:	SCALE:	
A20002.7	AS NOTED	)
DRAWN:	DRAWING NO:	REV.
AH		
CHECKED:		
AH	M401	
DATE:	1	
EEB 2021		

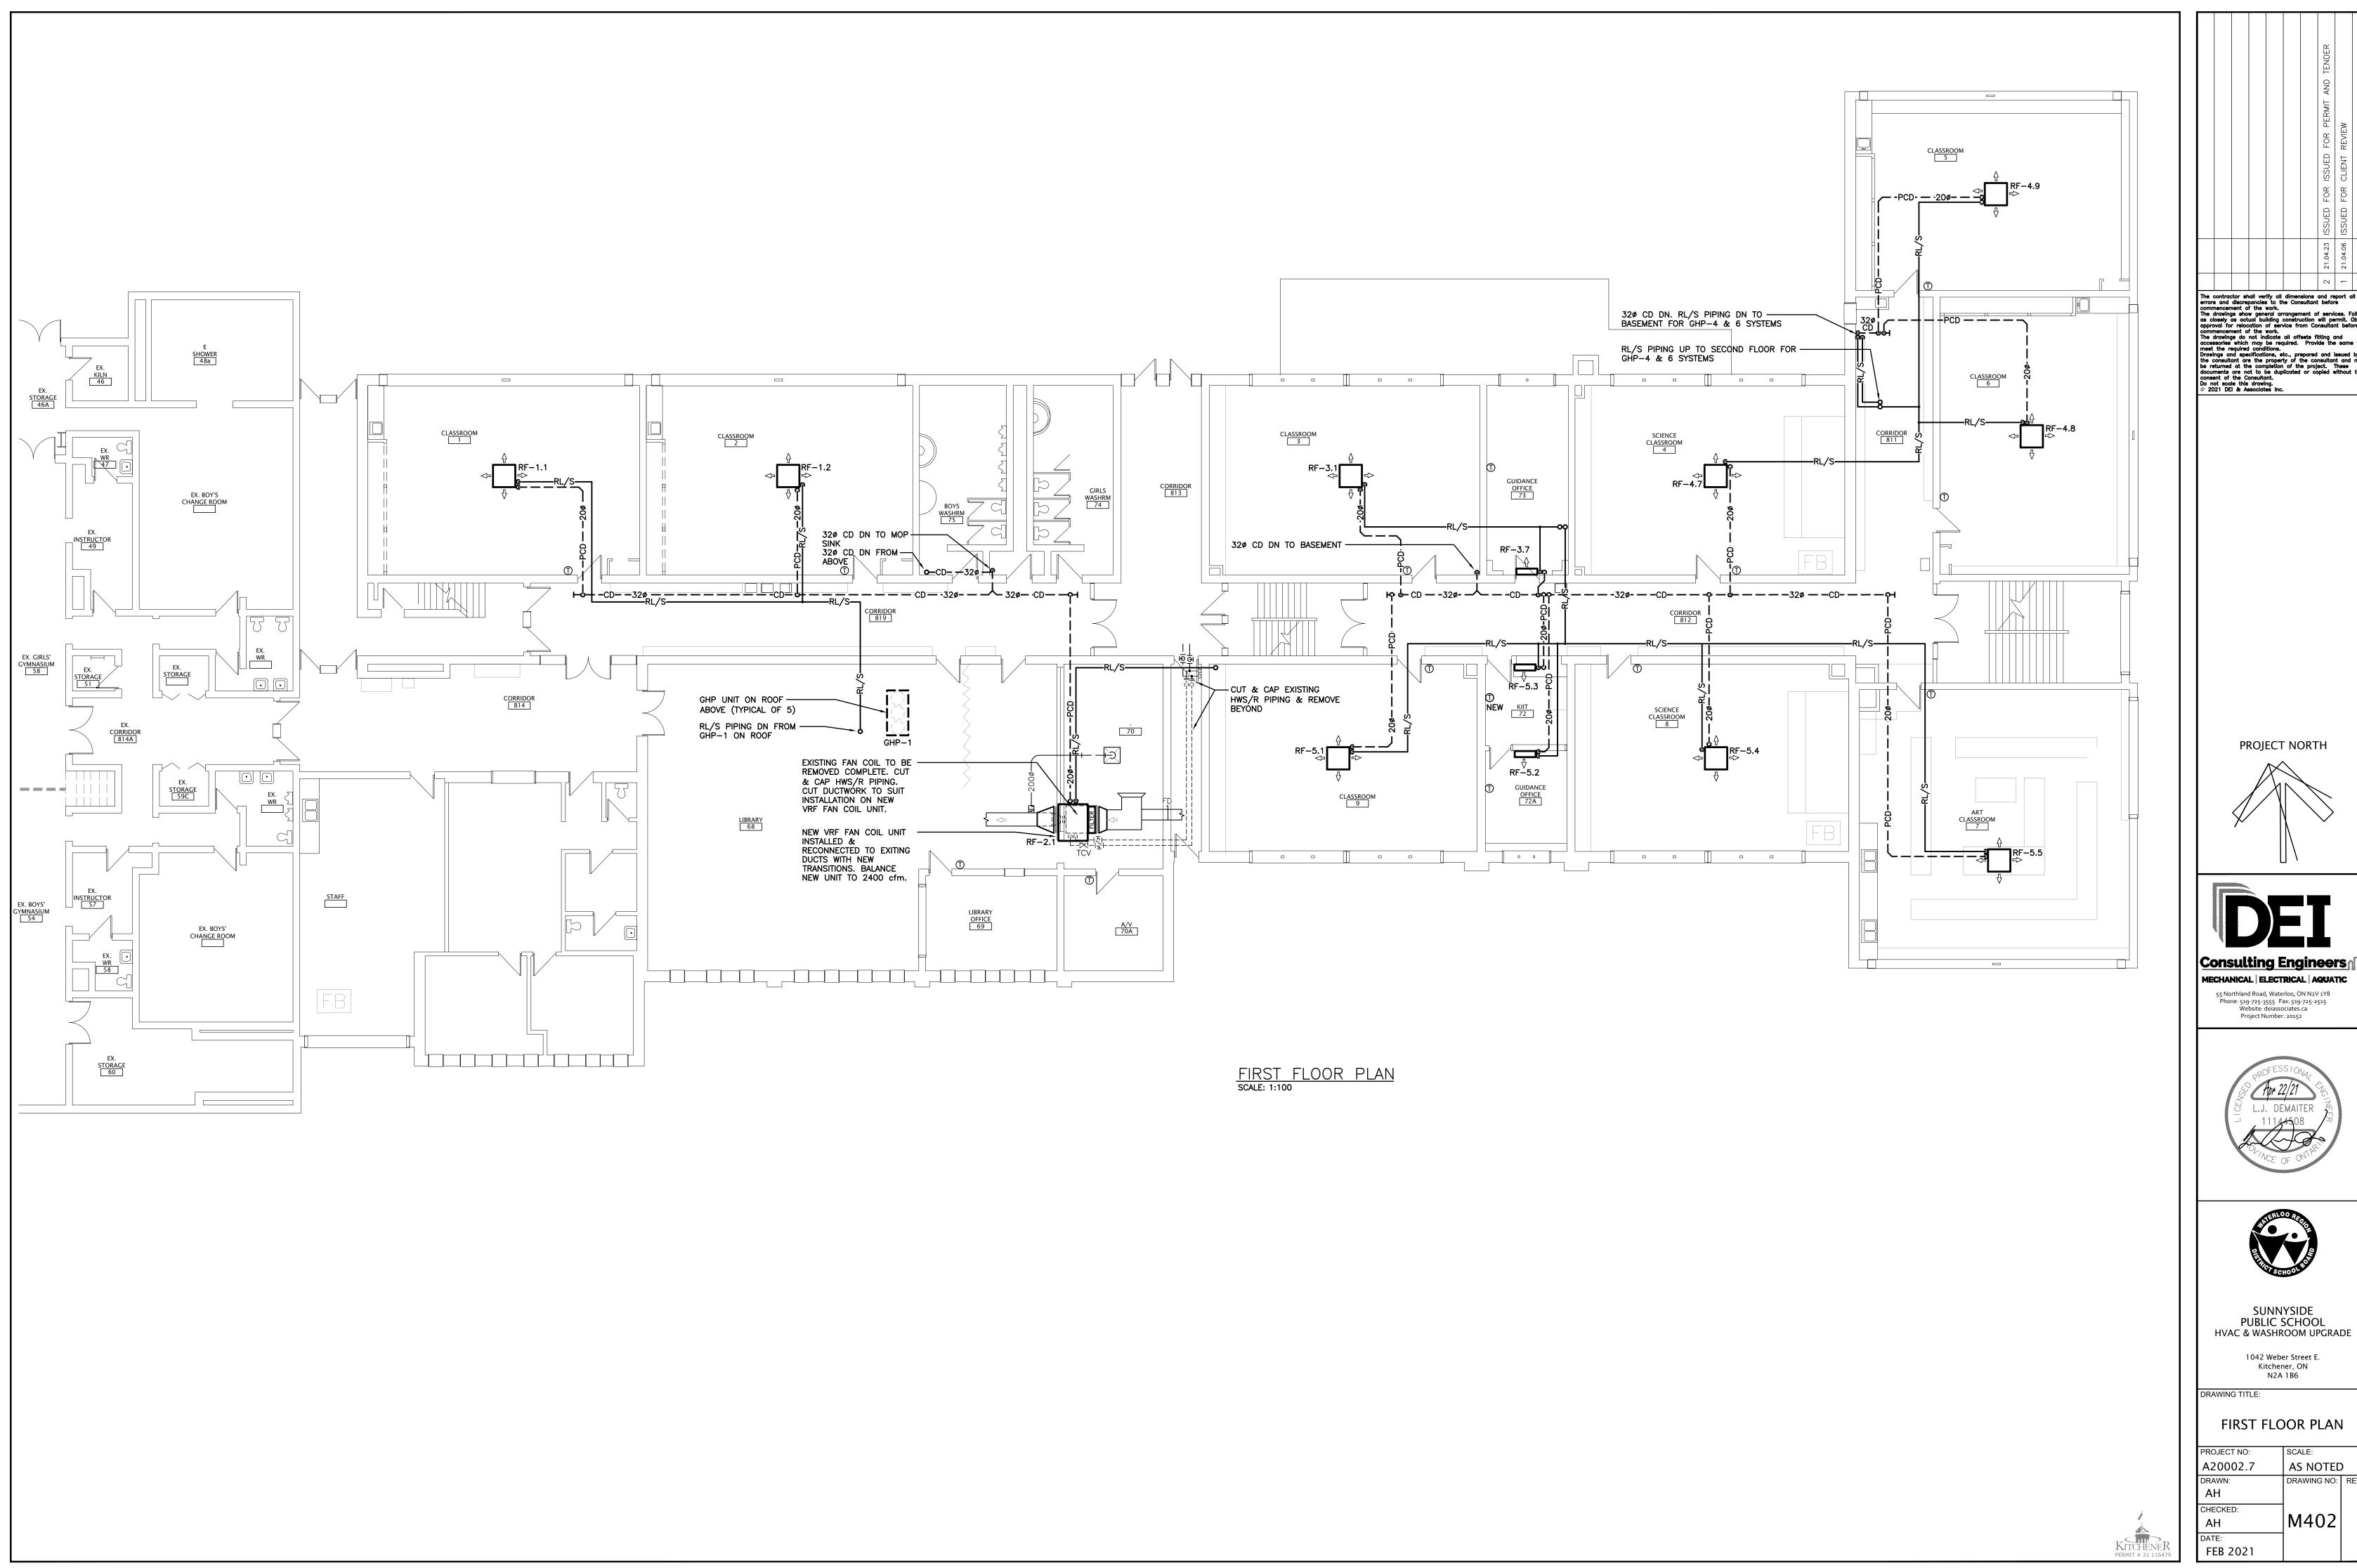


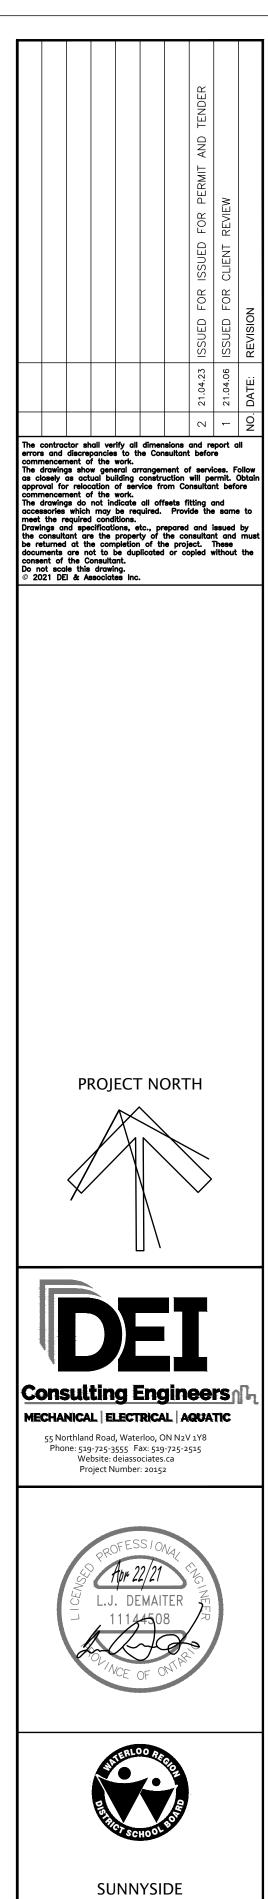


SCALE:

AS NOTED DRAWING NO: REV.

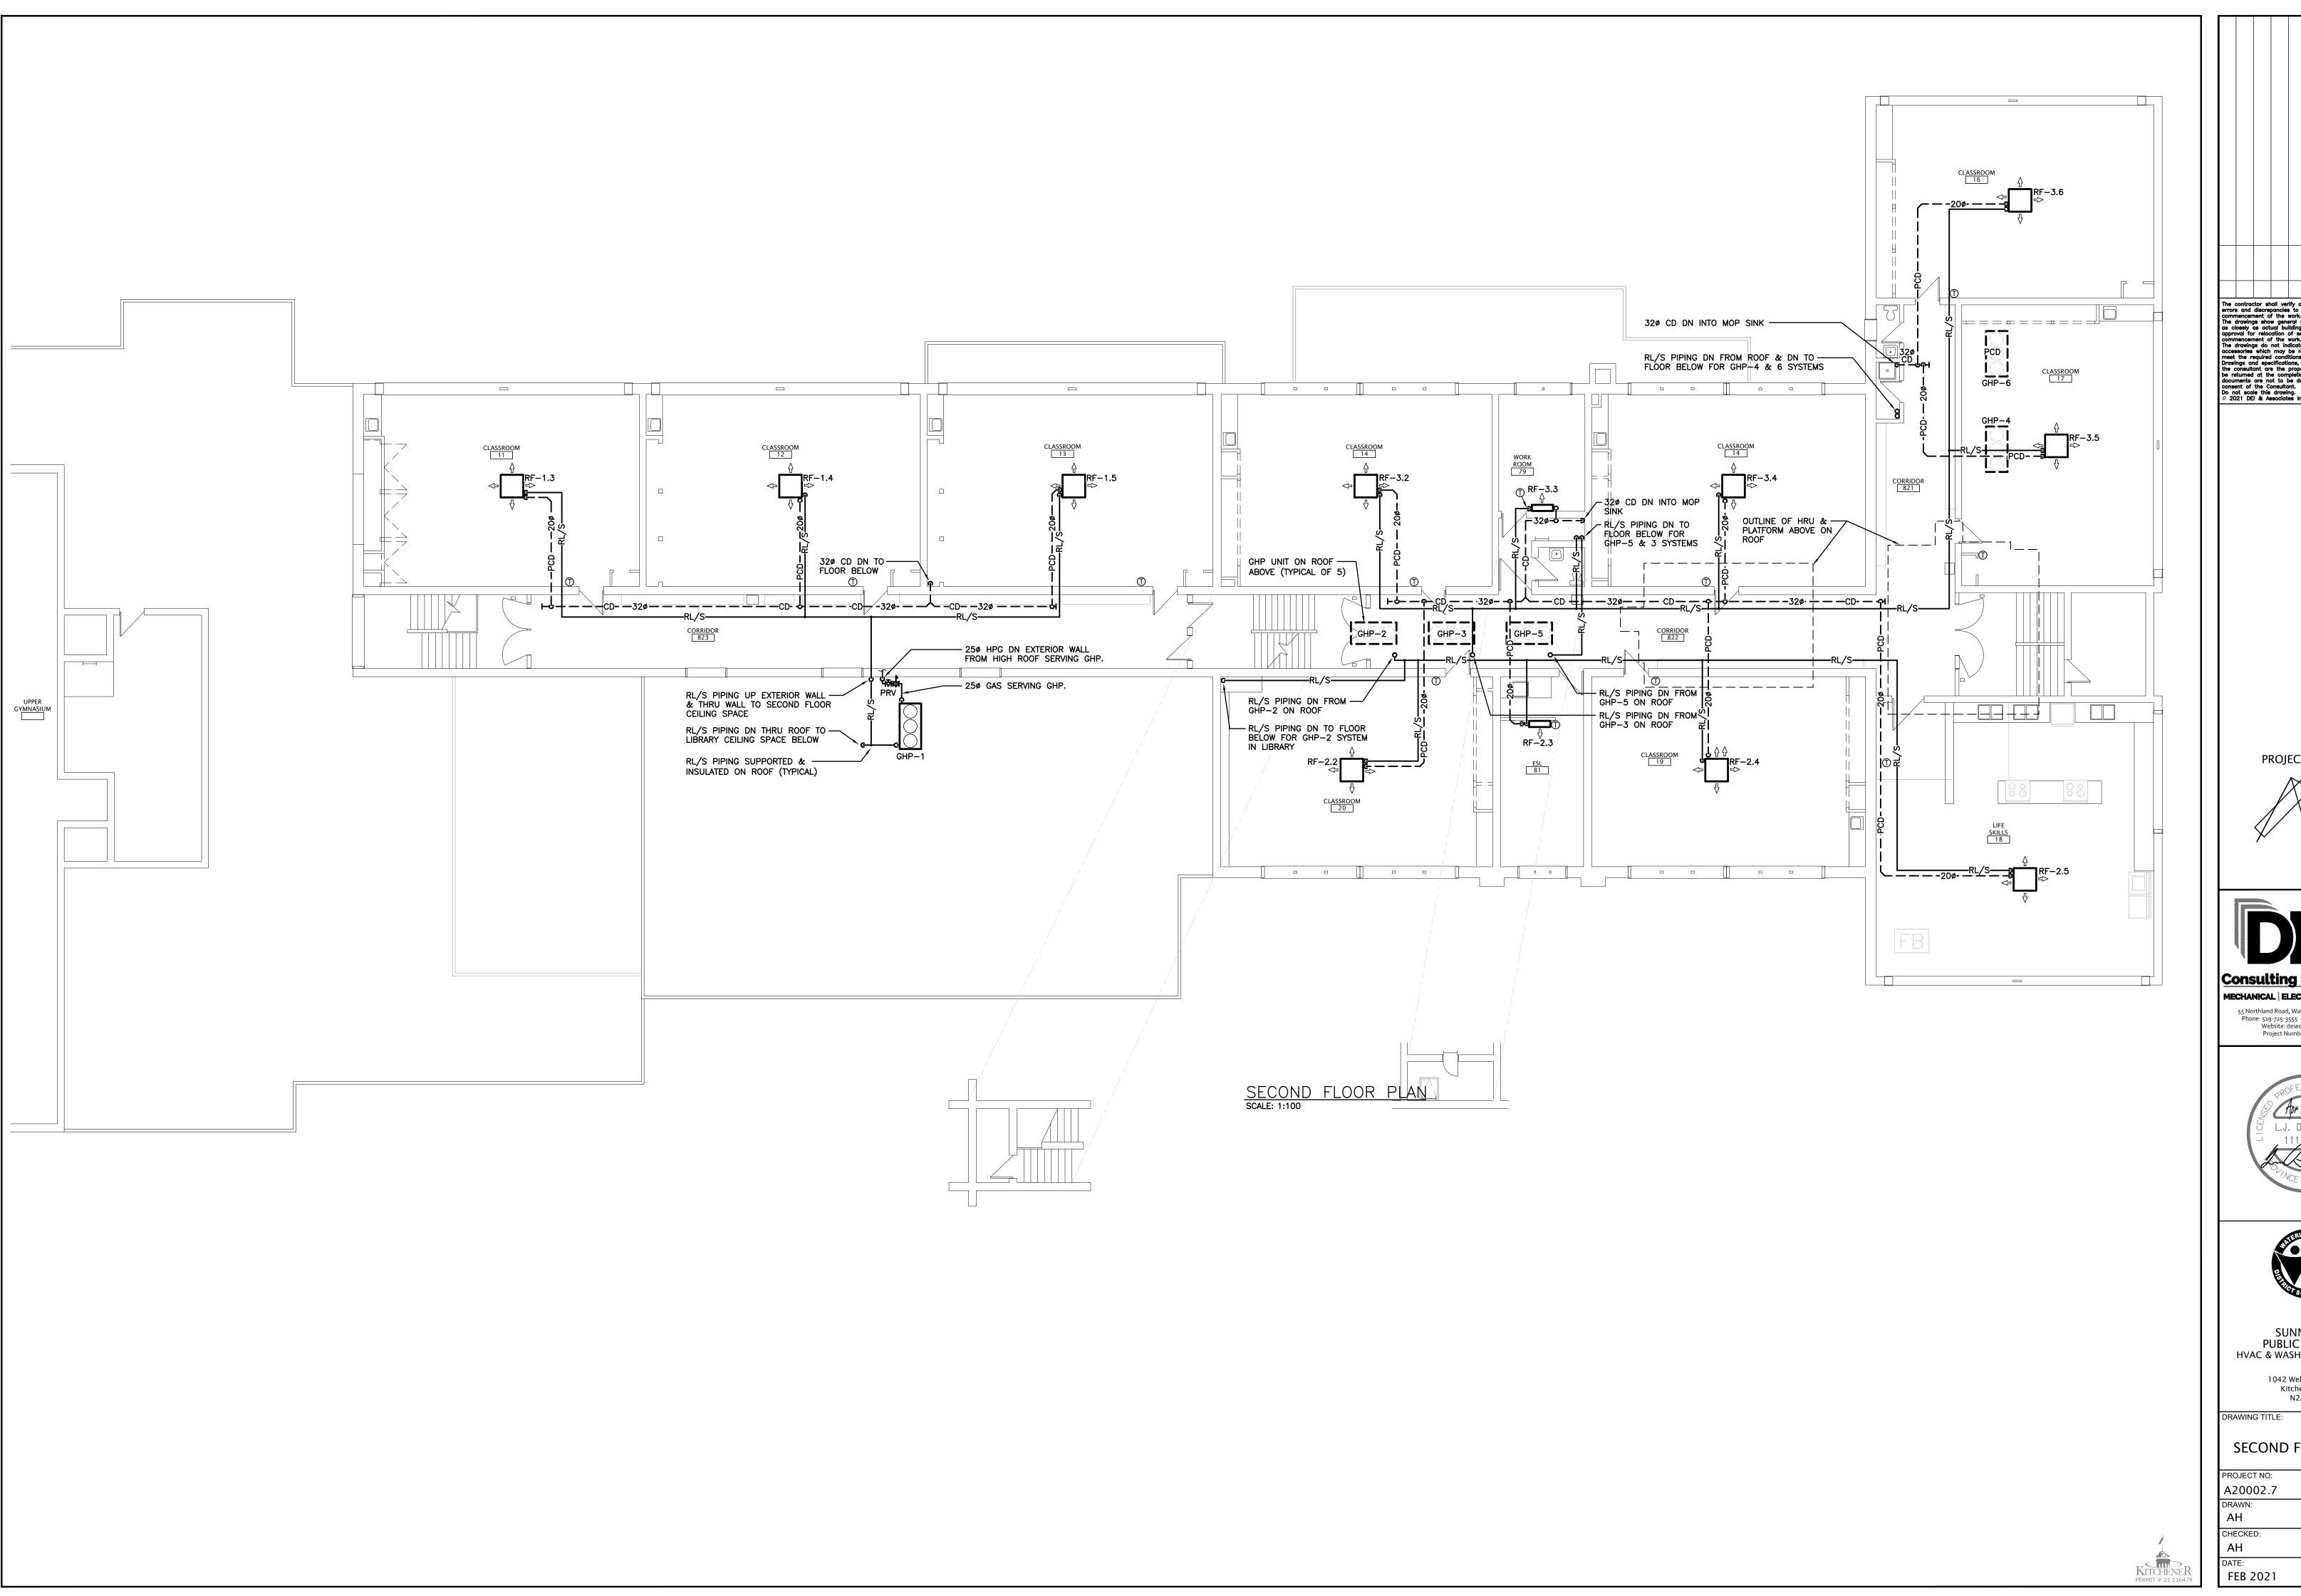

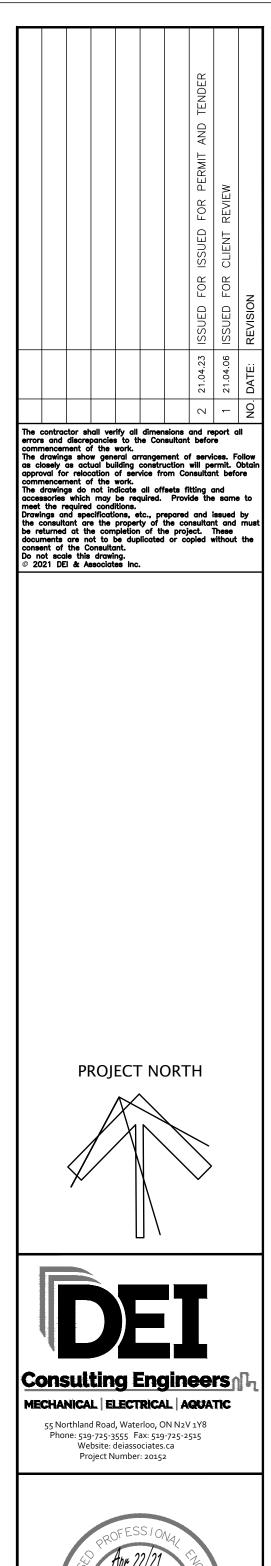



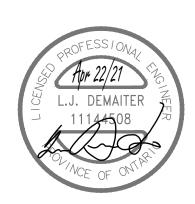




SUNNYSIDE PUBLIC SCHOOL HVAC & WASHROOM UPGRADE

1042 Weber Street E. Kitchener, ON N2A 1B6

SECOND FLOOR PLAN

PROJECT NO:	SCALE:
A20002.7	AS NOTED
DRAWN:	DRAWING NO: REV.
AH	
CHECKED:	
AH	M403
DATE:	
EED 2021	

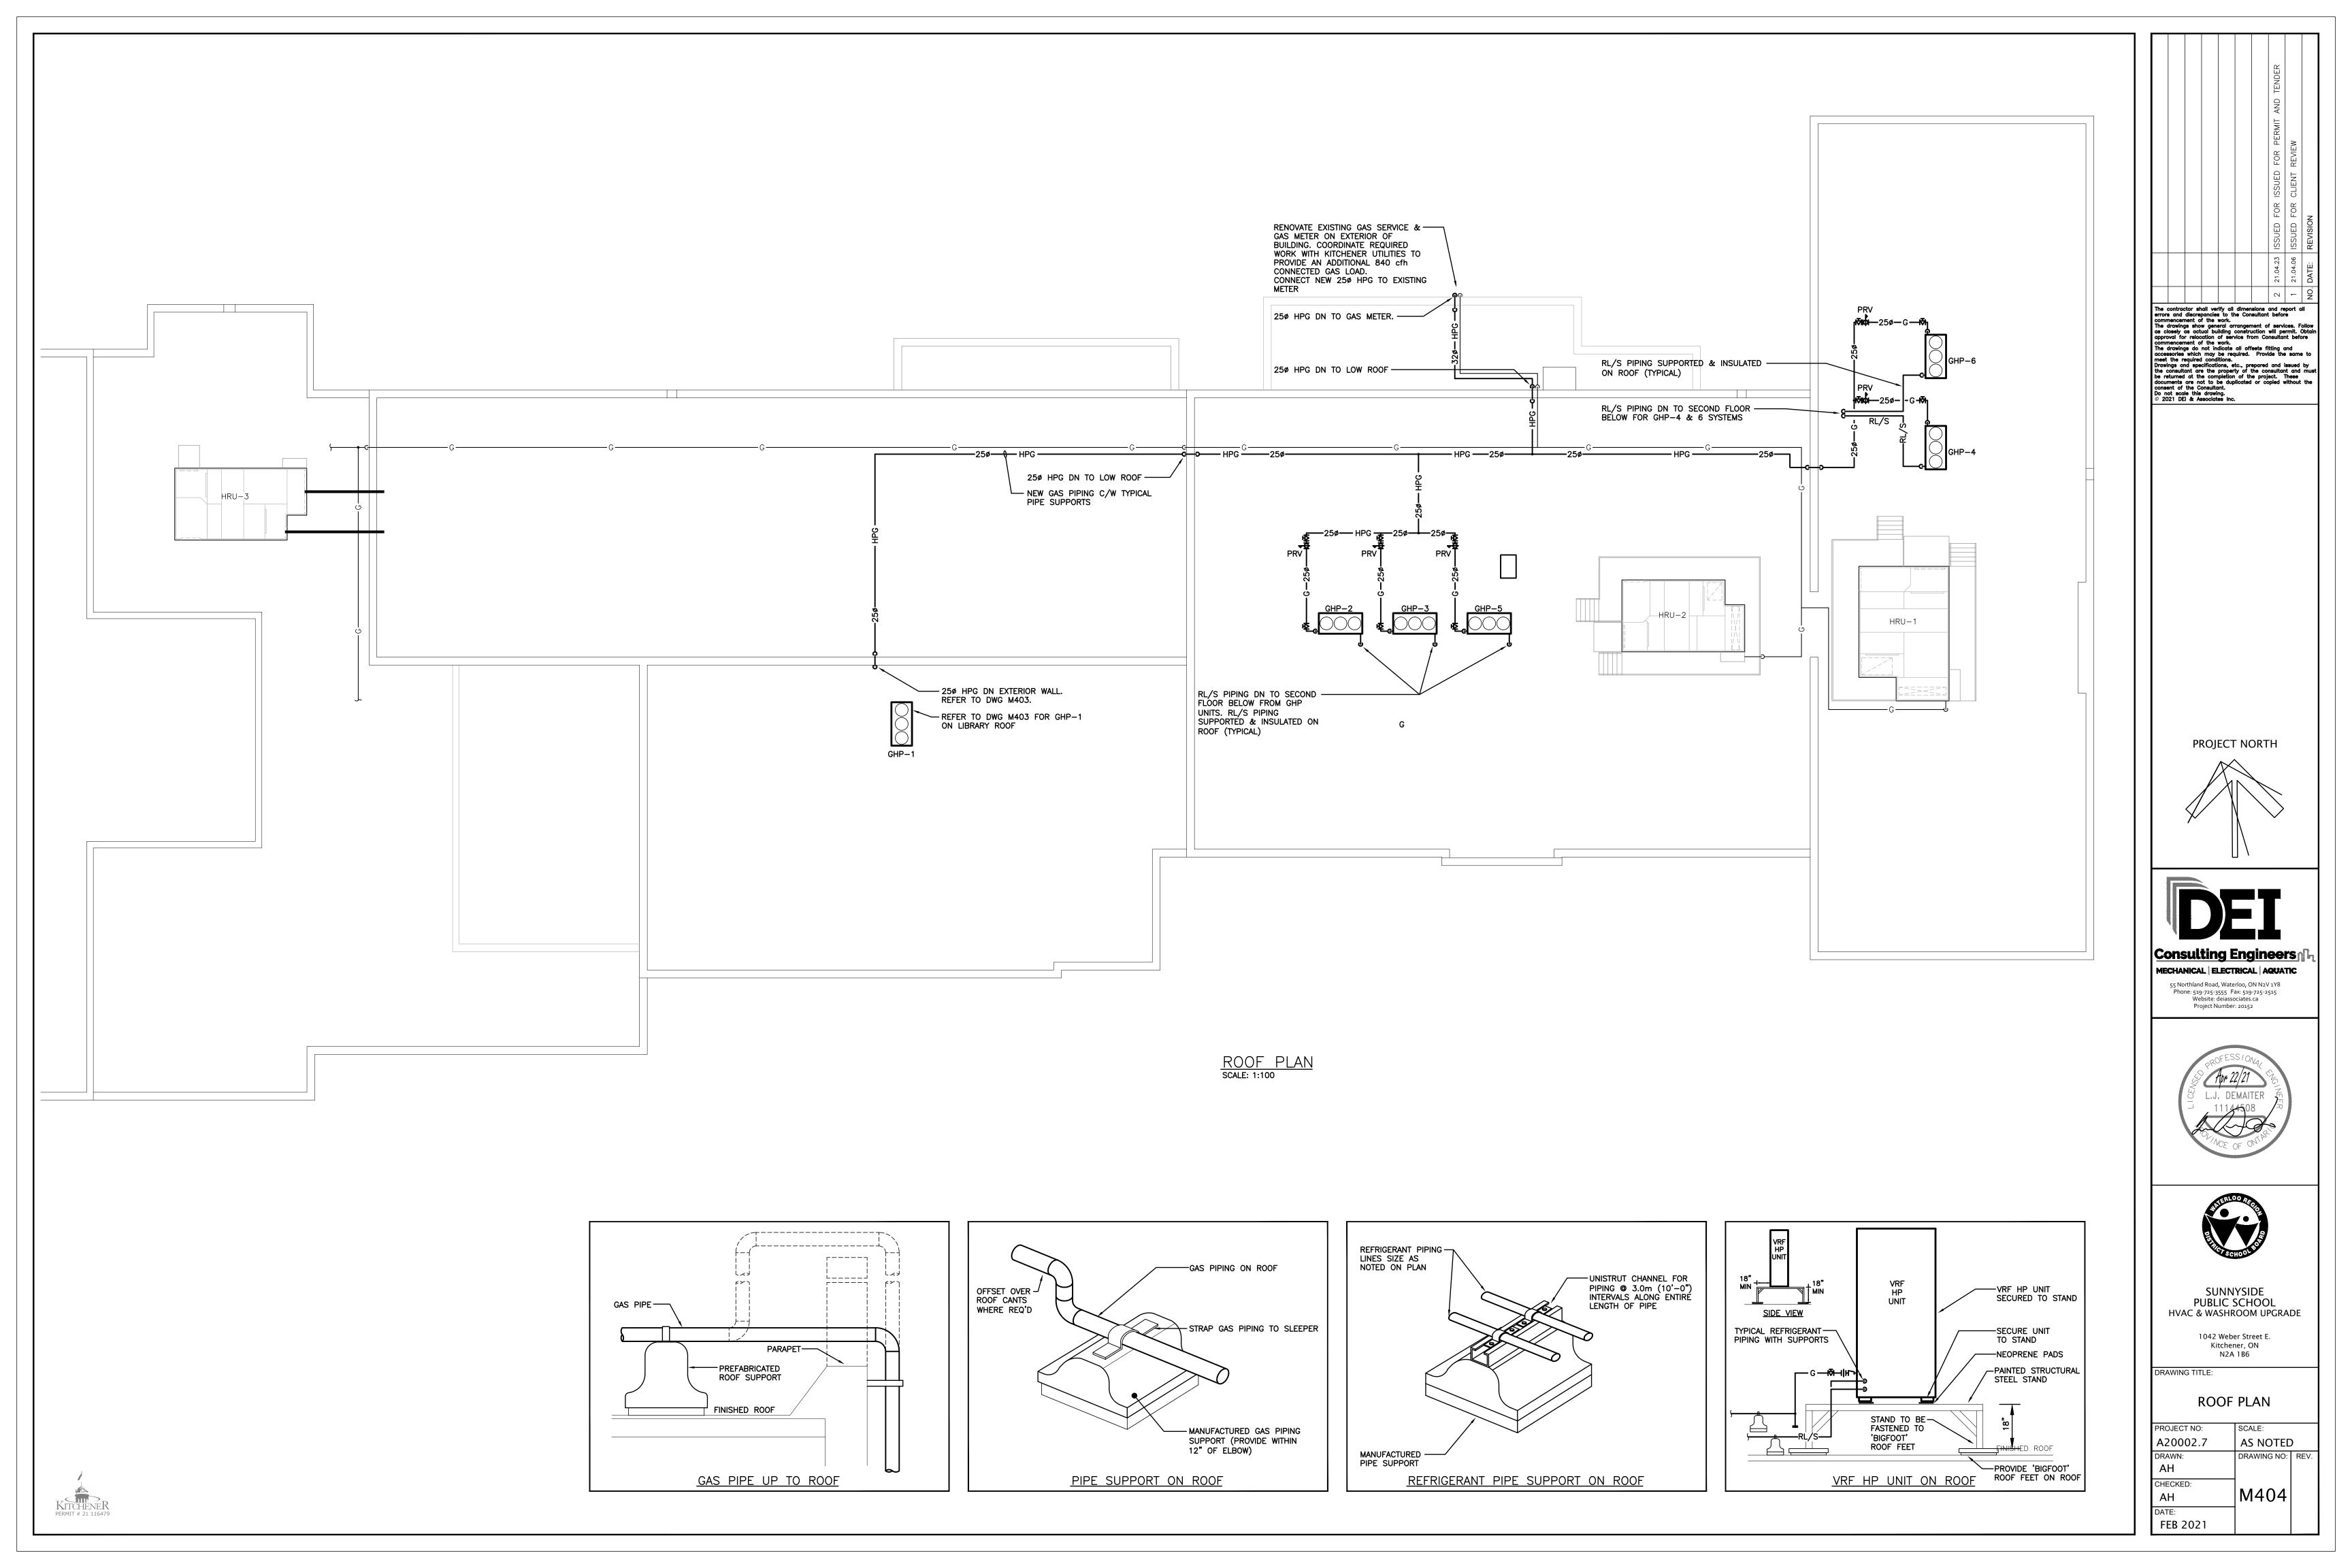

<u>VRF</u>	HP UNIT SO	CHEDULE																						
				Total Capa	city (BTU/h)	Fuel Consump	ption (BTU/h)	Fo	an	Outdoo	r Tempera	ture (°F)		ciency		Pipin	g Connections	(inch)				Power		Sound
Item	Model Number	Туре	Quantity	Total Cooling	Total Heating	Cooling	Heating	Airflow (CFM)	Quantity	Cooling DB	Cooling WB	Heating DB	Cooling IEER (SEER)	Heating COP (HSPF)	Refrigerant	Liquid	Suction	GAS	Volts	Phase	Hz		Power Consumption Cooling/Heating (kW)	
GHP-1	NNCP144J	HEAT PUMP (VRF)	1	143309	156000	119000	117000	12713	2	87.1	73.9	14.0	28.6	3.84	R410A	1/2	1 1/8	3/4	208V	1Ph	60Hz	3.98/3.53	0.89/0.79	57/54
GHP-2	NNCP168J	HEAT PUMP (VRF)	1	167194	189000	168000	147000	13420	2	87.1	73.9	14.0	28.6	3.84	R410A	5/8	1 1/8	3/4	208V	1Ph	60Hz	4.53/4.21	0.86/0.95	58/55
GHP-3	NNCP168J	HEAT PUMP (VRF)	1	167194	189000	168000	147000	13420	2	87.1	73.9	14.0	28.6	3.84	R410A	5/8	1 1/8	3/4	208V	1Ph	60Hz	4.53/4.21	0.86/0.95	58/55
GHP-4	NNCP168J	HEAT PUMP (VRF)	1	167194	189000	168000	147000	13420	2	87.1	73.9	14.0	28.6	3.84	R410A	5/8	1 1/8	3/4	208V	1Ph	60Hz	4.53/4.21	0.86/0.95	58/55
GHP-5	NNCP120J	HEAT PUMP (VRF)	1	119424	134000	93000	96000	12713	2	87.1	73.9	14.0	28.6	3.84	R410A	1/2	1	3/4	208V	1Ph	60Hz	4.44/4.13	0.89/0.79	57/54
GHP-6	NNCP120J	HEAT PUMP (VRF)	1	119424	134000	93000	96000	12713	2	87.1	73.9	14.0	28.6	3.84	R410A	1/2	1	3/4	208V	1Ph	60Hz	4.44/4.13	0.89/0.79	57/54

Material NNCP120J		Description	
141401 1203	Quantity 2	Heat pump	
NNCP144J	1	Heat pump	
NNCP168J	3	Heat pump	
FXAQ07P	6	Wall Mounted Type	
FXAQ09P	3	Wall Mounted Type	
FXAQ12P	2	Wall Mounted Type	
FXAQ18P	2	Wall Mounted Type	
FXAQ24P	1	Wall Mounted Type	
FXFQ15T	1	Round flow cassette	
FXFQ30T	18	Round flow cassette	
FXFQ48T	2	Round flow cassette	
FXMQ72M	1	Ceiling Concealed DC Duct Unit	
FXUQ18P	1	Ceiling-Suspended Type	
FXUQ36P	1	Ceiling-Suspended Type	
ACDC24	1	AC/DC Power Cord	
CLCW2B1	1	Remote Monitoring Adaptor	
YGAS560J1S	6	Anti-Vibration Mount	
BYCQ125B-W1	21	Standard Decoration Panel	
DACA-CP1-1	14	Optional Condensate Pump	
DMS502B71	1	BACnet interface	
RBPP22Y	15	Y branch, 2 pipes	
RBPP33Y	8	Y branch, 2 pipes	
RBPP72Y	9	Y branch, 2 pipes	
R410A	119.0lbs	Total extra refrigerant charge	
1/4	76.9ft		
3/8	857.3ft	Pipe diameter (inch)	
1/2	236.9ft	Pipe diameter (inch)	
5/8		Pipe diameter (inch)	
3/4		Pipe diameter (inch)	
7/8		Pipe diameter (inch)	
1 1/8		Pipe diameter (inch)	

	Model		_	Nominal Cap	acity (BTU/h)	Room Design	n Temp.(Return A	ir Temp.)(*F)	Air flow rate	Piping Conne	ections (inch)		Pov	/er		
tem	Number	Туре	Quantity	Cooling	Heating	Cooling DB	Cooling WB	Heating DB	(CFM)	Liquid	Gas	Volts	Phase	Hz	MCA	Remarks
-1.1	FXFQ30T	CEILING CASSETTE	1	30000	34000	75.0	67.1	72.0	671/1112	3/8	5/8	208/230V	1Ph	60Hz	1.3	
-1.2	FXFQ30T	CEILING CASSETTE	1	30000	34000	75.0	67.1	72.0	671/1112	3/8	5/8	208/230V	1Ph	60Hz	1.3	
-1.3	FXFQ30T	CEILING CASSETTE	1	30000	34000	75.0	67.1	72.0	671/1112	3/8	5/8	208/230V	1Ph	60Hz	1.3	
F-1.4	FXFQ30T	CEILING CASSETTE	1	30000	34000	75.0	67.1	72.0	671/1112	3/8	5/8	208/230V	1Ph	60Hz	1.3	
F-1.5	FXFQ30T	CEILING CASSETTE	1	30000	34000	75.0	67.1	72.0	671/1112	3/8	5/8	208/230V	1Ph	60Hz	1.3	
-2.1	FXMQ72M	DUCTED CEILING	1	72000	81000	75.0	67.1	72.0	1784/2047	3/8	3/4	208/230V	1Ph	60Hz	9.5	C/W ACCESSORY PUMP DACA-CP1-1 & RA FILTER KIT
F-2.2	FXFQ30T	CEILING CASSETTE	1	30000	34000	75.0	67.1	72.0	671/1112	3/8	5/8	208/230V	1Ph	60Hz	1.3	
F-2.3	FXAQ09P	WALL MOUNTED	1	9500	10500	75.0	67.1	72.0	175/280	1/4	1/2	208/230V	1Ph	60Hz	0.4	C/W ACCESSORY PUMP DACA-CP1-1
-2.4	FXFQ30T	CEILING CASSETTE	1	30000	34000	75.0	67.1	72.0	742/1218	3/8	5/8	208/230V	1Ph	60Hz	1.8	
-2.5	FXFQ48T	CEILING CASSETTE	1	48000	54000	75.0	67.1	72.0	671/1112	3/8	5/8	208/230V	1Ph	60Hz	1.3	
-3.1	FXFQ30T	CEILING CASSETTE	1	30000	34000	75.0	67.1	72.0	671/1112	3/8	5/8	208/230V	1Ph	60Hz	1.3	
-3.2	FXFQ30T	CEILING CASSETTE	1	30000	34000	75.0	67.1	72.0	671/1112	3/8	5/8	208/230V	1Ph	60Hz	1.3	
-3.3	FXAQ07P	WALL MOUNTED	1	7500	8500	75.0	67.1	72.0	671/1112	1/4	1/2	208/230V	1Ph	60Hz	1.3	C/W ACCESSORY PUMP DACA-CP1-1
-3.4	FXFQ30T	CEILING CASSETTE	1	30000	34000	75.0	67.1	72.0	671/1112	3/8		208/230V	1Ph	60Hz	1.3	o, ii noolooonii i oiiii Dhoh-of I-I
-3.4 -3.5	FXFQ30T		1			75.0	67.1	72.0	160/260	3/8	5/8	208/230V 208/230V				
-3.6	FXFQ30T	CEILING CASSETTE	1	30000	34000 34000	75.0	67.1	72.0 72.0	671/1112	3/8	5/8	208/230V 208/230V	1Ph 1Ph	60Hz 60Hz	1.3	
F-3.7			'						·		5/8					C/W ACCESSORY PUMP DACA-CP1-1
-3.7	FXAQ09P	WALL MOUNTED	1	9500	10500	75.0	67.1	72.0	175/280	1/4	1/2	208/230V	1Ph	60Hz	0.4	C/W ACCESSORY PUMP DACA-CPI-I
-4.1	FXAQ12P	WALL MOUNTED	1	12000	13500	75.0	67.1	72.0	180/290	1/4	1/2	208/230V	1Ph	60Hz	0.4	C/W ACCESSORY PUMP DACA-CP1-1
-4.2	FXAQ12P	WALL MOUNTED	1	12000	13500	75.0	67.1	72.0	180/290	1/4	1/2	208/230V	1Ph	60Hz	0.4	C/W ACCESSORY PUMP DACA-CP1-1
F-4.3	FXAQ18P	WALL MOUNTED	1	18000	20000	75.0	67.1	72.0	400/500	1/4	1/2	208/230V	1Ph	60Hz	0.5	C/W ACCESSORY PUMP DACA-CP1-1
F-4.4	FXUQ36P	CEILING SUSPENDED	1	36000	40000	75.0	67.1	72.0	742/1095	3/8	5/8	208/230V	1Ph	60Hz	1.4	
F-4.5	FXAQ07P	WALL MOUNTED	1	7500	8500	75.0	67.1	72.0	160/260	1/4	1/2	208/230V	1Ph	60Hz	0.4	C/W ACCESSORY PUMP DACA-CP1-1
F-4.6	FXAQ09P	WALL MOUNTED	1	9500	10500	75.0	67.1	72.0	175/280	1/4	1/2	208/230V	1Ph	60Hz	0.4	C/W ACCESSORY PUMP DACA-CP1-1
F-4.7	FXFQ30T	CEILING CASSETTE	1	30000	34000	75.0	67.1	72.0	671/1112	3/8	5/8	208/230V	1Ph	60Hz	1.3	
-4.8	FXFQ30T	CEILING CASSETTE	1	30000	34000	75.0	67.1	72.0	671/1112	3/8	5/8	208/230V	1Ph	60Hz	1.3	
F-4.9	FXFQ30T	CEILING CASSETTE	1	30000	34000	75.0	67.1	72.0	671/1112	3/8	5/8	208/230V	1Ph	60Hz	1.3	
F-5.1	FXFQ30T	CEILING CASSETTE	1	30000	34000	75.0	67.1	72.0	671/1112	3/8	5/8	208/230V	1Ph	60Hz	1.3	
-5.2	FXAQ07P	WALL MOUNTED	1	7500	8500	75.0	67.1	72.0	160/260	1/4	1/2	208/230V		60Hz	0.4	C/W ACCESSORY PUMP DACA-CP1-1
F-5.3	FXAQ07P	WALL MOUNTED	1	7500	8500	75.0	67.1	72.0	160/260	1/4	1/2	208/230V	1Ph	60Hz	0.4	C/W ACCESSORY PUMP DACA-CP1-1
F-5.4	FXFQ30T	CEILING CASSETTE	1	30000	34000	75.0	67.1	72.0	671/1112	3/8	5/8	208/230V	1Ph	60Hz	1.3	
F-5.5	FXFQ48T	CEILING CASSETTE	1	48000	54000	75.0	67.1	72.0	742/1218	3/8	5/8	208/230V	1Ph	60Hz	1.3	
F-6.1	FXUQ18P	CEILING	1	18000	20000	75.0	67.1	72.0	565/795	1/4	1/2	208/230V	1Ph	60Hz	0.6	
-6.2	FXFQ15T	SUSPENDED CEILING CASSETTE	1	15000	17000	75.0	67.1	72.0	388/512	1/4	•	208/230V		60Hz	0.6	
-6.3	FXAQ07P	WALL MOUNTED	1						·	1/4	1/2	208/230V 208/230V		60Hz		C/W ACCESSORY PUMP DACA-CP1-1
-6.4			1	7500	8500	75.0	67.1	72.0	160/260	,	1/2				0.4	C/W ACCESSORY PUMP DACA-CP1-1
-6.4 -6.5	FXAQ07P FXFQ30T	WALL MOUNTED  CEILING CASSETTE	1	7500 30000	8500 34000	75.0 75.0	67.1	72.0 72.0	160/260 671/1112	1/4 3/8	1/2 5/8	208/230V 208/230V		60Hz 60Hz	1.3	C/ W ACCESSORT FUMF DACA-CFT-T
-6.6	FXAQ24P	WALL MOUNTED	1	24000	27000	75.0	67.1	72.0	470/635	3/8	5/8	208/230V		60Hz	0.6	C/W ACCESSORY PUMP DACA-CP1-1
-6.7	FXAQ18P	WALL MOUNTED	•	18000	20000	75.0	67.1	72.0	400/500	1/4	1/2	208/230V		60Hz		,



2 21.04.23 ISSUED FOR ISSUED FOR PERMIT AND TE NO. DATE: REVISION

The contractor shall verify all dimensions and report all errors and discrepancies to the Consultant before commencement of the work.


The drawings show general arrangement of services. Follow as closely as actual building construction will permit. Obtain approval for relocation of service from Consultant before commencement of the work.

The drawings do not indicate all offsets fitting and accessories which may be required. Provide the same to meet the required conditions.

Drawings and specifications, etc., prepared and issued by the consultant are the property of the consultant and must be returned at the completion of the project. These documents are not to be duplicated or copied without the consent of the Consultant.


Do not scale this drawing.

PROJECT NORTH

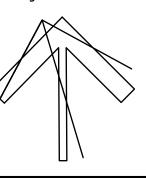

Consulting Engineers MECHANICAL ELECTRICAL AQUATIC

55 Northland Road, Waterloo, ON N2V 1Y8
Phone: 519-725-3555 Fax: 519-725-2515
Website: deiassociates.ca
Project Number: 20152

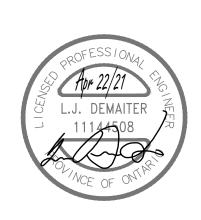




SUNNYSIDE PUBLIC SCHOOL HVAC & WASHROOM UPGRADE


1042 Weber Street E. Kitchener, ON N2A 1B6


DRAWING TITLE:

VRF DETAILS & SCHEMATICS


PROJECT NO:	SCALE:	
A20002.7	AS NOTED	
DRAWN:	DRAWING NO:	REV.
AH		
CHECKED:		
AH	M501	
DATE:		
FEB 2021		

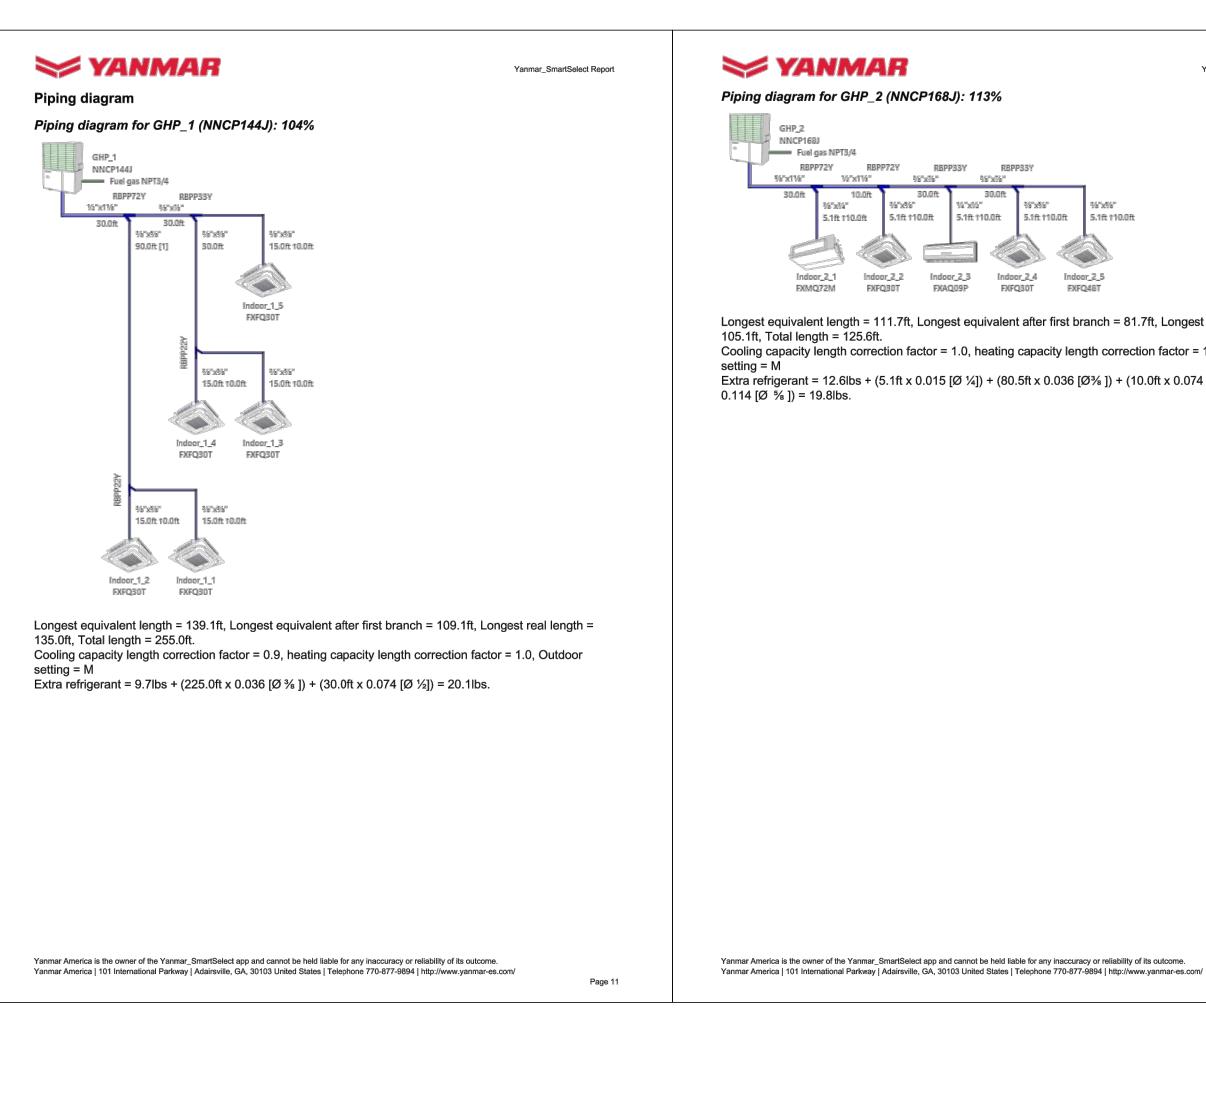

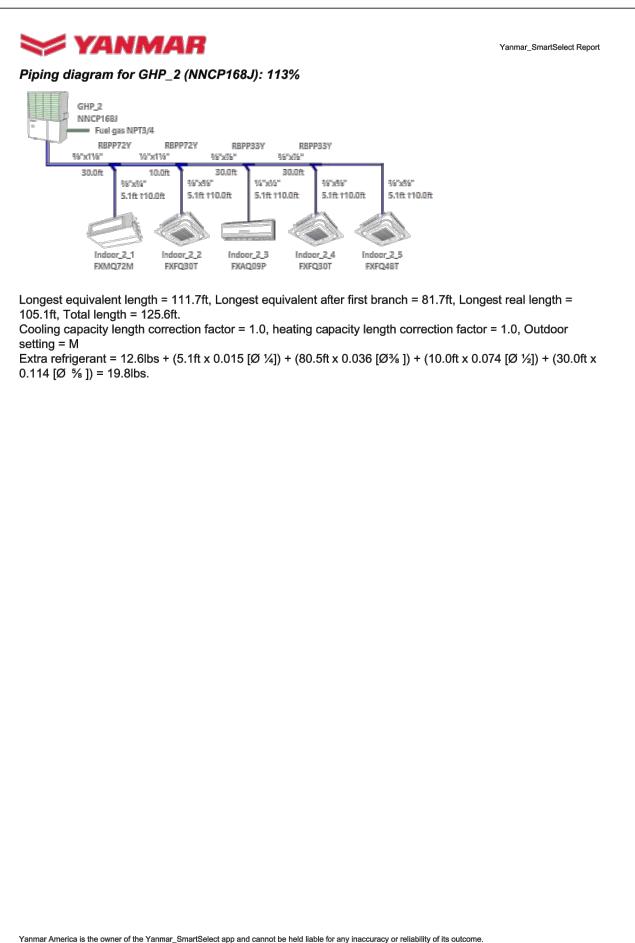

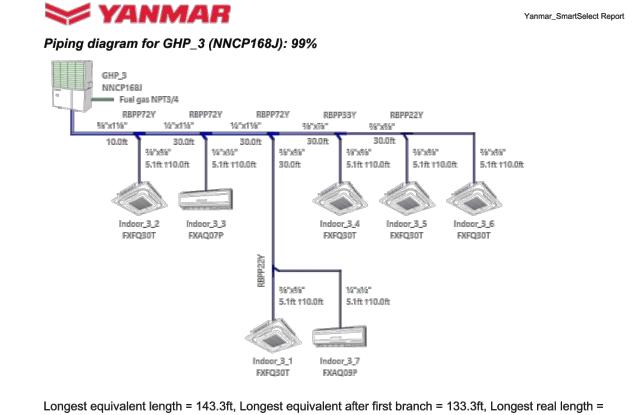

135.1ft, Total length = 195.9ft. Cooling capacity length correction factor = 0.9, heating capacity length correction factor = 1.0, Outdoor Extra refrigerant = 12.6lbs + (10.3ft x 0.015 [Ø  $\frac{1}{2}$ ]) + (115.6ft x 0.036 [Ø $\frac{3}{8}$ ]) + (60.0ft x 0.074 [Ø  $\frac{1}{2}$ ]) + (10.0ft x  $0.114 [\emptyset \frac{5}{8}]) = 22.5 lbs.$ 

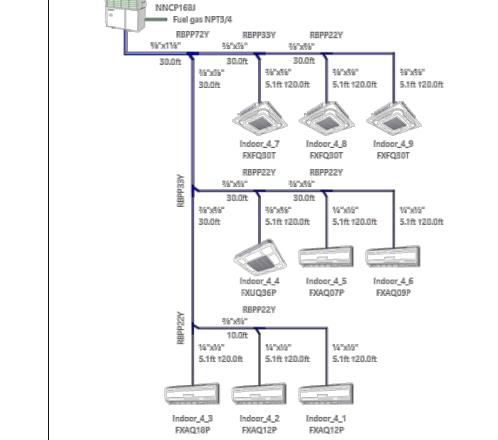

>> YANMAR

Piping diagram for GHP\_4 (NNCP168J): 110%

Longest equivalent length = 131.7ft, Longest equivalent after first branch = 101.7ft, Longest real length = 125.1ft, Total length = 266.2ft. Cooling capacity length correction factor = 0.9, heating capacity length correction factor = 1.0, Outdoor Extra refrigerant = 12.6lbs + (25.6ft x 0.015 [Ø  $\frac{1}{2}$ ]) + (210.5ft x 0.036 [Ø $\frac{3}{2}$ ]) + (30.0ft x 0.114 [Ø  $\frac{5}{2}$ ]) = 24.0lbs.

Yanmar\_SmartSelect Report


Yanmar America is the owner of the Yanmar\_SmartSelect app and cannot be held liable for any inaccuracy or reliability of its outcome. Yanmar America | 101 International Parkway | Adairsville, GA, 30103 United States | Telephone 770-877-9894 | http://www.yanmar-es.com/ Page 13

Yanmar America is the owner of the Yanmar\_SmartSelect app and cannot be held liable for any inaccuracy or reliability of its outcome.

Yanmar America | 101 International Parkway | Adairsville, GA, 30103 United States | Telephone 770-877-9894 | http://www.yanmar-es.com/

Yanmar America is the owner of the Yanmar\_SmartSelect app and cannot be held liable for any inaccuracy or reliability of its outcome. Yanmar America | 101 International Parkway | Adairsville, GA, 30103 United States | Telephone 770-877-9894 | http://www.yanmar-es.com/

Page 14

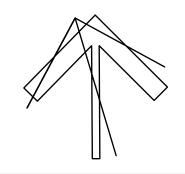

PROJECT NORTH

The contractor shall verify all dimensions and report all errors and discrepancies to the Consultant before commencement of the work. The drawings show general arrangement of services. Follow as closely as actual building construction will permit. Obtain approval for relocation of service from Consultant before commencement of the work.

The drawings do not indicate all offsets fitting and accessories which may be required. Provide the same to meet the required conditions.

Drawings and specifications, etc., prepared and issued by the consultant are the property of the consultant and must be returned at the completion of the project. These documents are not to be duplicated or copied without the consent of the Consultant.

Do not scale this drawing.

Consulting Engineers ը հ MECHANICAL | ELECTRICAL | AQUATIC 55 Northland Road, Waterloo, ON N2V 1Y8 Phone: 519-725-3555 Fax: 519-725-2515 Website: deiassociates.ca

Project Number: 20152 L.J. DEMAITER




SUNNYSIDE PUBLIC SCHOOL **HVAC & WASHROOM UPGRADE** 

> 1042 Weber Street E. Kitchener, ON N2A 1B6


DRAWING TITLE:

VRF SYSTEM PIPING **SCHEMATICS** 

PROJECT NO: SCALE: A20002.7 AS NOTED DRAWING NO: REV. AH CHECKED: ΑH FEB 2021

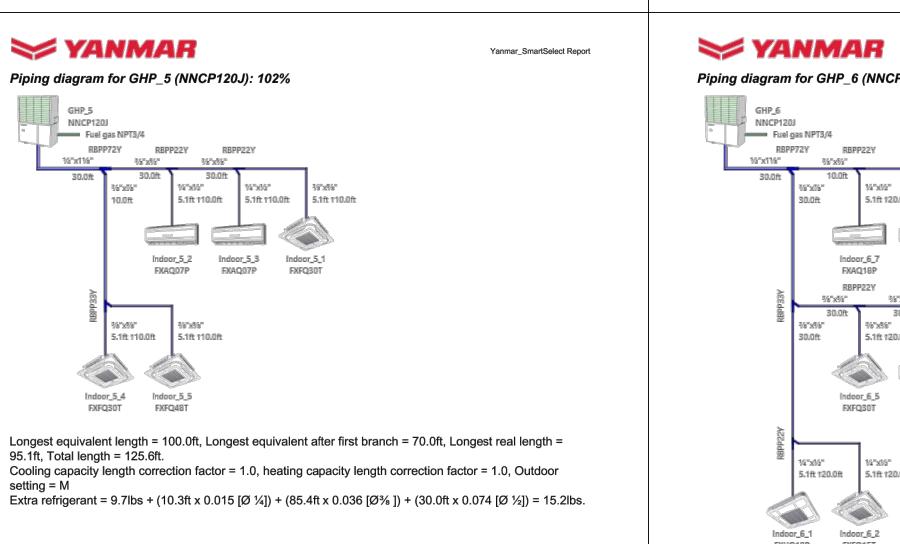



Page 15

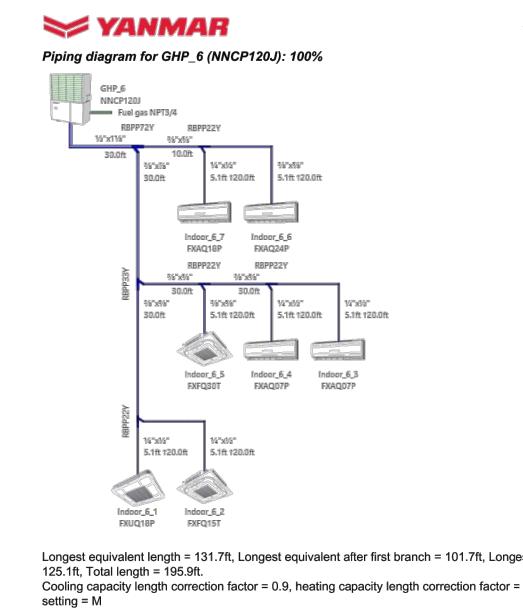



Longest equivalent length = 131.7ft, Longest equivalent after first branch = 101.7ft, Longest real length = Cooling capacity length correction factor = 0.9, heating capacity length correction factor = 1.0, Outdoor Extra refrigerant = 9.7lbs + (25.6ft x 0.015 [Ø  $\frac{1}{2}$ ]) + (140.3ft x 0.036 [Ø $\frac{3}{8}$ ]) + (30.0ft x 0.074 [Ø  $\frac{1}{2}$ ]) = 17.4lbs. Yanmar America is the owner of the Yanmar\_SmartSelect app and cannot be held liable for any inaccuracy or reliability of its outcome. Yanmar America | 101 International Parkway | Adairsville, GA, 30103 United States | Telephone 770-877-9894 | http://www.yanmar-es.com/ Page 16



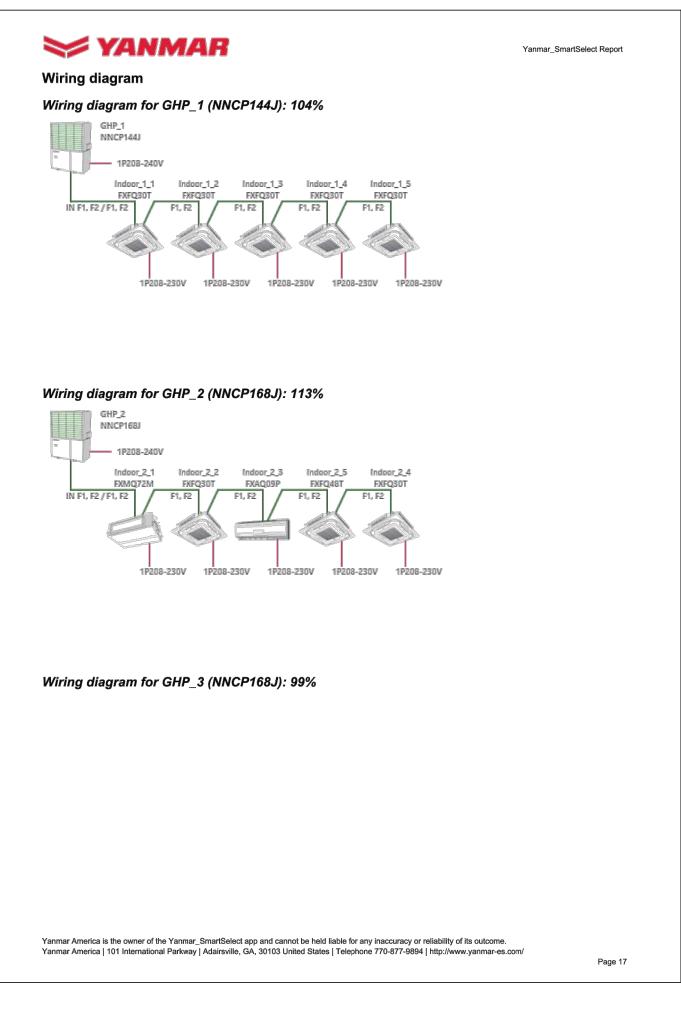

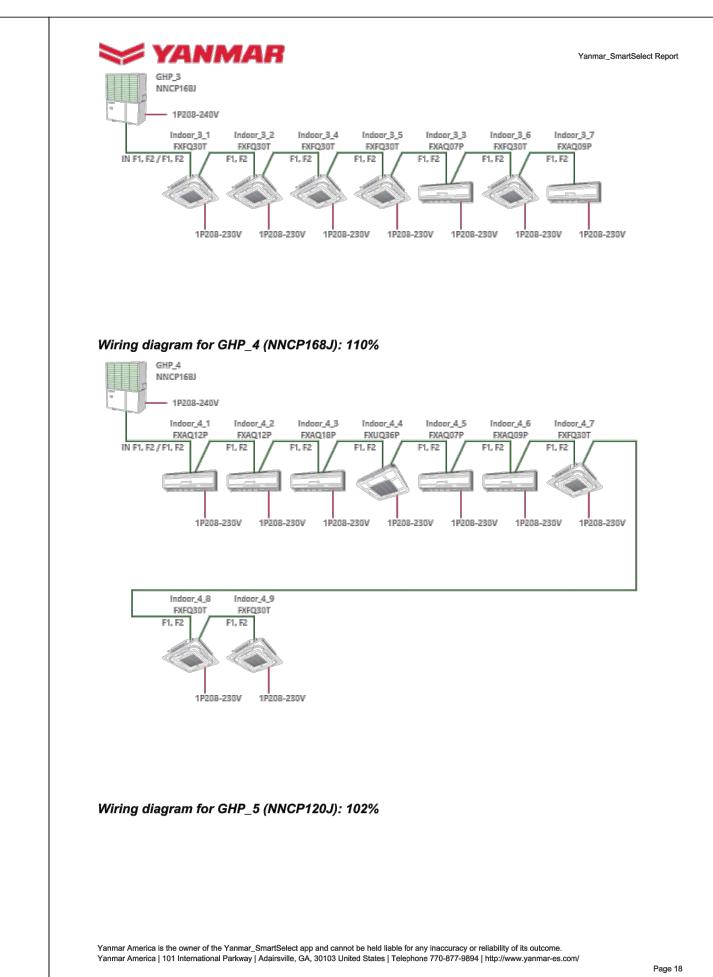

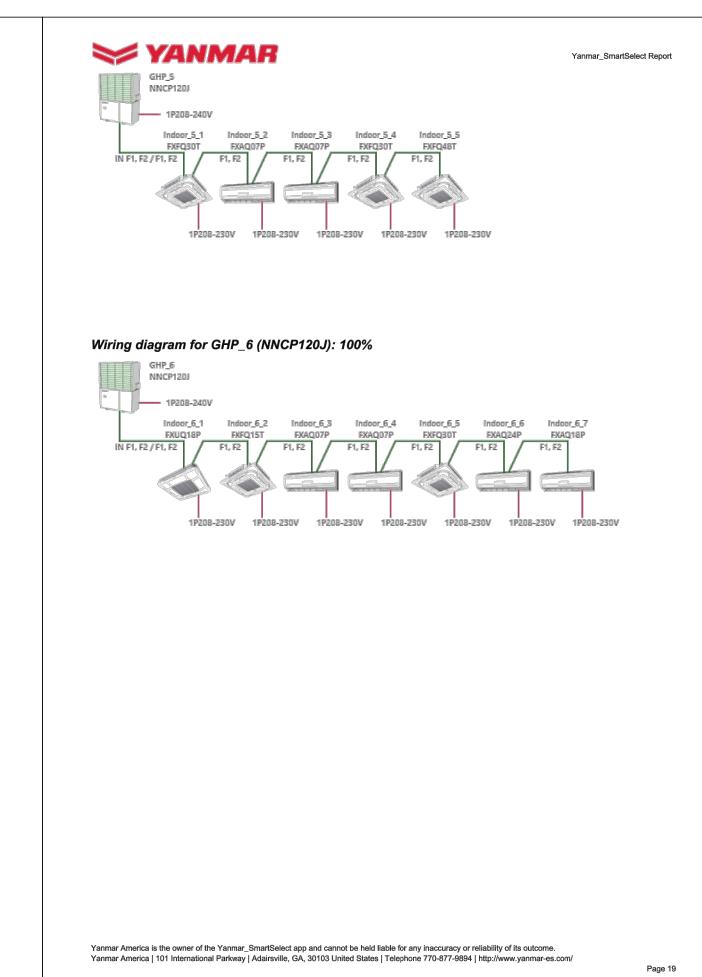

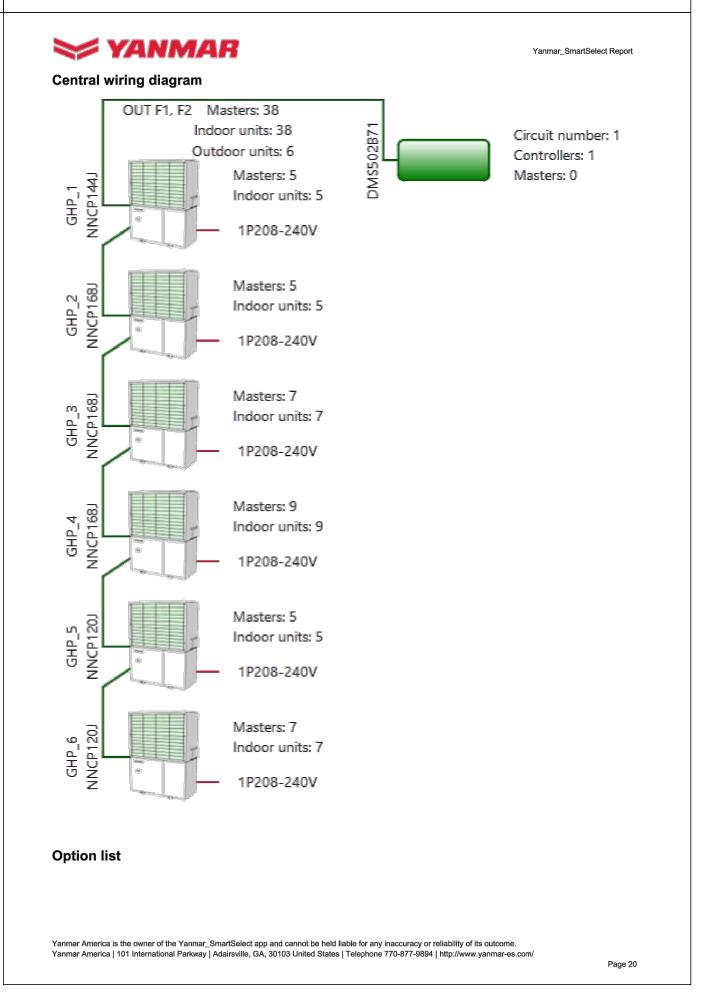



The contractor shall verify all dimensions and report all errors and discrepancies to the Consultant before commencement of the work.

NO. DATE: REVISION

The contractor shall verify all dimensions and report all errors and discrepancies to the Consultant before commencement of the work.

The drawings show general arrangement of services. Follow as closely as actual building construction will permit. Obtain approval for relocation of service from Consultant before commencement of the work.


The drawings do not indicate all offsets fitting and accessories which may be required. Provide the same to meet the required conditions.

Drawings and specifications, etc., prepared and issued by the consultant are the property of the consultant and must be returned at the completion of the project. These documents are not to be duplicated or copied without the consent of the Consultant.

Do not scale this drawing.

© 2021 DEI & Associates Inc.

PROJECT NORTH

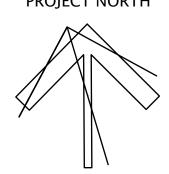


Consulting Engineers

MECHANICAL | ELECTRICAL | AQUATIC

55 Northland Road, Waterloo, ON N2V 1Y8
Phone: 519-725-3555 Fax: 519-725-2515
Website: deiassociates.ca

Project Number: 20152

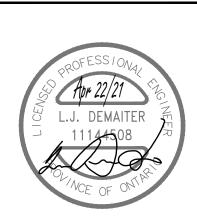



SUNNYSIDE PUBLIC SCHOOL HVAC & WASHROOM UPGRADE

> 1042 Weber Street E. Kitchener, ON

N2A 1B6

DRAWING TITLE:

VRF SYSTEM WIRING SCHEMATICS

PROJECT NO:
A20002.7

DRAWN:
AH


CHECKED:
AH


DATE:
FEB 2021


SCALE:
AS NOTED


DRAWING NO: REV.


M 5 0 3

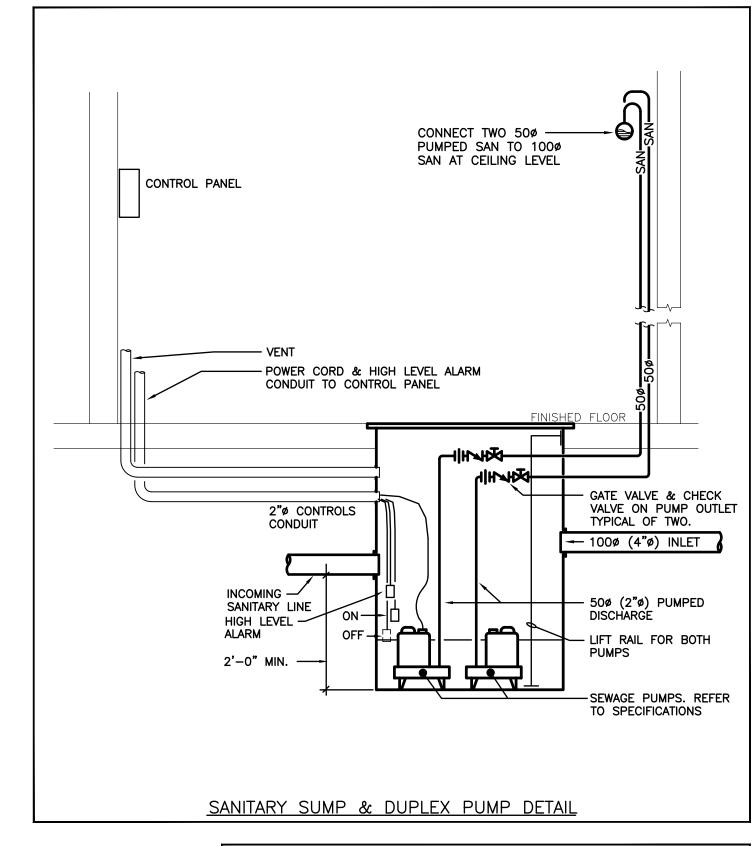


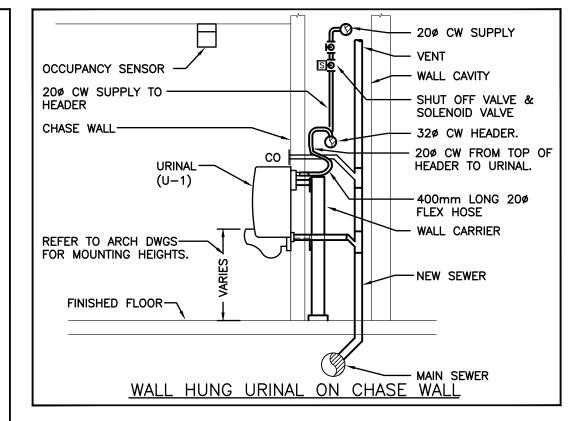


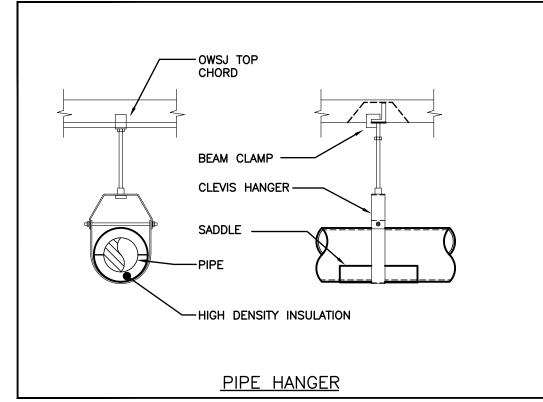


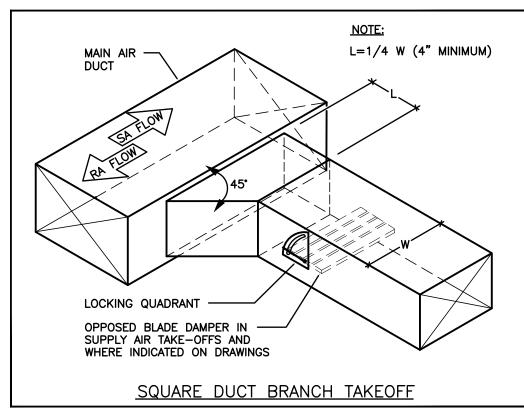


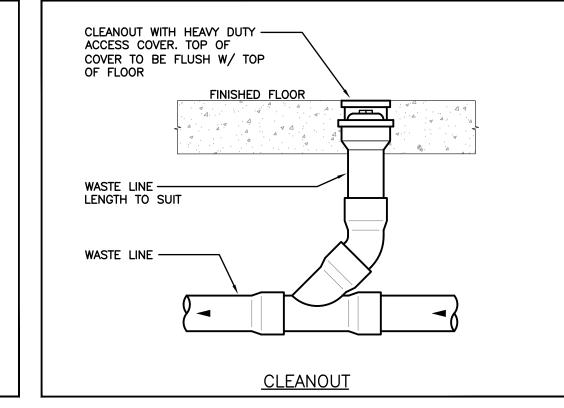

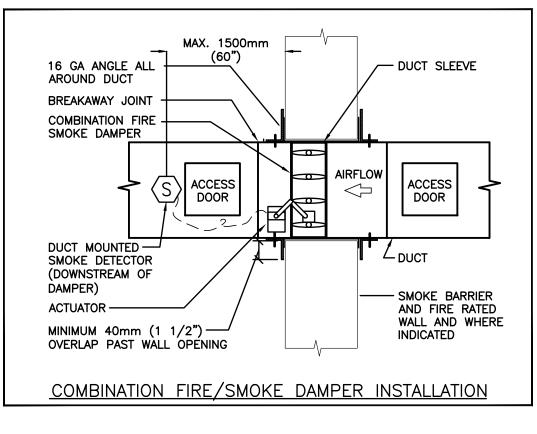

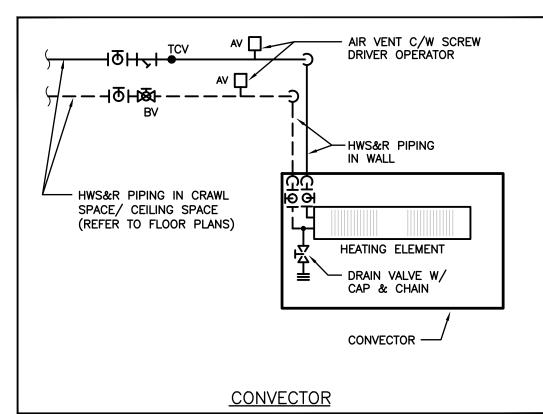

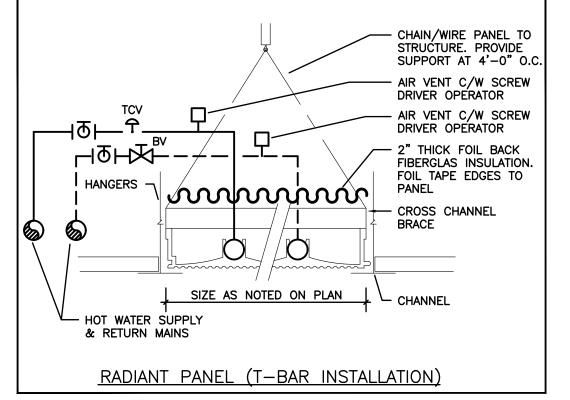

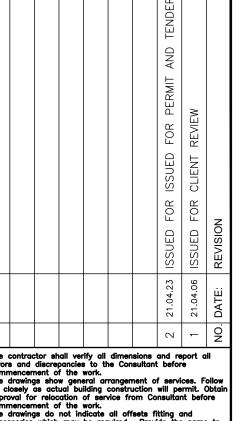

The contractor shall verify all dimensions and report all errors and discrepancies to the Consultant before commencement of the work.

The drawings show general arrangement of services. Follow as closely as actual building construction will permit. Obtain approval for relocation of service from Consultant before commencement of the work.


The drawings do not indicate all offsets fitting and accessories which may be required. Provide the same to meet the required conditions.


Drawings and specifications, etc., prepared and issued by the consultant are the property of the consultant and must be returned at the completion of the project. These documents are not to be duplicated or copied without the consent of the Consultant.

Do not scale this drawing.

Consulting Engineers Consulting Engineers Consulting Engineers Consulting Engineers Consulting Electrical Aquatic

55 Northland Road, Waterloo, ON N2V 1Y8
Phone: 519-725-3555 Fax: 519-725-2515
Website: deiassociates.ca
Project Number: 20152

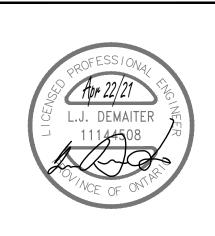

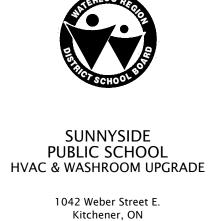

N2A 1B6

DRAWING TITLE:

PROJECT NO: SCALE:
A20002.7 AS NOTED

DRAWN: DRAWING NO: REV.
AH

CHECKED:
AH

DATE:
FEB 2021

### GENERAL REQUIREMENTS FOR BACKFLOW PREVENTER INSTALLATION

# Pursuant to City of Kitchener Bylaw 2013-115 being a bylaw to secure a continued and abundant supply of pure and wholesome water

Note: If the installation of the device(s) is a result of a survey which was previously submitted & approved by the City of Kitchener, please ensure installation is as per the approved survey before booking an inspection.

#### 1. Backflow Protection:

- a) **Sources of cross connections** shall be installed as per Part 7 & CAN/CSA B64-10. If selection cannot be easily identified or is not listed in the CSA Selection Guide, contact Marc Hilker, Kitchener Utilities at 519-741-2600 ext. 4840
- b) The Premise isolation device (installed at the meter) is required to be a Double Check Valve Assembly or a Reduced Pressure Type BFP for high hazard facilities. Residential buildings within the scope of Part 9 of the O.B.C. are not required to comply with the Backflow Regulations 2013-115 unless a hazard exists on the premises.
- c) A qualified tester shall test all testable backflow prevention devices, tag the device and submit the report on a City of Kitchener test report form which are available from the Building Department reception desk, 5<sup>th</sup> floor City Hall.
- d) All plumbing including the backflow preventer shall be installed by a plumber licensed with the City of Kitchener.
- e) **Label all non-potable water piping** either with the words "non-potable water" or a symbol, which is easily recognizable as the same.
- f) If installing **underground automatic lawn-sprinkler systems**, you are required to install an approved DCVA on the supply to the system. If chemical or fertilizer injection systems are employed on the system then an approved RP or PVB must be installed.
- 2. All plumbing is subject to **mandatory onsite inspection**. To arrange inspections please call 519-741-2761. For other permit inquiries contact 519-741-2433.
- 3. **Do not cover**, conceal or otherwise restrict access to any plumbing until the inspection has been completed and passed.
- 4. **Failure to follow these procedures** may result in issuance of an "Order to comply" and/or possible termination of water service.
- 5. **All testable backflow prevention devices** are subject to annual testing and tagging. Legible test reports on a City of Kitchener test report form must be submitted within 14 days of the test. The device shall be tagged with a City of Kitchener test tag, available from the Building Division.
- 6. **All buildings affected** by this initiative are required to have a new audit of the plumbing system completed 3 years after the initial survey.
- 7. PLEASE ENSURE YOU RETAIN A COPY OF ALL TEST REPORTS & SURVEYS.

**Contact Information:** 

Marc Hilker
Cross Connection Control Specialist
519-741-2600 ext: 4840
519-741-2638 FAX
marc.hilker@kitchener.ca



Development Services Department Building Division 200 King St. W., 5th Floor Kitchener, ON N2G 4G7 Ph. 519-741-2312 TTY 1-866-969-9994 building@kitchener.ca www.kitchener.ca

## **ICI PLUMBING INSPECTION AND TESTING**

DRAIN, WASTE, AND VENT INSTALLATIONS ON COMMERCIAL, INDUSTRIAL, INSTITUTIONAL AND MULTI-STOREY RESIDENTIAL PROJECTS

- All plumbing, including site services, must be inspected prior to covering. Non-compliance may result in plumbing required to be uncovered.
- All underground and above ground rough-in installations of drains and vents shall be tested as per 7.3.6 of the Ontario Building Code (water test five feet head above highest point in system or 5lb air test).
- A final test shall be carried out as per 7.3.6.6 of the Ontario Building Code. Cleanouts shall be provided to allow testing.
- All tests to be witnessed by Municipal Building Official.
- To book inspections call 519-741-2761 with the correct permit number. Minimum 24 hour prior notice is required to receive inspection.

Any questions please feel free to contact the Building Division.