


LIGHTING CONTROL SYSTEMS SEQUENCE OF OPERATION				
Space Type	Room Names	Control Sequence / Control Device(s)	Control System	DETAIL REFERENCE
GYMNASIUM	GYMNASIUM 138	Sequence: LZ-2: AUTOMATIC ON/AUTOMATIC OFF THROUGH OCCUPANCY SENSOR/MANUAL OFF THROUGH WALL SWITCH/POD. LZ-1 AND LZ-3: MANUAL ON THROUGH WALL SWITCH/POD /AUTOMATIC OFF THROUGH OCCUPANCY SENSOR/MANUAL OFF THROUGH WALL SWITCH/POD.	DIGITAL OCCUPANCY CONTROL SYSTEM	L 1750
WASHROOMS/CHANGEROOMS	TYPICAL	Sequence: AUTOMATIC ON/AUTOMATIC OFF THROUGH OCCUPANCY SENSOR/MANUAL OFF THROUGH WALL POD/STATION AS INDICATED ON DRAWINGS. OCCUPANCY SENSOR/MANUAL OFF THROUGH WALL SWITCH/POD.	DIGITAL OCCUPANCY CONTROL SYSTEM	L 1750

**NOTES:**  
1. ALL INDICATED TIMES SHALL BE COORDINATED WITH SCHOOL BOARD REPRESENTATIVE. REPORT ANY DISCREPANCIES BETWEEN SEQUENCE AND CONTROL DEVICES TO ENGINEER PRIOR TO PROGRAMMING. COORDINATE PROGRAMMING OF ANY SPACES NOT LISTED WITH BOARD REPRESENTATIVE (EXCLUDING SERVICE ROOMS).  
2. REFER TO SPECIFICATIONS FOR FURTHER INFORMATION REGARDING COMMISSIONING AND 3RD PARTY FUNCTIONAL TESTING OF LIGHTING CONTROL SYSTEMS.

HEATER SCHEDULE		FOR INFORMATION REGARDING EQUAL MANUFACTURERS REFER TO SPECIFICATION	
Item	Manufacturer/Catalog Number		
A	1500 WATT 208 VOLT SINGLE PHASE RECESSED MTD. FAN FORCED HEATER C/W BUILT-IN THERMOSTAT AND 24V RELAY WITH TRANSFORMER AND STANDARD FACTORY FINISH TO SUIT ARCHITECT.		
B	5000 WATT 208 VOLT SINGLE PHASE SUSPENDED UNIT HEATER C/W BUILT-IN THERMOSTAT AND 24V RELAY WITH TRANSFORMER AND STANDARD FACTORY FINISH TO SUIT ARCHITECT.		
C	1000 WATT 208 VOLT SINGLE PHASE BASEBOARD HEATER C/W BUILT-IN THERMOSTAT AND 24V RELAY WITH TRANSFORMER AND STANDARD FACTORY FINISH TO SUIT ARCHITECT.		

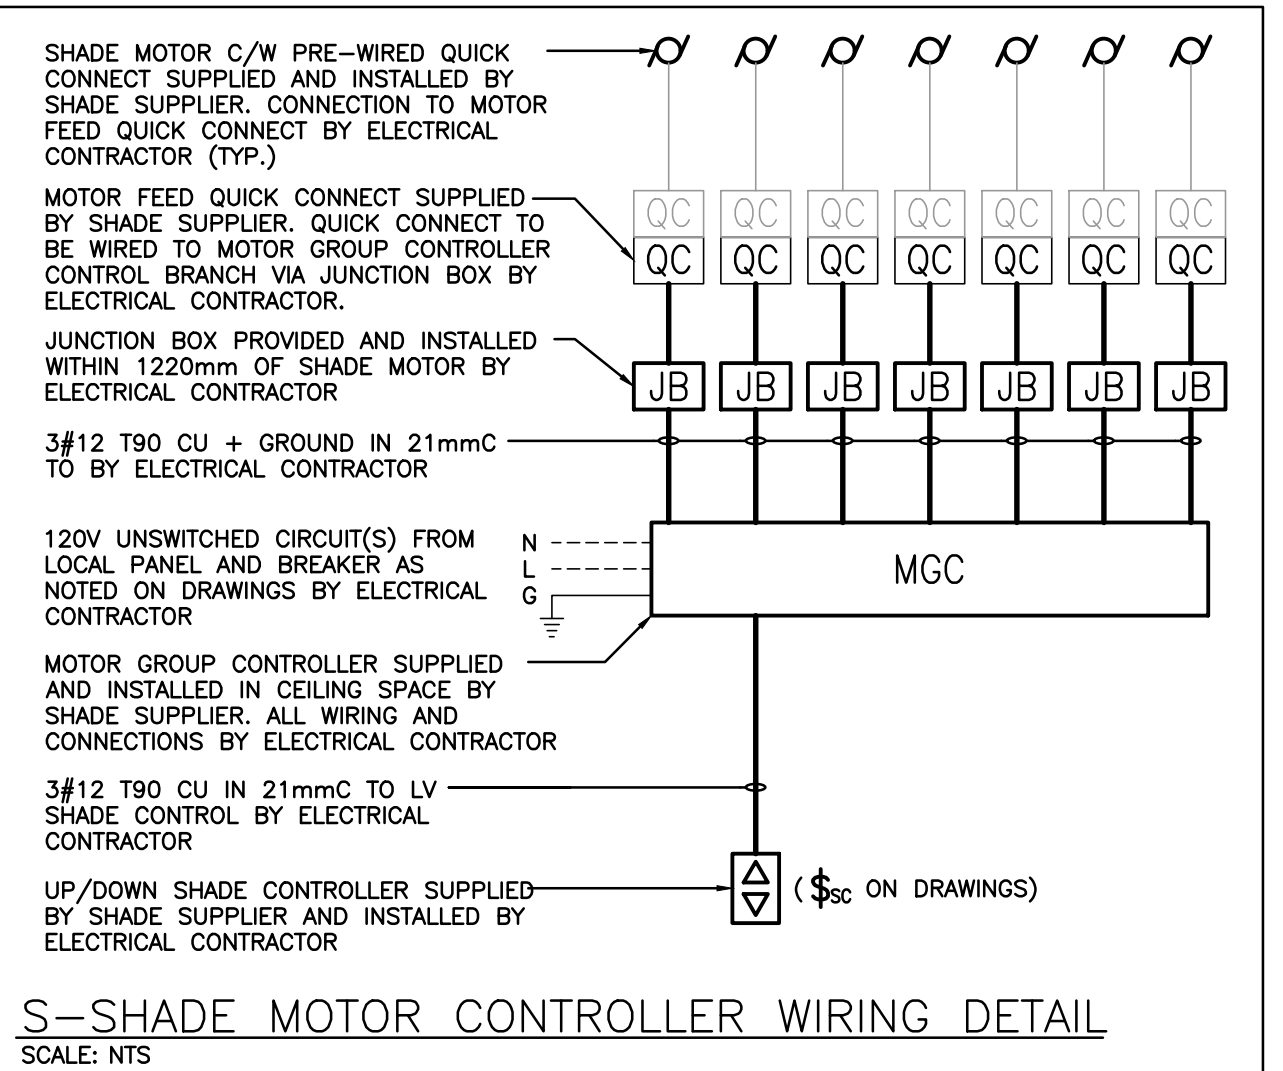

Item	Manufacturer/Catalog Number	Voltage	Lamp	Mounting	Description
P	COOPER CAT. #JULON-SANC-730-U-SMC-4R-BPC DYNA POLE CAT. SRK5-17	120V	160W 22684 LUMENS LED ARRAY 3000K BULB RATING: B1-U0-03	POLE	POLE MOUNTED DECORATIVE FIXTURE C/W CAST ALUMINUM HOUSING, STANDARD TYPE SMO DISTRIBUTION, BUTTON TYPE PHOTO CONTROL, TOOLLESS ENTRY TO HINGED LENS ASSEMBLY AND 17" (4.5m) STRAIGHT 4" SQUARE POLE C/W BASE COVER. ENTIRE ASSEMBLY SHALL HAVE CUSTOM FINISH TO BE CHOSEN BY ARCHITECT
W	COOPER CAT. #IST-SAI-D-730-U-TAFT-XX-BPC	120V	45.2W 5712 LUMENS LED ARRAY 3000K BULB RATING: B1-U0-02	WALL	COMPLETE CUT OFF LED WALLPACK FIXTURE C/W TYPE TAFT DISTRIBUTION, FULL CUT-OFF DARK SKY COMPLIANT, 800MA DRIVER, BUTTON TYPE PHOTO CONTROL AND FINISH TO SUIT ARCHITECT. MOUNT FIXTURE AT 13' AND 12' ABOVE FINISHED GRADE AS NOTED. REFER TO ARCHITECTURAL ELEVATIONS.
W1	COOPER CAT. #IST-SAI-E-730-U-TAFT-XX-BPC	120V	58.2W 7149 LUMENS LED ARRAY 3000K BULB RATING: B1-U0-02	WALL	COMPLETE CUT OFF LED WALLPACK FIXTURE C/W TYPE TAFT DISTRIBUTION, FULL CUT-OFF DARK SKY COMPLIANT, 800MA DRIVER, BUTTON TYPE PHOTO CONTROL AND FINISH TO SUIT ARCHITECT. MOUNT FIXTURE AT 13' ABOVE FINISHED GRADE AS NOTED. REFER TO ARCHITECTURAL ELEVATIONS.
V	LITHONIA CAT. #LDNG-30/25-L06-AR-LSS-MVOLT	120V	28.3W 2504 LUMENS LED ARRAY 3000K	RECESSED	6" (150mm) ROUND LED CANOPY DOWNLIGHT FIXTURE C/W FINISH TO SUIT ARCHITECT. NOTE: FIXTURE MUST BE WET LOCATION LISTED.

**NOTES:**  
1. IF THERE ARE ANY DISCREPANCIES BETWEEN THE FIXTURE PART NUMBER AND DESCRIPTION, IT IS THE RESPONSIBILITY OF THIS CONTRACTOR TO BRING THIS TO THE ELECTRICAL CONSULTANT'S ATTENTION PRIOR TO SHOP DRAWING SUBMITTAL.  
2. REFER TO SPECIFICATION FOR ALTERNATE EQUALS.  
3. WHERE NOTED ABOVE THAT FIXTURES ARE TO HAVE FINISH TO SUIT ARCHITECT THE FINISH WILL BE SELECTED FROM MANUFACTURER'S OPTIONAL COLOUR CHART (i.e. RAL COLOURS OR EQUAL). PROVIDE THIS COLOUR CHART WITH SHOP DRAWING SUBMITTAL.  
4. LED LUMEN VALUES QUOTED FOR FIXTURES ARE TO BE CONSIDERED MINIMUM, AND AS ABSOLUTE OR DELIVERED LUMENS, LUMEN VALUES SHOULD NOT EXCEED MORE THAN 10% OF SPECIFIED OUTPUT.

Item	Manufacturer/Catalog Number	Voltage	Lamp	Mounting	CR	Listings	Description
A	COOPER CAT. #HX-03-LW-UM-03S-03-U-AC-03W-SET-U LITHONIA CAT. #JSS-LB-A33 MOLT 40R B08R H28 W12	120V	LED 4000 LUMENS 4000K 32.2W	SUSPENDED	80	N/A	4" (122mm) SUSPENDED LED STRIP LIGHT C/W 36" CHAIN HANGER, WIDE LENSED OPTICAL DISTRIBUTION, 10% 0-10V DIMMING DRIVER, AND SWITCHABLE LUMENS. LIGHT FIXTURE SETTING IS TO BE SET AT "4000K" AND "MEDIUM" LUMEN
B	COOPER CAT. #14CITS-NAY LITHONIA CAT. #CPX 1X4 ALD7 B0CR SWW7 5ML MOLT	120V	LED 2450 LUMENS 4000K 18.4W	RECESSED	80	N/A	1'x4" (305mmx122mm) LED BACKLIT FLAT PANEL FIXTURE C/W FIELD SELECTABLE LUMENS AND COLOUR TEMPERATURE, WHITE Frosted LENS, 10% 0-10V DIMMING DRIVER, AND WHITE FINISH. LIGHT FIXTURE SETTING IS TO BE SET AT "4000K" AND "MEDIUM" LUMEN
B1	COOPER CAT. #14CITS-NAY LITHONIA CAT. #CPX 1X4 ALD7 B0CR SWW7 5ML MOLT DGA14	120V	LED 3348 LUMENS 4000K 24.1W	RECESSED	80	N/A	SIMILAR TO TYPE 'B' FIXTURE EXCEPT WITH DRY WALL KIT TYPE. LIGHT FIXTURE SETTING IS TO BE SET AT "4000K" AND "MEDIUM" LUMEN
C	COOPER CAT. #14CITS-NAY LITHONIA CAT. #CPX 2X4 ALB B0CR SWW7 5ML MOLT DGA14	120V	LED 4322 LUMENS 4000K 33.6W	RECESSED	80	N/A	2'x4" (610mmx122mm) LED BACKLIT FLAT PANEL FIXTURE C/W FIELD SELECTABLE LUMENS AND COLOUR TEMPERATURE, WHITE Frosted LENS, 10% 0-10V DIMMING DRIVER, AND WHITE FINISH. LIGHT FIXTURE SETTING IS TO BE SET AT "4000K" AND "LOW" LUMEN
F	LITHONIA CAT. #LDK4-AL01-SW11-L04-AR-LSS-MOLT-UZ2	120V	LED 1000 LUMENS 4000K 13W	RECESSED	80	N/A	RECESSED 4" (100mm) DIAMETER LED DOWNLIGHT SELECTABLE LUMENS AND SWITCHABLE COLOR TEMPERATURE, FIXTURE C/W SELF-FLANGED TRIM, SEMI-SPECULAR FINISH, AND UNIVERSAL DIMMING
G	LITHONIA CAT. #B5 1800LUM SEF AFL DND 120V G210 40K B0CR WCK	120V	LED 1800 LUMENS 4000K 100W	SUSPENDED	80	N/A	LED HIGHBAY FIXTURE C/W GENERAL DISTRIBUTION OPTICS, ACRYLIC, FROSTED LENS, WIRE GUARD, AND 0-10V DIMMING DRIVERS. NOTE: FIXTURE TO BE PASTED TO UNISTRUT CHANNELS SPANNING ACROSS THE TOP OF THE BOTTOM CHORD OF THE JOISTS. SUSPEND FIXTURE EVEN WITH THE BOTTOM OF THE ENTIRE FIXTURE ASSEMBLY IS TO HAVE A WHITE FINISH.
EMERG. LIGHTS	STANPRO CAT. #N1-06-12V3MLWH (SINGLE REMOTE) STANPRO CAT. #N2-06-12V3MLWH (DOUBLE REMOTE)	12V	LED SURFACE	N/A	N/A	N/A	HEAD LED REMOTE MINI PAR18 FIXTURE C/W COMPACT DESIGN, THERMOPLASTIC CONSTRUCTION, WHITE COLOUR, FULL AIMING ADJUSTMENT, AND 360° ROTATION.
COMBO UNIT	STANPRO CAT. #PRXAL-SERIES EM-1 #PRXAL10361-2N3LU-AT	12V/120V	LED SURFACE	N/A	N/A	N/A	LED EXTRUDED ALUMINUM PICTORAM FIXTURE C/W GREEN FACE AND WHITE LEGEND, UNIVERSAL MOUNTING TO SUIT WALL, END OR CEILING, MAXIMUM 2.5" (63mm) THICKNESS, 12V INTERNAL SEALED RECHARGEABLE BATTERY PROVIDING MINIMUM EMERGENCY WATTAGE AS NOTED BY THE CATALOGUE NUMBER C/W MICRO SIZE PAR18 12V 3W (MINIMUM) LED HEADS AND AUTO-TEST FEATURE.
EMERG. BATT.	STANPRO CAT. EM-2 #SLA12072-2N3LU/AT	12V/120V	LED SURFACE	N/A	N/A	N/A	LONG LIFE, SEALED RE-CHARGEABLE BATTERY PROVIDING MINIMUM EMERGENCY WATTAGE AS NOTED BY THE CATALOGUE NUMBER C/W MICRO SIZE PAR18 12V 3W (MINIMUM) LED HEADS AND AUTO-TEST FEATURE.
EXIT LIGHTS	STANPRO CAT. #RXAL-0-0-B-AT	12V/120V	2.5 WATT (MAX) 2 WATT (MIN) 100W	SURFACE	N/A	N/A	LED EXTRUDED ALUMINUM PICTORAM FIXTURE C/W GREEN FACE AND WHITE LEGEND, UNIVERSAL MOUNTING TO SUIT WALL, END OR CEILING AND MAXIMUM 63mm (2.5") THICKNESS. SELF-POWERED AND AUTOMATIC SELF-TEST DIAGNOSTIC

**NOTES:**  
1. LED LUMEN VALUES QUOTED FOR FIXTURES ARE TO BE CONSIDERED MINIMUM, AND AS ABSOLUTE OR DELIVERED LUMENS, LUMEN VALUES SHOULD NOT EXCEED MORE THAN 10% OF SPECIFIED OUTPUT.  
2. REFER TO SPECIFICATION FOR ALTERNATE EQUALS.  
3. EQUAL MANUFACTURER/SUPPLIERS MUST CONFIRM THE PROPOSED FIXTURE BY EMAIL WITH CONSULTANT'S OFFICE A MINIMUM OF 10 DAYS PRIOR TO TENDER CLOSE.

#### EQUIPMENT WIRING SCHEDULE

Description	Electrical Data	Starter	Ctrl Device	Isolating Device	Remote Items	Other	Interlock
Mechanical Item	Provided By	Size hp/kW/amps	Phase	Wiring	Wiring	Wiring	Wiring
HVAC-1 NEW ROOF TOP UNIT	M	575 47 A 3 60	3 60	Wiring	Wiring	Wiring	Wiring
EF-1 ROOF EXHAUST FAN	M	120 1/4 HP 1	1	Wiring	Wiring	Wiring	Wiring
EF-2 RANGEHOOD EXHAUST FAN	M	120 FHP 1	1	Wiring	Wiring	Wiring	Wiring
L-1 BARRIER FREE LAV (ELECTRONIC FAUCET)	M	120 FHP 1	1	Wiring	Wiring	Wiring	Wiring
L-2 LAV (ELECTRONIC FAUCET)	M	120 FHP 1	1	Wiring	Wiring	Wiring	Wiring
TP ELECTRIC TRAP PRIMER	M	120 FHP 1	1	Wiring	Wiring	Wiring	Wiring
EF-3 CEILING EXHAUST FAN	M	120 FHP 1	1	Wiring	Wiring	Wiring	Wiring

**Notes:**



No.	Revision	Date
6	ISSUED FOR CONSTRUCTION	2024.09.17
5	ISSUED FOR PERMIT RESPONSES	2024.06.24
4	ISSUED FOR TENDER	2024.05.01
3	ISSUED FOR PERMIT	2024.04.19
2	ISSUED FOR SPA SUBMISSION	2024.02.27
1	ISSUED FOR SPA REVIEW SET	2024.02.06





- |                        |                            |
|------------------------|----------------------------|
| Scale: AS NOTED        | Date: MAY 2024             |
| Drawn by: SB           | Checked by: RV             |
| Job No.<br><b>2314</b> | Drawing No.<br><b>E201</b> |

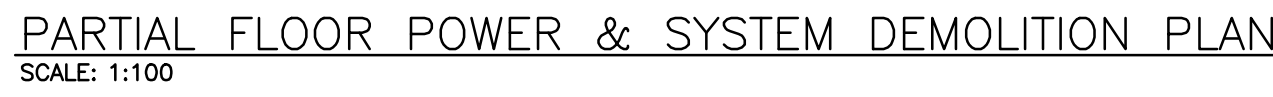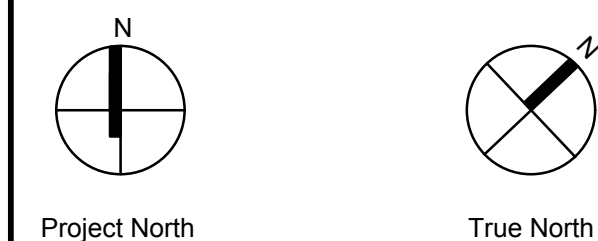

[illegible]

No.	Revisions	Date
6	ISSUED FOR CONSTRUCTION	2024.09.17
5	ISSUED FOR PERMIT RESPONSES	2024.06.24
4	ISSUED FOR TENDER	2024.05.07
3	ISSUED FOR PERMIT	2024.04.18
2	ISSUED FOR SPA SUBMISSION	2024.02.27
1	ISSUED FOR SPA REVIEW SET	2024.02.06
No	Revision	Date



Scale: AS NOTED	Date: MAY 2024
-----------------	----------------

Drawn by: SB	Checked by: RV
Job No.	Drawing No.

2314	E202
------	------





2314 | E203



# EXISTING PANEL 'DP-X' SCHEDULE

VOLTAGE: 120/208 VOLTS	
PHASE: 3P, 4W	
MAINS: 100A	
NEUTRAL BUS: FULL	
MOUNTING: SURFACE	
NOTES: POW-A-LINE 3A	
SP	SPARE 100A 1 1
ER	WEST HALL ALCOVE PANEL 100A 2 2
ER	SPACE 2P 3 3
ER	SPACE 2P 4 4
ER	SPACE 2P 5 5
ER	SPACE 2P 6 6
ER	SPACE 2P 7 7
ER	SPACE 2P 8 8
ER	SPACE 2P 9 9
ER	SPACE 2P 10 10
ER	SPACE 2P 11 11
ER	SPACE 2P 12 12
ER	SPACE 2P 13 13
ER	SPACE 2P 14 14
ER	SPACE 2P 15 15
ER	SPACE 2P 16 16
ER	SPACE 2P 17 17
ER	SPACE 2P 18 18
ER	SPACE 2P 19 19
ER	SPACE 2P 20 20
ER	SPACE 2P 21 21
ER	SPACE 2P 22 22
ER	SPACE 2P 23 23
ER	SPACE 2P 24 24
ER	SPACE 2P 25 25
ER	SPACE 2P 26 26
ER	SPACE 2P 27 27
ER	SPACE 2P 28 28
ER	SPACE 2P 29 29

# PROPOSED PANEL 'DP-X' SCHEDULE

SP	SPARE 100A 1 1	2 100A NORTH HALL PANEL
ER	WEST HALL ALCOVE PANEL 100A 2 2	3 2P
ER	SPACE 2P 3 3	4 2P
ER	SPACE 2P 4 4	5 100A EAST CLASS PANEL LP-1
ER	SPACE 2P 5 5	6 2P
ER	SPACE 2P 6 6	7 2P
ER	SPACE 2P 7 7	8 2P
ER	SPACE 2P 8 8	9 2P
ER	SPACE 2P 9 9	10 2P
ER	SPACE 2P 10 10	11 2P
ER	SPACE 2P 11 11	12 2P
ER	SPACE 2P 12 12	13 2P
ER	SPACE 2P 13 13	14 2P
ER	SPACE 2P 14 14	15 2P
ER	SPACE 2P 15 15	16 2P
ER	SPACE 2P 16 16	17 2P
ER	SPACE 2P 17 17	18 2P
ER	SPACE 2P 18 18	19 2P
ER	SPACE 2P 19 19	20 2P
ER	SPACE 2P 20 20	21 2P
ER	SPACE 2P 21 21	22 2P
ER	SPACE 2P 22 22	23 2P
ER	SPACE 2P 23 23	24 2P
ER	SPACE 2P 24 24	25 2P
ER	SPACE 2P 25 25	26 2P
ER	SPACE 2P 26 26	27 2P
ER	SPACE 2P 27 27	28 2P
ER	SPACE 2P 28 28	29 2P

DESIGNATION

'ER' INDICATES EXISTING SERVICE AND BREAKER THAT SHOULD REMAIN UNTOUCHED

'SP' INDICATES EXISTING BREAKER THAT MAY BECOME SPARE DUE TO DEMOLITION. (CONFIRM ON SITE)


'NB' INDICATES NEW BREAKER AND WIRING TO SERVICE INDICATED. PROVIDE MOUNTING HARDWARE AS REQUIRED.

NOTES: THIS CONTRACTOR IS TO INVESTIGATE BREAKERS AND REVISE PANEL SCHEDULES TO SUIT RENOVATION, NOTING ANY BREAKERS THAT BECOME SPARE DUE TO DEMOLITION. THIS CONTRACTOR IS ALSO TO NOTIFY THE CONSULTANT OF ANY BREAKERS THAT ARE INDICATED TO BE DEMOLISHED OR REUSED, BUT WHICH ARE IN USE BY OTHER DEVICES OR SERVICES.

# PANEL 'G'

VOLTAGE: 120/208 VOLTS	
PHASE: 3P, 4W	
MAINS: 100A	
NEUTRAL BUS: FULL	
MOUNTING: SURFACE	
NOTES: SQUARE D NO430L1C	
DC Panel #1 A	EXIT LTG. 15A 1 1
W/R, STORAGE RMS & C.R. LTG. 20A 2 2	2 20A GYM T-SLOT REC.
DC Panel #2 A GYM LTG. 20A 3 3	4 20A GYM T-SLOT REC.
EXTERIOR LIGHT 15A 7 7	8 15A GYM FANS WEST
STORAGE ROOMS REC. 15A 11 11	12 20A BASKETBALL NET MOTOR WEST
C.R. 138 REC. & PLUMBING EQ. 15A 13 13	14 20A BASKETBALL NET MOTOR EAST
STORAGE ROOMS REC. 15A 15 15	16 20A MAINTENANCE T-SLOT REC.
C.R. 137 REC. & PLUMBING EQ. 15A 17 17	18 20A SCOURBOARD
W/R, 135 REC. & PLUMBING EQ. 15A 19 19	20 15A PROJECTION SCREEN
W/R, 134 REC. & PLUMBING EQ. 15A 21 21	22 15A VESTIBULE V-4 FAN HEATER
CORRIDOR REC. 15A 23 23	24 2P
DOOR OPERATOR 15A 25 25	26 2P
FIRE SHUTTER 15A 27 27	28 2P
EF-1 15A 29 29	30 2P
EF-2 15A 31 31	32 2P
EF-3 15A 33 33	34 2P
TRAP PRIMER 15A 35 35	36 2P
SPARE 15A 37 37	38 2P
SPARE 15A 39 39	40 2P
SPACE 41 41	42 2P
SPACE 43 43	44 2P
SPACE 45 45	46 2P
SPACE 639 639	640 2P
SPACE 641 641	642



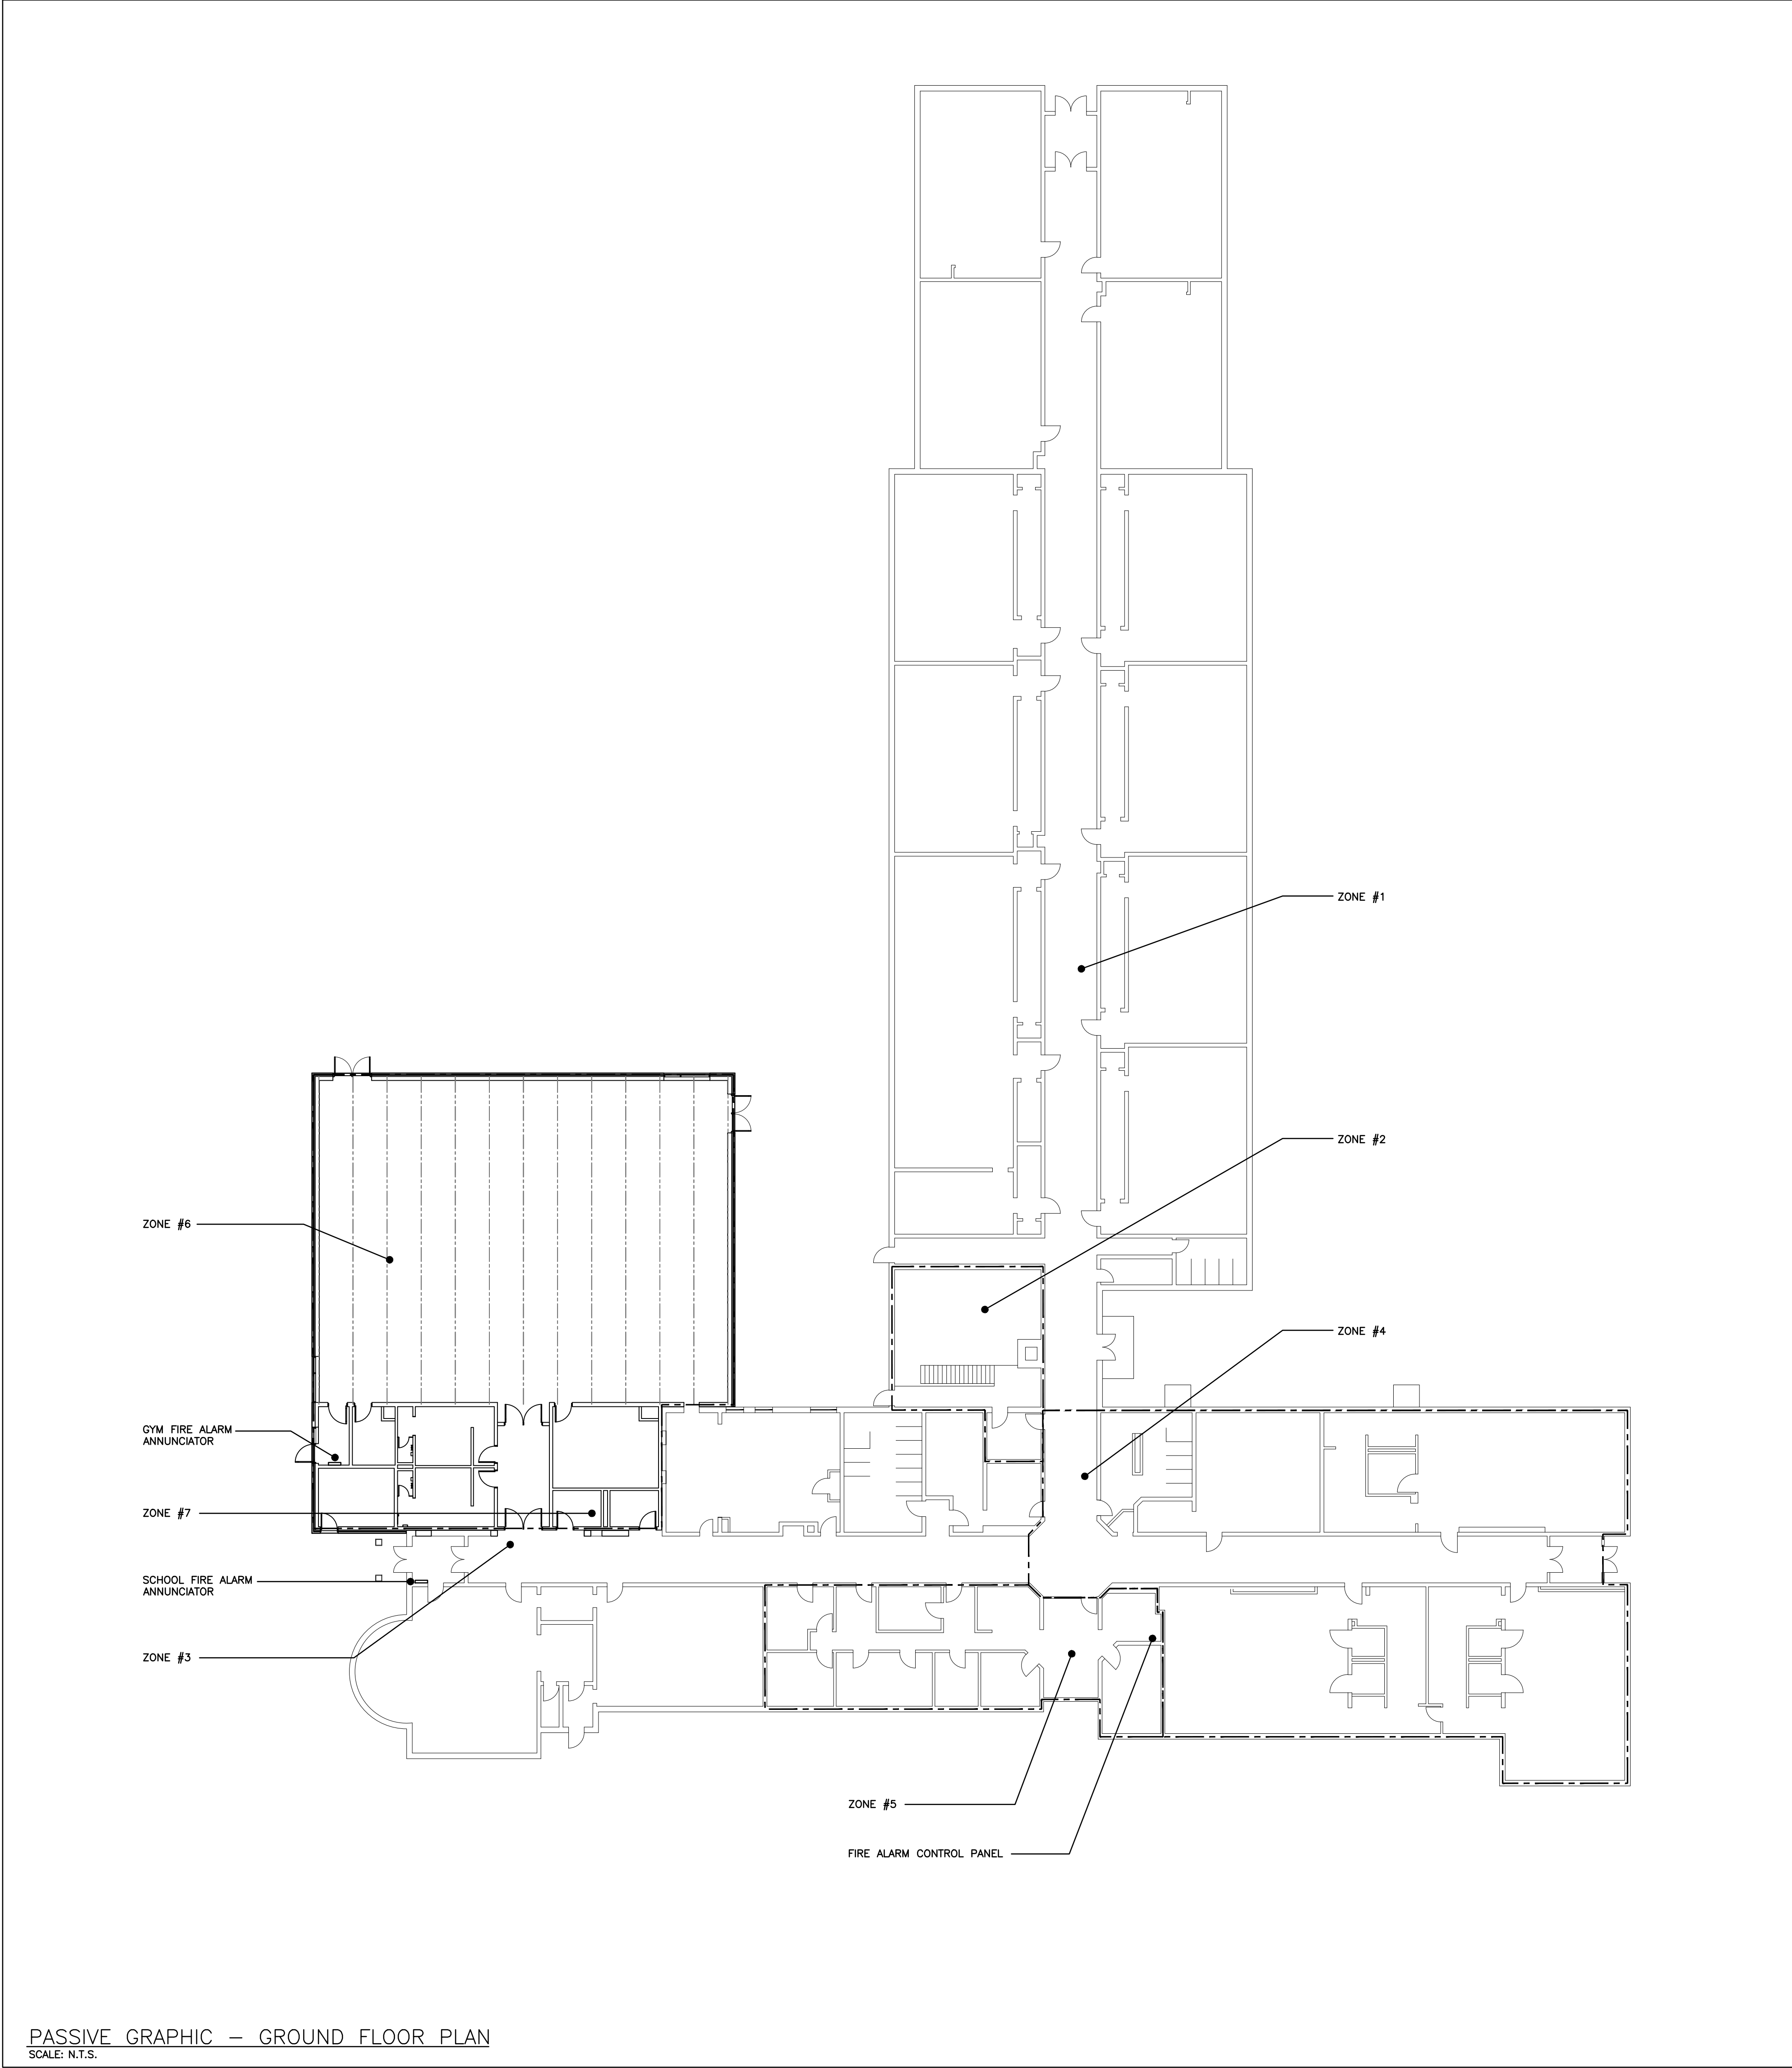


PASSIVE GRAPHIC - GROUND FLOOR PLAN  
SCALE: N.T.S.

FIRE ALARM ANNUNCIATOR SCHEDULE


Zone	Description	Alarm	Supervisory
1	NORTH WING	•	
2	BOILER ROOM	•	
3	WEST WING	•	
4	EAST WING	•	
5	OFFICE	•	
6	GYMNASIUM	•	
7	FIRE SMOKE DAMPER	•	
8	PORTABLES	•	
9	SPARE		
10	SPARE		
11	SPARE		
12	SPARE		

PARTIAL FIRE ALARM RISER DIAGRAM - DEMOLITION  
SCALE: N.T.S.

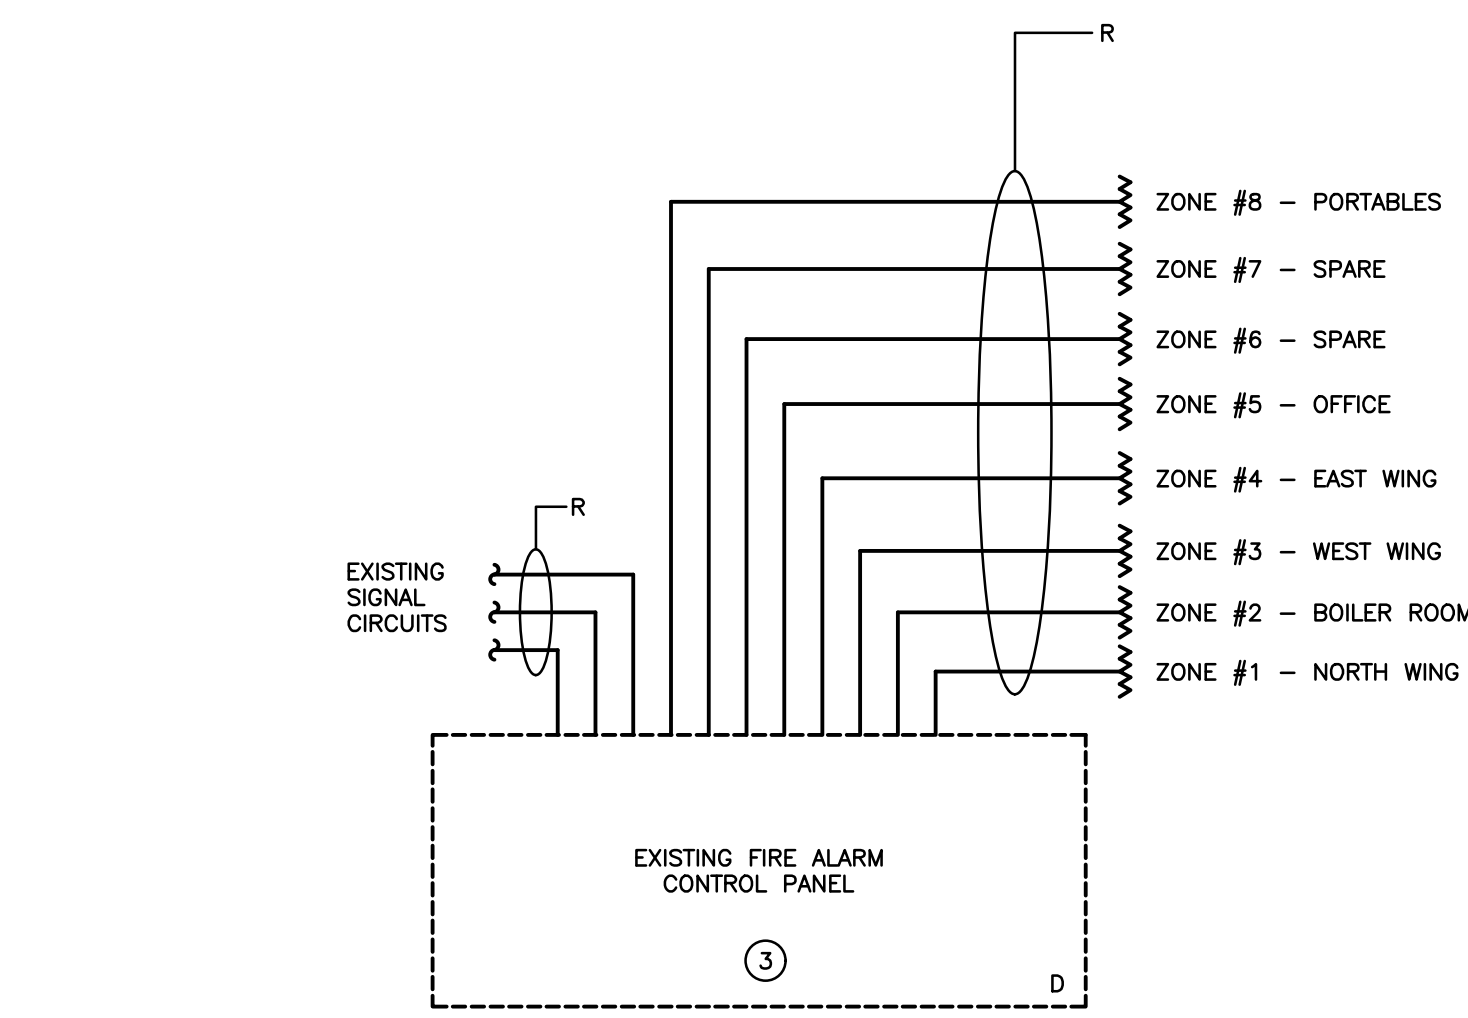


GROUND FLOOR

PARTIAL FIRE ALARM RISER DIAGRAM - RENOVATION  
SCALE: N.T.S.

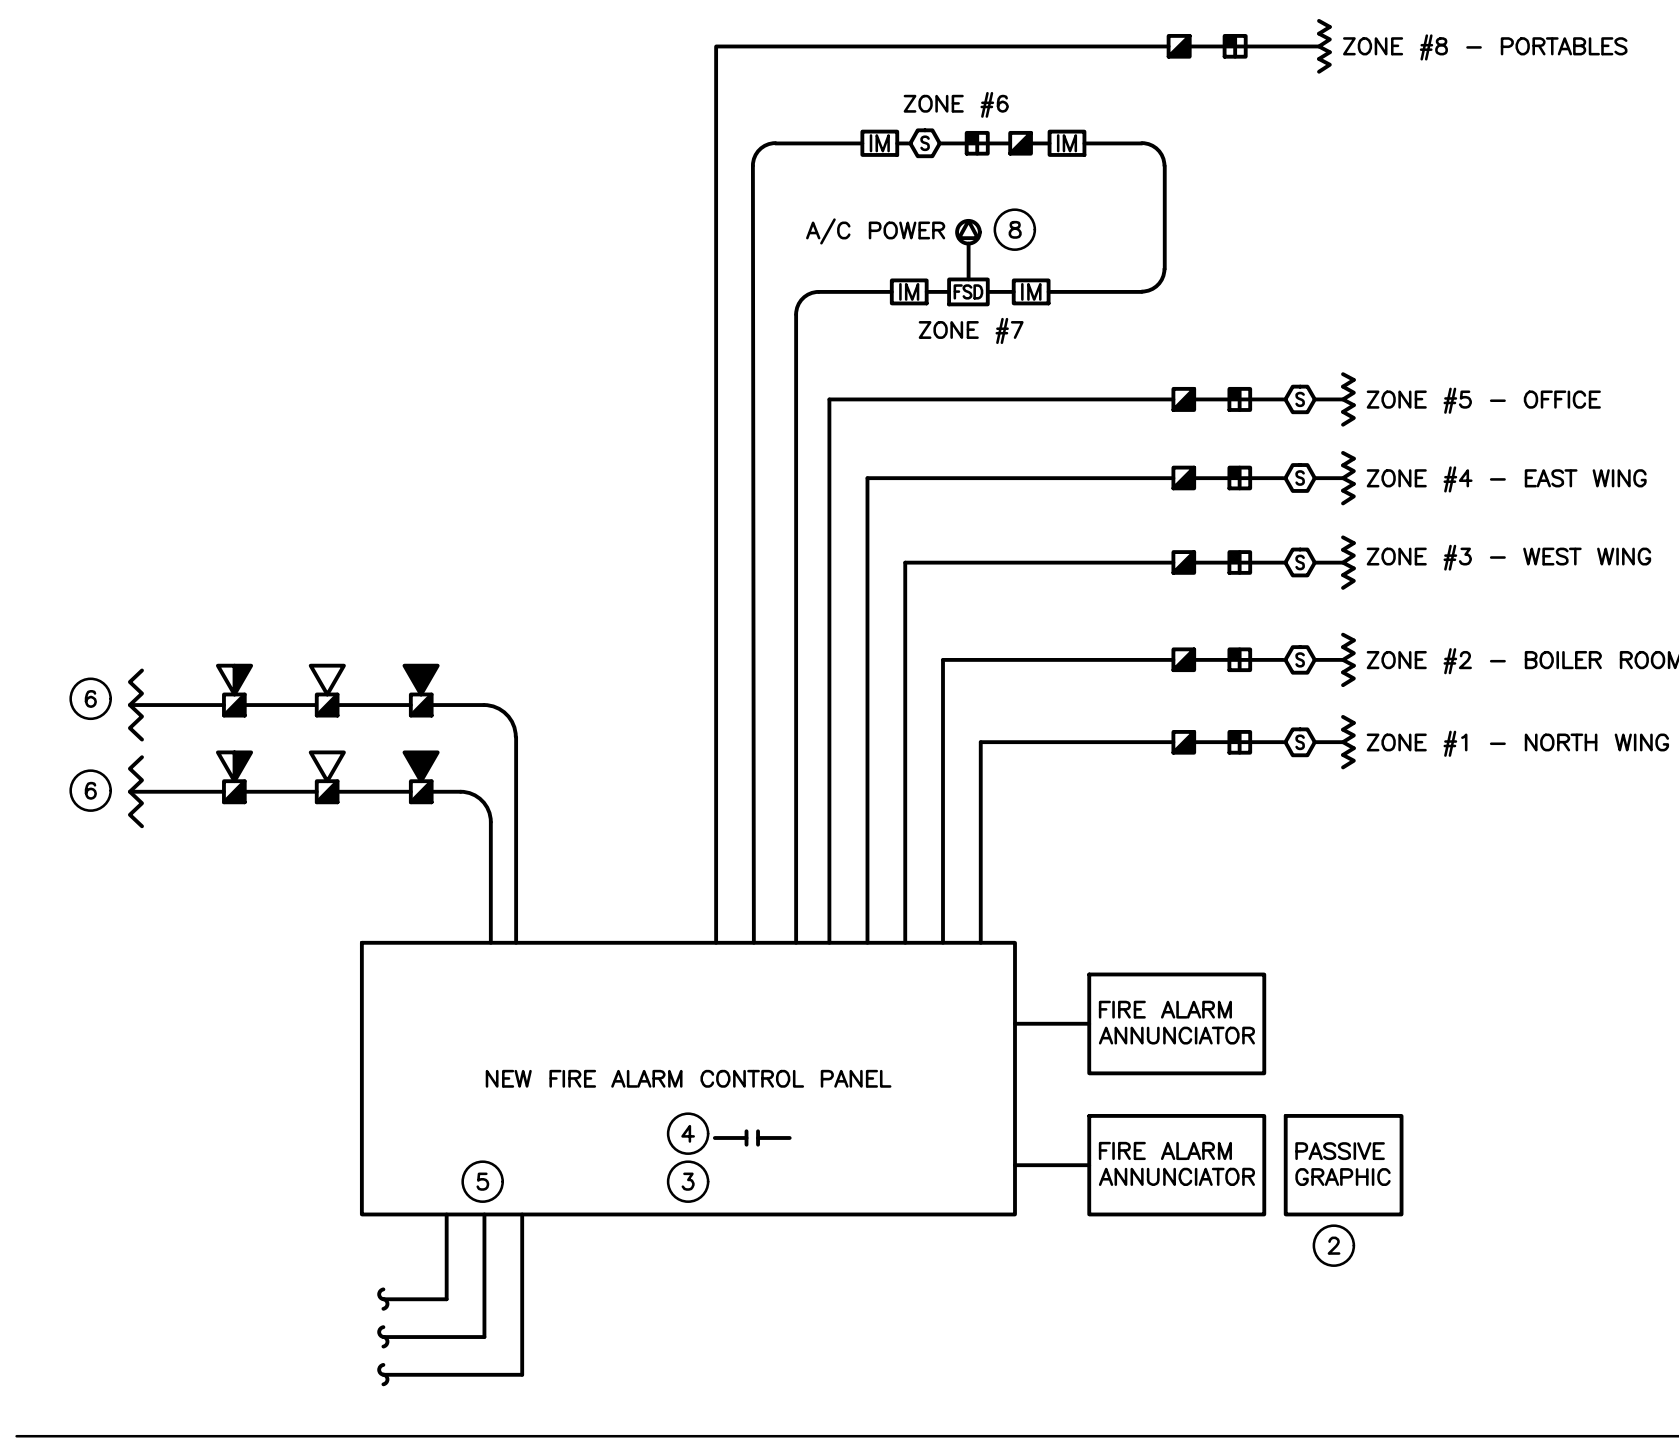

GROUND FLOOR

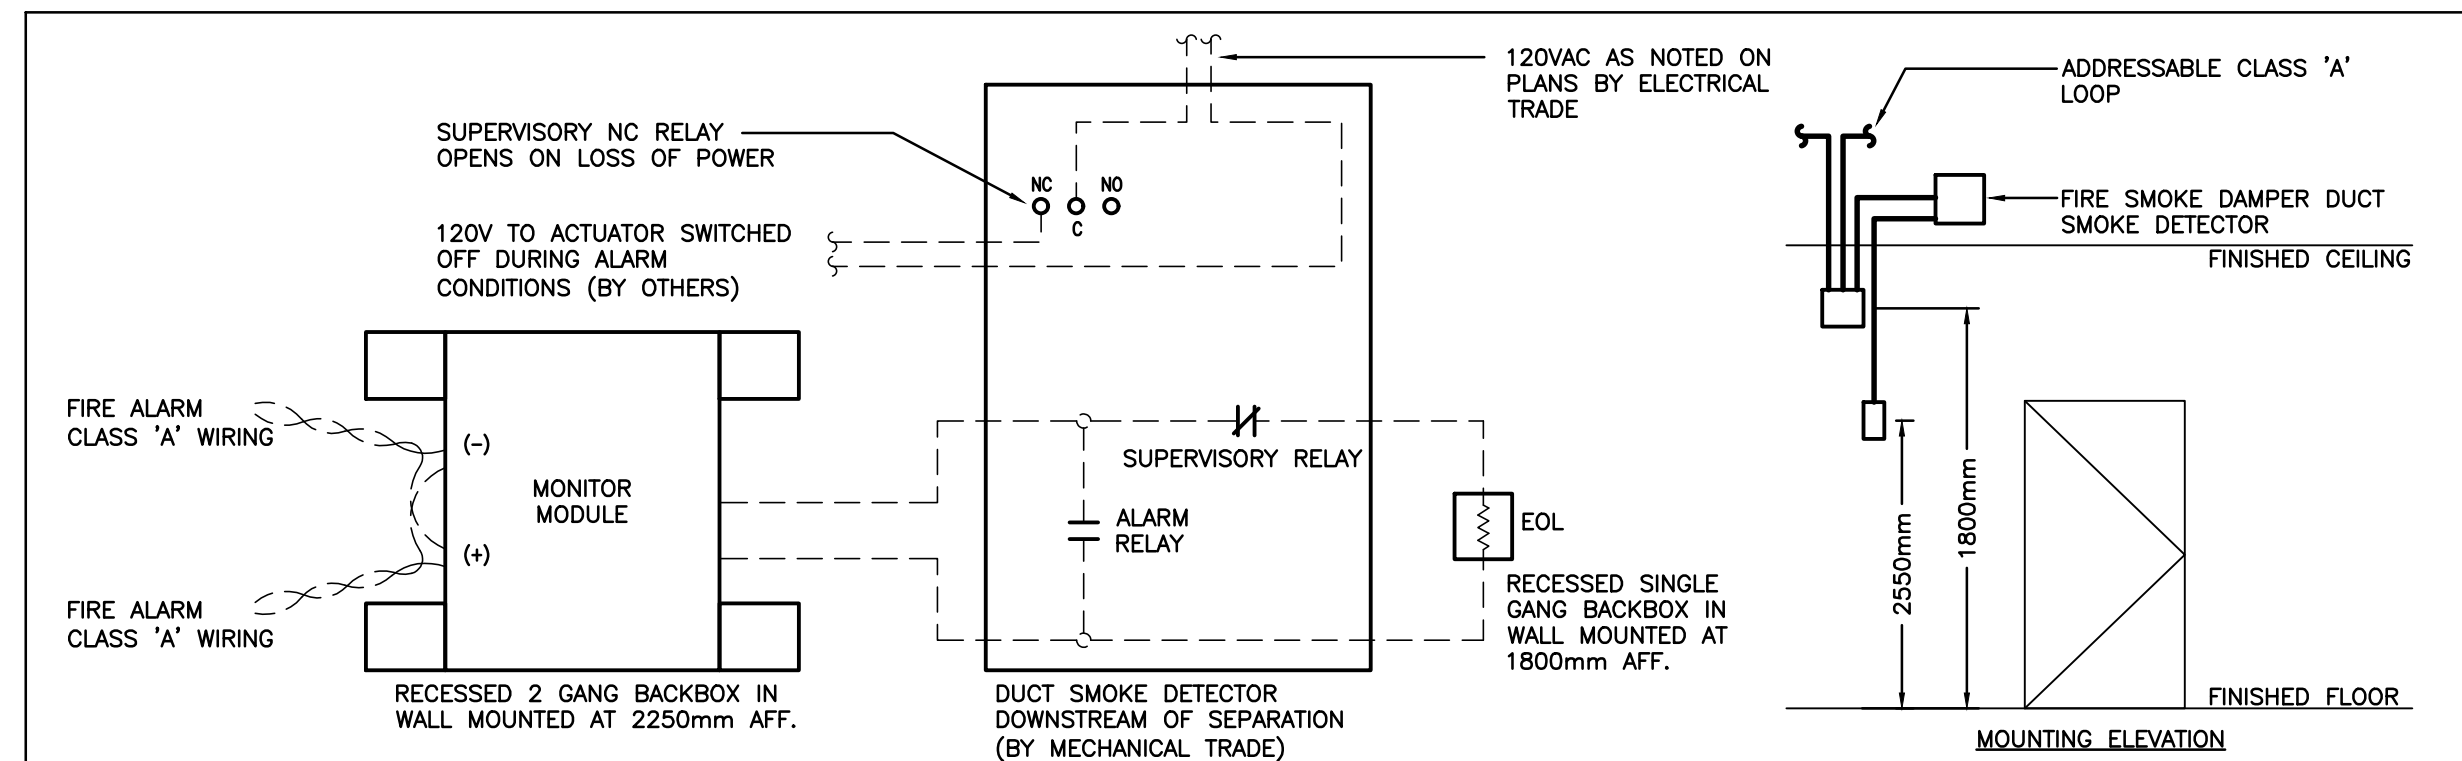

NOTES:

- MONITOR MODULE AND END OF LINE RESISTOR DEVICE MOUNTING HEIGHTS SHALL BE PER CAN/ULC S524 (LATEST EDITION).
- MOUNT DEVICES WITHIN ACCESSIBLE LOCATIONS IN SERVICE ROOMS, WHERE POSSIBLE, IN THE VICINITY OF RESPECTIVE FIRE SMOKE DAMPER DEVICES IN FINISHED SPACES TO BE C/W FLUSH MOUNT DEVICE BOXES AND COVERS. DEVICE COVERS TO BE LABELLED PER CAN/ULC S524 (LATEST EDITION).

A-FIRE/SMOKE DAMPER INSTALLATION DETAIL  
SCALE: N.T.S.

SEQUENCE OF OPERATIONS

NORMAL CONDITION:  
ALARM CONTACT OPEN, AUXILIARY CONTACT CLOSED, AC POWER IS PROVIDED TO DAMPER ACTUATOR, DAMPER IS OPEN.

ALARM CONDITION:  
ALARM CONTACT CLOSURES, BUILDING FIRE ALARM IS ACTIVATED, AUXILIARY CONTACT OPENS, AC POWER IS REMOVED FROM DAMPER ACTUATOR.

SUPERVISION:  
LOSS OF AC POWER, COVER LEFT OFF, WIRING ISSUE WILL CAUSE TROUBLE CONDITION. SUPERVISORY CONTACT OPENS, MAIN FIRE ALARM CONTROL PANEL WILL INDICATE TROUBLE. ADDRESSABLE MODULE WILL INDICATE DAMPER LOCATION, DAMPER POSITION IS NOT MONITORED BY FIRE ALARM CONTROL PANEL.

FIRE ALARM SPECIFIC NOTES

- REFER TO FLOOR PLANS FOR EXACT LOCATION AND QUANTITY OF NEW DEVICES.
- PROVIDE NEW FIRE ALARM PASSIVE GRAPHIC TO SUIT ADDITIONAL FIRE ALARM ZONES.
- EXISTING FIRE ALARM CONTROL PANEL IS TO BE REPLACED WITH NEW, DISCONNECT EXISTING SIGNAL AND INITIATING CIRCUITS AND RECONNECT TO NEW PANEL.
- PROVIDE TWO SETS OF RELAYS FOR SECURITY SYSTEM FOR ALARM AND TROUBLE SIGNALS.
- RECONNECT ALL OTHER ACCESSORIES AS REQUIRED (SECURITY, ULC MONITORING, ETC.)
- EXTEND EXISTING SIGNAL WIRING TO SUIT NEW DEVICES.
- PROVIDE NEW FIRE ALARM ZONES AS INDICATED.
- INDICATES 120V POWER AND FIRE ALARM CONNECTIONS TO SMOKE/FIRE DAMPER WITH INTEGRAL SMOKE DETECTOR. REFER TO FIRE ALARM SPECIFICATIONS, COORDINATE EXACT LOCATION/CONNECTION REQUIREMENTS WITH MECHANICAL CONTRACTOR. SMOKE/FIRE DAMPER AND ASSOCIATED INTEGRAL SMOKE DETECTOR TO BE PROVIDED AND INSTALLED BY MECHANICAL CONTRACTOR. PROVIDE MONITORING MODULE(S) PER SMOKE/FIRE DAMPER TO 120V POWER SUPPLY CONNECTION TO THE DAMPER ACTUATOR AND INTEGRAL SMOKE DETECTOR ALARM AS SIGNAL. A TROUBLE CONDITION SHALL BE ACTIVATED DUE TO THE LOSS OF AC POWER AT THE MAIN CONTROL PANEL, CONSISTING OF AUDIBLE AND VISUAL TROUBLE SIGNAL UNTIL ACKNOWLEDGED BY OPERATOR. REFER TO DETAIL A/E302.

The contractor shall verify all dimensions and report all errors and discrepancies to the Consultant before commencement of the work. The drawings show general arrangement of services. Follow as closely as actual building construction will permit. Obtain approval for relocation of service from Consultant before commencement of the work. The drawings do not indicate all offsets fitting and accessories which may be required. Provide the same to meet the required conditions. Drawings and specifications, etc., prepared and issued by the consultant are the property of the consultant and must be returned at the completion of the project. These documents are not to be duplicated or copied without the consent of the Consultant. Do not scale this drawing. © 2024 DEI Consulting Engineers Inc.