



CONCEPT SKETCH

ISSUED FOR RECORD SET UP TO CO#027
VOL 1 ARCHITECTURAL SET

CLIENT:
**NEAR NORTH
DISTRICT SCHOOL BOARD**
963 AIRPORT ROAD
NORTH BAY, ON.
P1B 8H1

ARCHITECT:
+VG ARCHITECTS
50 DALHOUSIE STREET,
BRANTFORD, ONTARIO, CANADA
N3T 2H8
T: 519.754.1652
www.ventingroup.com

CONSULTANTS:
STRUCTURAL:
STRUCTURES +VG
50 DALHOUSIE STREET,
BRANTFORD, ONTARIO, CANADA
N3T 2H8

MECHANICAL:
DEI CONSULTING ENGINEERS
55 NORTHLAND ROAD
WATERLOO, ONTARIO
N2V 1Y8

ELECTRICAL:
DEI CONSULTING ENGINEERS
55 NORTHLAND ROAD
WATERLOO, ONTARIO
N2V 1Y8

LANDSCAPE:
GSP GROUP INC.
72 VICTORIA STREET SOUTH, SUITE 201
KITCHENER, ONTARIO
N2G 4Y9

CIVIL:
TRITON ENGINEERING SERVICES LTD.
35 MCFARLANE ST
PARRY SOUND, ON.
P2A 2N3

PROJECT NAME:
PROJECT LOCATION:
PROJECT NUMBER:

CLIENT:



**NEW PARRY SOUND K-12 SCHOOL &
CHILD CARE FACILITY**

111 ISABELLA STREET,
PARRY SOUND, ON.
P2A 1N2


NNDSB TENDER # 2026-015+VG PROJECT #22111-3

Reproduction of drawings and related documents in whole or in part is
prohibited without written permission of the Ventin Group.
All dimensions and measurements must be
checked and relied by the Selected Contractor

+VG ARCHITECTS
THE VENTIN GROUP LTD
BRANTFORD
TORONTO
OTTAWA
AFFILIATED OFFICES:


A0.1

2026- ISSUED RECORD SET UP TO CO#027

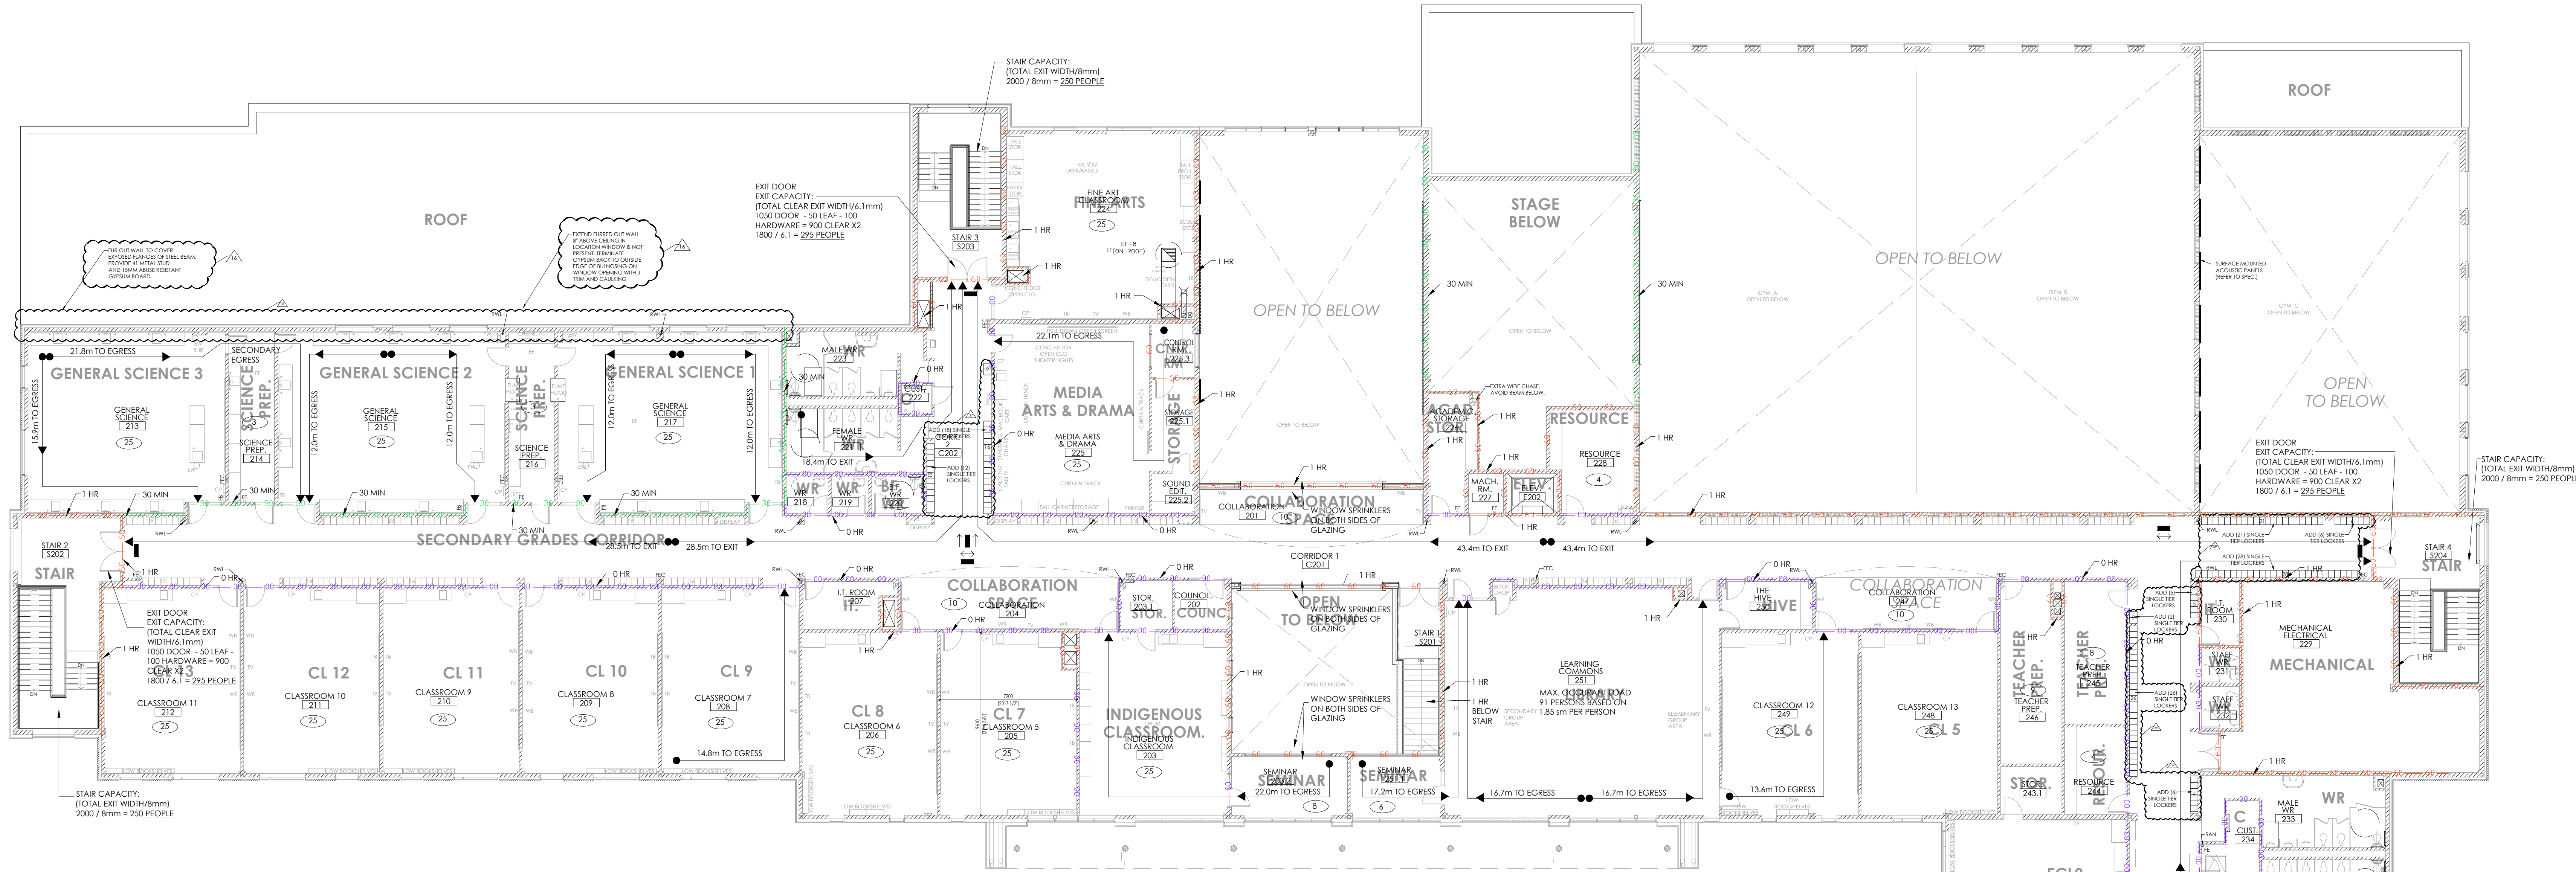

1 SECOND FLOOR - LIFE SAFETY PLAN
A0.4

LEVEL 2 PLAN

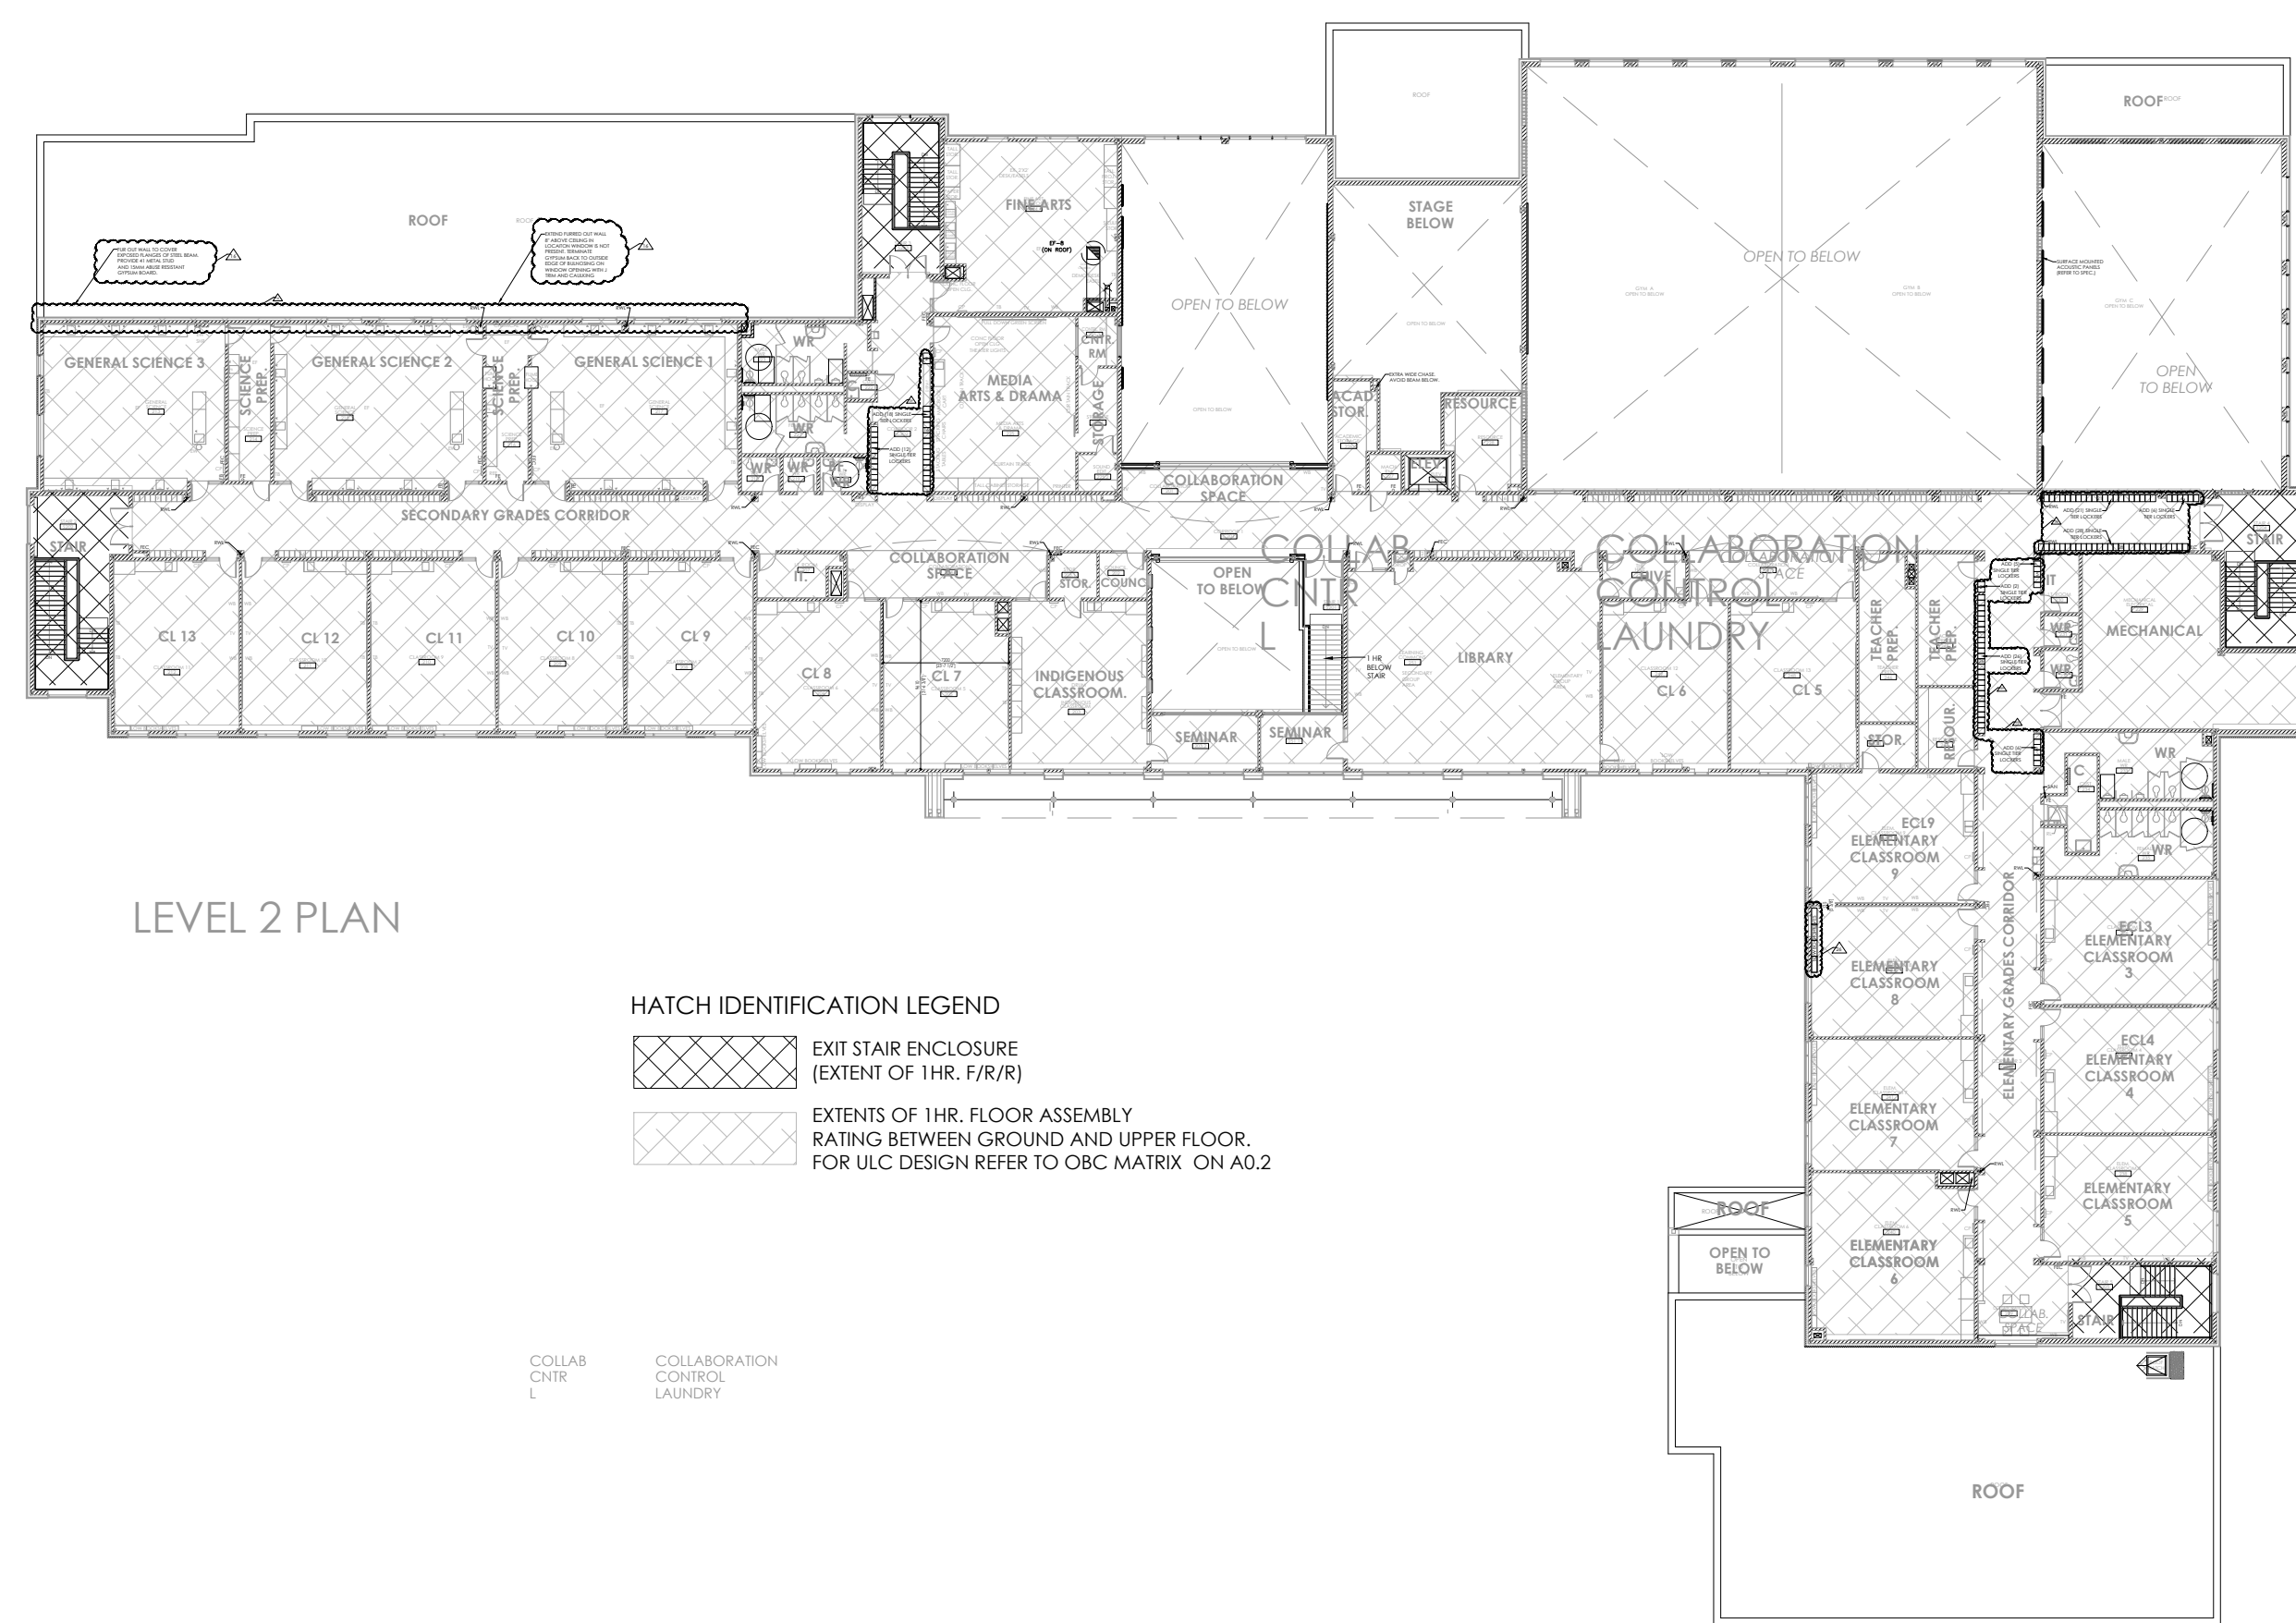

2 FLOOR PLATE RATING BETWEEN LEVEL 1 & LEVEL 2
A0.4

SYMBOLS & ABBREV.'S LEGEND IDENTIFICATION MARKER LEGEND

- 0 HR. FIRE SEPARATION RATING
- 1/2 HR. FIRE SEPARATION RATING
- 1 HR. FIRE SEPARATION RATING
- STC RATED CONCRETE BLOCK PARTITIONS TO BE 75% SOLID CONCRETE BLOCK TO OBTAIN A MIN. STC 50 RATING. REFER TO WALL TYPE DRAWING (A0 SERIES DRAWINGS) FOR ALL OTHER STC RATED PARTITIONS. SOUND SEAL ALL WALL PERIMETERS AND OPENINGS WITH ROULSOUND BATS AND ACOUSTICAL CAULKING (TYP.)
- WALL TYPE 4 (TYP.):
 - STC RATING (MIN. REQUIRED): 140mm CONCRETE BLOCK = STC 44
 - 140mm 75% SOLID CONCRETE BLOCK = STC 48
 - 190mm CONCRETE BLOCK = STC 44
 - 190mm 75% SOLID CONCRETE BLOCK = STC 47
 - 240mm CONCRETE BLOCK = STC 47
 - 240mm 75% SOLID CONCRETE BLOCK = STC 50
 - 290mm CONCRETE BLOCK = STC 52
 - REFER TO FLOOR PLANS FOR LOCATIONS OF 75% SOLID BLOCK AND FILLED SOLID BLOCK
 - WHERE STC RATING IS INDICATED IT SHALL APPLY TO ALL WALLS OF THAT SPACE AND SPACES OF THE SAME USE. TRAVEL DISTANCE IN METERS

- EXIT LIGHT W/ DIRECTIONAL ARROW
- EXIT DOORS
- POWER DOOR OPERATOR
- PUSH BUTTON FOR POWER DOOR OPERATOR
- FIRE EXTINGUISHER CABINET (RECESSED MOUNTED)
- SURFACE MOUNTED FIRE EXTINGUISHER
- HOLD OPEN DEVICE
- CONCERNING EXTENT OF FIRE STOPPING:
 - ALL PARTITIONS FORMING PART OF A FIRE SEPARATION SHALL BE COMPLETELY FIRE STOPPED & SMOKE SEALED. THIS INCLUDES ALL CORRIDOR WALLS AS WELL AS THE RATED FIRE SEPARATIONS NOTED ABOVE INCLUDING 0 HR. FIRE SEPARATION RATINGS. ALL OTHER FULL HEIGHT PARTITIONS NEED NOT BE FIRE STOPPED BUT SHALL HAVE MINERAL WOOL TIGHTLY PACKED. THIS INCLUDES ALL (FULL HEIGHT) MASONRY AND CEMENT BOARD WALLS.
 - APPLY INTUMESCENT FIREPROOFING WITH COLOUR TOP COAT FINISH TO EXPOSED SECTIONS OF THE STEEL LINTELS SUPPORTING OPENINGS IN LOAD BEARING WALLS OVER 200mm WIDE OR OPENINGS IN NON-LOADBEARING WALLS OVER 300mm WIDE. REFER TO O.B.C. SECTION 3.2.2.3. SECTIONS OF THESE LINTELS THAT ARE NOT WHOLLY OR PARTIALLY EXPOSED THAT FALL IN THE SAME CATEGORY AS MENTIONED ABOVE SHALL BE COVERED WITH SOLID CONCRETE BLOCK OR SPRAY-ON FIRE PROOFING.
- THIS IS A SPRINKLERED BUILDING. DESIGN, SUPPLY AND INSTALL OF ALL SPRINKLER PIPING, TREE DISTRIBUTION, SPRINKLER HEADS AND ANY RELATED EQUIP. ARE TO BE INCLUDED IN THIS CONTRACT.
- THESE DRAWINGS MUST BE REFERRED TO FOR LOCATIONS OF REQUIRED FIRE SEPARATIONS & REFER TO A4 SERIES DRAWINGS FOR TYPICAL FIRE AND SOUND STOPPING DETAILS. GENERAL CONTRACTOR TO COORDINATE WITH MECHANICAL DRAWINGS AND ALLOW FOR ANY EXTRA REQUIRED FIRE DAMPERS NOT SHOWN FOR NOTED FIRE SEPARATION REQUIREMENTS.
- COORD. W/ A4 DWG.'S FOR TYPICAL FIRE STOPPING & ACOUSTICAL SEALING DETAILS
- NUMBER OF PERSONS ACCOMMODATED IN ROOM OR AREA

- EXIT LIGHT W/ DIRECTIONAL ARROW
- EXIT DOORS
- POWER DOOR OPERATOR
- PUSH BUTTON FOR POWER DOOR OPERATOR
- FIRE EXTINGUISHER CABINET (RECESSED MOUNTED)
- SURFACE MOUNTED FIRE EXTINGUISHER
- HOLD OPEN DEVICE
- CONCERNING EXTENT OF FIRE STOPPING:
 - ALL PARTITIONS FORMING PART OF A FIRE SEPARATION SHALL BE COMPLETELY FIRE STOPPED & SMOKE SEALED. THIS INCLUDES ALL CORRIDOR WALLS AS WELL AS THE RATED FIRE SEPARATIONS NOTED ABOVE INCLUDING 0 HR. FIRE SEPARATION RATINGS. ALL OTHER FULL HEIGHT PARTITIONS NEED NOT BE FIRE STOPPED BUT SHALL HAVE MINERAL WOOL TIGHTLY PACKED. THIS INCLUDES ALL (FULL HEIGHT) MASONRY AND CEMENT BOARD WALLS.
 - APPLY INTUMESCENT FIREPROOFING WITH COLOUR TOP COAT FINISH TO EXPOSED SECTIONS OF THE STEEL LINTELS SUPPORTING OPENINGS IN LOAD BEARING WALLS OVER 200mm WIDE OR OPENINGS IN NON-LOADBEARING WALLS OVER 300mm WIDE. REFER TO O.B.C. SECTION 3.2.2.3. SECTIONS OF THESE LINTELS THAT ARE NOT WHOLLY OR PARTIALLY EXPOSED THAT FALL IN THE SAME CATEGORY AS MENTIONED ABOVE SHALL BE COVERED WITH SOLID CONCRETE BLOCK OR SPRAY-ON FIRE PROOFING.
- THIS IS A SPRINKLERED BUILDING. DESIGN, SUPPLY AND INSTALL OF ALL SPRINKLER PIPING, TREE DISTRIBUTION, SPRINKLER HEADS AND ANY RELATED EQUIP. ARE TO BE INCLUDED IN THIS CONTRACT.
- THESE DRAWINGS MUST BE REFERRED TO FOR LOCATIONS OF REQUIRED FIRE SEPARATIONS & REFER TO A4 SERIES DRAWINGS FOR TYPICAL FIRE AND SOUND STOPPING DETAILS. GENERAL CONTRACTOR TO COORDINATE WITH MECHANICAL DRAWINGS AND ALLOW FOR ANY EXTRA REQUIRED FIRE DAMPERS NOT SHOWN FOR NOTED FIRE SEPARATION REQUIREMENTS.
- COORD. W/ A4 DWG.'S FOR TYPICAL FIRE STOPPING & ACOUSTICAL SEALING DETAILS
- NUMBER OF PERSONS ACCOMMODATED IN ROOM OR AREA


- MIN. HEADROOM CLEARANCE 2.1m IN EVERY ACCESS TO EXIT REQUIRED 3.3,1.8
- WHERE FIRE SEPARATION RATING EXTENDS BEYOND ALONG A BUILDING FACADE, EXTEND 3m

REVISIONS

NO.	DATE	PARTICULAR
1	2022.04.06	ISSUED FOR 805 CLASS B COSTING
2	2022.06.18	ISSUED FOR SPA
3	2022.09.22	ISSUED FOR OWNERS REVIEW - RES SET
4	2022.12.16	ISSUED FOR 2ND SPA SUBMISSION
5	2023.01.31	ISSUED FOR TENDER
6	2023.02.22	ISSUED FOR ADDENDUM 9
7	2023.08.23	ISSUED FOR CONVENIENCE
8	2023.11.20	ISSUED FOR PERMIT COMMENTS
9	2024.01.24	ISSUED FOR SH03
10	2024.02.15	ISSUED FOR PCH038
11	2024.03.04	ISSUED FOR PCH039
12	2024.03.10	ISSUED FOR SH04
13	2024.05.14	ISSUED FOR SH04
14	2024.07.22	ISSUED FOR SH08
15	2024.08.07	ISSUED FOR SH09
16	2024.10.02	ISSUED FOR PCH015
17	2025.04.11	ISSUED FOR PCH019
18	2025.05.01	ISSUED FOR CO#07
19	2025.05.28	ISSUED FOR PCH020 - CO#010
20	2025.07.31	ISSUED FOR SH013
21	2025.08.06	ISSUED FOR SH014
22	2025.08.15	ISSUED FOR PCH025 - CO#017
23	2025.08.25	ISSUED FOR PCH027 - CO#021
24	2025.09.02	ISSUED FOR PCH029
25	2025.09.02	ISSUED FOR SH020 - CO#018
26	2025.09.08	ISSUED FOR PCH031
27	2025.09.10	ISSUED FOR PCH032 - CO#022
28	2025.09.10	ISSUED FOR PCH033
29	2025.09.11	ISSUED FOR SH022
30	2025.09.15	ISSUED FOR SH023
31	2025.09.16	ISSUED FOR PCH035 - CO#023
32	2025.09.30	ISSUED FOR PCH037 - CO#019
33	2025.10.30	ISSUED FOR PCH038 - CO#025
34	2025.10.04	ISSUED FOR PCH039 - CO#024
35	2025.10.20	ISSUED FOR PCH040
36	2025.10.30	ISSUED FOR PCH041
37	2025.10.23	ISSUED FOR PCH042
38	2025.11.21	ISSUED FOR PCH021R1 - CO12 COW01
39	2025.11.14	ISSUED FOR PCH043
40	2025.11.26	ISSUED FOR PCH044
41	2025.12.03	ISSUED FOR PCH044 - CO#026
42	2026.02.04	ISSUED FOR RECORD SET UP TO CO#027

NOTES:

KEY PLAN:

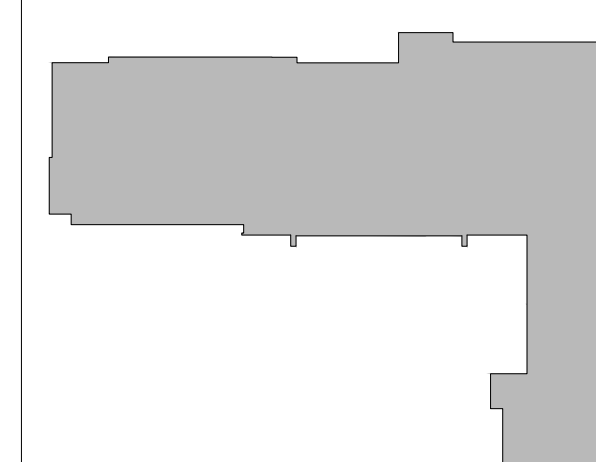

CLIENT:
NEAR NORTH DISTRICT SCHOOL BOARD
NDSB Tender # 2023-015

PROJECT:
NEW PARRY SOUND K-12 SCHOOL & CHILDCARE

PARRY SOUND HIGH SCHOOL SITE

111 ISABELLA STREET
PARRY SOUND, ONTARIO

ORIGINAL PAGE SIZE ARCH E1 - 30" x 42"
KEY TO DETAIL LOCATION:
A - DETAIL NO.
B - DETAIL NO. ORIGIN

ARCHITECTS
THE VENTIN GROUP LTD



A0.4

DRAWN BY: EB

CHECKED BY: PS

SECOND FLOOR - LIFE SAFETY PLAN

All dimensions and measurements must be checked and verified by the General Contractor.
Reproduction of drawings and related documents in whole or in part is prohibited without written permission of the Ventin Group.

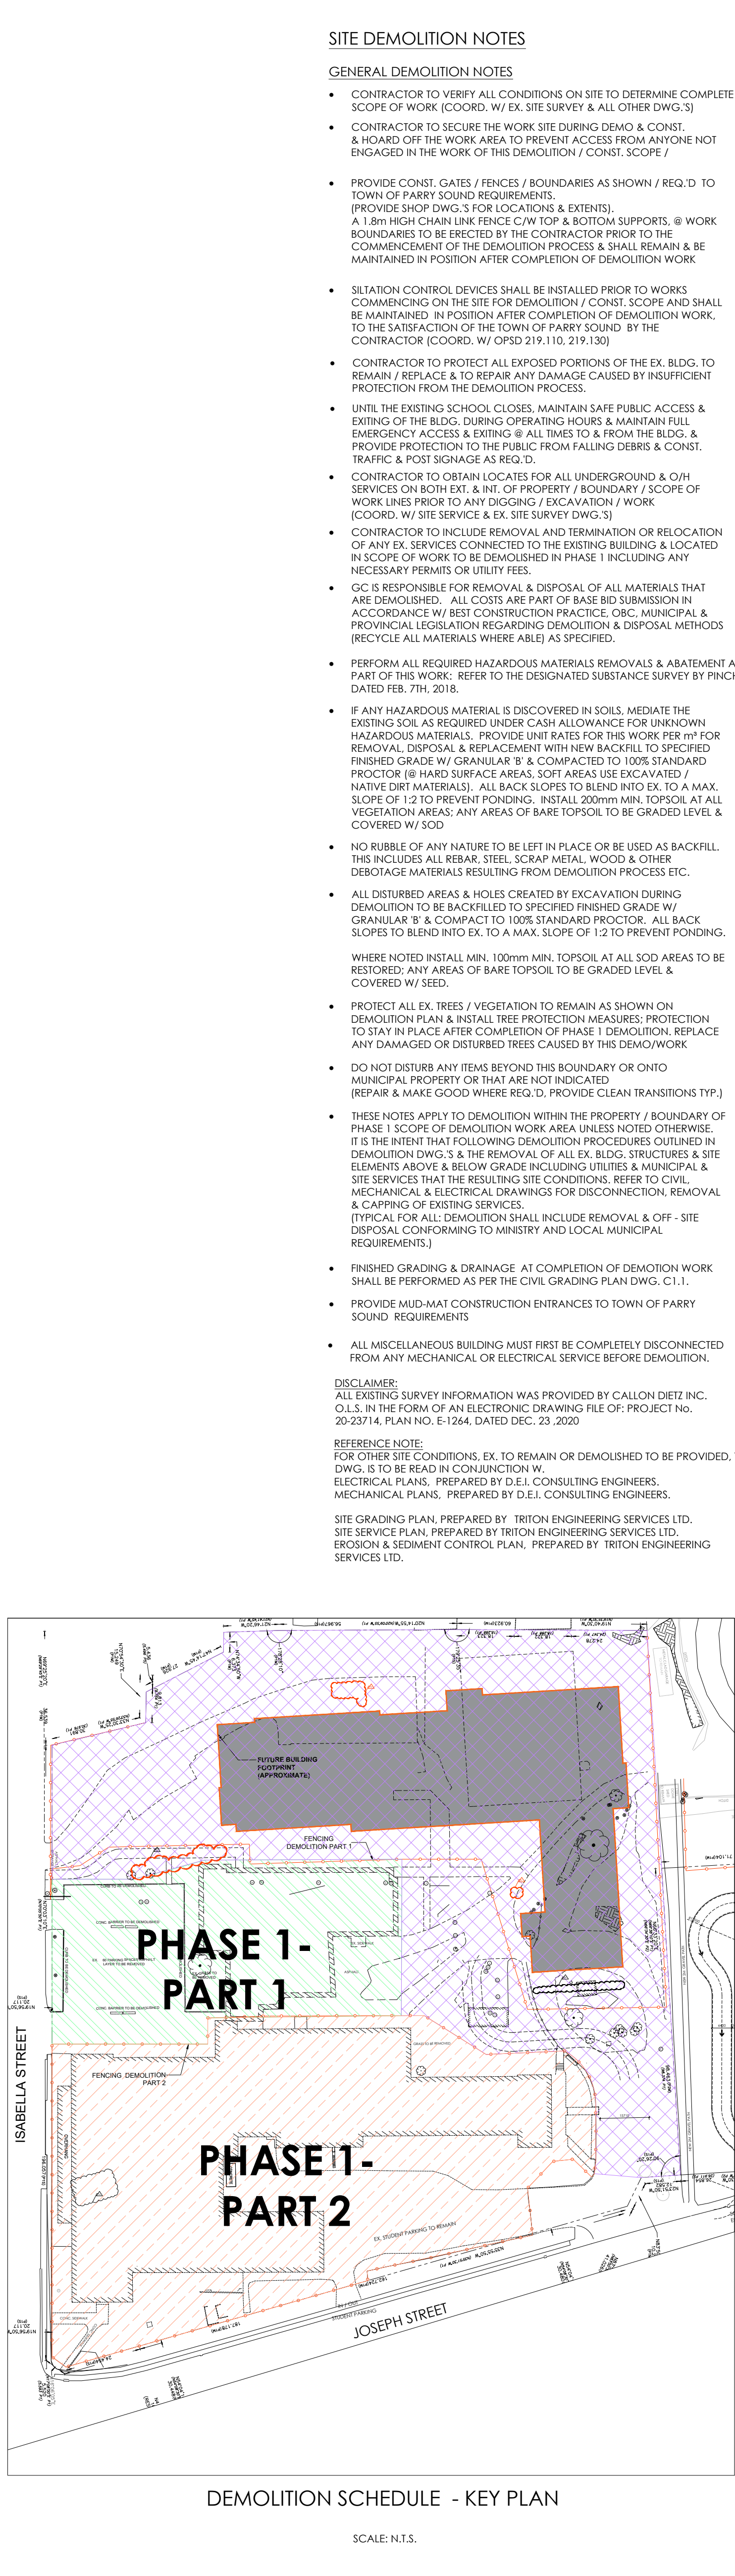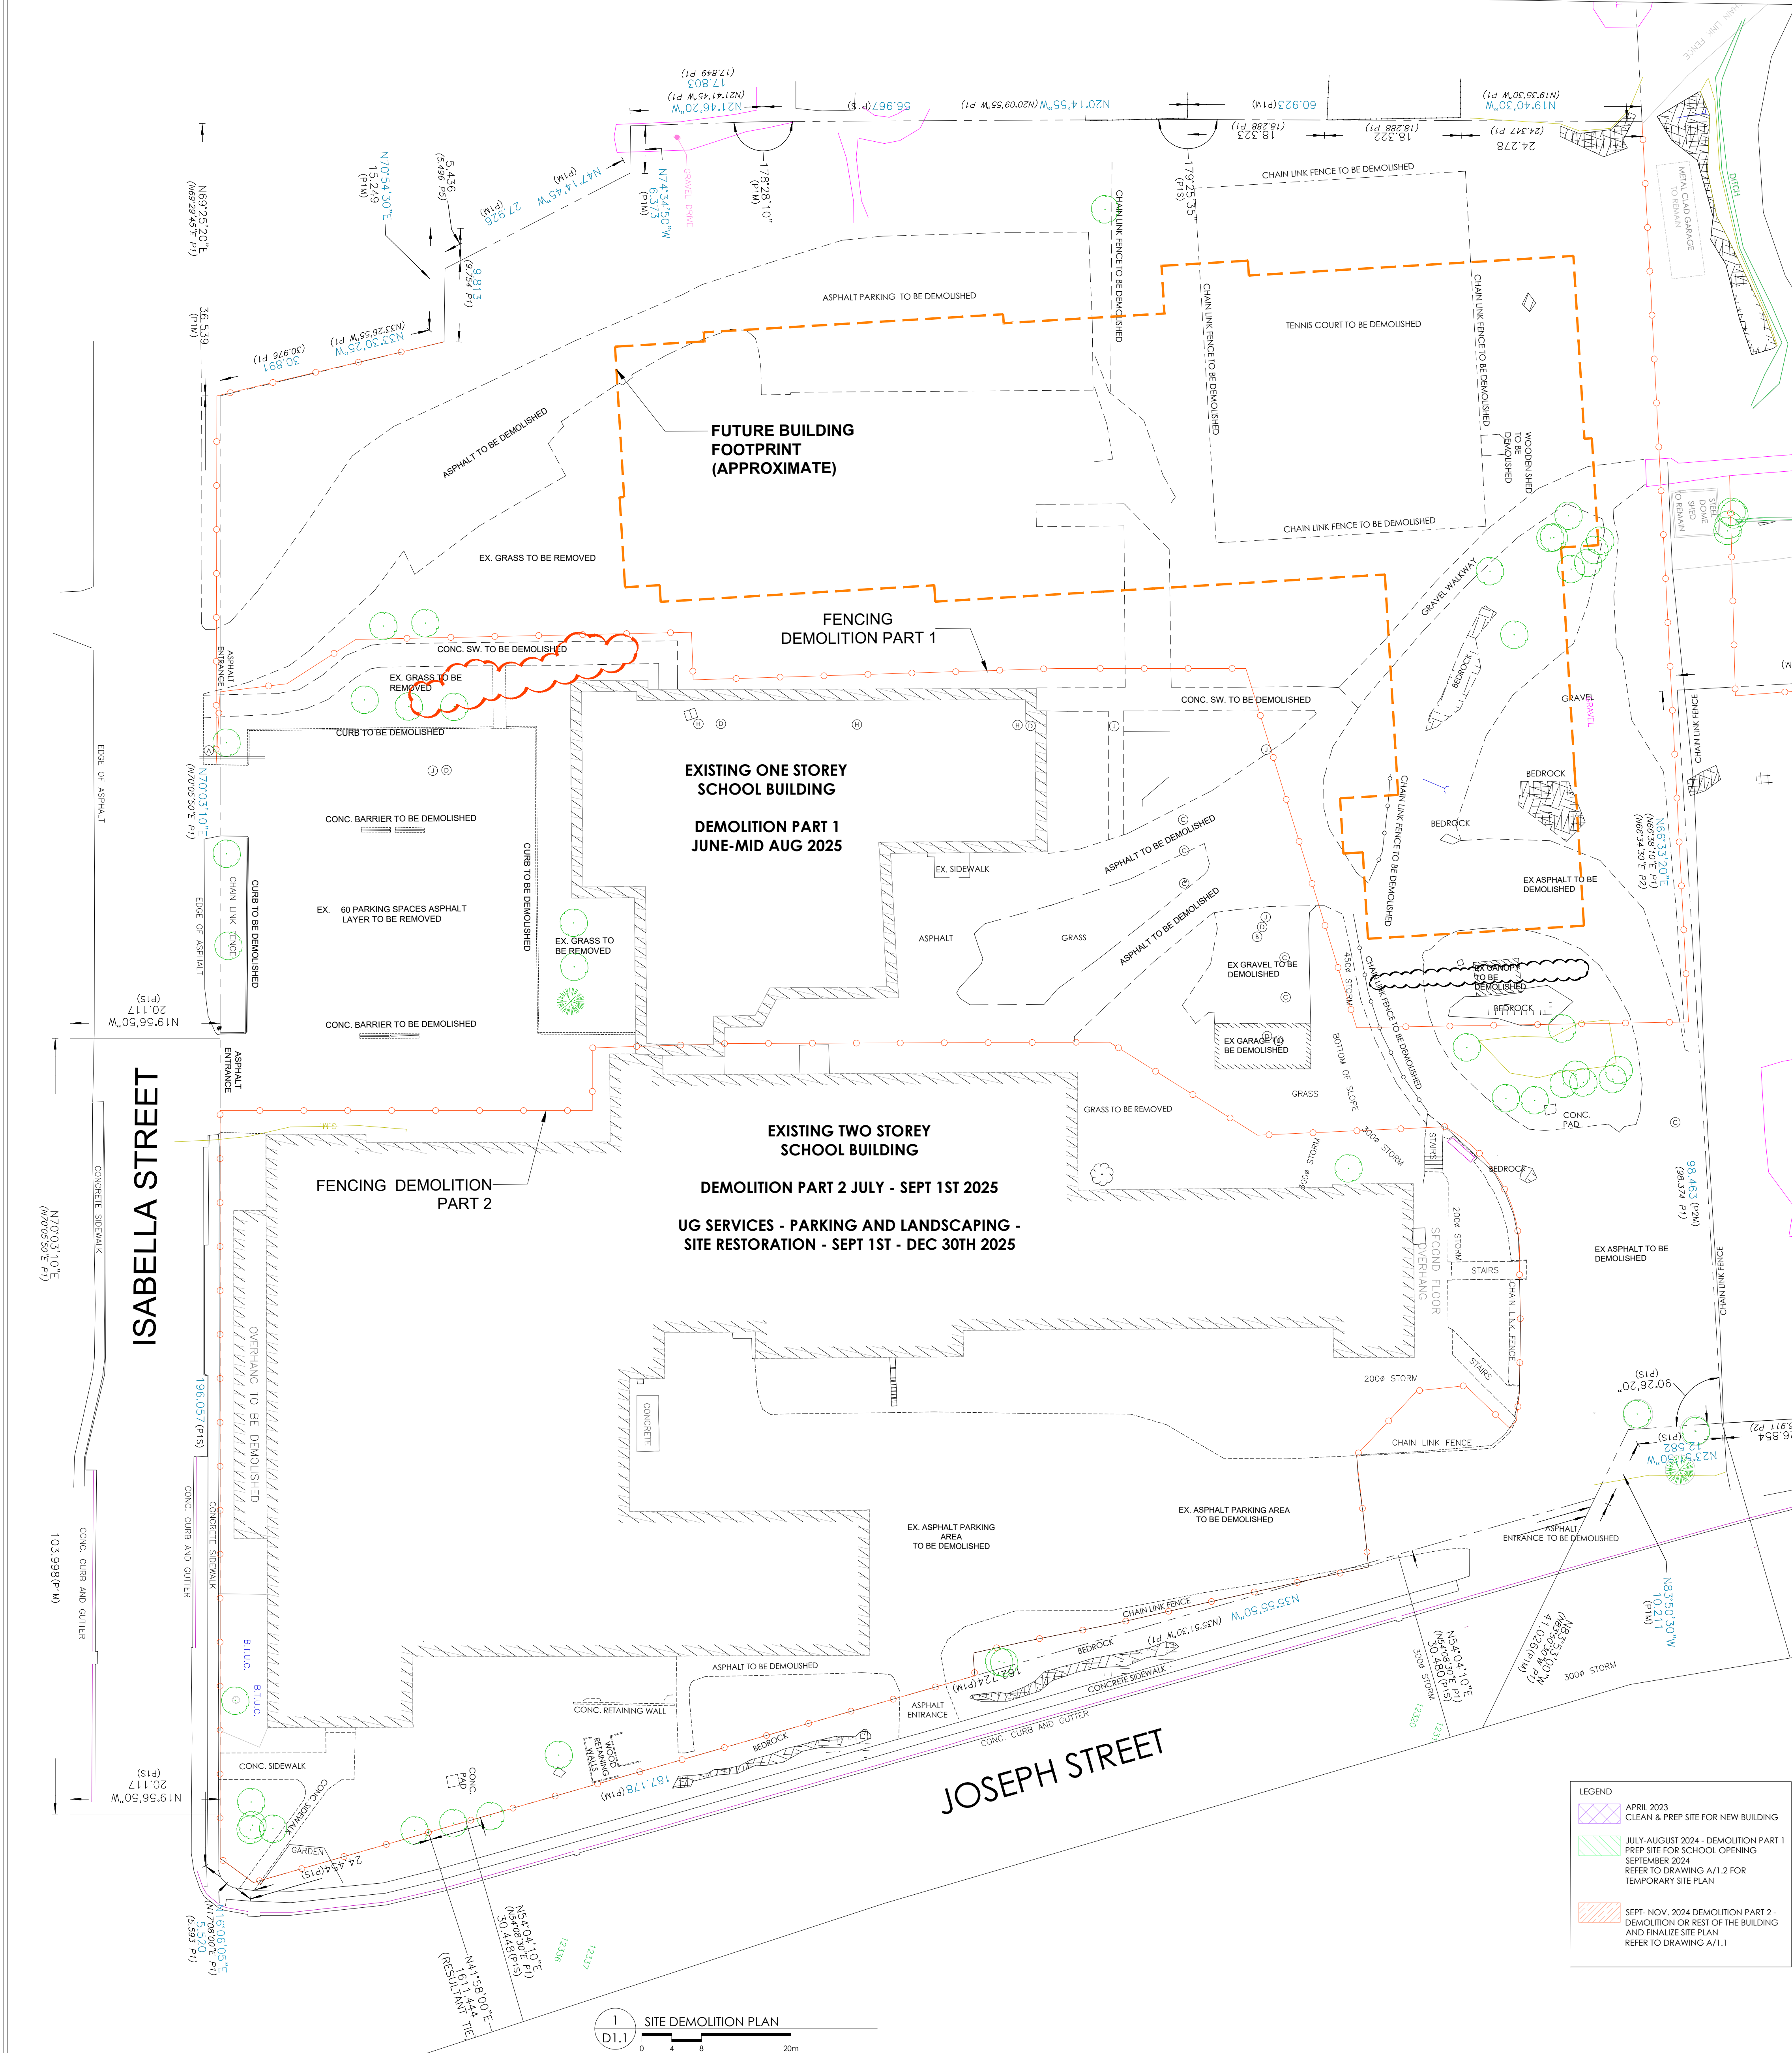

GENERAL NOTES:		
THE 'LIMITS OF CONSTRUCTION/DEMOLITION' SHALL BE ASSUMED TO BE THE PROPERTY LINE UNLESS OTHERWISE NOTED.		
FIRE ACCESS ROUTE TO BE POSTED AND DESIGNATED UNDER MUNICIPAL BY-LAW (FIRE ACCESS ROUTE TO BE MIN. 4 m WIDE WITH A MIN. 12 m CENTRELIN TURNING RADIUS AND MAX. 6% SLOPE).		
COORD. W. MECH. & ELEC. SITE PLANS FOR ALL EXISTING & NEW LOCATIONS OF SERVICES & ENTRY OF SERVICES INTO THE BUILDING ENVELOPE. (ALL MECH. & ELEC. INFO INDICATED ON ARCHITECTURAL SITE DWG. IS FOR GENERAL REFERENCE & COORD. ONLY).		
COORD. W. SITE GRADING PLAN BY CIVIL CONSULTANT (DWG. C-1.1) FOR PROPOSED FINAL FINISH GRADE ELEVATIONS & DRAINAGE SLOPES.		
THE SUB-GRADE SOILS EXPOSED AFTER EXCAVATION SHALL BE INSPECTED AND CERTIFIED BY A QUALIFIED REGISTERED PROFESSIONAL SOILS ENGINEER AND A COPY OF THE REPORT SHALL BE FORWARDED TO THE TOWN OF PARRY SOUND.		
ALL GRANULAR FILL PLACED ON THE SITE SHALL BE COMPACTED TO A MINIMUM OF 98-100% STANDARD PROCTOR DENSITY. A SUFFICIENT NUMBER OF TESTS SHALL BE TAKEN AT VARIOUS LEVELS SATISFACTORY TO THE DIRECTOR OF ENGINEERING. TEST RESULTS SHALL BE SENT TO TOWN OF PARRY SOUND WITH A LETTER, SIGNED AND STAMPED BY THE SOILS ENGINEER, STATING THAT A SUFFICIENT NUMBER OF TESTS HAVE BEEN TAKEN AND THE MINIMUM DEGREE OF COMPACTION HAS BEEN REACHED.		
ADMINISTER AND CARRY OUT ON SITE AND EXCESS SOIL MANAGEMENT PRACTICES IN ACCORDANCE WITH GRABO REGULATIONS 406/19A FOR TRACKING, TRANSPORTATION, REUSE, OFF-SITE DEPOSIT ETC.		
SITATION CONTROL DEVICES SHALL BE INSTALLED PRIOR TO WORKS COMMENCING ON THE SITE FOR DEMOLITION / CONSTRUCTION AND SHALL BE MAINTAINED IN POSITION AFTER COMPLETION OF DEMOLITION WORK.		
CONTRACTOR TO OBTAIN LOCATES FOR ALL UNDERGROUND & O/H SERVICES ON BOTH EX. & INT. OF PROPERTY / BOUNDARY / SCOPE OF WORK LINES PRIOR TO ANY DIGGING / EXCAVATION / WORK (COORD. W/ SITE SERVICE & EX. SITE SURVEY DWG. S).		
CONTRACTOR TO INCLUDE REMOVAL AND TERMINATION OR RELOCATION OF ANY EX. SERVICES CONNECTED TO THE EXISTING BUILDING & LOCATED IN SCOPE OF WORK TO BE DEMOLISHED IN PHASE 1 INCLUDING ANY NECESSARY PERMITS OR UTILITY FEES.		
GC IS RESPONSIBLE FOR REMOVAL & DISPOSAL OF ALL MATERIALS THAT ARE DEMOLISHED. ALL COSTS ARE PART OF BASE BID SUBMISSION IN ACCORDANCE W/ BEST CONSTRUCTION PRACTICE. OBC, MUNICIPAL & PROVINCIAL LEGISLATION REGARDING DEMOLITION & DISPOSAL METHODS (RECYCLE ALL MATERIALS WHERE ABLE) AS SPECIFIED.		
PERFORM ALL REQUIRED HAZARDOUS MATERIALS REMOVALS & ABATEMENT AS PART OF THIS WORK. REFER TO THE DESIGNATED SUBSTANCE SURVEY BY PINCHIN, DATED FEB. 7TH, 2018.		
IF ANY HAZARDOUS MATERIAL IS DISCOVERED IN SOILS, MEDIANE THE EXISTING SOIL AS REQUIRED UNDER CASH ALLOWANCE FOR UNKNOWN HAZARDOUS MATERIALS. PROVIDE UNIT RATES FOR THIS WORK PER m ³ FOR REMOVAL, DISPOSAL & REPLACEMENT WITH NEW BACKFILL TO SPECIFIED FINISHED GRADE W/ GRANULAR B & COMPACTED TO 100% STANDARD PROCTOR (B HAND SURFACE AREAS, SOFT AREAS USE EXCAVATED / NATIVE DIRT MATERIALS). ALL BACK SLOPES TO BLEND INTO EX. TO A MAX. SLOPE OF 1:2 TO PREVENT PONDING. INSTALL 200mm MIN. TOPSOIL AT ALL VEGETATION AREAS; ANY AREAS OF BARE TOPSOIL TO BE GRADED LEVEL & COVERED W/ SOO.		
NO RUBBLE OF ANY NATURE TO BE LEFT IN PLACE OR BE USED AS BACKFILL. THIS INCLUDES ALL REBAR, STEEL, SCRAP METAL, WOOD & OTHER DEBRIDGE MATERIALS RESULTING FROM DEMOLITION PROCESS ETC.		
ALL DISTURBED AREAS & HOLES CREATED BY EXCAVATION DURING DEMOLITION TO BE BACKFILLED TO SPECIFIED FINISHED GRADE W/ GRANULAR B & COMPACT TO 100% STANDARD PROCTOR. ALL BACK SLOPES TO BLEND INTO EX. TO A MAX. SLOPE OF 1:2 TO PREVENT PONDING. WHERE NOTED INSTALL MIN. 100mm MIN. TOPSOIL AT ALL SOO AREAS TO BE RESTORED; ANY AREAS OF BARE TOPSOIL TO BE GRADED LEVEL & COVERED W/ SEED.		
PROTECT ALL EX. TREES / VEGETATION TO REMAIN AS SHOWN ON DEMOLITION PLAN & INSTALL TREE PROTECTION MEASURES: PROTECTION TO STAY IN PLACE AFTER COMPLETION OF PHASE 1 DEMOLITION, REPLACE ANY DAMAGED OR DISTURBED TREES CAUSED BY THIS DEMO/WORK.		
DO NOT DISTURB ANY ITEMS BEYOND THIS BOUNDARY OR ONTO MUNICIPAL PROPERTY OR THAT ARE NOT INDICATED (REPAIR & MAKE GOOD WHERE REQ'D, PROVIDE CLEAR TRANSITIONS TYP.).		
THESE NOTES APPLY TO DEMOLITION WITHIN THE PROPERTY / BOUNDARY OF PHASE 1 SCOPE OF DEMOLITION WORK AREA UNLESS NOTED OTHERWISE. IT IS THE INTENT THAT FOLLOWING DEMOLITION PROCEDURES OUTLINED IN DEMOLITION DWG. S & THE REMOVAL OF ALL EX. BLDG. STRUCTURES & SITE ELEMENTS ABOVE & BELOW GRADE INCLUDING UTILITIES & MUNICIPAL & SITE SERVICES THAT THE RESULTING SITE CONDITIONS, REFER TO CIVIL MECHANICAL & ELECTRICAL DRAWINGS FOR DISCONNECTION, REMOVAL & CAPPING OF EXISTING SERVICES. (TYPICAL FOR ALL DEMOLITION SHALL INCLUDE REMOVAL & OFF-SITE DISPOSAL CONFORMING TO MINISTRY AND LOCAL MUNICIPAL REQUIREMENTS.)		
FINISHED GRADING & DRAINAGE AT COMPLETION OF DEMOLITION WORK SHALL BE PERFORMED AS PER THE CIVIL GRADING PLAN DWG. C-1.1.		
PROVIDE MUD-MAT CONSTRUCTION ENTRANCES TO TOWN OF PARRY SOUND REQUIREMENTS.		
ALL MISCELLANEOUS BUILDING MUST FIRST BE COMPLETELY DISCONNECTED FROM ANY MECHANICAL OR ELECTRICAL SERVICE BEFORE DEMOLITION.		
DISCLAIMER: ALL EXISTING SURVEY INFORMATION WAS PROVIDED BY CALLON DIETZ INC. O.L.S. IN THE FORM OF AN ELECTRONIC DRAWING FILE OF: PROJECT NO. 20-2374, PLAN NO. E-1264, DATED DEC. 23, 2020.		
REFERENCE NOTE: FOR OTHER SITE CONDITIONS, EX. TO REMAIN OR DEMOLISHED TO BE PROVIDED, THIS DWG. IS TO BE READ IN CONJUNCTION W/ ELECTRICAL PLANS, PREPARED BY D.E.I. CONSULTING ENGINEERS, MECHANICAL PLANS, PREPARED BY D.E.I. CONSULTING ENGINEERS.		
SITE GRADING PLAN, PREPARED BY TRITON ENGINEERING SERVICES LTD.		
SITE SERVICE PLAN, PREPARED BY TRITON ENGINEERING SERVICES LTD.		
EROSION & SEDIMENT CONTROL PLAN, PREPARED BY TRITON ENGINEERING SERVICES LTD.		
DO NOT DISTURB THE REST OF THE EX. SERVICE TO REMAIN & ENSURE IN PROPER WORKING ORDER AFTER COMPLETION OF WORK & ALL NEW LAND INFILL & REPLACEMENT W/ PROPER DRAINAGE SLOPES TOWARD EX. SERVICES]		
DISCONNECT @ THE SOURCE & ACTUAL TERMINATION LOCATION IS SUBJECT TO: EX. W/ LOCAL AUTHORITY / UTILITY / CITY / TOWN HAVING JURISDICTION FOR THEIR REG. 3.4 ACTIONS OF THE ACTUAL DISCONNECT / TERMINATION / CAP LOCATION: (COORD. W/ ELEC., MECH. & CIVIL DWG. S)		
DO NOT DISTURB THE REST OF THE EX. SERVICE TO REMAIN & ENSURE IN PROPER WORKING ORDER AFTER COMPLETION OF WORK & ALL NEW LAND INFILL & REPLACEMENT W/ PROPER DRAINAGE SLOPES TOWARD EX. SERVICES]		
EX. FENCING TO REMAIN UNLESS OTHERWISE INDICATED. ADD SILT FENCING IN FRONT OF EX. & NEW FENCING FOR SITATION CONTROL, REFER TO SITE PLAN FOR NEW FENCING AND CONSTRUCTION FENCING.		
<NOT USED>		
REMOVE EX. VEGETATION / ROOTS IN CONFLICT W/ PROPOSED LAYOUT. COMPLETELY REMOVE ROOT SYSTEMS WHICH ARE FOUND WITHIN THE PROPERTY LIMITS - DO NOT UNDERCUT PER FENCING / HARDING, REMOVE ONLY THAT PORTION OF TREE ROOT SYSTEMS WHICH ARE FOUND WITHIN PROPERTY LIMITS.		
<NOT USED>		
REFER & COORDINATE WITH MECHANICAL & ELECTRICAL DRAWINGS FOR REMOVAL OF ABOVE & BELOW GROUND SERVICES WITHIN PHASE 1 DEMOLITION BUILDING PERIMETERS AS NOTED INCLUDING RELOCATION AND RECONNECTION OF EXISTING SERVICES. REFER TO CIVIL DRAWING C-1.1 FOR EXISTING SERVICES BEYOND THE DEMOLISHED BUILDING PERIMETER TO BE REMOVED, RETAINED OR RECONNECTED.		
DO NOT DISTURB THE REST OF THE EX. SERVICE TO REMAIN & ENSURE IN PROPER WORKING ORDER AFTER COMPLETION OF WORK & ALL NEW LAND INFILL & REPLACEMENT W/ PROPER DRAINAGE SLOPES TOWARD EX. SERVICES]		
<NOT USED>		
MEDIANE SOIL AS REQ'D IF ANY HAZARDOUS MATERIALS ARE DISCOVERED. PROVIDE UNIT RATES FOR THIS WORK PER m ³ FOR REMOVAL, DISPOSAL & REPLACEMENT W/ NEW GRANULAR B MATERIAL.		
<NOT USED>		
VEGETATION TO BE REMOVED		
VEGETATION TO REMAIN		

REVISIONS

NO.	DATE	PARTICULAR
1	2022.04.06	ISSUED FOR 80% CLASS B COSTING
2	2022.06.18	ISSUED FOR SPA
3	2022.09.22	ISSUED FOR OWNERS REVIEW - RPS SET
4	2022.12.16	ISSUED FOR 2ND SPA SUBMISSION
5	2023.01.31	ISSUED FOR TENDER
6	2023.02.22	ISSUED FOR ADDENDUM 9
7	2023.08.23	ISSUED FOR CONVENIENCE
8	2023.11.20	ISSUED FOR PERMIT COMMENTS
9	2024.05.24	ISSUED FOR DEMOLITION PERMIT
10	2024.02.15	ISSUED FOR PCH#08
11	2024.03.04	ISSUED FOR PCH#09
12	2024.03.10	ISSUED FOR PCH#09
13	2024.05.14	ISSUED FOR PCH#09
14	2024.07.22	ISSUED FOR PCH#09
15	2024.08.07	ISSUED FOR PCH#09
16	2024.10.02	ISSUED FOR PCH#15
17	2025.04.11	ISSUED FOR PCH#19
18	2025.05.01	ISSUED FOR PCH#07
19	2025.05.28	ISSUED FOR PCH#20 - CO#410
20	2025.07.31	ISSUED FOR PCH#13
21	2025.08.06	ISSUED FOR PCH#14
22	2025.08.15	ISSUED FOR PCH#25 - CO#417
23	2025.08.25	ISSUED FOR PCH#27 - CO#421
24	2025.09.02	ISSUED FOR PCH#29
25	2025.09.02	ISSUED FOR PCH#20 - CO#418
26	2025.09.08	ISSUED FOR PCH#31
27	2025.09.09	ISSUED FOR PCH#32 - CO#422
28	2025.09.10	ISSUED FOR PCH#33
29	2025.09.11	ISSUED FOR PCH#22
30	2025.09.15	ISSUED FOR PCH#23
31	2025.09.16	ISSUED FOR PCH#35 - CO#423
32	2025.09.30	ISSUED FOR PCH#37 - CO#419
33	2025.09.30	ISSUED FOR PCH#38 - CO#425
34	2025.10.04	ISSUED FOR PCH#39 - CO#424
35	2025.10.20	ISSUED FOR PCH#40
36	2025.10.30	ISSUED FOR PCH#41
37	2025.10.23	ISSUED FOR PCH#42
38	2025.11.21	ISSUED FOR PCH#42/1 - CO12 CO#39
39	2025.11.14	ISSUED FOR PCH#43
40	2025.11.26	ISSUED FOR PCH#43/1
41	2025.12.03	ISSUED FOR PCH#44 - CO#426
42	2026.02.04	ISSUED FOR RECORD SET UP TO CO#27

KEY PLAN:

CLIENT:

Near North District School Board
NND\$B tender # 2023-015

PROJECT:

NEW PARRY SOUND K-12 SCHOOL & CHILDCARE

PARRY SOUND HIGH SCHOOL SITE

111 ISABELLA STREET
PARRY SOUND, ONTARIO

ORIGINAL PAGE SIZE ARCH E1 - 30" x 42"

KEY TO DETAIL LOCATION:
A - DETAIL NO.
B - DETAIL NO. ORIGIN

ARCHITECTS

THE VENTIN GROUP LTD

VG

ARCHITECTS

THE VENTIN GROUP LTD


D1.1

SITE DEMOLITION PLAN

Drawn By: jkely

Checked By: PS

Reduction of drawings and related documents in whole or in part is prohibited without written permission of the firm group.

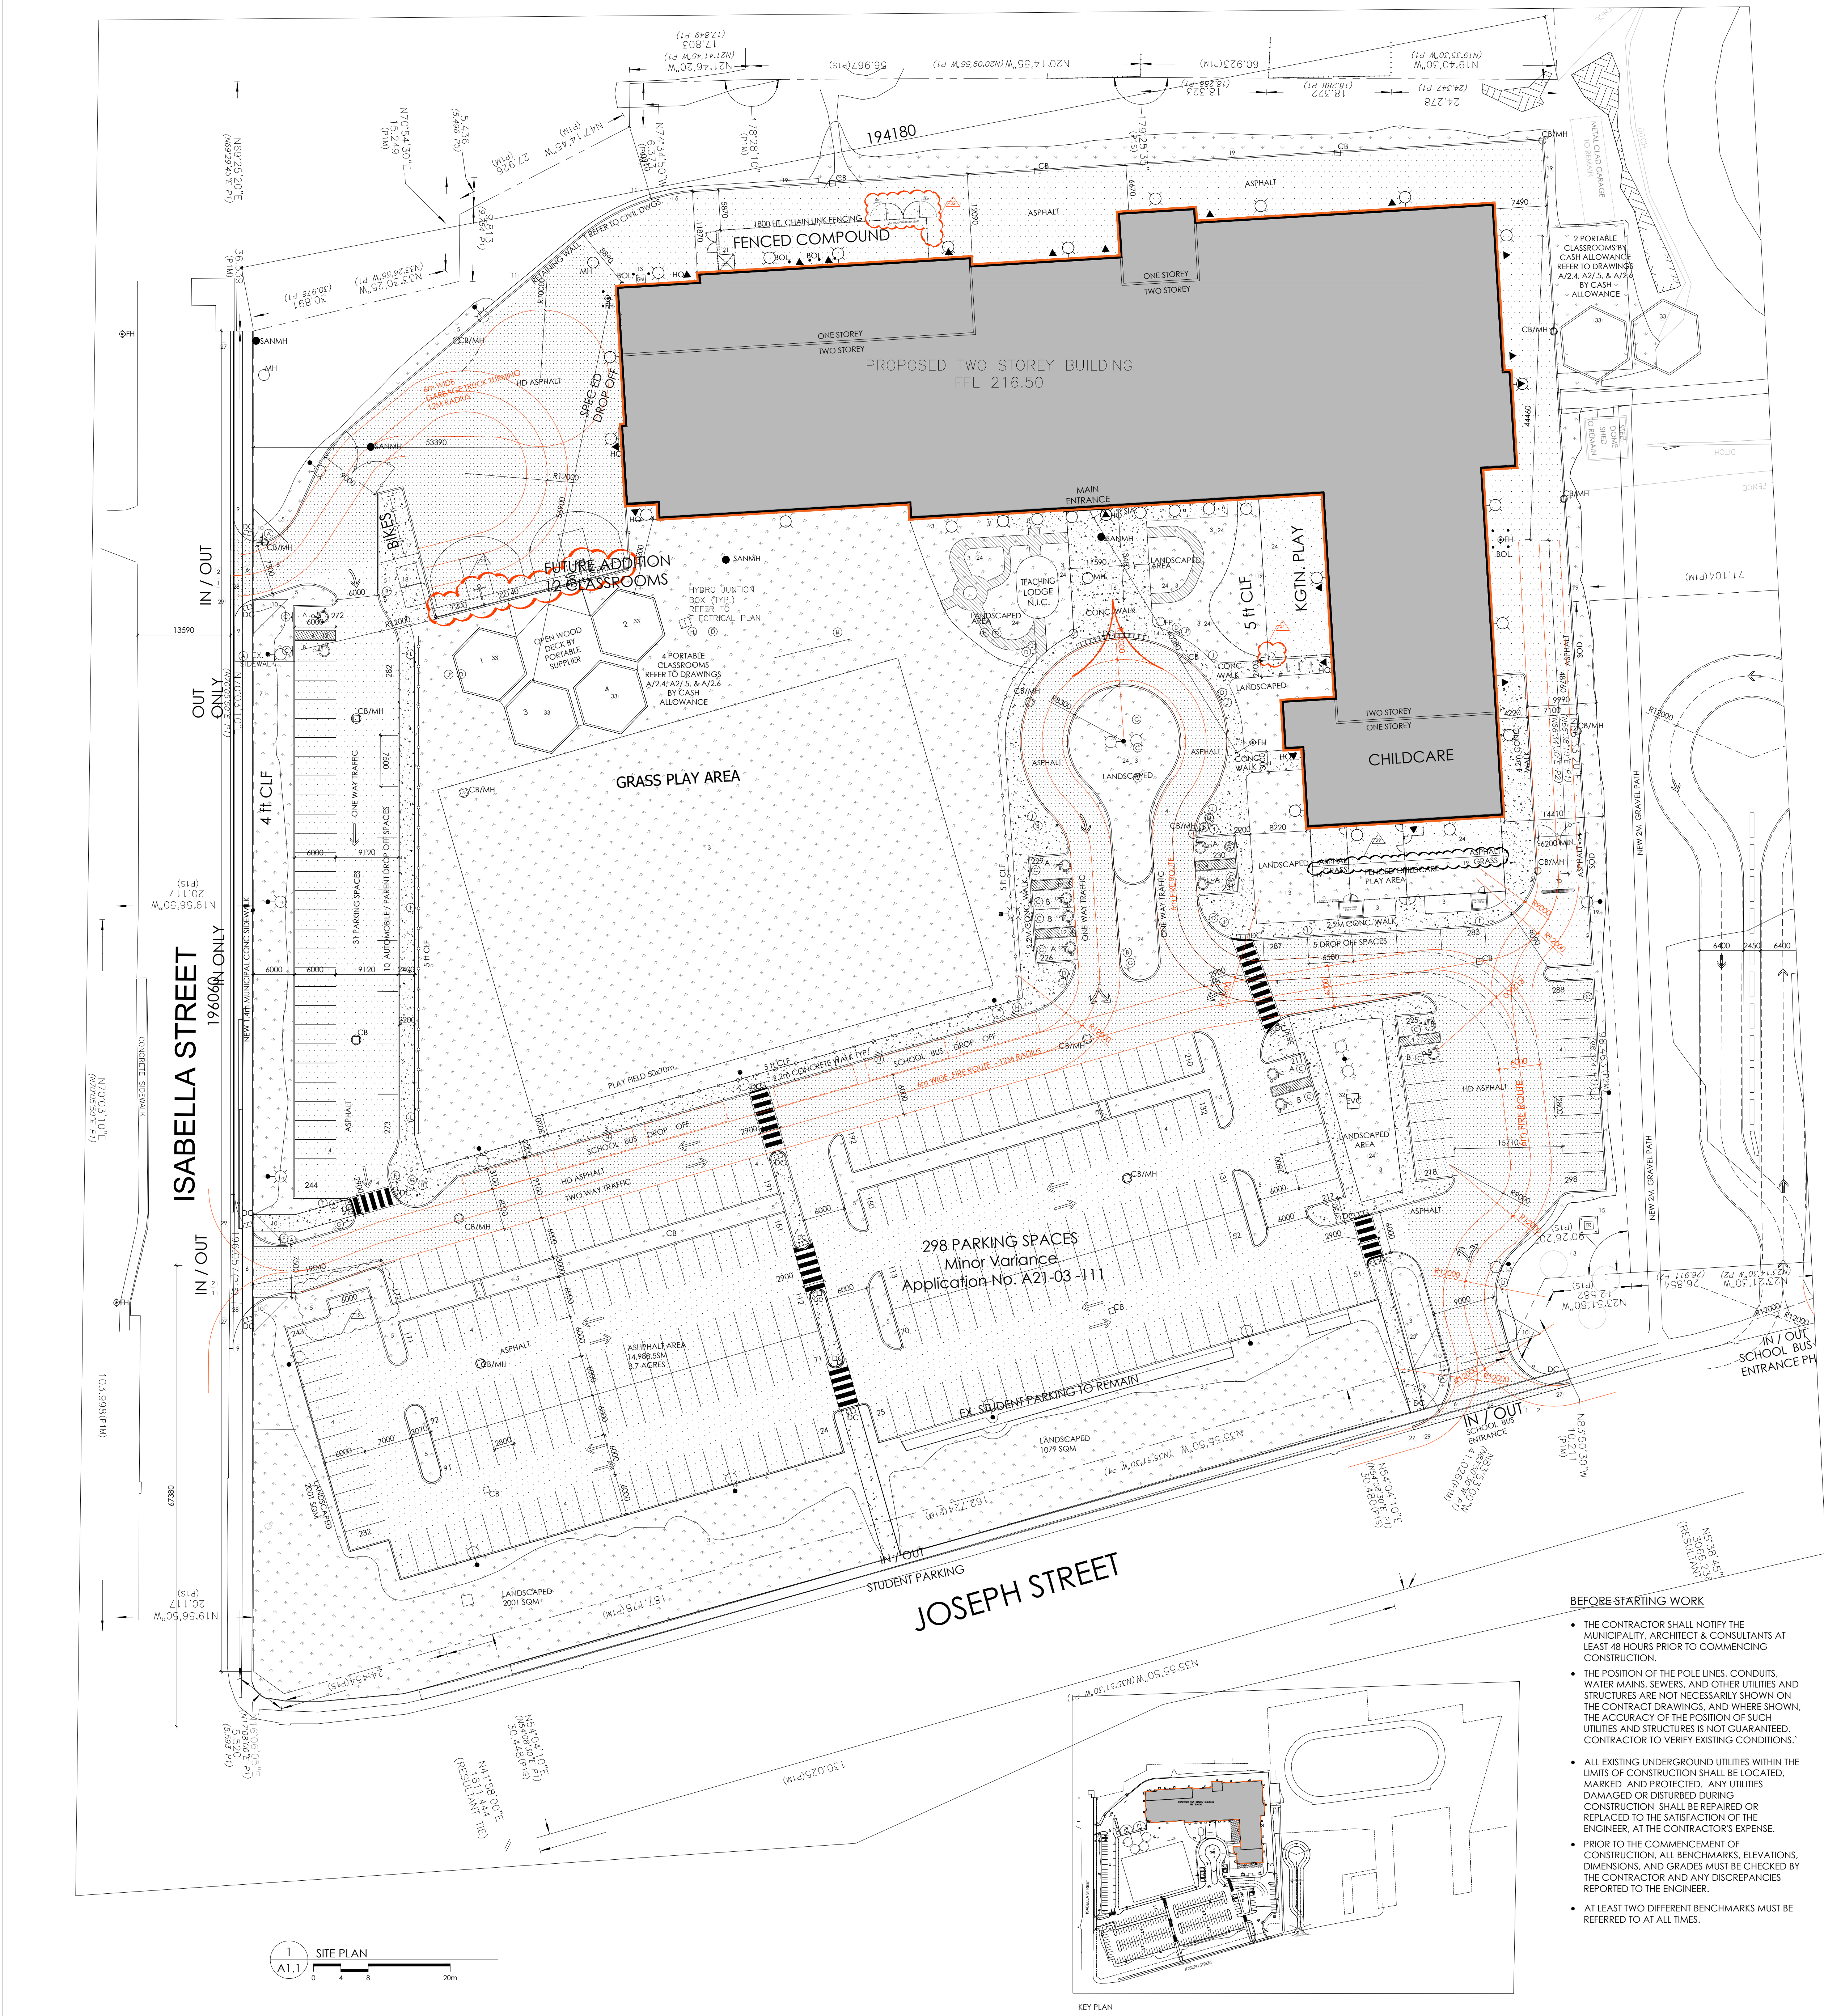

- REFERENCE NOTES:**
- GENERAL CONTRACTOR TO PERFORM ALL WORK WITHIN THE ROAD ALLOWANCE UNLESS SPECIFICALLY OTHERWISE NOTED.
 - GENERAL CONTRACTOR TO EXECUTE WORK TO DRIVEWAY ENTRANCE UNDER PERMIT & SUPERVISION OF THE CITY FOLLOWING MUNICIPAL STANDARD DETAILS. DRIVEWAY ENTRANCE TO BE CLOSED FOR INSTALLATION OF NEW ENTRANCES.
 - COORD. WITH LANDSCAPE DRAWINGS FOR ALL PLANTING BEDS, TREE PLANTINGS, LANDSCAPE FEATURES & SLOODED AREAS.
 - PROVIDE NEW PAINTED PARKING STALL LINE MARKINGS, HANDICAP SYMBOLS, CROSS HATCH MARKINGS, TURNING ARROWS ETC. ON TOP OF FINISHED ASPHALT LAYER.
 - CONCRETE BARRIER CURBS UNLESS OTHERWISE NOTED (COORD. W/ OPSD-600.090 & MUNICIPAL STANDARD DETAILS).
 - NEW MUNICIPAL CONCRETE WALKWAY 1500mm WIDE C/W REIN. CONC. ACROSS VEHICLE ENTRANCE PER MUNIC. STD.
 - REMOVE ANY EXISTING CURB CUTS & DRIVEWAY ACCESS & REINSTATE BARRIER CURB & NEW TOPSOIL & SOD.
 - PROPOSED LOCATION OF CONSTRUCTION ACCESS C/W MUD MAT.
 - PROVIDE MIN. 100mm TOPSOIL & SOD IN ALL AREAS OF EXISTING ROAD BOULEVARD WHERE DISTURBED BY NEW WORK.
 - A 5m X 5m VISIBILITY TRIANGLE MUST BE MAINTAINED REMAIN CLEAR AT BOTH SIDES OF ALL INTERSECTION OF VEHICULAR TRAFFIC ACCESS ROADS / DRIVEWAYS. THE MAX. HEIGHT OF ANY OBJECT OR MATURE VEGETATION WITHIN THE VISIBILITY TRIANGLE IS NOT TO EXCEED 0.6m ABOVE THE CENTRELINE OF THE CORRESPONDING ADJACENT STREET.
 - 4m HIGH PRECAST CONCRETE RETAINING WALL COMPLETE WITH GUARD RAIL.
 - ACCESSIBLE ASLE WITH MIN. WIDTH OF 1.5 SHARED BY ACCESSIBLE PARKING SPACES AS PER MUNICIPAL BY-LAW.
 - GAS METER ENCLOSURE - REFER TO DETAIL 9/A1.3.
 - FLAG POLE DETAIL - REFER TO DETAIL 1/A1.3.
 - TRANSFORMER ON CONC. PAD TO SLIT - C/W BOLLARDS & 6m EASEMENT.
 - CONC. FILLED GALV. STEEL BOLLARD - REFER TO DETAILS 2/A1.3.
 - BICYCLE RACKS AS SPECIFIED PER UNIT - 45 MINIMUM CAPACITY.
 - GARBAGE & RECYCLING ENCLOSURE ON CONCRETE PAD TO MEET MUNICIPAL STANDARDS. REFER TO DETAILS ON A1.4.
 - ASPHALT / TURF DETAIL - REFER TO DETAIL 6/A1.3.
 - ROUGH-IN FOR FUTURE ILLUMINATED SCHOOL SIGN APPROXIMATELY 1.8m HIGH X 2.4m LONG & PROPOSED LOCATION FOR PROJECT SIGN - REFER TO DETAIL 3 & 4 ON A1.3.
 - SAWDUST EXTRACTOR ON CONC. PAD TO SUIT.
 - ASPHALT SPEED HUMP - REFER TO DETAIL 10/A1.3.
 - FOOTBALL / SOCCER GOAL POSTS - REFER TO SPECIFICATIONS.
 - REFER TO LANDSCAPE DWG 5 FOR DETAILED LAYOUT.
 - SEATING BENCHES TO BE RELOCATED FROM EXISTING SCHOOL 26 RESERVED.
 - THE NEW CONC. CURB INTO EXISTING CURBING.
 - REIN. CONC. SLAB TO EXTEND TO EXISTING EDGE OF ROAD PER MUNIC. STD.
 - REMOVE EXISTING STREET CURB & GUTTER 3 REGD FOR NEW WORK.
 - DOWN RASSED CONCRETE RIPPLE STRIP.
 - PROPOSED NEW FIRE HYDRANT LOCATION COORD WITH CIVIL DWGS.
 - ROUGH-IN FOR FUTURE SITE ELECTRIC VEHICLE CHARGING STATION REFER TO ELECT SITE PLAN.
 - PORTABLE CLASSROOMS INCLUDED ON CONTRACT BY CASH ALLOWANCE.

- GENERAL NOTES:**
- THE "LIMITS OF CONSTRUCTION" SHALL BE ASSUMED TO BE THE PROPERTY LINE UNLESS OTHERWISE NOTED.
 - FIRE ACCESS ROUTE TO BE POSTED AND DESIGNATED UNDER MUNICIPAL BY-LAW FIRE ACCESS ROUTE TO BE MIN. 4m WIDE WITH A MIN. 12m CENTRELINE TURNING RADIUS AND MAX. 4% SLOPE.
 - COORD. W/ CIVIL DRAWINGS FOR PROPOSED FINAL FINISH GRADE ELEV'S, DRAINAGE SLOPES & PROPOSED SITE SERVICES.
 - TYP. DRIVEWAY & PARKING LOT CONC. CURBS AS INDICATED ON DRAWING. COORD. W/ OPSD DETAILS & CIVIL DRAWINGS FOR EXISTING CURB TYPES. SITE DIMENSIONS ARE TYPICALLY DIMENSIONED TO FACE OF CURB.
 - THE SUB-GRADE SOILS EXPOSED AFTER EXCAVATION SHALL BE INSPECTED AND CERTIFIED BY A QUALIFIED REGISTERED PROFESSIONAL SOILS ENGINEER AND A COPY OF THE REPORT SHALL BE FORWARDED TO THE MUNICIPALITY.
 - ALL FILL PLACED ON THE SITE SHALL BE COMPACTED TO A MINIMUM OF 98-100% STANDARD PROCTOR DENSITY. A SUFFICIENT NUMBER OF TESTS SHALL BE TAKEN AT VARIOUS LEVELS OF THE SITE TO BE SATISFACTORY TO THE DIRECTOR OF ENGINEERING. TEST RESULTS SHALL BE SENT TO CITY OF WINDSOR WITH A LETTER, SIGNED AND STAMPED BY THE SOILS ENGINEER, STATING THAT A SUFFICIENT NUMBER OF TESTS HAVE BEEN TAKEN AND THE MINIMUM DEGREE OF COMPACTION HAS BEEN REACHED.
 - APPROVAL OF THIS DRAWING IS FOR MATERIAL ACCEPTABILITY AND COMPLIANCE WITH MUNICIPAL AND PROVINCIAL SPECIFICATIONS AND STANDARDS ONLY. APPROVAL AND INSPECTION BY THE CITY OF WINDSOR DOES NOT CARRY THE LINE AND GRADE OF THE WORKS AND IT IS THE OWNER'S RESPONSIBILITY TO HAVE THEIR ENGINEER CERTIFY THIS ACCORDINGLY.
 - SITUATION CONTROL DEVICES SHALL BE INSTALLED PRIOR TO WORKS COMMENCING ON THE SITE AND SHALL BE MAINTAINED FOR THE DURATION OF CONSTRUCTION, TO THE SATISFACTION OF THE TOWN OF MILTON. (COORD. W/ OPSD DETAILS).
 - PROJECT SIGN TO BE ERRECTED @ BEGINNING OF PROJECT. COORD. W/ DETAIL FOR PROJECT SIGN. LOCATION TO BE COORDINATED WITH ARCHITECT ON SITE. (DETAILS 3 & 4 ON A1.4).
 - PROVIDE HEAVY DUTY (HD) ASPHALT @ ALL DRIVEWAYS. PROVIDE MEDIUM DUTY (MD) ASPHALT @ ALL PARKING SPACES. PROVIDE LIGHT DUTY (LD) ASPHALT @ ALL PLAYGROUND & WALKWAY AREAS ONLY (UNLESS SPECIFICALLY NOTED OTHERWISE).
 - CONTRACTOR IS RESPONSIBLE FOR PLANTINGS, SOD, WATERING, FERTILISING & MAINTENANCE UNTIL SUBSTANTIAL PERFORMANCE IS ACHIEVED. THE WARRANTY PERIOD WILL COMMENCE UPON SUBSTANTIAL PERFORMANCE OF THIS WORK. COORDINATE WITH LANDSCAPE DRAWINGS & SPECIFICATIONS.

- SITE SIGNAGE LEGEND:**
- (A) STOP SIGN
 - (B) ONE WAY
 - (C) BARRIER-FREE PARKING
 - (D) FIRE ROUTE STATING FIRE ROUTE TO BE POSTED AND DESIGNATED UNDER MUNICIPAL BY-LAW
 - (E) NO RIGHT TURN
 - (F) NO LEFT TURN
 - (G) DO NOT ENTER
 - (H) SCHOOL BUS PARKING ONLY
 - (I) TEMP. PARKING ONLY - DROP OFF AREA
 - (J) NO PARKING - FIRE ROUTE

- NOTE:**
- CONFIRM LOCATIONS & CONTENT OF ALL SIGNAGE W/ THE OWNER & MUNICIPALITY PRIOR TO FABRICATION & ERECTION. PROPOSED SITE SIGNAGE TO COMPLY W/ SIGNAGE BY-LAWS.
 - ALL SIGNS TO BE LOCATED NOT TO CREATE A HAZARD ON WALKWAYS AND BE CENTERED ON POSTS TYP.

- HATCH IDENTIFICATION MARKER LEGEND**
- AREA OF ASPHALT
 - H.D. = HEAVY DUTY
 - M.D. = MEDIUM DUTY
 - PAINTED ROAD MARKINGS
 - PROPOSED NEW BUILDING
 - PROPOSED SOD

NOTE:
COORD. W/ EX. SITE SURVEY DWG. FOR THEIR LEGEND & OBJECT DEPICTION NOTATIONS

- SITE PLAN LEGEND:**
- ENTRANCE / EXIT @ GRADE FLUSH W/ INT. FIN. FLOOR
 - ENTRANCE / EXIT - W/ BARRIER FREE DOOR OPERATOR (COORD. W/ ELEC. DWG. S)
 - PROPERTY LINES / BOUNDARY
 - BY-LAW SET BACKS
 - PTD. WHEELCHAIR SIGN ON ASPHALT
 - FD. WHEELCHAIR SIGN ON ASPHALT PAVEMENT
 - BOLLARD - REFER TO DETAIL 2/A1.3
 - REMOVABLE BOLLARD - REFER TO SPECIFICATIONS
 - BICYCLE RACK - REFER TO SPECIFICATIONS
 - PROPOSED PROJECT SIGN (COORD. W/ 3/A1.4)
 - SIGNAGE (COORD. W/ SIGNAGE SCH.)
 - FLAG POLE (COORD. W/ 1/A1.3)
 - DC - DROPPED CURB (COORD. W/ OPSD-310.030)
 - PROVIDE TACTILE WARNINGS IN ALL DROPPED CURBS
 - SWALE - COORDINATE WITH CIVIL DWGS.
 - EX. TREE TO REMAIN TYP.
 - A 5m X 5m VISIBILITY TRIANGLE MUST BE MAINTAINED (REMAIN CLEAR) AT BOTH SIDES OF ALL INTERSECTION OF VEHICULAR TRAFFIC ACCESS ROADS / DRIVEWAYS. THE MAX. HEIGHT OF ANY OBJECT OR MATURE VEGETATION WITHIN THE VISIBILITY TRIANGLE IS NOT TO EXCEED 0.6m ABOVE THE CENTRELINE OF THE CORRESPONDING ADJACENT STREET.
 - PROPOSED/EX. CATCH BASIN - COORD. W/ CIVIL DWGS
 - PROPOSED/EX. CATCH BASIN - MAN-HOLE - COORD. W/ CIVIL DWGS
 - PROPOSED/EX. MAN-HOLE - COORD. W/ CIVIL DWGS
 - PROPOSED/EX. SANITARY MAN-HOLE - COORD. W/ CIVIL DWGS
 - NEW FIRE HYDRANT LOCATION
 - PROPOSED SIAMISE / FIRE DEPARTMENT CONNECTION
 - LIGHT STD. (COORD. W/ ELEC. SITE PLAN)
 - LIGHT STD. (COORD. W/ ELEC. SITE PLAN)
 - HYDRO VALVE/TRANSFORMER ON CONC. PAD
 - PROVIDE TACTILE BOLLARDS - REFER TO NOTE 15 (COORD. W/ ELEC. SITE PLAN)
 - GAS METER - REFER TO 9/A1.3 FOR ENCLOSURE DETAIL
 - RAISED CONCRETE RIPPLE STRIP

- GENERAL NOTES -MUNICIPAL**
- ALL WORK INVOLVED IN THE CONSTRUCTION, RELOCATION, REPAIR OF MUNICIPAL SERVICES FOR THE PROPOSED DEVELOPMENT SHALL BE TO THE SATISFACTION OF THE MUNICIPALITY.
 - STREET EXCAVATION PERMITS ARE REQUIRED FOR ANY WORK IN MUNICIPAL RIGHT OF WAY BY ANY CONTRACTOR.
 - CONTRACTOR IS RESPONSIBLE FOR ALL SERVICING, UTILITIES, AND COSTS.
 - STORM WATER DRAINAGE MUST NOT HAVE A NEGATIVE IMPACT ON ADJACENT PROPERTIES.
 - FIRE ROUTE SIGNS AND 3-WAY FIRE HYDRANTS SHALL BE ESTABLISHED TO THE SATISFACTION OF THE FIRE DEPARTMENT AND AT THE EXPENSE OF THE CONTRACTOR.
 - ALL DRIVEWAYS FROM PROPERTY LINES FOR THE FIRST 7.5 M SHALL BE WITHIN 2% MAXIMUM GRADE. THEREAFTER, ALL DRIVEWAYS SHALL BE WITHIN 10% MAXIMUM GRADES.
 - THE MUNICIPAL APPROVAL OF THIS SITE PLAN DOES NOT EXEMPT THE CONTRACTOR FROM THE REQUIREMENTS TO OBTAIN THE VARIOUS PERMITS/APPROVALS NORMALLY REQUIRED TO COMPLETE THE CONSTRUCTION PROJECT, SUCH AS, BUT NOT LIMITED TO THE FOLLOWING:
 - BUILDINGS PERMIT
 - SEWER AND WATER PERMITS
 - ROAD CUT PERMITS
 - RELOCATION OF SERVICES
 - APPROACH APPROVAL PERMITS
 - ENCROACHMENT AGREEMENTS
 - COMMITTEE OF ADJUSTMENT
 - ANY ABANDONED ACCESSSES MUST BE REMOVED AND THE CURB AND BOULEVARD RESTORED WITH SOD AT THE CONTRACTORS EXPENSE TO THE SATISFACTION OF THE MUNICIPALITY.

DISCLAIMER:
ALL EXISTING SURVEY INFORMATION WAS PROVIDED BY CALLON DIZ INC. O.L.S. IN THE FORM OF AN ELECTRONIC DRAWING FILE OF: PROJECT NO. 20-23714, PLAN NO. E-1264, DATED DEC. 23, 2020

REFERENCE NOTE:
FOR OTHER SITE CONDITIONS, EX. TO REMAIN OR NEW TO BE PROVIDED, THIS DRAWING IS TO BE READ IN CONJUNCTION WITH DWG. #C1 - SITE - REMOVAL PLAN, DWG. #C2 - SITE GRADING PLAN & DWG. #C3 - SITE SERVICING PLAN PREPARED BY - TRITON ENGINEERING SERVICES LTD. DWG. # E1.1 - OVERALL SITE PLAN PREPARED BY DEI CONSULTING ENGINEERS, DWG. #11.0 - ELECTRICAL LANDSCAPE PLAN PREPARED BY GSP

LIGHTING NOTE:
LIGHTING MUST BE DIRECTED ON SITE AND MUST NOT SPILL OVER TO ADJACENT PROPERTIES OR STREETS. PROVIDE "HOUSE SHIELDS" WHERE NEEDED, TO COMPLETELY ELIMINATE GLARE TO ADJACENT PROPERTIES

BENCHMARK:
ELEVATIONS ARE GEODETIC AND OBTAINED FROM FILE PROVIDED BY: BY L.L. MAUGHAN COMPANY LTD. O.L.S. IN THE FORM OF AN ELECTRONIC DRAWING FILE OF: PROJECT NO. 17219, PLAN NO. MCD-2856, DATED SEPT. 26, 2017

DEVELOPMENT DETAILS:		
PROPERTY:	REGISTERED PLAN 171 TOWN OF PARRY SOUND, ONTARIO	
ADDRESS:	111 ISABELLA STREET, PARRY SOUND, ONTARIO	
ZONING	TOWN OF PARRY SOUND BYLAW 8600	INSTITUTIONAL
LOT AREA	PER BYLAW	PROJECT
	-460 sq m	7.9 ha (19.52 Ac.)
BUILDING COVERAGE (m2)	MAX 45%	TOTAL 6,140 m2
		7.8 %
LANDSCAPED AREA (m2)		7,236 m2 - 9.15%
ASPHALT - HARD SURFACED AREA (m2)	INCL. ASPHALT, CURBS, SIDEWALKS	10,263 m2 - 13%
MIN. FRONT YARD	7.5m	6.3 m
MIN. EXTERIOR SIDE YARD	3 m	12.9 m
MIN. INTERIOR SIDE YARD	6 m	214.58 m
MIN. REAR YARD	10 m	30 m
MAX. BUILDING HEIGHT	10.5 m	9.8 m
OBC BUILDING AREA		6,255 m²
TOTAL GROSS AREA	TOTAL 2 STOREYS	9,785 m²
PARKING REQUIREMENTS		
MIN. SIZE OF PARKING STALLS PERPENDICULAR	COMMITTEE OF ADJUSTMENT Minor Variance Application No. A21-03 -111	PROVIDED IN PROJECT
	2.8m WIDE x 6m LONG	2.8m WIDE x 6 m LONG
PARKING SPACES REQUIRED	298 TOTAL	298 PARKING SPACES PROVIDED
BF- PARKING SPACES REQUIRED	4 - TYPE A : 3.4 x 5.8m 4 - TYPE B : 2.4 x 5.8 m PER AODA	12 BARRIER FREE SPACES PROVIDED 6 - TYPE A : 3.4 x 6 m 6 - TYPE B : 2.8 x 6 m
BICYCLE PARKING	1PER 10 REQUIRED PARKING SPOIS	MIN. 30 BICYCLE SPACES TO BE PROVIDED
TYPE OF DEVELOPMENT - K-12 SCHOOL & CHILDCARE		
BUILDING CLASSIFICATION	GROUP A, DIV. 2 OBC CLASSIFICATION - 3.2.2.24 UP TO 6 STOREYS, ANY AREA SPRINKLERED	

REVISIONS		
NO.	DATE	PARTICULAR
1	2022.04.06	ISSUED FOR 80% CLASS B COSTING
2	2022.06.18	ISSUED FOR SPA
3	2022.09.22	ISSUED FOR OWNERS REVIEW - RES SET
4	2022.12.16	ISSUED FOR 2ND SPA SUBMISSION
5	2023.01.31	ISSUED FOR TENDER
6	2023.02.22	ISSUED FOR ADDENDUM 9
7	2023.03.23	ISSUED FOR CONVENIENCE
8	2023.11.20	ISSUED FOR PERMIT COMMENTS
9	2024.01.24	ISSUED FOR SHED3
10	2024.02.15	ISSUED FOR PCH4038
11	2024.03.04	ISSUED FOR PCH4039
12	2024.03.10	ISSUED FOR SH404
13	2024.03.14	ISSUED FOR SH406
14	2024.07.22	ISSUED FOR SH408
15	2024.08.07	ISSUED FOR SH409
16	2024.10.02	ISSUED FOR PCH415
17	2025.04.11	ISSUED FOR PCH419
18	2025.05.01	ISSUED FOR CO4057
19	2025.05.28	ISSUED FOR PCH420 - CO4010
20	2025.07.31	ISSUED FOR SH413
21	2025.08.06	ISSUED FOR SH414
22	2025.08.15	ISSUED FOR PCH425 - CO4017
23	2025.08.25	ISSUED FOR PCH426 - CO4021
24	2025.09.02	ISSUED FOR PCH429
25	2025.09.02	ISSUED FOR SH420 - CO4018
26	2025.09.08	ISSUED FOR PCH431
27	2025.09.09	ISSUED FOR PCH432 - CO4022
28	2025.09.10	ISSUED FOR PCH433
29	2025.09.11	ISSUED FOR SH422
30	2025.09.15	ISSUED FOR SH423
31	2025.09.16	ISSUED FOR PCH 435 - CO4023
32	2025.09.30	ISSUED FOR PCH437 - CO4019
33	2025.10.03	ISSUED FOR PCH 438 - CO4025
34	2025.10.04	ISSUED FOR PCH 439 - CO4024
35	2025.10.20	ISSUED FOR PCH 439
36	2025.10.30	ISSUED FOR PCH4041
37	2025.10.23	ISSUED FOR PCH 442
38	2025.11.21	ISSUED FOR PCH4021/81 - CO12 CO4039
39	2025.11.14	ISSUED FOR PCH4043
40	2025.11.26	ISSUED FOR PCH4048
41	2025.12.03	ISSUED FOR PCH4044 - CO4026
42	2026.02.04	ISSUED FOR RECORD SET UP TO CO4027

NOTES:

KEY PLAN:




CLIENT:
NEAR NORTH DISTRICT SCHOOL BOARD
NDSB Tender # 2023-015

PROJECT:
NEW PARRY SOUND K-12 SCHOOL & CHILDCARE

PARRY SOUND HIGH SCHOOL SITE

111 ISABELLA STREET
PARRY SOUND, ONTARIO


ORIGINAL PAGE SIZE ARCH E1 - 30" x 42"
KEY TO DETAIL LOCATION:
A - DETAIL NO.
B - DETAIL NO. ORIGIN

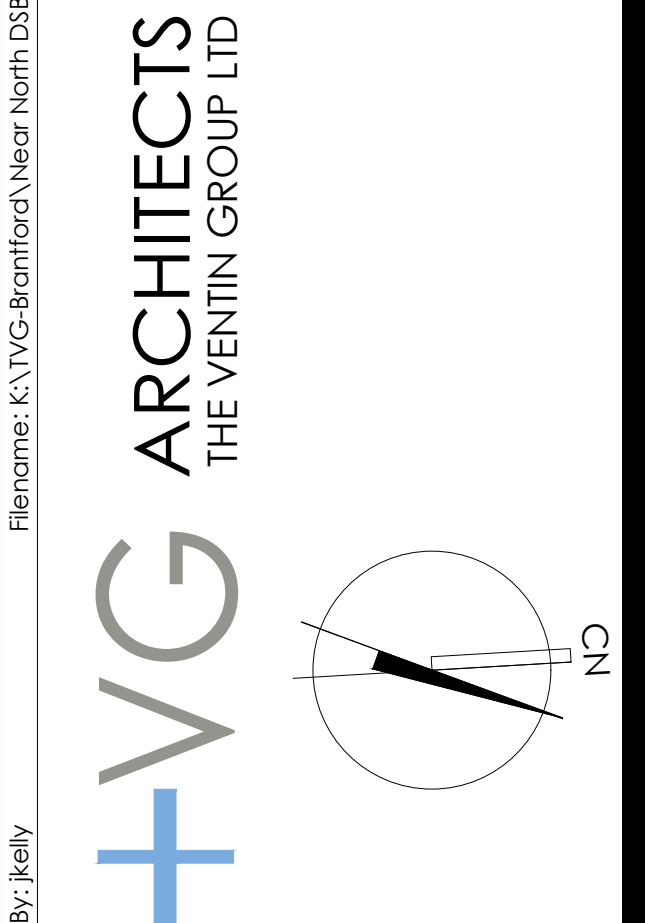

ARCHITECTURAL SITE PLAN

A1.1

Plot Date: Feb 03, 2026 - 5:05pm By: Jkely
DRAWN BY: EB
CHECKED BY: PS

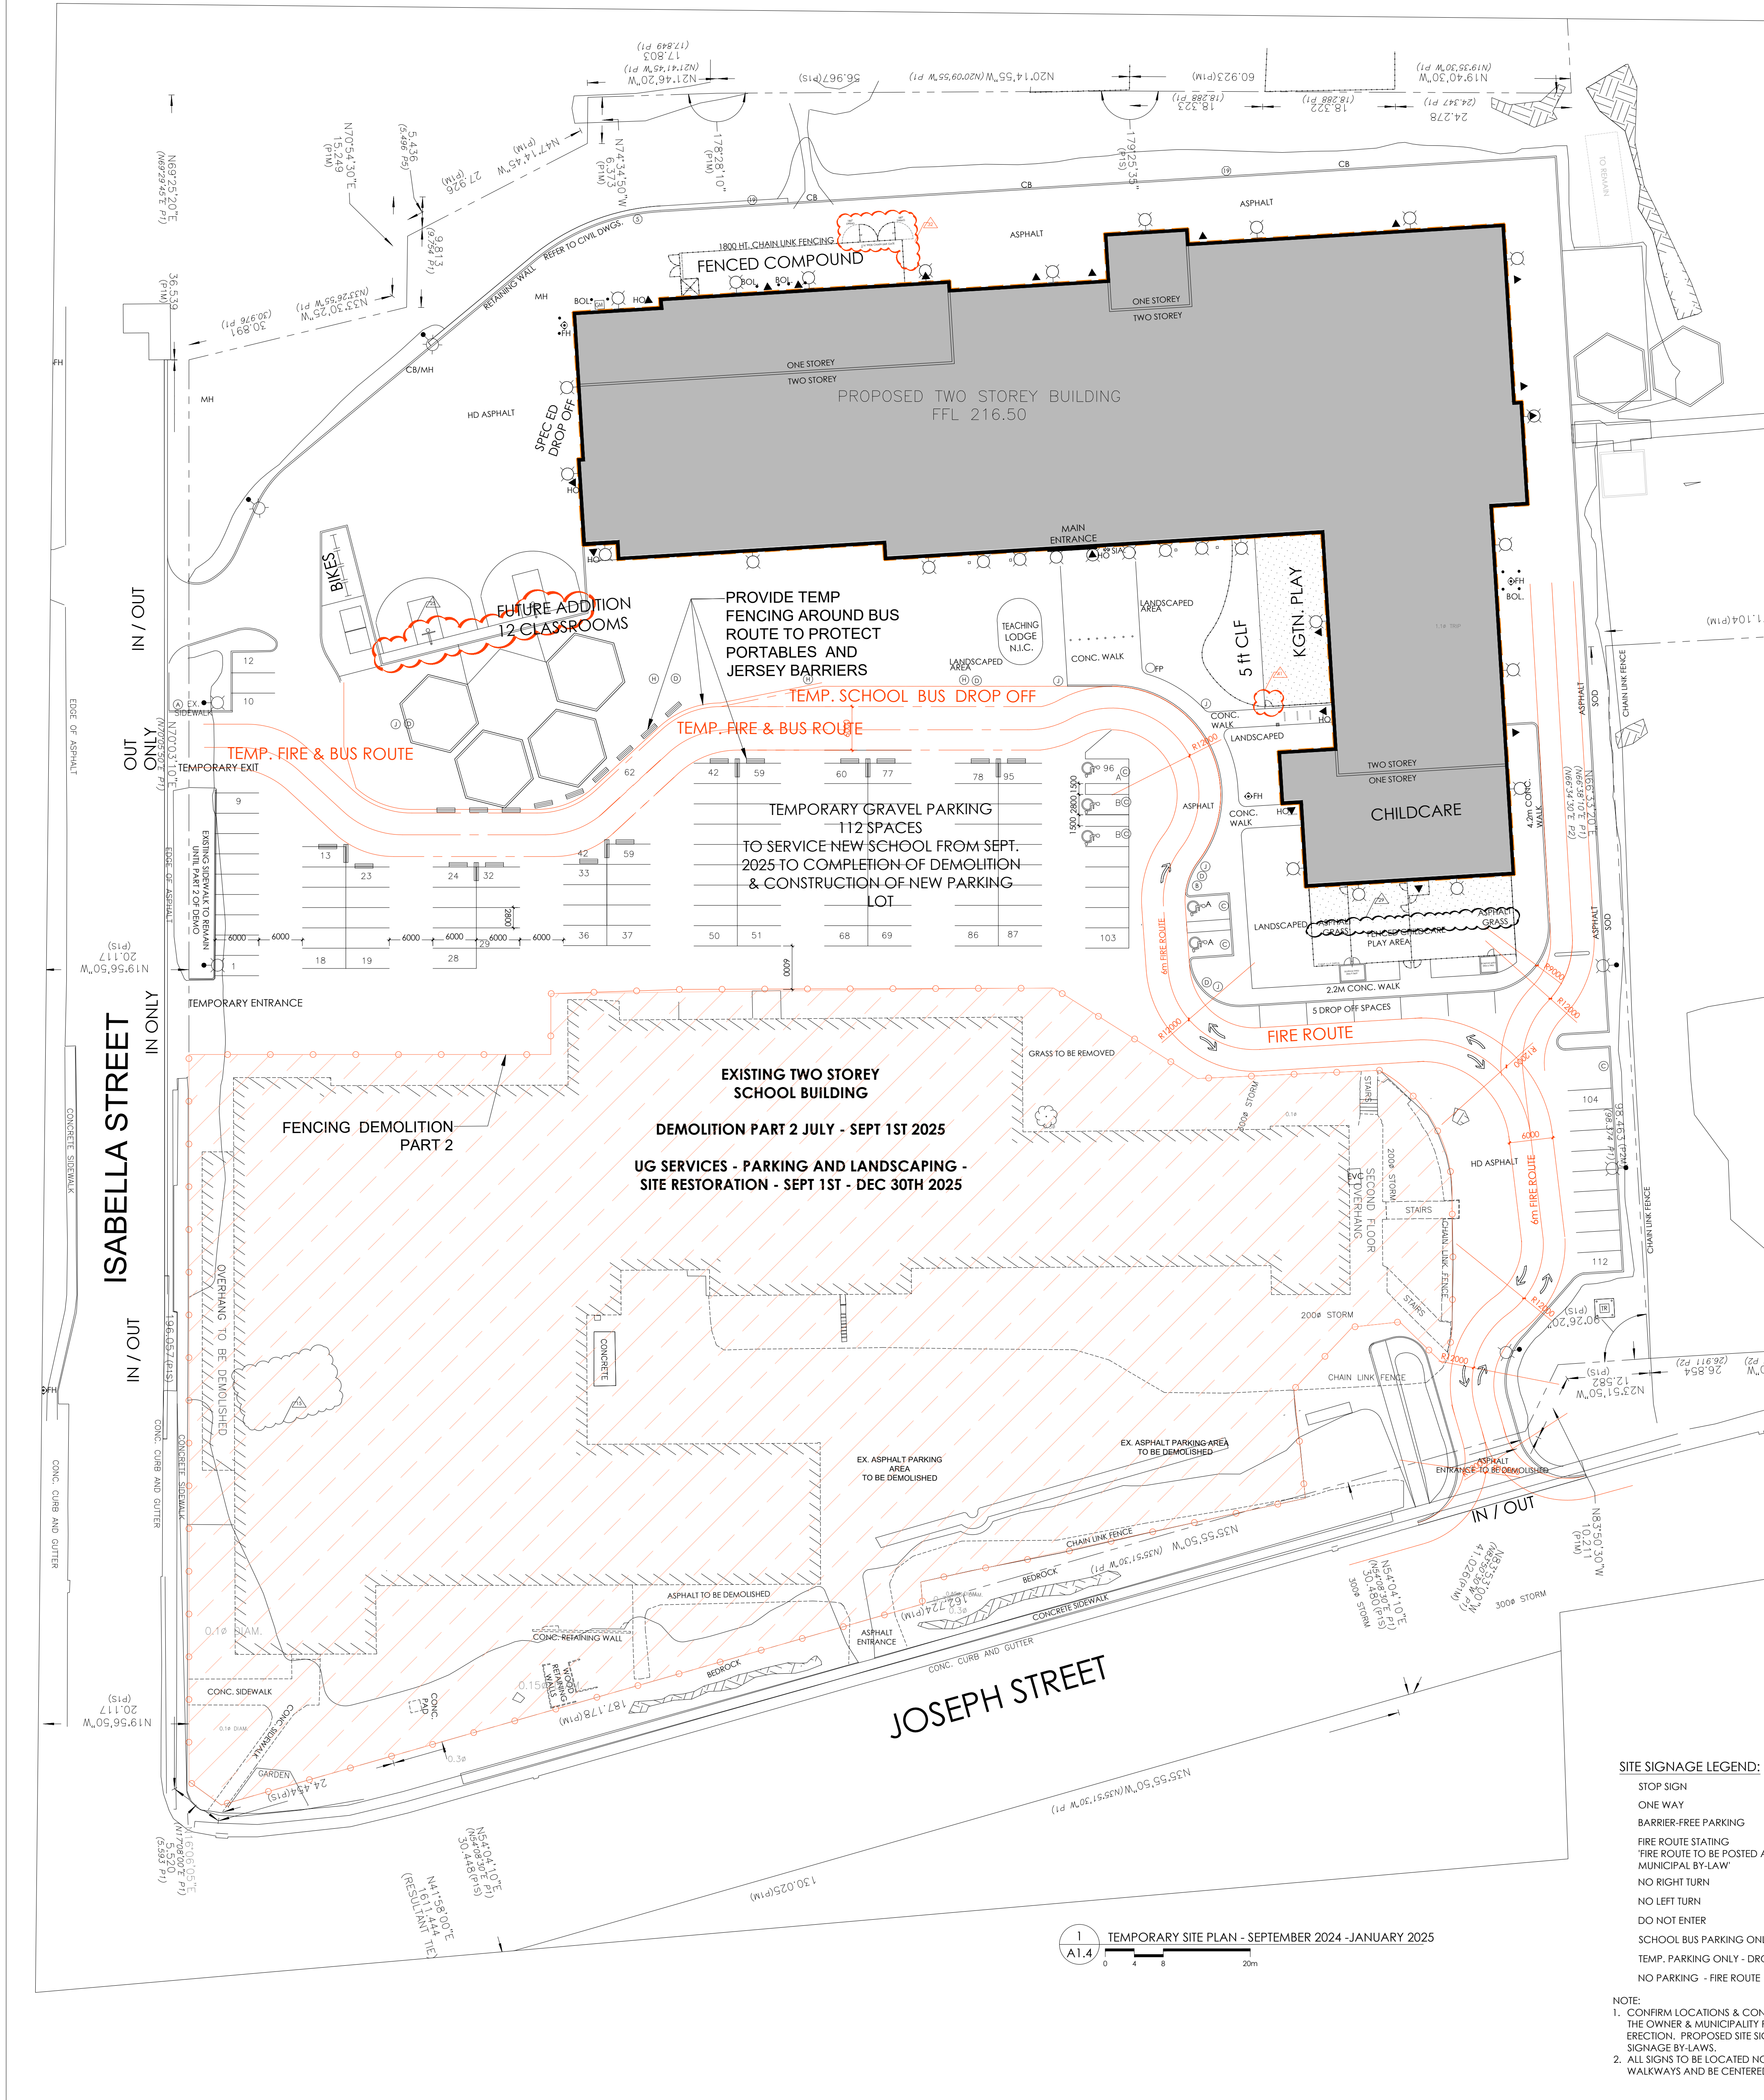

SITE SIGNAGE LEGEND:

STOP SIGN
ONE WAY
BARRIER-FREE PARKING
FIRE ROUTE STATING
FIRE ROUTE TO BE POSTED AND DESIGNATED UNDER MUNICIPAL BY-LAW
NO RIGHT TURN
NO LEFT TURN
DO NOT ENTER
SCHOOL BUS PARKING ONLY
TEMP. PARKING ONLY - DROP OFF AREA
NO PARKING - FIRE ROUTE

NOTE:

1. CONFIRM LOCATIONS & CONTENT OF ALL SIGNAGE W/ THE OWNER & MUNICIPALITY PRIOR TO FABRICATION & ERECTION. PROPOSED SITE SIGNAGE TO COMPLY W/ SIGNAGE BY-LAWS.
2. ALL SIGNS TO BE LOCATED NOT TO CREATE A HAZARD ON WALKWAYS AND BE CENTERED ON POSTS TYP.

GENERAL NOTES:

- THE LIMITS OF CONSTRUCTION/DEMOLITION SHALL BE ASSUMED TO BE THE PROPERTY LINE UNLESS OTHERWISE NOTED.
- FIRE ACCESS ROUTE TO BE POSTED AND DESIGNATED UNDER MUNICIPAL BY-LAW (FIRE ACCESS ROUTE TO BE MIN. 6m WIDE WITH A MIN. 12m CENTRELINE TURNING RADIUS) TO PROVIDE ACCESS FROM ANYONE NOT ENGAGED IN THE WORK OF THIS DEMOLITION / CONST. SCOPE / PROVIDE CONST. GATES / FENCES / BOUNDARIES AS SHOWN / REF. TO TOWN OF PARRY SOUND REQUIREMENTS.
- CONTRACTOR TO SECURE THE WORK SITE DURING DEMO & CONST. & HOURS OF THE WORK AREA TO PREVENT ACCESS FROM ANYONE NOT ENGAGED IN THE WORK OF THIS DEMOLITION / CONST. SCOPE / PROVIDE CONST. GATES / FENCES / BOUNDARIES AS SHOWN / REF. TO TOWN OF PARRY SOUND REQUIREMENTS.
- CONTRACTOR TO OBTAIN LOCATES FOR ALL UNDERGROUND & O/H SERVICES ON BOTH EX. & NEW LOCATES PRIOR TO ANY DIGGING / EXCAVATION / WORK (COORD. W/ SITE SERVICE & EX. SITE SURVEY DWG. S).
- CONTRACTOR TO INCLUDE REMOVAL AND TERMINATION OR RELOCATION OF ANY EX. SERVICES CONNECTED TO THE EXISTING BUILDING & LOCATED IN SCOPE OF WORK TO BE DEMOLISHED IN PHASE 1 INCLUDING ANY NECESSARY PERMITS OR UTILITY FEES.
- GC IS RESPONSIBLE FOR REMOVAL & DISPOSAL OF ALL MATERIALS THAT ARE DEMOLISHED. ALL COSTS ARE PART OF BASE BID SUBMISSION IN ACCORDANCE W/ BEST CONSTRUCTION PRACTICE. ORC, MUNICIPAL & PROVINCIAL LEGISLATION REGARDING DEMOLITION & DISPOSAL METHODS RECYCLE ALL MATERIALS WHERE AVAILABLE AS SPECIFIED.
- PERFORM ALL REQUIRED HAZARDOUS MATERIALS REMOVALS & ABATEMENT AS PART OF THIS WORK. REFER TO THE DESIGNATED SUBSTANCE SURVEY BY PINCHN, DATED FEB. 7TH, 2018.
- IF ANY HAZARDOUS MATERIAL IS DISCOVERED IN SOILS, MEDIANE THE EXISTING SOIL AS REQUIRED UNDER CASH ALLOWANCE FOR UNKNOWN HAZARDOUS MATERIALS. PROVIDE UNIT RATES FOR THIS WORK PER m² FOR REMOVAL, DISPOSAL & REPLACEMENT WITH NEW BACKFILL TO SPECIFIED FINISHED GRADE W/ GRANULAR B' & COMPACTED TO 100% STANDARD PROCTOR (B' HARD SURFACE AREAS, SOFT AREAS USE EXCAVATION & NATIVE DIRT MATERIALS). ALL BACK SLOPES TO BLEND INTO EX. TO A MAX. SLOPE OF 1:2 TO PREVENT PONDING. INSTALL 200mm MIN. TOPSOIL AT ALL VEGETATION AREAS. ANY AREAS OF BARE TOPSOIL TO BE GRADED LEVEL & COVERED W/ SEED.
- NO RUBBLE OF ANY NATURE TO BE LEFT IN PLACE OR BE USED AS BACKFILL. THIS INCLUDES ALL REBAR, STEEL, METAL, WOOD & OTHER DEBRIS MATERIALS REMAINING FROM DEMOLITION PROCESS ETC.
- ALL DISTURBED AREAS & HOLES CREATED BY EXCAVATION DURING DEMOLITION TO BE BACKFILLED TO SPECIFIED FINISHED GRADE W/ GRANULAR B' & COMPACTED TO 100% STANDARD PROCTOR. ALL BACK SLOPES TO BLEND INTO EX. TO A MAX. SLOPE OF 1:2 TO PREVENT PONDING.
- WHERE NOTED INSTALL MIN. 100mm MIN. TOPSOIL AT ALL SOD AREAS TO BE RESTORED; ANY AREAS OF BARE TOPSOIL TO BE GRADED LEVEL & COVERED W/ SEED.
- PROTECT ALL EX. TREES / VEGETATION TO REMAIN AS SHOWN ON DEMOLITION PLAN & INSTALL TREE PROTECTION MEASURES: PROTECTION TO STAY IN PLACE AFTER COMPLETION OF PHASE 1 DEMOLITION, REPLACE ANY DAMAGED OR DISTURBED TREES CAUSED BY THIS DEMO/WORK.
- DO NOT DISTURB ANY ITEMS BEYOND THIS BOUNDARY OR ONTO MUNICIPAL PROPERTY OR THAT ARE NOT INDICATED (REPAIR & MAKE GOOD WHERE REQ'D TO PROVIDE CLEAN TRANSITIONS TYP.)
- THESE NOTES APPLY TO DEMOLITION WITHIN THE PROPERTY / BOUNDARY OF PHASE 1 SCOPE OF DEMOLITION WORK AREA UNLESS NOTED OTHERWISE. IT IS THE INTENT THAT FOLLOWING DEMOLITION PROCEDURES OUTLINED IN DEMOLITION DWG. S & THE REMOVAL OF ALL EX. BLDG. STRUCTURES & SITE ELEMENTS ABOVE & BELOW GRADE INCLUDING UTILITIES & MUNICIPAL & SITE SERVICES THAT THE RESULTING SITE CONDITIONS, REFER TO CIVIL, MECHANICAL & ELECTRICAL DRAWINGS FOR DISCONNECTION, REMOVAL & CAPPING OF EXISTING SERVICES.
- TYPICAL FOR ALL DEMOLITION SHALL INCLUDE REMOVAL & OFF-SITE DISPOSAL, CONFORMING TO MINISTRY AND LOCAL MUNICIPAL REQUIREMENTS.
- FINISHED GRADING & DRAINAGE AT COMPLETION OF DEMOLITION WORK SHALL BE PERFORMED AS PER THE CIVIL GRADING PLAN DWG. C1.1.
- PROVIDE MUD-MAT CONSTRUCTION ENTRANCES TO TOWN OF PARRY SOUND REQUIREMENTS
- ALL MISCELLANEOUS BUILDING MUST FIRST BE COMPLETELY DISCONNECTED FROM ANY MECHANICAL OR ELECTRICAL SERVICE BEFORE DEMOLITION.

BEFORE STARTING WORK

- THE CONTRACTOR SHALL NOTIFY THE TOWN OF PARRY SOUND, ARCHITECT & CONSULTANTS AT LEAST 48 HOURS PRIOR TO COMMENCING DEMOLITION & CONSTRUCTION.
- THE POSITION OF THE POLE LINES, CONDUITS, WATER MAINS, SEWERS, AND OTHER UTILITIES AND STRUCTURES ARE NOT NECESSARILY SHOWN ON THE CONTRACT DRAWINGS, AND WHERE SHOWN, THE ACCURACY OF THE POSITION OF SUCH UTILITIES AND STRUCTURES IS NOT GUARANTEED. CONTRACTOR TO VERIFY EXISTING CONDITIONS.
- ALL EXISTING UNDERGROUND UTILITIES WITHIN THE LIMITS OF CONSTRUCTION SHALL BE LOCATED, MARKED AND PROTECTED. ANY UTILITIES DAMAGED OR DISTURBED DURING CONSTRUCTION SHALL BE REPAIRED OR REPLACED TO THE SATISFACTION OF THE ENGINEER, AT THE CONTRACTOR'S EXPENSE.
- PRIOR TO THE COMMENCEMENT OF CONSTRUCTION, ALL BENCHMARKS, ELEVATIONS, DIMENSIONS, AND GRADES MUST BE CHECKED BY THE CONTRACTOR AND ANY DISCREPANCIES REPORTED TO THE ENGINEER.
- AT LEAST TWO DIFFERENT BENCHMARKS MUST BE REFERRED TO AT ALL TIMES.

BEFORE STARTING WORK

- THE CONTRACTOR SHALL NOTIFY THE TOWN OF PARRY SOUND, ARCHITECT & CONSULTANTS AT LEAST 48 HOURS PRIOR TO COMMENCING DEMOLITION & CONSTRUCTION.
- THE POSITION OF THE POLE LINES, CONDUITS, WATER MAINS, SEWERS, AND OTHER UTILITIES AND STRUCTURES ARE NOT NECESSARILY SHOWN ON THE CONTRACT DRAWINGS, AND WHERE SHOWN, THE ACCURACY OF THE POSITION OF SUCH UTILITIES AND STRUCTURES IS NOT GUARANTEED. CONTRACTOR TO VERIFY EXISTING CONDITIONS.
- ALL EXISTING UNDERGROUND UTILITIES WITHIN THE LIMITS OF CONSTRUCTION SHALL BE LOCATED, MARKED AND PROTECTED. ANY UTILITIES DAMAGED OR DISTURBED DURING CONSTRUCTION SHALL BE REPAIRED OR REPLACED TO THE SATISFACTION OF THE ENGINEER, AT THE CONTRACTOR'S EXPENSE.
- PRIOR TO THE COMMENCEMENT OF CONSTRUCTION, ALL BENCHMARKS, ELEVATIONS, DIMENSIONS, AND GRADES MUST BE CHECKED BY THE CONTRACTOR AND ANY DISCREPANCIES REPORTED TO THE ENGINEER.
- AT LEAST TWO DIFFERENT BENCHMARKS MUST BE REFERRED TO AT ALL TIMES.

SPECIFIC DEMOLITION NOTES

- REMOVE ALL ABOVE & BELOW GROUND SERVICES (UNLESS OTHERWISE NOTED TO REMAIN IN WORKING ORDER) (COORD. W/ CIVIL, MECHANICAL & ELECTRICAL DRAWINGS)
- REMOVE THE SCHOOL BUILDING & ASSOCIATED SYSTEMS WITHIN THE DEMOLITION SITE PERIMETER / PROPERTY / BOUNDARY / SCOPE OF WORK LINE INCLUDING BUT NOT LIMITED TO REINFORCED CONCRETE FOOTINGS, FOUNDATIONS, GRADE BEAMS, RETAIN. WALLS, FLOOR SLABS, STAIRS, MASONRY STEEL ROOF & STRUCTURE, RETAINING WALLS & ALL ASSOCIATED REBAR ETC.
- <NOT USED>
- <NOT USED>
- REMOVE AS NOTED EX. ASPHALT PAVEMENT, CONC. PAVEMENT, GRANULAR SURFACES, INCLUDING BUT NOT LIMITED TO WALKWAYS, SIDEWALKS, DRIVEWAYS & ASSOCIATED SYSTEMS BACK TO GRANULARS / INCLUDING ALL GRANULARS TO NATIVE SOIL.
- REMOVE EX. VEGETATION / ROOTS IN CONFLICT W/ PROPOSED LAYOUT. COMPLETELY REMOVE ROOT SYSTEMS WHICH ARE FOUND WITHIN THE PROPERTY LIMITS. DO NOT UNDERCUT PER. FENCING / HOARDING. REMOVE ONLY THAT PORTION OF TREE ROOT SYSTEMS WHICH ARE FOUND WITHIN PROPERTY LIMITS.
- EX. FENCING TO REMAIN UNLESS OTHERWISE INDICATED. ADD SILT FENCING IN FRONT OF EX. & NEW FENCING FOR SILTATION CONTROL. REFER TO SITE PLAN FOR NEW FENCING AND CONSTRUCTION FENCING.
- <NOT USED>
- REFER & COORDINATE WITH MECHANICAL & ELECTRICAL DRAWINGS FOR REMOVAL OF ABOVE & BELOW GROUND SERVICES WITHIN PHASE 1 DEMOLITION BUILDING PERIMETER AS NOTED INCLUDING RELOCATION AND RECONNECT OF EXISTING SERVICES. REFER TO CIVIL DRAWING C1.1 FOR EXISTING SERVICES BEYOND THE DEMOLISHED BUILDING PERIMETER TO BE REMOVED. RETAINED OR RECONNECTED.
- DO NOT DISTURB THE REST OF THE EX. SERVICE TO REMAIN & ENSURE IN PROPER WORKING ORDER AFTER COMPLETION OF WORK & ALL NEW LAND INFILL IS GRADED W/ PROPER DRAINAGE SLOPES TOWARD EX. SERVICES
- DISCONNECT @ THE SOURCE & ACTUAL TERMINATION LOCATION IS SUBJECT TO EX. W/ LOCAL AUTHORITY / UTILITY / CITY / TOWN HAVING JURISDICTION FOR THEIR REQ. 3 & ACTIONS OF THE ACTUAL DISCONNECT / TERMINATION / CAP LOCATION (COORD. W/ ELEC. MECH. & CIVIL DWG. S)
- <NOT USED>
- <NOT USED>

HATCH IDENTIFICATION MARKER LEGEND

- AREA OF ASPHALT
H.D. = HEAVY DUTY
M.D. = MEDIUM DUTY
- PAINTED ROAD MARKINGS
- PROPOSED NEW BUILDING
- PROPOSED SOD

NOTE:
COORD. W/ EX. SITE SURVEY DWG. FOR THEIR LEGEND & OBJECT DEPICTION NOTATIONS

SITE DEMOLITION NOTES

GENERAL DEMOLITION NOTES

- CONTRACTOR TO VERIFY ALL CONDITIONS ON SITE TO DETERMINE COMPLETE SCOPE OF WORK (COORD. W/ EX. SITE SURVEY & ALL OTHER DWG. S)
- CONTRACTOR TO SECURE THE WORK SITE DURING DEMO & CONST. & HOURS OF THE WORK AREA TO PREVENT ACCESS FROM ANYONE NOT ENGAGED IN THE WORK OF THIS DEMOLITION / CONST. SCOPE / PROVIDE CONST. GATES / FENCES / BOUNDARIES AS SHOWN / REF. TO TOWN OF PARRY SOUND REQUIREMENTS.
- CONTRACTOR TO OBTAIN LOCATES FOR ALL UNDERGROUND & O/H SERVICES ON BOTH EX. & NEW LOCATES PRIOR TO ANY DIGGING / EXCAVATION / WORK (COORD. W/ SITE SERVICE & EX. SITE SURVEY DWG. S).
- CONTRACTOR TO INCLUDE REMOVAL AND TERMINATION OR RELOCATION OF ANY EX. SERVICES CONNECTED TO THE EXISTING BUILDING & LOCATED IN SCOPE OF WORK TO BE DEMOLISHED IN PHASE 1 INCLUDING ANY NECESSARY PERMITS OR UTILITY FEES.
- GC IS RESPONSIBLE FOR REMOVAL & DISPOSAL OF ALL MATERIALS THAT ARE DEMOLISHED. ALL COSTS ARE PART OF BASE BID SUBMISSION IN ACCORDANCE W/ BEST CONSTRUCTION PRACTICE. ORC, MUNICIPAL & PROVINCIAL LEGISLATION REGARDING DEMOLITION & DISPOSAL METHODS RECYCLE ALL MATERIALS WHERE AVAILABLE AS SPECIFIED.
- PERFORM ALL REQUIRED HAZARDOUS MATERIALS REMOVALS & ABATEMENT AS PART OF THIS WORK. REFER TO THE DESIGNATED SUBSTANCE SURVEY BY PINCHN, DATED FEB. 7TH, 2018.
- IF ANY HAZARDOUS MATERIAL IS DISCOVERED IN SOILS, MEDIANE THE EXISTING SOIL AS REQUIRED UNDER CASH ALLOWANCE FOR UNKNOWN HAZARDOUS MATERIALS. PROVIDE UNIT RATES FOR THIS WORK PER m² FOR REMOVAL, DISPOSAL & REPLACEMENT WITH NEW BACKFILL TO SPECIFIED FINISHED GRADE W/ GRANULAR B' & COMPACTED TO 100% STANDARD PROCTOR (B' HARD SURFACE AREAS, SOFT AREAS USE EXCAVATION & NATIVE DIRT MATERIALS). ALL BACK SLOPES TO BLEND INTO EX. TO A MAX. SLOPE OF 1:2 TO PREVENT PONDING. INSTALL 200mm MIN. TOPSOIL AT ALL VEGETATION AREAS. ANY AREAS OF BARE TOPSOIL TO BE GRADED LEVEL & COVERED W/ SEED.
- NO RUBBLE OF ANY NATURE TO BE LEFT IN PLACE OR BE USED AS BACKFILL. THIS INCLUDES ALL REBAR, STEEL, METAL, WOOD & OTHER DEBRIS MATERIALS REMAINING FROM DEMOLITION PROCESS ETC.
- ALL DISTURBED AREAS & HOLES CREATED BY EXCAVATION DURING DEMOLITION TO BE BACKFILLED TO SPECIFIED FINISHED GRADE W/ GRANULAR B' & COMPACTED TO 100% STANDARD PROCTOR. ALL BACK SLOPES TO BLEND INTO EX. TO A MAX. SLOPE OF 1:2 TO PREVENT PONDING.
- WHERE NOTED INSTALL MIN. 100mm MIN. TOPSOIL AT ALL SOD AREAS TO BE RESTORED; ANY AREAS OF BARE TOPSOIL TO BE GRADED LEVEL & COVERED W/ SEED.
- PROTECT ALL EX. TREES / VEGETATION TO REMAIN AS SHOWN ON DEMOLITION PLAN & INSTALL TREE PROTECTION MEASURES: PROTECTION TO STAY IN PLACE AFTER COMPLETION OF PHASE 1 DEMOLITION, REPLACE ANY DAMAGED OR DISTURBED TREES CAUSED BY THIS DEMO/WORK.
- DO NOT DISTURB ANY ITEMS BEYOND THIS BOUNDARY OR ONTO MUNICIPAL PROPERTY OR THAT ARE NOT INDICATED (REPAIR & MAKE GOOD WHERE REQ'D TO PROVIDE CLEAN TRANSITIONS TYP.)
- THESE NOTES APPLY TO DEMOLITION WITHIN THE PROPERTY / BOUNDARY OF PHASE 1 SCOPE OF DEMOLITION WORK AREA UNLESS NOTED OTHERWISE. IT IS THE INTENT THAT FOLLOWING DEMOLITION PROCEDURES OUTLINED IN DEMOLITION DWG. S & THE REMOVAL OF ALL EX. BLDG. STRUCTURES & SITE ELEMENTS ABOVE & BELOW GRADE INCLUDING UTILITIES & MUNICIPAL & SITE SERVICES THAT THE RESULTING SITE CONDITIONS, REFER TO CIVIL, MECHANICAL & ELECTRICAL DRAWINGS FOR DISCONNECTION, REMOVAL & CAPPING OF EXISTING SERVICES.
- TYPICAL FOR ALL DEMOLITION SHALL INCLUDE REMOVAL & OFF-SITE DISPOSAL, CONFORMING TO MINISTRY AND LOCAL MUNICIPAL REQUIREMENTS.
- FINISHED GRADING & DRAINAGE AT COMPLETION OF DEMOLITION WORK SHALL BE PERFORMED AS PER THE CIVIL GRADING PLAN DWG. C1.1.
- PROVIDE MUD-MAT CONSTRUCTION ENTRANCES TO TOWN OF PARRY SOUND REQUIREMENTS
- ALL MISCELLANEOUS BUILDING MUST FIRST BE COMPLETELY DISCONNECTED FROM ANY MECHANICAL OR ELECTRICAL SERVICE BEFORE DEMOLITION.

DISCLAIMER:
ALL EXISTING SURVEY INFORMATION WAS PROVIDED BY CALLOW DYE INC. O.L.S. IN THE FORM OF AN ELECTRONIC DRAWING FILE OF PROJECT NO. 20-23714. PLAN NO. E-1264, DATED DEC. 23, 2020
REFERENCE NOTE:
FOR OTHER SITE CONDITIONS, EX. TO REMAIN OR DEMOLISHED TO BE PROVIDED, THIS DWG. IS TO BE READ IN CONJUNCTION W/ ELECTRICAL PLANS, PREPARED BY D.E.I. CONSULTING ENGINEERS, MECHANICAL PLANS, PREPARED BY D.E.I. CONSULTING ENGINEERS.
SITE GRADING PLAN, PREPARED BY TRITON ENGINEERING SERVICES LTD.
SITE SERVICE PLAN, PREPARED BY TRITON ENGINEERING SERVICES LTD.
EROSION & SEDIMENT CONTROL PLAN, PREPARED BY TRITON ENGINEERING SERVICES LTD.

SITE PLAN LEGEND:

- ENTRANCE / EXIT @ GRADE FLUSH W/ INT. FIN. FLOOR
- ENTRANCE / EXIT - W/ BARRIER FREE DOOR OPERATOR (COORD. W/ ELEC. DWG. S)
- PROPERTY LINES / BOUNDARY BY LAW SET BACKS
- P.T.D. WHEELCHAIR SIGN ON ASPHALT
- DIAGONAL PAINTED DIRECTIONAL ARROWS ON ASPHALT PAVEMENT
- BOL.
- RE. BOL.
- REMOVABLE BOLLARD - REFER TO SPECIFICATIONS
- BICYCLE RACK - REFER TO SPECIFICATIONS
- PROPOSED PROJECT SIGN (COORD. W/ 3(A)/4)
- SIGNAGE (COORD. W/ SIGNAGE SCH.)
- FLAG POLE (COORD. W/ 1(A)/3)
- DC - DROPPED CURB (COORD. W/ OPSD-310.033)
- PROVIDE DIRECTIONAL WARNING IN ALL DROPPED CURBS
- SWALE - COORDINATE WITH CIVIL DWGS.
- EX. TREE TO REMAIN TYP.
- A 5m x 5m VISIBILITY TRIANGLE MUST BE MAINTAINED (REMAIN CLEAR) AT BOTH SIDES OF ALL INTERSECTION OF VEHICULAR TRAFFIC ACCESS ROADS / DRIVEWAYS. THE MAX. HEIGHT OF ANY OBJECT OR NATIVE VEGETATION WITHIN THE VISIBILITY TRIANGLE IS NOT TO EXCEED 0.6m ABOVE THE CENTRELINE OF THE CORRESPONDING ADJACENT STREET.
- PROPOSED/EX. CATCH BASIN - COORD. W/ CIVIL DWGS
- PROPOSED/EX. CATCH BASIN - MAN HOLE - COORD. W/ CIVIL DWGS
- PROPOSED/EX. MAN HOLE - COORD. W/ CIVIL DWGS
- PROPOSED/EX. SANITARY MAN HOLE - COORD. W/ CIVIL DWGS
- NEW FIRE HYDRANT LOCATION
- PROPOSED SIAMSESE FIRE DEPARTMENT CONNECTION
- LIGHT STD. (COORD. W/ ELEC. SITE PLAN)
- LIGHT STD. (COORD. W/ ELEC. SITE PLAN)
- HYDRO VAULT/TRANSFORMER ON CONC. PAD PROTECTED BY BOLLARDS - REFER TO NOTE 15 (COORD. W/ ELEC. SITE PLAN)
- GAS METER - REFER TO 9(A)/3 FOR ENCLOSURE DETAIL
- RAISED CONCRETE RIPPLE STRIP

REVISIONS		
NO.	DATE	PARTICULAR
1	2022.04.06	ISSUED FOR 80% CLASS B COSTING
2	2022.06.18	ISSUED FOR SPA
3	2022.09.22	ISSUED FOR OWNERS REVIEW - RES. SET
4	2022.12.16	ISSUED FOR 2ND SPA SUBMISSION
5	2023.01.31	ISSUED FOR TENDER
6	2023.02.22	ISSUED FOR ADDENDUM 9
7	2023.08.20	ISSUED FOR CONVEINENCE
8	2023.11.20	ISSUED FOR PERMIT COMMENTS
9	2024.05.28	ISSUED FOR PERMIT
10	2024.05.28	REVISION FOR DEMOLITION PERMIT
11	2024.06.04	REVISION FOR DEMOLITION PERMIT
12	2024.06.10	ISSUED FOR PERMIT
13	2024.06.14	ISSUED FOR PERMIT
14	2024.07.22	ISSUED FOR PERMIT
15	2024.08.07	ISSUED FOR PERMIT
16	2024.10.02	ISSUED FOR PCHN15
17	2025.04.11	ISSUED FOR PCHN19
18	2025.05.01	ISSUED FOR CO407
19	2025.05.28	ISSUED FOR PCHN20 - CO4010
20	2025.07.31	ISSUED FOR 94013
21	2025.08.06	ISSUED FOR 94014
22	2025.08.15	ISSUED FOR PCHN25 - CO4017
23	2025.08.25	ISSUED FOR PCHN27 - CO4021
24	2025.09.02	ISSUED FOR PCHN29
25	2025.09.09	ISSUED FOR PCHN30 - CO4028
26	2025.09.08	ISSUED FOR PCHN31
27	2025.09.09	ISSUED FOR PCHN32 - CO4022
28	2025.09.10	ISSUED FOR PCHN33
29	2025.09.11	ISSUED FOR CO4022
30	2025.09.15	ISSUED FOR CO4023
31	2025.09.16	ISSUED FOR PCHN33 - CO4023
32	2025.09.30	ISSUED FOR PCHN37 - CO4019
33	2025.09.30	ISSUED FOR PCHN38 - CO4025
34	2025.10.04	ISSUED FOR PCHN39 - CO4024
35	2025.10.20	ISSUED FOR PCHN40
36	2025.10.30	ISSUED FOR PCHN41
37	2025.10.31	ISSUED FOR PCHN42
38	2025.11.23	ISSUED FOR PCHN43 - CO12 C2039
39	2025.11.24	ISSUED FOR PCHN43
40	2025.11.26	ISSUED FOR PCHN43
41	2025.12.03	ISSUED FOR PCHN44 - CO4027
42	2026.02.04	ISSUED FOR PCHN45 SET UP TO CO4027

NOTES:

KEY PLAN:

CLIENT:
NEAR NORTH DISTRICT SCHOOL BOARD
NDSB Tender # 2023-015

PROJECT:
NEW PARRY SOUND K-12 SCHOOL & CHILDCARE

PARRY SOUND HIGH SCHOOL SITE

111 ISABELLA STREET
PARRY SOUND, ONTARIO

ORIGINAL PAGE SIZE ARCH E1 - 30" x 42"

KEY TO DETAIL LOCATION:






A - DETAIL NO.
B - DETAIL NO. ORIGIN

ARCHITECTS
THE VENTIN GROUP LTD

+VVG

File Name: K:\TVG\Brantford\Near North DSB Parry Sound\2022\2011\Drawings\Wd\Current\NN-A1.1_SPC.dwg
Plot Date: Feb. 03, 2026 - 5:06pm by J. Kelly
DRAWN BY: EB
CHECKED BY: PS

A1.2

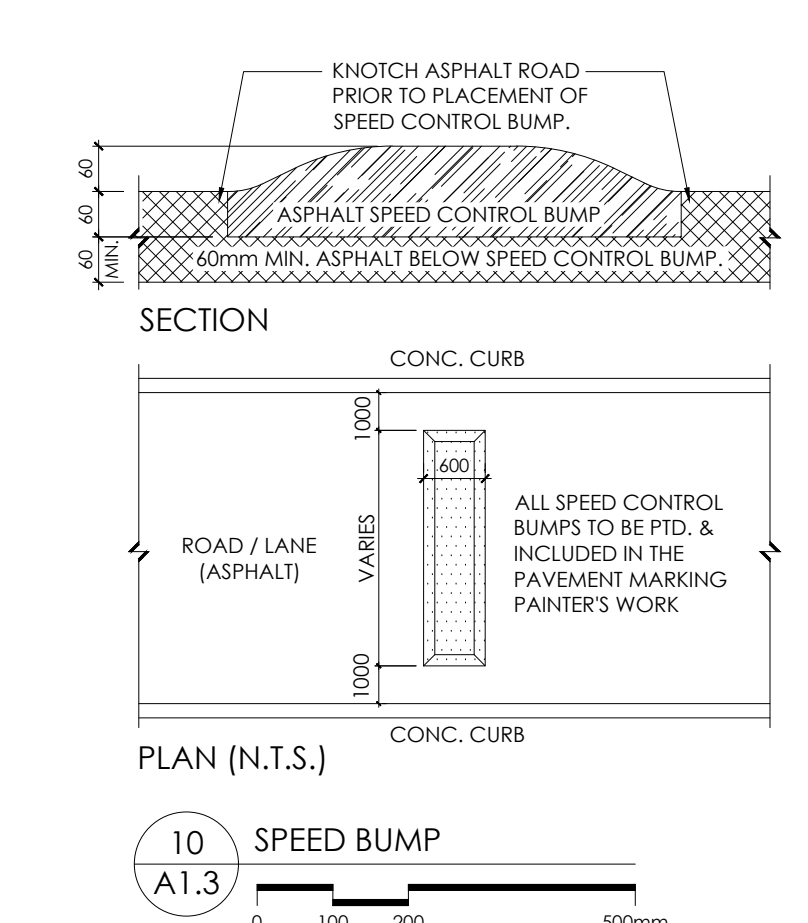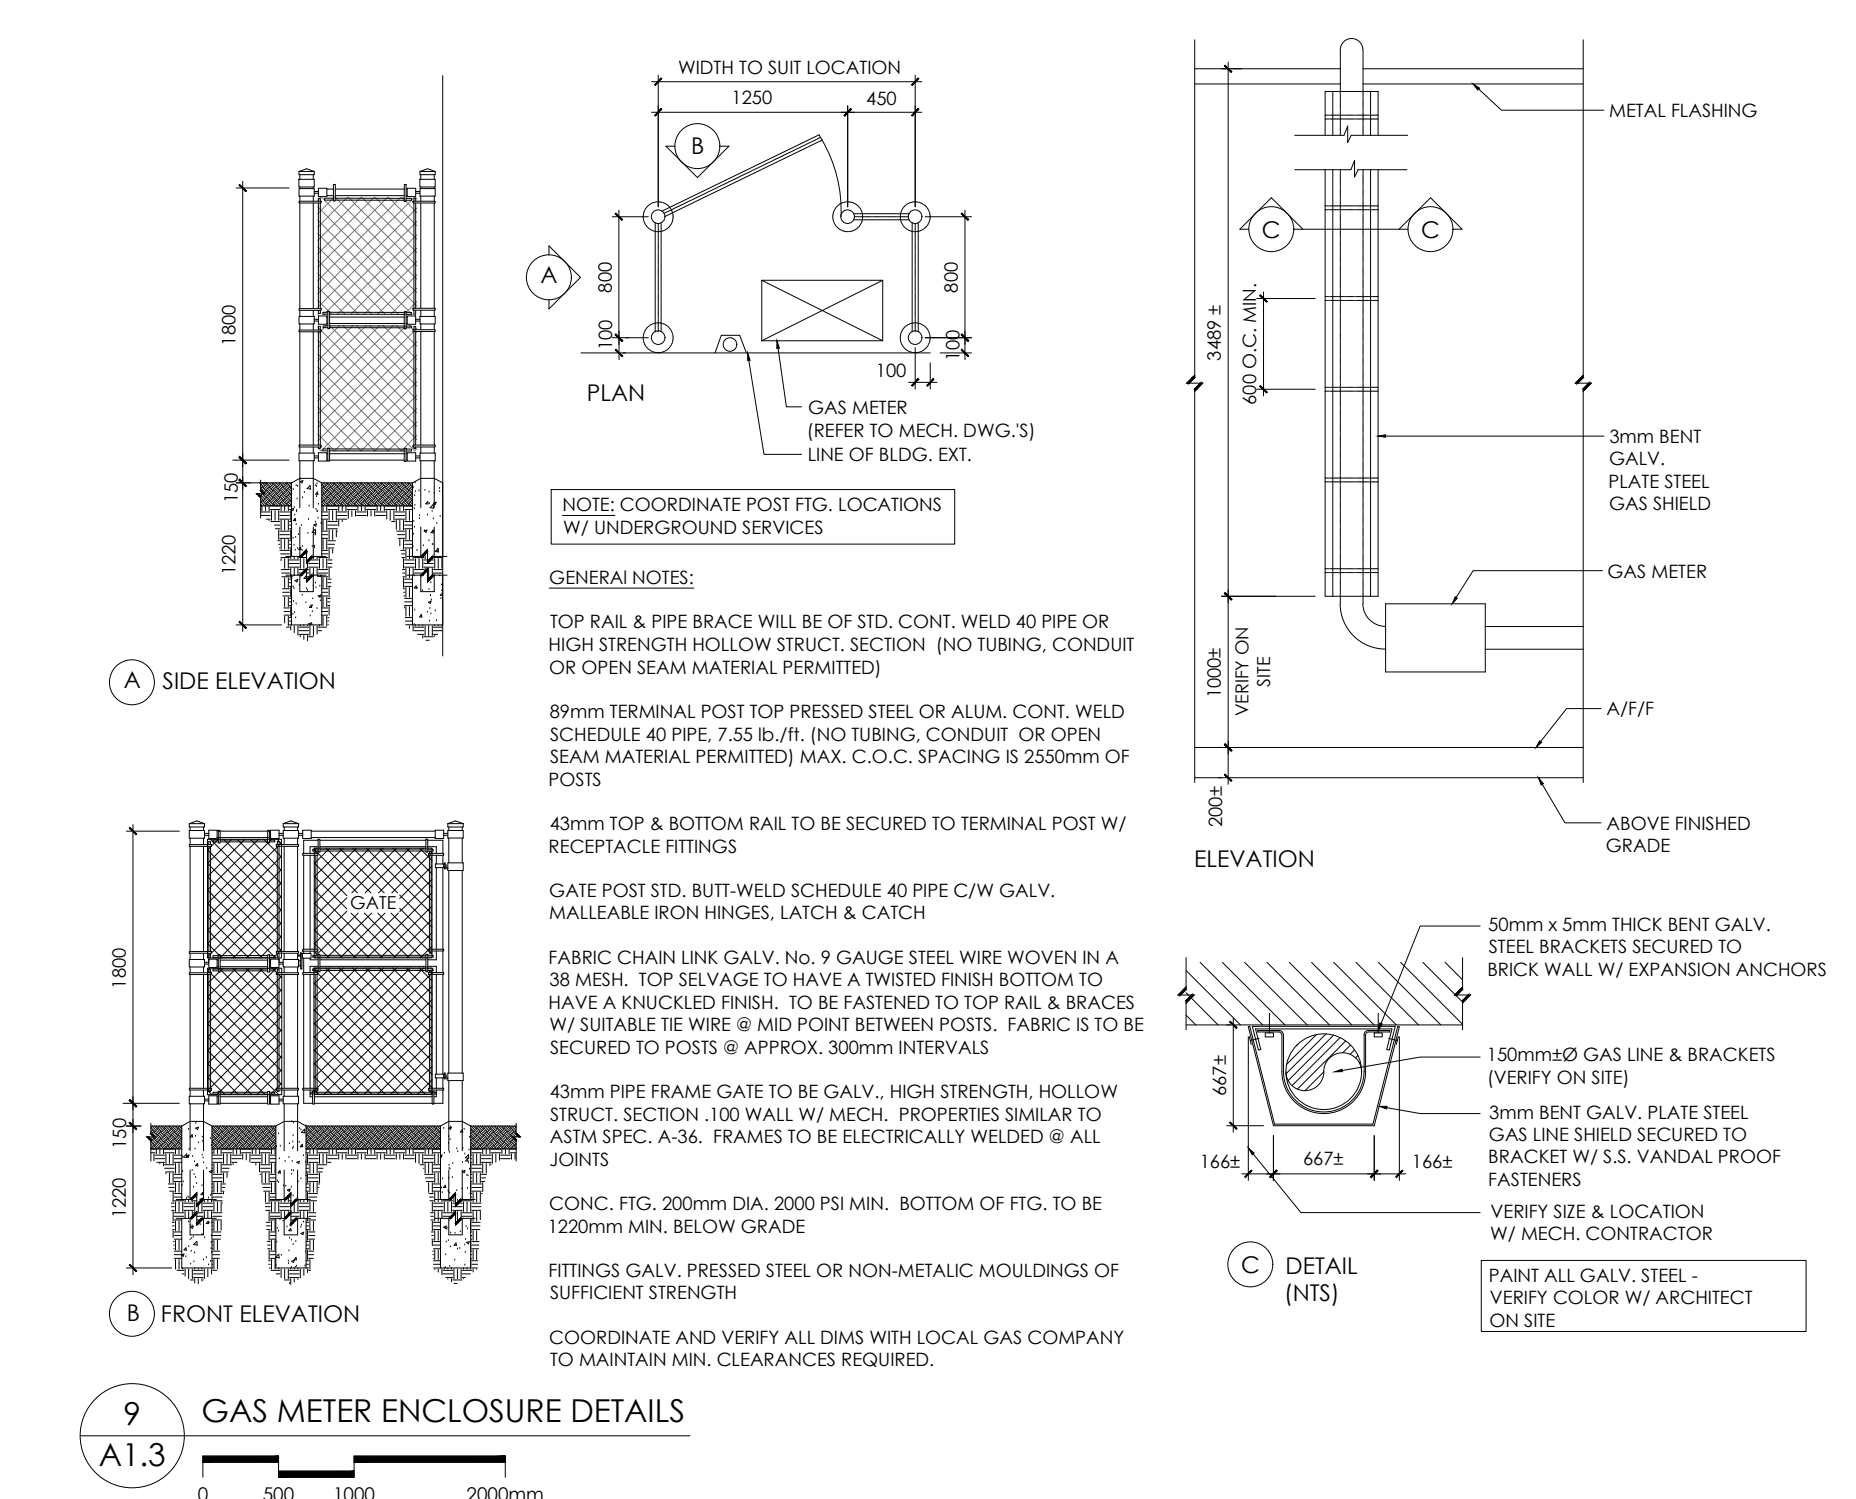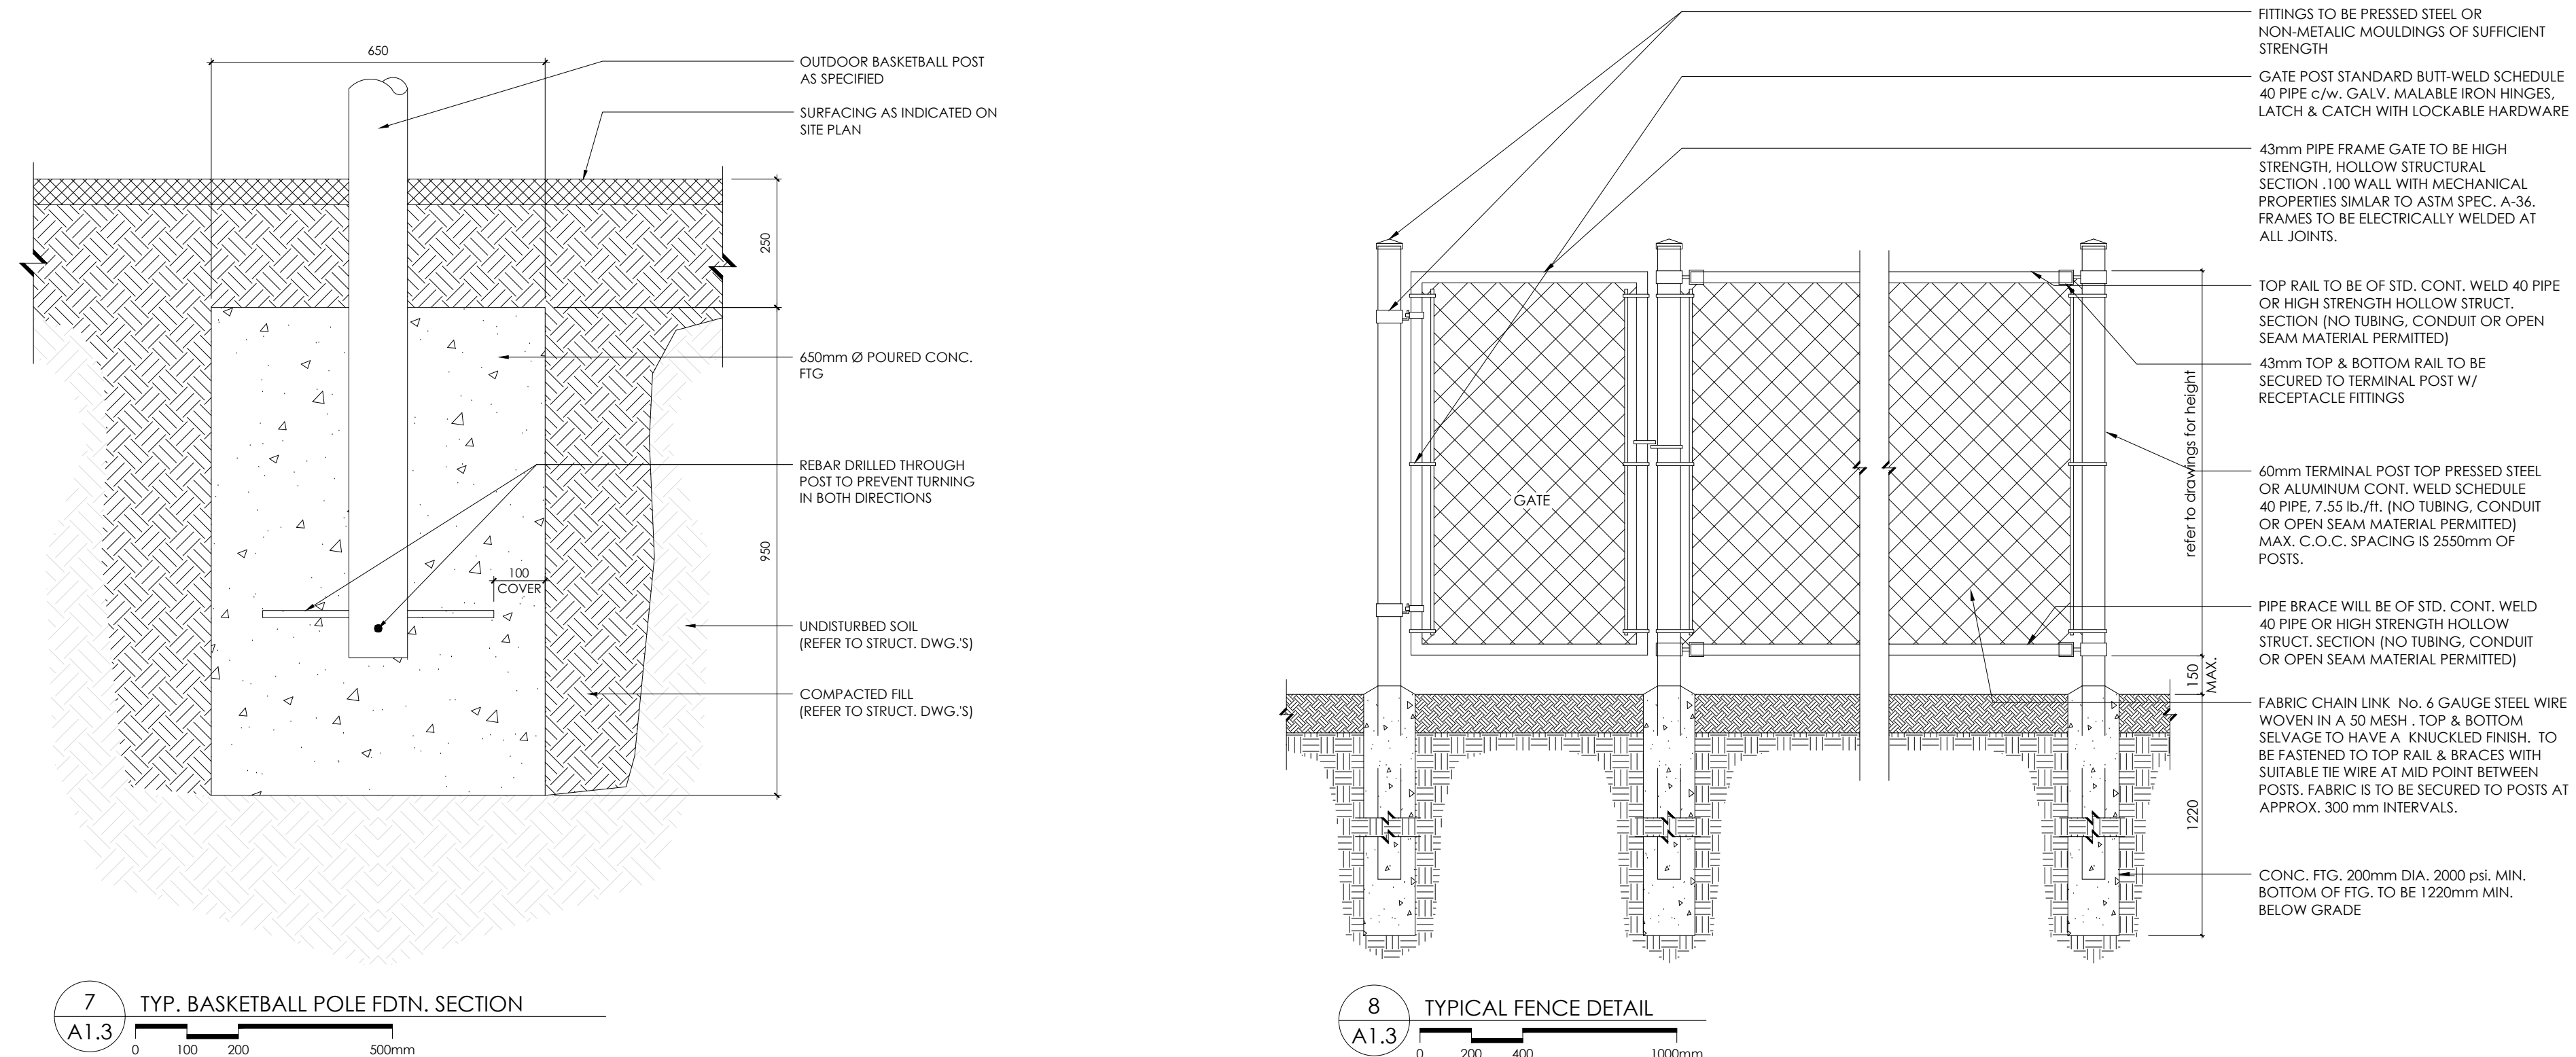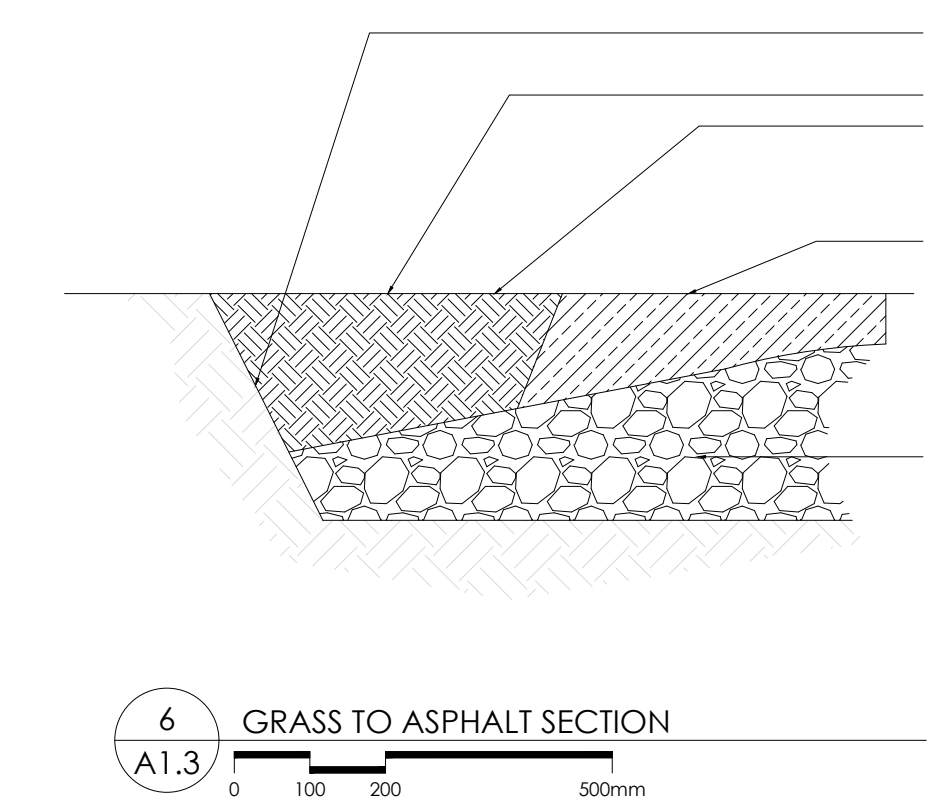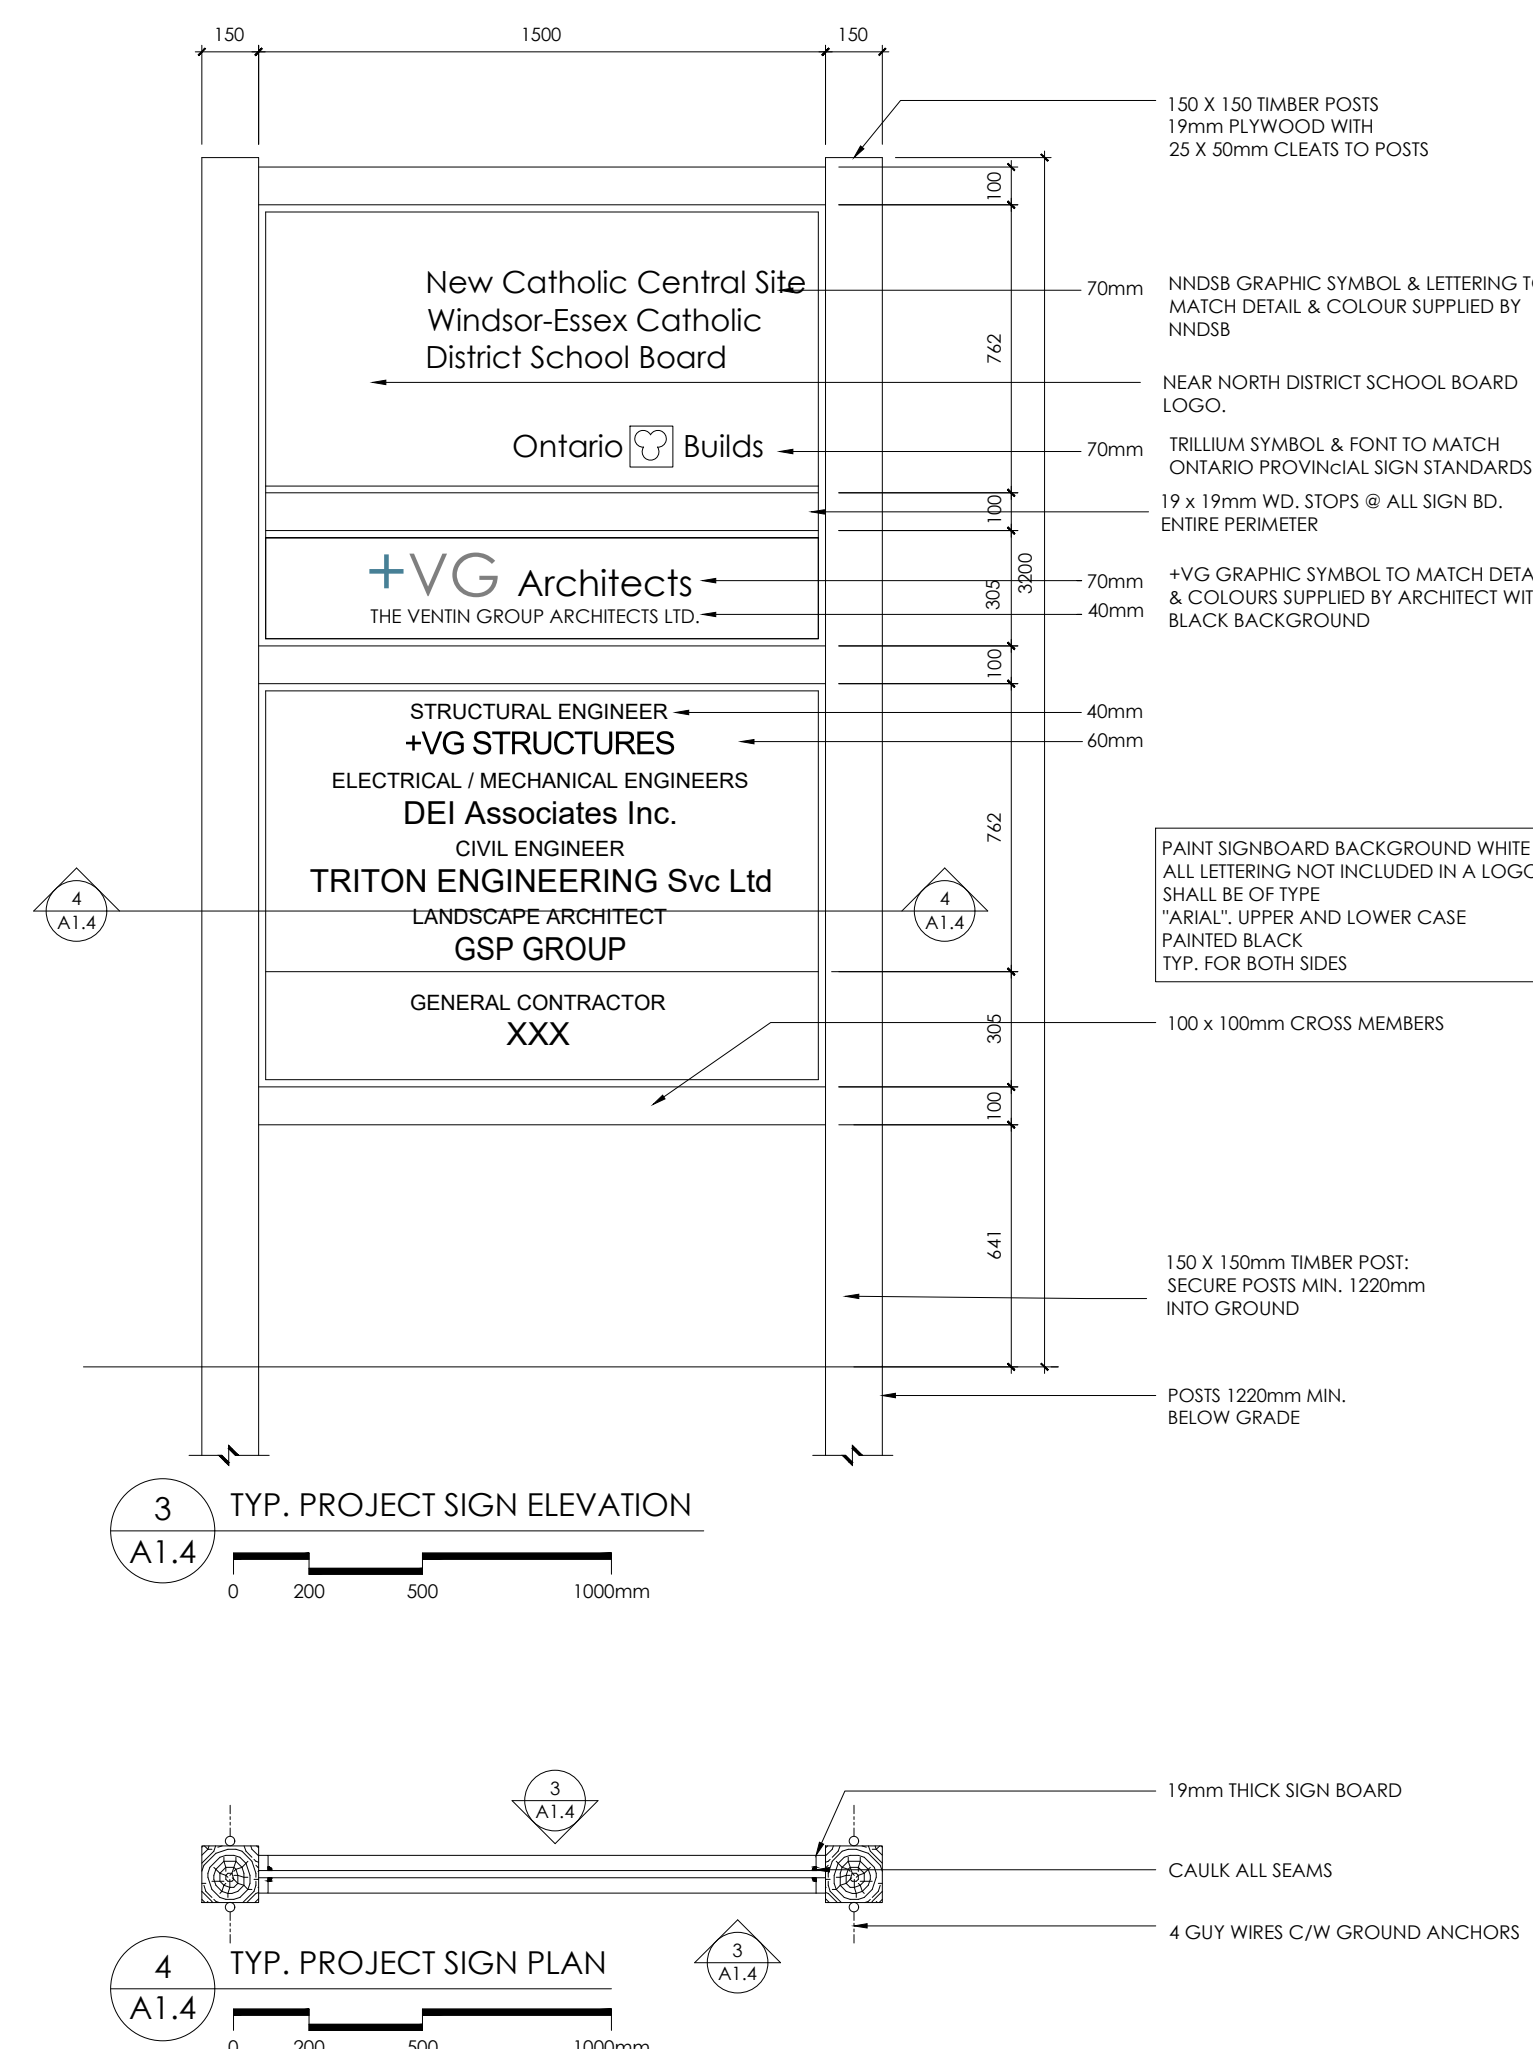

REVISIONS		
NO.	DATE	PARTICULAR
1	2022.06.06	ISSUED FOR ROPS CLASS B COSTING
2	2022.08.18	ISSUED FOR ROPS CLASS B COSTING
3	2022.09.27	ISSUED FOR OWNERS REVIEW - 1955 SET
4	2022.12.16	ISSUED FOR 2ND STATION & STATION
5	2023.01.31	ISSUED FOR TENDER
6	2023.02.22	ISSUED FOR ADDENDUM #9
7	2023.03.28	ISSUED FOR CONFORMANCE
8	2023.11.20	ISSUED FOR RFP#10 COMMENTS
9	2024.01.24	ISSUED FOR RFP#10
10	2024.02.15	ISSUED FOR RFP#1008
11	2024.03.04	ISSUED FOR RFP#1009
12	2024.03.10	ISSUED FOR RFP#1004
13	2024.03.14	ISSUED FOR RFP#1004
14	2024.07.22	ISSUED FOR RFP#1008
15	2024.08.07	ISSUED FOR RFP#1009
16	2024.10.02	ISSUED FOR RFP#1015
17	2025.04.11	ISSUED FOR RFP#1019
18	2025.05.01	ISSUED FOR C0407
19	2025.05.28	ISSUED FOR RFP#1020 - C04010
20	2025.07.31	ISSUED FOR RFP#1031
21	2025.08.04	ISSUED FOR RFP#1014
22	2025.08.15	ISSUED FOR RFP#1015 - C04017
23	2025.08.25	ISSUED FOR RFP#1015 - C04021
24	2025.09.02	ISSUED FOR RFP#1029
25	2025.09.09	ISSUED FOR RFP#1030 - C04018
26	2025.09.08	ISSUED FOR RFP#1031
27	2025.09.09	ISSUED FOR RFP#1031 - C04022
28	2025.09.10	ISSUED FOR RFP#1033
29	2025.09.11	ISSUED FOR RFP#104022
30	2025.09.15	ISSUED FOR RFP#104022
31	2025.09.16	ISSUED FOR RFP#1041 - C04019
32	2025.09.30	ISSUED FOR RFP#1043 - C04023
33	2025.09.30	ISSUED FOR RFP#1043 - C04025
34	2025.10.06	ISSUED FOR RFP#1049 - C04024
35	2025.10.20	ISSUED FOR RFP#1049#1
36	2025.10.30	ISSUED FOR RFP#1049#1
37	2025.10.23	ISSUED FOR RFP#1042
38	2025.11.14	ISSUED FOR RFP#1010#1 - C012 C04004
39	2025.11.14	ISSUED FOR RFP#1003
40	2025.11.26	ISSUED FOR RFP#1008#1
41	2025.12.03	ISSUED FOR RFP#1004 - C04026
42	2026.06.20	ISSUED FOR RECORD SET UP TO C0407

NOTES:

KEY PLAN:

CLIENT:
NEAR NORTH DISTRICT SCHOOL BOARD
NNDNB Tender # 2023-015

PROJECT:
NEW PARRY SOUND K-12 SCHOOL & CHILDCARE

PARRY SOUND HIGH SCHOOL SITE

111 ISABELLA STREET
PARRY SOUND, ONTARIO

ORIGINAL PAGE SIZE ARCH E1 - 30" x 42"

KEY TO DETAIL LOCATION:

	A - DETAIL NO.
	B - DETAIL NO. ORIGIN

By Jody

Blarney: K.VG-Branford Near North


+VG

ARCHITECTS


THE VENTIN GROUP LTD

A1.3


SITE PLAN DETAILS

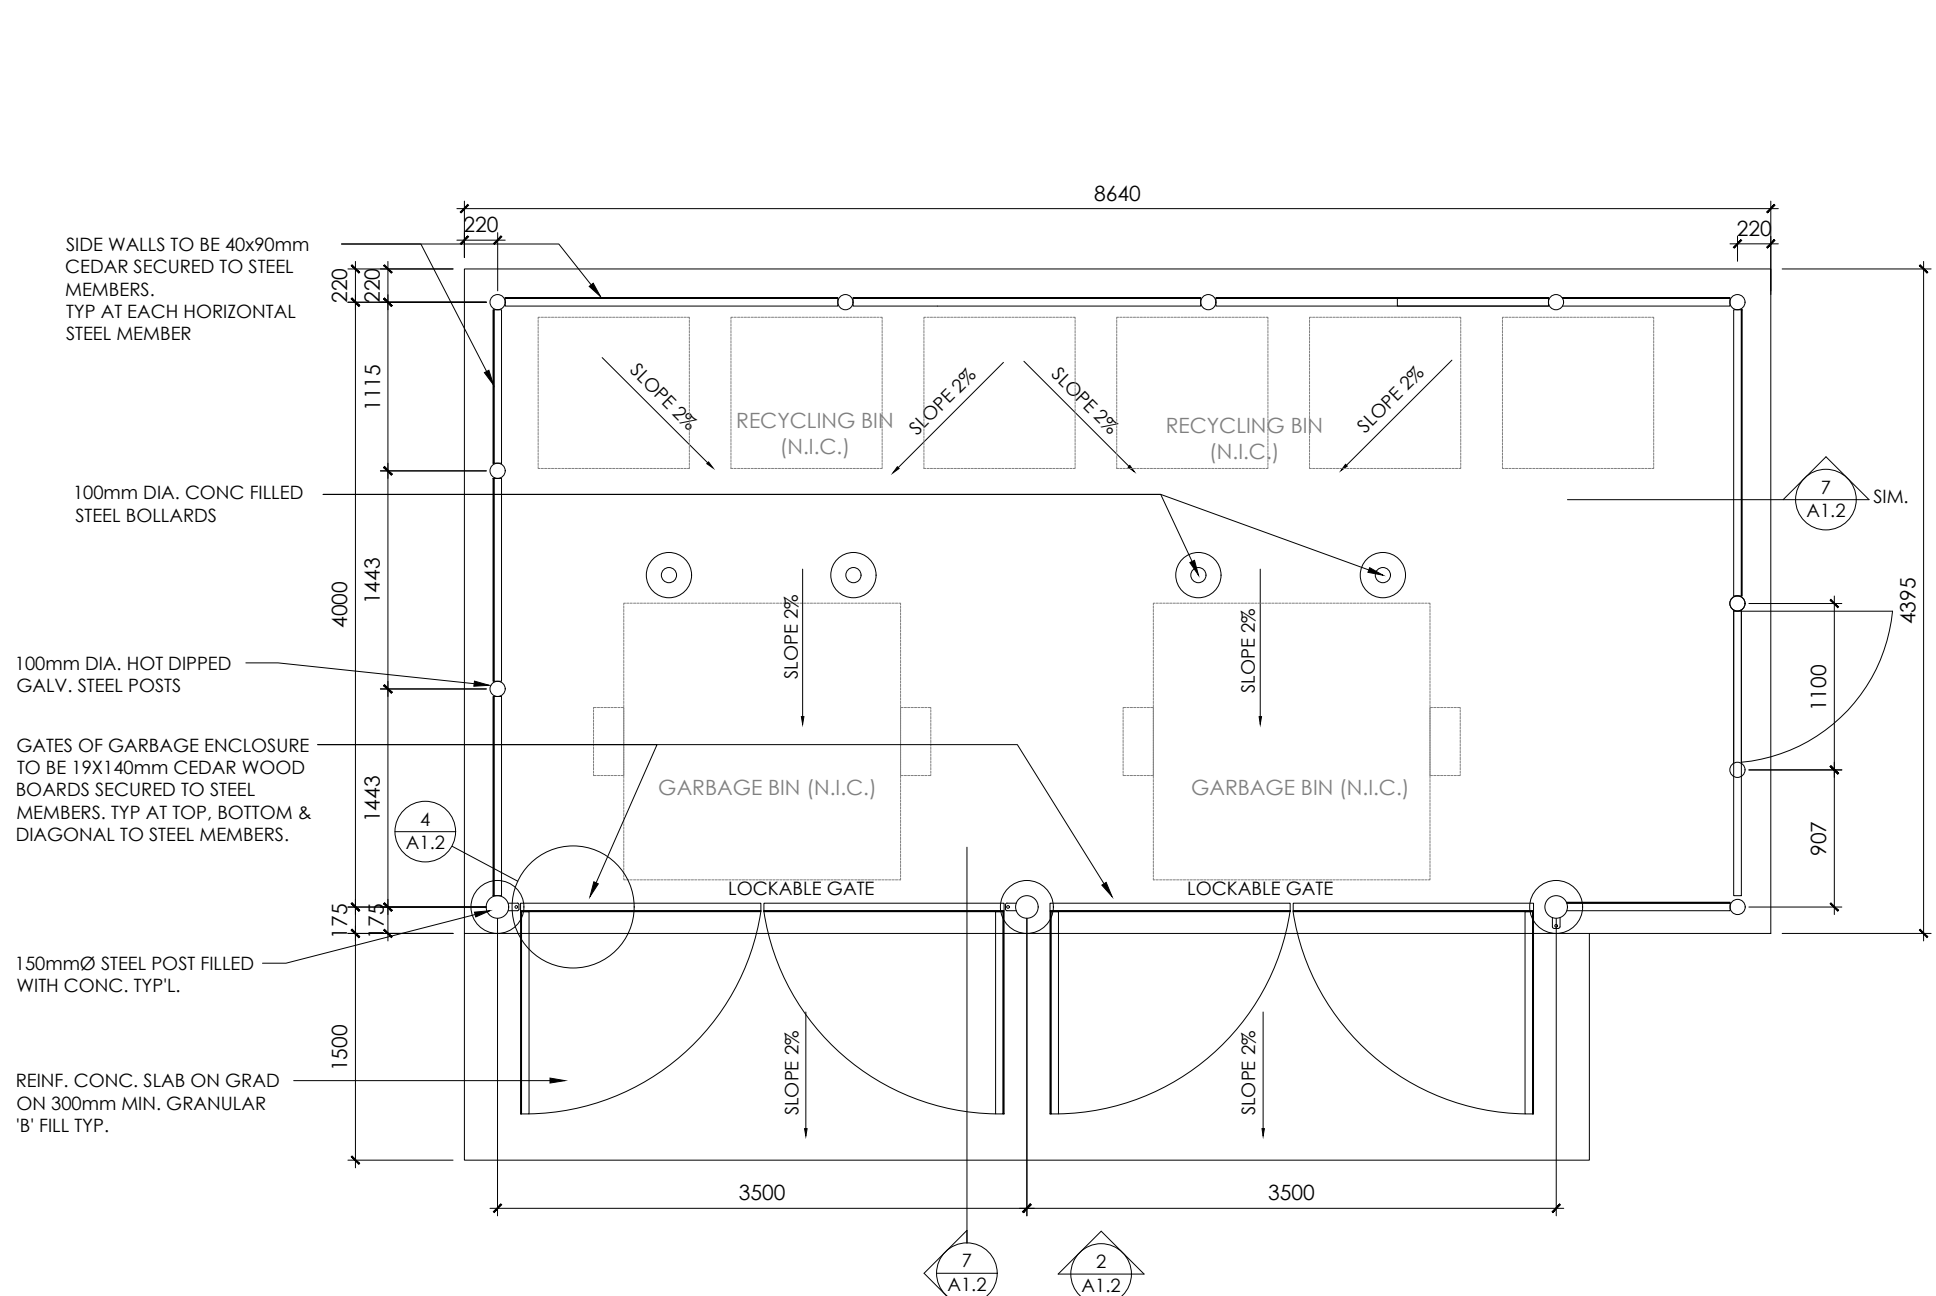


1 GARBAGE ENCLOSURE DETAIL
0 500 1000 2000mm

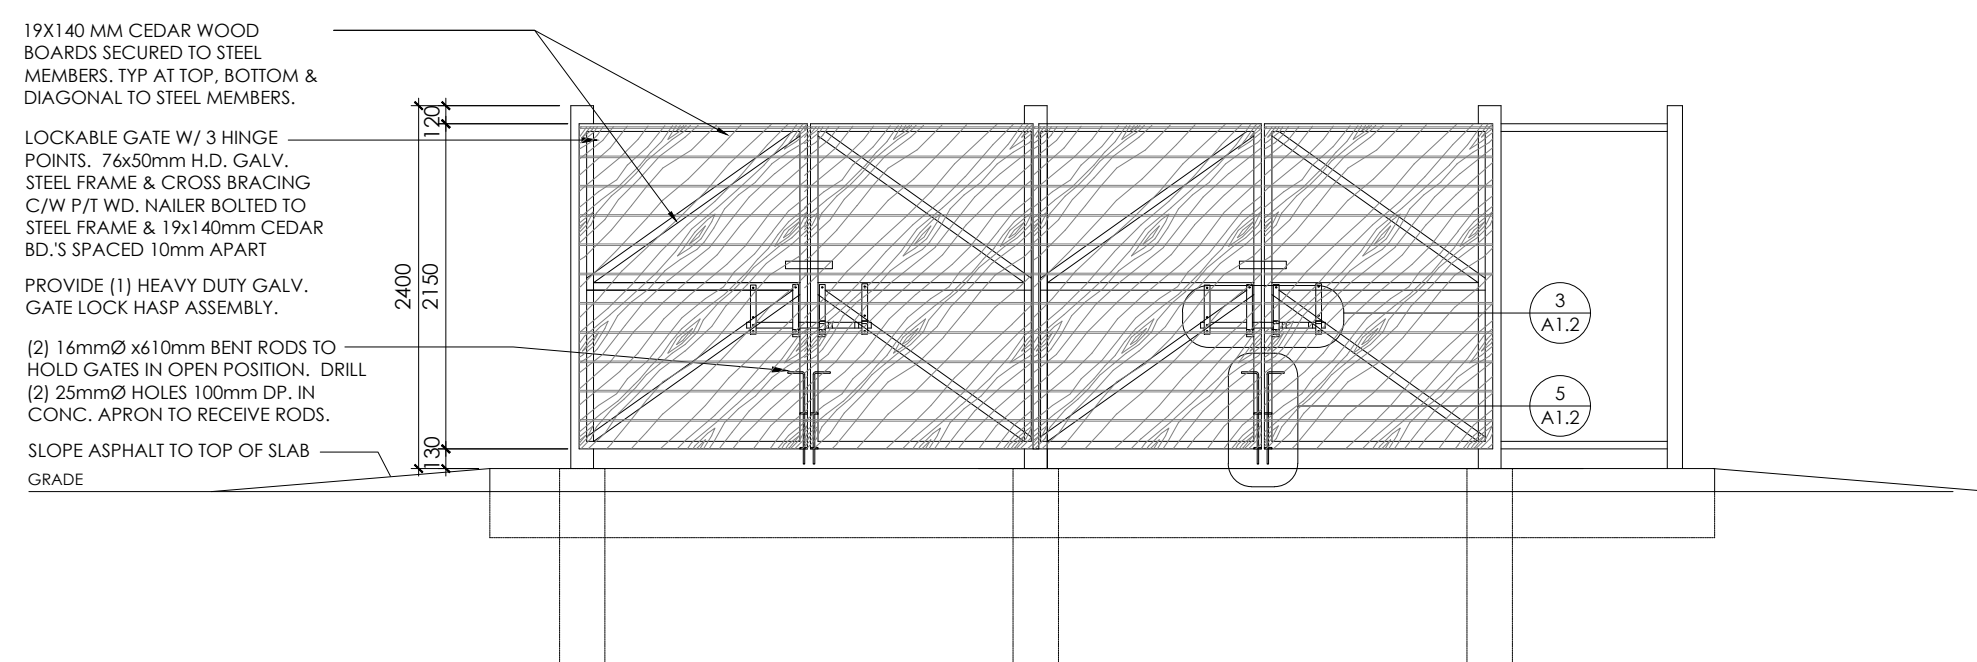


2 GARBAGE ENCLOSURE FRONT ELEV.
0 500 1000 2000mm

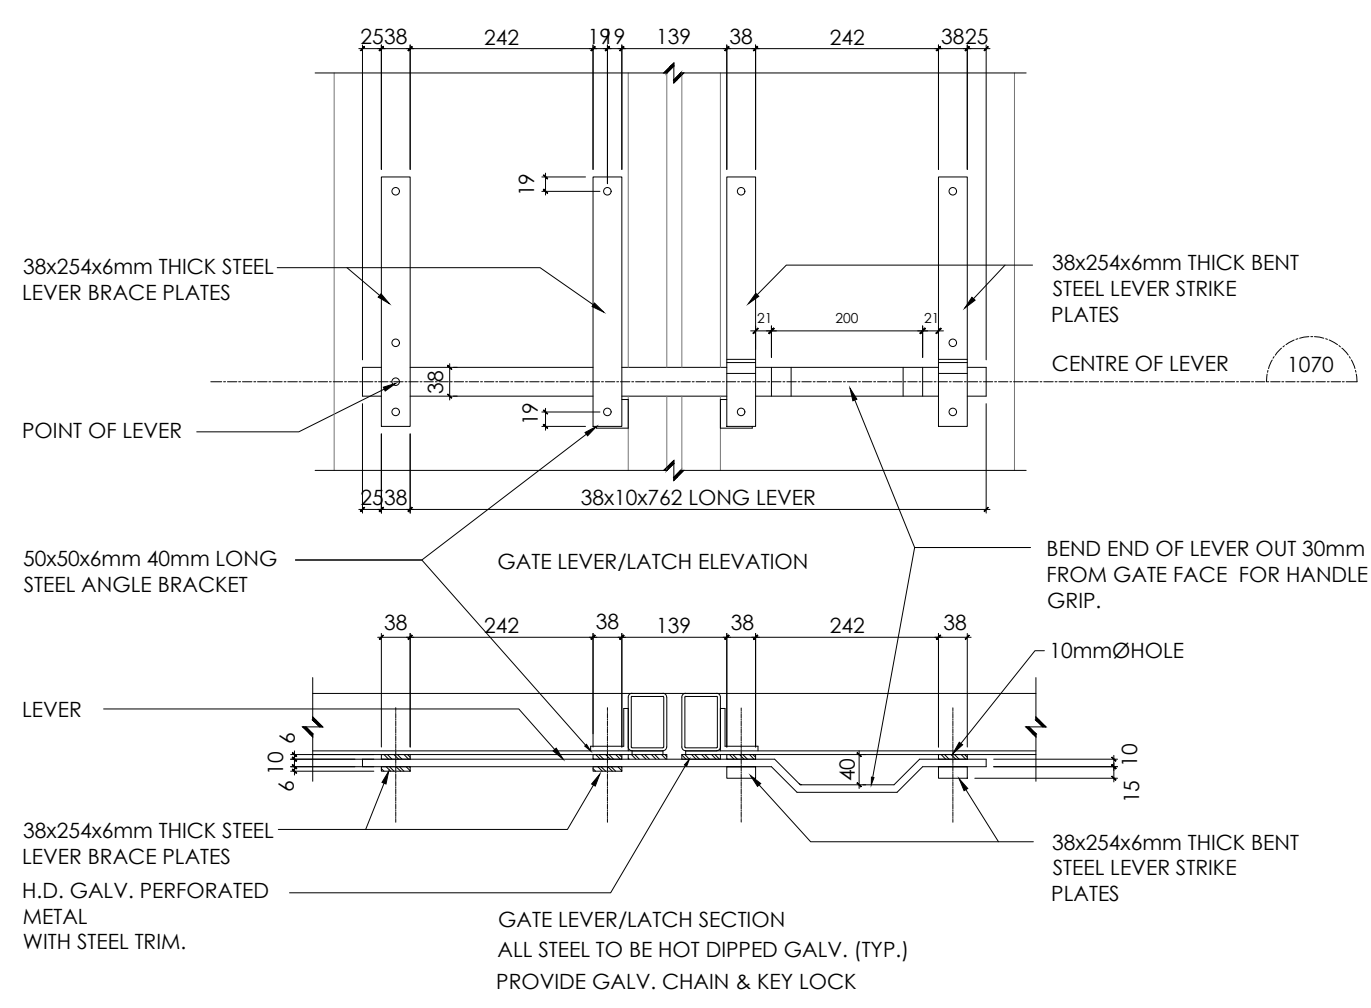


3 GARBAGE ENCLOSURE - LATCH ELEVATION & SECTION
0 100 200 500mm

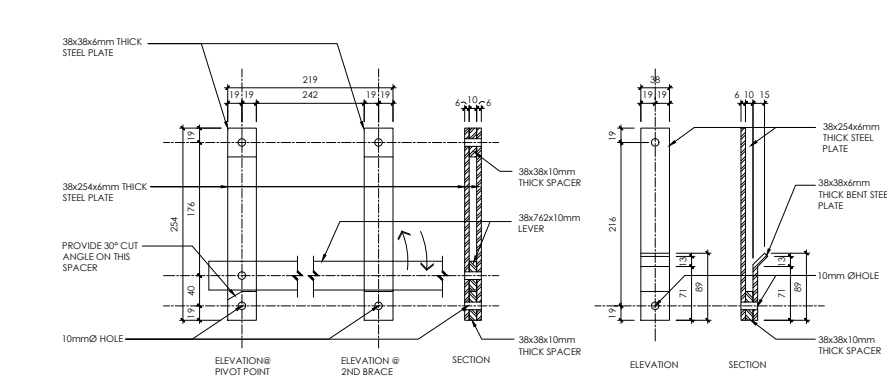


4 GARBAGE ENCLOSURE - LATCH HARDWARE DETAILS
0 100 200 500mm

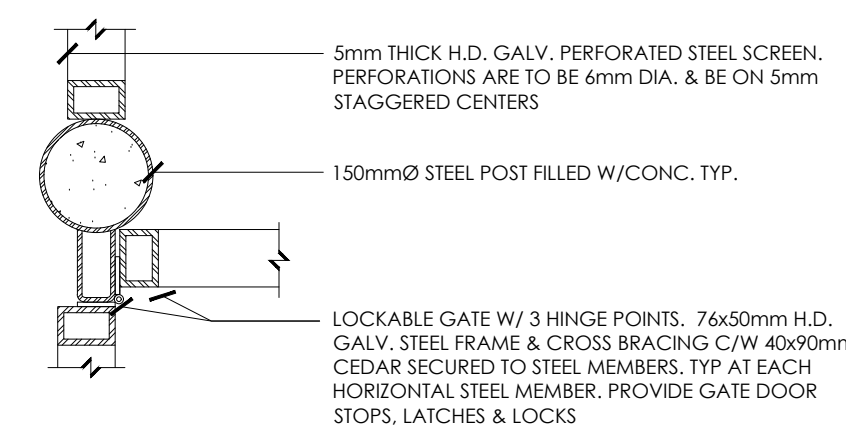

5 GARBAGE ENCLOSURE - PLAN DETAIL @ GATE HINGE POINT
0 10 20 50mm

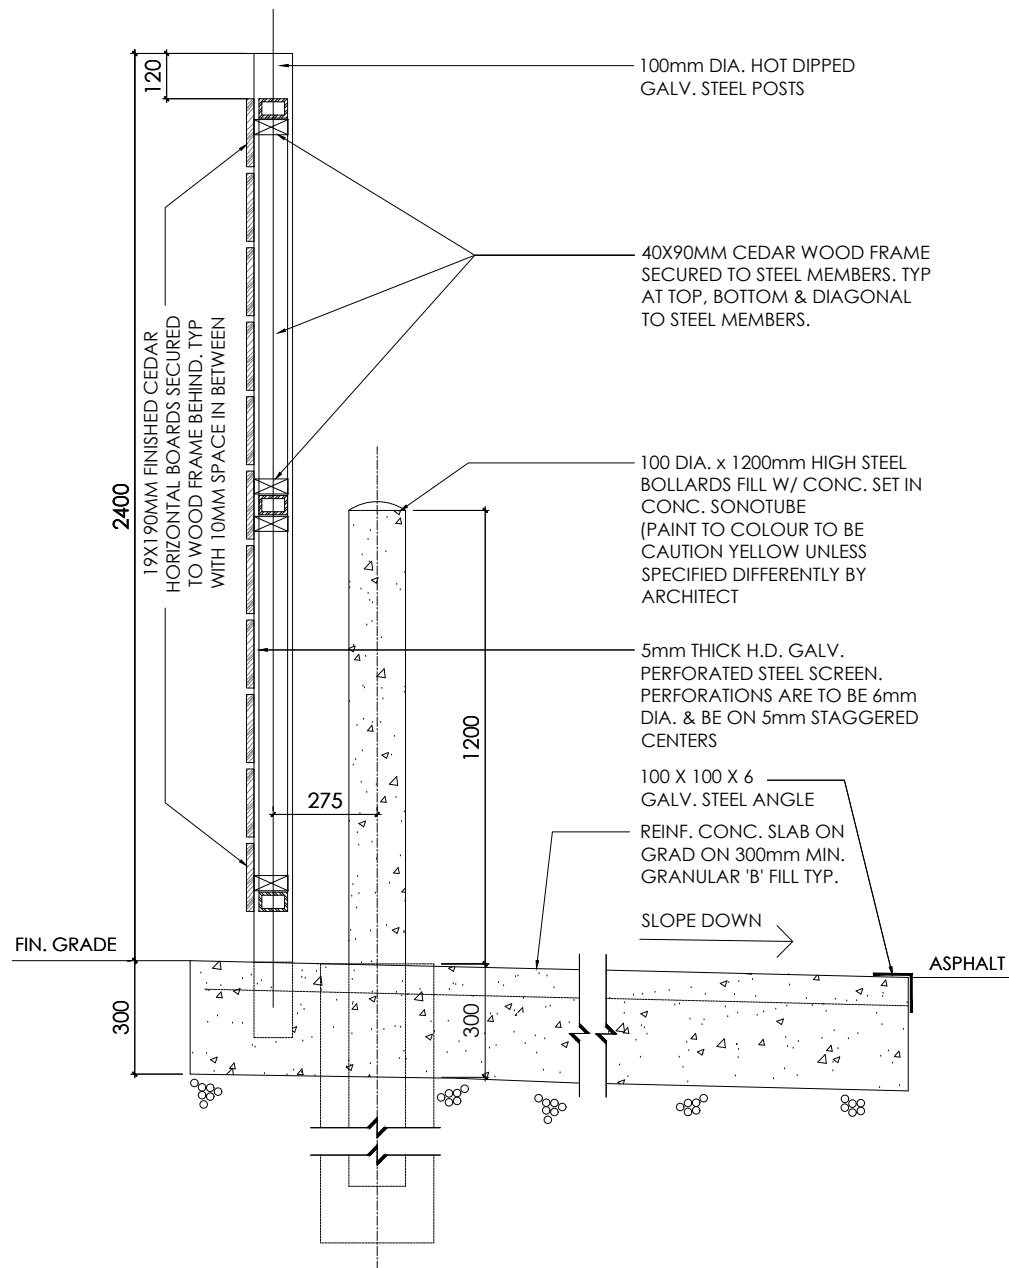

6 GARBAGE ENCLOSURE SECTION
0 10 20 50mm

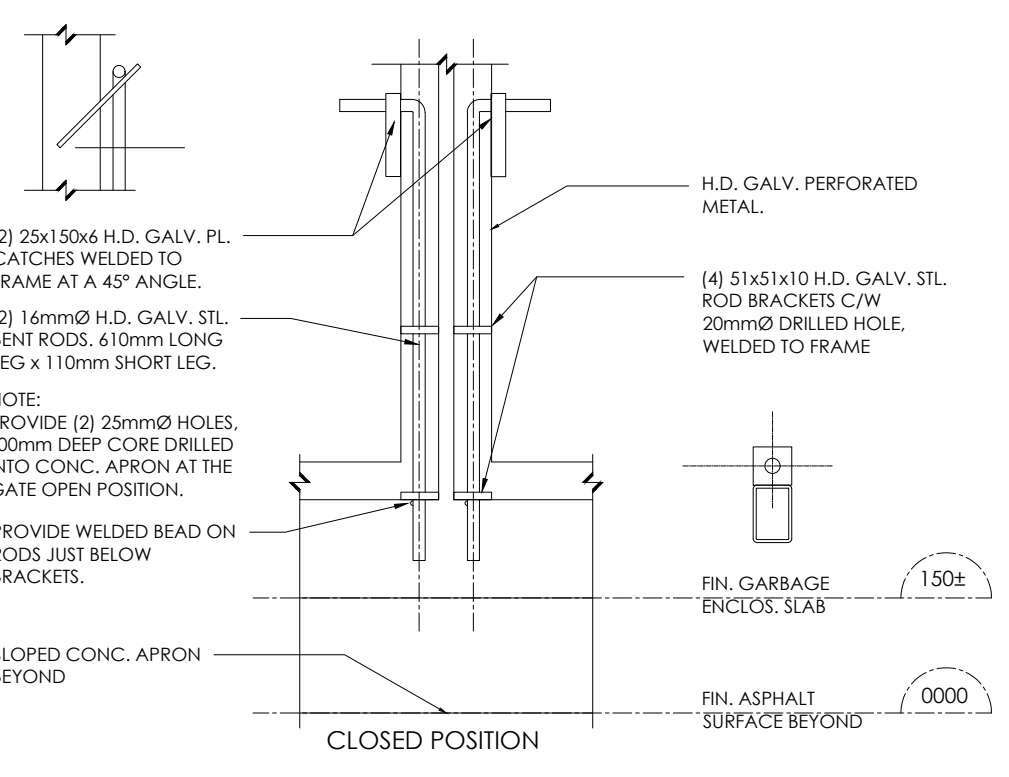

7 GARBAGE ENCLOSURE - RODS INTERIER ELEVATION DETAIL
0 10 20 50mm

REVISIONS		
NO.	DATE	PARTICULAR
1	2022.04.06	ISSUED FOR 805 CLASS B COSTING
2	2022.06.18	ISSUED FOR SPA
3	2022.09.22	ISSUED FOR OWNERS REVIEW - RES SET
4	2022.12.16	ISSUED FOR 2nd SPA SUBMISSION
5	2023.01.31	ISSUED FOR TENDER
6	2023.02.22	ISSUED FOR ADDENDUM 9
7	2023.08.23	ISSUED FOR CONVENIENCE
8	2023.11.20	ISSUED FOR PERMIT COMMENTS
9	2024.01.24	ISSUED FOR SH#3
10	2024.02.15	ISSUED FOR PCH#308
11	2024.03.04	ISSUED FOR PCH#309
12	2024.03.10	ISSUED FOR SH#004
13	2024.05.14	ISSUED FOR SH#004
14	2024.07.22	ISSUED FOR SH#008
15	2024.08.07	ISSUED FOR SH#009
16	2024.10.02	ISSUED FOR PCH#15
17	2025.04.11	ISSUED FOR PCH#019
18	2025.05.01	ISSUED FOR CO#07
19	2025.05.28	ISSUED FOR PCH#20 - CO#010
20	2025.07.31	ISSUED FOR SH#013
21	2025.08.06	ISSUED FOR SH#014
22	2025.08.15	ISSUED FOR PCH#25 - CO#017
23	2025.08.25	ISSUED FOR PCH#27 - CO#021
24	2025.09.02	ISSUED FOR PCH#29
25	2025.09.02	ISSUED FOR SH#0 - CO#018
26	2025.09.08	ISSUED FOR PCH#31
27	2025.09.09	ISSUED FOR PCH#32 - CO#022
28	2025.09.10	ISSUED FOR PCH#33
29	2025.09.11	ISSUED FOR SH#02
30	2025.09.15	ISSUED FOR SH#023
31	2025.09.16	ISSUED FOR PCH #35 - CO#023
32	2025.09.30	ISSUED FOR PCH #37 - CO#019
33	2025.09.30	ISSUED FOR PCH #38 - CO#025
34	2025.10.04	ISSUED FOR PCH #39 - CO#024
35	2025.10.20	ISSUED FOR PCH #40#1
36	2025.10.30	ISSUED FOR PCH#041
37	2025.10.23	ISSUED FOR PCH #42
38	2025.11.21	ISSUED FOR PCH#021#01 - CO12 CO#030
39	2025.11.14	ISSUED FOR PCH#043
40	2025.11.26	ISSUED FOR PCH#048#1
41	2025.12.03	ISSUED FOR PCH#044 - CO#026
42	2026.02.04	ISSUED FOR RECORD SET UP TO CO#027

NOTES:

KEY PLAN:





Near North
District School Board


CLIENT:
NEAR NORTH DISTRICT SCHOOL BOARD
NND58 Tender # 2023-015

PROJECT:
NEW PARRY SOUND K-12 SCHOOL & CHILDCARE
PARRY SOUND HIGH SCHOOL SITE

111 ISABELLA STREET
PARRY SOUND, ONTARIO

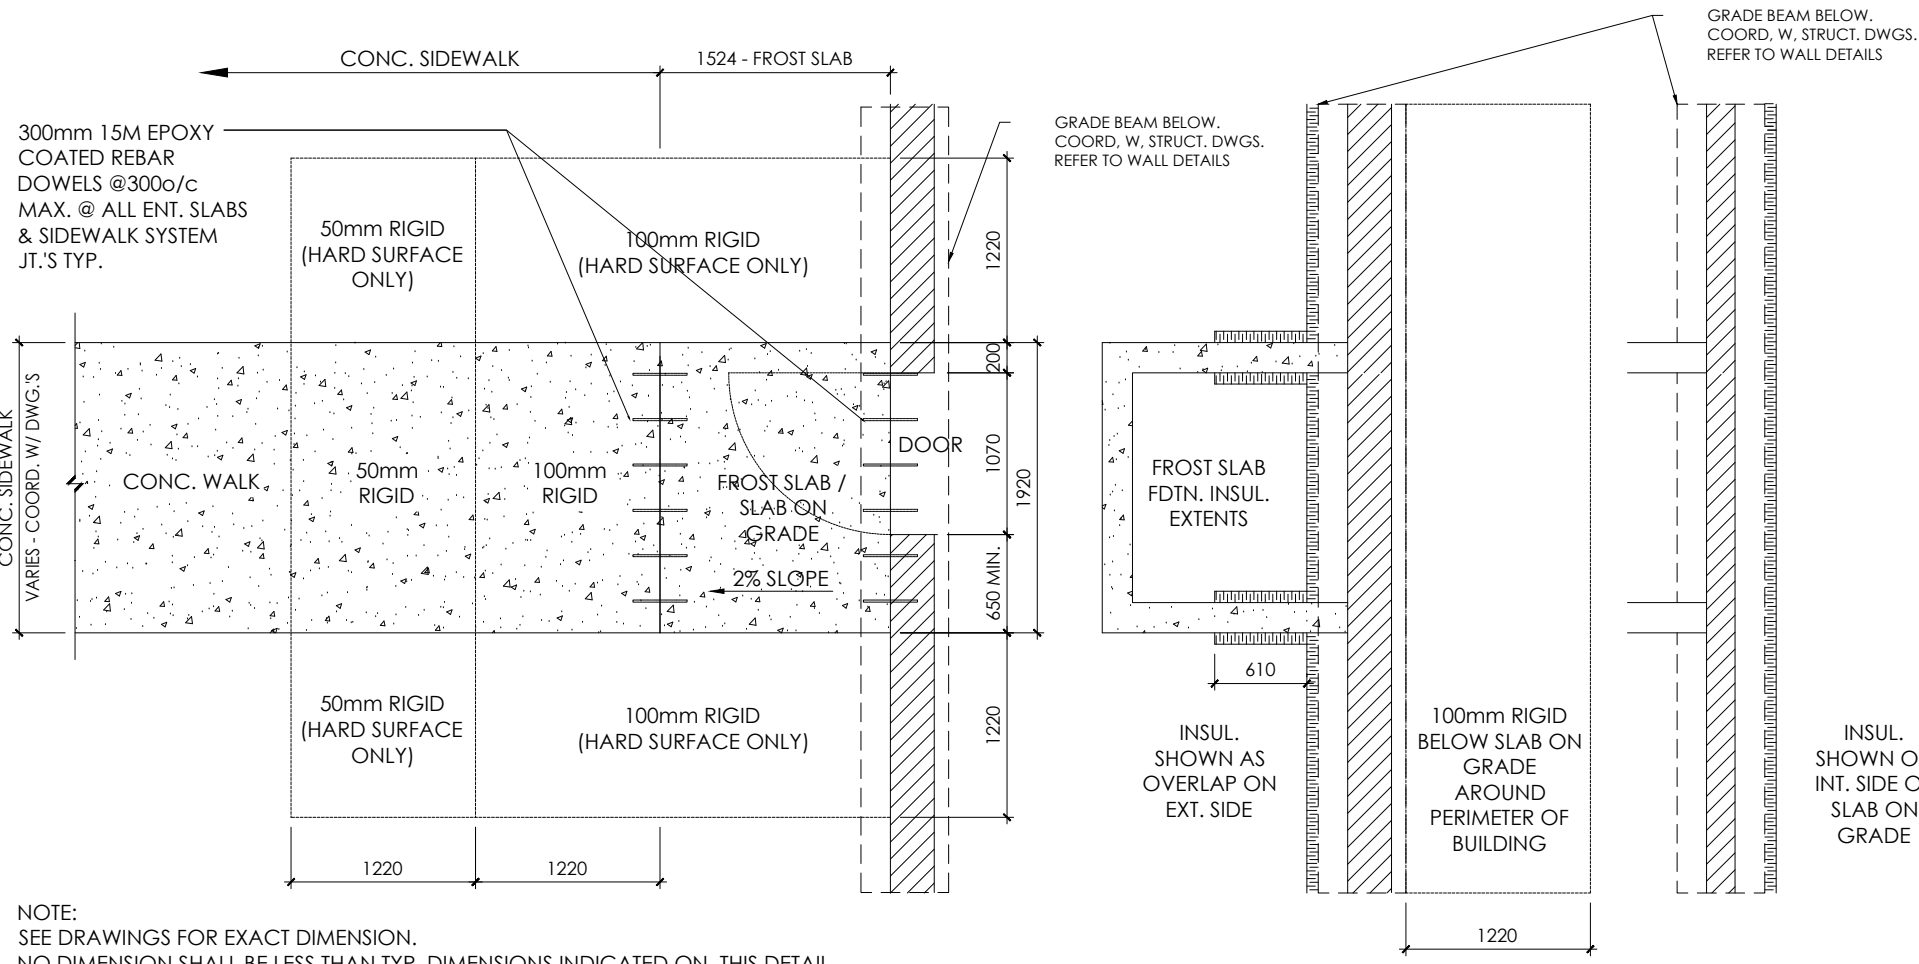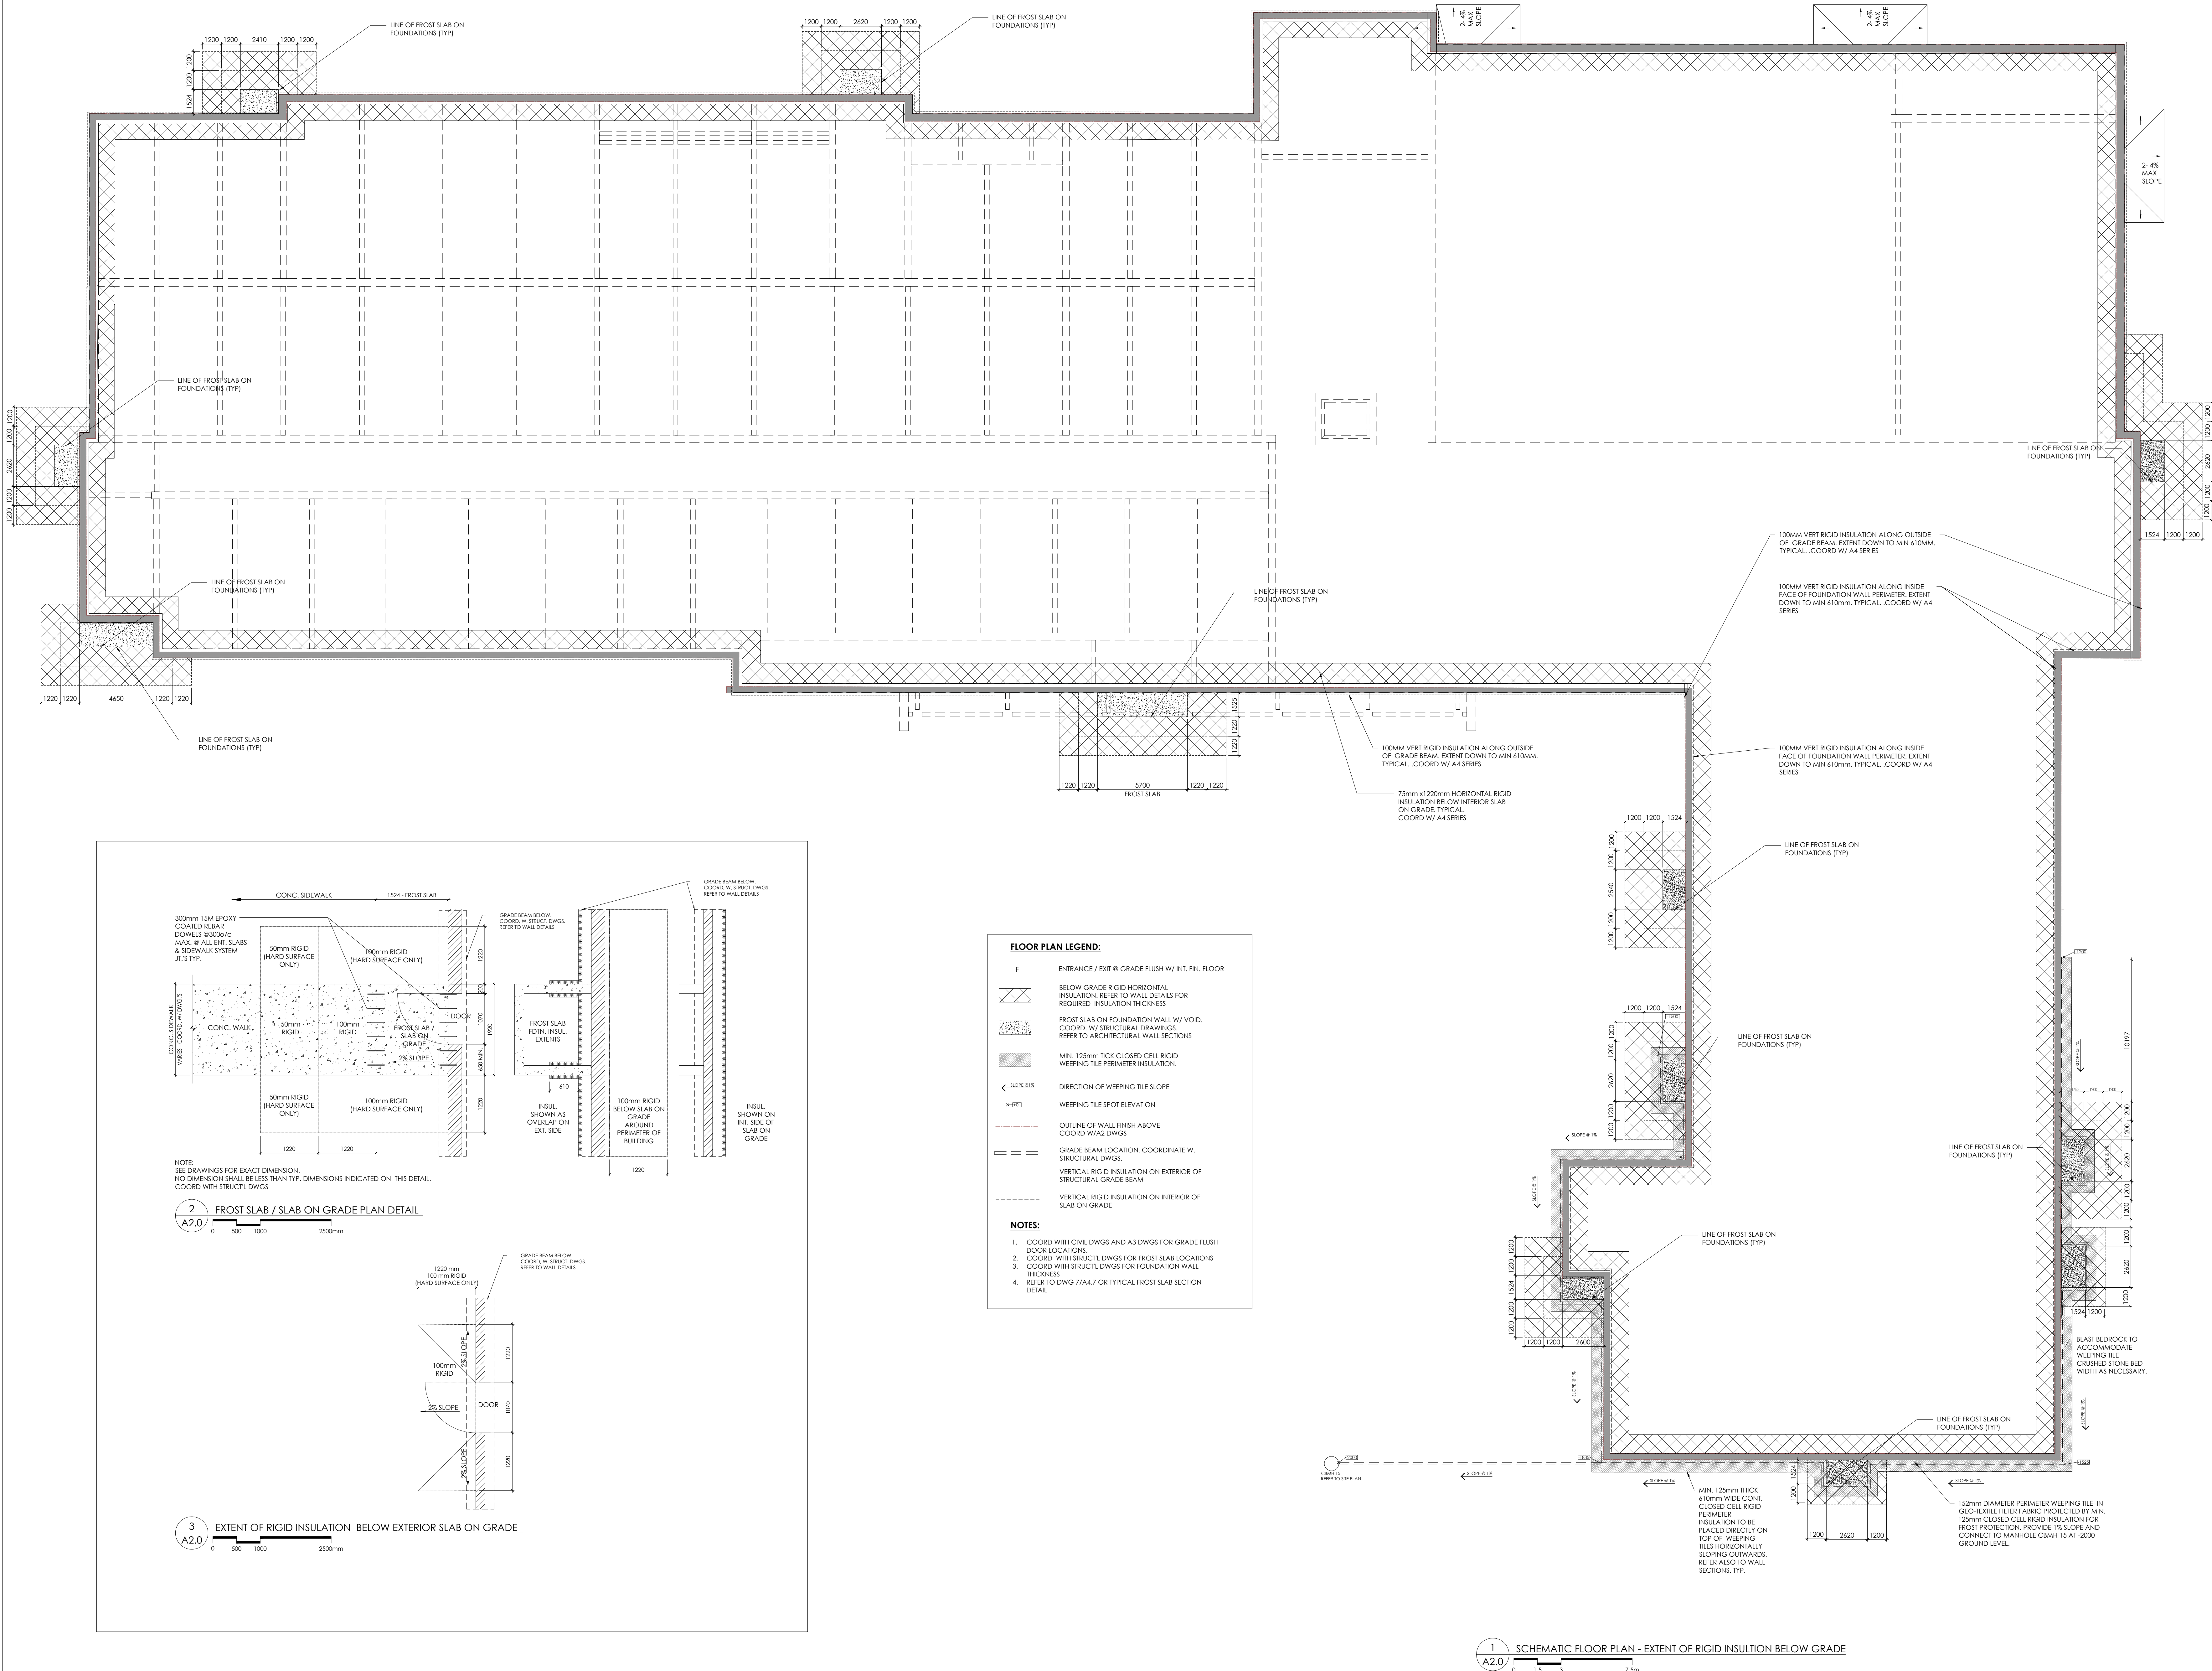

2 FROST SLAB / SLAB ON GRADE PLAN DETAIL
A2.0

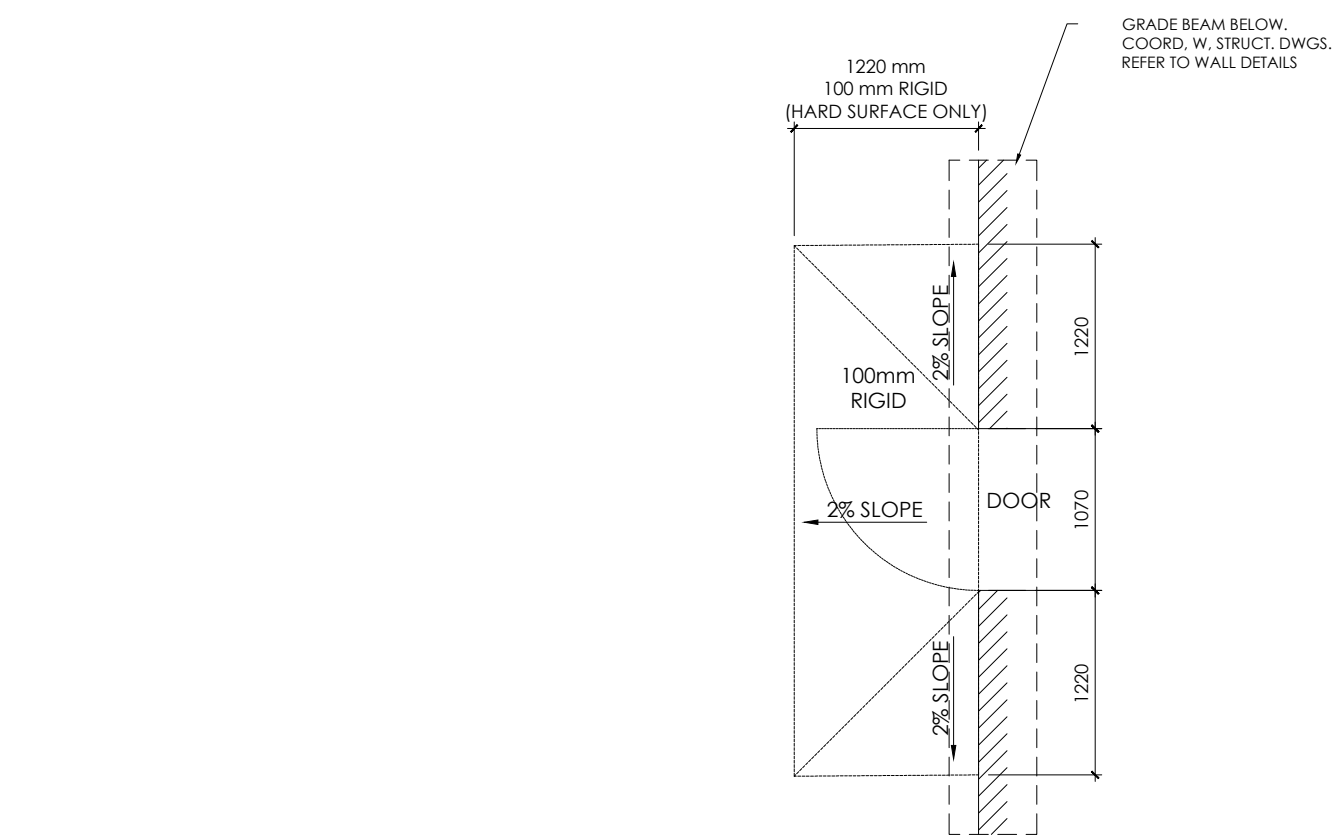

3 EXTENT OF RIGID INSULATION BELOW EXTERIOR SLAB ON GRADE
A2.0

FLOOR PLAN LEGEND:

- F ENTRANCE / EXIT @ GRADE FLUSH W/ INT. FIN. FLOOR
- BELOW GRADE RIGID HORIZONTAL INSULATION, REFER TO WALL DETAILS FOR REQUIRED INSULATION THICKNESS
- FROST SLAB ON FOUNDATION WALL W/ VOID, COORD. W/ STRUCTURAL DRAWINGS, REFER TO ARCHITECTURAL WALL SECTIONS
- MIN. 125mm THICK CLOSED CELL RIGID WEeping TILE PERIMETER INSULATION
- DIRECTION OF WEeping TILE SLOPE
- WEeping TILE SPOT ELEVATION
- OUTLINE OF WALL FINISH ABOVE COORD. W/ A4 DWGS
- GRADE BEAM LOCATION, COORDINATE W. STRUCTURAL DWGS
- VERTICAL RIGID INSULATION ON EXTERIOR OF STRUCTURAL GRADE BEAM
- VERTICAL RIGID INSULATION ON INTERIOR OF SLAB ON GRADE

NOTES:

- COORD WITH CIVIL DWGS AND A3 DWGS FOR GRADE FLUSH DOOR LOCATIONS
- COORD WITH STRUCTL DWGS FOR FROST SLAB LOCATIONS
- COORD WITH STRUCTL DWGS FOR FOUNDATION WALL THICKNESS
- REFER TO DWG 7/A4.7 OR TYPICAL FROST SLAB SECTION DETAIL


1 SCHEMATIC FLOOR PLAN - EXTENT OF RIGID INSULATION BELOW GRADE
A2.0

REVISIONS

NO.	DATE	PARTICULAR
1	2022.04.06	ISSUED FOR 80% CLASS B COSTING
2	2022.06.18	ISSUED FOR SPA
3	2022.09.22	ISSUED FOR OWNERS REVIEW - RES SET
4	2022.12.16	ISSUED FOR 2ND SPA SUBMISSION
5	2023.01.31	ISSUED FOR TENDER
6	2023.02.22	ISSUED FOR ADDENDUM 9
7	2023.08.23	ISSUED FOR CONVENIENCE
8	2023.11.20	ISSUED FOR PERMIT COMMENTS
9	2024.01.24	ISSUED FOR SH03
10	2024.02.15	ISSUED FOR PCN#08
11	2024.03.04	ISSUED FOR PCN#09
12	2024.03.10	ISSUED FOR SH04
13	2024.05.14	ISSUED FOR SH04
14	2024.07.22	ISSUED FOR SH08
15	2024.08.07	ISSUED FOR SH09
16	2024.10.02	ISSUED FOR PCN#15
17	2025.04.11	ISSUED FOR PCN#019
18	2025.05.01	ISSUED FOR CO#07
19	2025.05.28	ISSUED FOR PCN#20 - CO#010
20	2025.07.31	ISSUED FOR SH013
21	2025.08.06	ISSUED FOR SH014
22	2025.08.15	ISSUED FOR PCN#25 - CO#017
23	2025.08.25	ISSUED FOR PCN#27 - CO#021
24	2025.09.02	ISSUED FOR PCN#29
25	2025.09.02	ISSUED FOR SH00 - CO#018
26	2025.09.08	ISSUED FOR PCN#31
27	2025.09.09	ISSUED FOR PCN#32 - CO#022
28	2025.09.10	ISSUED FOR PCN#33
29	2025.09.11	ISSUED FOR SH022
30	2025.09.15	ISSUED FOR SH023
31	2025.09.16	ISSUED FOR PCN F33 - CO#023
32	2025.09.30	ISSUED FOR PCN F37 - CO#019
33	2025.09.30	ISSUED FOR PCN F38 - CO#025
34	2025.10.04	ISSUED FOR PCN F39 - CO#024
35	2025.10.20	ISSUED FOR PCN F40#1
36	2025.10.30	ISSUED FOR PCN#41
37	2025.10.23	ISSUED FOR PCN F42
38	2025.11.21	ISSUED FOR PCN#021#01 - CO12 CO#03
39	2025.11.14	ISSUED FOR PCN#043
40	2025.11.26	ISSUED FOR PCN#043#1
41	2025.12.03	ISSUED FOR PCN#044 - CO#026
42	2026.02.04	ISSUED FOR RECORD SET UP TO CO#027

NOTES:

KEY PLAN:

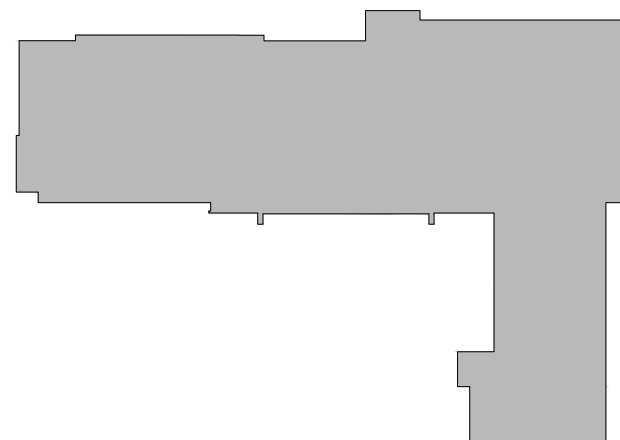

CLIENT:

NEAR NORTH DISTRICT SCHOOL BOARD
NND\$B Tender # 2023-015

PROJECT:

NEW PARRY SOUND K-12 SCHOOL & CHILDCARE

PARRY SOUND HIGH SCHOOL SITE

111 ISABELLA STREET
PARRY SOUND, ONTARIO


ORIGINAL PAGE SIZE ARCH E1 - 30" x 42"

KEY TO DETAIL LOCATION:

A - DETAIL NO.

B - DETAIL NO. ORIGIN

VG ARCHITECTS
THE VENTIN GROUP LTD

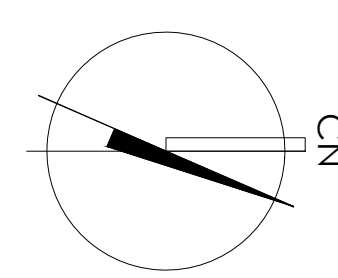

A2.0


DRAWN BY: KH

CHECKED BY: PS

BELOW GRADE RIGID INSULATION PLAN & DETAILS

Reproduction of drawings and related documents in whole or in parts checked and sealed by the Sealed Contractor. All dimensions and measurements must be checked and sealed by the Sealed Contractor.

A2.1.1 & A2.1.2A

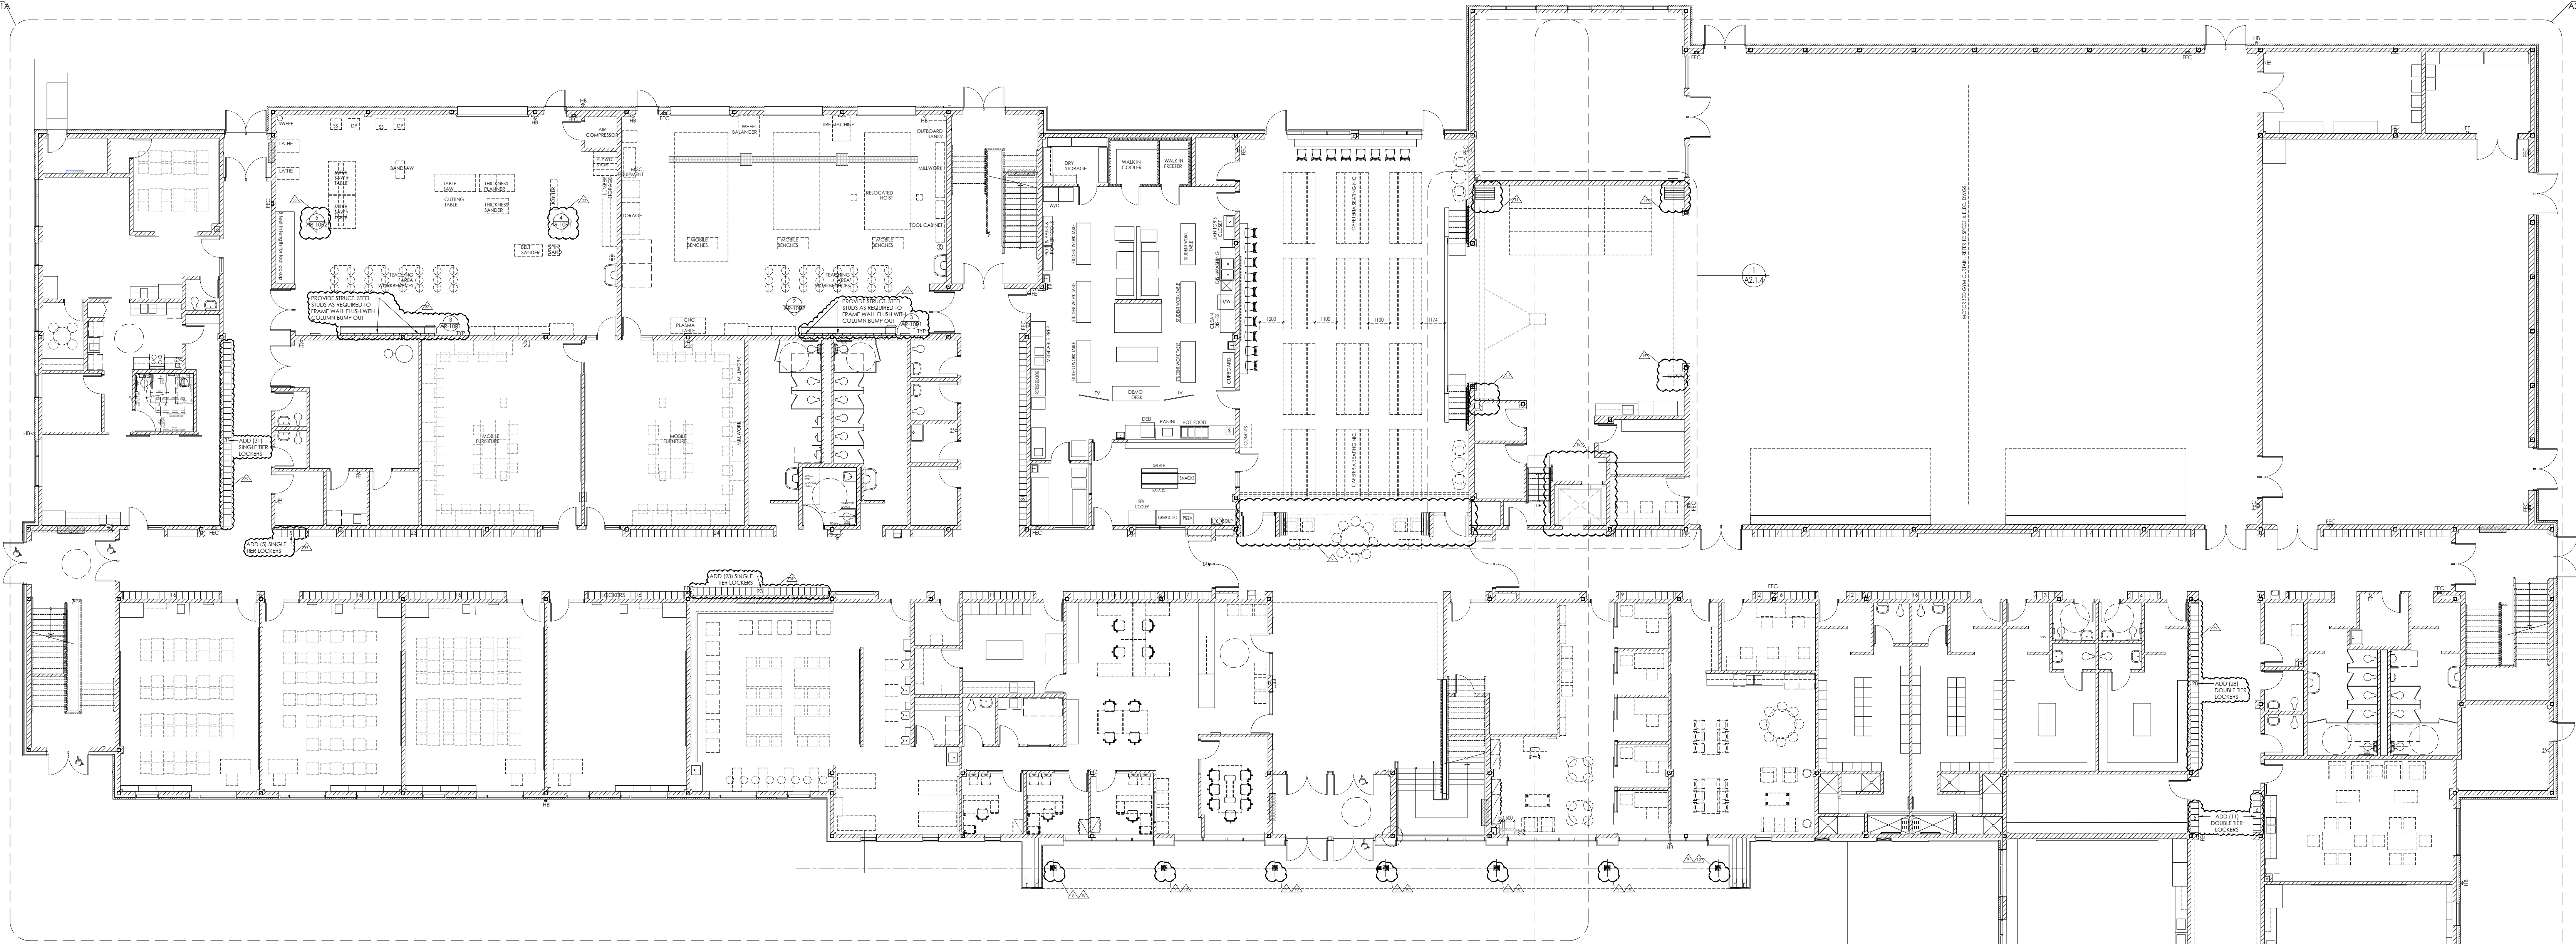

1
A2.1 FIRST FLOOR PLAN - OVERALL
0 1.5 3 7.5m


A2.1.2 & A2.1.2A

Filename: K:\TVG-Brantford\Near North DSS Parry Sound School\2211\Drawings\Wd-Current\NNA-A2.1-Apr 4-25 ED.dwg
Plot Date: Feb 03, 2026 - 5:09pm By: jkely

REVISIONS		
NO.	DATE	PARTICULAR
1	2022.04.06	ISSUED FOR 805 CLASS B COSTING
2	2022.06.18	ISSUED FOR SPA
3	2022.09.22	ISSUED FOR OWNERS REVIEW - RFS SET
4	2022.12.16	ISSUED FOR 2nd SPA SUBMISSION
5	2023.01.31	ISSUED FOR TENDER
6	2023.02.22	ISSUED FOR ADDENDUM 9
7	2023.08.23	ISSUED FOR CONVENIENCE
8	2023.11.20	ISSUED FOR PERMIT COMMENTS
9	2024.01.24	ISSUED FOR SH03
10	2024.02.15	ISSUED FOR PCN#038
11	2024.03.04	ISSUED FOR PCN#039
12	2024.03.10	ISSUED FOR SH004
13	2024.05.14	ISSUED FOR SH004
14	2024.07.22	ISSUED FOR SH008
15	2024.08.07	ISSUED FOR SH009
16	2024.10.02	ISSUED FOR PCN#15
17	2025.04.11	ISSUED FOR CO#019
18	2025.05.01	ISSUED FOR CO#07
19	2025.05.28	ISSUED FOR PCN#20 - CO#010
20	2025.07.31	ISSUED FOR SH013
21	2025.08.06	ISSUED FOR SH014
22	2025.08.15	ISSUED FOR PCN#25 - CO#017
23	2025.08.25	ISSUED FOR PCN#27 - CO#021
24	2025.09.02	ISSUED FOR PCN#29
25	2025.09.02	ISSUED FOR SH020 - CO#018
26	2025.09.08	ISSUED FOR PCN#31
27	2025.09.09	ISSUED FOR PCN#32 - CO#022
28	2025.09.10	ISSUED FOR PCN#33
29	2025.09.11	ISSUED FOR SH022
30	2025.09.15	ISSUED FOR SH023
31	2025.09.16	ISSUED FOR PCN #35 - CO#023
32	2025.09.30	ISSUED FOR PCN #37 - CO#019
33	2025.09.30	ISSUED FOR PCN #38 - CO#025
34	2025.10.04	ISSUED FOR PCN #39 - CO#024
35	2025.10.20	ISSUED FOR PCN #40
36	2025.10.30	ISSUED FOR PCN#41
37	2025.10.23	ISSUED FOR PCN #42
38	2025.11.21	ISSUED FOR PCN#021/R1 - CO12 CO#01
39	2025.11.14	ISSUED FOR PCN#043
40	2025.11.26	ISSUED FOR PCN#048/1
41	2025.12.03	ISSUED FOR PCN#044 - CO#026
42	2026.02.04	ISSUED FOR RECORD SET UP TO CO#027

NOTES:

KEY PLAN:

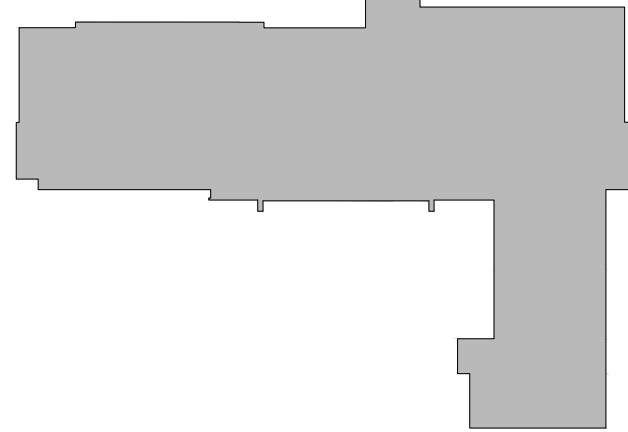


CLIENT:
NEAR NORTH DISTRICT SCHOOL BOARD
NNDSSB Tender # 2023-015

PROJECT:
NEW PARRY SOUND K-12 SCHOOL & CHILDCARE
PARRY SOUND HIGH SCHOOL SITE

111 ISABELLA STREET
PARRY SOUND, ONTARIO

ORIGINAL PAGE SIZE ARCH E1 - 30" x 42"
KEY TO DETAIL LOCATION:
A - DETAIL NO.
B - DETAIL NO. ORIGIN

VG ARCHITECTS
THE VENTIN GROUP LTD

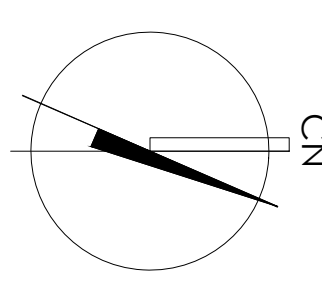

A2.1


DRAWN BY: EB/KH

CHECKED BY: PS


OVERALL FIRST FLOOR PLAN

Reproduction of drawings and related documents in whole or in part is prohibited without written permission of the design group.

All dimensions and measurements must be checked and verified by the General Contractor.

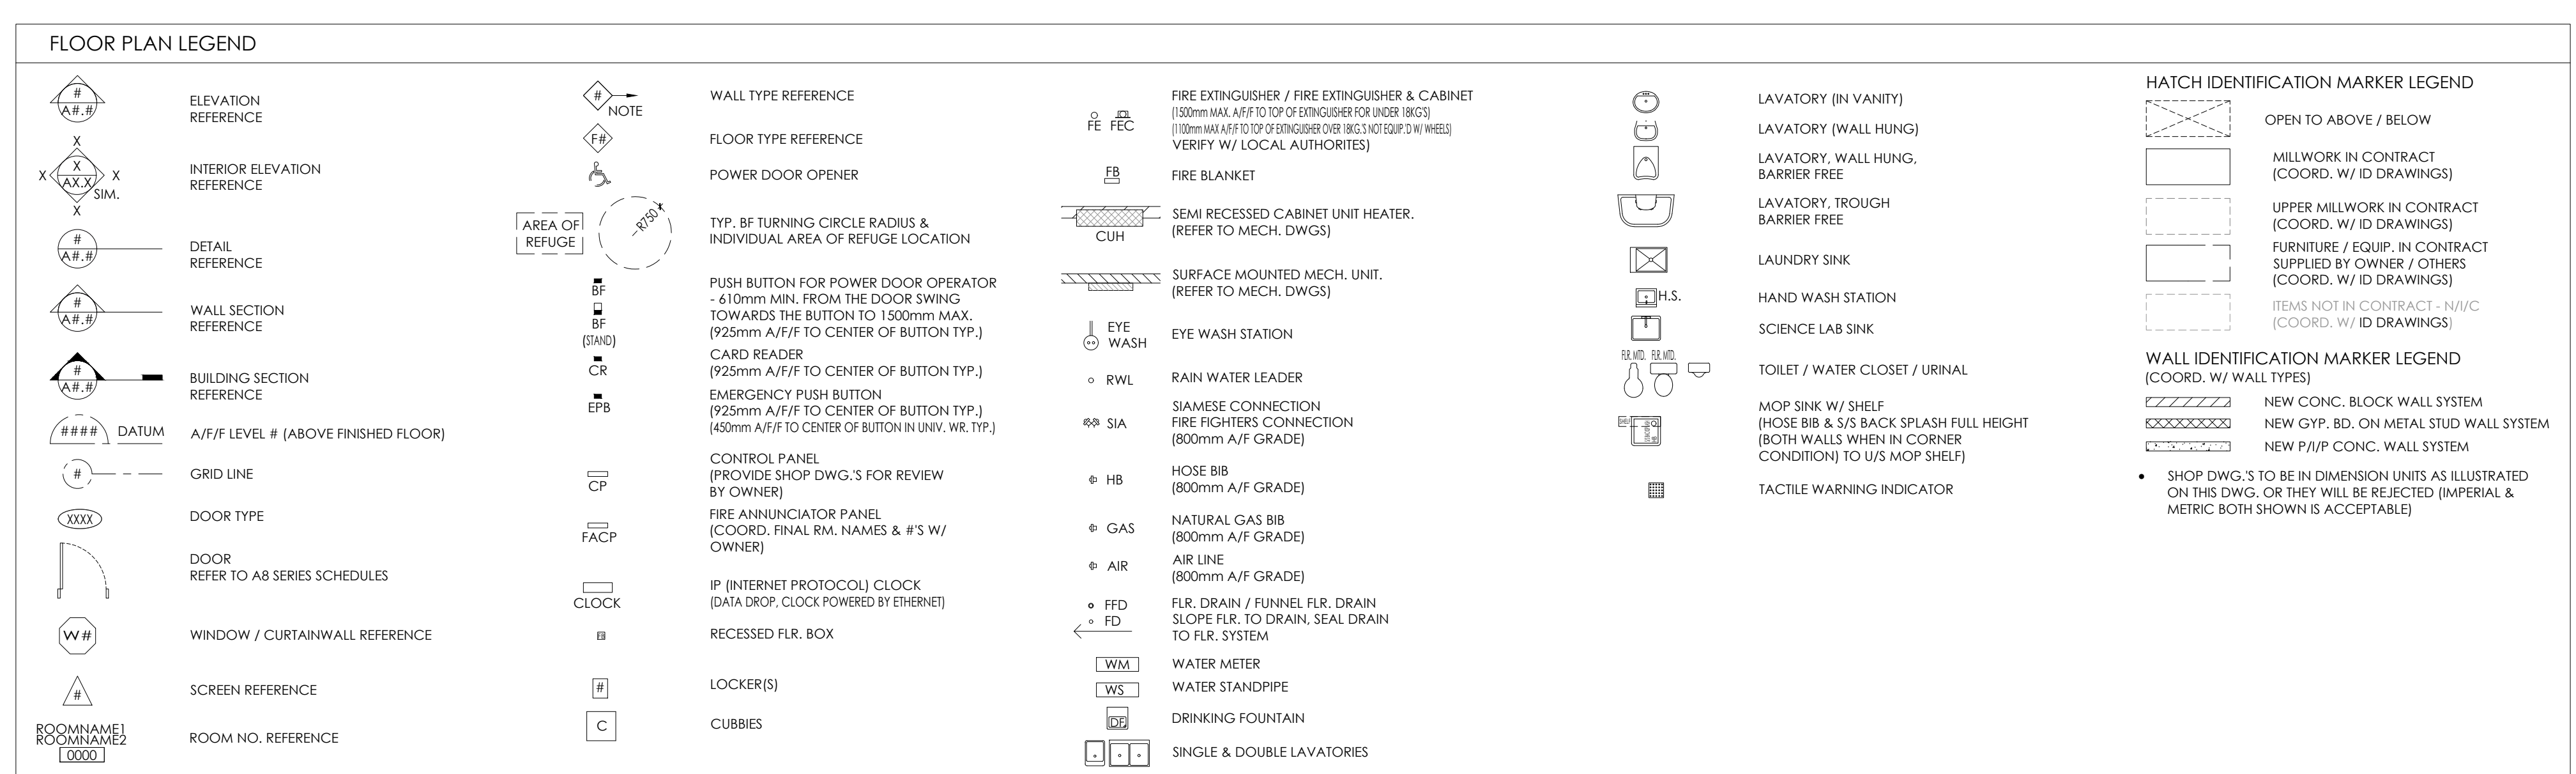

FIRST FLOOR PLAN - SOUTH WING

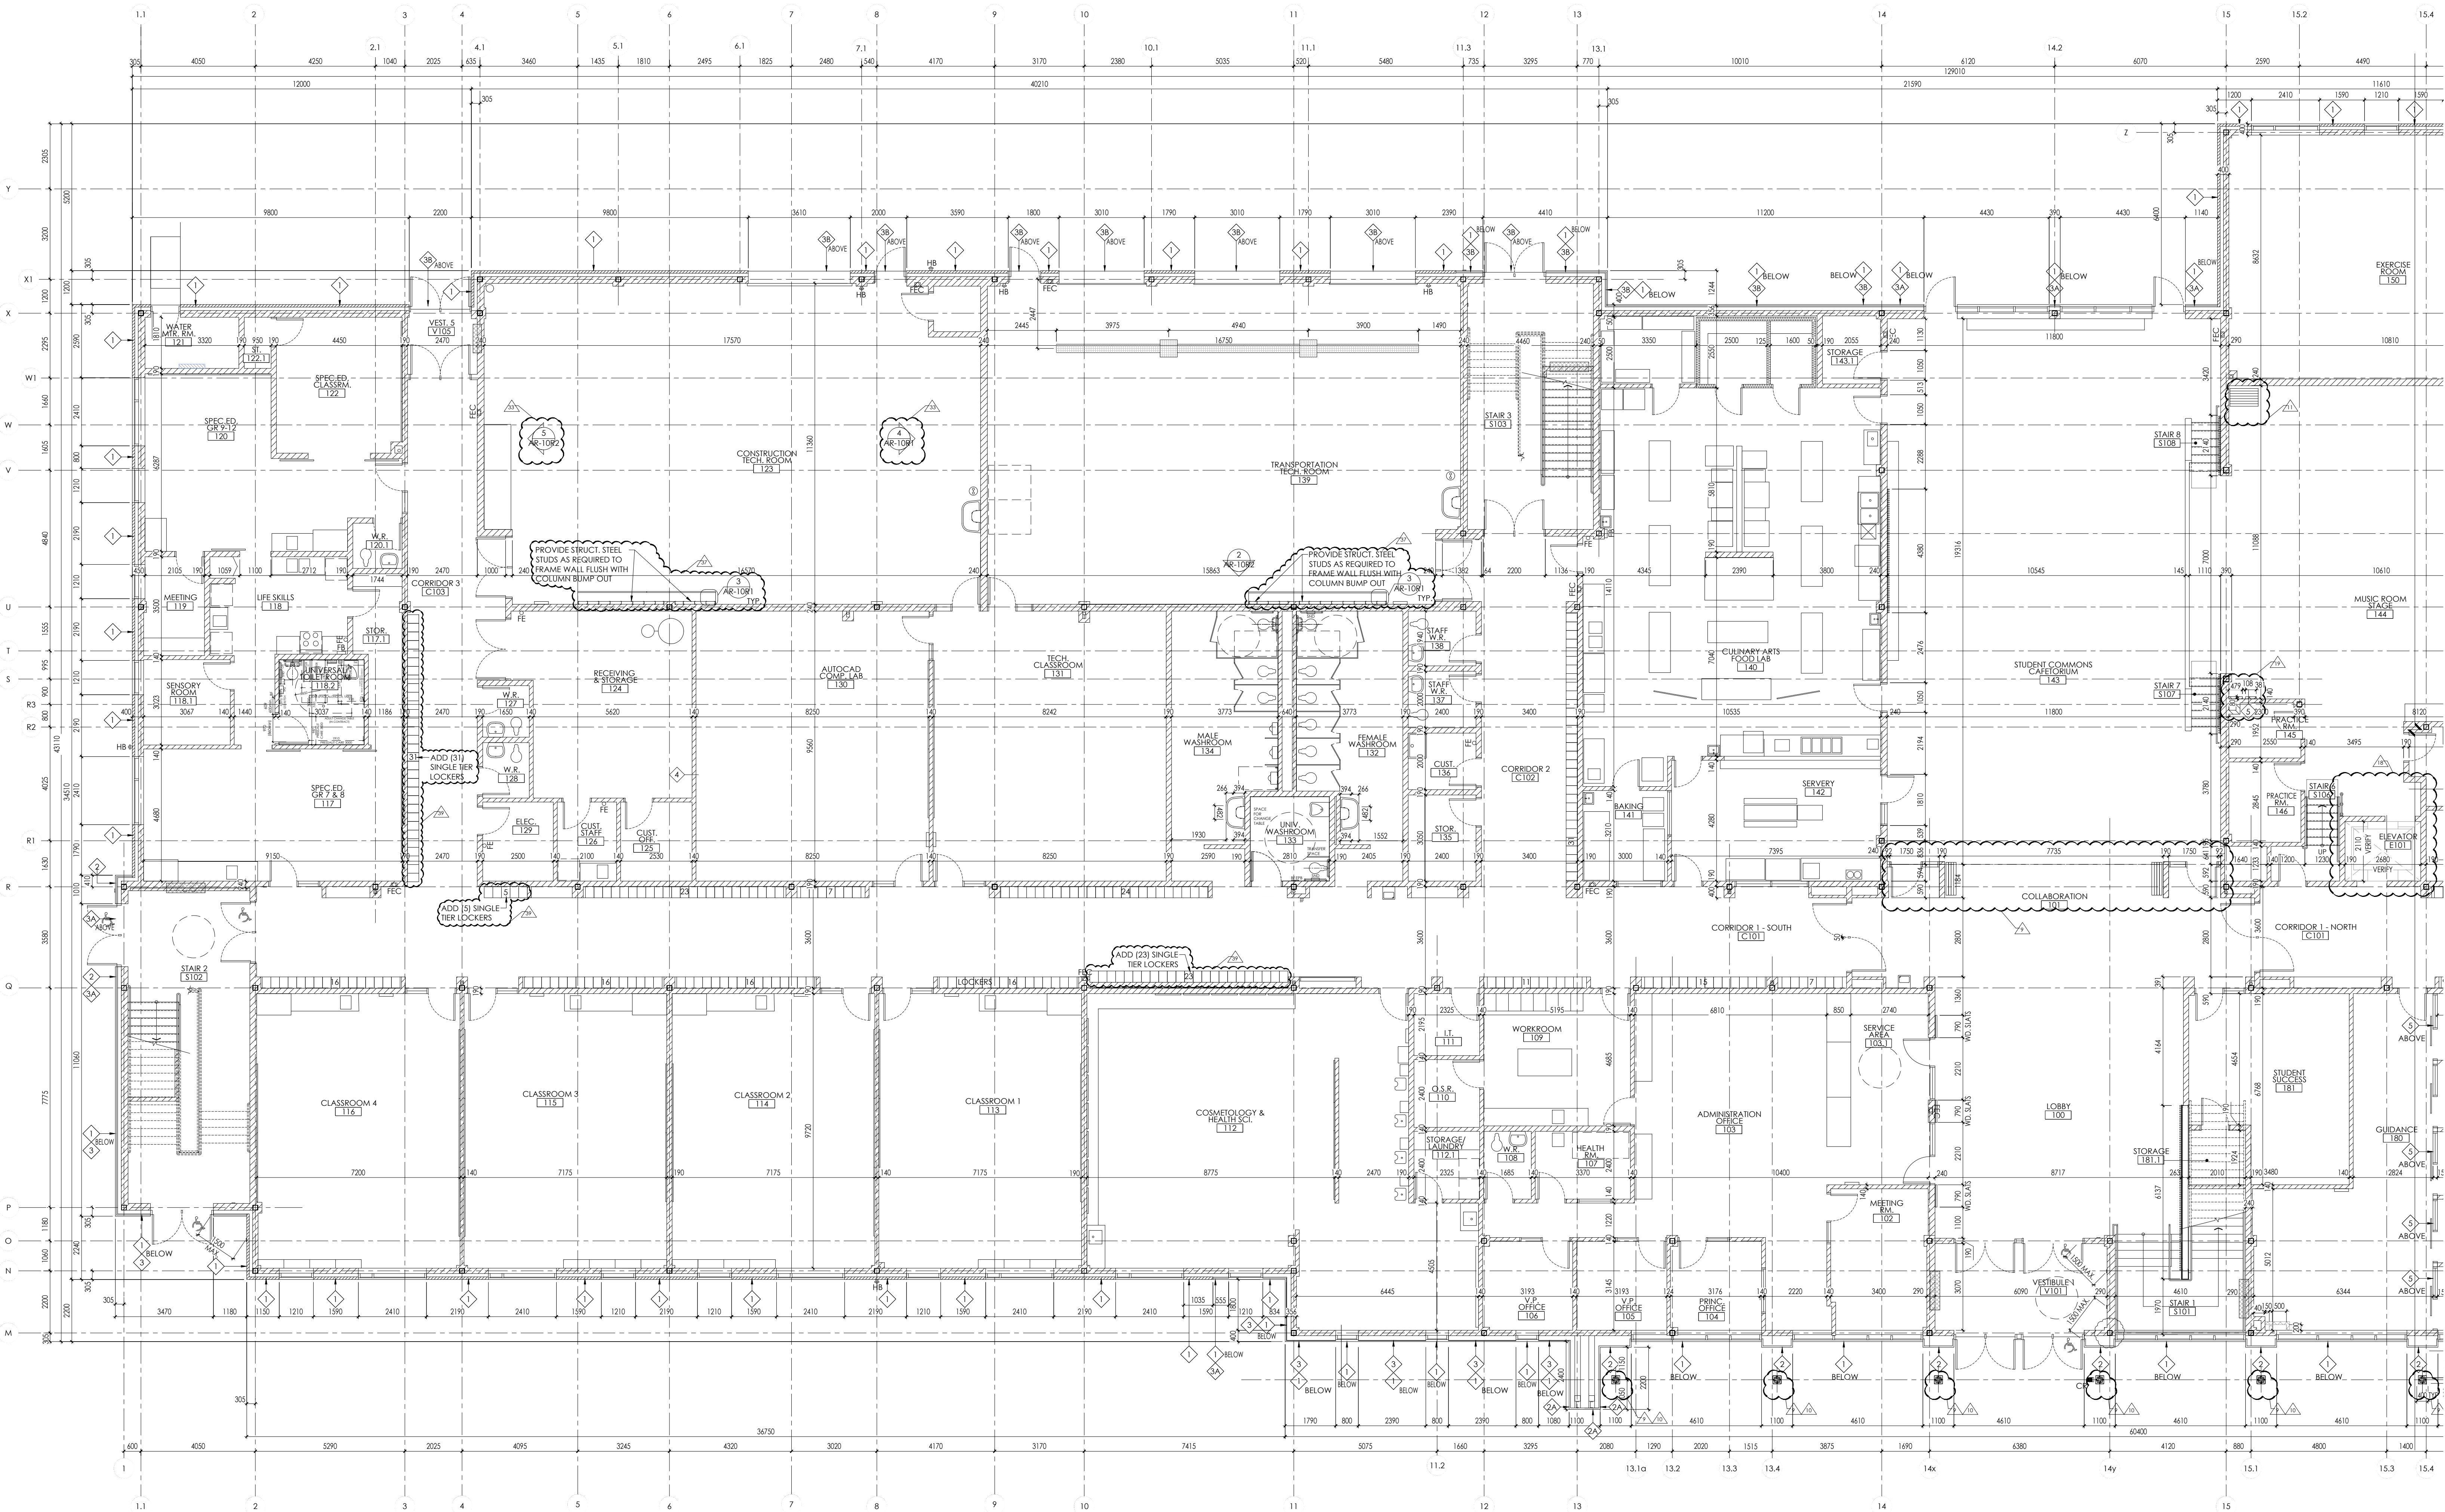


1 FIRST FLOOR DIMENSION PLAN - SOUTH WING
A2.1.1A

REFER TO SHEET A2.1.1 FOR
NOTES & LEGEND REFERENCE

REVISIONS		
NO.	DATE	PARTICULAR
1	2022.04.06	ISSUED FOR 805 CLASS B COATING
2	2022.06.18	ISSUED FOR SPA
3	2022.09.22	ISSUED FOR OWNERS REVIEW - RES SET
4	2022.12.16	ISSUED FOR 2ND SPA SUBMISSION
5	2023.01.31	ISSUED FOR TENDER
6	2023.02.22	ISSUED FOR ADDENDUM 9
7	2023.08.23	ISSUED FOR CONVENIENCE
8	2023.11.20	ISSUED FOR PERMIT COMMENTS
9	2024.01.24	ISSUED FOR SH#3
10	2024.02.15	ISSUED FOR PCN#308
11	2024.03.04	ISSUED FOR PCN#309
12	2024.03.10	ISSUED FOR SH#04
13	2024.05.14	ISSUED FOR SH#06
14	2024.07.22	ISSUED FOR SH#08
15	2024.08.07	ISSUED FOR SH#09
16	2024.10.02	ISSUED FOR PCN#15
17	2025.04.11	ISSUED FOR PCN#19
18	2025.05.01	ISSUED FOR CO#57
19	2025.05.28	ISSUED FOR PCN#20 - CO#10
20	2025.07.31	ISSUED FOR SH#13
21	2025.08.06	ISSUED FOR SH#14
22	2025.08.15	ISSUED FOR PCN#25 - CO#17
23	2025.08.25	ISSUED FOR PCN#27 - CO#21
24	2025.09.02	ISSUED FOR PCN#29
25	2025.09.02	ISSUED FOR SH#20 - CO#18
26	2025.09.08	ISSUED FOR PCN#31
27	2025.09.09	ISSUED FOR PCN#32 - CO#22
28	2025.09.10	ISSUED FOR PCN#33
29	2025.09.11	ISSUED FOR SH#22
30	2025.09.15	ISSUED FOR SH#23
31	2025.09.16	ISSUED FOR PCN F35 - CO#23
32	2025.09.30	ISSUED FOR PCN F37 - CO#19
33	2025.10.04	ISSUED FOR PCN F38 - CO#24
34	2025.10.04	ISSUED FOR PCN F39 - CO#24
35	2025.10.20	ISSUED FOR PCN F40#1
36	2025.10.30	ISSUED FOR PCN#41
37	2025.10.23	ISSUED FOR PCN F42
38	2025.11.21	ISSUED FOR PCN#21#1 - CO#2 CO#20
39	2025.11.14	ISSUED FOR PCN#43
40	2025.11.26	ISSUED FOR PCN#44
41	2025.12.03	ISSUED FOR PCN#44 - CO#26
42	2026.02.04	ISSUED FOR RECORD SET UP TO CO#27

NOTES:

KEY PLAN:

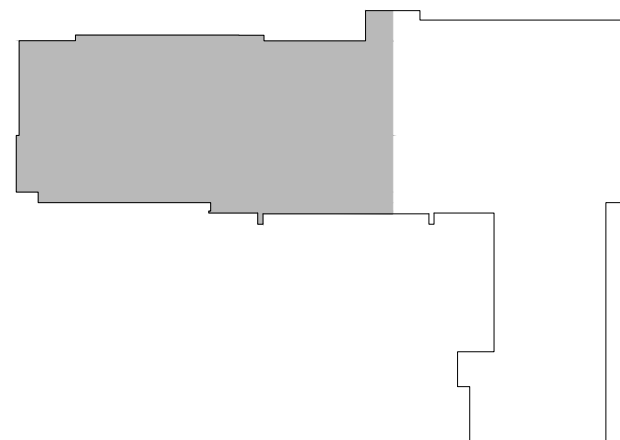


CLIENT:
NEAR NORTH DISTRICT SCHOOL BOARD
NND58 Tender # 2023-015

PROJECT:
NEW PARRY SOUND K-12 SCHOOL & CHILDCARE
PARRY SOUND HIGH SCHOOL SITE

111 ISABELLA STREET
PARRY SOUND, ONTARIO

ORIGINAL PAGE SIZE ARCH E1 - 30" x 42"
KEY TO DETAIL LOCATION:
A - DETAIL NO.
B - DETAIL NO. ORIGIN

VG ARCHITECTS
THE VENTIN GROUP LTD

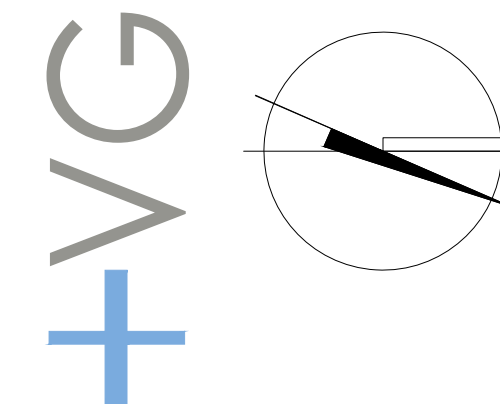


A2.1.1A

DRAWN BY : KH CHECKED BY : PS

Filename: K:\TVG\Brandford\Near North DSS PARRY SOUND SCHOOL\22111\Drawings\Wd-Current\NN-A2.1-Apt 4-25 ED.dwg Plot Date: Feb.03. 2026 - 5:09pm By: jkelly

FIRST FLOOR DIMENSION PLAN - SOUTH WING

All dimensions and measurements must be checked and verified by the Senior Contractor. Reproduction of drawings and related documents in whole or in part is prohibited without written permission of the Ventin Group.

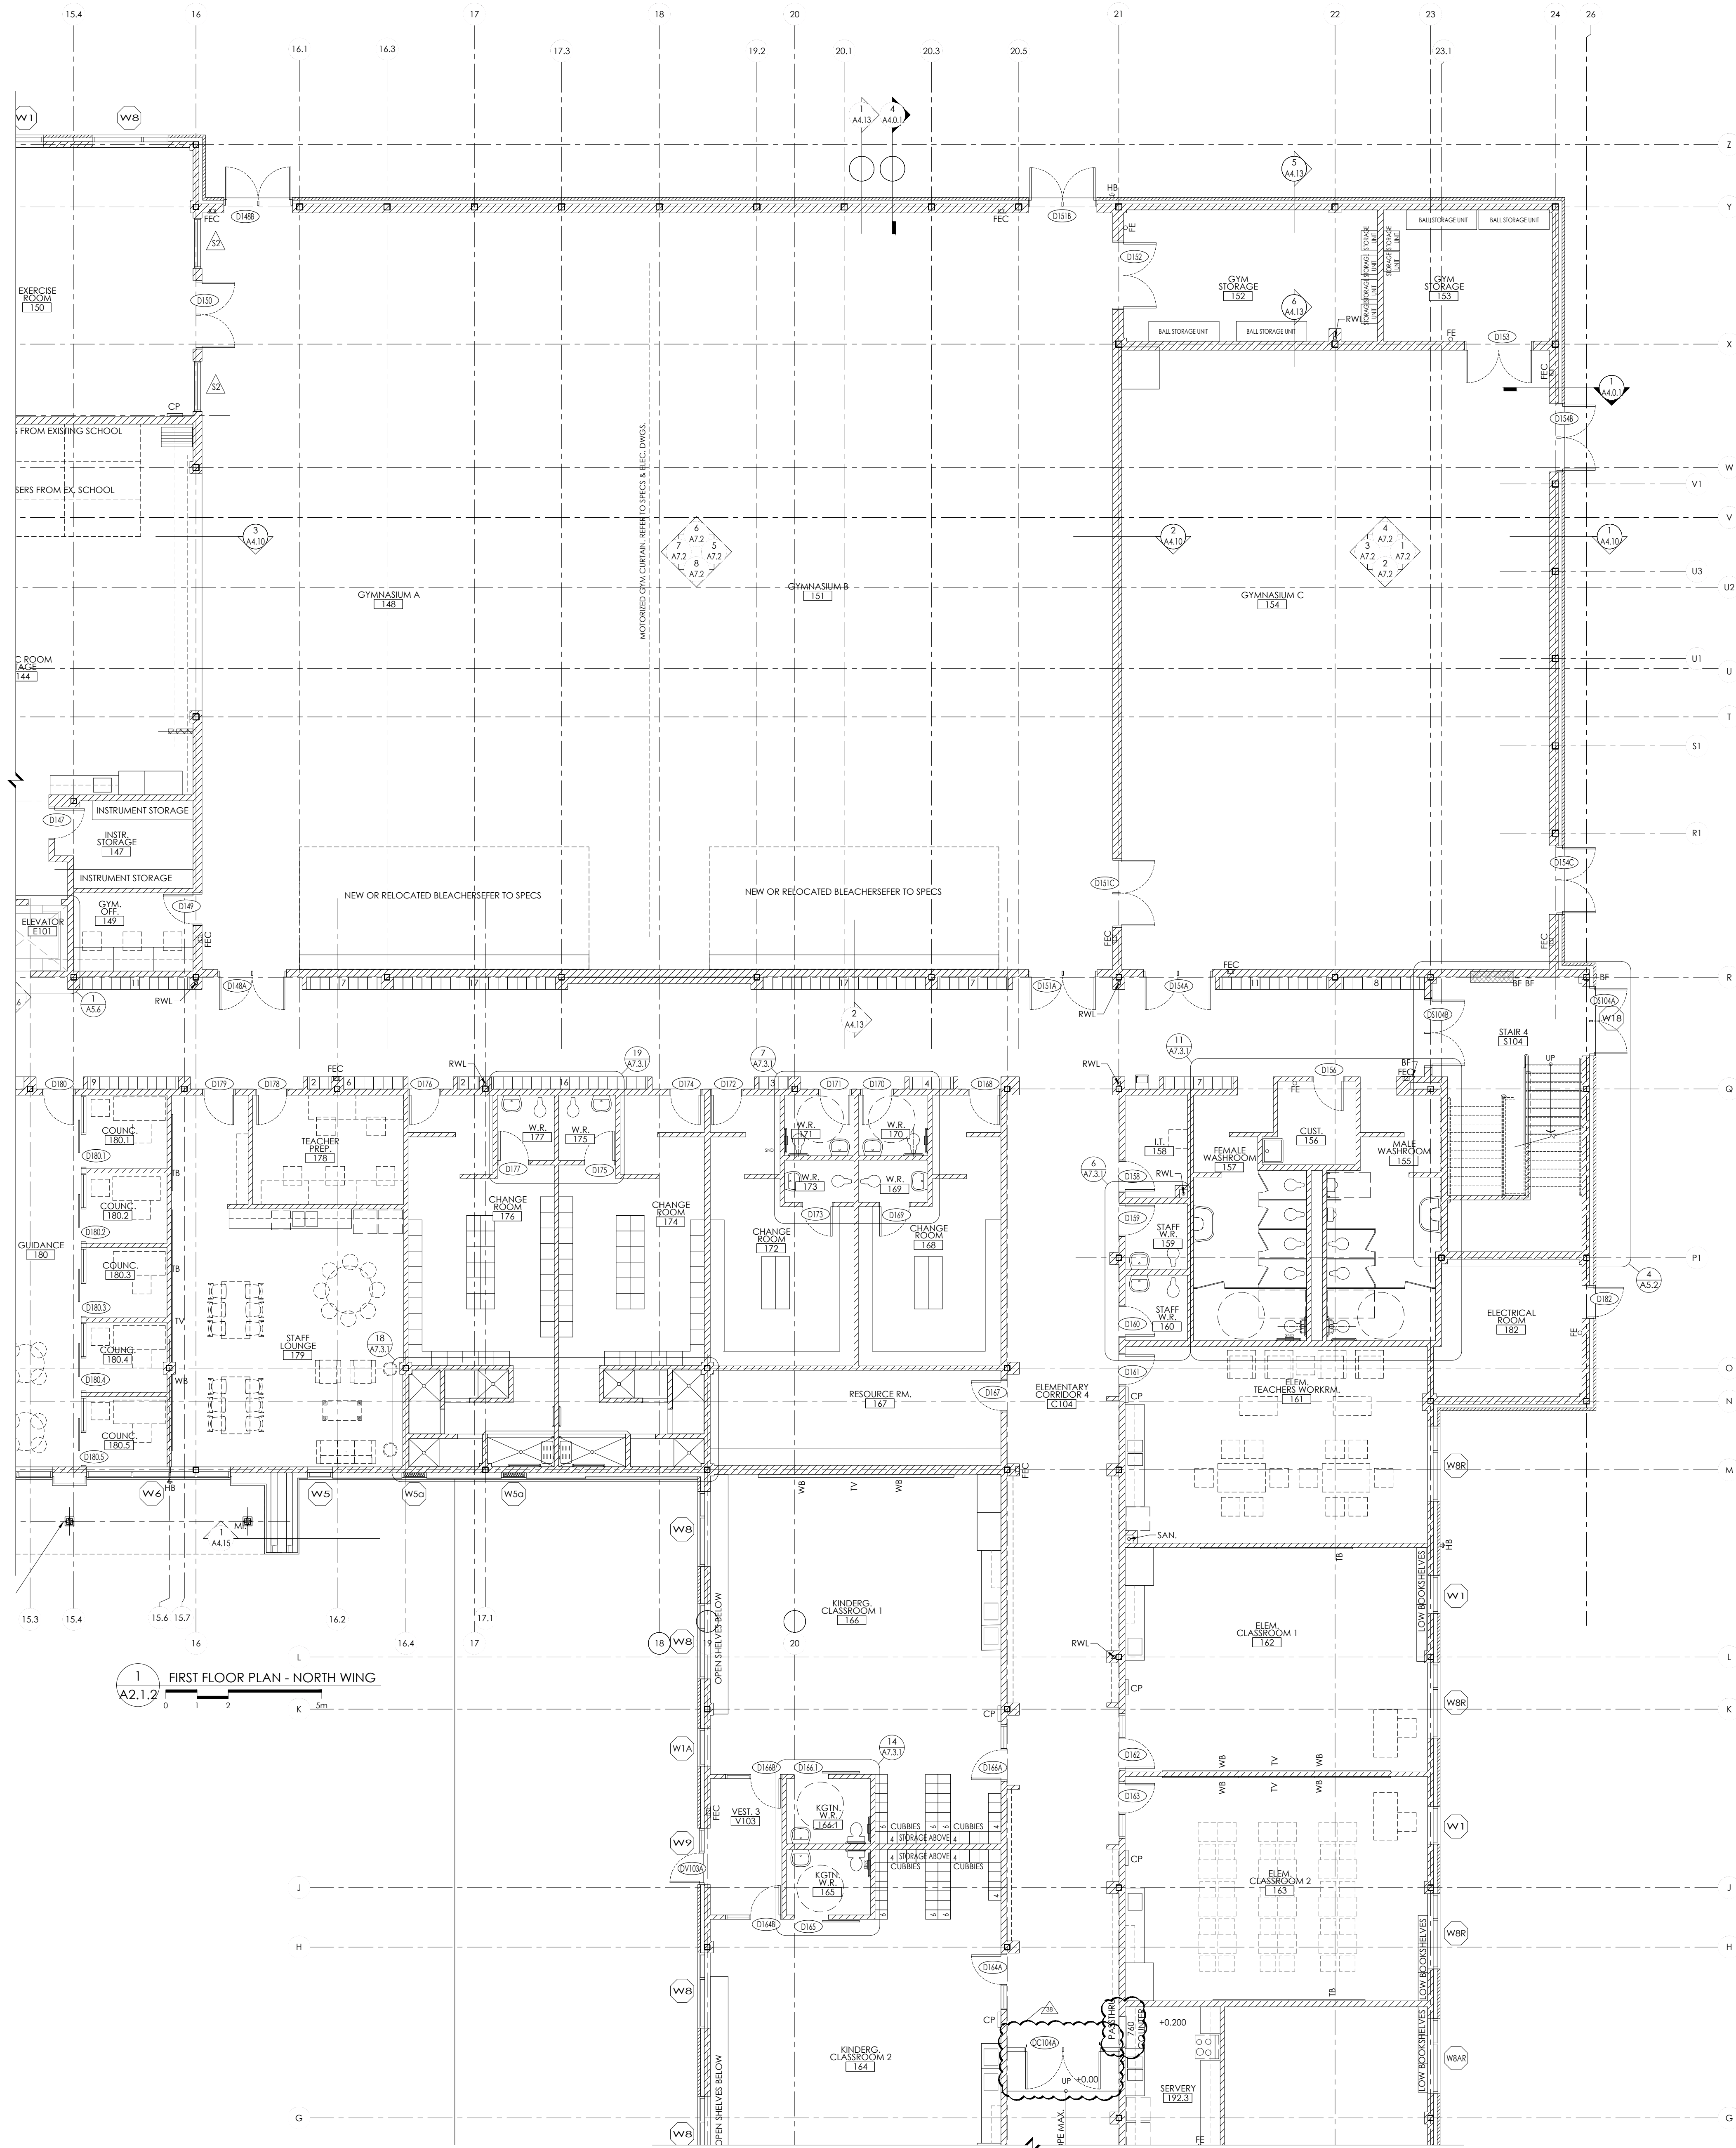


REFER TO SHEET A2.1.1 FOR
NOTES & LEGEND REFERENCE

REVISIONS		
NO.	DATE	PARTICULAR
1	2022.04.06	ISSUED FOR 80% CLASS B COSTING
2	2022.06.18	ISSUED FOR SPA
3	2022.09.22	ISSUED FOR OWNERS REVIEW - RRS SET
4	2022.12.16	ISSUED FOR 2nd SPA SUBMISSION
5	2023.01.31	ISSUED FOR TENDER
6	2023.02.22	ISSUED FOR ADDENDUM 9
7	2023.08.23	ISSUED FOR CONVENIENCE
8	2023.11.20	ISSUED FOR PERMIT COMMENTS
9	2024.01.24	ISSUED FOR SH03
10	2024.02.15	ISSUED FOR PCH038
11	2024.03.04	ISSUED FOR PCH039
12	2024.03.18	ISSUED FOR NDS0643
13	2024.05.14	ISSUED FOR SH04
14	2024.07.22	ISSUED FOR SH08
15	2024.08.07	ISSUED FOR SH09
16	2024.10.02	ISSUED FOR PCH015
17	2025.04.11	ISSUED FOR PCH019
18	2025.05.01	ISSUED FOR CO#07
19	2025.05.28	ISSUED FOR PCH020 - CO#010
20	2025.07.31	ISSUED FOR SH013
21	2025.08.06	ISSUED FOR SH014
22	2025.08.15	ISSUED FOR PCH025 - CO#017
23	2025.08.25	ISSUED FOR PCH027 - CO#021
24	2025.09.02	ISSUED FOR PCH029
25	2025.09.02	ISSUED FOR SH020 - CO#018
26	2025.09.08	ISSUED FOR PCH031
27	2025.09.09	ISSUED FOR PCH032 - CO#022
28	2025.09.10	ISSUED FOR PCH033
29	2025.09.11	ISSUED FOR SH022
30	2025.09.15	ISSUED FOR SH023
31	2025.09.16	ISSUED FOR PCH F33 - CO#023
32	2025.09.30	ISSUED FOR PCH F37 - CO#019
33	2025.09.30	ISSUED FOR PCH F38 - CO#025
34	2025.10.04	ISSUED FOR PCH F39 - CO#024
35	2025.10.20	ISSUED FOR PCH F40
36	2025.10.30	ISSUED FOR PCH041
37	2025.10.23	ISSUED FOR PCH F42
38	2025.11.21	ISSUED FOR PCH021 R1 - CO12 CO#04
39	2025.11.14	ISSUED FOR PCH043
40	2025.11.26	ISSUED FOR PCH048
41	2025.12.03	ISSUED FOR PCH044 - CO#026
42	2026.02.04	ISSUED FOR RECORD SET UP TO CO#07

NOTES:

KEY PLAN:

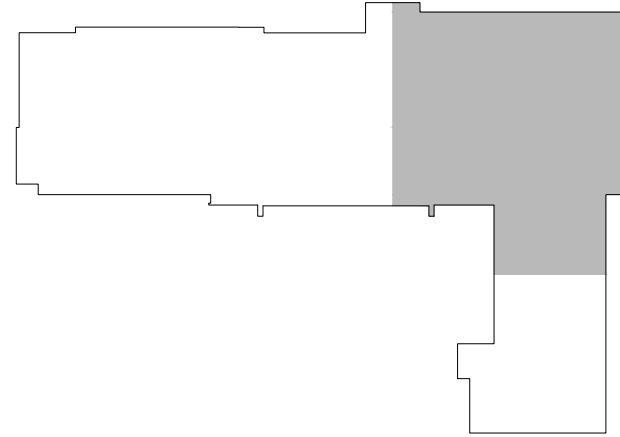

CLIENT:

NEAR NORTH DISTRICT SCHOOL BOARD
NDSB Tender # 2023-015


PROJECT:

NEW PARRY SOUND K-12 SCHOOL & CHILDCARE
PARRY SOUND HIGH SCHOOL SITE

111 ISABELLA STREET
PARRY SOUND, ONTARIO

ORIGINAL PAGE SIZE ARCH E1 - 30" x 42"
KEY TO DETAIL LOCATION:
A - DETAIL NO.
B - DETAIL NO. ORIGIN

VG ARCHITECTS
THE VENTIN GROUP LTD

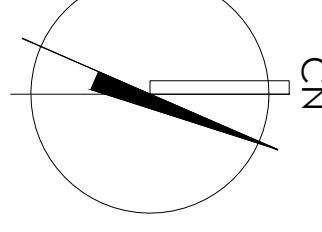

A2.1.2

Plot Date: Feb.03. 2026 - 5:09pm By: Jeky


Filename: K:\TVC\Brantford\Near North DSS Parry Sound School\2211\Drawings\Wd Current\NIN-A2.1-Apr 4-25-ED.dwg

DRAWN BY: EB/KH

CHECKED BY: PS

FIRST FLOOR PLAN - NORTH WING

All dimensions and measurements must be checked and verified by the Senior Designer/Checker and the Senior Designer/Checker.

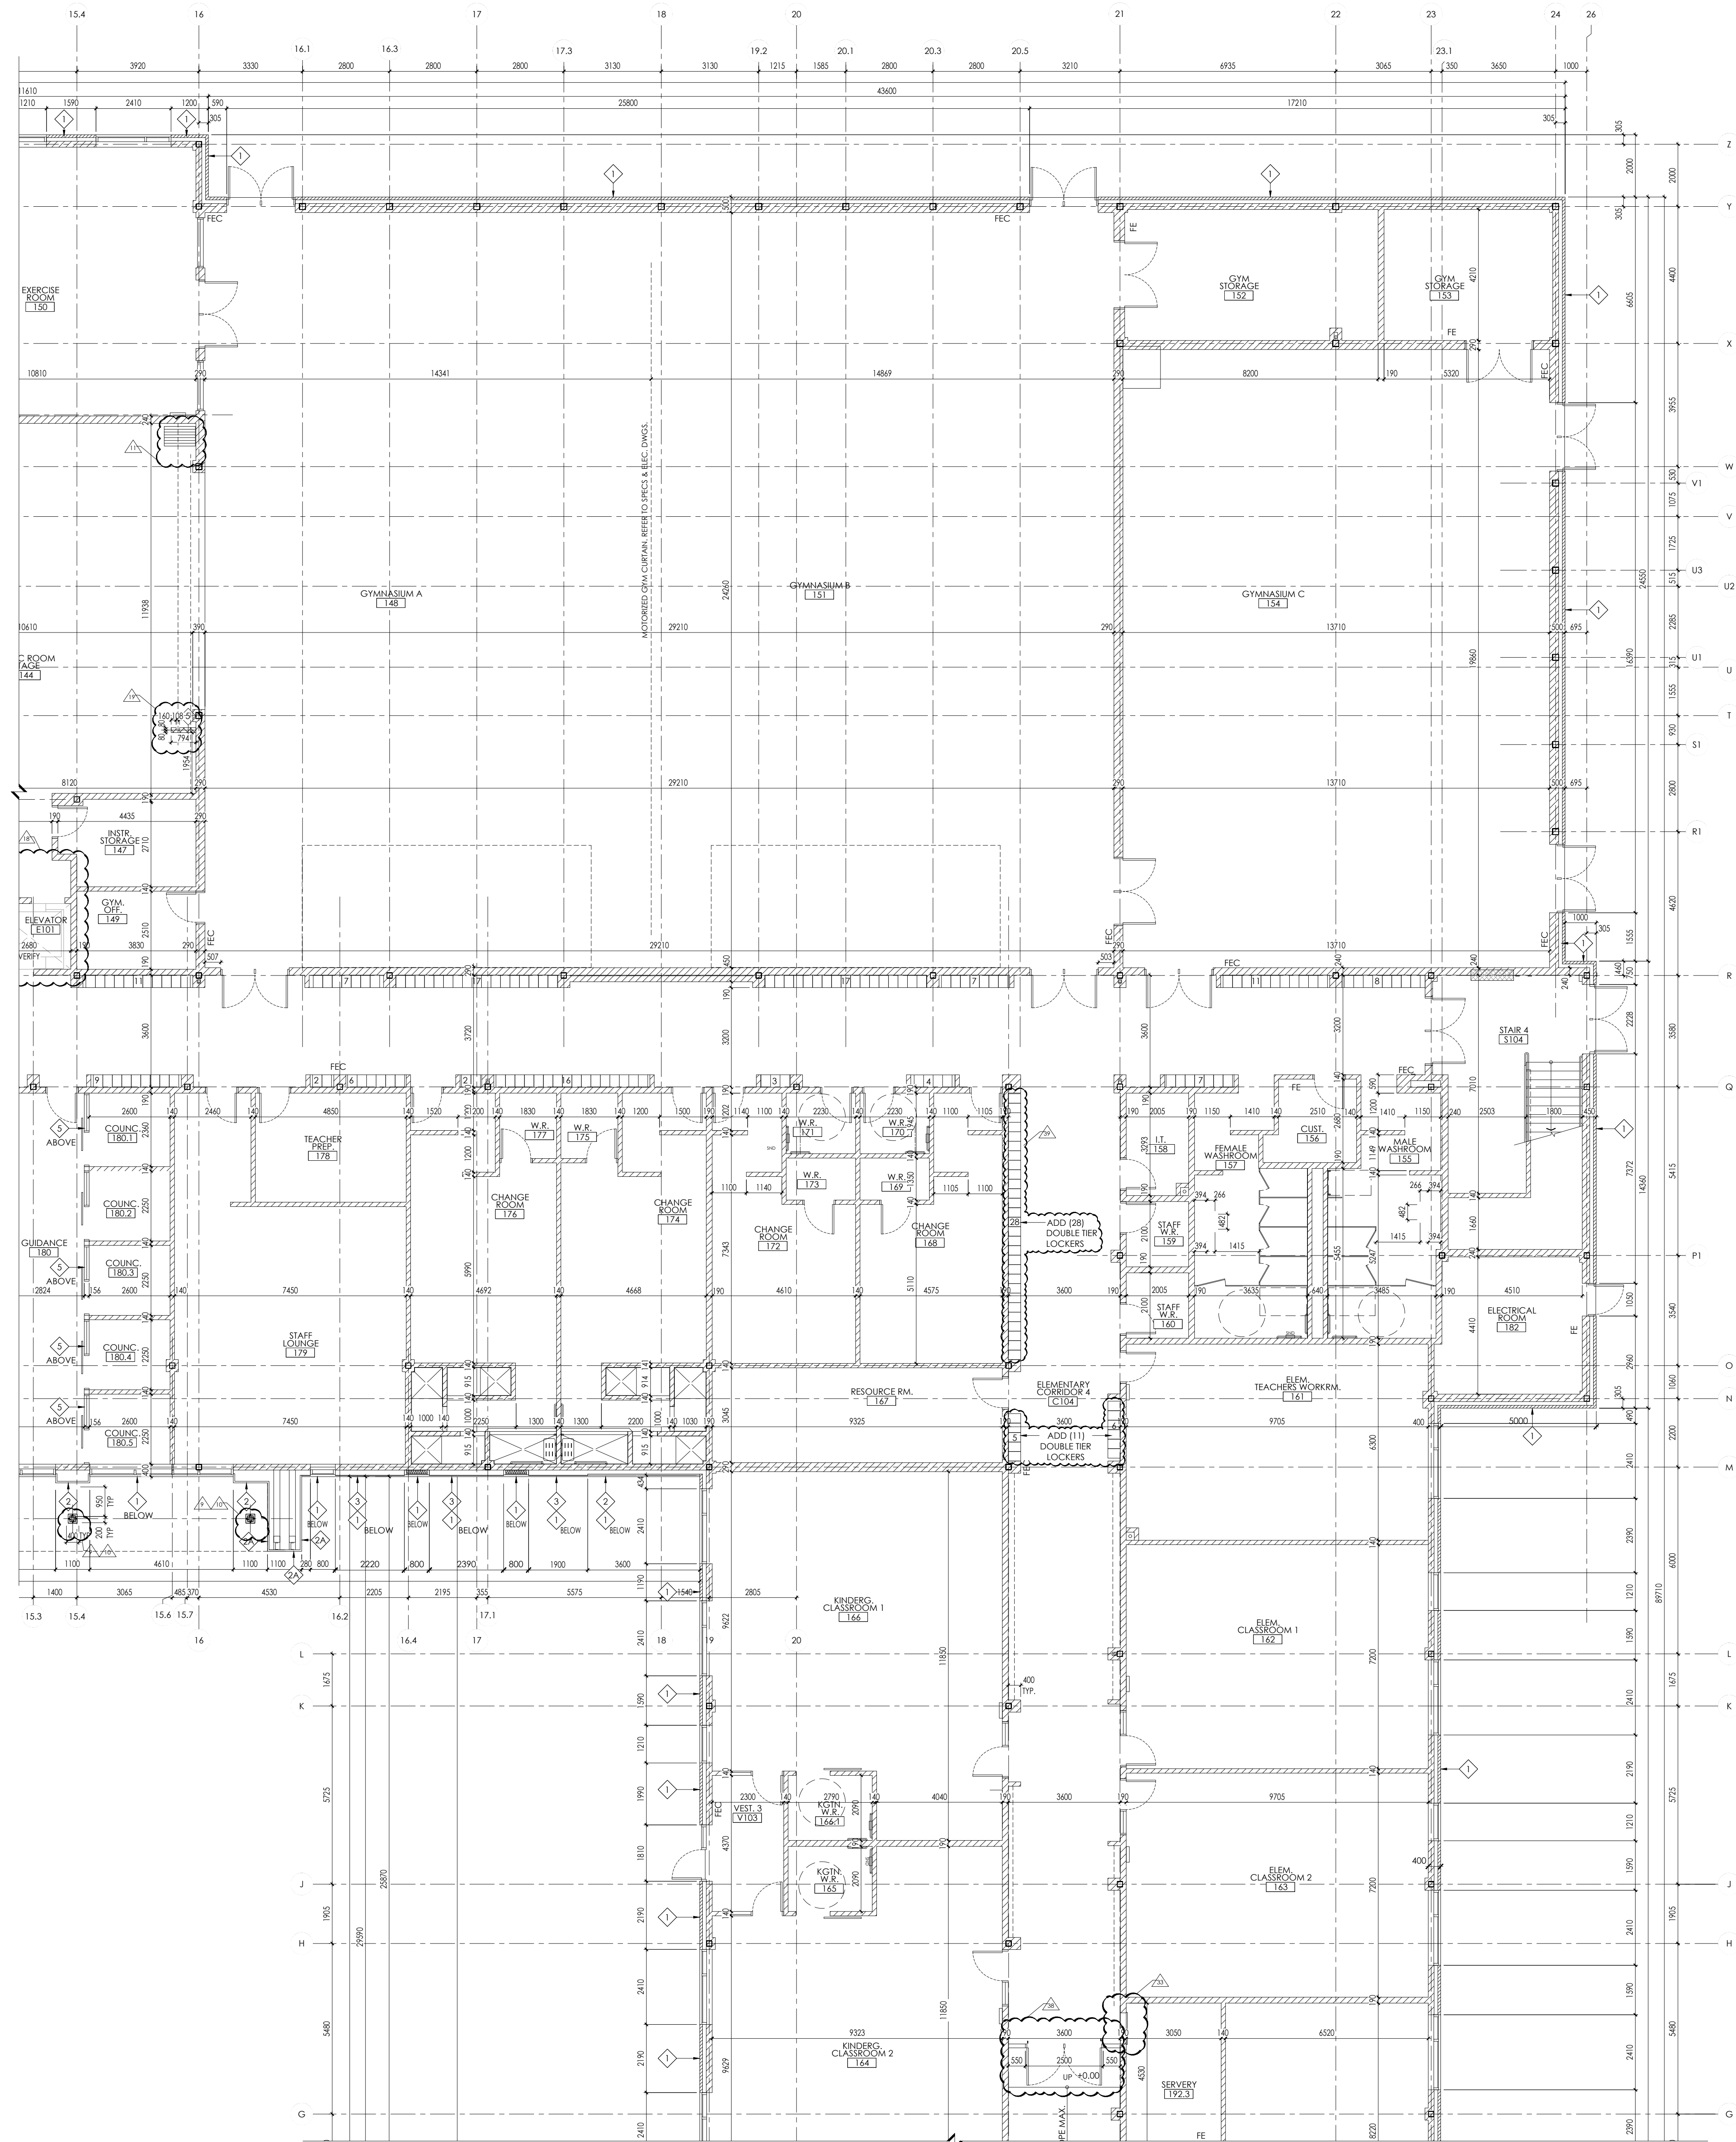


2 FIRST FLOOR DIMENSION PLAN - NORTH WING
A2.1.2A
0 1 2 5m

REFER TO SHEET A2.1.1 FOR
NOTES & LEGEND REFERENCE

REVISIONS		
NO.	DATE	PARTICULAR
1	2022.04.06	ISSUED FOR 805 CLASS B COSTING
2	2022.06.18	ISSUED FOR SPA
3	2022.09.22	ISSUED FOR OWNERS REVIEW - RES SET
4	2022.12.16	ISSUED FOR 2ND SPA SUBMISSION
5	2023.01.31	ISSUED FOR TENDER
6	2023.02.22	ISSUED FOR ADDENDUM 9
7	2023.08.23	ISSUED FOR CONVENIENCE
8	2023.11.20	ISSUED FOR PERMIT COMMENTS
9	2024.01.24	ISSUED FOR SH03
10	2024.02.15	ISSUED FOR PCN#08
11	2024.03.04	ISSUED FOR PCN#09
12	2024.03.10	ISSUED FOR SH04
13	2024.05.14	ISSUED FOR SH04
14	2024.07.22	ISSUED FOR SH08
15	2024.08.07	ISSUED FOR SH09
16	2024.10.02	ISSUED FOR PCN#15
17	2025.04.11	ISSUED FOR PCN#19
18	2025.05.01	ISSUED FOR CO#07
19	2025.05.28	ISSUED FOR PCN#20 - CO#10
20	2025.07.31	ISSUED FOR SH013
21	2025.08.06	ISSUED FOR SH014
22	2025.08.15	ISSUED FOR PCN#25 - CO#017
23	2025.08.25	ISSUED FOR PCN#27 - CO#021
24	2025.09.02	ISSUED FOR PCN#29
25	2025.09.02	ISSUED FOR SH020 - CO#018
26	2025.09.08	ISSUED FOR PCN#31
27	2025.09.09	ISSUED FOR PCN#32 - CO#022
28	2025.09.10	ISSUED FOR PCN#33
29	2025.09.11	ISSUED FOR SH022
30	2025.09.15	ISSUED FOR SH023
31	2025.09.16	ISSUED FOR PCN F35 - CO#023
32	2025.09.30	ISSUED FOR PCN#37 - CO#019
33	2025.09.30	ISSUED FOR PCN#38 - CO#025
34	2025.10.04	ISSUED FOR PCN#39 - CO#024
35	2025.10.20	ISSUED FOR PCN#40
36	2025.10.30	ISSUED FOR PCN#41
37	2025.10.23	ISSUED FOR PCN#42
38	2025.11.21	ISSUED FOR PCN#021 R#1 - CO12 CO#04
39	2025.11.14	ISSUED FOR PCN#043
40	2025.11.26	ISSUED FOR PCN#048
41	2025.12.03	ISSUED FOR PCN#044 - CO#026
42	2026.02.04	ISSUED FOR RECORD SET UP TO CO#027

NOTES:

KEY PLAN:

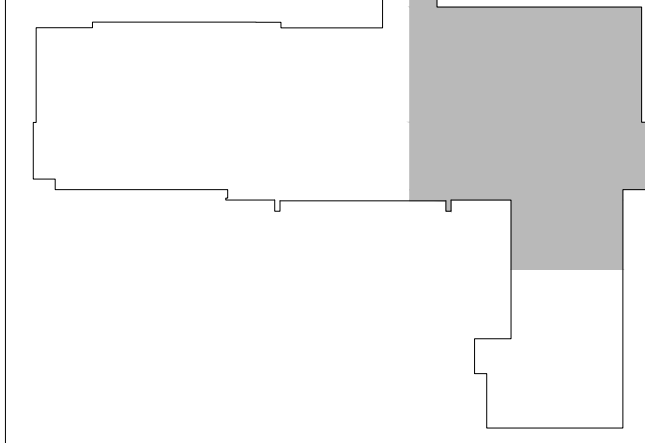


CLIENT:
NEAR NORTH DISTRICT SCHOOL BOARD
NND58 Tender # 2023-015

PROJECT:
NEW PARRY SOUND K-12 SCHOOL & CHILDCARE
PARRY SOUND HIGH SCHOOL SITE

111 ISABELLA STREET
PARRY SOUND, ONTARIO

ORIGINAL PAGE SIZE ARCH E1 - 30" x 42"
KEY TO DETAIL LOCATION:
A - DETAIL NO.
B - DETAIL NO. ORIGIN

VG ARCHITECTS
THE VENTIN GROUP LTD

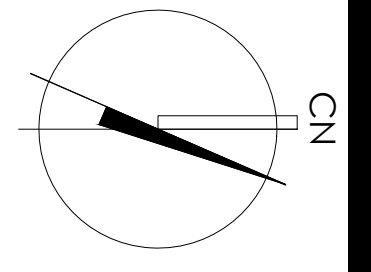


A2.1.2A

DRAWN BY: KH CHECKED BY: PS

Filename: K:\TVG-Brandford\Near North DSS Parry Sound\School\2211\Drawings\W4-Current\NNA-A2.1-Arch 4.25 ED.dwg
Plot Date: Feb 03, 2026 - 5:09pm By: Kelly

FIRST FLOOR DIMENSION PLAN - NORTH WING

Reproduction of drawings and related documents in whole or in parts
checked and sealed by the Sealed Contractor

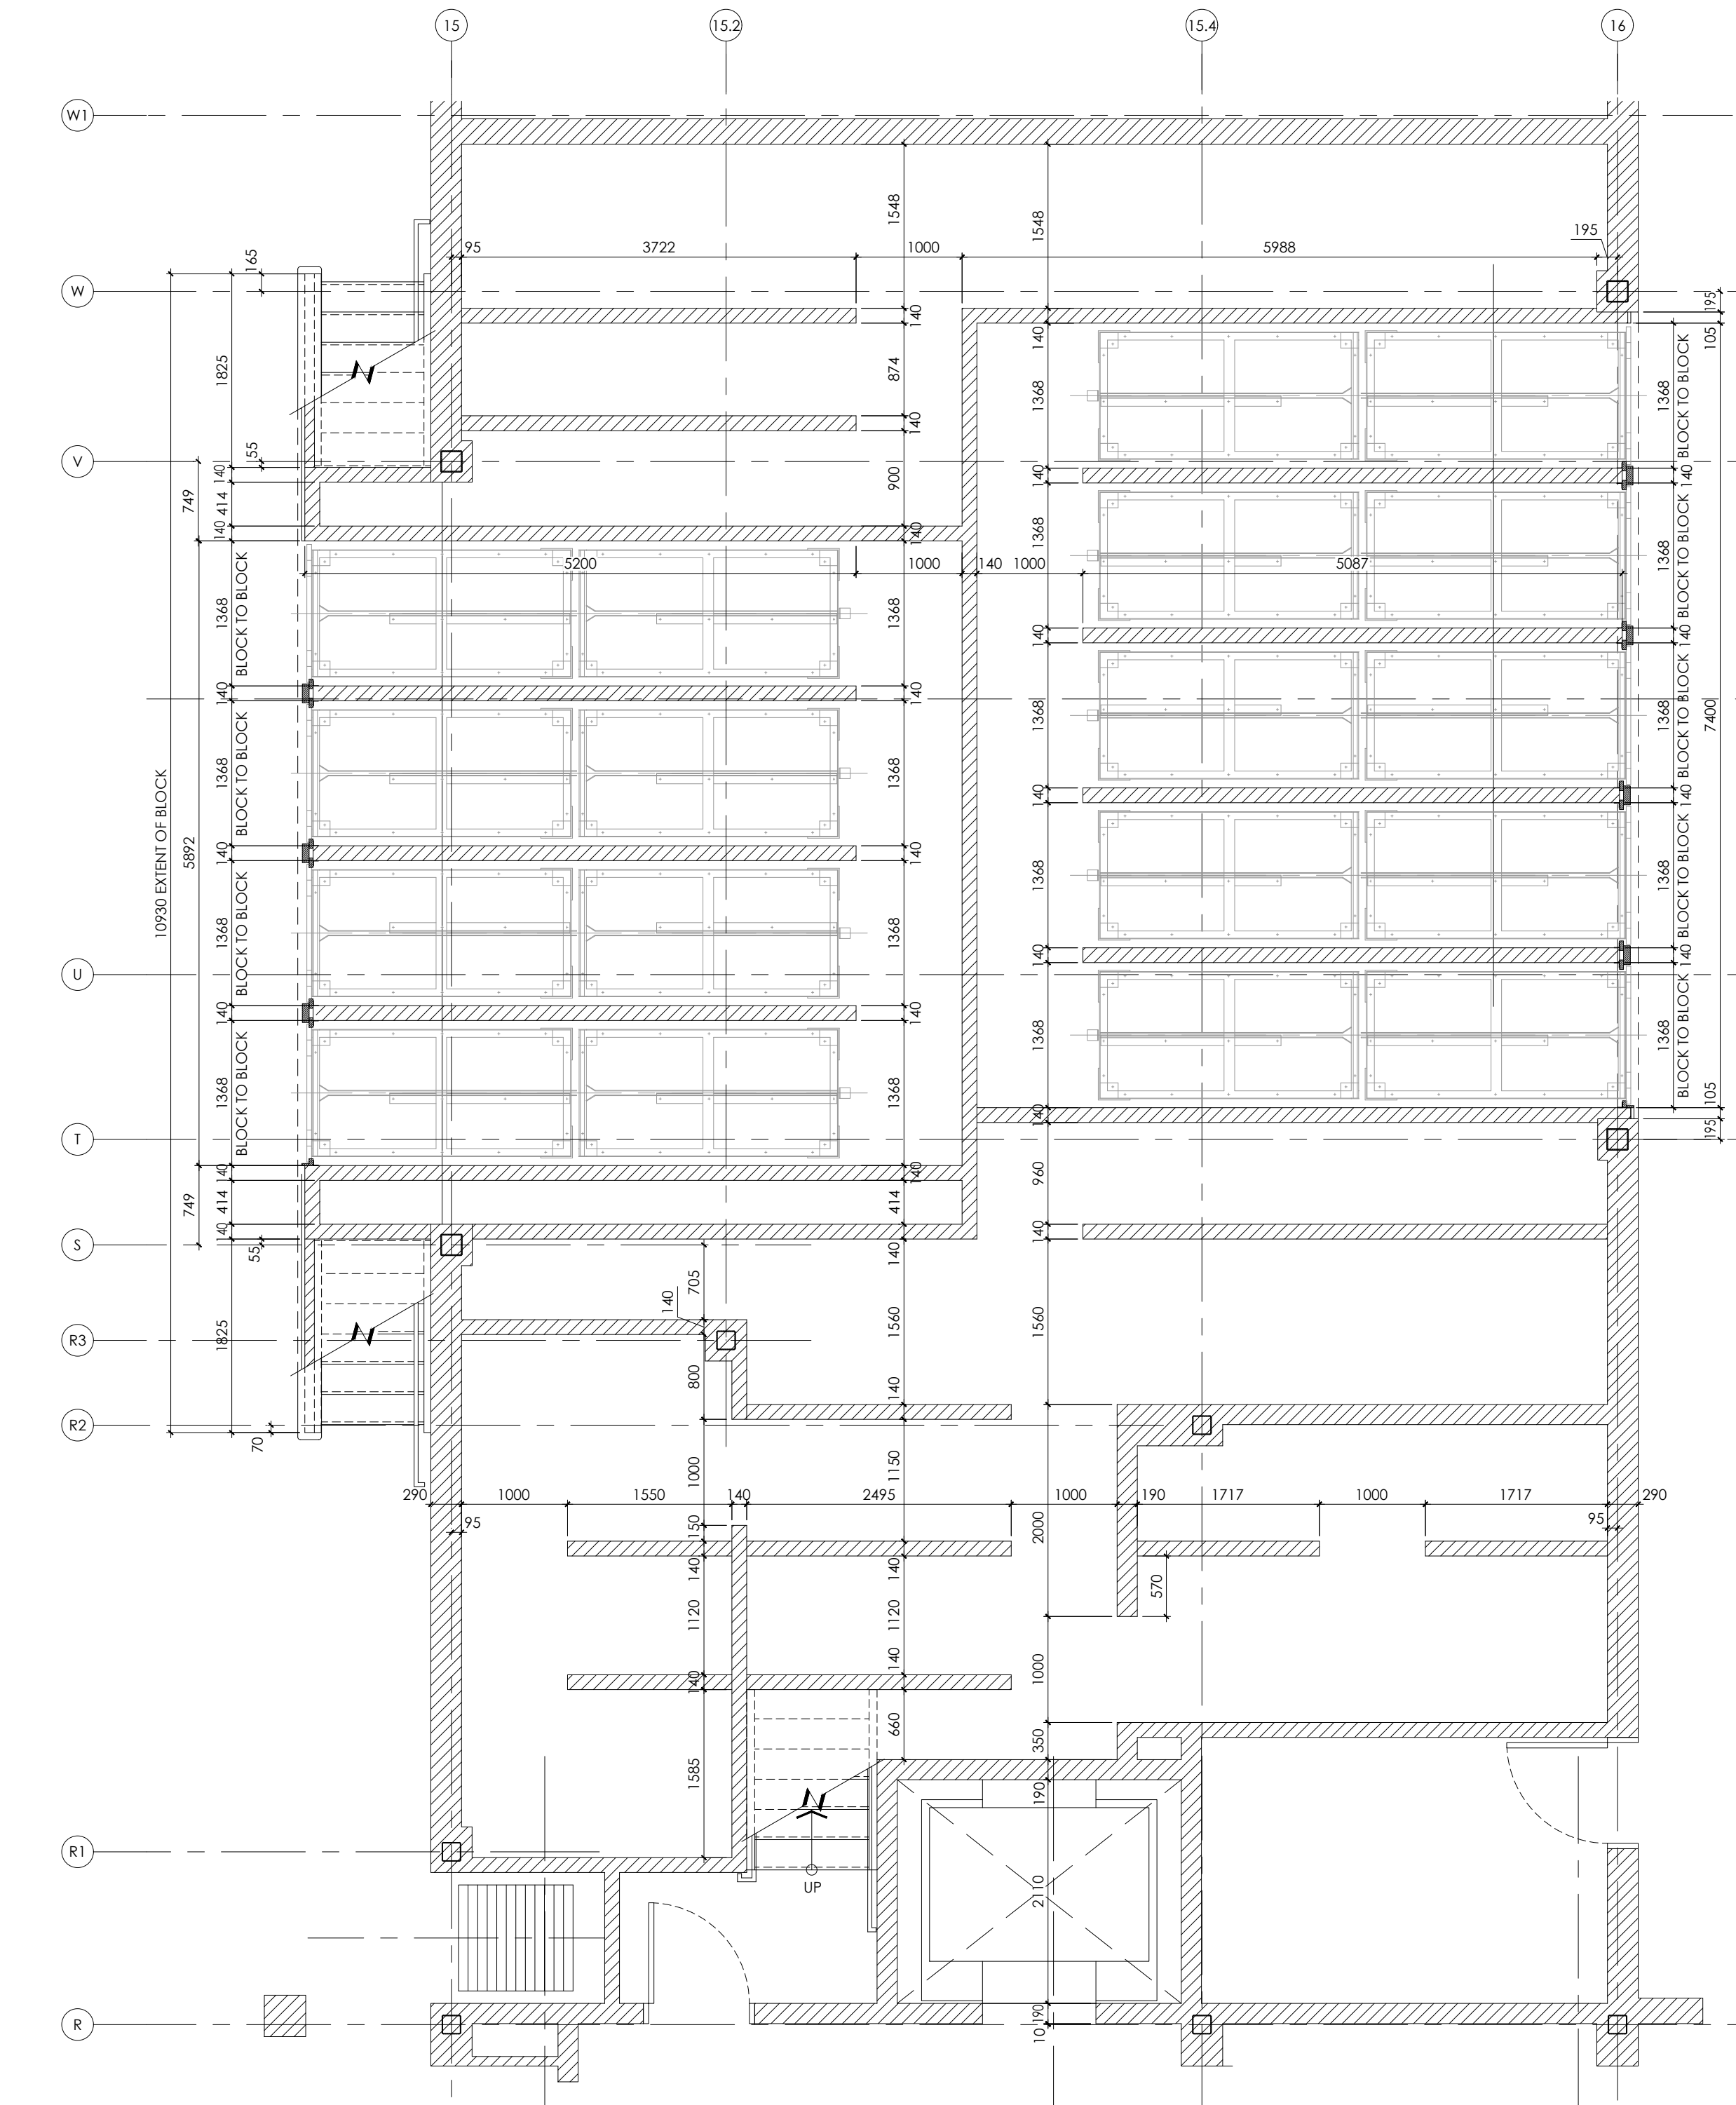

REFER TO SHEET A2.1.1 FOR
NOTES & LEGEND REFERENCE

REVISIONS		
NO.	DATE	PARTICULAR
1	2022.04.06	ISSUED FOR 80% CLASS B COSTING
2	2022.06.18	ISSUED FOR SPA
3	2022.09.22	ISSUED FOR OWNERS REVIEW - RFS SET
4	2022.12.16	ISSUED FOR 2nd SPA SUBMISSION
5	2023.01.31	ISSUED FOR TENDER
6	2023.02.22	ISSUED FOR ADDENDUM 9
7	2023.08.23	ISSUED FOR CONVENIENCE
8	2023.11.20	ISSUED FOR PERMIT COMMENTS
9	2024.01.24	ISSUED FOR SH03
10	2024.02.15	ISSUED FOR PCH0308
11	2024.03.04	ISSUED FOR PCH0409
12	2024.03.10	ISSUED FOR SH004
13	2024.05.14	ISSUED FOR SH004
14	2024.07.22	ISSUED FOR SH008
15	2024.08.07	ISSUED FOR SH009
16	2024.10.02	ISSUED FOR PCH015
17	2025.04.11	ISSUED FOR PCH019
18	2025.05.01	ISSUED FOR CO#07
19	2025.05.28	ISSUED FOR PCH020 - CO#010
20	2025.07.31	ISSUED FOR SH013
21	2025.08.06	ISSUED FOR SH014
22	2025.08.15	ISSUED FOR PCH025 - CO#017
23	2025.08.25	ISSUED FOR PCH027 - CO#021
24	2025.09.02	ISSUED FOR PCH029
25	2025.09.02	ISSUED FOR SH020 - CO#018
26	2025.09.08	ISSUED FOR PCH031
27	2025.09.09	ISSUED FOR PCH032 - CO#022
28	2025.09.10	ISSUED FOR PCH033
29	2025.09.11	ISSUED FOR SH022
30	2025.09.15	ISSUED FOR SH023
31	2025.09.16	ISSUED FOR PCH F33 - CO#023
32	2025.09.30	ISSUED FOR PCH F37 - CO#019
33	2025.09.30	ISSUED FOR PCH F38 - CO#025
34	2025.10.04	ISSUED FOR PCH F39 - CO#024
35	2025.10.20	ISSUED FOR PCH F40#1
36	2025.10.30	ISSUED FOR PCH0401
37	2025.10.23	ISSUED FOR PCH F42
38	2025.11.21	ISSUED FOR PCH021#1 - CO12 CO#03
39	2025.11.14	ISSUED FOR PCH0403
40	2025.11.26	ISSUED FOR PCH0401
41	2025.12.03	ISSUED FOR PCH044 - CO#026
42	2026.02.04	ISSUED FOR RECORD SET UP TO CO#07

NOTES:

KEY PLAN:



CLIENT:

NEAR NORTH DISTRICT SCHOOL BOARD
NND58 Tender # 2023-015

PROJECT:

NEW PARRY SOUND K-12 SCHOOL & CHILDCARE
PARRY SOUND HIGH SCHOOL SITE


111 ISABELLA STREET
PARRY SOUND, ONTARIO

ORIGINAL PAGE SIZE ARCH E1 - 30" x 42"

KEY TO DETAIL LOCATION:

A - DETAIL NO.
B - DETAIL NO. ORIGIN

+VG ARCHITECTS
THE VENTIN GROUP LTD

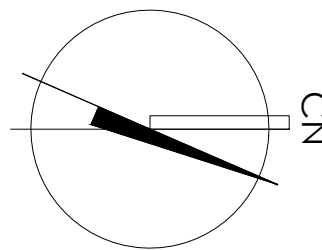

A2.1.4

DRAWN BY: EB/KH

CHECKED BY: PS


PARTIAL FIRST FLOOR UNDER STAGE FRAMING PLAN

Reproduction of drawings and related documents in whole or in part is
prohibited without written permission of the design group.


All dimensions and measurements must be
checked and verified by the General Contractor

Filename: K:\TVG\Brantford\Near North D58 Pary Sound School\2211\Drawings\W4-Current\NIN-A2.1-Apr 4-25 ED.dwg

Plot Date: Feb 03, 2026 - 5:09pm By: Jkely

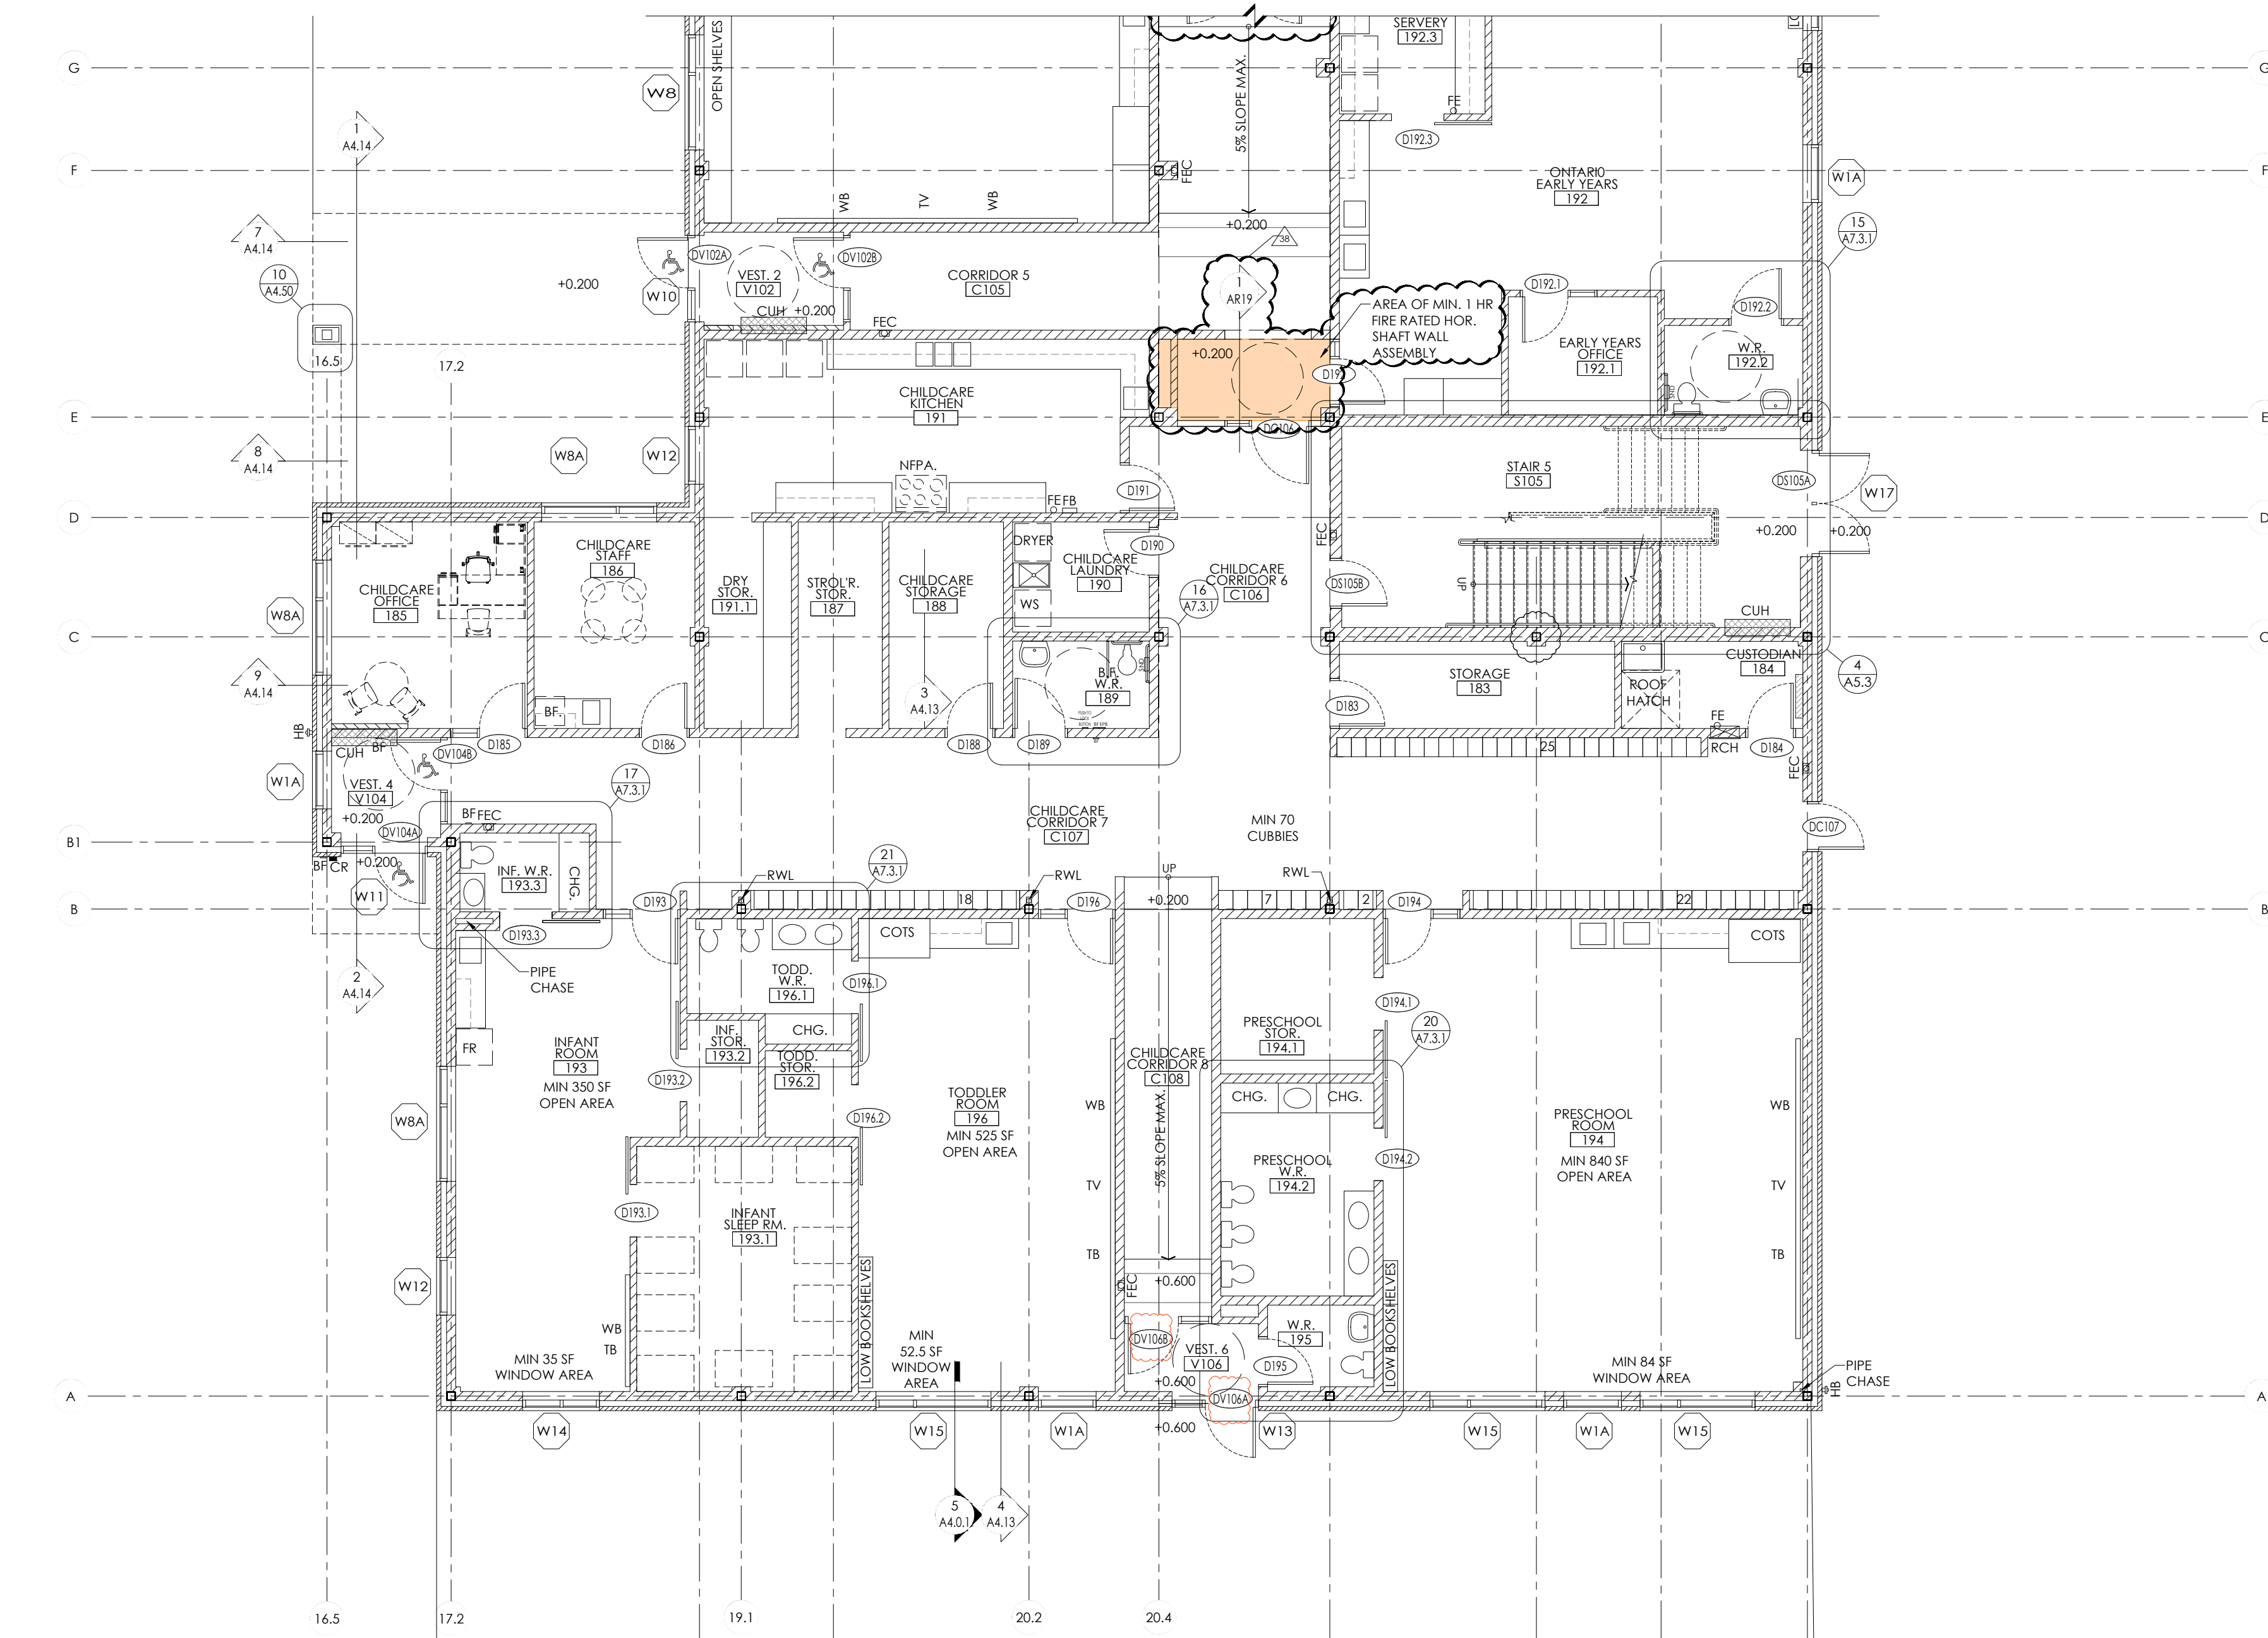


1 FIRST FLOOR PLAN - CHILDCARE WING

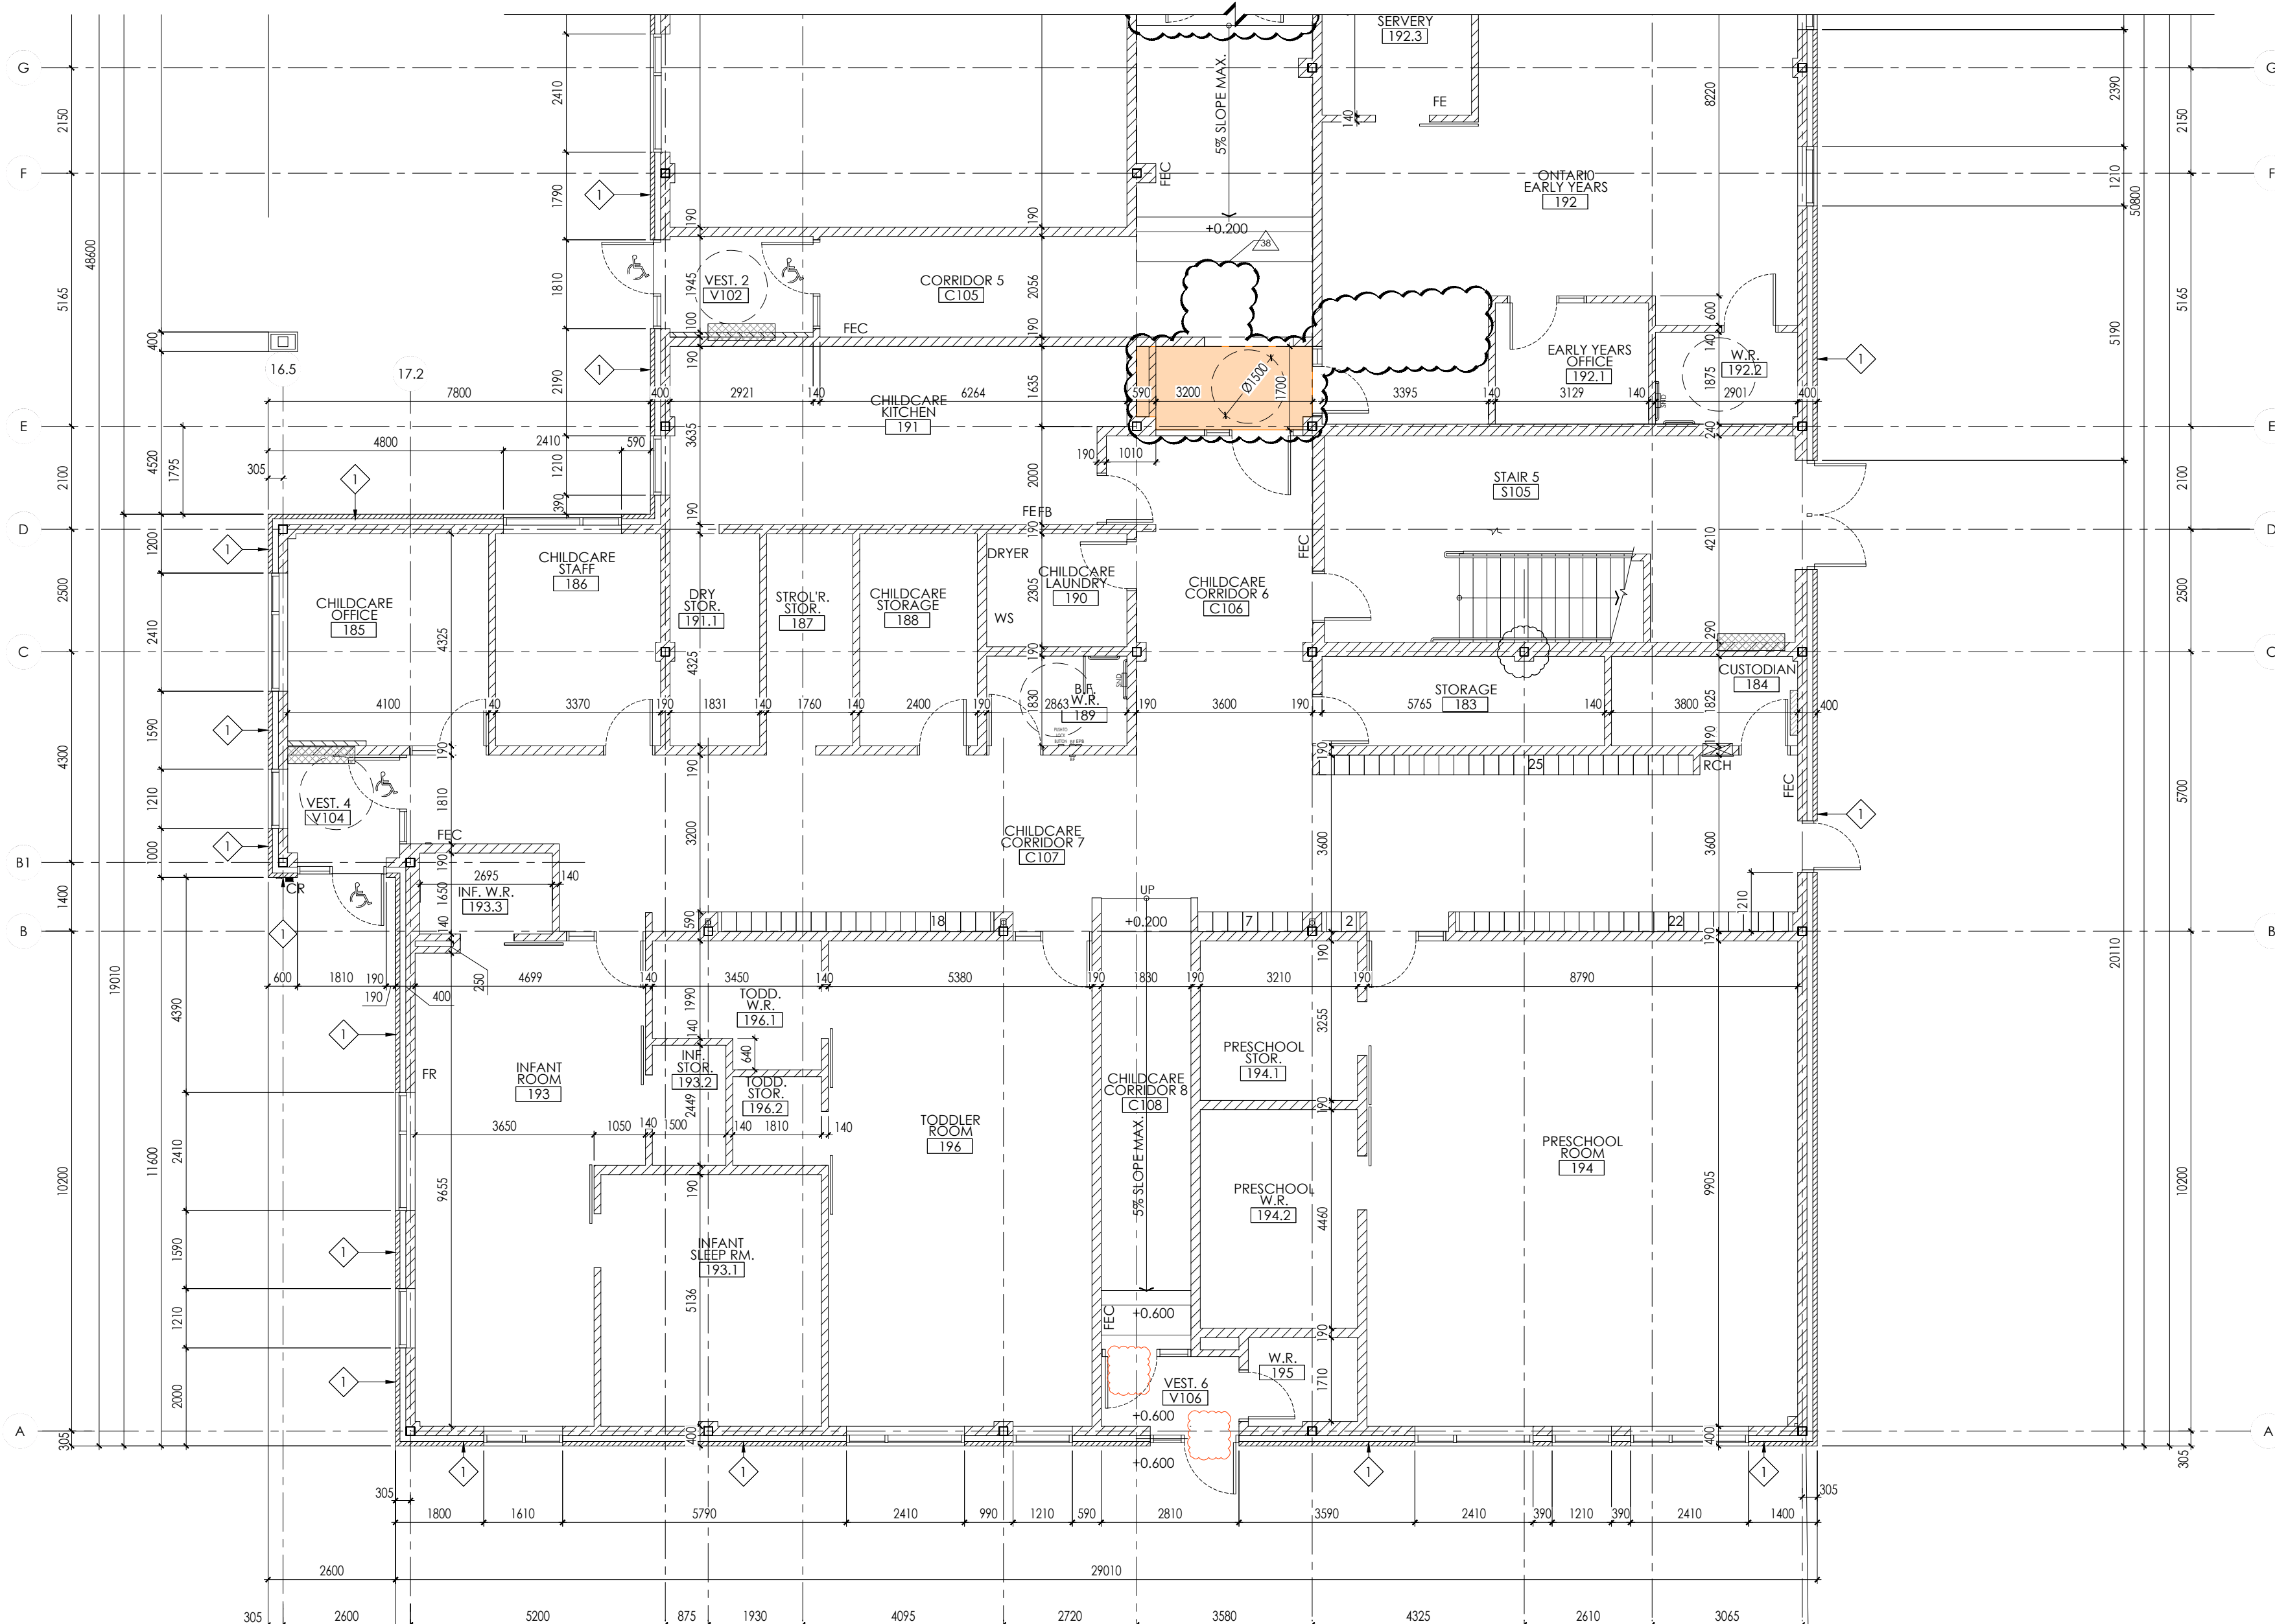

2 FIRST FLOOR DIMENSION PLAN - CHILDCARE WING

REVISIONS		
NO.	DATE	PARTICULAR
1	2022.04.06	ISSUED FOR 80% CLASS B COSTING
2	2022.06.18	ISSUED FOR SPA
3	2022.09.22	ISSUED FOR OWNERS REVIEW - RFS SET
4	2022.12.16	ISSUED FOR 2ND SPA SUBMISSION
5	2023.01.31	ISSUED FOR TENDER
6	2023.02.22	ISSUED FOR ADDENDUM 9
7	2023.08.23	ISSUED FOR CONVENIENCE
8	2023.11.20	ISSUED FOR PERMIT COMMENTS
9	2024.01.24	ISSUED FOR SH03
10	2024.02.15	ISSUED FOR PCH038
11	2024.03.04	ISSUED FOR PCH009
12	2024.03.10	ISSUED FOR SH004
13	2024.05.14	ISSUED FOR SH004
14	2024.07.22	ISSUED FOR SH008
15	2024.08.07	ISSUED FOR SH009
16	2024.10.02	ISSUED FOR PCH015
17	2025.04.11	ISSUED FOR PCH019
18	2025.05.01	ISSUED FOR CO#07
19	2025.05.28	ISSUED FOR PCH020 - CO#010
20	2025.07.31	ISSUED FOR SH013
21	2025.08.06	ISSUED FOR SH014
22	2025.08.15	ISSUED FOR PCH025 - CO#017
23	2025.08.25	ISSUED FOR PCH027 - CO#021
24	2025.09.02	ISSUED FOR PCH029
25	2025.09.02	ISSUED FOR SH020 - CO#018
26	2025.09.08	ISSUED FOR PCH031
27	2025.09.09	ISSUED FOR PCH032 - CO#022
28	2025.09.10	ISSUED FOR PCH033
29	2025.09.11	ISSUED FOR SH022
30	2025.09.15	ISSUED FOR SH023
31	2025.09.16	ISSUED FOR PCH F33 - CO#023
32	2025.09.30	ISSUED FOR PCH F37 - CO#019
33	2025.09.30	ISSUED FOR PCH F38 - CO#025
34	2025.10.04	ISSUED FOR PCH F39 - CO#024
35	2025.10.20	ISSUED FOR PCH F40#1
36	2025.10.30	ISSUED FOR PCH041
37	2025.10.23	ISSUED FOR PCH F42
38	2025.11.21	ISSUED FOR PCH021#1 - CO12 CO#030
39	2025.11.14	ISSUED FOR PCH043
40	2025.11.26	ISSUED FOR PCH040#1
41	2025.12.03	ISSUED FOR PCH044 - CO#026
42	2026.02.04	ISSUED FOR RECORD SET UP TO CO#027

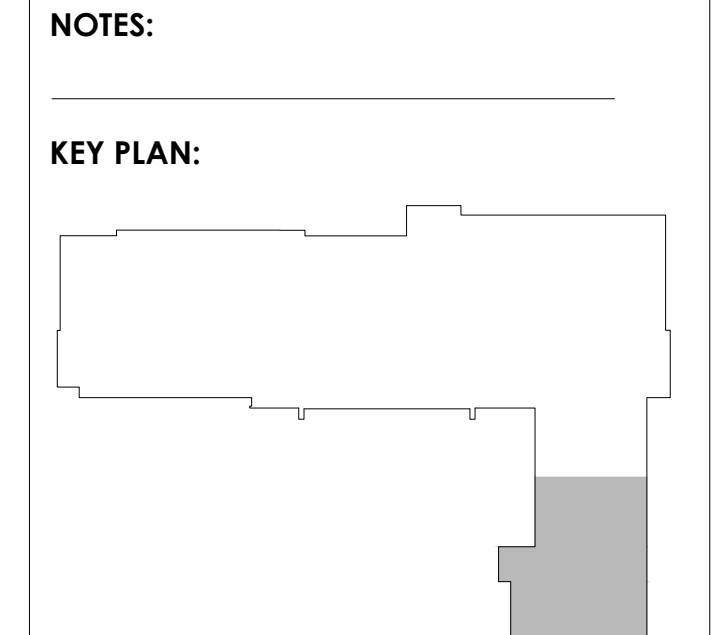

KEY PLAN:



CLIENT:
NEAR NORTH DISTRICT SCHOOL BOARD
NND\$B Tender # 2023-015


PROJECT:
NEW PARRY SOUND K-12 SCHOOL & CHILDCARE

PARRY SOUND HIGH SCHOOL SITE

111 ISABELLA STREET
PARRY SOUND, ONTARIO

ORIGINAL PAGE SIZE ARCH E1 - 30" x 42"

KEY TO DETAIL LOCATION:
A - DETAIL NO.
B - DETAIL NO. ORIGIN

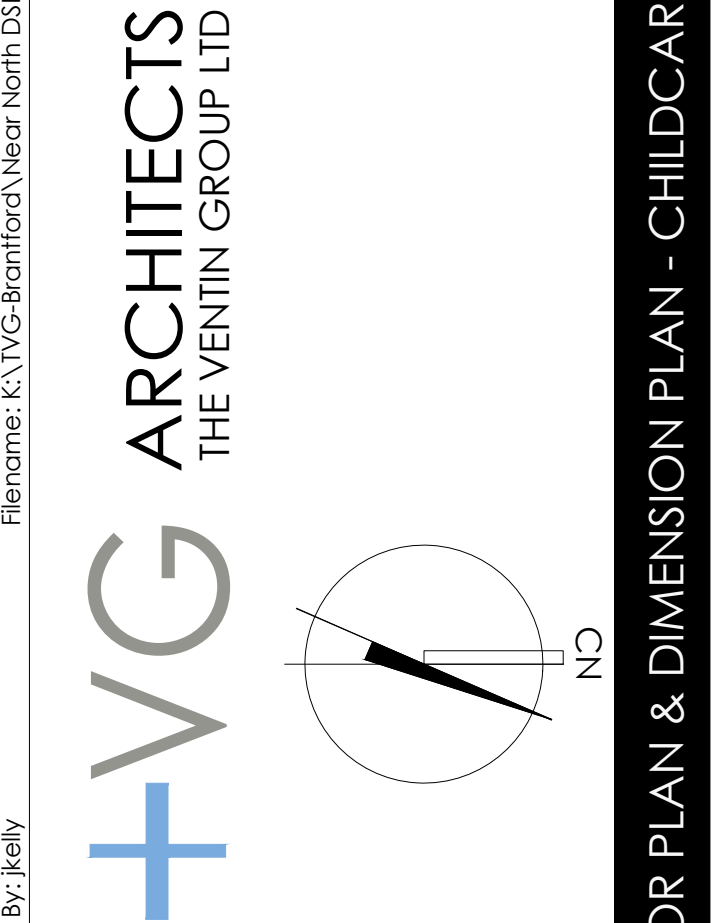


A2.1.3

DRAWN BY: EB/KH CHECKED BY: PS

File name: K:\TVG-Branford\Near North DSS Parry Sound School\22111\Drawings\Wd-Current\NIN-A2.1-Apr 4-25-ED.dwg
Plot Date: Feb 03, 2026 - 5:09pm By: Jeky
All dimensions and measurements must be checked and verified by the General Contractor
Reproduction of drawings and related documents in whole or in part is prohibited without written permission of the Ventin Group

REFER TO SHEET A2.1.1 FOR
NOTES & LEGEND REFERENCE

2
A2.1.1 & A2.1.1.A

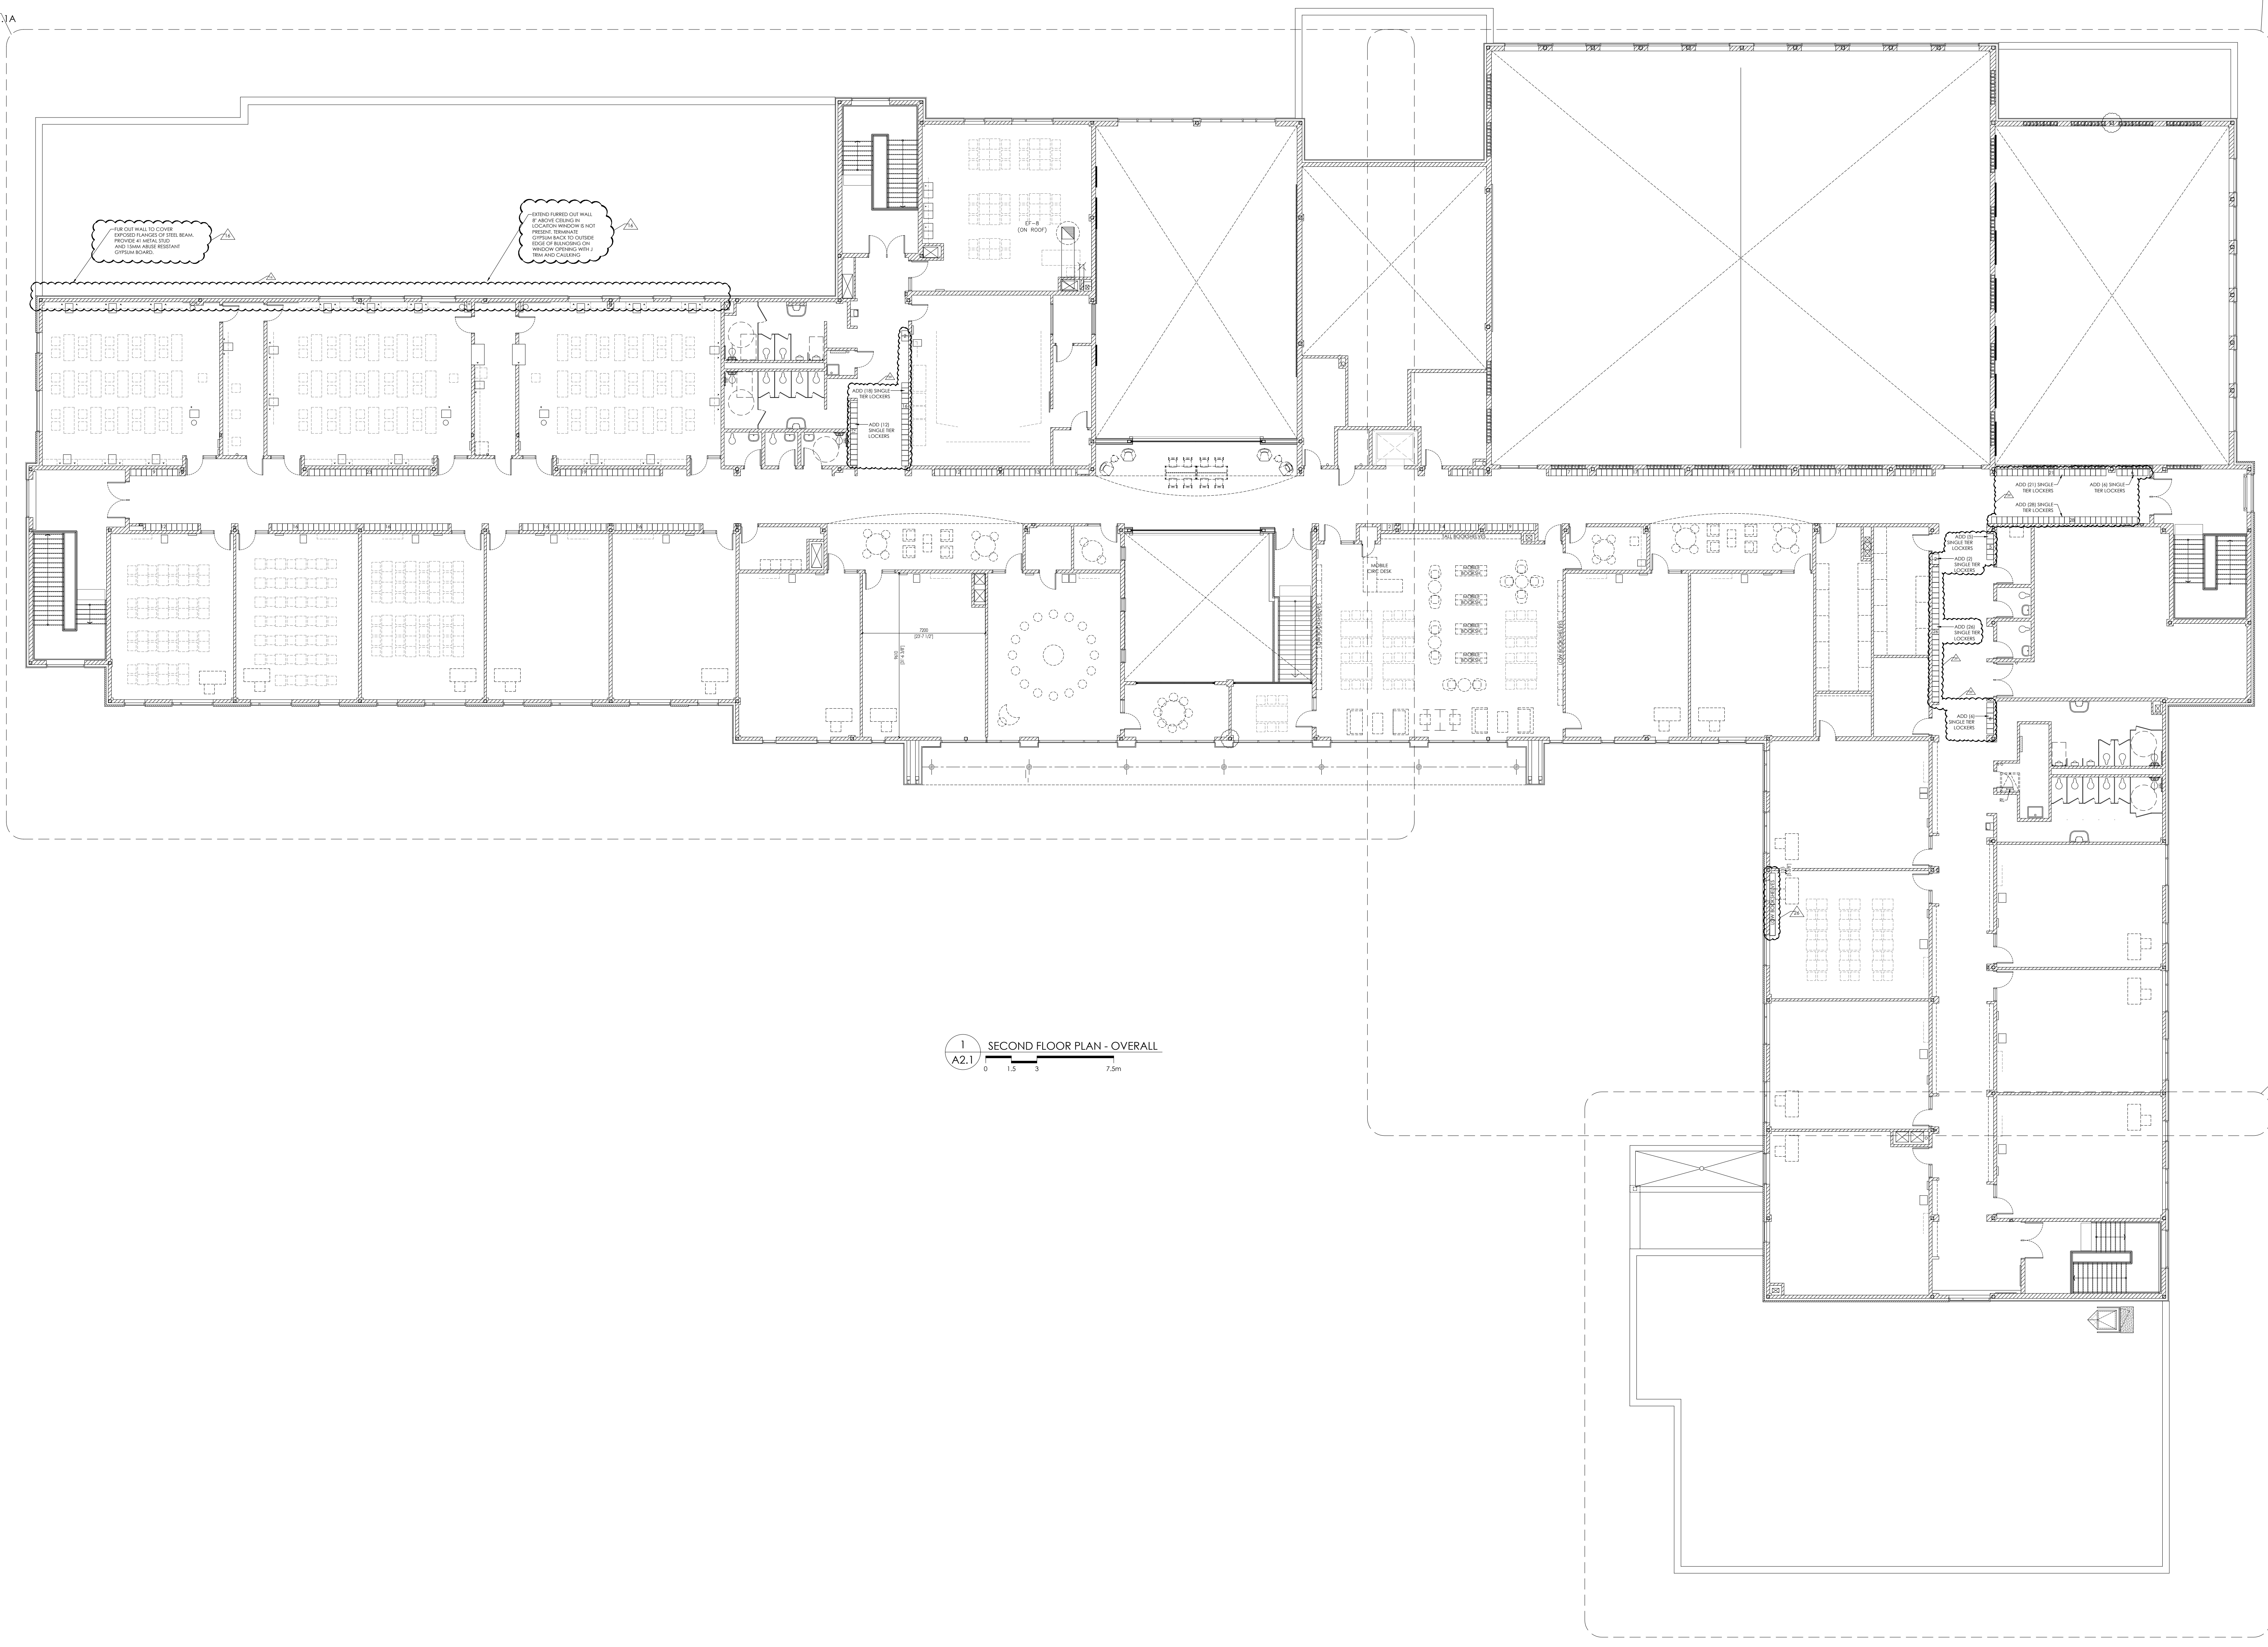


1
A2.1 SECOND FLOOR PLAN - OVERALL
0 1.5 3 7.5m

2
A2.1.2 & A2.1.2.A

REVISIONS		
NO.	DATE	PARTICULAR
1	2022.04.06	ISSUED FOR 805 CLASS B COSTING
2	2022.06.18	ISSUED FOR SPA
3	2022.09.22	ISSUED FOR OWNERS REVIEW - RES SET
4	2022.12.16	ISSUED FOR 2ND SPA SUBMISSION
5	2023.01.31	ISSUED FOR TENDER
6	2023.02.22	ISSUED FOR ADDENDUM 9
7	2023.08.23	ISSUED FOR CONVENIENCE
8	2023.11.20	ISSUED FOR PERMIT COMMENTS
9	2024.01.24	ISSUED FOR SH03
10	2024.02.15	ISSUED FOR PCN#08
11	2024.03.04	ISSUED FOR PCN#09
12	2024.03.10	ISSUED FOR SH#04
13	2024.05.14	ISSUED FOR SH#06
14	2024.07.22	ISSUED FOR SH#08
15	2024.08.07	ISSUED FOR SH#09
16	2024.10.02	ISSUED FOR PCN#15
17	2025.04.11	ISSUED FOR PCN#19
18	2025.05.01	ISSUED FOR CO#07
19	2025.05.28	ISSUED FOR PCN#20 - CO#10
20	2025.07.31	ISSUED FOR SH#13
21	2025.08.06	ISSUED FOR SH#14
22	2025.08.15	ISSUED FOR PCN#3 - CO#17
23	2025.08.25	ISSUED FOR PCN#27 - CO#21
24	2025.09.02	ISSUED FOR PCN#29
25	2025.09.02	ISSUED FOR SH#20 - CO#18
26	2025.09.08	ISSUED FOR PCN#31
27	2025.09.09	ISSUED FOR PCN#32 - CO#22
28	2025.09.10	ISSUED FOR PCN#33
29	2025.09.11	ISSUED FOR SH#22
30	2025.09.15	ISSUED FOR SH#23
31	2025.09.16	ISSUED FOR PCN F33 - CO#23
32	2025.09.30	ISSUED FOR PCN#37 - CO#19
33	2025.09.30	ISSUED FOR PCN#38 - CO#25
34	2025.10.04	ISSUED FOR PCN#39 - CO#24
35	2025.10.20	ISSUED FOR PCN#40#1
36	2025.10.30	ISSUED FOR PCN#41
37	2025.10.23	ISSUED FOR PCN#42
38	2025.11.21	ISSUED FOR PCN#21#1 - CO12 CORN
39	2025.11.14	ISSUED FOR PCN#43
40	2025.11.26	ISSUED FOR PCN#43#1
41	2025.12.03	ISSUED FOR PCN#44 - CO#26
42	2026.02.04	ISSUED FOR RECORD SET UP TO CO#27

NOTES:

KEY PLAN:

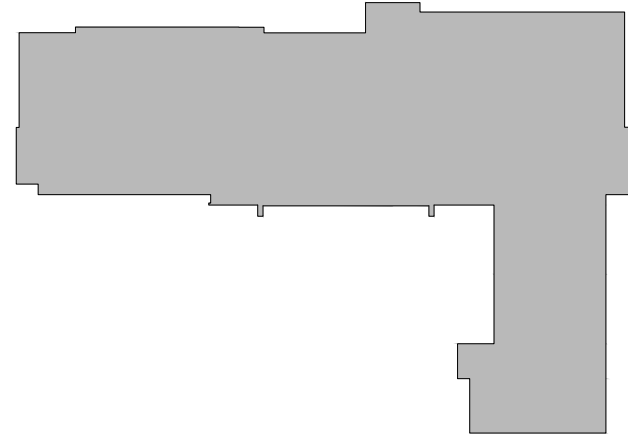


CLIENT:
NEAR NORTH DISTRICT SCHOOL BOARD
NND58 Tender # 2023-015

PROJECT:
NEW PARRY SOUND K-12 SCHOOL & CHILDCARE
PARRY SOUND HIGH SCHOOL SITE

111 ISABELLA STREET
PARRY SOUND, ONTARIO

ORIGINAL PAGE SIZE ARCH E1 - 30" x 42"
KEY TO DETAIL LOCATION:
A - DETAIL NO.
B - DETAIL NO. ORIGIN

+VG ARCHITECTS
THE VENTIN GROUP LTD

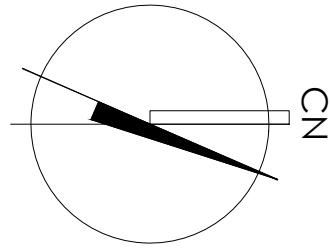

A2.2

Plot Date: Feb 03, 2026 - 5:09pm By: Jkely

Filename: K:\TVG\Brantford\Near North DSS Pary Sound School\22111\Drawings\Wd\Current\NN-A2.2.dwg

DRAWN BY: EB/KH

CHECKED BY: PS

OVERALL SECOND FLOOR PLAN

Reproduction of drawings and related documents in whole or in parts
for other than the original project without written permission of the design group.

All dimensions and measurements must be
checked and verified by the General Contractor



	ELEVATION REFERENCE
	INTERIOR ELEVATION REFERENCE
	DETAIL REFERENCE
	WALL SECTION REFERENCE
	BUILDING SECTION REFERENCE
	A/F/F LEVEL # (ABOVE FINISHED FLOOR)
	GRID LINE
	DOOR TYPE
	DOOR
	REFER TO AB SERIES SCHEDULES
	WINDOW / CURTAINWALL REFERENCE
	SCREEN REFERENCE
	ROOM NO. REFERENCE

WALL TYPE REFERENCE
FLOOR TYPE REFERENCE
POWER DOOR OPERATOR
TYP. BF TURNING CIRCUMFERENCE
INDIVIDUAL AREA OF FLOOR
PUSH BUTTON FOR POWER
- 610mm MIN. FROM TOP
TOWARDS THE BUTTON
(925mm A/F/F TO CENTER)
CARD READER
(925mm A/F/F TO CENTER)
EMERGENCY PUSH BUTTON
(925mm A/F/F TO CENTER)
(450mm A/F/F TO CENTER OF
CONTROL PANEL)
(PROVIDE SHOP DWG. BY
OWNER)
FIRE ANNUNCIATOR PANEL
(COORD. FINAL RM. NO.
OWNER)
IN INTERNET PROTOCOL
(DATA DROP, CLOCK POWER)
RECESSED FLR. BOX
LOCKER(S)
CUBBIES

SEMI EXTINGUISHER / FIRE EXTINGUISHER & CABIN
150MM MAX. AIR FLOW OF 200GPM PER HOUR (BGS)
FIRE EXTINGUISHER / FIRE EXTINGUISHER & CABIN
150MM MAX. AIR FLOW OF 200GPM PER HOUR (BGS)
VERIFY W/ LOCAL AUTHORITIES)

SEMI BLANKET

SEMI RECESSED CABINET UNIT HEATER.
[REFER TO MECH. DWGS.]

SURFACE MOUNTED MECH. UNIT.
[REFER TO MECH. DWGS.]

RADIANT HEATER
[REFER TO MECH. DWGS.]

EYE WASH STATION

RAIN WATER LEADER

SIAMESE CONNECTION
FIRE FIGHTERS CONNECTION
(800mm A/F GRADE)

HOSE BIB
(800mm A/F GRADE)

NATURAL GAS BIB
(800mm A/F GRADE)

AIR LINE
(800mm A/F GRADE)

F.L. DRAIN / FUNNEL F.L. DRAIN
SLOPE F.L. TO DRAIN. SEAL DRAIN
TO F.L. SYSTEM

WATER METER

WATER STANDPIPE

DRINKING FOUNTAIN

SINGLE & DOUBLE LAVATORIES

AVATORY [IN VANITY]
AVATORY [WALL HUNG]
AVATORY, WALL HUNG,
HARRIER FREE
AVATORY, TROUGH
HARRIER FREE
AUNDRY SINK
HAND WASH STATION
SCIENCE LAB SINK
TOILET / WATER CLOSET / URINAL
MOP SINK W/ SHELF
HOSE SIB & BACK SPLASH FULL HEIGHT
BOTH WALLS WHEN IN CORNER
CONDITION] TO U/S MOP SHELF)
TACTILE WARNING INDICATOR
EMERGENCY SHOWER/EYE WASH STATION

HATCH IDENTIFICATION MARKER LEGEND

	OPEN TO ABOVE / BELOW
	MILLWORK IN CONTRACT (COORD. W/ ID DRAWINGS)
	UPPER MILLWORK IN CONTRACT (COORD. W/ ID DRAWINGS)
	FURNITURE / EQUIP. IN CONTRACT SUPPLIED BY OWNER / OTHERS (COORD. W/ ID DRAWINGS)
	ITEMS NOT IN CONTRACT - N/C (COORD. W/ ID DRAWINGS)

WALL IDENTIFICATION MARKER LEGEND (COORD. W/ WALL TYPES)


	NEW CONC. BLOCK WALL SYSTEM
	NEW GYP. BD. ON METAL STUD W/
	NEW P/F/ CONC. WALL SYSTEM
	ACUSTIC CONCRETE BLOCKS

• SHOP DWG.'S TO BE IN DIMENSION UNITS AS ILLUSTRATED ON THIS DWG, OR THEY WILL BE REJECTED (IMPERIAL & METRIC BOTH SHOWN IS ACCEPTABLE)

NO.	DATE	PARTICULAR
2	2022.06.06	ISSUED FOR RCP CLASS 8 COSTING
3	2022.06.18	ISSUED FOR SPA
3	2022.07.22	ISSUED FOR OWNERS REVIEW - HRS SET
3	2022.12.16	ISSUED FOR 2ND SPA SUBMISSION
3	2023.01.31	ISSUED FOR RCP
3	2023.02.22	ISSUED FOR ADDENDUM V
3	2023.06.28	ISSUED FOR CONFORMANCE
9	2023.11.20	ISSUED FOR PRELIM COMMENTS
9	2024.01.24	ISSUED FOR SPA03
10	2024.02.15	ISSUED FOR RCPH008
10	2024.03.04	ISSUED FOR RCPH009
12	2023.08.18	ISSUED FOR RCPH004X3
13	2024.01.24	ISSUED FOR RCPH004R1
14	2024.07.22	ISSUED FOR SPA08
15	2024.08.07	ISSUED FOR SPA09
16	2024.10.02	ISSUED FOR RCPH15
17	2025.04.11	ISSUED FOR RCPH19
18	2025.05.01	ISSUED FOR COM07
20	2025.05.28	ISSUED FOR RCPH02 - COM010
20	2025.07.31	ISSUED FOR SPA013
20	2025.08.04	ISSUED FOR SPA014
22	2025.08.15	ISSUED FOR RCPH23 - COM017
23	2025.08.25	ISSUED FOR RCPH23 - COM021
23	2025.09.02	ISSUED FOR RCPH29
23	2025.09.02	ISSUED FOR SPA02 - COM018
23	2025.09.08	ISSUED FOR RCPH43
23	2025.09.09	ISSUED FOR RCPH43 - COM022
23	2025.09.10	ISSUED FOR RCPH43
23	2025.09.11	ISSUED FOR RCPH42
23	2025.09.15	ISSUED FOR RCPH423
31	2025.09.19	ISSUED FOR RCPH X5 - COM023
31	2025.09.30	ISSUED FOR RCPH X7 - COM019
31	2025.09.30	ISSUED FOR RCPH X9 - COM025
31	2025.10.06	ISSUED FOR RCPH X9 - COM024
31	2025.10.30	ISSUED FOR RCPH4R1
31	2025.10.30	ISSUED FOR RCPH4R1
31	2025.10.23	ISSUED FOR RCPH42
38	2025.11.21	ISSUED FOR RCPH012R1 - COM016
40	2025.11.14	ISSUED FOR RCPH014Q3
40	2025.11.26	ISSUED FOR RCPH014R1
41	2025.12.03	ISSUED FOR RCPH014A - COM026
42	2026.02.04	ISSUED FOR RECORD SET UP TO COM027

NOTES:

KEY PLAN:

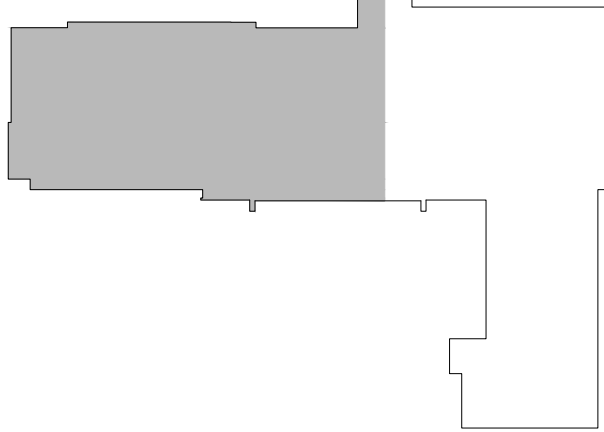

CLIENT:
NEAR NORTH DISTRICT SCHOOL BOARD
NNDSB Tender # 2023-015

PROJECT: _____


PARRY SOUND HIGH SCHOOL SITE

111 ISABELLA STREET
PARRY SOUND, ONTARIO

ORIGINAL PAGE SIZE ARCH E1 - 30" x 42"

KEY TO DETAIL LOCATION:
 A - DETAIL NO.
 B - DETAIL NO. ORIGIN

+VG ARCHITECTS
THE VENTIN GROUP LTD

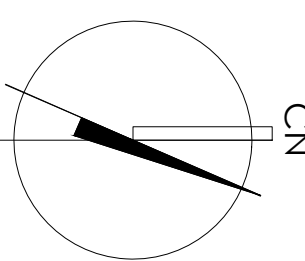


A2.2.1

SECOND FLOOR PLAN - SOUTH WING

Plot Date: Feb 03, 2026 - 5:09pm By: jkelly


CHECKED BY : PS

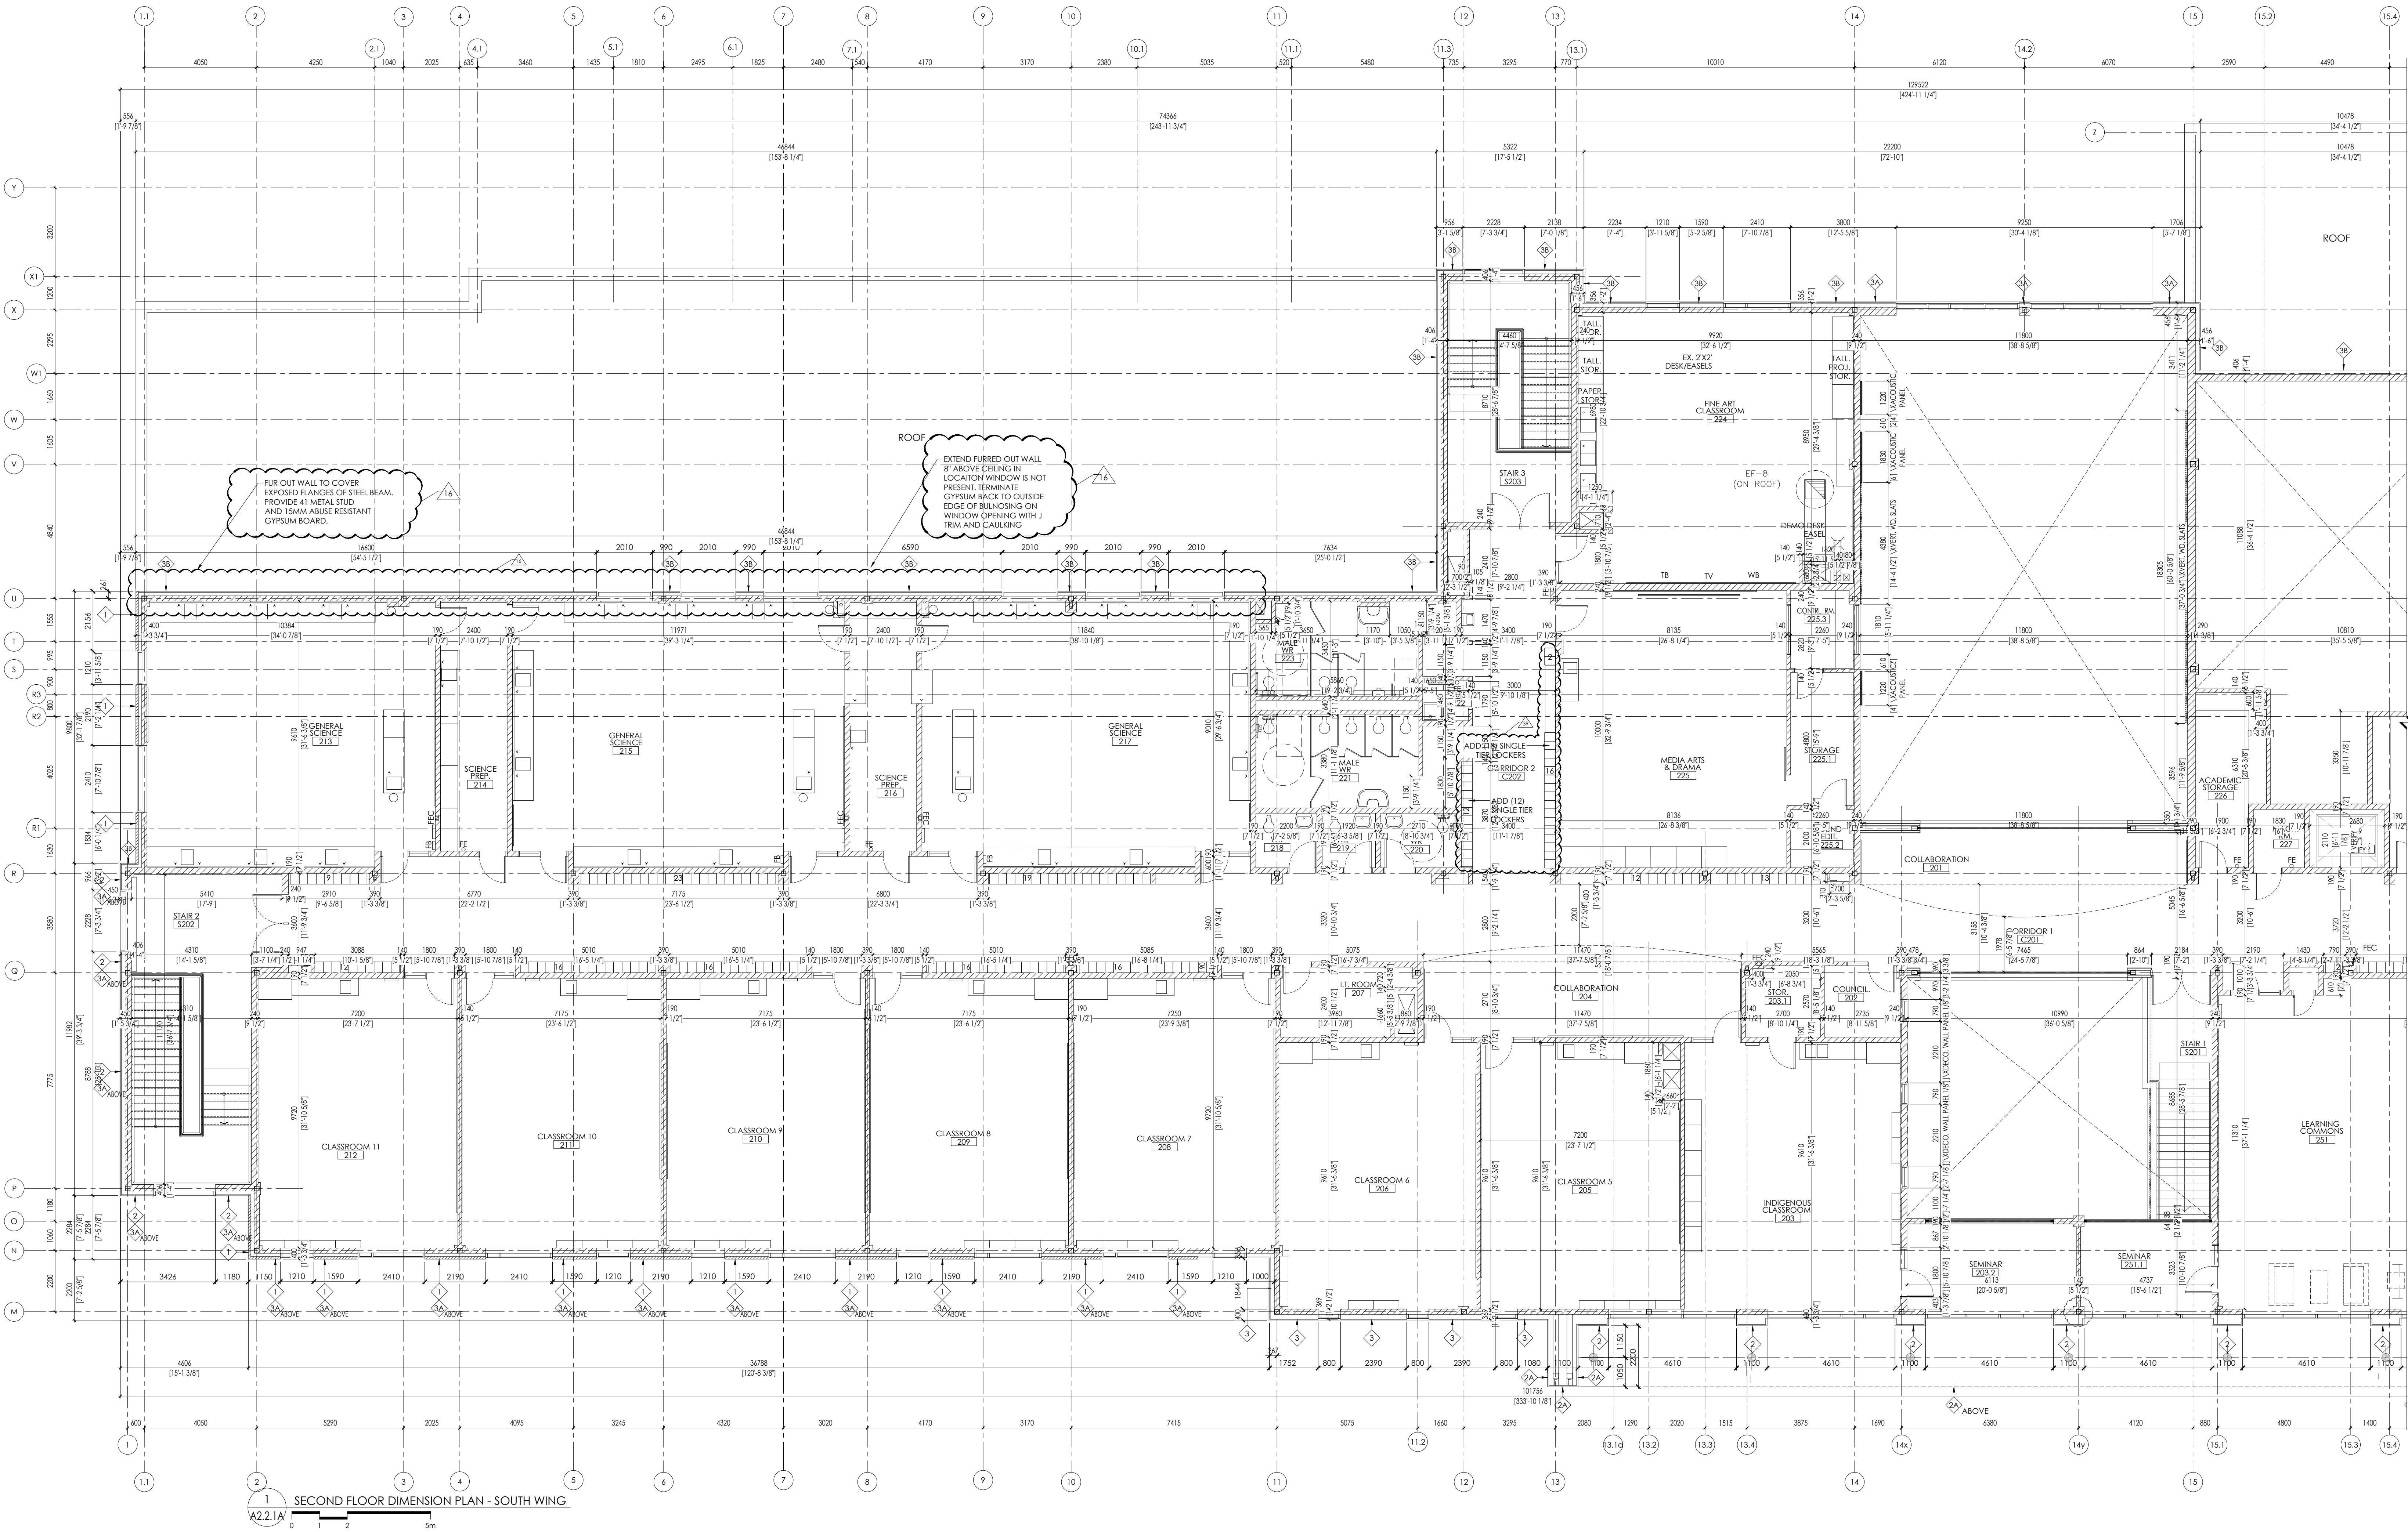

REVISIONS		
NO.	DATE	PARTICULAR
1	2022.04.06	ISSUED FOR 805 CLASS B COSTING
2	2022.06.18	ISSUED FOR SPA
3	2022.09.22	ISSUED FOR OWNERS REVIEW - RES SET
4	2022.12.16	ISSUED FOR 2ND SPA SUBMISSION
5	2023.01.31	ISSUED FOR TENDER
6	2023.02.22	ISSUED FOR ADDENDUM 9
7	2023.08.23	ISSUED FOR CONVENIENCE
8	2023.11.20	ISSUED FOR PERMIT COMMENTS
9	2024.01.24	ISSUED FOR SH03
10	2024.02.15	ISSUED FOR PCN#08
11	2024.03.04	ISSUED FOR PCN#09
12	2024.03.10	ISSUED FOR SH04
13	2024.05.14	ISSUED FOR SH04
14	2024.07.22	ISSUED FOR SH08
15	2024.08.07	ISSUED FOR SH09
16	2024.10.02	ISSUED FOR PCN#15
17	2025.04.11	ISSUED FOR PCN#19
18	2025.05.01	ISSUED FOR CO#07
19	2025.05.28	ISSUED FOR PCN#20 - CO#10
20	2025.07.31	ISSUED FOR SH013
21	2025.08.06	ISSUED FOR SH014
22	2025.08.15	ISSUED FOR PCN#25 - CO#17
23	2025.08.25	ISSUED FOR PCN#27 - CO#21
24	2025.09.02	ISSUED FOR PCN#29
25	2025.09.02	ISSUED FOR SH020 - CO#18
26	2025.09.08	ISSUED FOR PCN#31
27	2025.09.09	ISSUED FOR PCN#32 - CO#22
28	2025.09.10	ISSUED FOR PCN#33
29	2025.09.11	ISSUED FOR SH022
30	2025.09.15	ISSUED FOR SH023
31	2025.09.16	ISSUED FOR PCN F35 - CO#33
32	2025.09.30	ISSUED FOR PCN#37 - CO#39
33	2025.09.30	ISSUED FOR PCN#38 - CO#40
34	2025.10.04	ISSUED FOR PCN#39 - CO#42
35	2025.10.20	ISSUED FOR PCN#40
36	2025.10.30	ISSUED FOR PCN#41
37	2025.10.23	ISSUED FOR PCN#42
38	2025.11.21	ISSUED FOR PCN#21/31 - CO12 CO#39
39	2025.11.14	ISSUED FOR PCN#43
40	2025.11.26	ISSUED FOR PCN#43
41	2025.12.03	ISSUED FOR PCN#44 - CO#26
42	2026.02.04	ISSUED FOR RECORD SET UP TO CO#27

NOTES:

KEY PLAN:

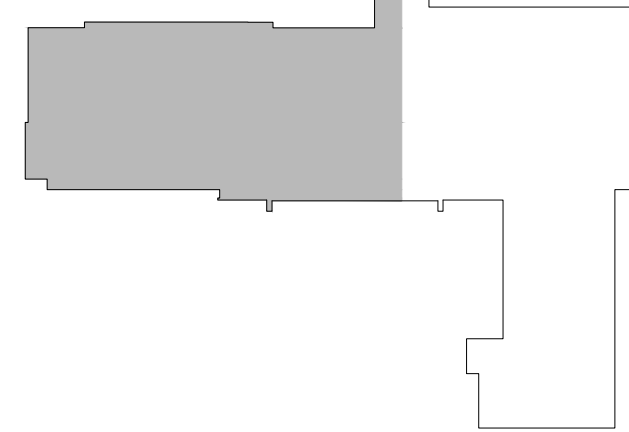


CLIENT:
NEAR NORTH DISTRICT SCHOOL BOARD
NND58 Tender # 2023-015

PROJECT:
NEW PARRY SOUND K-12 SCHOOL & CHILDCARE
PARRY SOUND HIGH SCHOOL SITE

111 ISABELLA STREET
PARRY SOUND, ONTARIO

ORIGINAL PAGE SIZE ARCH E1 - 30" x 42"
KEY TO DETAIL LOCATION:
A - DETAIL NO.
B - DETAIL NO. ORIGIN

VG ARCHITECTS
THE VENTIN GROUP LTD

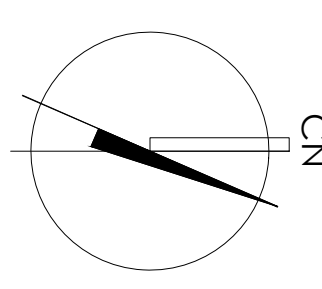

A2.2.1A

REFER TO SHEET A2.2.1 FOR
NOTES & LEGEND REFERENCE

Plot Date: Feb.03, 2026 - 5:09pm By: Kelly

DRAWN BY: KH

CHECKED BY: PS

SECOND FLOOR DIMENSION PLAN - SOUTH WING


Reproduction of drawings and related documents in whole or in part is
prohibited without written permission of the Ventin Group.

All dimensions and measurements must be
checked and verified by the Senior Contractor



SECOND FLOOR PLAN - NORTH WING

whole or in part is checked and verified by the General Contractor

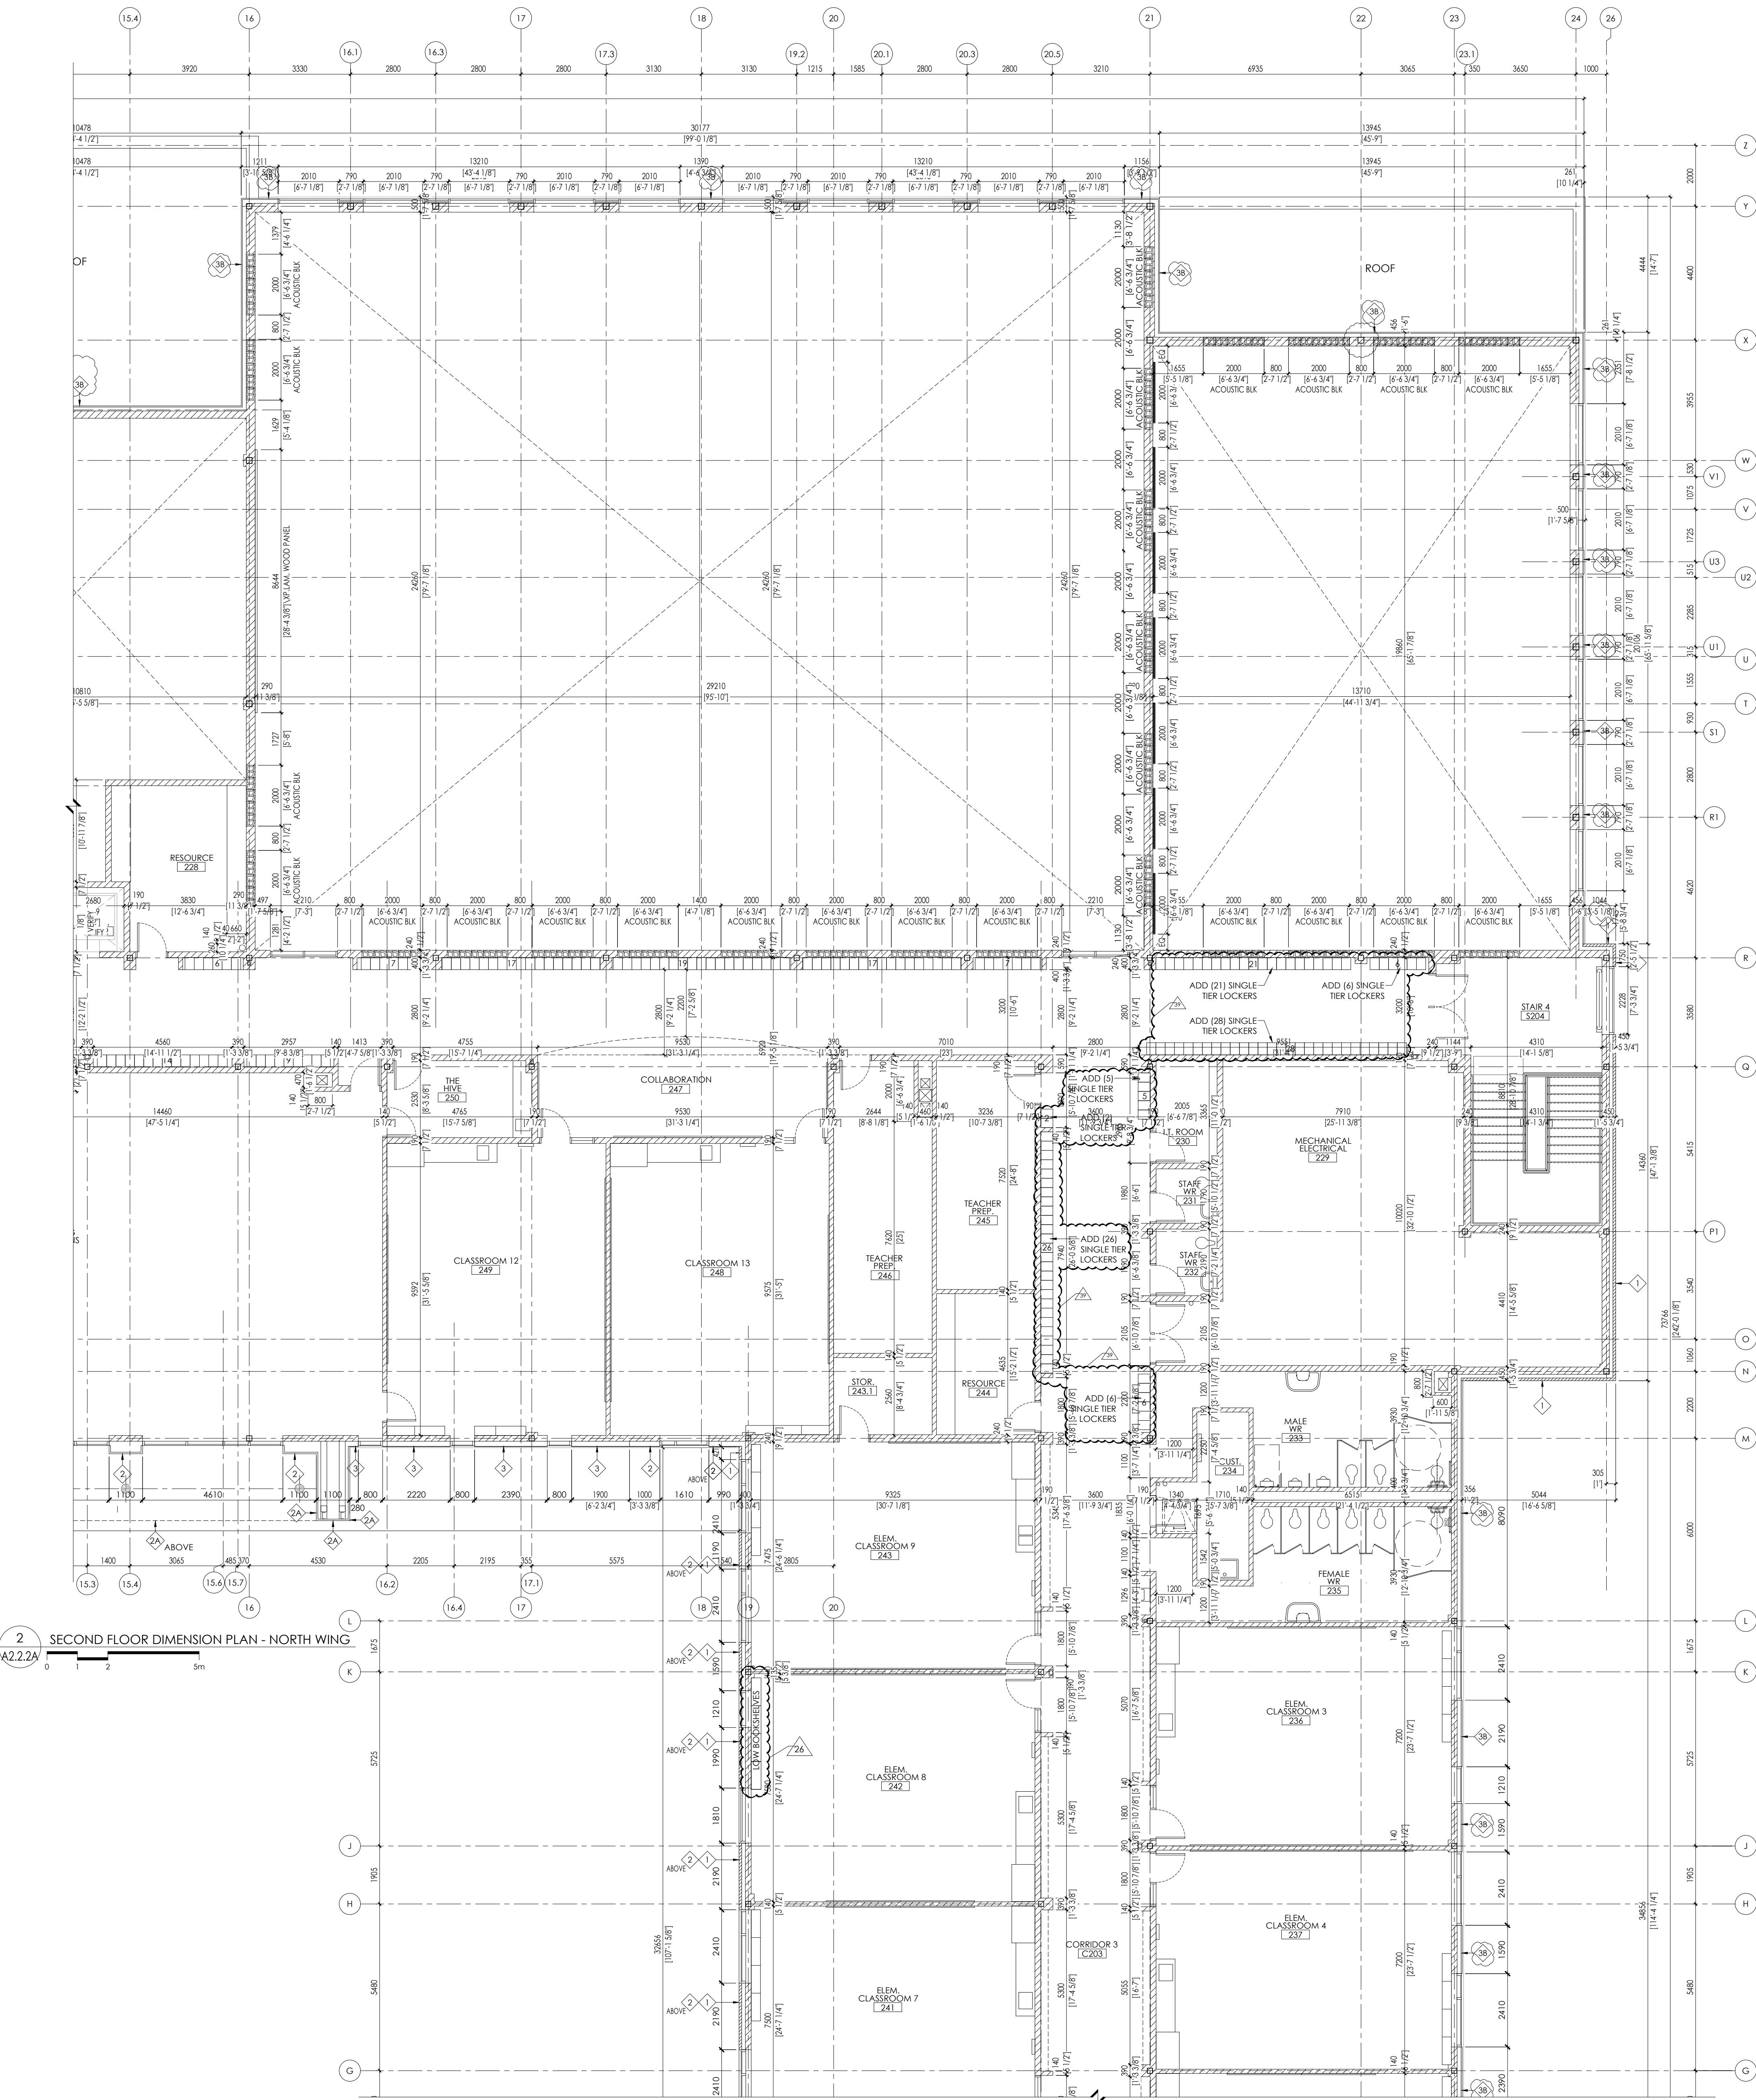


2 SECOND FLOOR DIMENSION PLAN - NORTH WING
A2.2.2A

REFER TO SHEET A2.2.1 FOR
NOTES & LEGEND REFERENCE

REVISIONS		
NO.	DATE	PARTICULAR
1	2022.04.06	ISSUED FOR 805 CLASS B COSTING
2	2022.08.18	ISSUED FOR SPA
3	2022.09.22	ISSUED FOR OWNERS REVIEW - RES SET
4	2022.12.16	ISSUED FOR 2ND SPA SUBMISSION
5	2023.01.31	ISSUED FOR TENDER
6	2023.02.22	ISSUED FOR ADDENDUM 9
7	2023.08.23	ISSUED FOR CONVENIENCE
8	2023.11.20	ISSUED FOR PERMIT COMMENTS
9	2024.01.24	ISSUED FOR SH03
10	2024.02.15	ISSUED FOR PCN#08
11	2024.03.04	ISSUED FOR PCN#09
12	2024.03.10	ISSUED FOR SH04
13	2024.05.14	ISSUED FOR SH04
14	2024.07.22	ISSUED FOR SH08
15	2024.08.07	ISSUED FOR SH09
16	2024.10.02	ISSUED FOR PCN#15
17	2025.04.11	ISSUED FOR PCN#19
18	2025.05.01	ISSUED FOR CO#07
19	2025.05.28	ISSUED FOR PCN#20 - CO#10
20	2025.07.31	ISSUED FOR SH013
21	2025.08.06	ISSUED FOR SH014
22	2025.08.15	ISSUED FOR PCN#25 - CO#17
23	2025.08.25	ISSUED FOR PCN#27 - CO#21
24	2025.09.02	ISSUED FOR PCN#29
25	2025.09.02	ISSUED FOR SH020 - CO#18
26	2025.09.08	ISSUED FOR PCN#31
27	2025.09.09	ISSUED FOR PCN#32 - CO#22
28	2025.09.10	ISSUED FOR PCN#33
29	2025.09.11	ISSUED FOR SH022
30	2025.09.15	ISSUED FOR SH023
31	2025.09.16	ISSUED FOR PCN F35 - CO#23
32	2025.09.30	ISSUED FOR PCN#37 - CO#19
33	2025.09.30	ISSUED FOR PCN#38 - CO#25
34	2025.10.04	ISSUED FOR PCN#39 - CO#24
35	2025.10.20	ISSUED FOR PCN#40
36	2025.10.30	ISSUED FOR PCN#41
37	2025.10.23	ISSUED FOR PCN#42
38	2025.11.21	ISSUED FOR PCN#21#1 - CO12 CO#26
39	2025.11.14	ISSUED FOR PCN#43
40	2025.11.26	ISSUED FOR PCN#43#1
41	2025.12.03	ISSUED FOR PCN#44 - CO#26
42	2026.02.04	ISSUED FOR RECORD SET UP TO CO#27

NOTES:

KEY PLAN:

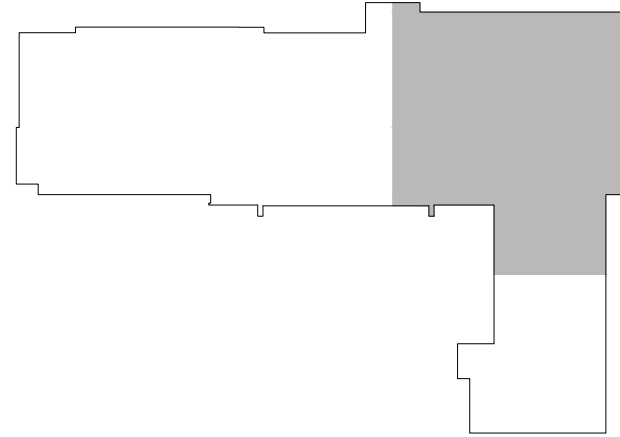

CLIENT:

NEAR NORTH DISTRICT SCHOOL BOARD
NND58 Tender # 2023-015


PROJECT:

NEW PARRY SOUND K-12 SCHOOL & CHILDCARE
PARRY SOUND HIGH SCHOOL SITE

111 ISABELLA STREET
PARRY SOUND, ONTARIO

ORIGINAL PAGE SIZE ARCH E1 - 30" x 42"
KEY TO DETAIL LOCATION:
A - DETAIL NO.
B - DETAIL NO. ORIGIN

VG ARCHITECTS
THE VENTIN GROUP LTD

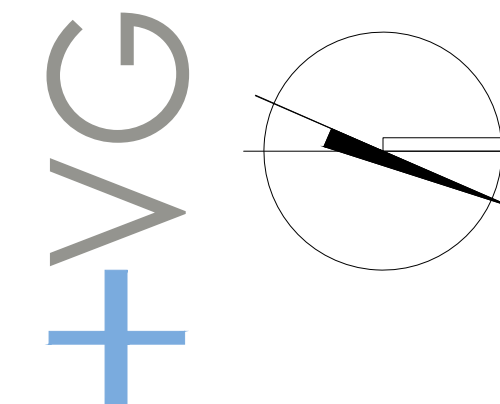

A2.2.2A


DRAWN BY: KH

CHECKED BY: PS


SECOND FLOOR DIMENSION PLAN - NORTH WING

Reproduction of drawings and related documents in whole or in part is
prohibited without written permission of the design group.

All dimensions and measurements must be
checked and verified by the Senior Consultant

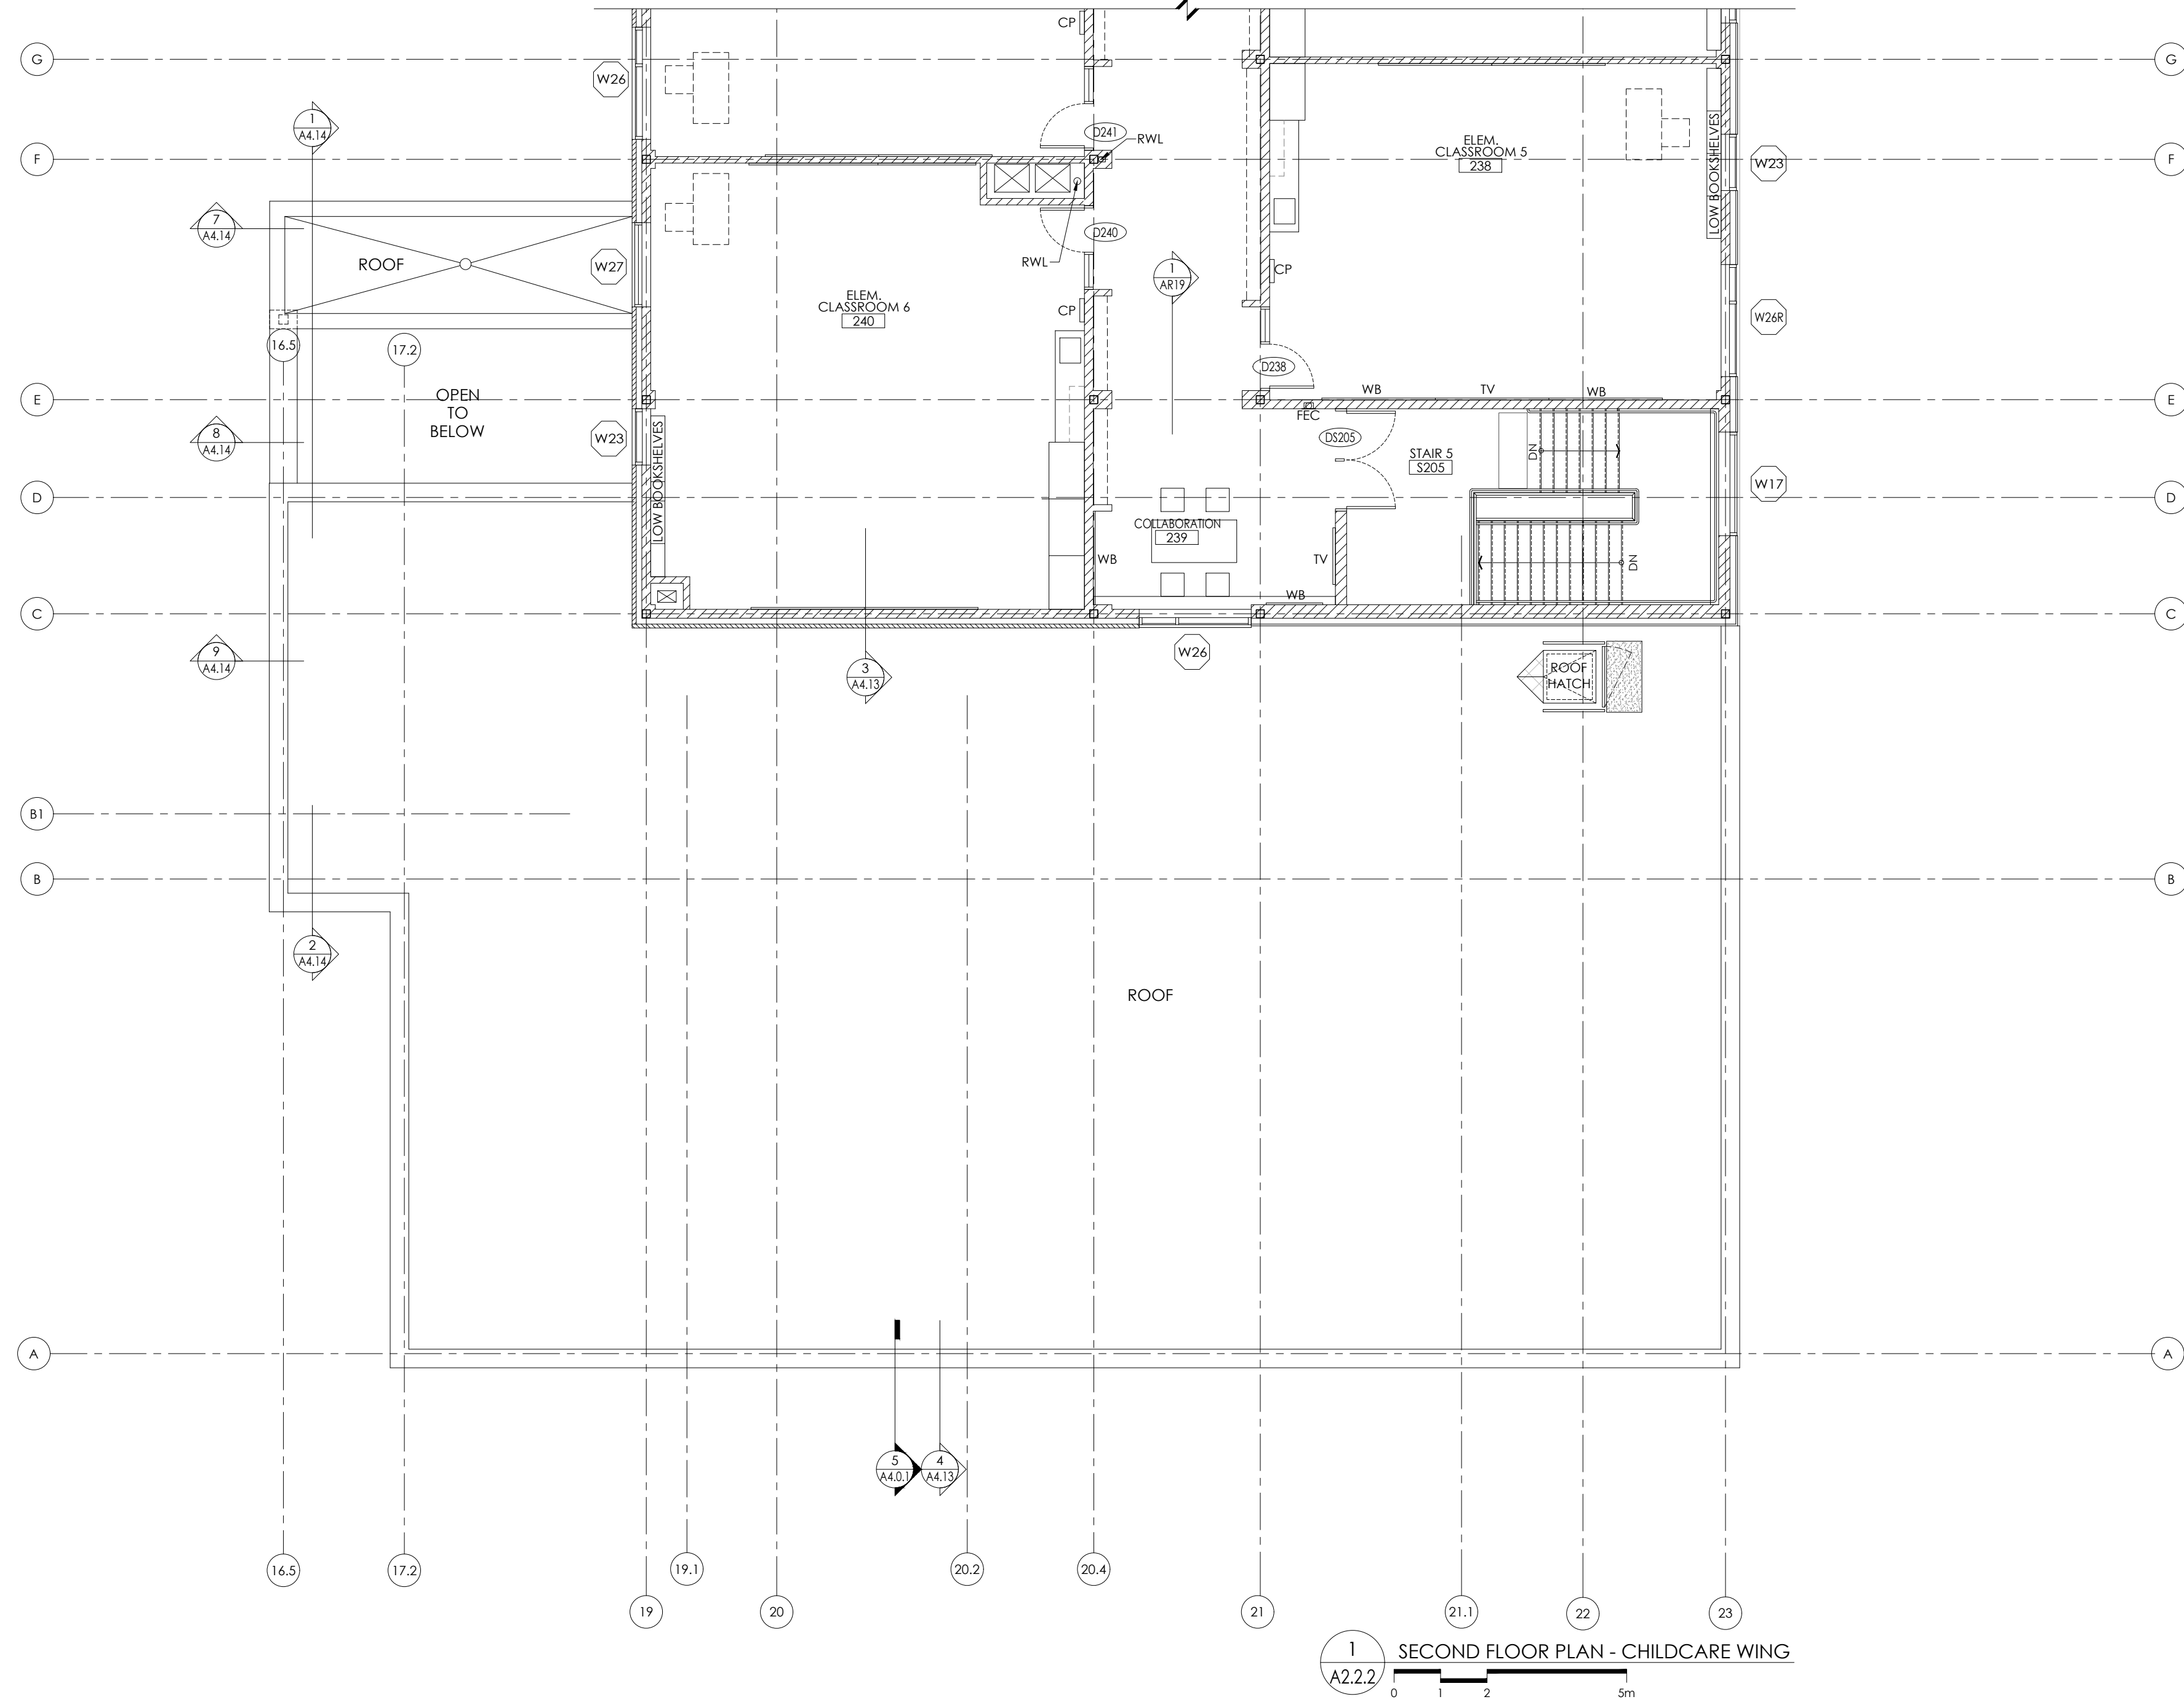

1 SECOND FLOOR PLAN - CHILDCARE WING
A2.2.2

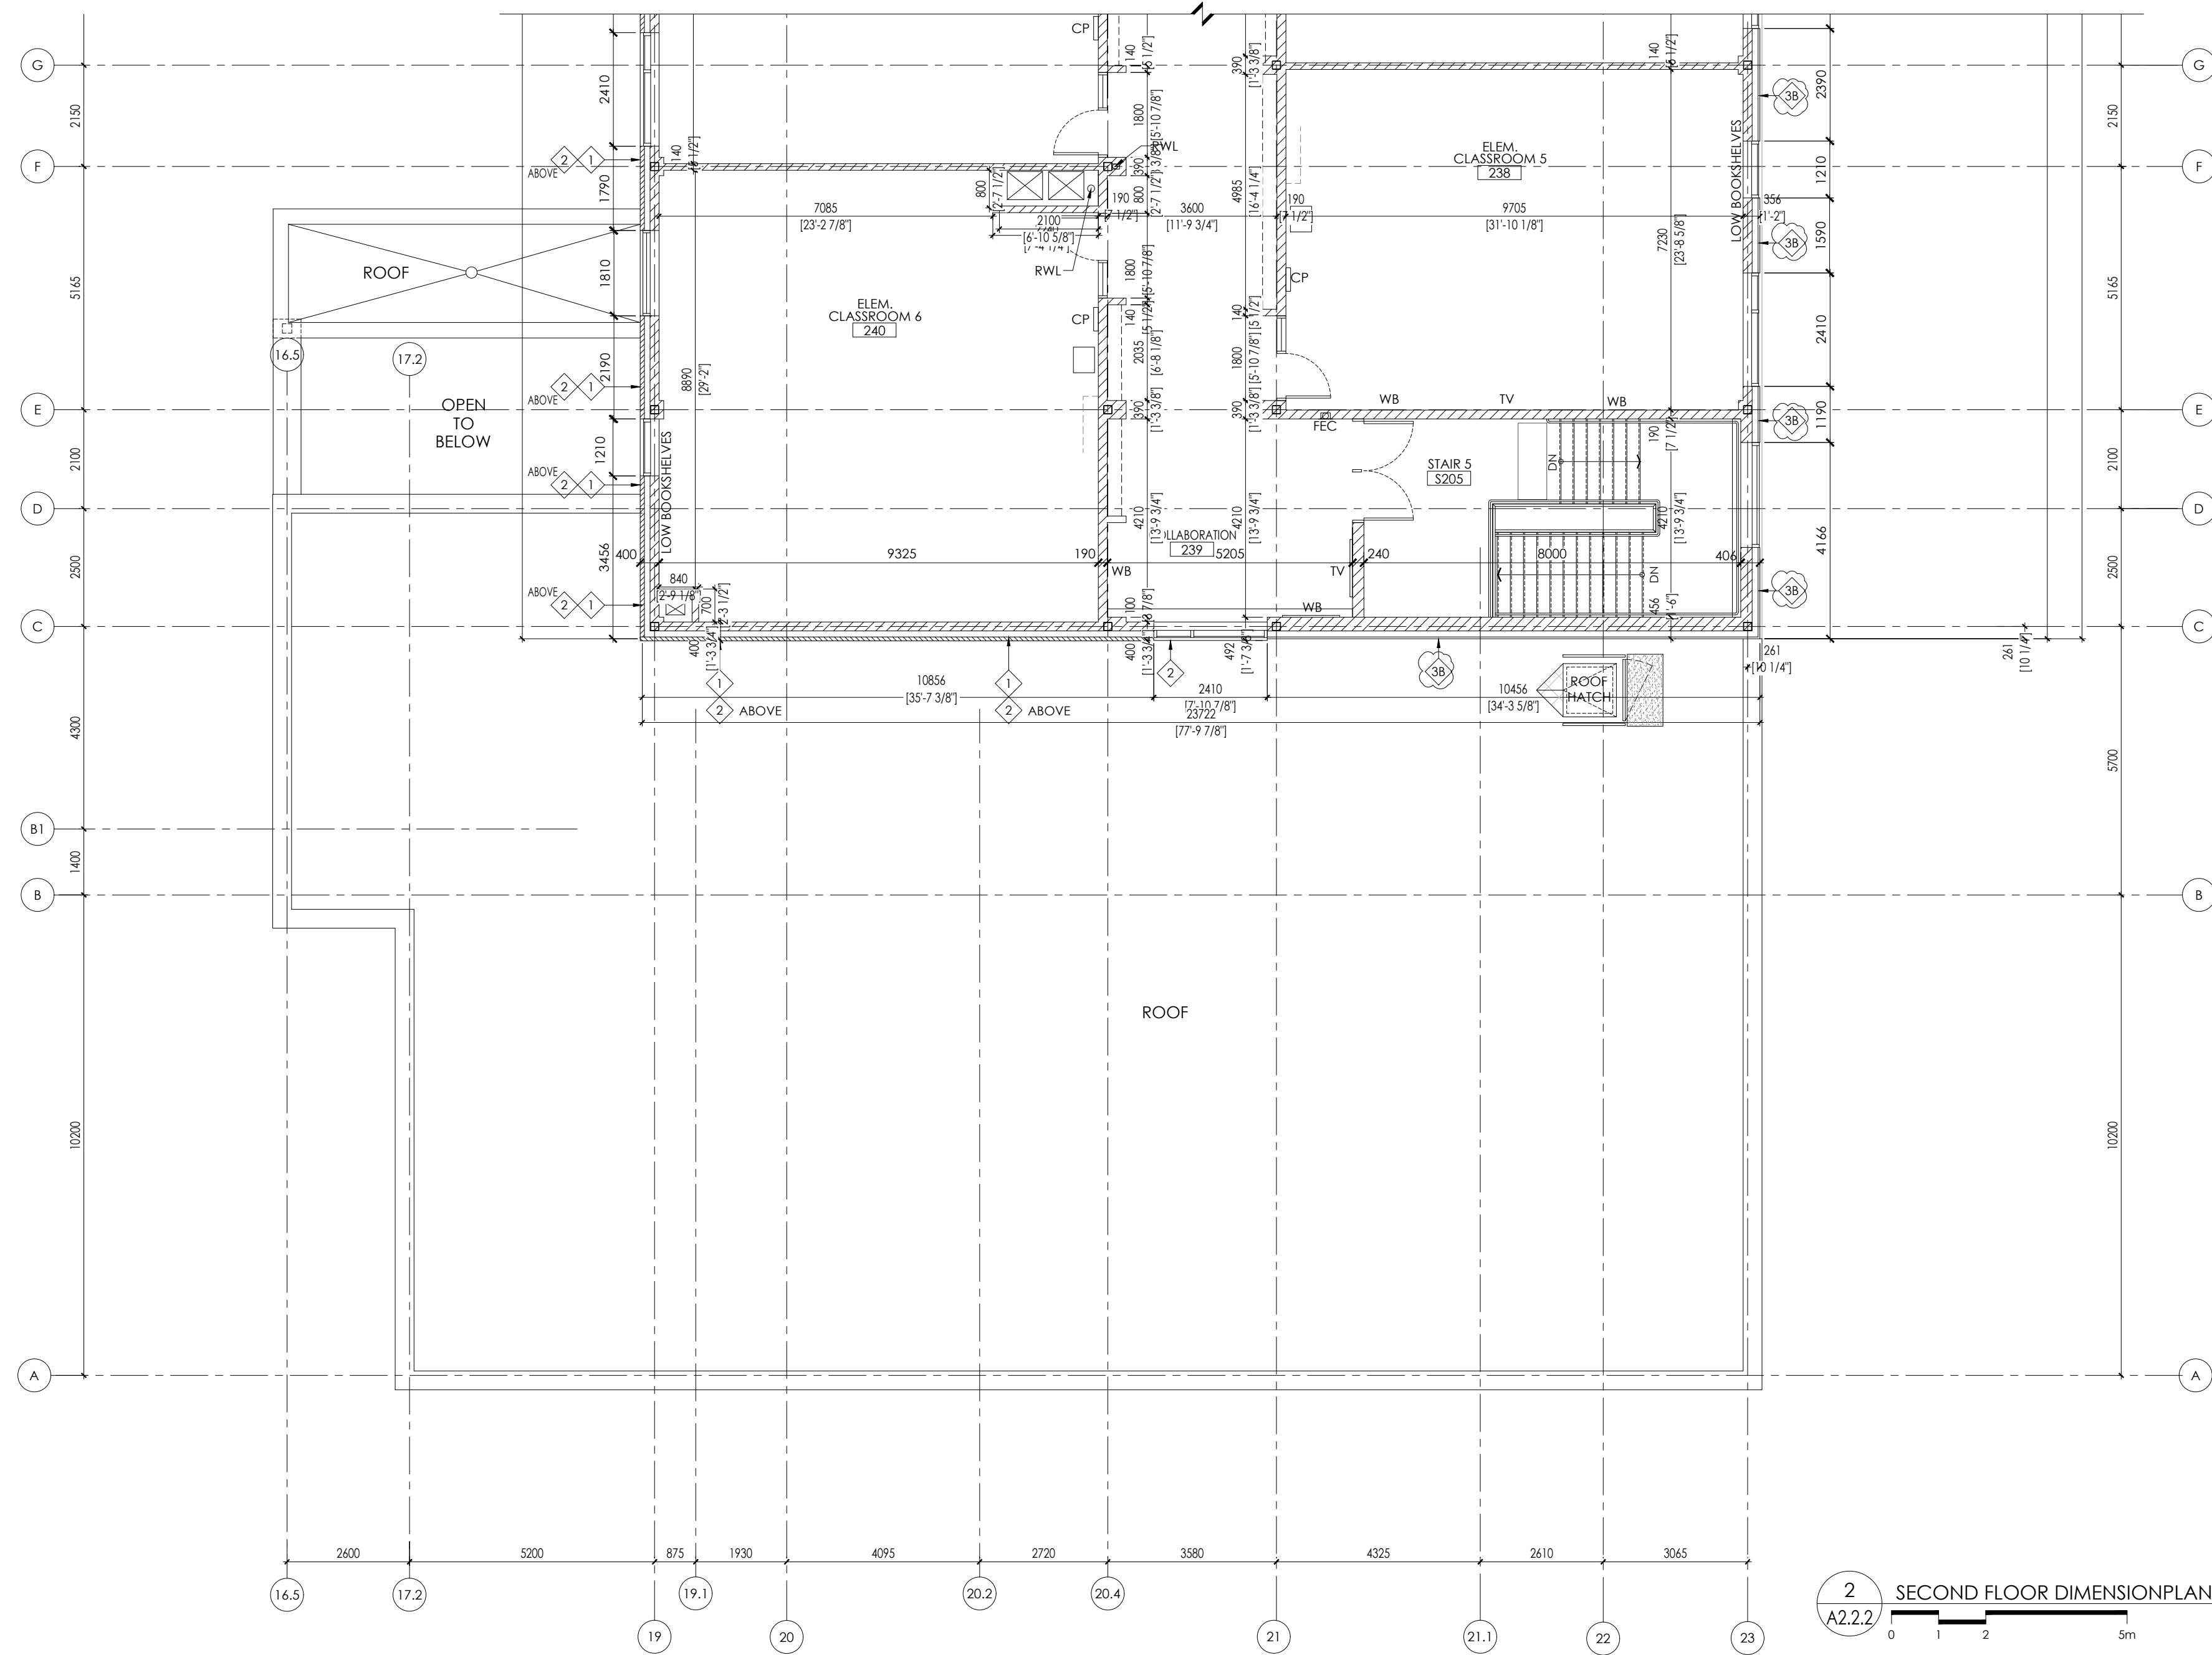

2 SECOND FLOOR DIMENSION PLAN - CHILDCARE WING
A2.2.2

REFER TO SHEET A2.2.1 FOR
NOTES & LEGEND REFERENCE

REVISIONS		
NO.	DATE	PARTICULAR
1	2022.04.06	ISSUED FOR 805 CLASS B COSTING
2	2022.06.18	ISSUED FOR SPA
3	2022.09.22	ISSUED FOR OWNERS REVIEW - RFS SET
4	2022.12.16	ISSUED FOR 2nd SPA SUBMISSION
5	2023.01.31	ISSUED FOR TENDER
6	2023.02.22	ISSUED FOR ADDENDUM 9
7	2023.08.23	ISSUED FOR CONVENIENCE
8	2023.11.20	ISSUED FOR PERMIT COMMENTS
9	2024.01.24	ISSUED FOR SH03
10	2024.02.15	ISSUED FOR PCH0308
11	2024.03.04	ISSUED FOR PCH0309
12	2024.03.10	ISSUED FOR SH004
13	2024.05.14	ISSUED FOR SH004
14	2024.07.22	ISSUED FOR SH008
15	2024.08.07	ISSUED FOR SH009
16	2024.10.02	ISSUED FOR PCH015
17	2025.04.11	ISSUED FOR PCH019
18	2025.05.01	ISSUED FOR CO#07
19	2025.05.28	ISSUED FOR PCH020 - CO#010
20	2025.07.31	ISSUED FOR SH013
21	2025.08.06	ISSUED FOR SH014
22	2025.08.15	ISSUED FOR PCH025 - CO#017
23	2025.08.25	ISSUED FOR PCH027 - CO#021
24	2025.09.02	ISSUED FOR PCH029
25	2025.09.02	ISSUED FOR SH020 - CO#018
26	2025.09.08	ISSUED FOR PCH031
27	2025.09.09	ISSUED FOR PCH032 - CO#022
28	2025.09.10	ISSUED FOR PCH033
29	2025.09.11	ISSUED FOR SH022
30	2025.09.15	ISSUED FOR SH023
31	2025.09.16	ISSUED FOR PCH F33 - CO#023
32	2025.09.30	ISSUED FOR PCH F37 - CO#019
33	2025.09.30	ISSUED FOR PCH F38 - CO#025
34	2025.10.04	ISSUED FOR PCH F39 - CO#024
35	2025.10.20	ISSUED FOR PCH F40#1
36	2025.10.30	ISSUED FOR PCH041
37	2025.10.23	ISSUED FOR PCH F42
38	2025.11.21	ISSUED FOR PCH021#01 - CO12 CO#034
39	2025.11.14	ISSUED FOR PCH043
40	2025.11.26	ISSUED FOR PCH043#1
41	2025.12.03	ISSUED FOR PCH044 - CO#026
42	2026.02.04	ISSUED FOR RECORD SET UP TO CO#07

NOTES:

KEY PLAN:



CLIENT:

NEAR NORTH DISTRICT SCHOOL BOARD
NND58 Tender # 2023-015


PROJECT:

NEW PARRY SOUND K-12 SCHOOL & CHILDCARE
PARRY SOUND HIGH SCHOOL SITE

111 ISABELLA STREET
PARRY SOUND, ONTARIO

ORIGINAL PAGE SIZE ARCH E1 - 30" x 42"
KEY TO DETAIL LOCATION:
A - DETAIL NO.
B - DETAIL NO. ORIGIN

+VVG ARCHITECTS
THE VENTIN GROUP LTD

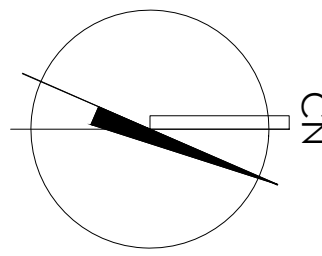

A2.2.3


DRAWN BY: EB/KH

CHECKED BY: PS

SECOND FLOOR PLAN & DIMENSION PLAN - CHILDCARE WING

All dimensions and measurements must be
checked and verified by the Senior Contractor

Reproduction of drawings and related documents in whole or in part is
prohibited without written permission of the design group.

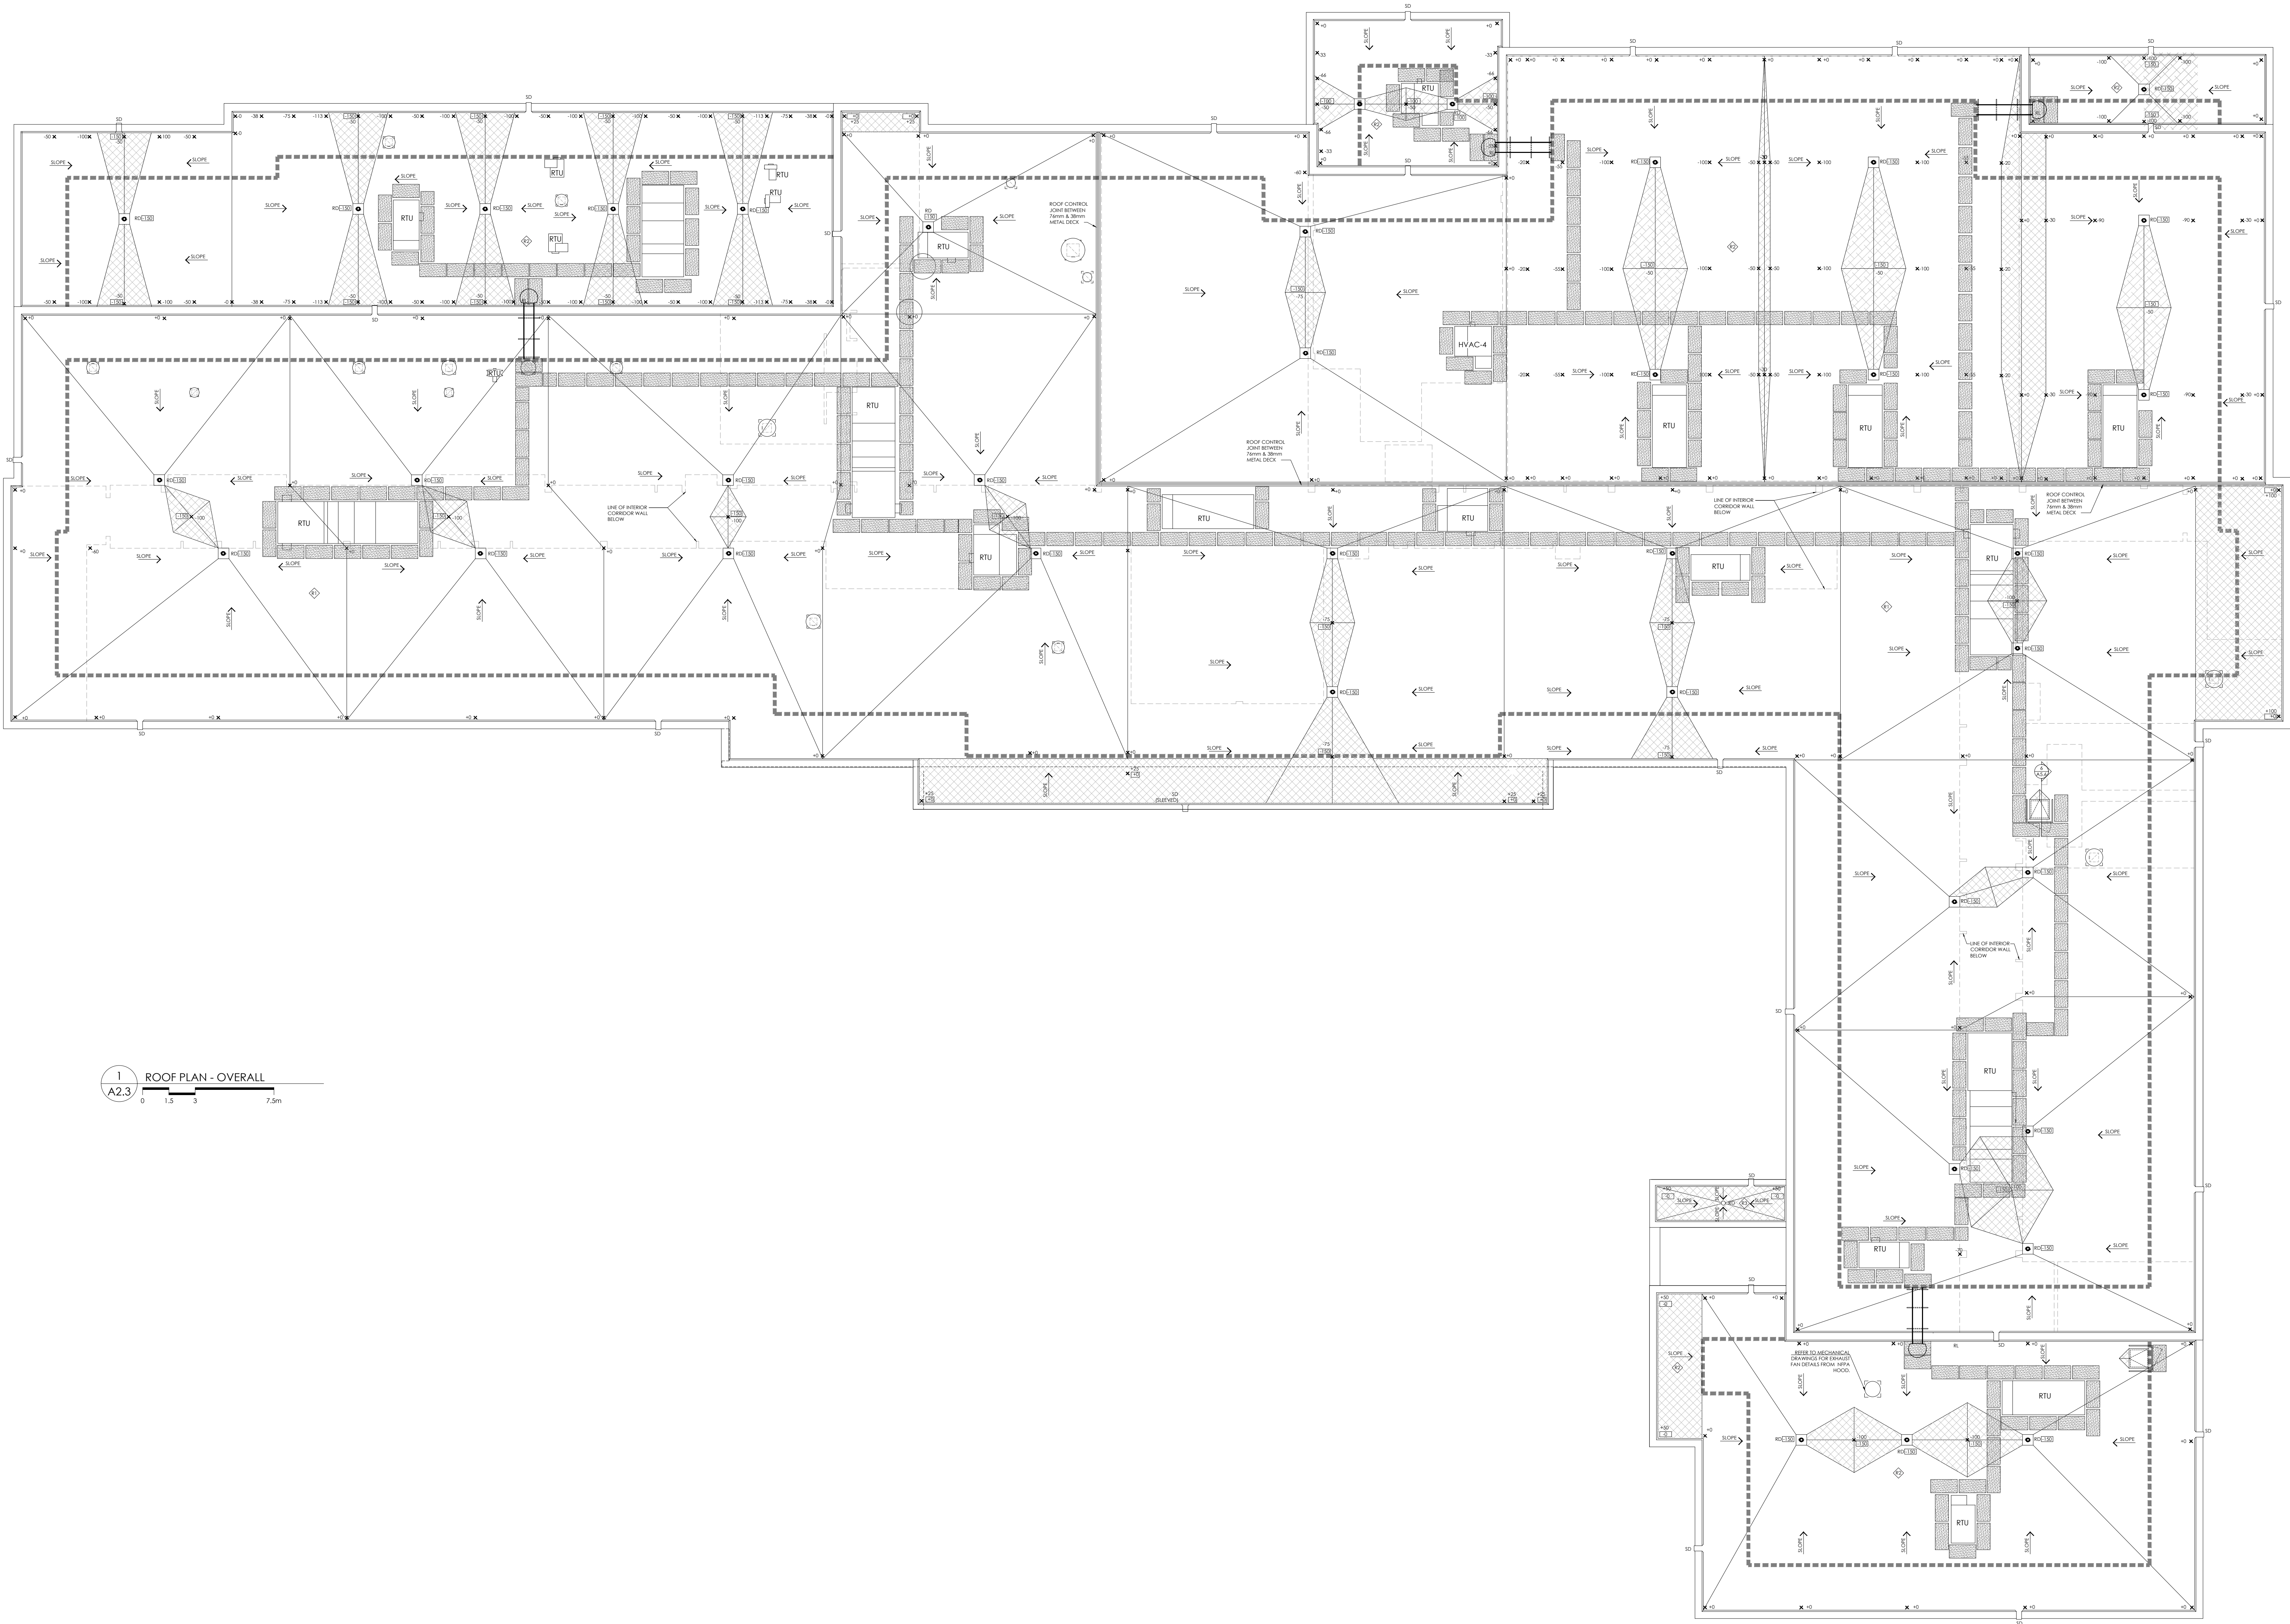

1 ROOF PLAN - OVERALL
A2.3
0 1.5 3 7.5m


NOTES:
REFER TO MECHANICAL DRAWINGS FOR PLACEMENT
OF MECHANICAL ROOF TOP EQUIPMENT

* THE BUILDING OWNER / OPERATOR SHALL RESPONSIBLE FOR PREPARING, IMPLEMENTING, TRAINING AND ENFORCING PROCEDURAL SAFETY RULES / POLICIES FOR AUTHORIZED ACCESS OF THE ROOF AREA FOR SERVICING INCLUDING BUT NOT LIMITED TO THE USE OF ROOF ACCESS HATCHES, ROOF ACCESS LADDERS, TRAVEL RESTRAINT SYSTEM, FALL PROTECTION SYSTEM AND MINIMUM DISTANCE SEPARATION FOR SERVICE PERSONNEL FROM ROOF PERIMETERS WITHOUT THE USE OF FALL PROTECTION BASED ON THE MOST RECENT ONTARIO HEALTH AND SAFETY ACT (OHSIA) REQUIREMENTS. THE BUILDING OWNER / OPERATOR SHALL UPDATE THE SAFETY RULES / POLICIES TO SUIT ANY FUTURE LEGISLATED CHANGES TO THE OHSIA.

REVISIONS		
NO.	DATE	PARTICULAR
1	2022.04.06	ISSUED FOR 805 CLASS B COSTING
2	2022.06.18	ISSUED FOR SPA
3	2022.09.22	ISSUED FOR OWNERS REVIEW - RRS SET
4	2022.12.16	ISSUED FOR 2ND SPA SUBMISSION
5	2023.01.31	ISSUED FOR TENDER
6	2023.02.22	ISSUED FOR ADDENDUM 9
7	2023.08.23	ISSUED FOR CONVENIENCE
8	2023.11.20	ISSUED FOR PERMIT COMMENTS
9	2024.01.24	ISSUED FOR SH#3
10	2024.02.15	ISSUED FOR PCH#308
11	2024.03.04	ISSUED FOR PCH#409
12	2024.03.10	ISSUED FOR SH#404
13	2024.05.14	ISSUED FOR SH#406
14	2024.07.22	ISSUED FOR SH#408
15	2024.08.07	ISSUED FOR SH#409
16	2024.10.02	ISSUED FOR PCH#415
17	2025.04.11	ISSUED FOR PCH#419
18	2025.05.01	ISSUED FOR CO#407
19	2025.05.28	ISSUED FOR PCH#30 - CO#410
20	2025.07.31	ISSUED FOR SH#413
21	2025.08.06	ISSUED FOR SH#414
22	2025.08.15	ISSUED FOR PCH#35 - CO#417
23	2025.08.25	ISSUED FOR PCH#27 - CO#421
24	2025.09.02	ISSUED FOR PCH#29
25	2025.09.02	ISSUED FOR SH#40 - CO#418
26	2025.09.08	ISSUED FOR PCH#31
27	2025.09.09	ISSUED FOR PCH#32 - CO#422
28	2025.09.10	ISSUED FOR PCH#33
29	2025.09.11	ISSUED FOR SH#22
30	2025.09.15	ISSUED FOR SH#23
31	2025.09.16	ISSUED FOR PCH F35 - CO#423
32	2025.09.30	ISSUED FOR PCH#37 - CO#419
33	2025.09.30	ISSUED FOR PCH#38 - CO#425
34	2025.10.04	ISSUED FOR PCH#39 - CO#424
35	2025.10.20	ISSUED FOR PCH#40
36	2025.10.30	ISSUED FOR PCH#41
37	2025.10.23	ISSUED FOR PCH#42
38	2025.11.21	ISSUED FOR PCH#21#1 - CO#2 COW#1
39	2025.11.14	ISSUED FOR PCH#403
40	2025.11.26	ISSUED FOR PCH#404
41	2025.12.03	ISSUED FOR PCH#44 - CO#426
42	2026.02.04	ISSUED FOR RECORD SET UP TO CO#27

NOTES:

KEY PLAN:

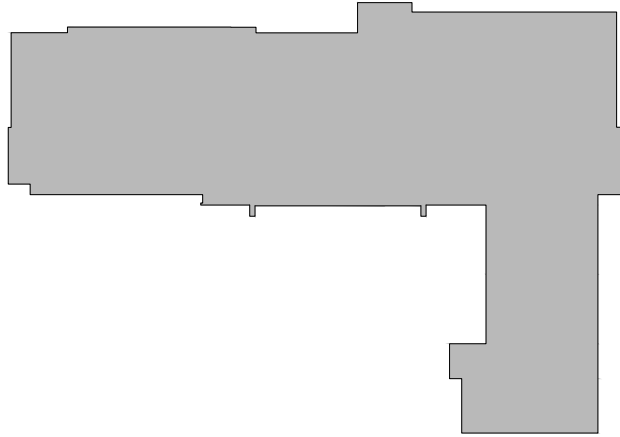


CLIENT:
NEAR NORTH DISTRICT SCHOOL BOARD
NND58 Tender # 2023-015

PROJECT:
NEW PARRY SOUND K-12 SCHOOL & CHILDCARE
PARRY SOUND HIGH SCHOOL SITE

111 ISABELLA STREET
PARRY SOUND, ONTARIO

ORIGINAL PAGE SIZE ARCH E1 - 30" x 42"
KEY TO DETAIL LOCATION:
A - DETAIL NO.
B - DETAIL NO. ORIGIN

ARCHITECTS
THE VENTIN GROUP LTD

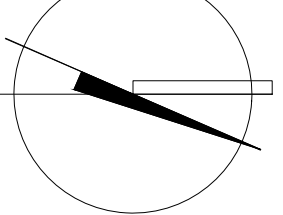

ROOF PLAN - OVERALL


A2.3

Plot Date: Feb 03, 2026 - 5:10pm By: Jkely

DRAWN BY: EB/KH

CHECKED BY: PS

All dimensions and measurements must be checked and verified by the General Contractor. Reproduction of drawings and related documents in whole or in part is forbidden without written permission of the Ventin Group.

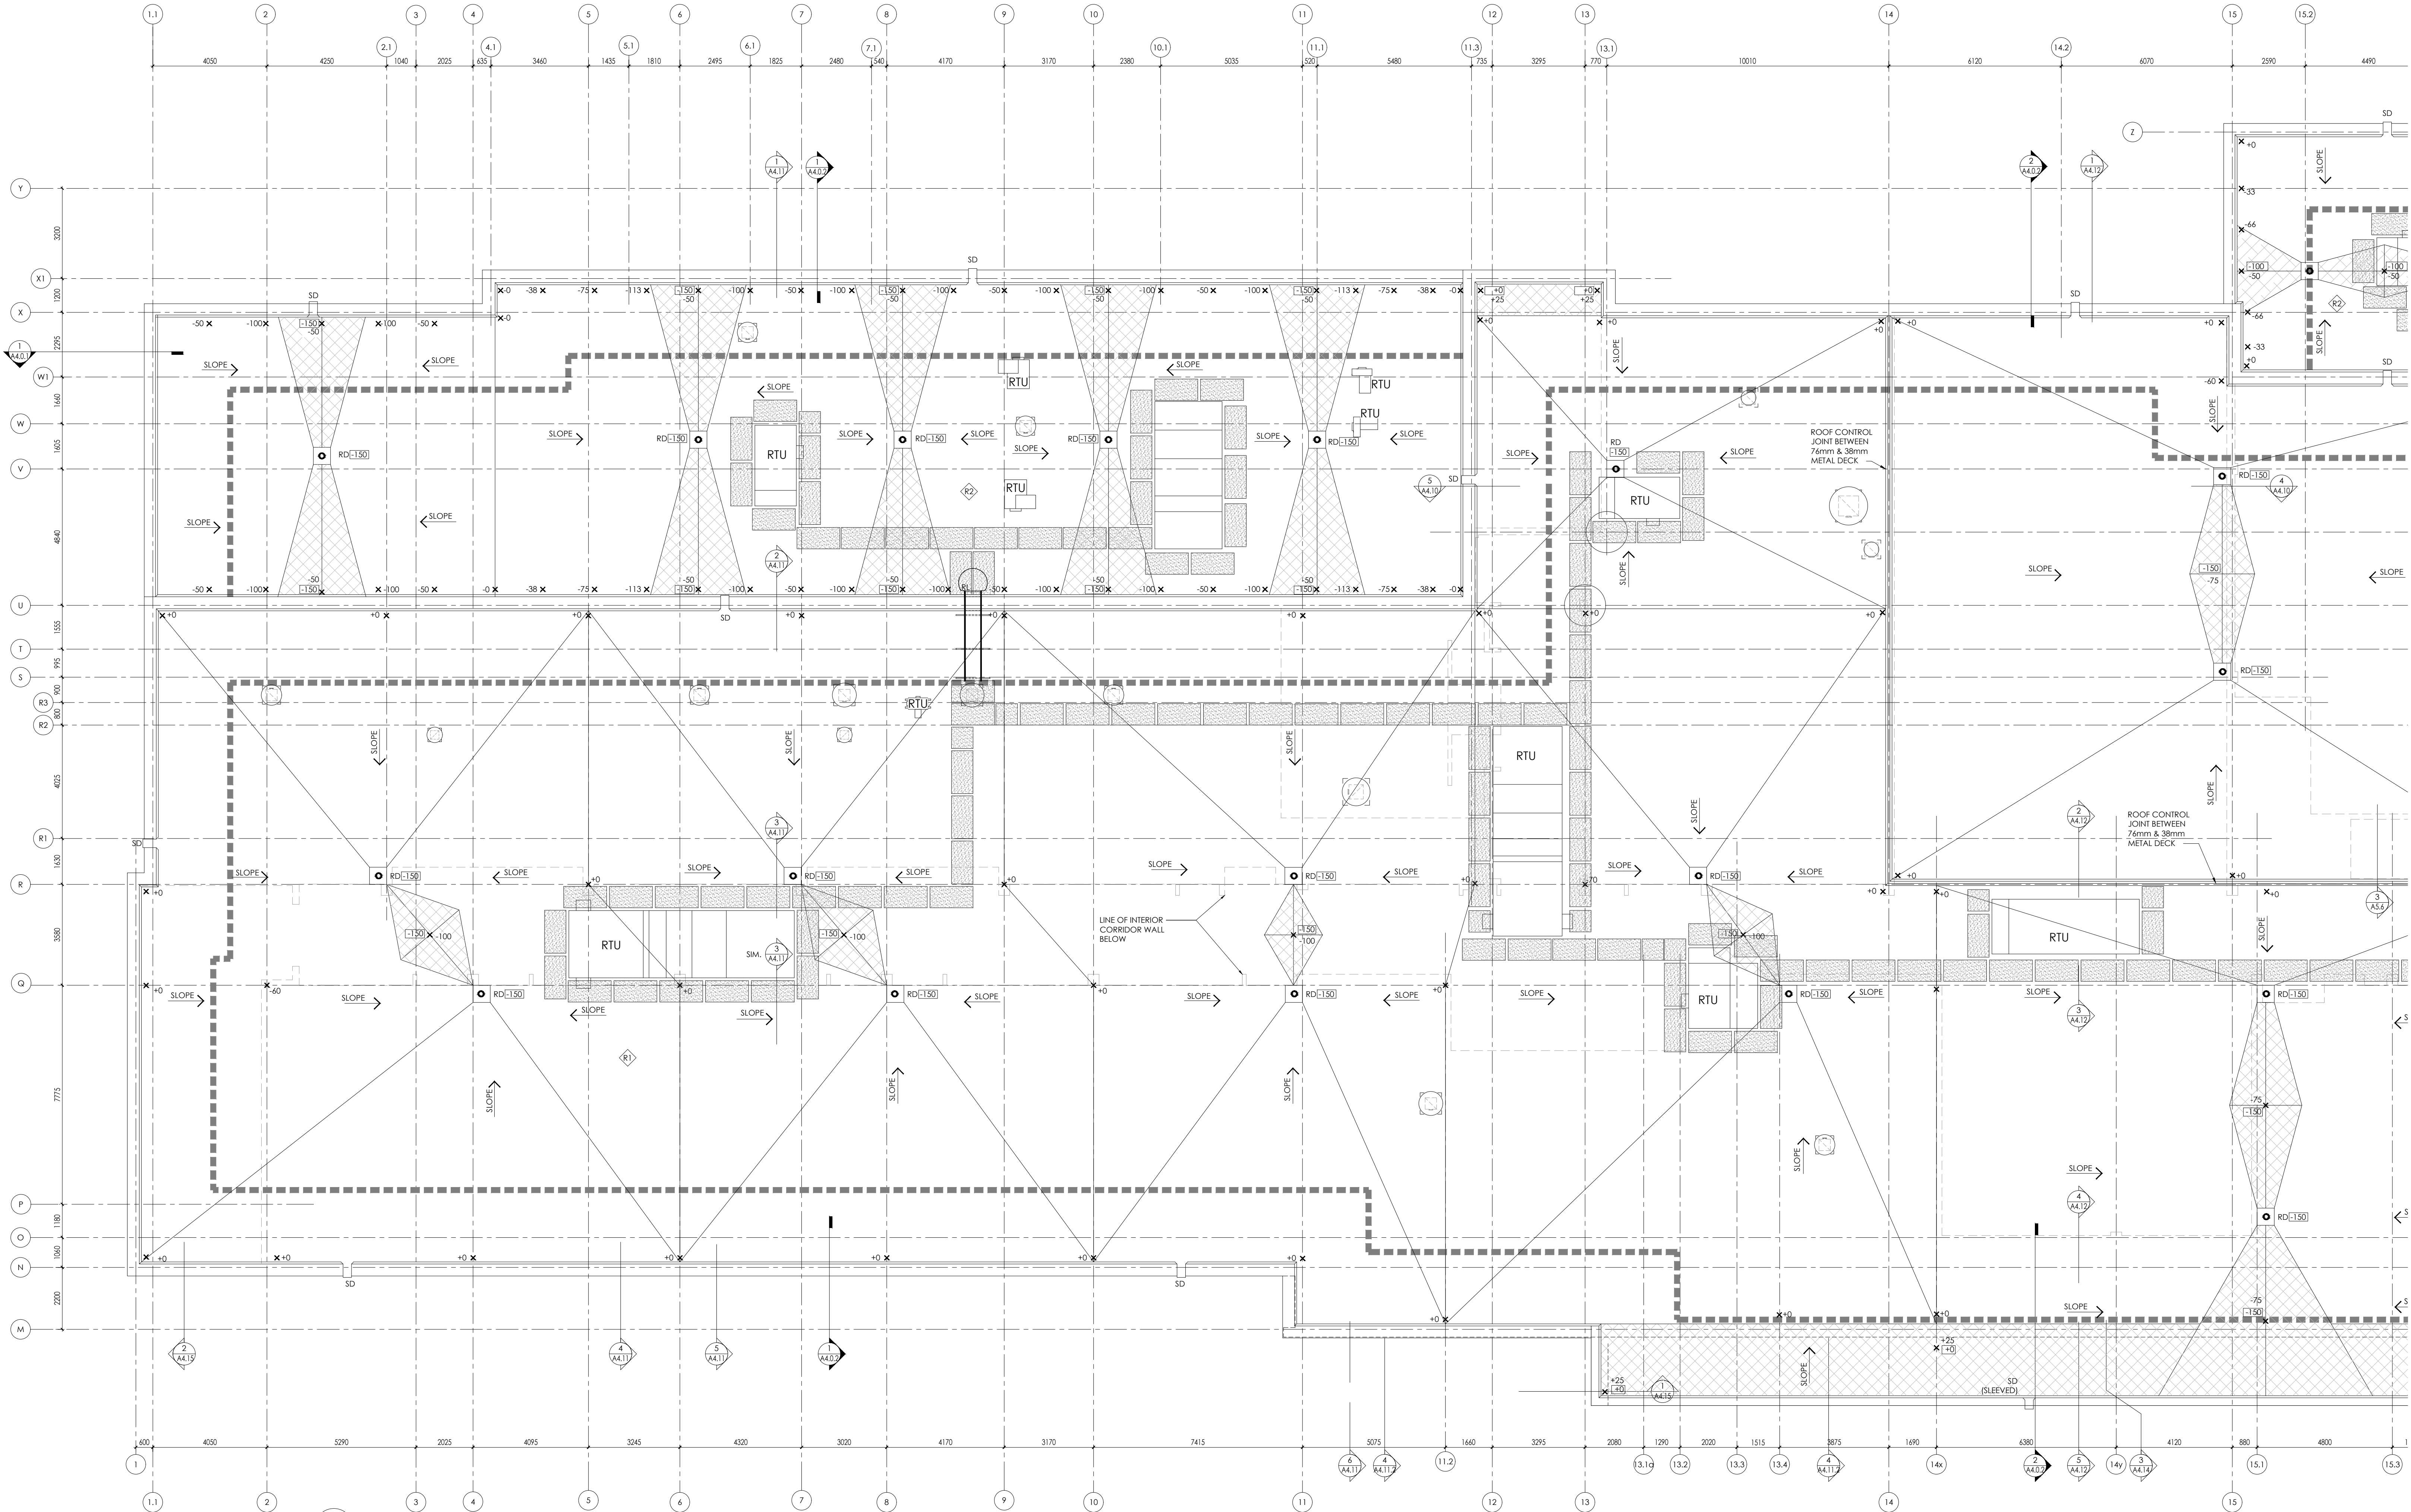

ROOF LEGEND

- SLOPE** → ROOF SLOPE DIRECTION
PROVIDE POSITIVE ROOF SLOPES TOWARD ROOF DRAIN. SLOPE TO BE MIN. 1:5-2%
RELATIVE ROOF SLOPE HEIGHT / ELEV. DIFFERENCES OF TOP OF ROOF SURFACE LAYER WITHIN THE ROOF PER. INDICATED
RELATIVE TO HIGH POINT OF FINISHED ROOF IS NOTED AS UTM TYP. (NOT INCLUDING THE TAPERED INSUL.)
- +50** RELATIVE ROOF SLOPE HEIGHT DIFFERENCES OF TOP OF ROOF SURFACE WITHIN THE ROOF PER. INDICATED
- RD-150** ROOF DRAIN LOCATION
610x410mm x 25mm DEEP ROOF INSUL. DEPRESSION @ ROOF DRAIN LOCATION
ROOF DRAINS ARE LOCATED IN THE GENERAL LOCATION ON THE ROOF PLAN. COORD. W/ STRUCT. DWG. S & COORD. W/ THE STEEL SHOP DWG. S FOR EXACT ROOF DRAIN LOCATION.
PROVIDE POSITIVE ROOF SLOPES TOWARD ROOF DRAIN. SLOPE TO BE MIN. 1:5-2%
[MAX. 150mm ALLOWANCE FOR WATER RETENTION UNTIL IT CAN DRAIN]
[MAX. AREA PER RD - 150 M²]
- RTU** ROOF TOP EQUIPMENT & VENTS
LOCATE ROOF TOP EQUIPMENT AWAY FROM ROOF DRAINS, ROOF PERIMETERS AND VALLEYS ON A 600mm HIGH PRE-FAB INSUL. CURB
(COORD. W/ R/A T 3)
CONTRACTOR - AIR INTAKE / EXHAUST / ACCESS / MAINTENANCE
- RTU SCREEN** TAPERED ROOF INSULATION TO PROVIDE ROOF SLOPE IN AREA WHERE EX. ROOF STRUCT. CAN NOT BE ALTERED FOR REG'D DRAINAGE SLOPE.
PROVIDE ADDITIONAL TAPERED INSUL. @ ALL ROOF TOP UNIT LOCATIONS TO DIVERT WATER AROUND THE UNITS TO DRAIN.
SLOPE TO BE MIN. 1:5-2%.
- ADHERED MEMBRANE WEAR LAYER PARAREAD BY SIPSAT**
& TIE IN TO EX. BELOW GRADE DRAINAGE STORM WATER MANAGEMENT SYSTEM
- RTU SCREEN** ROOF TOP ACCESS HATCH C/W PRE-FAB ROOF HATCH MOUNTED GUARD & SAFETY GATE BY ROOF HATCH SUPPLIER.

- GENERAL NOTES**
- INSTALL CONC. PRECAST PAVERS / WALKWAY MEMBRANE @ ALL ROOF TOP UNIT LOCATIONS. ALL ROOF TOP UNIT LOCATIONS INDICATED ON THIS PLAN ARE APPROXIMATE
 - IN ADDITION TO PRECAST PAVERS / WALKWAY MEMBRANE INDICATED ON ROOF PLAN ALLOW FOR SUPPLY & INSTALL. OF AN ADDITIONAL 50 PRECAST ROOF PAVES / 20m² WALKWAY MEMBRANE TO BE INSTALLED AROUND ROOF TOP MECH. EQUIP. AS SITE DIRECTED
 - COORDINATE ROOF SUPPORTS FOR ROOF TOP GAS LINE W/ MECHANICAL GAS LINE LAYOUT
 - ROOF DRAINS SHOWN ARE TO BE 8" STRUCT. LOW POINTS. COORDINATE ALL LOW POINTS W/ STRUCTURAL DRAWINGS. SITE VERIFY & ENSURE ROOF DRAINS ARE INSTALLED @ LOW POINTS.
 - COORD. W/ MECH. & ELEC. DWG. S FOR LOCATIONS OF ALL ROOF TOP MECH. & ELEC. EQUIP. EQUIP. SHOWN ON ARCH. ROOF PLAN IS FOR GENERAL REFERENCE ONLY
 - INSTALL NEW TAPERED INSUL. AROUND ALL NEW MECH. UNITS ON ROOF SYSTEMS TO DIRECT WATER AROUND THE MECH. UNITS TOWARD THE ROOF DRAINS. COORDINATE TAPERED INSULATION & DIRECTION OF ROOF SLOPES AFTER INSTALLATION OF MECH. UNIT CURBS & PRIOR TO START OF FINISHED ROOFING.
- HATCH IDENTIFICATION MARKER LEGEND**
- TRAVEL LIMIT WARNING STRIP (300mm FROM EDGE OF ROOF, TYP.)
 - *NOTE: TO BE A SEPARATE COLOUR CAP SHEET 300mm WIDE IN THE HOD-BIT ROOFING.
- SEPARATE PRICE** (FOR ROOF TOP UNITS AS SHOWN ON ROOF PLAN)
PROVIDE DIRECT MOUNT ROOF TOP UNIT SCREENING SYSTEM COORDINATE W/ DIVISION 16. COORDINATE WITH MECHANICAL & ADJUST PAVES LOCATIONS TO SUIT.
COORDINATE RTU SCREEN ACCESS LOCATIONS WITH RTU SUPPLIER.


NOTES:
REFER TO MECHANICAL DRAWINGS FOR PLACEMENT OF MECHANICAL ROOF TOP EQUIPMENT

* THE BUILDING OWNER / OPERATOR SHALL RESPONSIBLE FOR PREPARING, IMPLEMENTING, TRAINING AND ENFORCING PROCEDURAL SAFETY RULES / POLICIES FOR AUTHORIZED ACCESS OF THE ROOF AREA FOR SERVICING INCLUDING BUT NOT LIMITED TO THE USE OF ROOF ACCESS HATCHES, ROOF ACCESS LADDERS, TRAVEL RESTRAINT SYSTEM, FALL PROTECTION SYSTEM AND MINIMUM DISTANCE SEPARATION FOR SERVICE PERSONNEL FROM ROOF PERIMETERS WITHOUT THE USE OF FALL PROTECTION BASED ON THE MOST RECENT ONTARIO HEALTH AND SAFETY ACT (OHSIA) REQUIREMENTS. THE BUILDING OWNER / OPERATOR SHALL UPDATE THE SAFETY RULES / POLICIES TO SUIT ANY FUTURE LEGISLATED CHANGES TO THE OHSIA.

NO.	DATE	PARTICULAR
1	2022.04.06	ISSUED FOR 805 CLASS B COSTING
2	2022.06.18	ISSUED FOR SPA
3	2022.09.22	ISSUED FOR OWNERS REVIEW - RES. SET
4	2022.12.16	ISSUED FOR 2ND SPA SUBMISSION
5	2023.01.31	ISSUED FOR TENDER
6	2023.02.22	ISSUED FOR ADDENDUM 9
7	2023.08.23	ISSUED FOR CONVENIENCE
8	2023.11.20	ISSUED FOR PERMIT COMMENTS
9	2024.01.24	ISSUED FOR SH403
10	2024.02.15	ISSUED FOR PCH4038
11	2024.03.04	ISSUED FOR PCH4039
12	2024.03.10	ISSUED FOR SH404
13	2024.05.14	ISSUED FOR SH404
14	2024.07.22	ISSUED FOR SH408
15	2024.08.07	ISSUED FOR SH409
16	2024.10.02	ISSUED FOR PCH415
17	2025.04.11	ISSUED FOR PCH4019
18	2025.05.01	ISSUED FOR CO4057
19	2025.05.28	ISSUED FOR PCH4030 - CO4010
20	2025.07.31	ISSUED FOR SH4013
21	2025.08.06	ISSUED FOR SH4014
22	2025.08.15	ISSUED FOR PCH4035 - CO4017
23	2025.08.25	ISSUED FOR PCH4027 - CO4021
24	2025.09.02	ISSUED FOR PCH4029
25	2025.09.02	ISSUED FOR SH400 - CO4018
26	2025.09.08	ISSUED FOR PCH4031
27	2025.09.09	ISSUED FOR PCH4032 - CO4022
28	2025.09.10	ISSUED FOR PCH4033
29	2025.09.11	ISSUED FOR SH4022
30	2025.09.15	ISSUED FOR SH4023
31	2025.09.16	ISSUED FOR PCH4035 - CO4023
32	2025.09.30	ISSUED FOR PCH4037 - CO4019
33	2025.10.30	ISSUED FOR PCH4038 - CO4025
34	2025.10.04	ISSUED FOR PCH4039 - CO4024
35	2025.10.20	ISSUED FOR PCH4041
36	2025.10.30	ISSUED FOR PCH4041
37	2025.10.23	ISSUED FOR PCH4042
38	2025.11.21	ISSUED FOR PCH4021R1 - CO12 CO4030
39	2025.11.14	ISSUED FOR PCH4043
40	2025.11.26	ISSUED FOR PCH4043R1
41	2025.12.03	ISSUED FOR PCH4044 - CO4026
42	2026.02.04	ISSUED FOR RECORD SET UP TO CO4027

NOTES:

KEY PLAN:

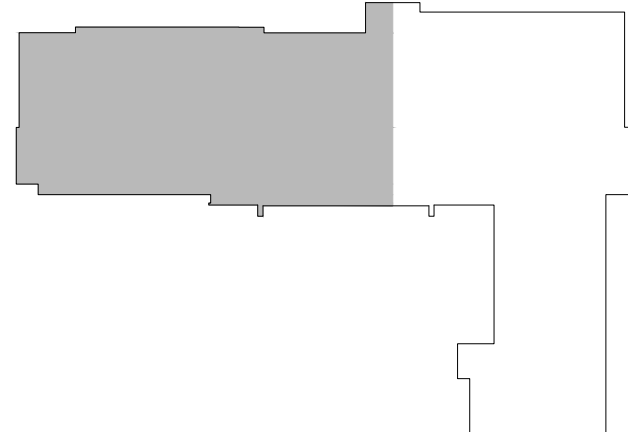

CLIENT:
NEAR NORTH DISTRICT SCHOOL BOARD
NND58 Tender # 2023-015

PROJECT:
NEW PARRY SOUND K-12 SCHOOL & CHILDCARE


PARRY SOUND HIGH SCHOOL SITE

111 ISABELLA STREET
PARRY SOUND, ONTARIO

ORIGINAL PAGE SIZE ARCH E1 - 30" x 42"
KEY TO DETAIL LOCATION:
A - DETAIL NO.
B - DETAIL NO. ORIGIN

ARCHITECTS
THE VENTIN GROUP LTD

VG+

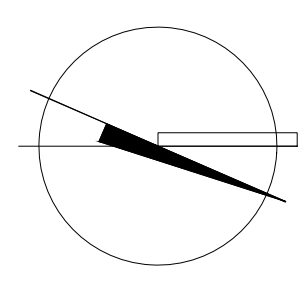

A2.3.1


Plot Date: Feb 03, 2026 - 5:10pm By: JKH

DRAWN BY: EB/KH

CHECKED BY: PS

ROOF PLAN - SOUTH WING

All dimensions and measurements must be checked and verified by the Senior Contractor.

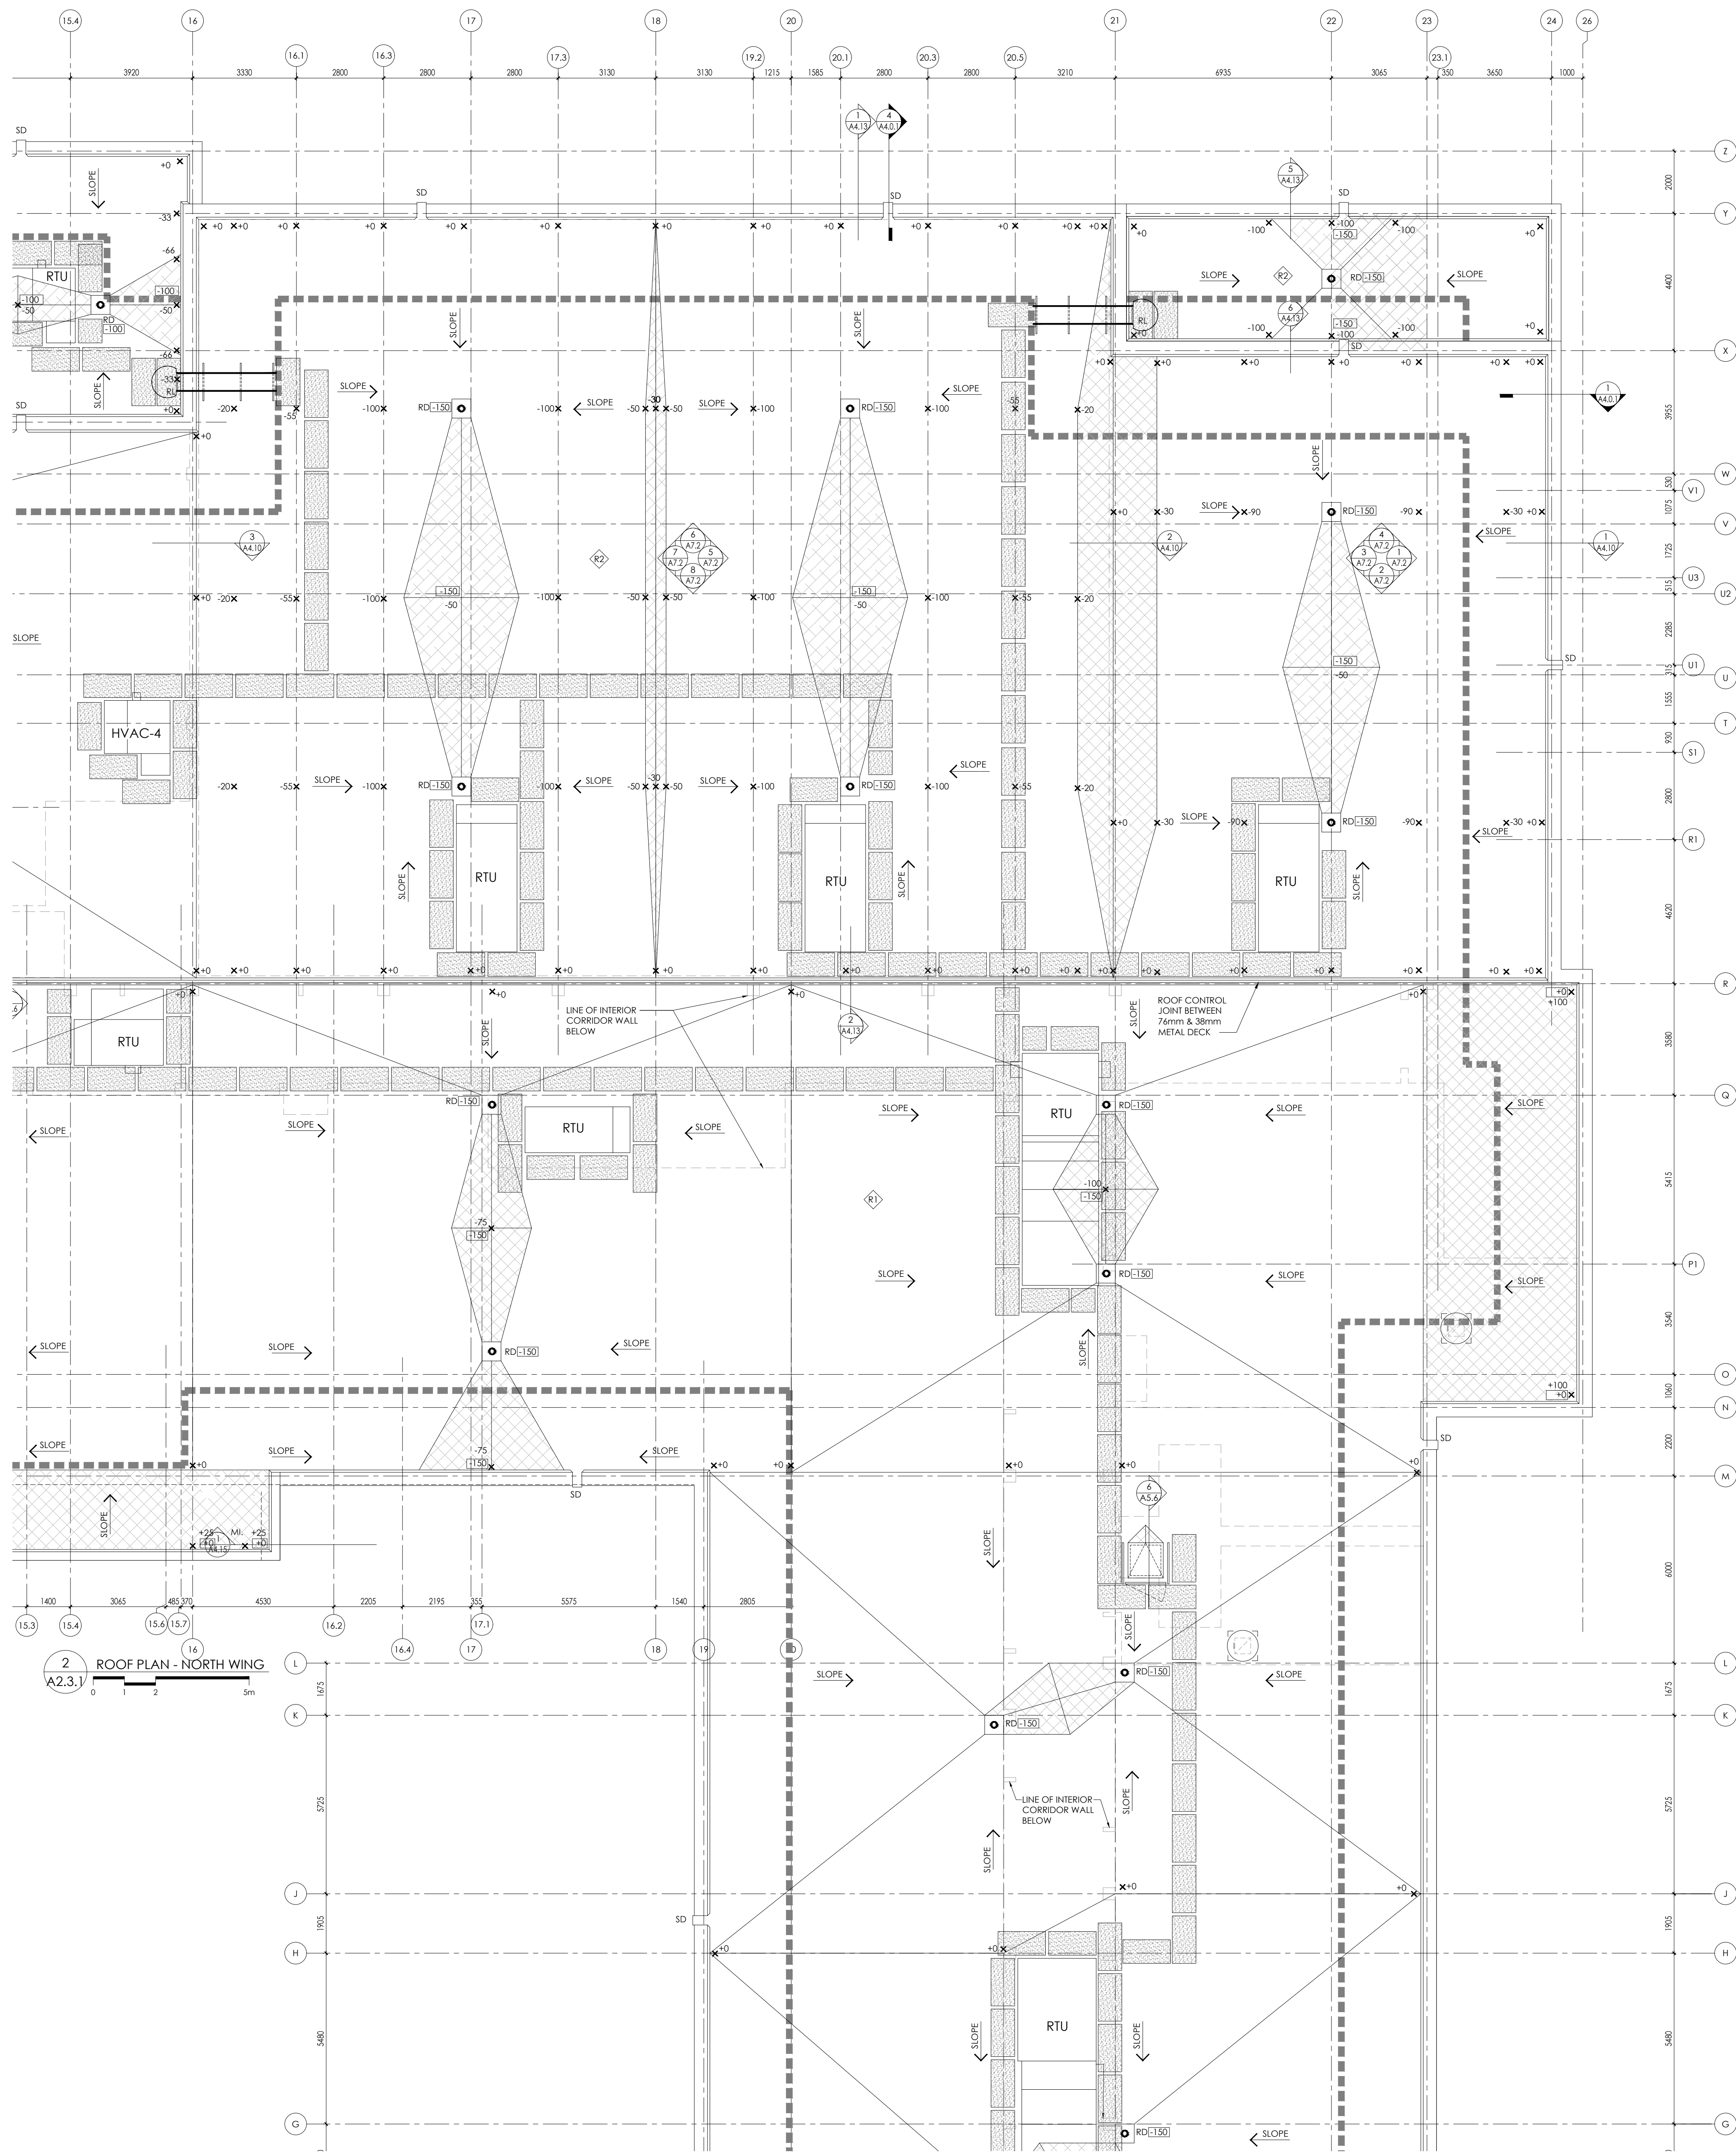

NOTES:
REFER TO MECHANICAL DRAWINGS FOR PLACEMENT
OF MECHANICAL ROOF TOP EQUIPMENT


* THE BUILDING OWNER / OPERATOR SHALL RESPONSIBLE FOR PREPARING, IMPLEMENTING, TRAINING AND ENFORCING PROCEDURAL SAFETY RULES / POLICIES FOR AUTHORIZED ACCESS OF THE ROOF AREA FOR SERVICING INCLUDING BUT NOT LIMITED TO THE USE OF ROOF ACCESS HATCHES, ROOF ACCESS LADDERS, TRAVEL RESTRAINT SYSTEM, FALL PROTECTION SYSTEM AND MINIMUM DISTANCE SEPARATION FOR SERVICE PERSONNEL FROM ROOF PERIMETERS WITHOUT THE USE OF FALL PROTECTION BASED ON THE MOST RECENT ONTARIO HEALTH AND SAFETY ACT (OHSIA) REQUIREMENTS. THE BUILDING OWNER / OPERATOR SHALL UPDATE THE SAFETY RULES / POLICIES TO SUIT ANY FUTURE LEGISLATED CHANGES TO THE OHSIA.

REVISIONS

NO.	DATE	PARTICULAR
1	2022.04.06	ISSUED FOR 805 CLASS B COSTING
2	2022.06.18	ISSUED FOR SPA
3	2022.09.22	ISSUED FOR OWNERS REVIEW - RFS SET
4	2022.12.16	ISSUED FOR 2ND SPA SUBMISSION
5	2023.01.31	ISSUED FOR TENDER
6	2023.02.22	ISSUED FOR ADDENDUM 9
7	2023.08.23	ISSUED FOR CONVENIENCE
8	2023.11.20	ISSUED FOR PERMIT COMMENTS
9	2024.01.24	ISSUED FOR SH#3
10	2024.02.15	ISSUED FOR PCN#308
11	2024.03.04	ISSUED FOR PCN#309
12	2024.03.10	ISSUED FOR SH#04
13	2024.05.14	ISSUED FOR SH#04
14	2024.07.22	ISSUED FOR SH#08
15	2024.08.07	ISSUED FOR SH#09
16	2024.10.02	ISSUED FOR PCN#115
17	2025.04.11	ISSUED FOR PCN#319
18	2025.05.01	ISSUED FOR CO#57
19	2025.05.28	ISSUED FOR PCN#30 - CO#10
20	2025.07.31	ISSUED FOR SH#13
21	2025.08.06	ISSUED FOR SH#14
22	2025.08.15	ISSUED FOR PCN#35 - CO#17
23	2025.08.25	ISSUED FOR PCN#27 - CO#21
24	2025.09.02	ISSUED FOR PCN#29
25	2025.09.02	ISSUED FOR SH#20 - CO#18
26	2025.09.08	ISSUED FOR PCN#31
27	2025.09.09	ISSUED FOR PCN#32 - CO#22
28	2025.09.10	ISSUED FOR PCN#33
29	2025.09.11	ISSUED FOR SH#22
30	2025.09.15	ISSUED FOR SH#23
31	2025.09.16	ISSUED FOR PCN F35 - CO#33
32	2025.09.30	ISSUED FOR PCN F37 - CO#37
33	2025.09.30	ISSUED FOR PCN F38 - CO#35
34	2025.10.04	ISSUED FOR PCN F39 - CO#34
35	2025.10.20	ISSUED FOR PCN F40#1
36	2025.10.30	ISSUED FOR PCN#41
37	2025.10.23	ISSUED FOR PCN F42
38	2025.11.21	ISSUED FOR PCN#21/R1 - CO12 CO#38
39	2025.11.14	ISSUED FOR PCN#43
40	2025.11.26	ISSUED FOR PCN#43#1
41	2025.12.03	ISSUED FOR PCN#44 - CO#26
42	2026.02.04	ISSUED FOR RECORD SET UP TO CO#27

NOTES:

KEY PLAN:

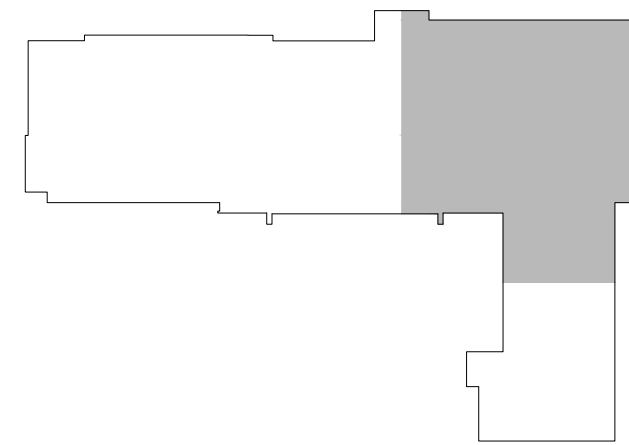

CLIENT:

NEAR NORTH DISTRICT SCHOOL BOARD
NNDSD Tender # 2023-015


PROJECT:

NEW PARRY SOUND K-12 SCHOOL & CHILDCARE
PARRY SOUND HIGH SCHOOL SITE

111 ISABELLA STREET
PARRY SOUND, ONTARIO

ORIGINAL PAGE SIZE ARCH E1 - 30" x 42"
KEY TO DETAIL LOCATION:
A - DETAIL NO.
B - DETAIL NO. ORIGIN

ARCHITECTS
THE VENTIN GROUP LTD

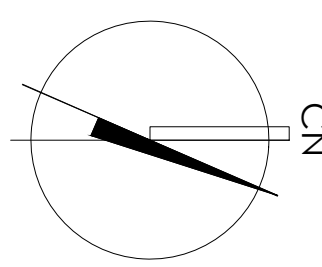

A2.3.2

ROOF PLAN - NORTH WING


Plot Date: Feb 03, 2026 - 5:10pm By: Kelly

DRAWN BY: EB/KH

CHECKED BY: PS

All dimensions and measurements must be checked and verified by the Senior Consultant.

Filename: K:\TVG-Branford\Near North DSS Parry Sound School\22111\Drawings\W4-Current\NIN-A2.3.dwg

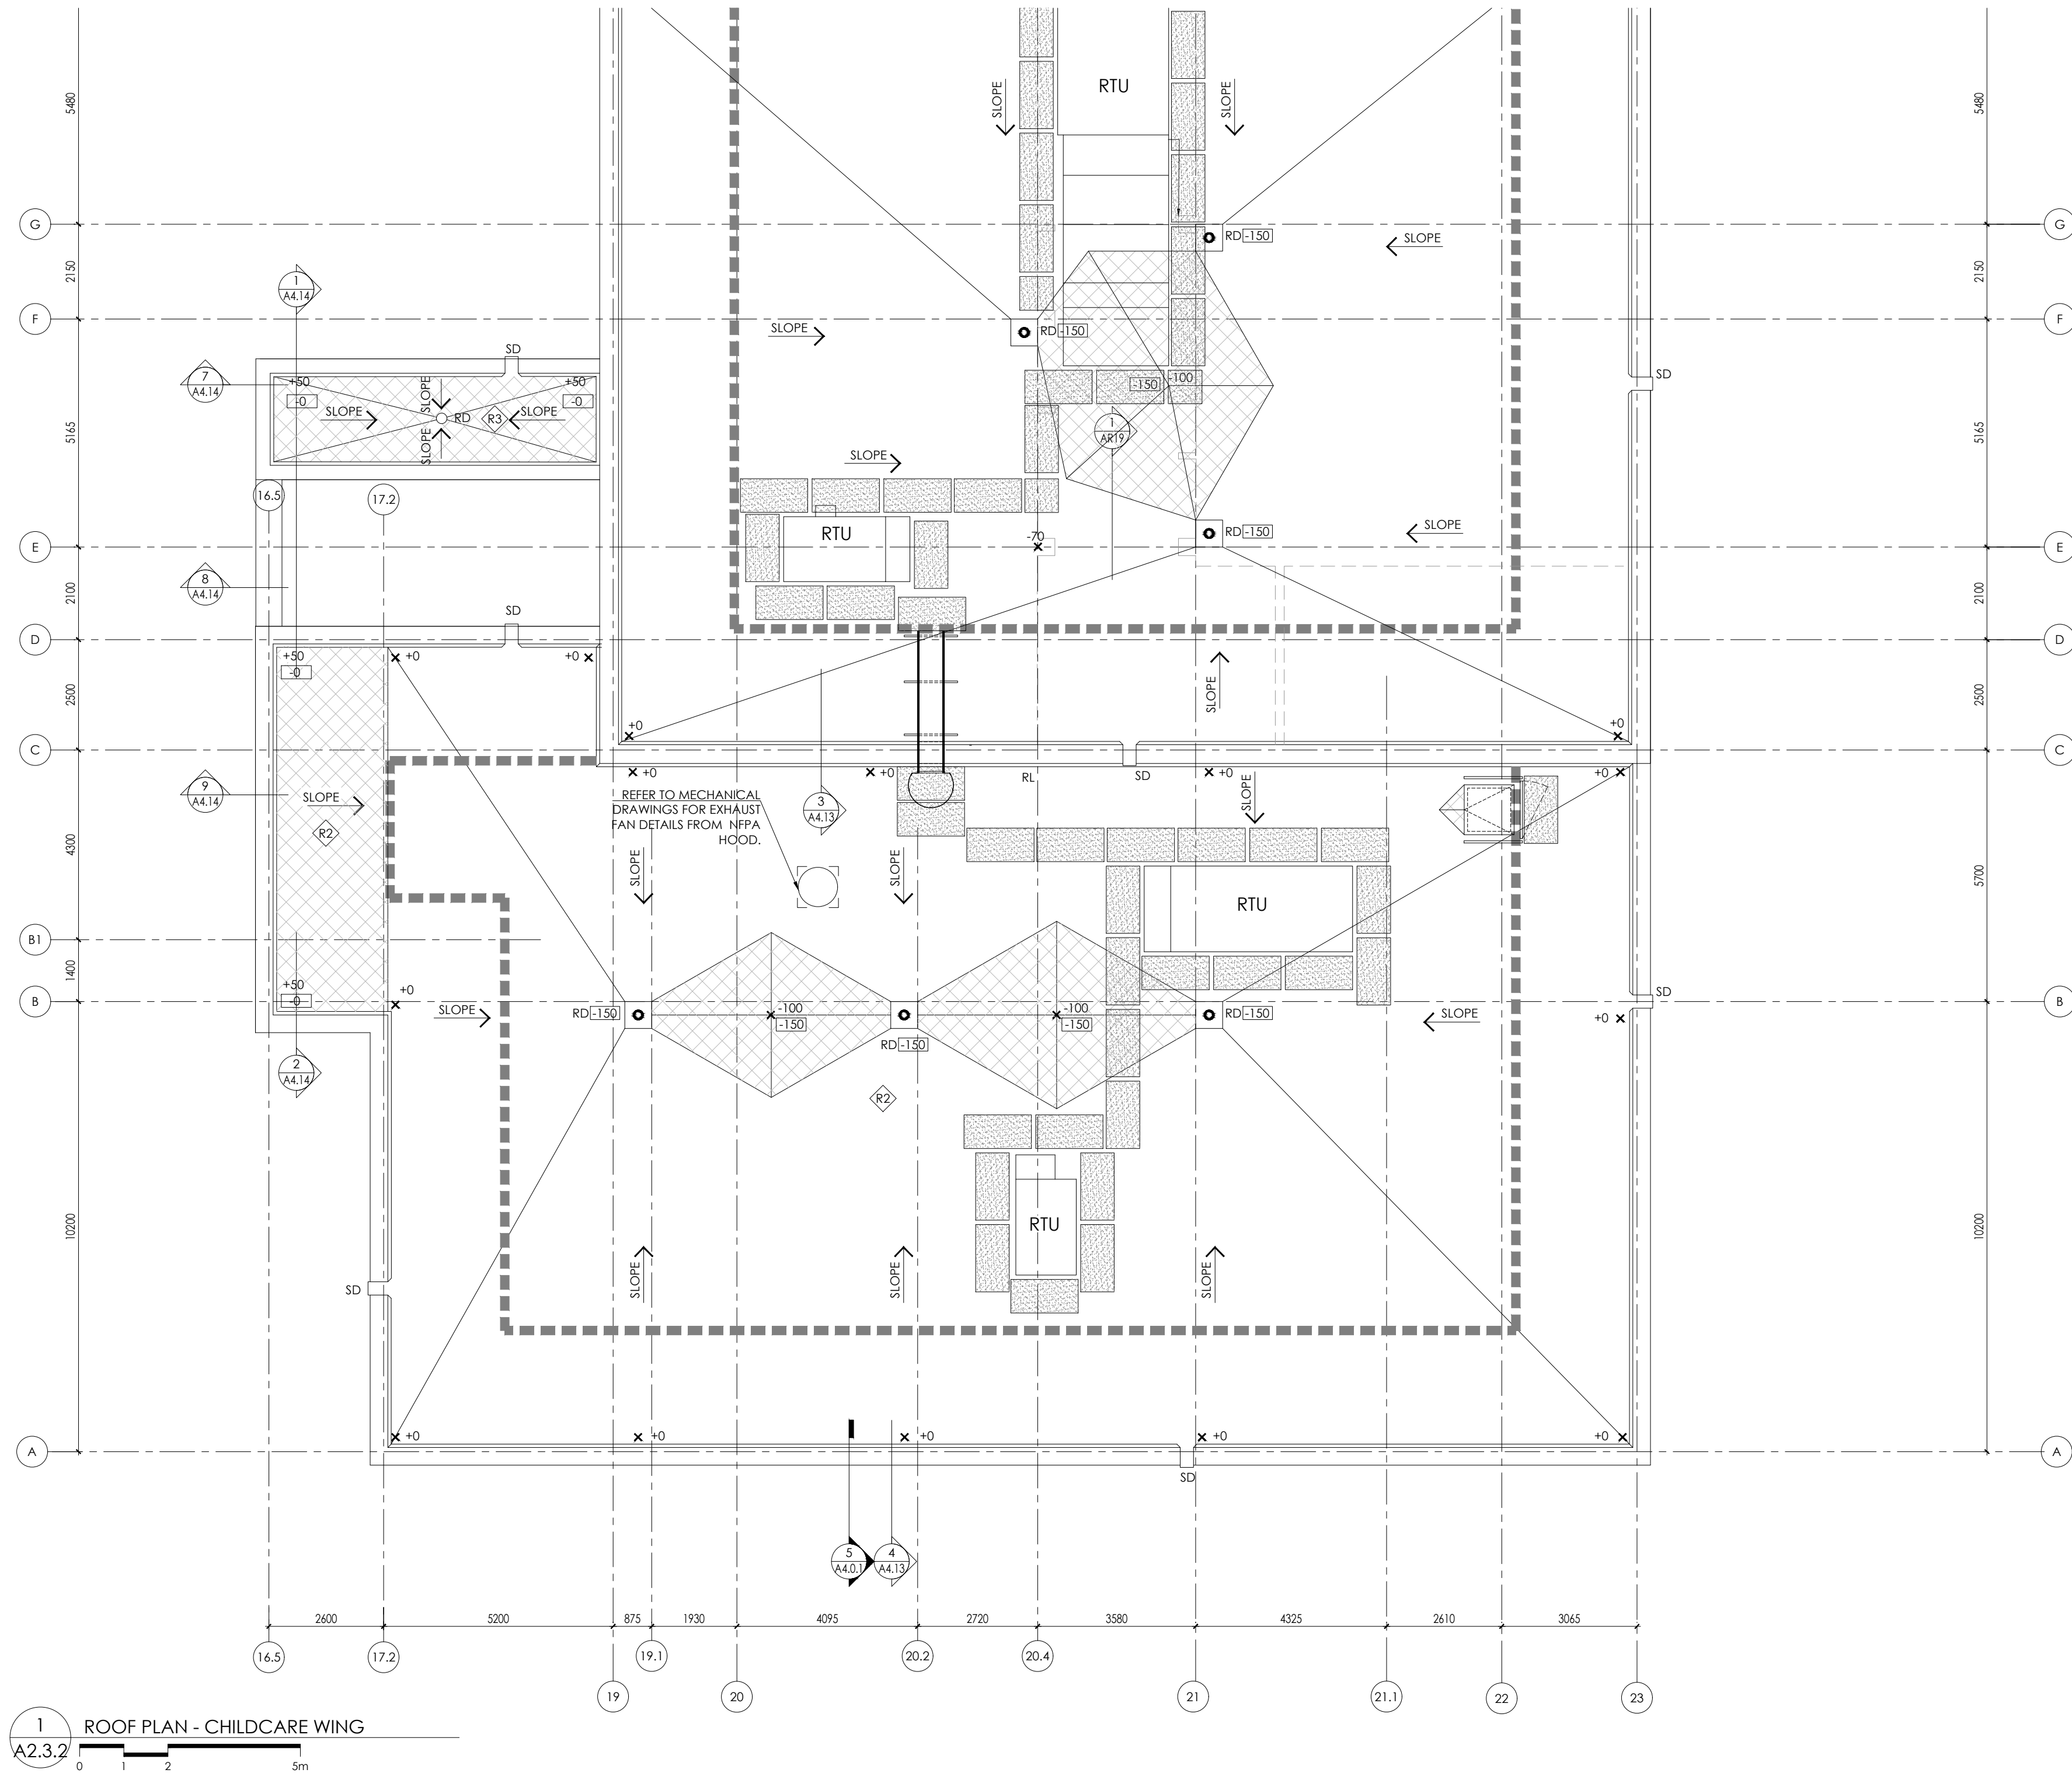

NOTES:
REFER TO MECHANICAL DRAWINGS FOR PLACEMENT
OF MECHANICAL ROOF TOP EQUIPMENT

* THE BUILDING OWNER / OPERATOR SHALL RESPONSIBLE FOR PREPARING, IMPLEMENTING, TRAINING AND ENFORCING PROCEDURAL SAFETY RULES / POLICIES FOR AUTHORIZED ACCESS OF THE ROOF AREA FOR SERVICING INCLUDING BUT NOT LIMITED TO THE USE OF ROOF ACCESS HATCHES, ROOF ACCESS LADDERS, TRAVEL RESTRAINT SYSTEM, FALL PROTECTION SYSTEM AND MINIMUM DISTANCE SEPARATION FOR SERVICE PERSONNEL FROM ROOF PERIMETERS WITHOUT THE USE OF FALL PROTECTION BASED ON THE MOST RECENT ONTARIO HEALTH AND SAFETY ACT (OHSIA) REQUIREMENTS. THE BUILDING OWNER / OPERATOR SHALL UPDATE THE SAFETY RULES / POLICIES TO SUIT ANY FUTURE LEGISLATED CHANGES TO THE OHSIA.

REVISIONS		
NO.	DATE	PARTICULAR
1	2022.04.06	ISSUED FOR 805 CLASS B COSTING
2	2022.06.18	ISSUED FOR SPA
3	2022.09.22	ISSUED FOR OWNERS REVIEW - RES SET
4	2022.12.16	ISSUED FOR 2nd SPA SUBMISSION
5	2023.01.31	ISSUED FOR TENDER
6	2023.02.22	ISSUED FOR ADDENDUM 9
7	2023.08.23	ISSUED FOR CONVENIENCE
8	2023.11.20	ISSUED FOR PERMIT COMMENTS
9	2024.01.24	ISSUED FOR SH#3
10	2024.02.15	ISSUED FOR PCH#38
11	2024.03.04	ISSUED FOR PCH#39
12	2024.03.10	ISSUED FOR SH#04
13	2024.05.14	ISSUED FOR SH#04
14	2024.07.22	ISSUED FOR SH#08
15	2024.08.07	ISSUED FOR SH#09
16	2024.10.02	ISSUED FOR PCH#15
17	2025.04.11	ISSUED FOR PCH#19
18	2025.05.01	ISSUED FOR CO#07
19	2025.05.28	ISSUED FOR PCH#20 - CO#10
20	2025.07.31	ISSUED FOR SH#13
21	2025.08.06	ISSUED FOR SH#14
22	2025.08.15	ISSUED FOR PCH#25 - CO#17
23	2025.08.25	ISSUED FOR PCH#27 - CO#21
24	2025.09.02	ISSUED FOR PCH#29
25	2025.09.02	ISSUED FOR SH#20 - CO#18
26	2025.09.08	ISSUED FOR PCH#31
27	2025.09.09	ISSUED FOR PCH#32 - CO#22
28	2025.09.10	ISSUED FOR PCH#33
29	2025.09.11	ISSUED FOR SH#22
30	2025.09.15	ISSUED FOR SH#23
31	2025.09.16	ISSUED FOR PCH #35 - CO#23
32	2025.09.30	ISSUED FOR PCH #37 - CO#24
33	2025.09.30	ISSUED FOR PCH #38 - CO#25
34	2025.10.04	ISSUED FOR PCH #39 - CO#26
35	2025.10.20	ISSUED FOR PCH #40#1
36	2025.10.30	ISSUED FOR PCH#41
37	2025.10.23	ISSUED FOR PCH #42
38	2025.11.21	ISSUED FOR PCH#21#1 - CO12 CO#28
39	2025.11.14	ISSUED FOR PCH#43
40	2025.11.26	ISSUED FOR PCH#43#1
41	2025.12.03	ISSUED FOR PCH#44 - CO#26
42	2026.02.04	ISSUED FOR RECORD SET UP TO CO#27

NOTES:

KEY PLAN:



CLIENT:

NEAR NORTH DISTRICT SCHOOL BOARD
NNDsB Tender # 2023-015

PROJECT:

NEW PARRY SOUND K-12 SCHOOL & CHILDCARE

PARRY SOUND HIGH SCHOOL SITE


111 ISABELLA STREET
PARRY SOUND, ONTARIO

ORIGINAL PAGE SIZE ARCH E1 - 30" x 42"

KEY TO DETAIL LOCATION:

A - DETAIL NO.
B - DETAIL NO. ORIGIN

VG ARCHITECTS
THE VENTIN GROUP LTD

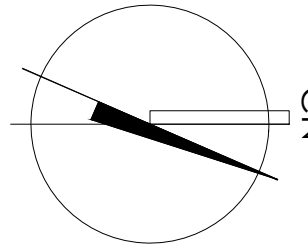

A2.3.3


ROOF PLAN - CHILDCARE WING

Plot Date: Feb 03, 2026 - 5:10pm By: Jkelly

Filename: K:\TVG\Brantford\Near North DSS\Parry Sound\School\22111\Drawings\Wd\Current\NIN-A2.3.dwg


DRAWN BY: EB/KH

CHECKED BY: PS

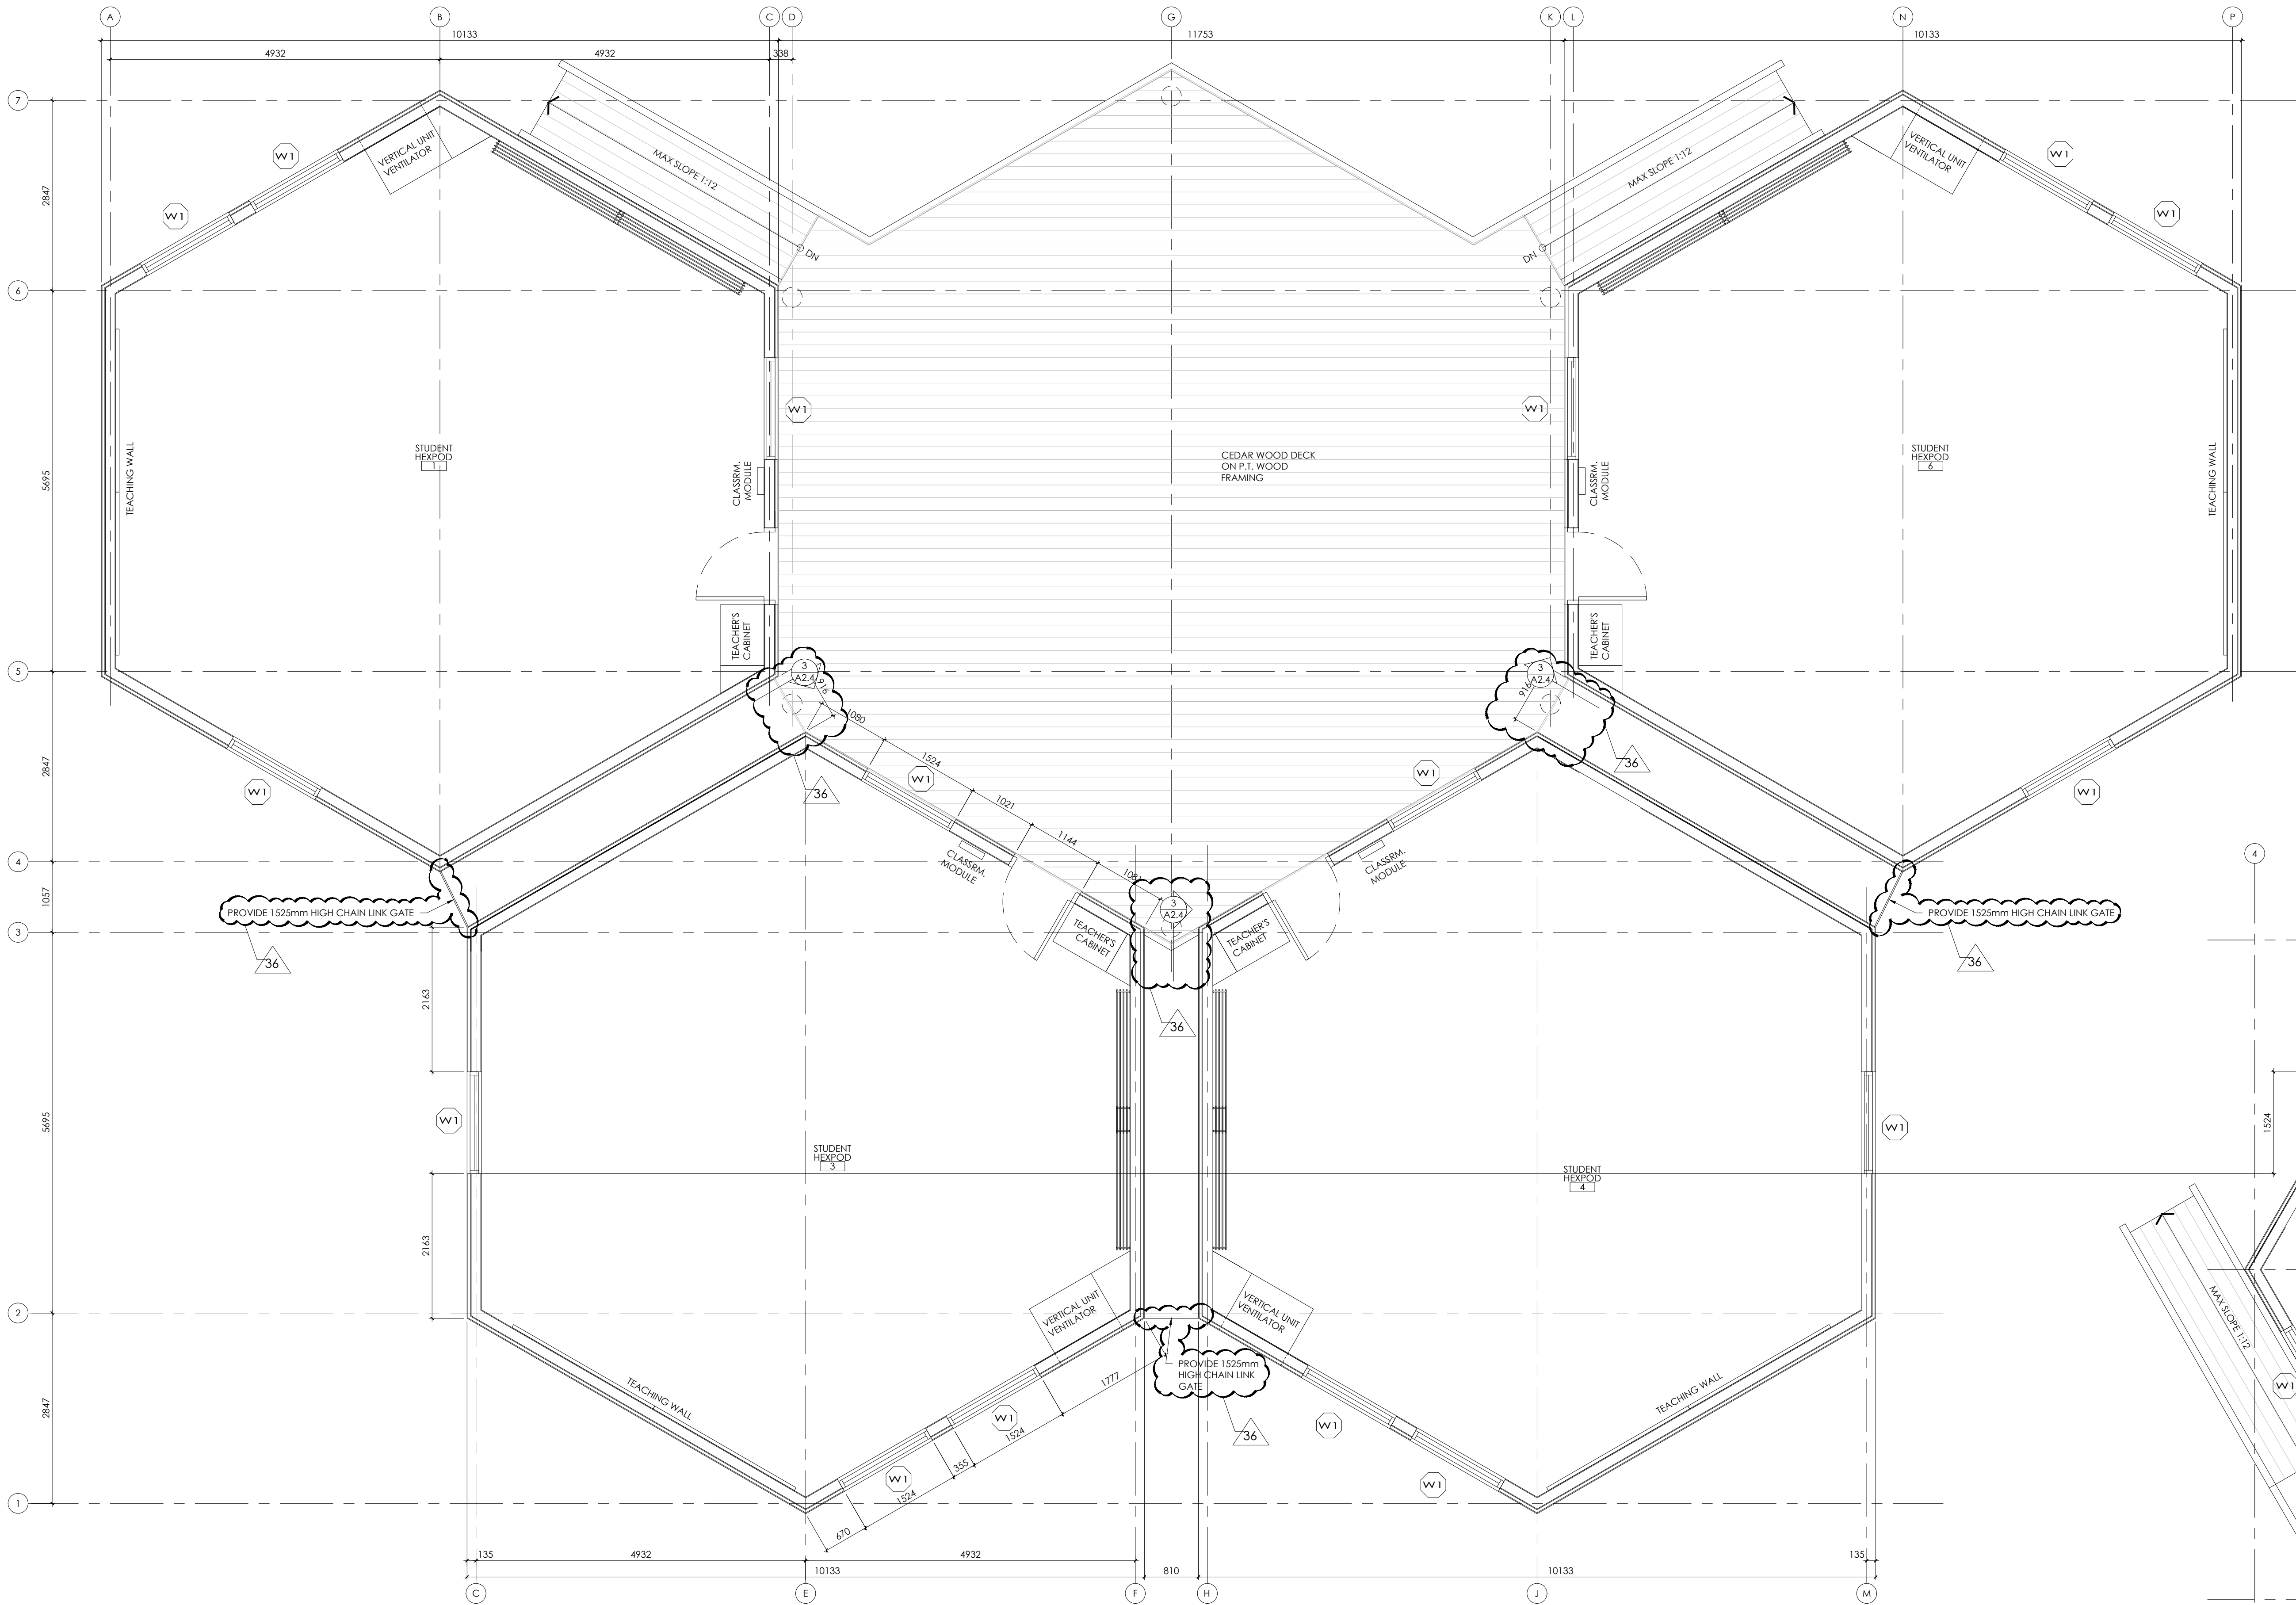


1 FLOOR PLAN - QUAD POD
A2.4
0 500 1000 2000mm

HEXPOD PORTABLE CLASSROOM DRAWINGS ARE SHOWN HERE FOR REFERENCE ONLY. PORTABLE CLASSROOMS & FOUNDATIONS, WOOD DECKS & RAMPS TO BE PROVIDED EBS AND PAID FOR OUT OF THE CASH ALLOWANCE.

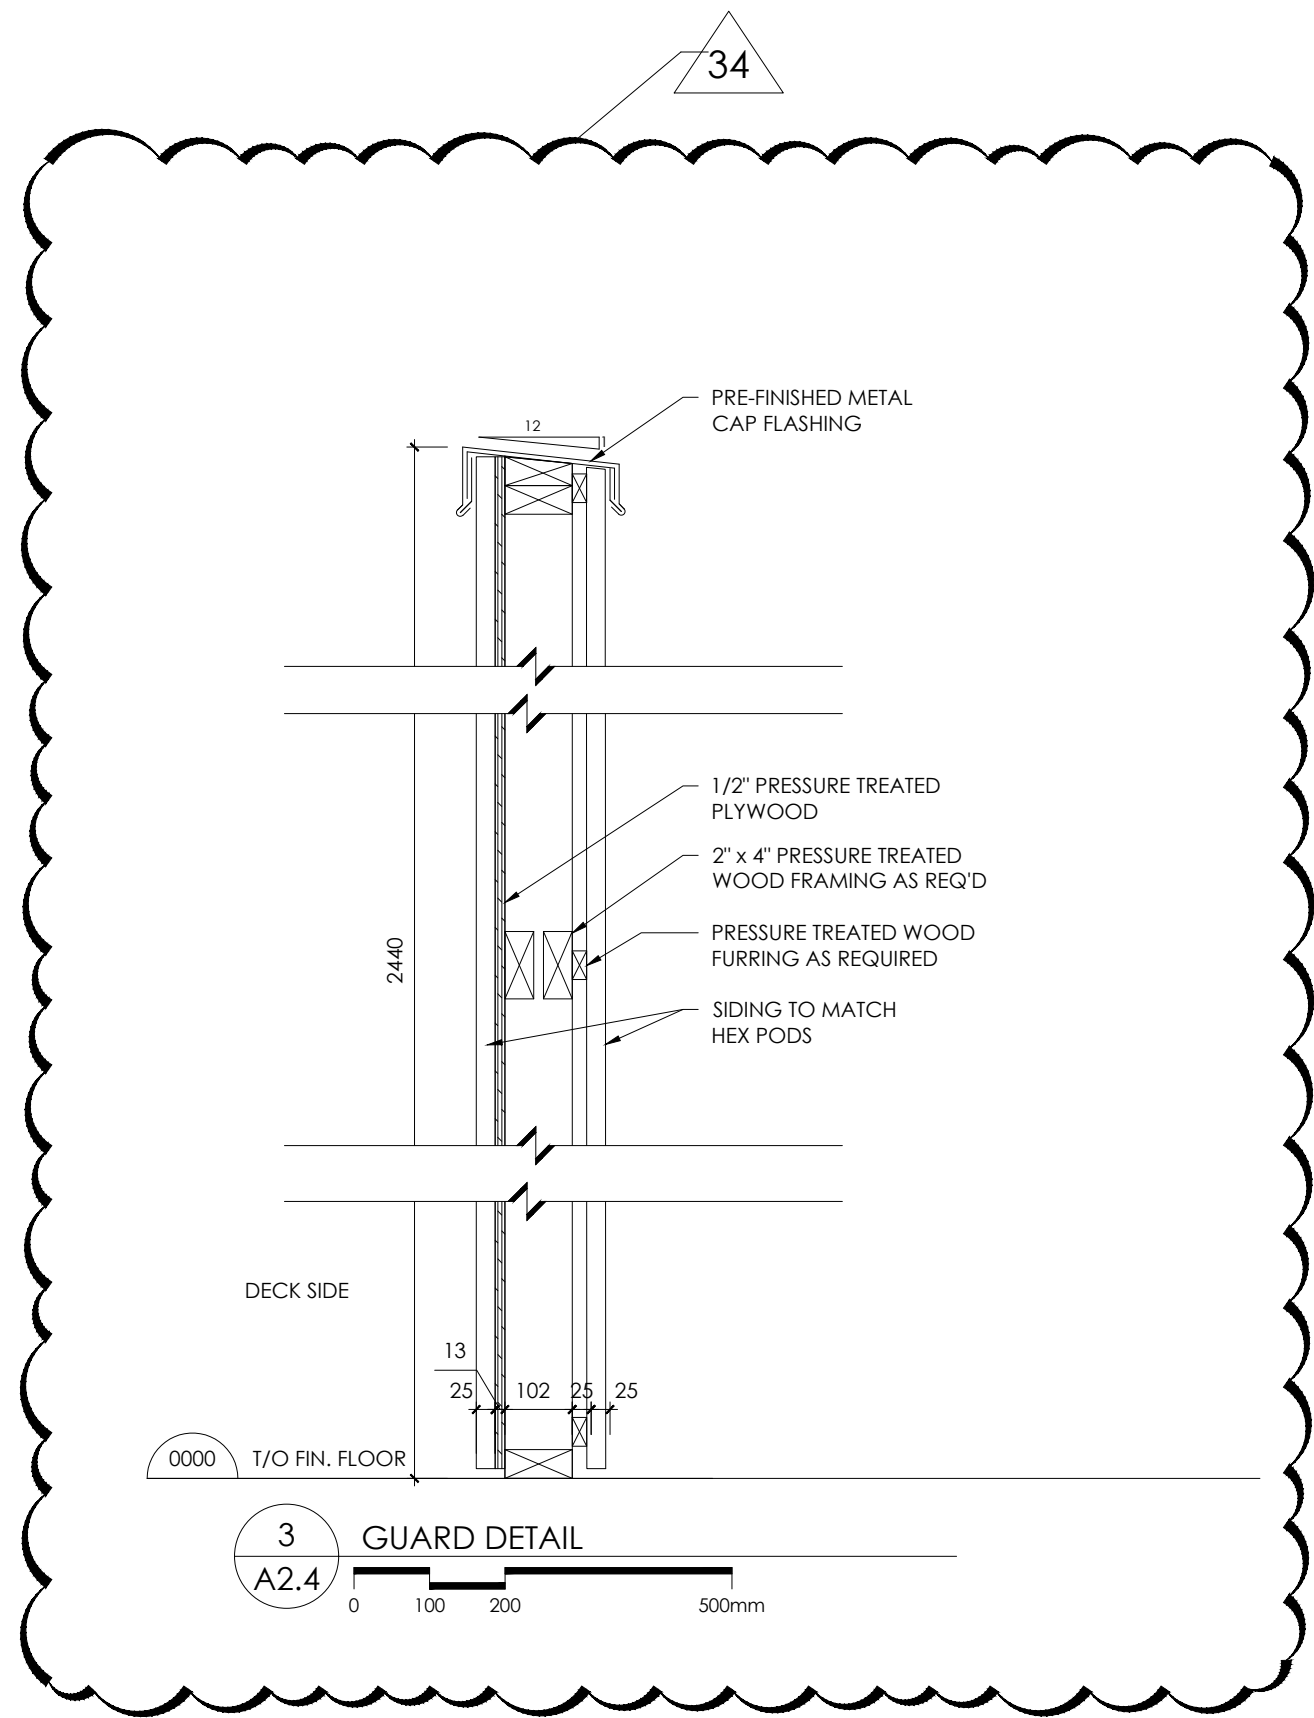

3 GUARD DETAIL
A2.4
0 100 200 500mm

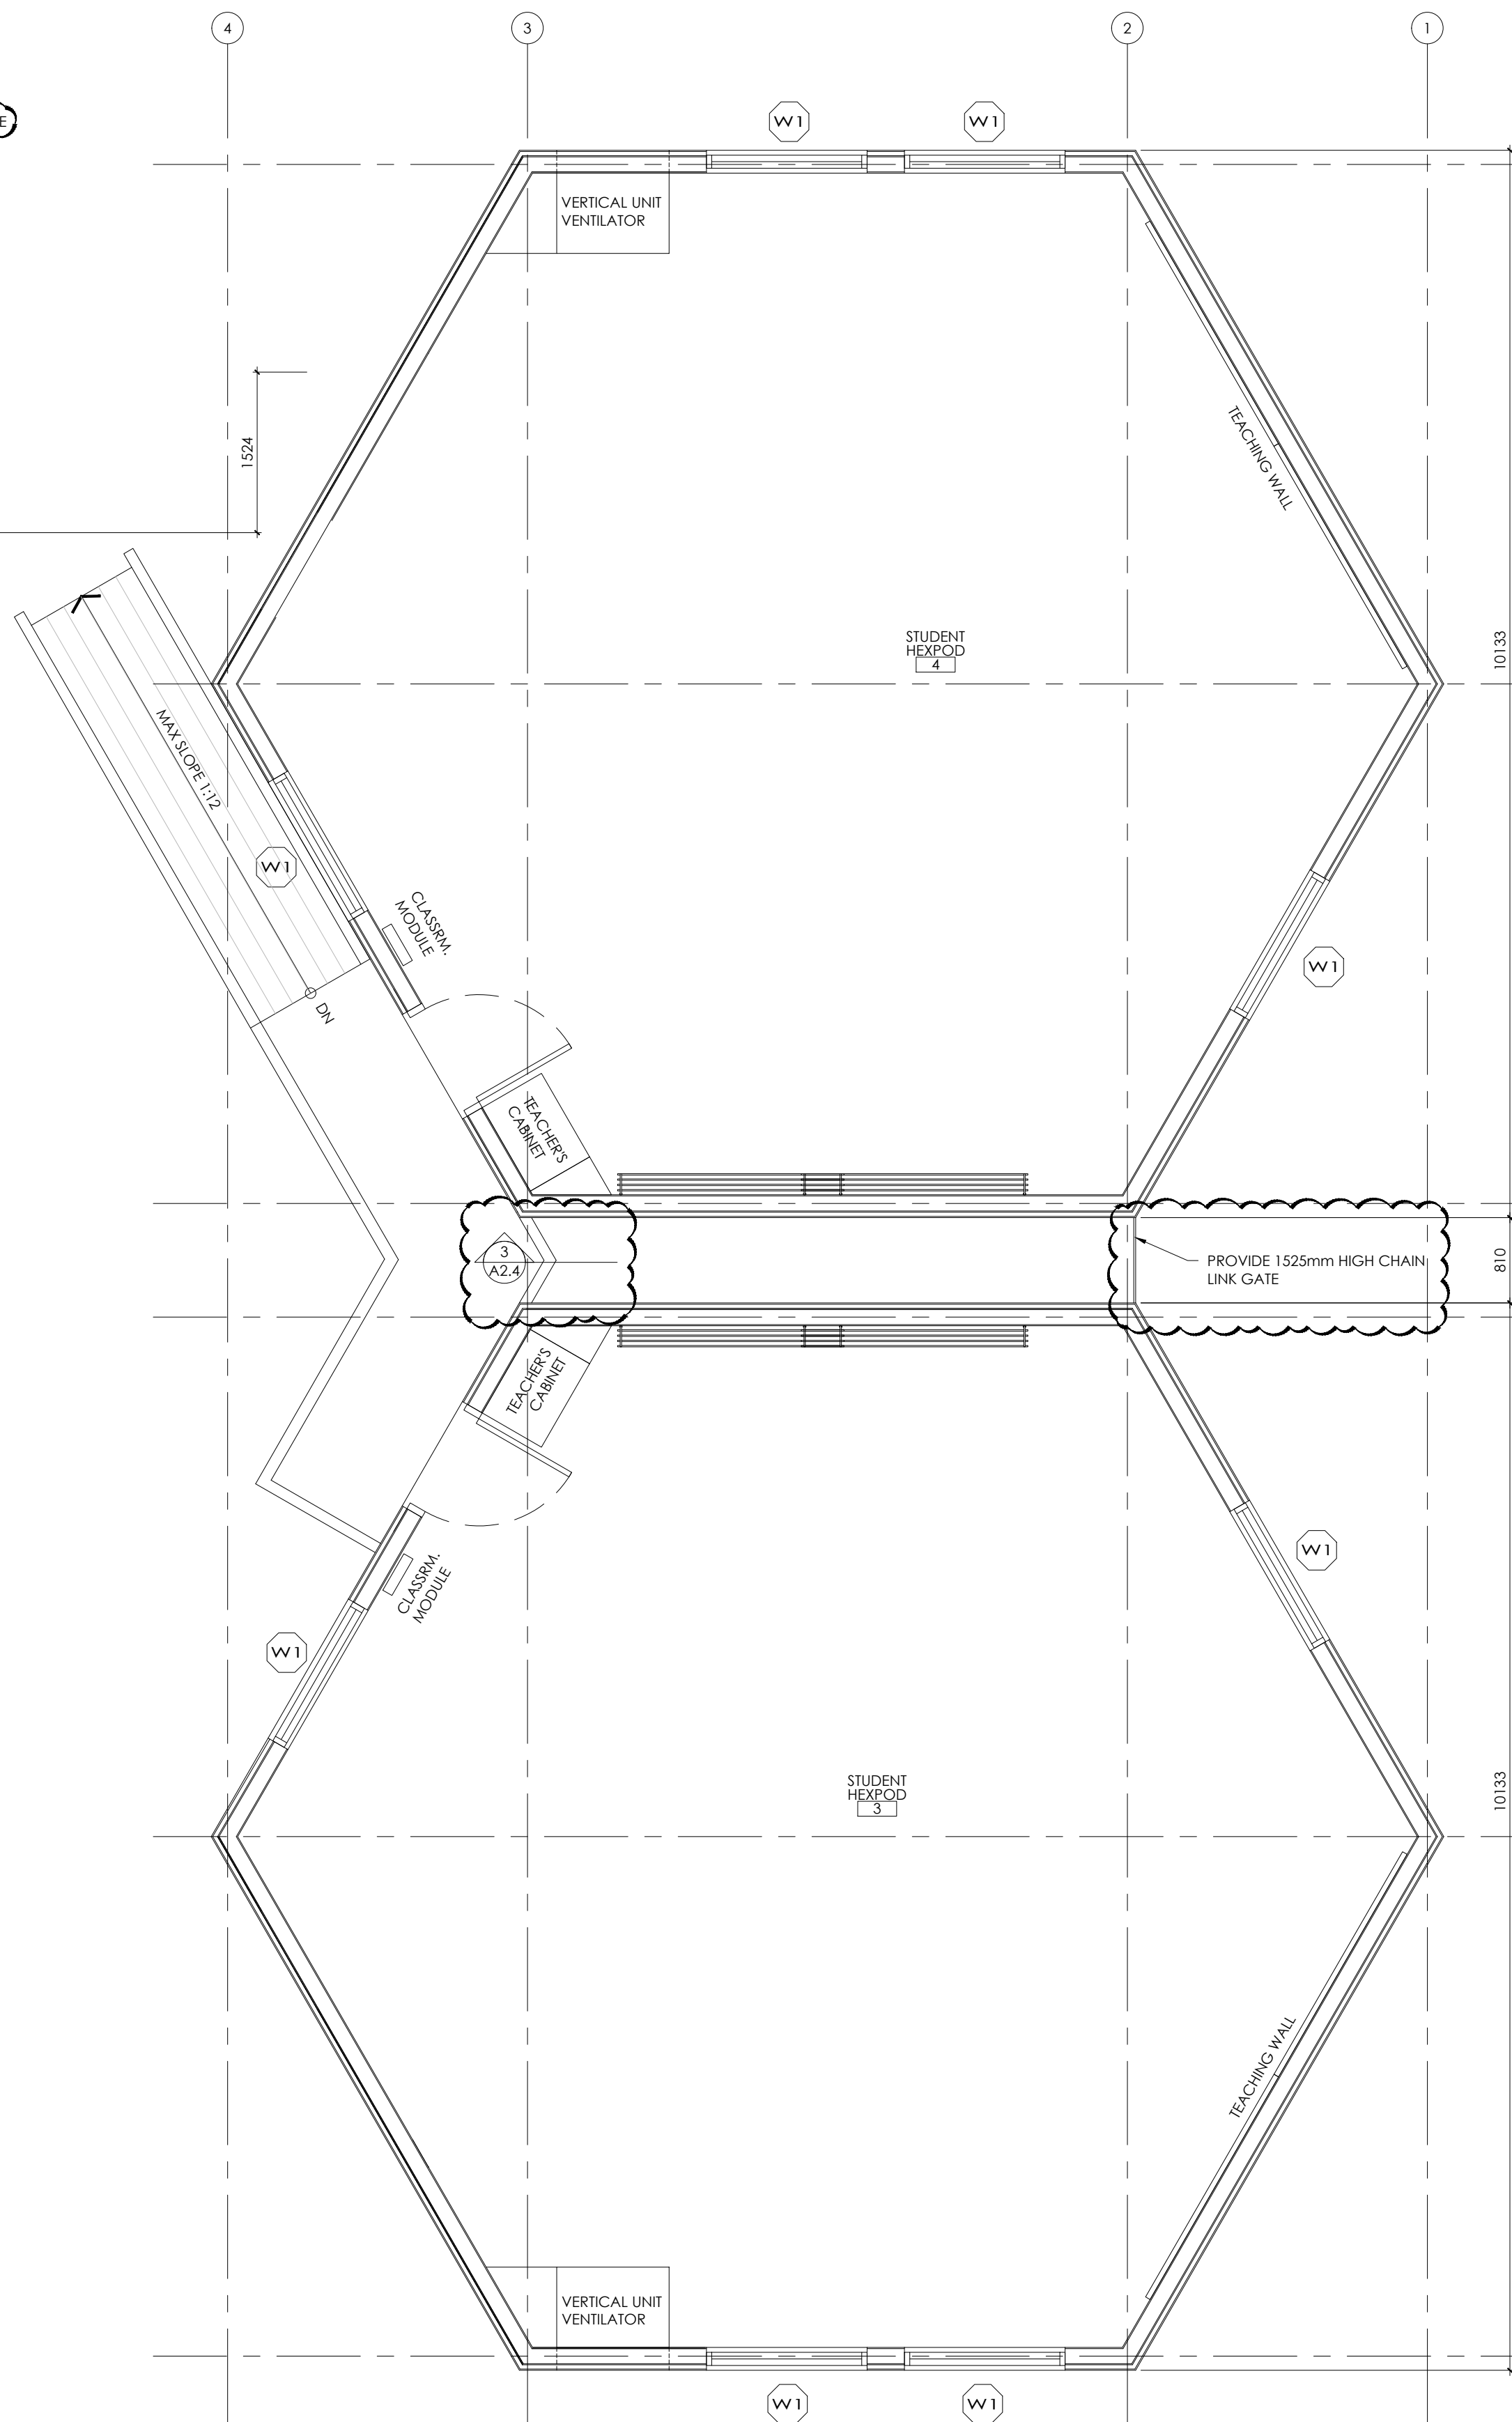

2 FLOOR PLAN - DUO POD
A2.4
0 500 1000 2000mm

REVISIONS		
NO.	DATE	PARTICULAR
1	2022.04.06	ISSUED FOR 805 CLASS B COSTING
2	2022.06.18	ISSUED FOR SPA
3	2022.09.22	ISSUED FOR OWNERS REVIEW - RES SET
4	2022.12.16	ISSUED FOR 2nd SPA SUBMISSION
5	2023.01.31	ISSUED FOR TENDER
6	2023.02.22	ISSUED FOR ADDENDUM 9
7	2023.08.23	ISSUED FOR CONVENIENCE
8	2023.11.20	ISSUED FOR PERMIT COMMENTS
9	2024.07.24	ISSUED FOR PORTABLE PERMIT
10	2024.09.23	ISSUED FOR PCN#84
11	2024.03.04	ISSUED FOR PCN#99
12	2024.03.10	ISSUED FOR SH#04
13	2024.05.14	ISSUED FOR SH#04
14	2024.02.29	ISSUED FOR PCN#404R1
15	2024.08.07	ISSUED FOR SH#09
16	2024.10.02	ISSUED FOR PCN#15
17	2025.04.11	ISSUED FOR PCN#15
18	2025.05.01	ISSUED FOR CO#07
19	2025.05.28	ISSUED FOR PCN#20 - CO#010
20	2025.07.31	ISSUED FOR SH#03
21	2025.08.06	ISSUED FOR SH#04
22	2025.08.15	ISSUED FOR PCN#25 - CO#013
23	2025.08.25	ISSUED FOR PCN#27 - CO#021
24	2025.09.02	ISSUED FOR PCN#29
25	2025.09.02	ISSUED FOR SH#0 - CO#018
26	2025.09.08	ISSUED FOR PCN#31
27	2025.09.09	ISSUED FOR PCN#32 - CO#022
28	2025.09.10	ISSUED FOR PCN#33
29	2025.09.11	ISSUED FOR SH#02
30	2025.09.15	ISSUED FOR SH#02
31	2025.09.16	ISSUED FOR PCN F33 - CO#023
32	2025.09.30	ISSUED FOR PCN#37 - CO#019
33	2025.09.30	ISSUED FOR PCN#38 - CO#025
34	2025.10.04	ISSUED FOR PCN#39 - CO#024
35	2025.10.20	ISSUED FOR PCN#40R1
36	2025.10.30	ISSUED FOR PCN#40R1
37	2025.10.23	ISSUED FOR PCN#42
38	2025.11.21	ISSUED FOR PCN#021R1 - CO12 CO#09
39	2025.11.14	ISSUED FOR PCN#043
40	2025.11.26	ISSUED FOR PCN#04R1
41	2025.12.03	ISSUED FOR PCN#044 - CO#026
42	2026.02.04	ISSUED FOR RECORD SET UP TO CO#07

NOTES:

KEY PLAN:




CLIENT:
NEAR NORTH DISTRICT SCHOOL BOARD
NND58 Tender # 2023-015

PROJECT:
NEW PARRY SOUND K-12 SCHOOL & CHILDCARE
PARRY SOUND HIGH SCHOOL SITE
111 ISABELLA STREET
PARRY SOUND, ONTARIO

ORIGINAL PAGE SEE ARCH E1 - 30' x 42'
KEY TO DETAIL LOCATION:
A - DETAIL NO.
B - DETAIL NO. ORIGIN

VG ARCHITECTS
THE VENTIN GROUP LTD

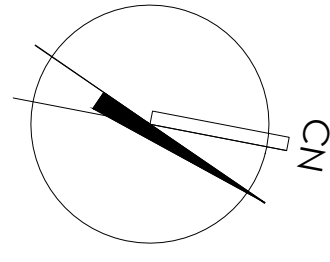


A2.4

DRAWN BY : SR

CHECKED BY : EB


HEX PODS - FLOOR PLAN (CASH ALLOWANCE)

Reproduction of drawings and related documents in whole or in part is prohibited without written permission of the Ventin Group.

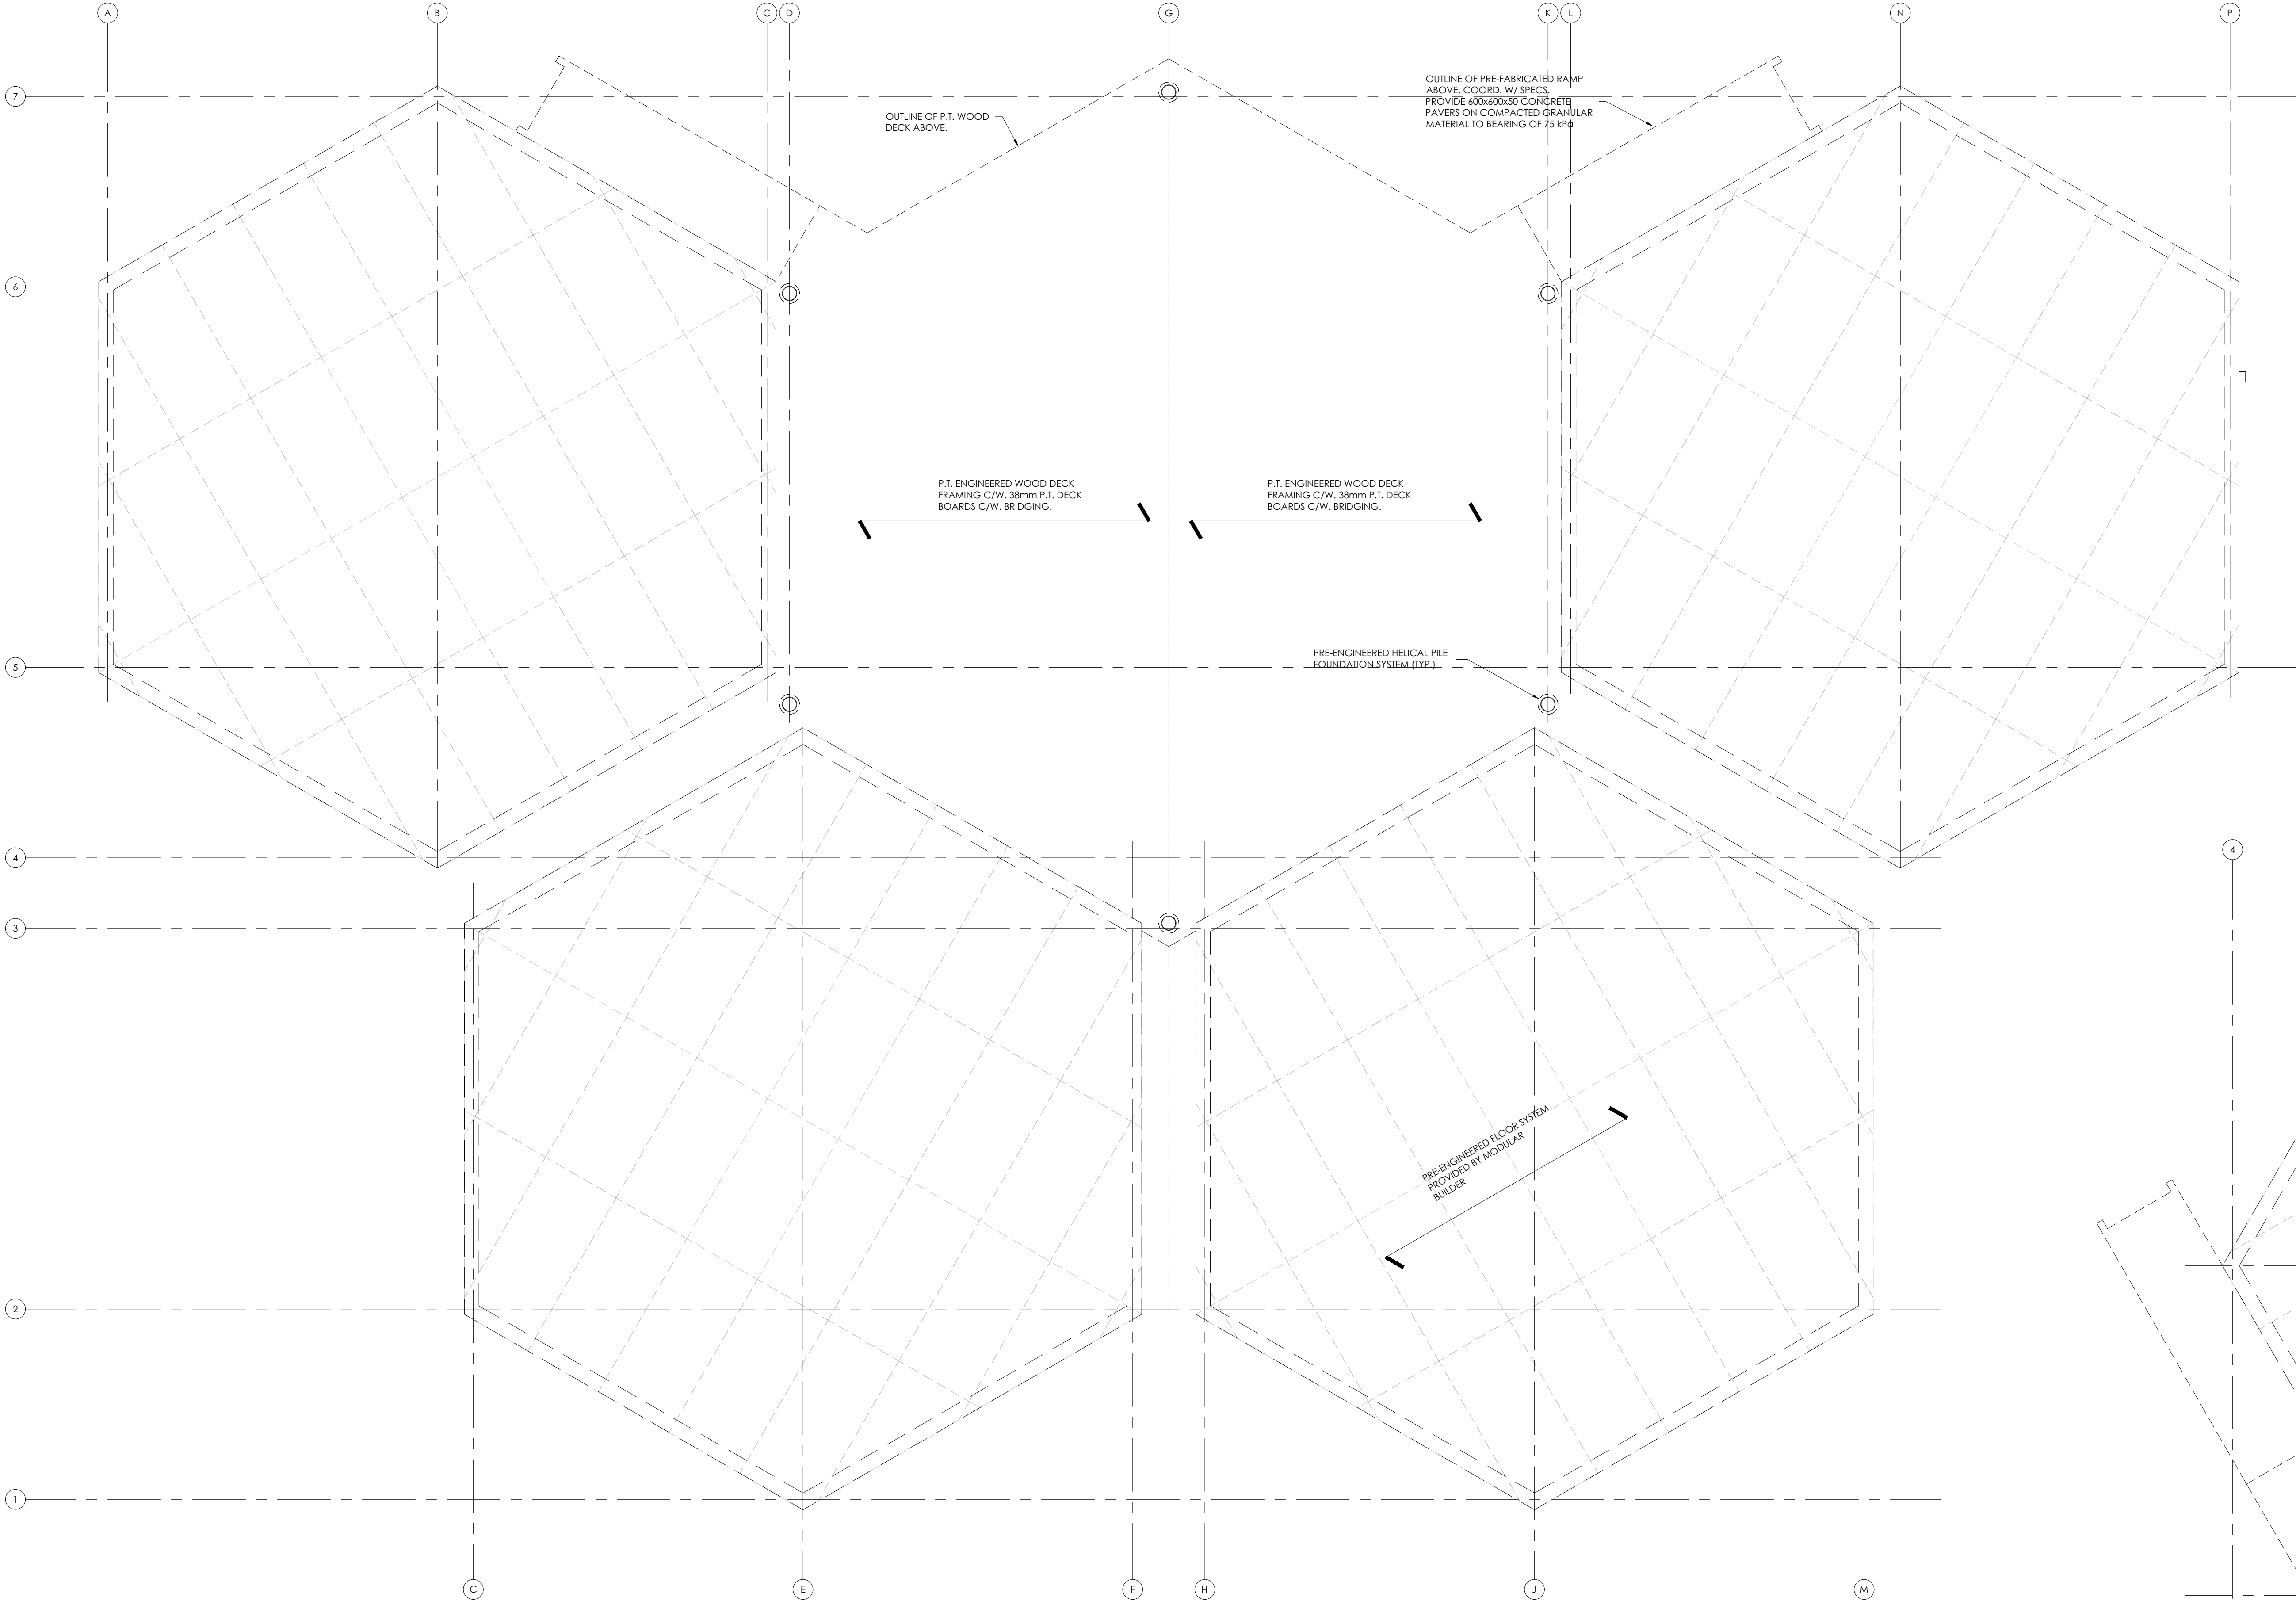

1 FOUNDATION FLOOR PLAN - QUAD POD
A2.5
0 500 1000 2500mm

HEXPOD PORTABLE CLASSROOM DRAWINGS ARE SHOWN HERE FOR REFERENCE ONLY. PORTABLE CLASSROOMS & FOUNDATIONS, WOOD DECKS & RAMPS TO BE PROVIDED EBS AND PAID FOR OUT OF THE CASH ALLOWANCE.

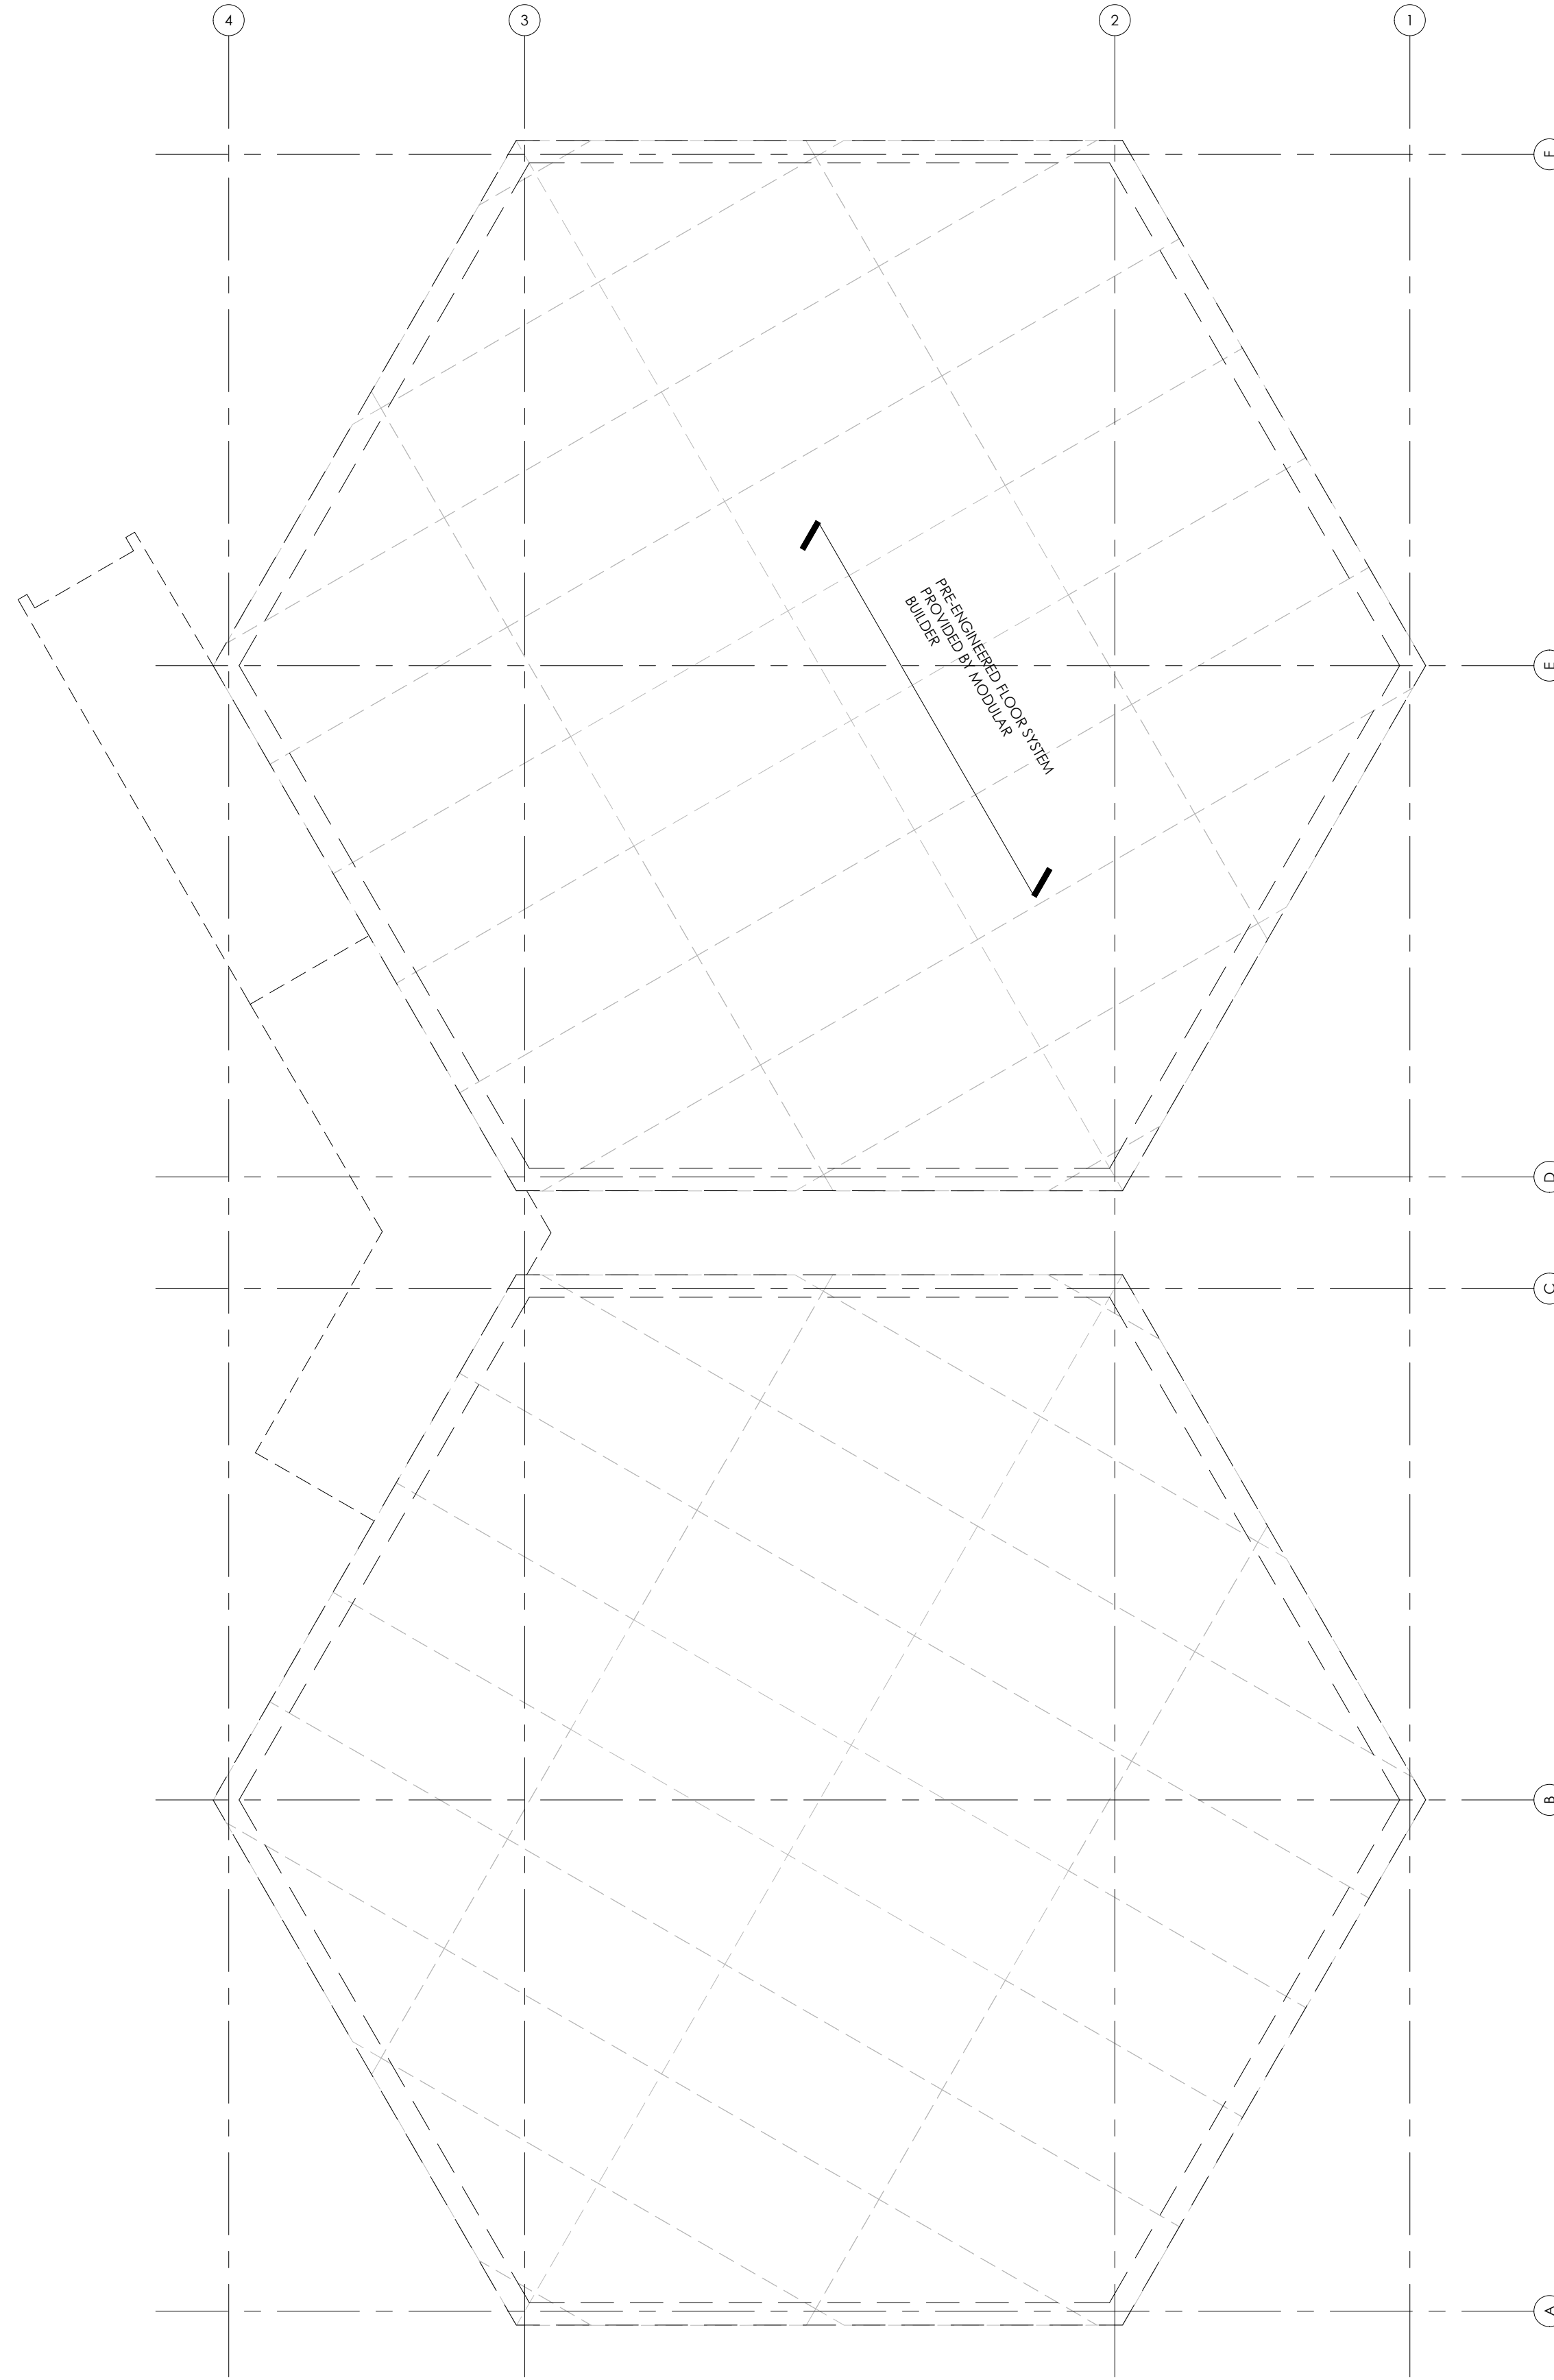

2 FOUNDATION FLOOR PLAN - DUO POD
A2.5
0 500 1000 2500mm

REVISIONS		
NO.	DATE	PARTICULAR
1	2022.04.06	ISSUED FOR 805 CLASS B COSTING
2	2022.06.18	ISSUED FOR SPA
3	2022.09.22	ISSUED FOR OWNERS REVIEW - RES SET
4	2022.12.16	ISSUED FOR 2nd SPA SUBMISSION
5	2023.01.31	ISSUED FOR TENDER
6	2023.02.22	ISSUED FOR ADDENDUM 9
7	2023.08.23	ISSUED FOR CONVENIENCE
8	2023.11.20	ISSUED FOR PERMIT COMMENTS
9	2024.07.24	ISSUED FOR PORTABLE PERMIT
10	2024.02.15	ISSUED FOR PCH#08
11	2024.03.04	ISSUED FOR PCH#09
12	2024.03.10	ISSUED FOR SH#04
13	2024.05.14	ISSUED FOR SH#06
14	2024.07.22	ISSUED FOR SH#08
15	2024.08.07	ISSUED FOR SH#09
16	2024.10.02	ISSUED FOR PCH#15
17	2025.04.11	ISSUED FOR PCH#19
18	2025.05.01	ISSUED FOR CO#07
19	2025.05.28	ISSUED FOR PCH#20 - CO#010
20	2025.07.31	ISSUED FOR SH#13
21	2025.08.06	ISSUED FOR SH#14
22	2025.08.15	ISSUED FOR PCH#25 - CO#017
23	2025.08.25	ISSUED FOR PCH#27 - CO#021
24	2025.09.02	ISSUED FOR PCH#29
25	2025.09.02	ISSUED FOR SH#20 - CO#018
26	2025.09.08	ISSUED FOR PCH#31
27	2025.09.09	ISSUED FOR PCH#32 - CO#022
28	2025.09.10	ISSUED FOR PCH#33
29	2025.09.11	ISSUED FOR SH#22
30	2025.09.15	ISSUED FOR SH#23
31	2025.09.16	ISSUED FOR PCH F33 - CO#023
32	2025.09.30	ISSUED FOR PCH F37 - CO#019
33	2025.09.30	ISSUED FOR PCH F38 - CO#025
34	2025.10.04	ISSUED FOR PCH F39 - CO#024
35	2025.10.20	ISSUED FOR PCH F40#1
36	2025.10.30	ISSUED FOR PCH#41
37	2025.10.23	ISSUED FOR PCH F42
38	2025.11.21	ISSUED FOR PCH#021#1 - CO12 CO#09
39	2025.11.14	ISSUED FOR PCH#043
40	2025.11.26	ISSUED FOR PCH#048#1
41	2025.12.03	ISSUED FOR PCH#044 - CO#026
42	2026.02.04	ISSUED FOR RECORD SET UP TO CO#027

NOTES:

KEY PLAN:




CLIENT:
NEAR NORTH DISTRICT SCHOOL BOARD
NND\$B Tender # 2023-015

PROJECT:
NEW PARRY SOUND K-12 SCHOOL & CHILDCARE
PARRY SOUND HIGH SCHOOL SITE
111 ISABELLA STREET
PARRY SOUND, ONTARIO

ORIGINAL PAGE SIZE ARCH E1 - 30" x 42"
KEY TO DETAIL LOCATION:
A - DETAIL NO.
B - DETAIL NO. ORIGIN

ARCHITECTS
THE VENTIN GROUP LTD

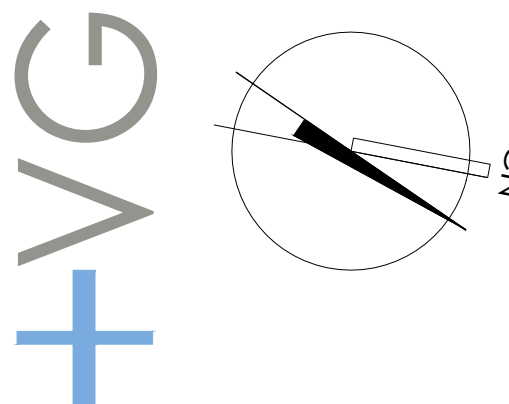

A2.5

DRAWN BY : SR


CHECKED BY : EB

Filename: K:\TVG\Brantford\Near North DSS\Parry Sound\School\22111\Drawings\WG\Current\NN-A2.4.2.6 & A4.3 Hex Pod Roof Plans.dwg
Plot Date: Feb 03, 2026 - 5:11pm By: Jkely

HEX PODS - FOUNDATION FLOOR PLAN (CASH ALLOWANCE)


Reproduction of drawings and related documents in whole or in part is prohibited without written permission of The Ventin Group.

All dimensions and measurements must be checked and verified by the Senior Consultant.

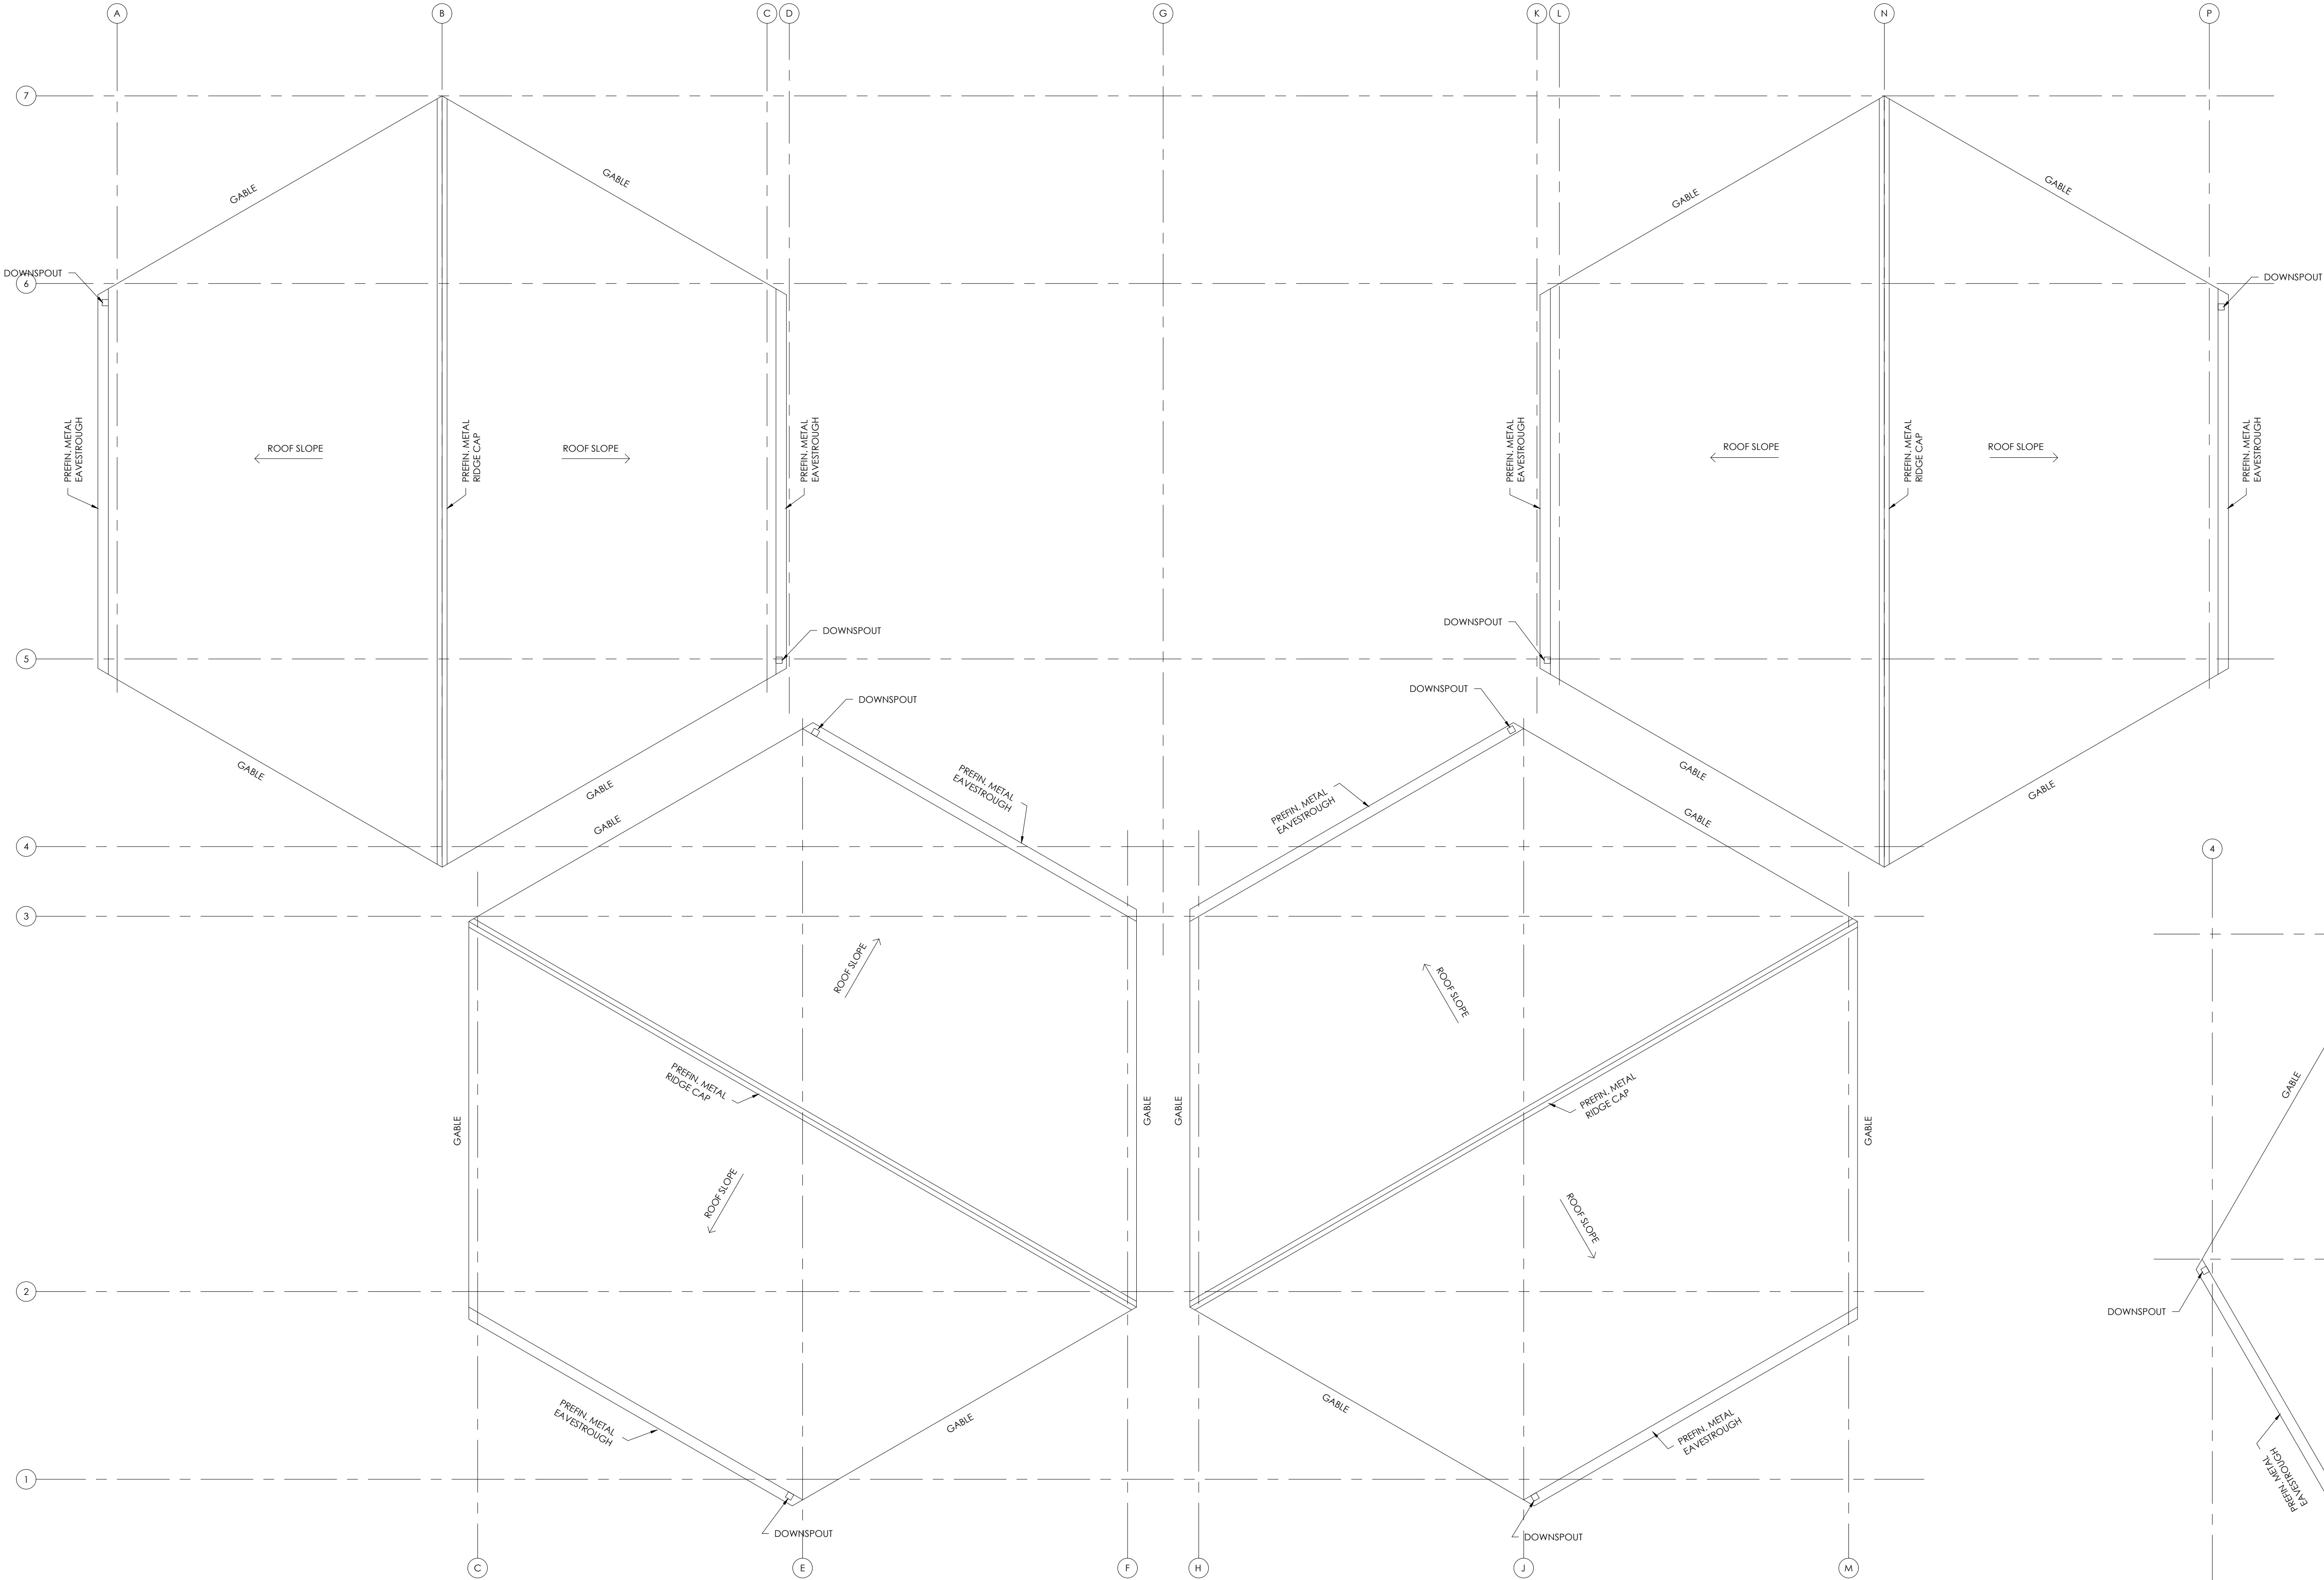

1 ROOF PLAN - QUAD POD
A2.6
0 500 1000 2500mm

HEXPOD PORTABLE CLASSROOM DRAWINGS ARE SHOWN HERE FOR REFERENCE ONLY. PORTABLE CLASSROOMS & FOUNDATIONS, WOOD DECKS & RAMPS TO BE PROVIDED EBS AND PAID FOR OUT OF THE CASH ALLOWANCE.

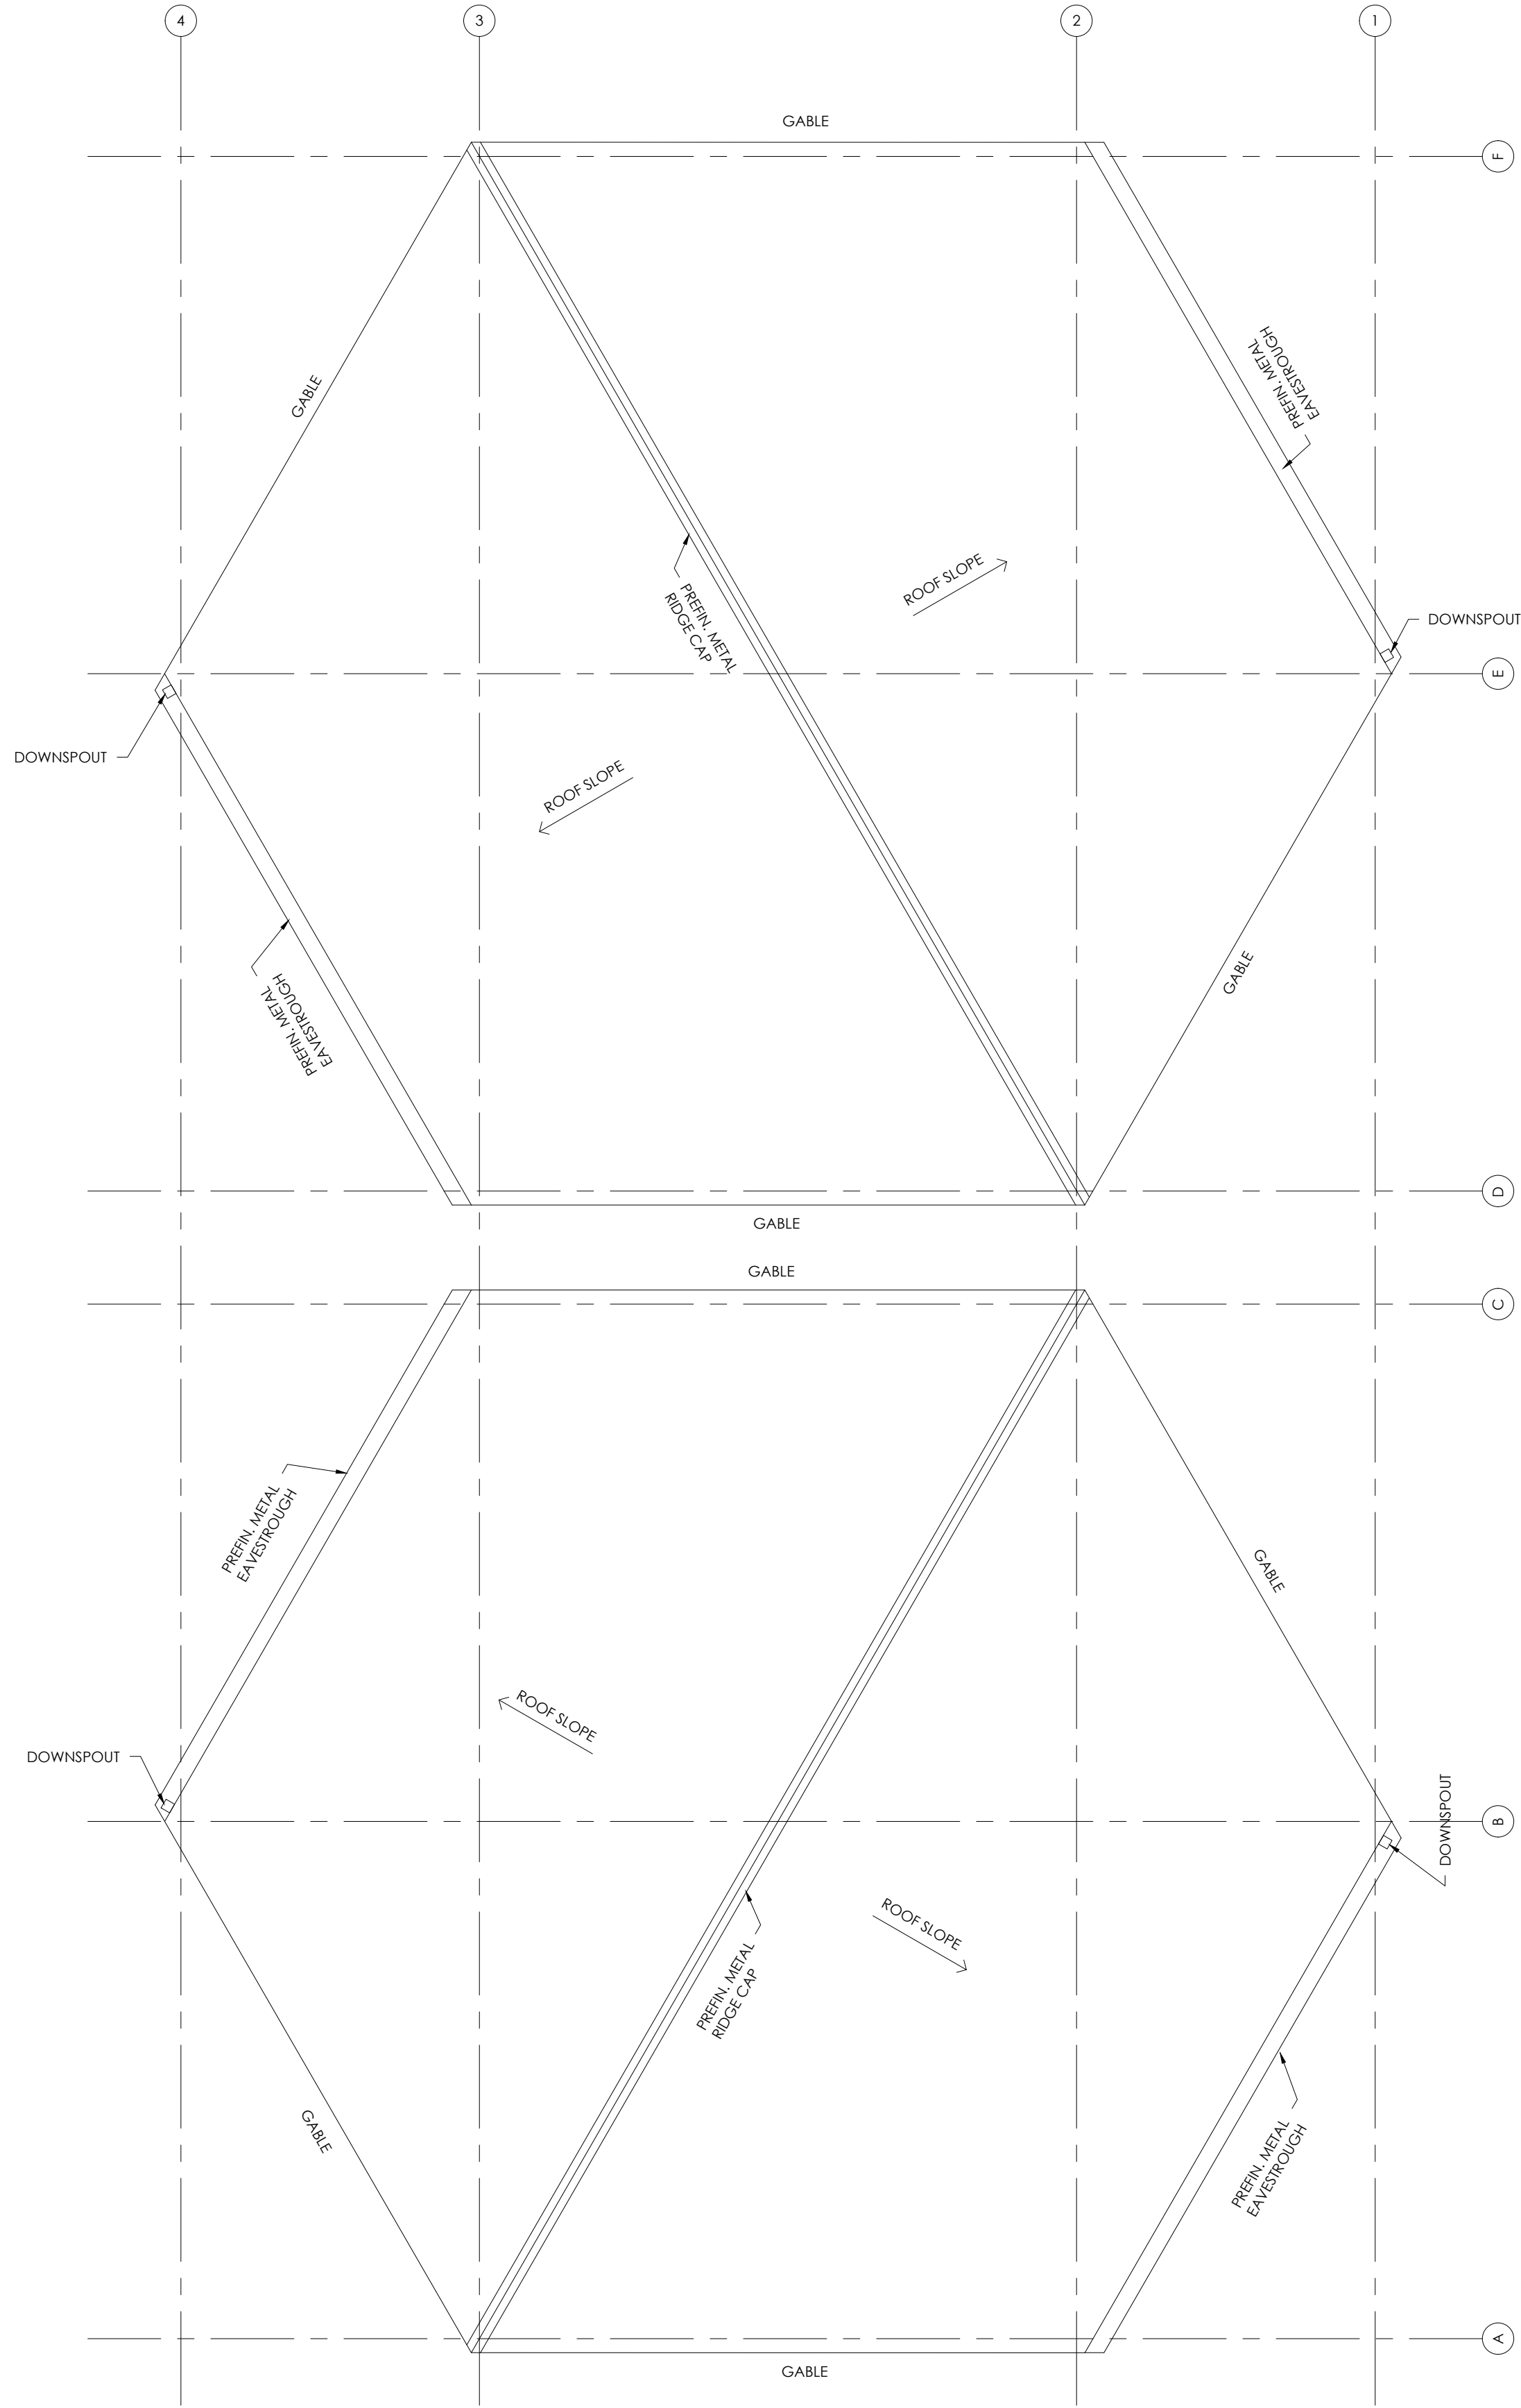

2 ROOF PLAN - DUO POD
A2.6
0 500 1000 2500mm

REVISIONS		
NO.	DATE	PARTICULAR
1	2022.04.06	ISSUED FOR 805 CLASS B COSTING
2	2022.06.18	ISSUED FOR SPA
3	2022.09.22	ISSUED FOR OWNERS REVIEW - RFS SET
4	2022.12.16	ISSUED FOR 2nd SPA SUBMISSION
5	2023.01.31	ISSUED FOR TENDER
6	2023.02.22	ISSUED FOR ADDENDUM 9
7	2023.08.23	ISSUED FOR CONVENIENCE
8	2023.11.20	ISSUED FOR PERMIT COMMENTS
9	2024.07.24	ISSUED FOR PORTABLE PERMIT
10	2024.02.15	ISSUED FOR PCH#38
11	2024.03.04	ISSUED FOR PCH#39
12	2024.03.10	ISSUED FOR SH#04
13	2024.05.14	ISSUED FOR SH#04
14	2024.07.22	ISSUED FOR SH#08
15	2024.08.07	ISSUED FOR SH#09
16	2024.10.02	ISSUED FOR PCH#15
17	2025.04.11	ISSUED FOR PCH#19
18	2025.05.01	ISSUED FOR CO#07
19	2025.05.28	ISSUED FOR PCH#20 - CO#10
20	2025.07.31	ISSUED FOR SH#13
21	2025.08.06	ISSUED FOR SH#14
22	2025.08.15	ISSUED FOR PCH#25 - CO#17
23	2025.08.25	ISSUED FOR PCH#27 - CO#21
24	2025.09.02	ISSUED FOR PCH#29
25	2025.09.02	ISSUED FOR SH#20 - CO#18
26	2025.09.08	ISSUED FOR PCH#31
27	2025.09.09	ISSUED FOR PCH#32 - CO#22
28	2025.09.10	ISSUED FOR PCH#33
29	2025.09.11	ISSUED FOR SH#22
30	2025.09.15	ISSUED FOR SH#23
31	2025.09.16	ISSUED FOR PCH F33 - CO#23
32	2025.09.30	ISSUED FOR PCH #37 - CO#19
33	2025.09.30	ISSUED FOR PCH #38 - CO#25
34	2025.10.04	ISSUED FOR PCH #39 - CO#24
35	2025.10.20	ISSUED FOR PCH #481
36	2025.10.30	ISSUED FOR PCH#41
37	2025.10.23	ISSUED FOR PCH #42
38	2025.11.21	ISSUED FOR PCH#21#1 - CO12 CO#26
39	2025.11.14	ISSUED FOR PCH#43
40	2025.11.26	ISSUED FOR PCH#481
41	2025.12.03	ISSUED FOR PCH#44 - CO#26
42	2026.02.04	ISSUED FOR RECORD SET UP TO CO#27

NOTES:

KEY PLAN:




CLIENT:
NEAR NORTH DISTRICT SCHOOL BOARD
NND58 Tender # 2023-015

PROJECT:
NEW PARRY SOUND K-12 SCHOOL & CHILDCARE
PARRY SOUND HIGH SCHOOL SITE

111 ISABELLA STREET
PARRY SOUND, ONTARIO

ORIGINAL PAGE SIZE ARCH E1 - 30" x 42"
KEY TO DETAIL LOCATION:
A - DETAIL NO.
B - DETAIL NO. ORIGIN

VG ARCHITECTS
THE VENTIN GROUP LTD

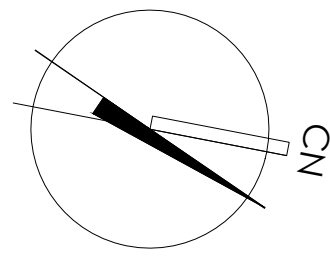

A2.6

DRAWN BY : SR

CHECKED BY : EB


Filename: K:\TVG\Brandford\Near North DSS\Parry Sound\School\22111\Drawings\WG\Current\NIN-A2.4.2.6 & A4.3 Hex Pod Roof Plans.dwg

Plot Date: Feb 03, 2026 - 5:11pm By: Jkely

HEX PODS - ROOF PLAN (CASH ALLOWANCE)


Reproduction of drawings and related documents in whole or in part is prohibited without written permission of the Ventin Group.

All dimensions and measurements must be checked and verified by the General Contractor.

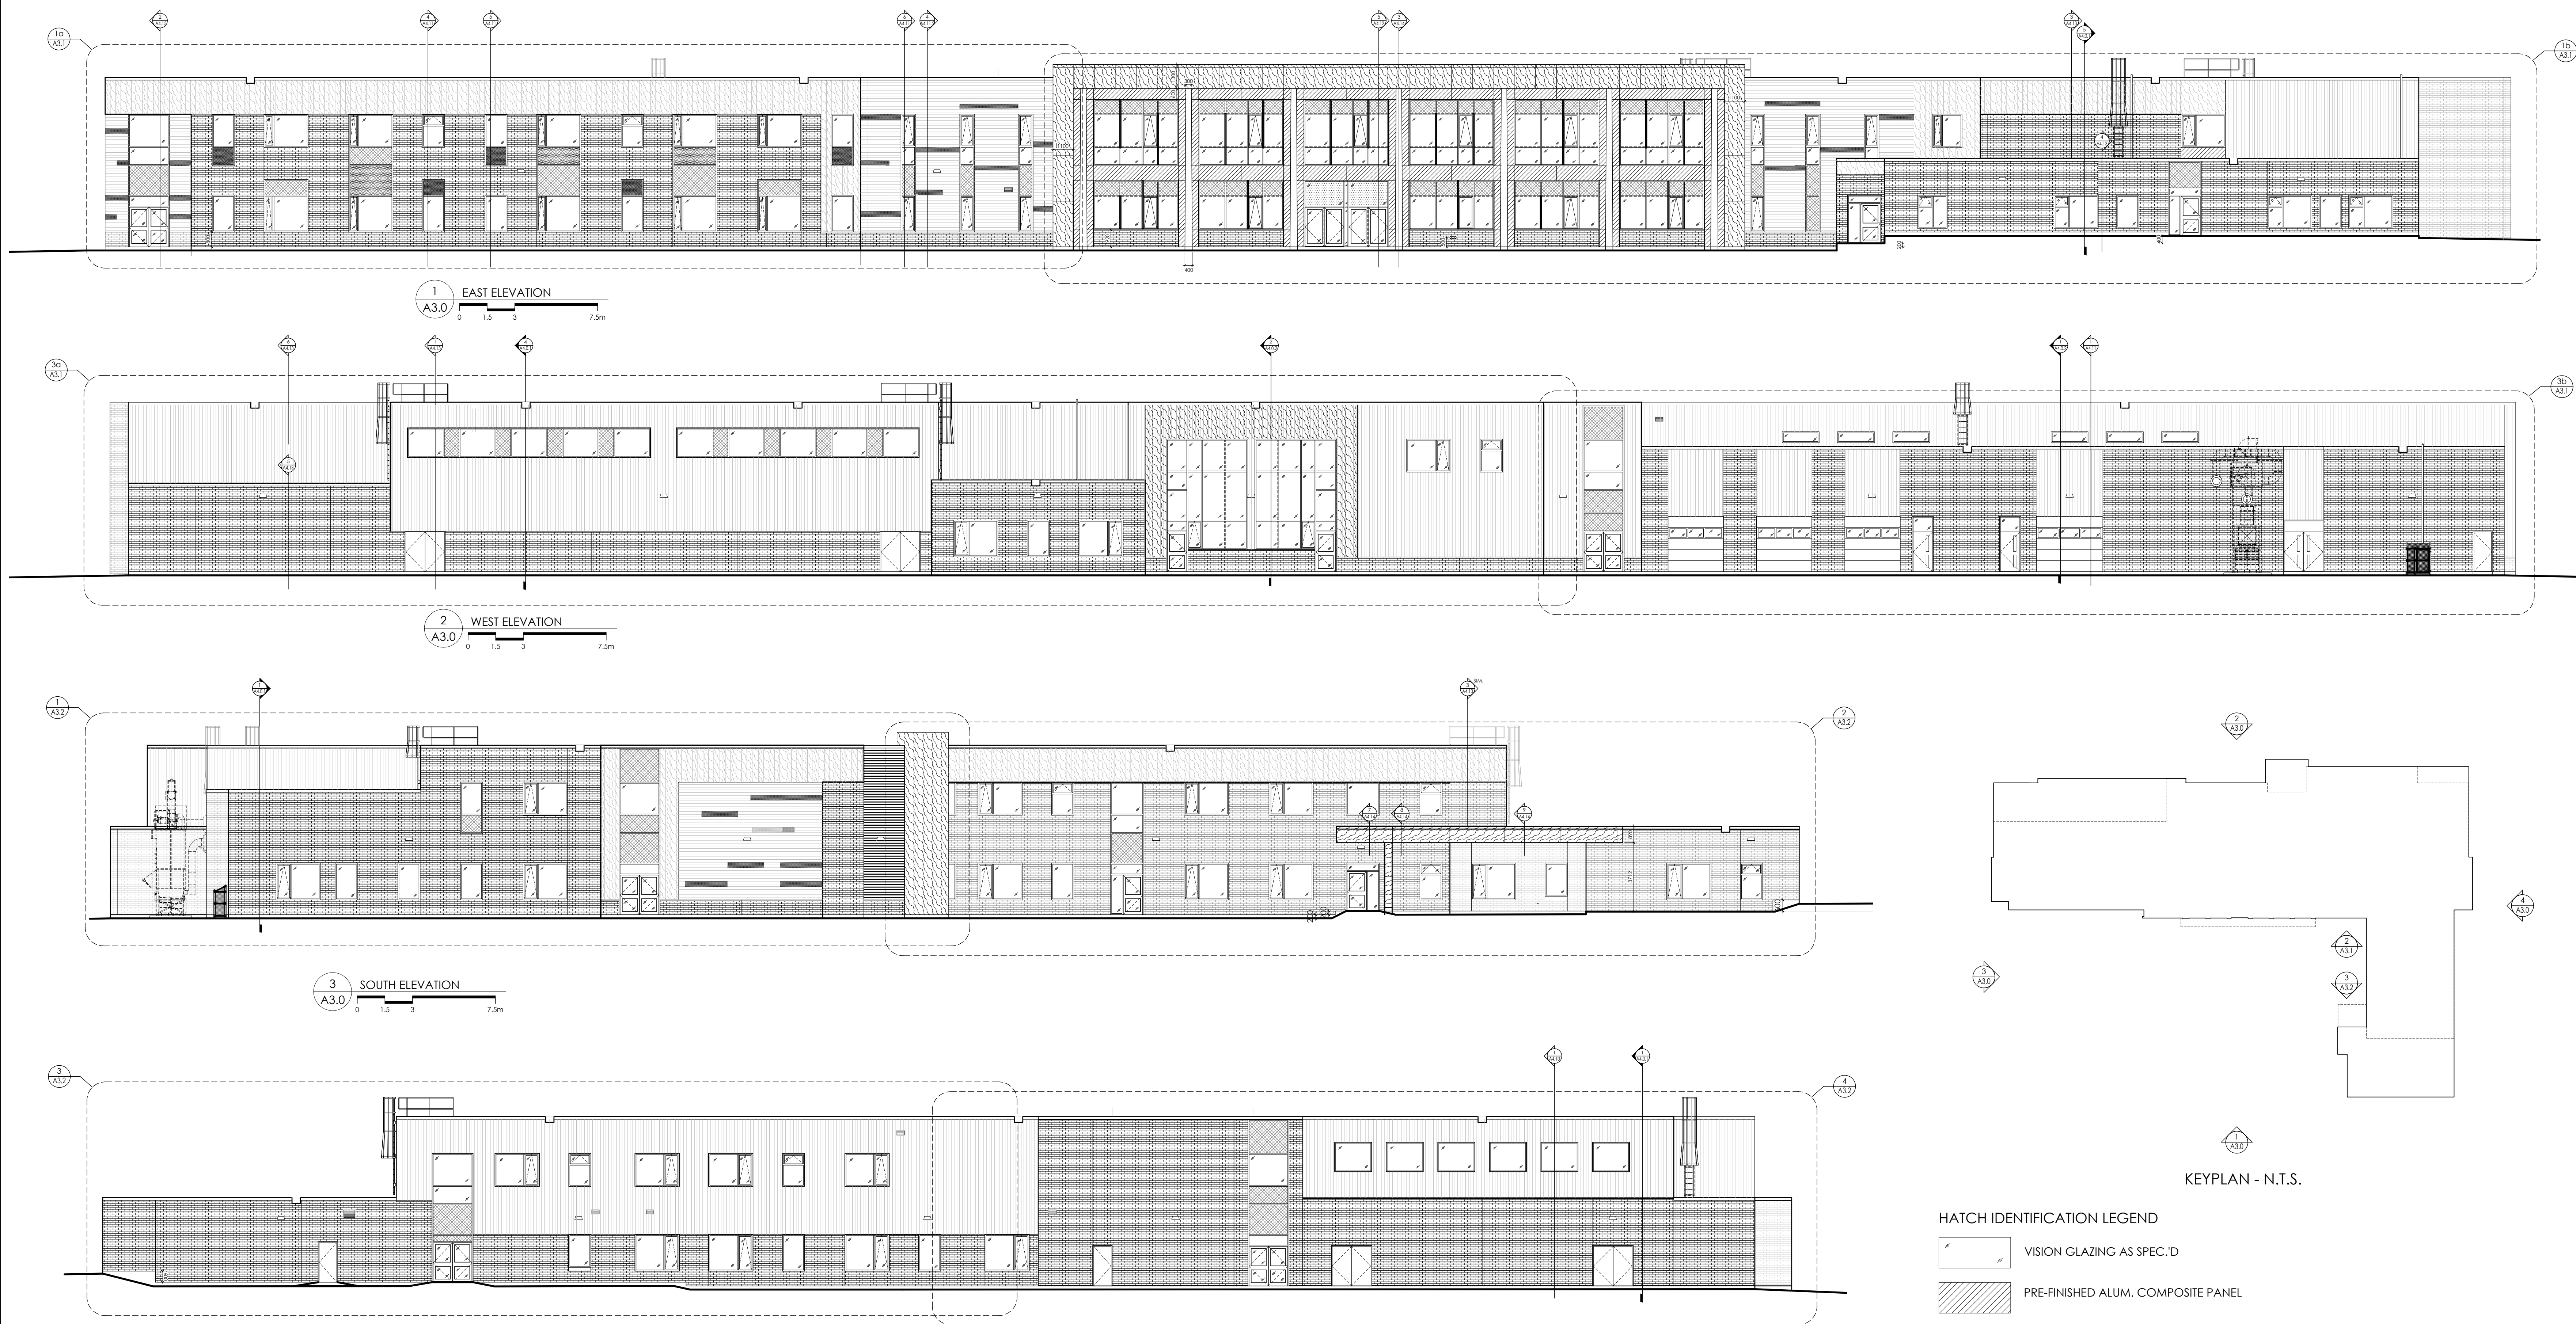

HATCH IDENTIFICATION LEGEND

- VISION GLAZING AS SPEC.'D
- PRE-FINISHED ALUM. COMPOSITE PANEL
- PRE-FINISHED ALUMINUM COMPOSITE PANEL W/ WOOD GRAIN FINISH
- PRE-FINISHED METAL CLADDING WOOD LOOK FINISH
- PRE-FINISHED METAL CLADDING 8" CORRUGATED
- SPANDREL GLAZING ALLOW 3 COLOURS
- ALUMINUM PLANK CLADDING WOOD LOOK FINISH
- ALUMINUM PLANK CLADDING ALLOW 3 COLOURS
- MASONRY VENEER AS SPEC.'D

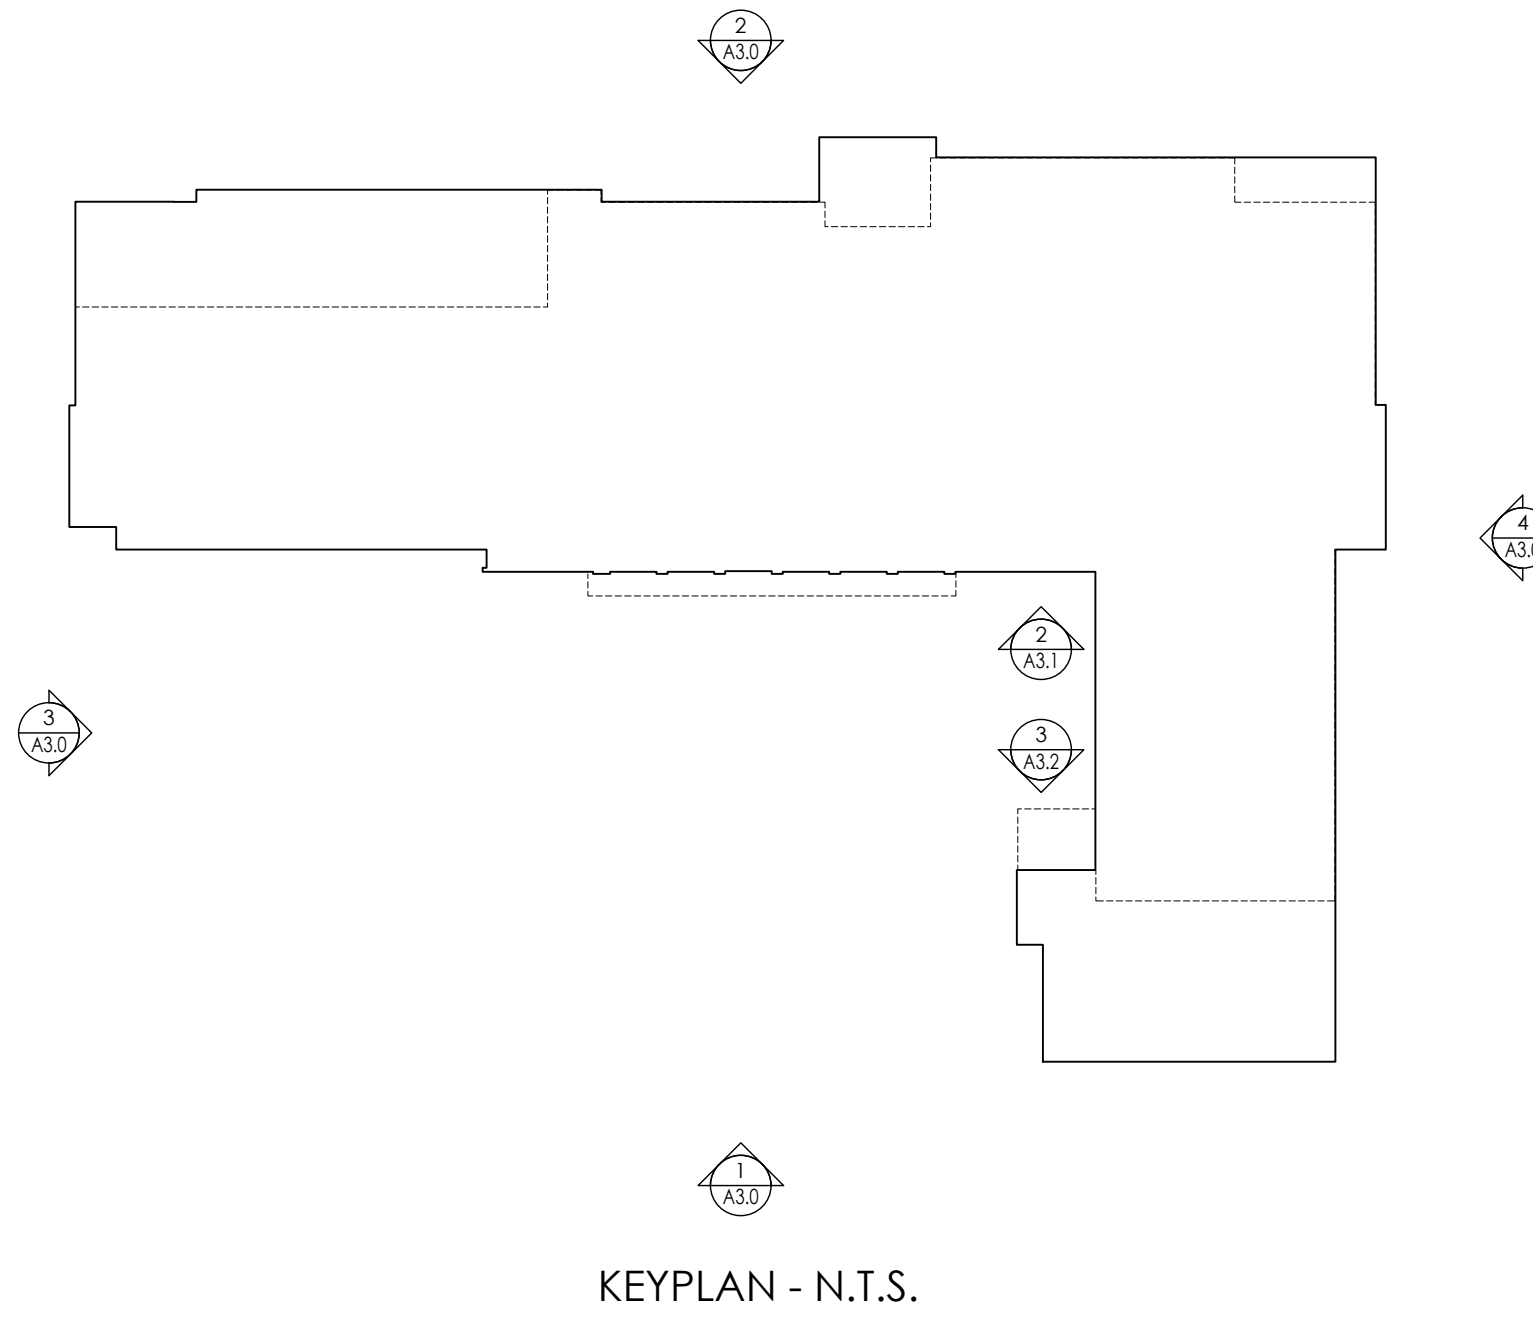

REVISIONS		
NO.	DATE	PARTICULAR
1	2022.04.06	ISSUED FOR 805 CLASS B COSTING
2	2022.06.18	ISSUED FOR SPA
3	2022.09.22	ISSUED FOR OWNERS REVIEW - RES SET
4	2022.12.16	ISSUED FOR 2nd SPA SUBMISSION
5	2023.01.31	ISSUED FOR TENDER
6	2023.02.22	ISSUED FOR ADDENDUM 9
7	2023.08.23	ISSUED FOR CONVENIENCE
8	2023.11.20	ISSUED FOR PERMIT COMMENTS
9	2024.01.24	ISSUED FOR SH#3
10	2024.02.15	ISSUED FOR PCH#38
11	2024.03.04	ISSUED FOR PCH#39
12	2024.03.10	ISSUED FOR SH#04
13	2024.05.14	ISSUED FOR SH#06
14	2024.07.22	ISSUED FOR SH#08
15	2024.08.07	ISSUED FOR SH#09
16	2024.10.02	ISSUED FOR PCH#15
17	2025.04.11	ISSUED FOR PCH#19
18	2025.05.01	ISSUED FOR CO#57
19	2025.05.28	ISSUED FOR PCH#20 - CO#10
20	2025.07.31	ISSUED FOR SH#13
21	2025.08.06	ISSUED FOR SH#14
22	2025.08.15	ISSUED FOR PCH#25 - CO#17
23	2025.08.25	ISSUED FOR PCH#27 - CO#21
24	2025.09.02	ISSUED FOR PCH#29
25	2025.09.10	ISSUED FOR SH#10 - CO#18
26	2025.09.08	ISSUED FOR PCH#31
27	2025.09.09	ISSUED FOR PCH#32 - CO#22
28	2025.09.10	ISSUED FOR PCH#33
29	2025.09.11	ISSUED FOR SH#22
30	2025.09.15	ISSUED FOR SH#23
31	2025.09.16	ISSUED FOR PCH #35 - CO#23
32	2025.09.30	ISSUED FOR PCH #37 - CO#19
33	2025.09.30	ISSUED FOR PCH #38 - CO#25
34	2025.10.04	ISSUED FOR PCH #39 - CO#24
35	2025.10.20	ISSUED FOR PCH #40#1
36	2025.10.30	ISSUED FOR PCH#41
37	2025.10.23	ISSUED FOR PCH #42
38	2025.11.21	ISSUED FOR PCH#21#1 - CO12 CORN
39	2025.11.14	ISSUED FOR PCH#43
40	2025.11.26	ISSUED FOR PCH#48#1
41	2025.12.03	ISSUED FOR PCH#44 - CO#26
42	2026.02.04	ISSUED FOR RECORD SET UP TO CO#27

NOTES:

KEY PLAN:



CLIENT:
NEAR NORTH DISTRICT SCHOOL BOARD
NND58 Tender # 2023-015

PROJECT:
NEW PARRY SOUND K-12 SCHOOL & CHILDCARE
PARRY SOUND HIGH SCHOOL SITE
111 ISABELLA STREET
PARRY SOUND, ONTARIO

ORIGINAL PAGE SIZE ARCH E1 - 30" x 42"
KEY TO DETAIL LOCATION:
A - DETAIL NO.
B - DETAIL NO. ORIGIN

VG ARCHITECTS
THE VENTIN GROUP LTD

A3.0

DRAWN BY: EB CHECKED BY: PS

EXTERIOR ELEVATIONS - OVERALL

Reproduction of drawings and related documents in whole or in part is prohibited without written permission of the Ventin Group.

Filename: K:\TVG\Brantford\Near North D58 Pary Sound School\22111\Drawings\WG\Current\NIN-A3.1.dwg Plot Date: Feb 03, 2026 - 5:12pm By: jlely



REVISIONS		
NO.	DATE	PARTICULAR
1	2022.04.06	ISSUED FOR 80% CLASS B COSTING
2	2022.06.18	ISSUED FOR SPA
3	2022.09.22	ISSUED FOR OWNERS REVIEW - RFS SET
4	2022.12.16	ISSUED FOR 2nd SPA SUBMISSION
5	2023.01.31	ISSUED FOR TENDER
6	2023.02.22	ISSUED FOR ADDENDUM 9
7	2023.08.23	ISSUED FOR CONVENIENCE
8	2023.11.20	ISSUED FOR PERMIT COMMENTS
9	2024.09.26	ISSUED FOR SH022
10	2024.02.15	ISSUED FOR PCH038
11	2024.03.04	ISSUED FOR PCH039
12	2024.03.10	ISSUED FOR SH004
13	2024.05.14	ISSUED FOR SH004
14	2024.07.22	ISSUED FOR SH008
15	2024.08.07	ISSUED FOR PCH039
16	2024.10.02	ISSUED FOR PCH015
17	2025.04.11	ISSUED FOR PCH019
18	2025.05.01	ISSUED FOR CO#07
19	2025.05.28	ISSUED FOR PCH030 - CO#010
20	2025.07.31	ISSUED FOR SH013
21	2025.08.06	ISSUED FOR SH014
22	2025.08.15	ISSUED FOR PCH035 - CO#017
23	2025.08.25	ISSUED FOR PCH027 - CO#021
24	2025.09.02	ISSUED FOR PCH029
25	2025.09.02	ISSUED FOR SH020 - CO#018
26	2025.09.08	ISSUED FOR PCH031
27	2025.09.09	ISSUED FOR PCH032 - CO#022
28	2025.09.10	ISSUED FOR PCH033
29	2025.09.11	ISSUED FOR SH022
30	2025.09.15	ISSUED FOR SH023
31	2025.09.16	ISSUED FOR PCH F35 - CO#023
32	2025.09.30	ISSUED FOR PCH037 - CO#019
33	2025.09.30	ISSUED FOR PCH038 - CO#025
34	2025.10.04	ISSUED FOR PCH039 - CO#024
35	2025.10.20	ISSUED FOR PCH040
36	2025.10.30	ISSUED FOR PCH041
37	2025.10.23	ISSUED FOR PCH042
38	2025.11.21	ISSUED FOR PCH020181 - CO#2 CO#030
39	2025.11.14	ISSUED FOR PCH0403
40	2025.11.26	ISSUED FOR PCH04041
41	2025.12.03	ISSUED FOR PCH0404 - CO#026
42	2026.02.04	ISSUED FOR RECORD SET UP TO CO#027

NOTES:

KEY PLAN:



CLIENT:
NEAR NORTH DISTRICT SCHOOL BOARD
NDSB Tender # 2023-015

PROJECT:
NEW PARRY SOUND K-12 SCHOOL & CHILDCARE

PARRY SOUND HIGH SCHOOL SITE

111 ISABELLA STREET
PARRY SOUND, ONTARIO

ORIGINAL PAGE SIZE ARCH E1 - 30" x 42"
KEY TO DETAIL LOCATION:
A - DETAIL NO.
B - DETAIL NO. ORIGIN

SYMBOLS & ABBREV.'S LEGEND

IDENTIFICATION MARKER LEGEND

	ELEVATION REFERENCE
	DETAIL REFERENCE
	WALL SECTION REFERENCE
	BUILDING SECTION REFERENCE
	DATUM
	GRID LINE
	WINDOW / CURTAINWALL (COORD. W/ A/B SERIES SCHEDULES)
	LIGHT FIXTURES (COORD. W/ ELEC. DWG.S)
	PERSONAL ADDRESS SYSTEM (COORD. W/ ELEC. DWG.S)
	PUSH BUTTON FOR POWER DOOR OPERATOR (925mm TO CENTER OF BUTTON A/F/F TYP.) (COORD. W/ ELEC. DWG.S)
	SIAMESE CONNECTION / FIRE FIGHTERS CONNECTION (800mm A/F GRADE) (COORD. W/ MECH. DWG.S)
	HOSE BIB (COORD. W/ MECH. DWG.S)
	MECHANICAL LOUVER(S) FINISHED 'COLOUR' TO MATCH SURROUNDING WALL(COORD. W/ MECH. DWG.S)
	SCUPPER DRAIN LOCATION SCUPPER DRAINS ARE LOCATED IN THE GENERAL LOCATION ON THE ROOF PLAN (COORD. W/ ELEVATIONS) (COORD. W/ ROOF PLAN)
	MASONRY VENEER AS SPEC'D
	CONTROL JOINT LOCATION (COORD. W/ & ELEVATIONS FOR TYP. DETAIL) (COORD. W/ MASONRY MODULE)
	COMPARTMENTALIZATION OF CAVITY JOINT LOCATION (COORD. W/ DETAILS FOR TYP. DETAIL OF JOINTS) (COORD. W/ MASONRY MODULE) (SUBMIT SHOP DWG.S)

GENERAL NOTES

- COLOUR OF DURANAR PAINT (ALL TYPES OF COATING) FOR OPERATORS, GLAZING STOPS AND OTHER EXPOSED ACCESSORIES TO BE SELECTED BY ARCHITECT FROM MANUF. STD. OR PREMIUM RANGE
- EXCEPT WHERE DURANAR PAINT IS MARKED ON THE DRAWINGS, ALL INTERIOR & EXTERIOR ALUM. FRAMES OF WINDOWS, DOORS, SIDELIGHTS, GLASS PANEL FRAMINGS, CURTAIN WALL FRAMINGS, CAPS TO BE BASED ON BLACK COLOR. FINAL COLOR TO BE SELECTED BY ARCHITECT FROM MANUF. STD. RANGE
- SHOP DWG.S TO BE IN DIMENSION UNITS AS ILLUSTRATED ON THIS DWG. OR THEY WILL BE SELECTED (IMPERIAL & METRIC BOTH SHOWN IS ACCEPTABLE)

FIRE STOPPING

- (1) EXCEPT AS PERMITTED BY SENTENCE (2) BELOW, FIRE STOPS CONFORMING TO ARTICLE 3.1.1.17.7. SHALL BE PROVIDED TO BLOCK OFF CONCEALED SPACES WITHIN A WALL ASSEMBLY
- (A) AT EVERY FLOOR LEVEL
- (B) AT EVERY CEILING LEVEL WHERE THE CEILING FORMS PART OF AN ASSEMBLY REQUIRED TO HAVE A FIRE-RESISTANCE RATING, AND
- (C) SO THAT THE MAXIMUM HORIZONTAL DIMENSION IS NOT MORE THAN 20 M AND THE MAXIMUM VERTICAL DIMENSION IS NOT MORE THAN 3M
- (2) FIRE BLOCKS CONFORMING TO SENTENCE (1) ARE NOT REQUIRED PROVIDED:
 - (a) THE WALL SPACE IS FILLED WITH INSULATION
 - (b) THE EXPOSED CONSTRUCTION MATERIALS AND ANY INSULATION WITHIN THE WALL SPACE ARE NONCOMBUSTIBLE
 - (c) THE EXPOSED MATERIALS WITHIN THE WALL SPACE, INCLUDING INSULATION BUT NOT INCLUDING WIRING, PIPING OR SIMILAR SERVICES, HAVE A FLAME SPREAD RATING NOT MORE THAN 25 ON ANY EXPOSED SURFACE, OR ON ANY SURFACE THAT WOULD BE EXPOSED BY CUTTING THROUGH THE MATERIAL IN ANY DIRECTION, AND FIRE BLOCKS ARE INSTALLED SO THAT THE VERTICAL DISTANCE BETWEEN THEM IS NOT MORE THAN 10 M OR
 - (d) THE INSULATED WALL ASSEMBLY CONTAINS NOT MORE THAN ONE CONCEALED AIR SPACE AND THE HORIZONTAL THICKNESS OF THAT AIR SPACE IS NOT MORE THAN 25 MM
- INSTALL CAVITY CLOSURE FROM FACE OF CONCRETE BASE WALL TO INTER. FACE OF EXTERIOR CLADDING. PROVIDE REINFORCED FLEXIBLE THRU WALL FLASHING C/W WEEPER AT EVERY HORIZONTAL FIRE STOPPING CLOSURE. REFER TO DETAILS ON A4 SERIES.





ARCHITECTS
THE VENTIN GROUP LTD
+VVG

111 ISABELLA STREET
PARRY SOUND, ONTARIO

A3.1

DRAWN BY: EB CHECKED BY: PS

EXTERIOR ELEVATIONS

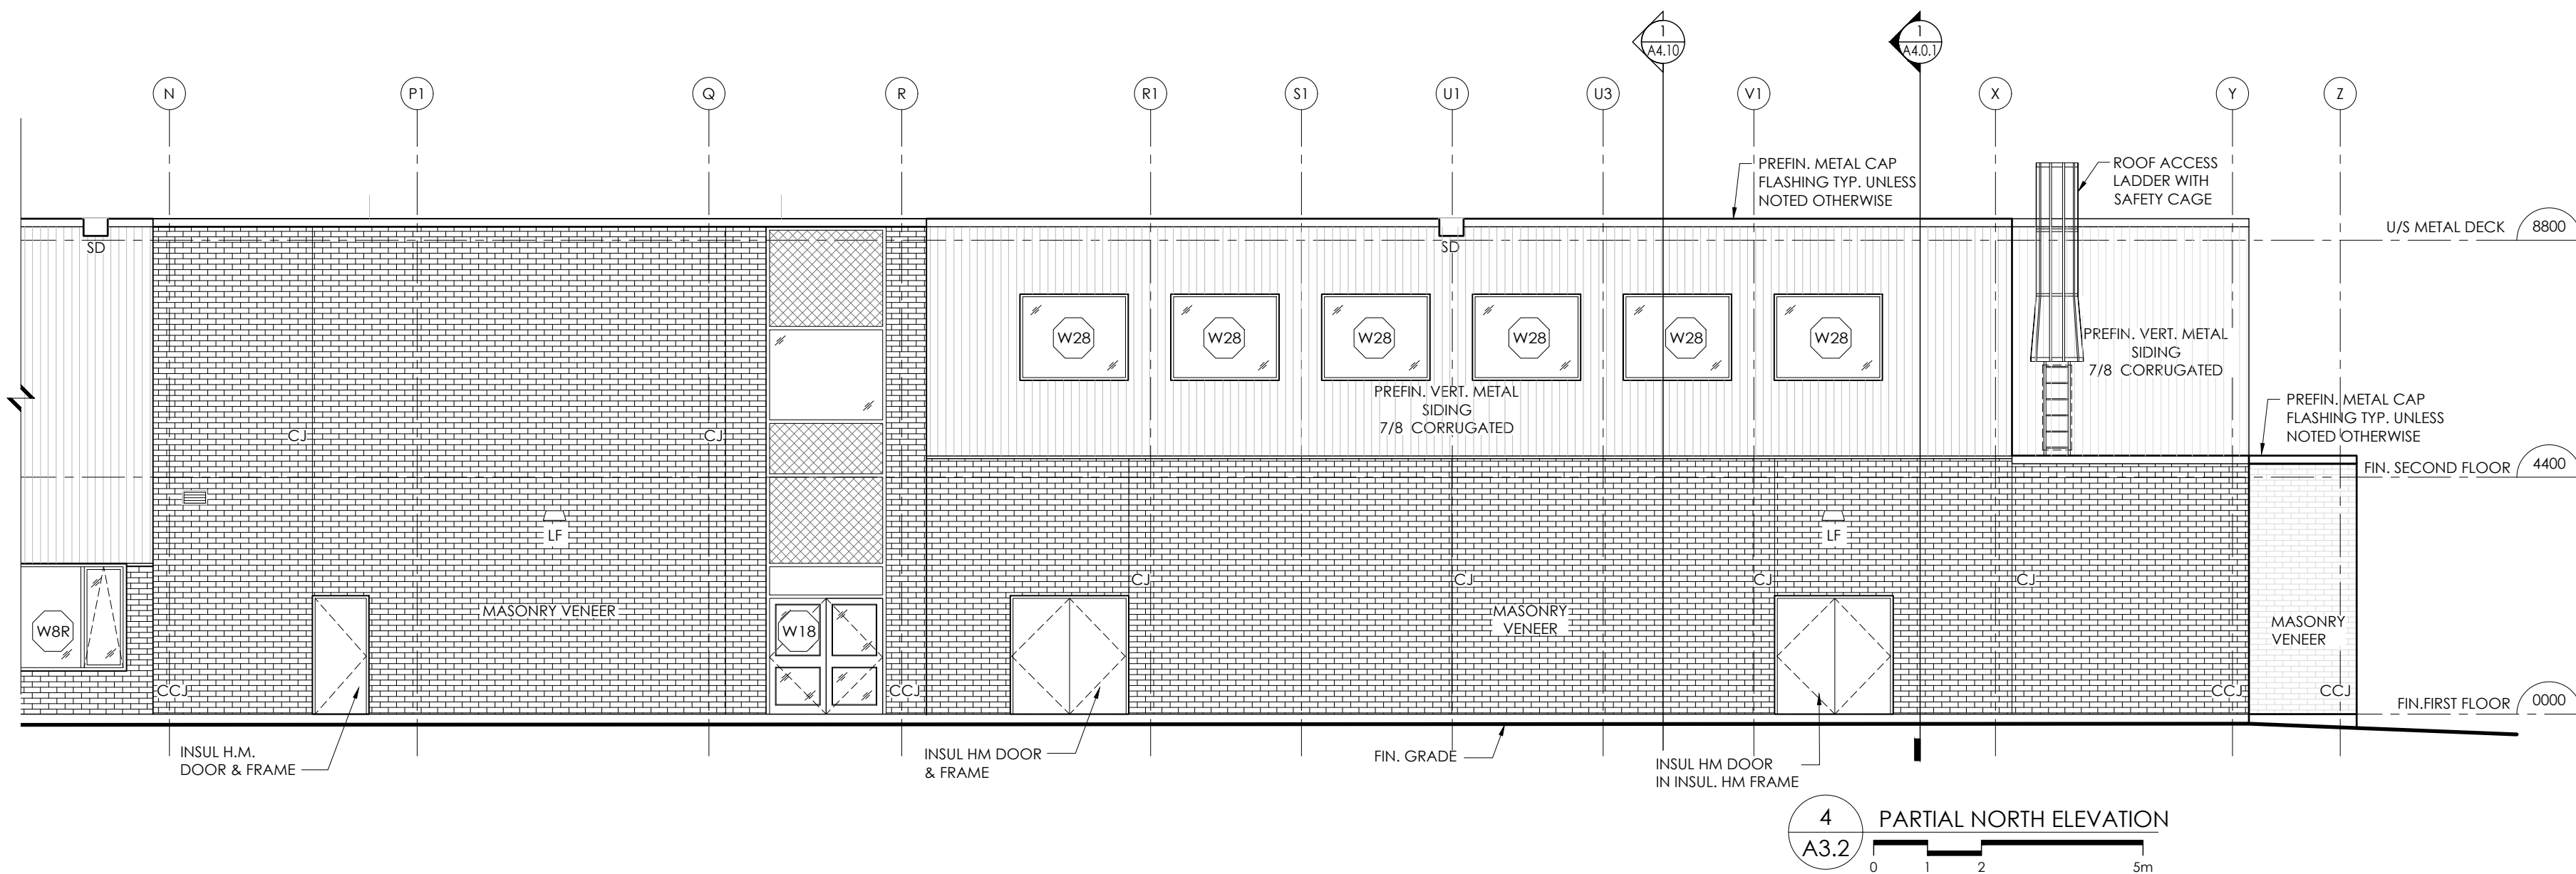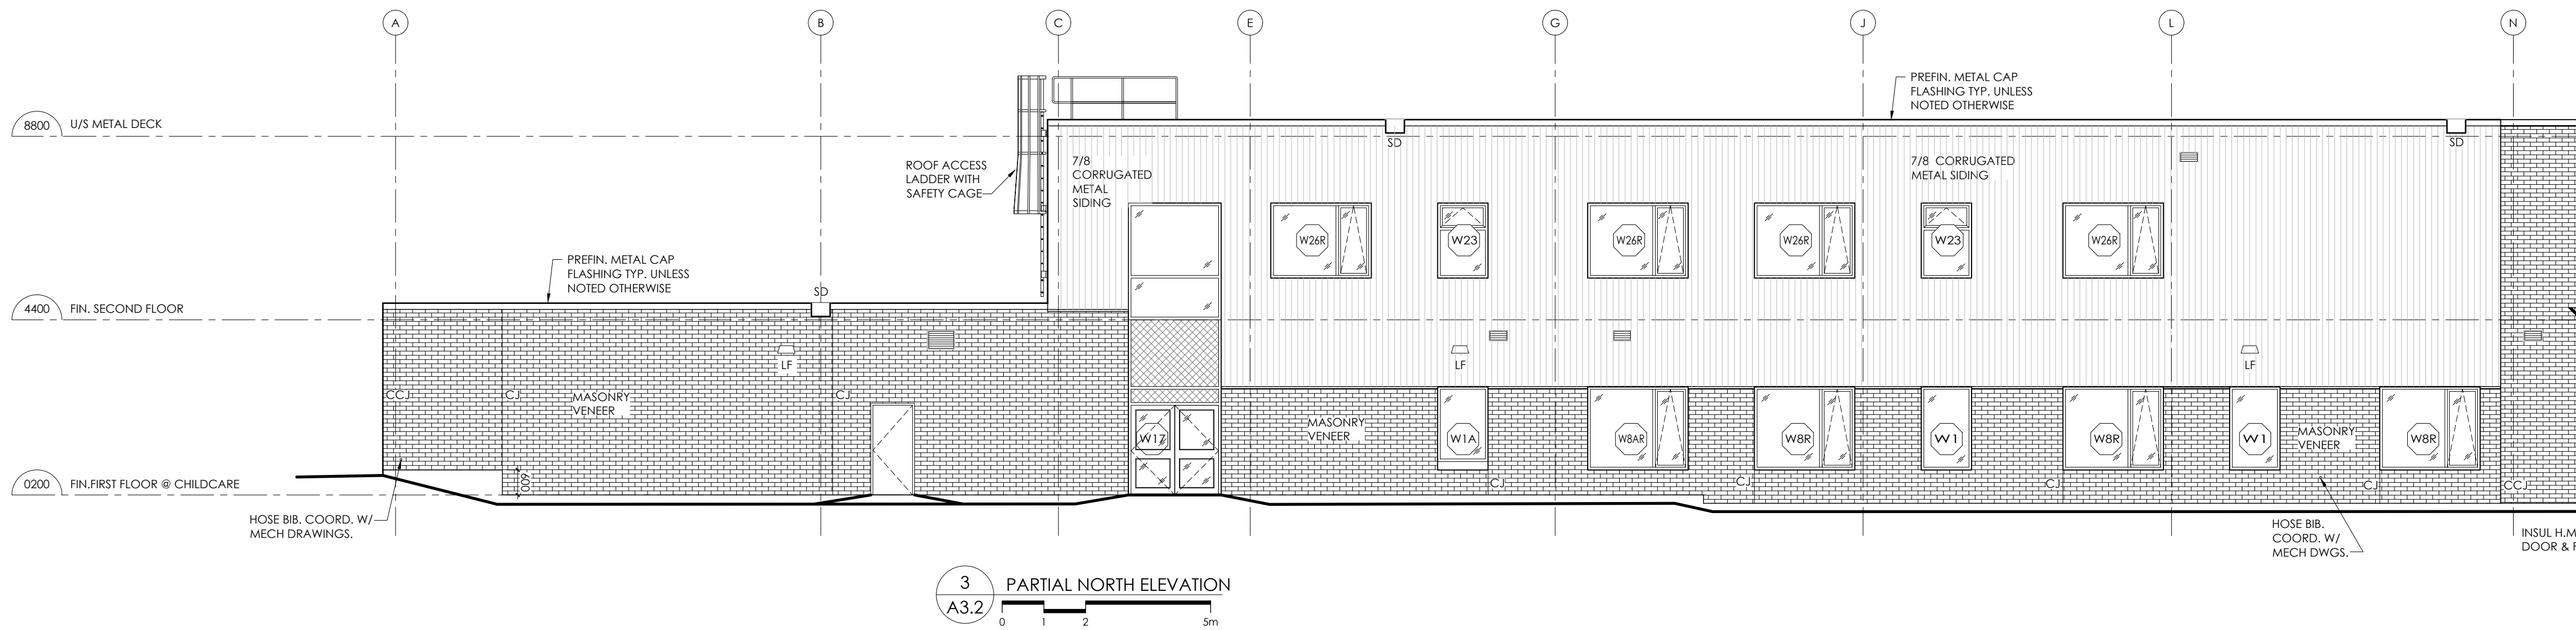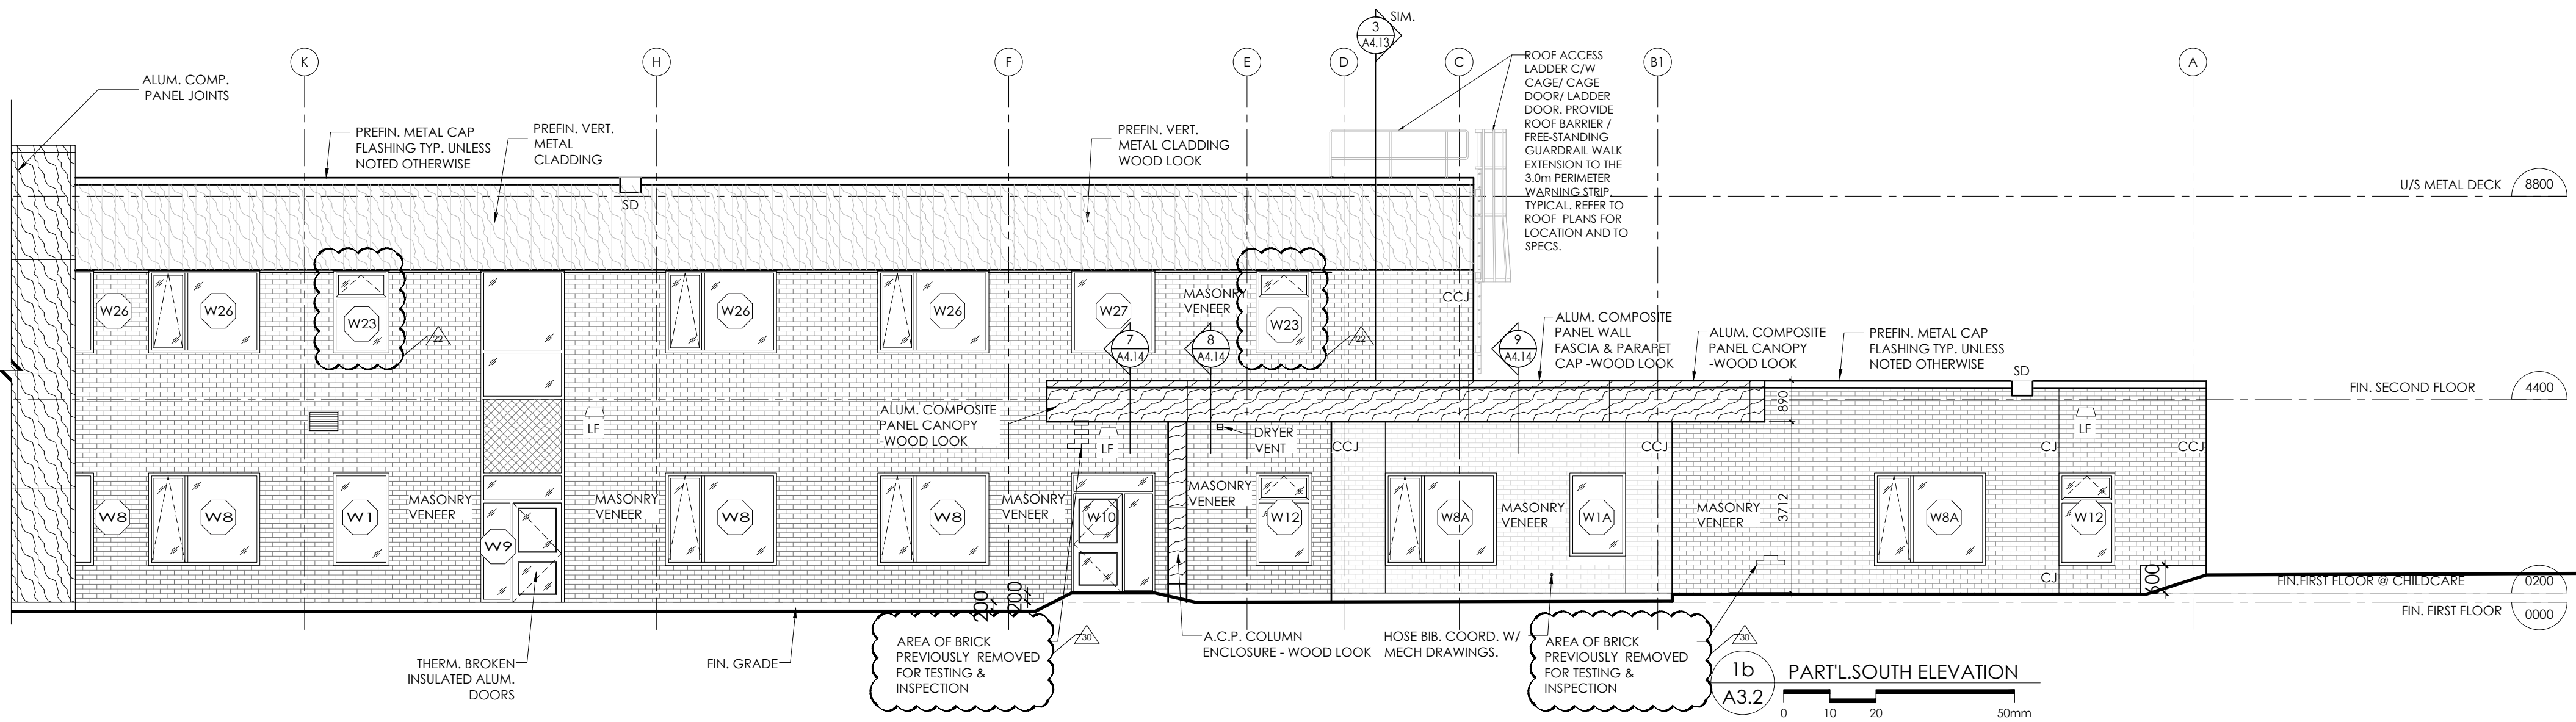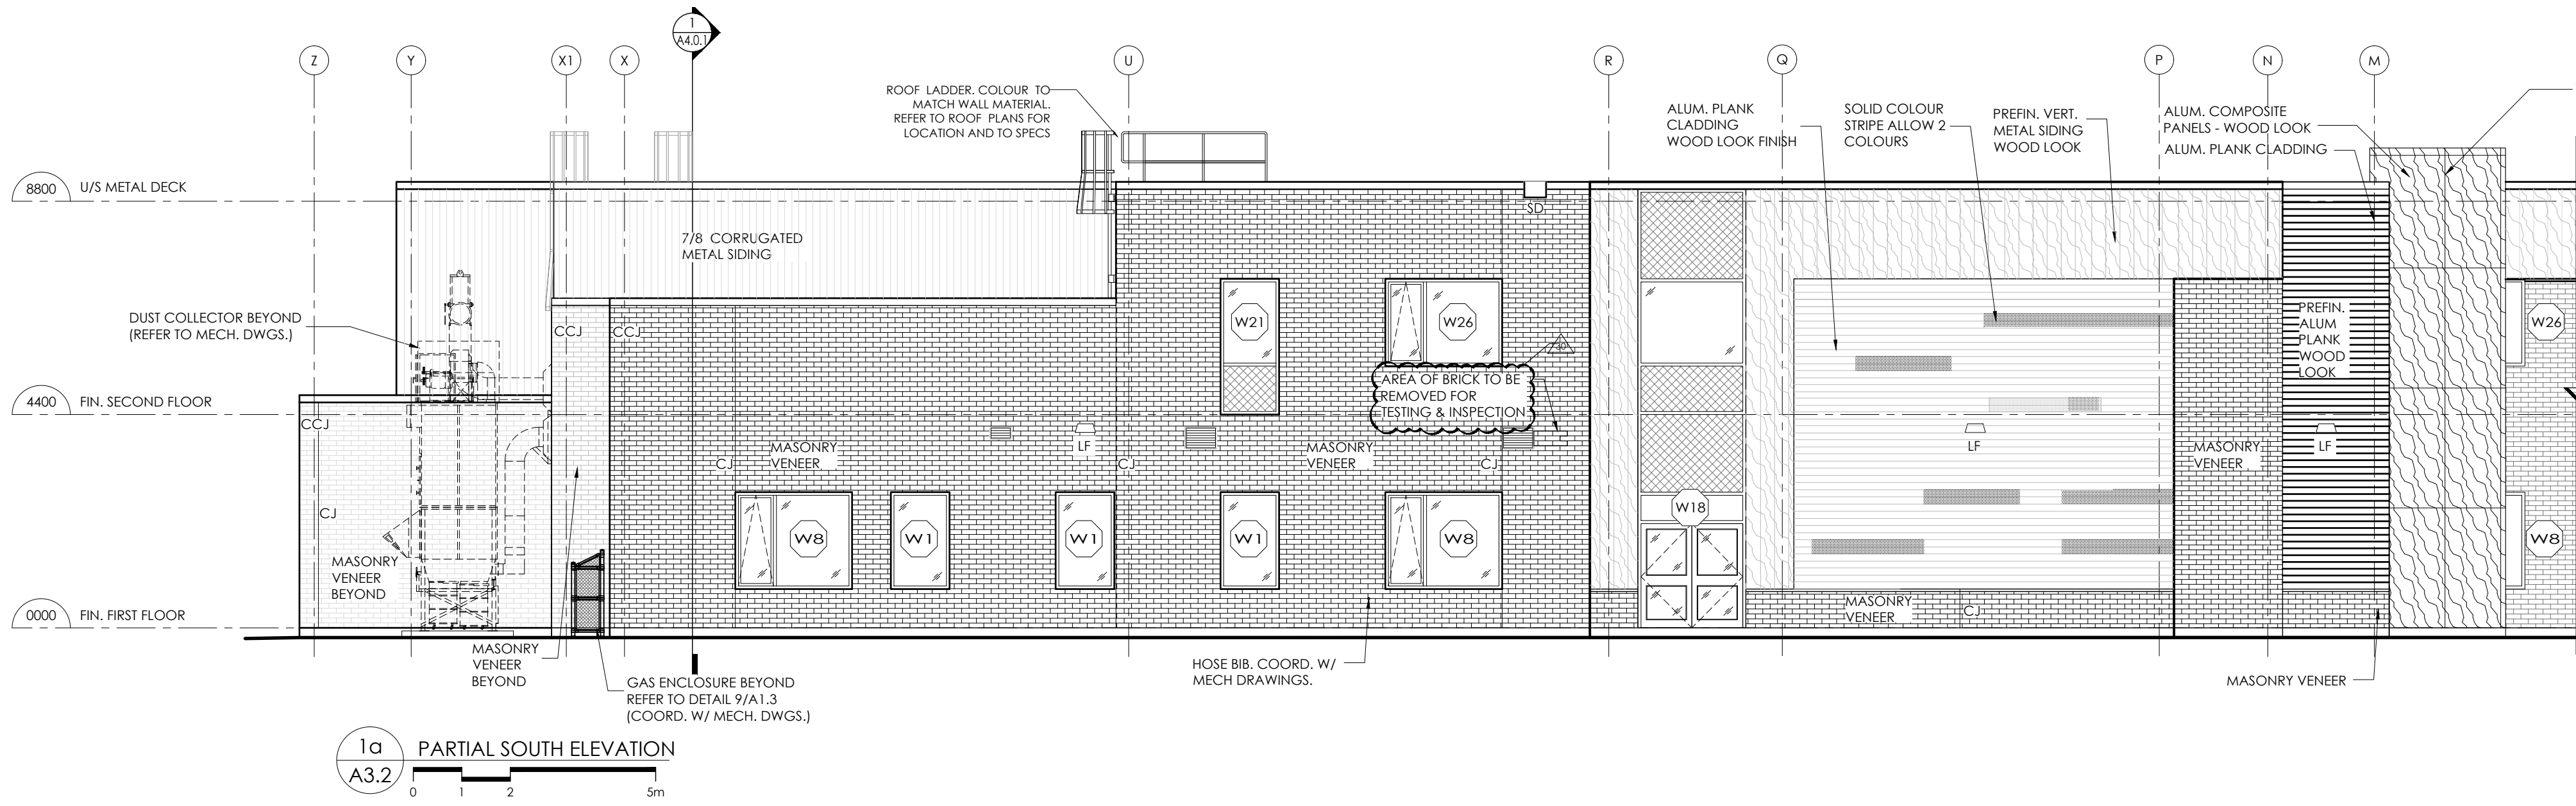

GENERAL NOTES

- COLOUR OF DURAMAR PAINT (ALL TYPES OF COATINGS) FOR OPERATIONS, CLADDING STOPS AND OTHER EXPOSED ACCESSORIES TO BE SELECTED BY ARCHITECT FROM MANUF. STD. OR PREMIUM RANGE EXCEPT WHERE DURAMAR PAINT IS MARKED ON THE DRAWINGS. ALL INTERIOR & EXTERIOR ALUM. FRAMES OF WINDOWS, DOORS, SIDE LIGHTS, GLASS PANEL FRAMINGS, CURTAIN WALL FRAMINGS CAPS TO BE BASED ON BLACK COLOUR. FINAL COLOUR TO BE SELECTED BY ARCHITECT FROM MANUF. STD. RANGE.
- SHOP DWGS. TO BE IN DIMENSION UNITS AS ILLUSTRATED. ON THIS DWG. OR THEY WILL BE REJECTED. IMPERIAL & METRIC BOTH SHOWN IS ACCEPTABLE.

FIRE STOPPING

(1) EXCEPT AS PERMITTED BY SENTENCE (2) BELOW, FIRE STOPS CONFORMING TO ARTICLE 3.1.11.1.7. SHALL BE PROVIDED TO BLOCK OFF CONCEALED SPACES WITHIN A WALL ASSEMBLY.

(A) AT EVERY FLOOR LEVEL.

(B) AT EVERY CEILING LEVEL WHERE THE CEILING FORMS PART OF AN ASSEMBLY REQUIRED TO HAVE A FIRE-RESISTANCE RATING, AND

(C) SO THAT THE MAXIMUM HORIZONTAL DIMENSION IS NOT MORE THAN 20 M AND THE MAXIMUM VERTICAL DIMENSION IS NOT MORE THAN 3M.

(2) FIRE BLOCKS CONFORMING TO SENTENCE (1) ARE NOT REQUIRED PROVIDED:

(a) THE WALL SPACE IS FILLED WITH INSULATION.


(b) THE EXPOSED CONSTRUCTION MATERIALS AND ANY INSULATION WITHIN THE WALL SPACE ARE NON-COMBUSTIBLE.

(c) THE EXPOSED MATERIALS WITHIN THE WALL SPACE, INCLUDING INSULATION BUT NOT INCLUDING WIRING, PIPING OR SIMILAR SERVICES, HAVE A FLAME-SPREAD RATING NOT MORE THAN 25 ON ANY EXPOSED SURFACE, OR ON ANY SURFACE THAT WOULD BE EXPOSED BY CUTTING THROUGH THE MATERIAL IN ANY DIRECTION, AND FIRE BLOCKS ARE INSTALLED SO THAT THE VERTICAL DISTANCE BETWEEN THEM IS NOT MORE THAN 150 mm.

(d) THE INSULATED WALL ASSEMBLY CONTAINS NOT MORE THAN ONE CONCEALED AIR SPACE AND THE HORIZONTAL THICKNESS OF THAT AIR SPACE IS NOT MORE THAN 25 mm.

INSTALL CAVITY CLOSURE FROM FACE OF CONCRETE BASE WALL TO INTER. FACE OF EXTERIOR CLADDING. PROVIDE REINFORCED FLEXIBLE THRU WALL FLASHING C/W WEATHER AT EVERY HORIZONTAL FIRE STOPPING CLOSURE. REFER TO DETAILS ON A4 SERIES.

REFER TO A3.1 FOR ALL OTHER NOTES

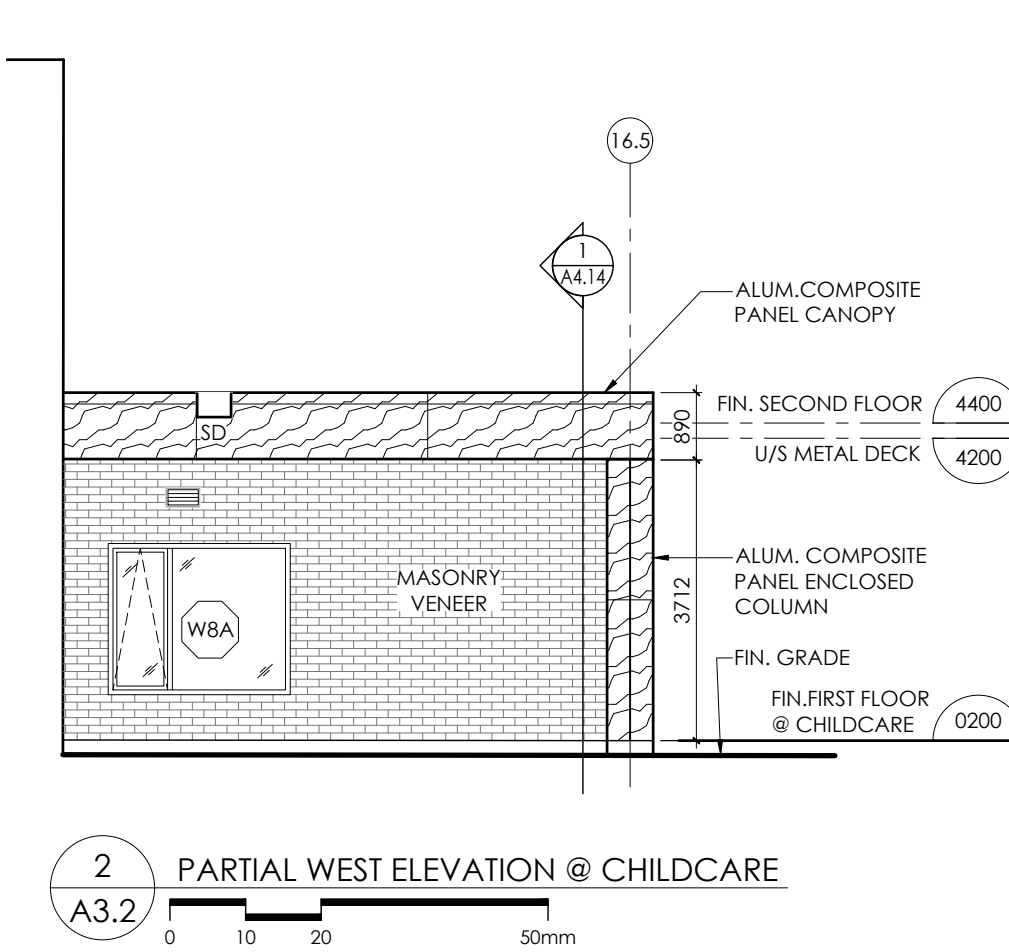

HATCH IDENTIFICATION LEGEND

	VISION GLAZING AS SPEC.'D
	PRE-FINISHED ALUM. COMPOSITE PANEL
	PRE-FINISHED ALUMINUM COMPOSITE PANEL W/ WOOD GRAIN FINISH
	PRE-FINISHED METAL CLADDING WOOD LOOK FINISH
	PRE-FINISHED METAL CLADDING CORRUGATED
	SPANDREL GLAZING ALLOW 3 COLOURS
	ALUMINUM PLANK CLADDING WOOD LOOK FINISH
	ALUMINUM PLANK CLADDING ALLOW 3 COLOURS
	MASONRY VENEER AS SPEC.'D

REVISIONS

NO.	DATE	PARTICULAR
1	2022.04.06	ISSUED FOR 80% CLASS B COSTING
2	2022.06.18	ISSUED FOR SPA
3	2022.09.22	ISSUED FOR OWNERS REVIEW - RES SET
4	2022.12.16	ISSUED FOR 2ND SPA SUBMISSION
5	2023.01.31	ISSUED FOR TENDER
6	2023.02.22	ISSUED FOR ADDENDUM 9
7	2023.08.23	ISSUED FOR CONVENIENCE
8	2023.11.20	ISSUED FOR PERMIT COMMENTS
9	2024.09.26	ISSUED FOR SH020
10	2024.02.15	ISSUED FOR PCH0308
11	2024.03.04	ISSUED FOR PCH0309
12	2024.03.10	ISSUED FOR SH0404
13	2024.05.14	ISSUED FOR SH0406
14	2024.07.22	ISSUED FOR SH0408
15	2024.08.07	ISSUED FOR SH0409
16	2024.10.02	ISSUED FOR PCH0415
17	2025.04.11	ISSUED FOR PCH0419
18	2025.05.01	ISSUED FOR CO#07
19	2025.05.28	ISSUED FOR PCH030 - CO#010
20	2025.07.31	ISSUED FOR SH0413
21	2025.08.06	ISSUED FOR SH0414
22	2025.08.15	ISSUED FOR PCH035 - CO#017
23	2025.08.25	ISSUED FOR PCH032 - CO#021
24	2025.09.02	ISSUED FOR PCH039
25	2025.09.02	ISSUED FOR SH020 - CO#018
26	2025.09.08	ISSUED FOR PCH031
27	2025.09.09	ISSUED FOR PCH032 - CO#022
28	2025.09.10	ISSUED FOR PCH033
29	2025.09.11	ISSUED FOR SH022
30	2025.09.15	ISSUED FOR SH023
31	2025.09.16	ISSUED FOR PCH F33 - CO#023
32	2025.09.30	ISSUED FOR PCH F37 - CO#019
33	2025.09.30	ISSUED FOR PCH F38 - CO#025
34	2025.10.04	ISSUED FOR PCH F39 - CO#024
35	2025.10.20	ISSUED FOR PCH F40
36	2025.10.30	ISSUED FOR PCH0401
37	2025.10.23	ISSUED FOR PCH F42
38	2025.11.21	ISSUED FOR PCH0401R1 - CO12 CO#030
39	2025.11.14	ISSUED FOR PCH0403
40	2025.11.26	ISSUED FOR PCH0404R1
41	2025.12.03	ISSUED FOR PCH0404 - CO#026
42	2026.02.04	ISSUED FOR RECORD SET UP TO CO#027

NOTES:

KEY PLAN:

CLIENT:

NEAR NORTH DISTRICT SCHOOL BOARD
NND58 Tender # 2023-015

PROJECT:

NEW PARRY SOUND K-12 SCHOOL & CHILDCARE
PARRY SOUND HIGH SCHOOL SITE

111 ISABELLA STREET
PARRY SOUND, ONTARIO

ORIGINAL PAGE SIZE ARCH E1 - 30" x 42"

KEY TO DETAIL LOCATION:

A - DETAIL NO.
B - DETAIL NO. ORIGIN






VG ARCHITECTS
THE VENTIN GROUP LTD

FILENAME: K:\TVG\Bentford\Near North D58 Parry Sound School\22111\Drawings\WG\Current\NIN-A3.1.dwg
Plot Date: Feb 03, 2026 - 5:12pm By: jleky

DRAWN BY: EB
CHECKED BY: PS

EXTERIOR ELEVATIONS

A3.2

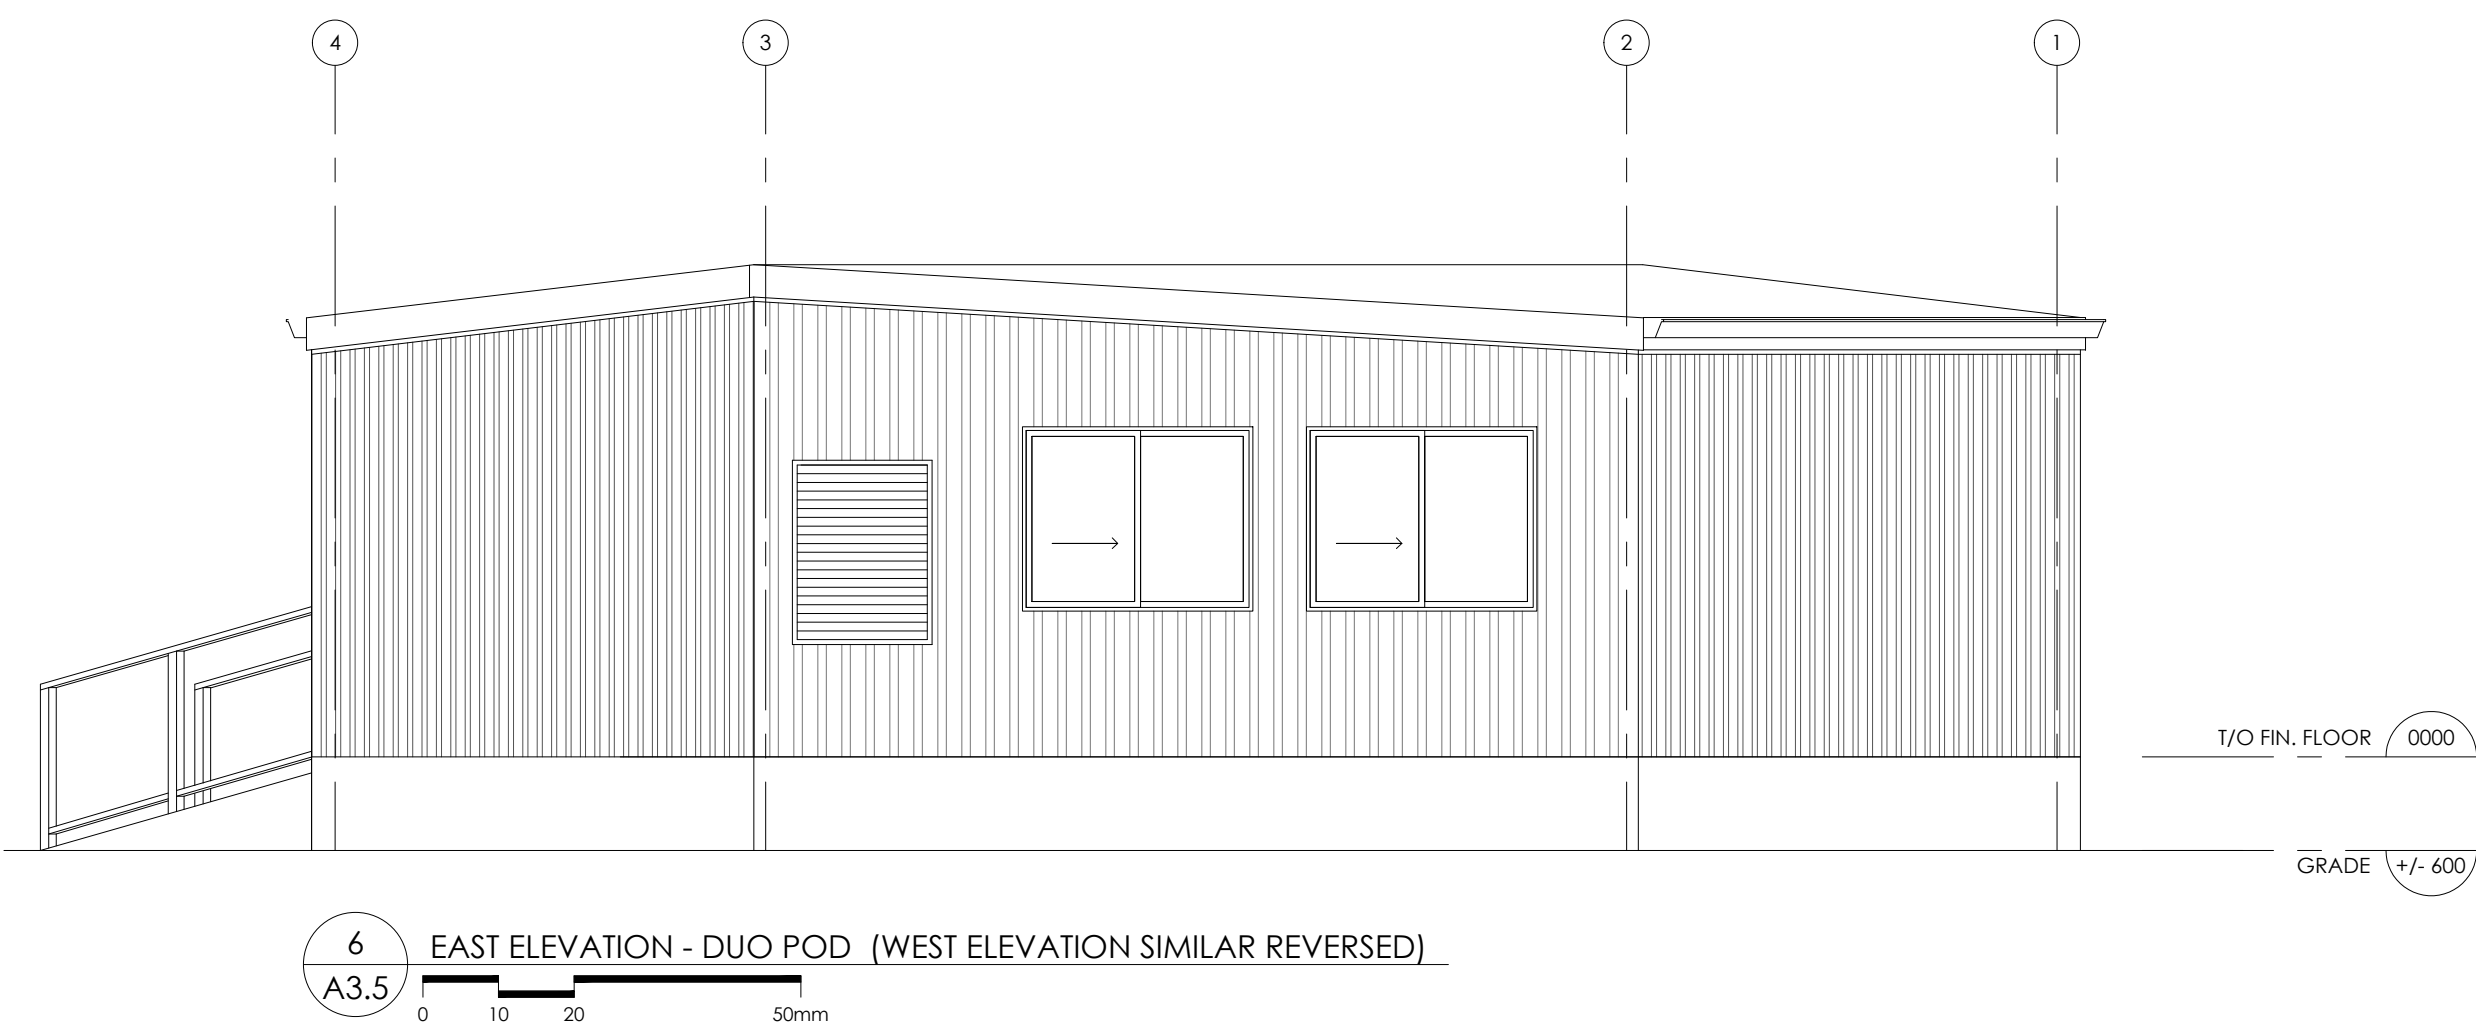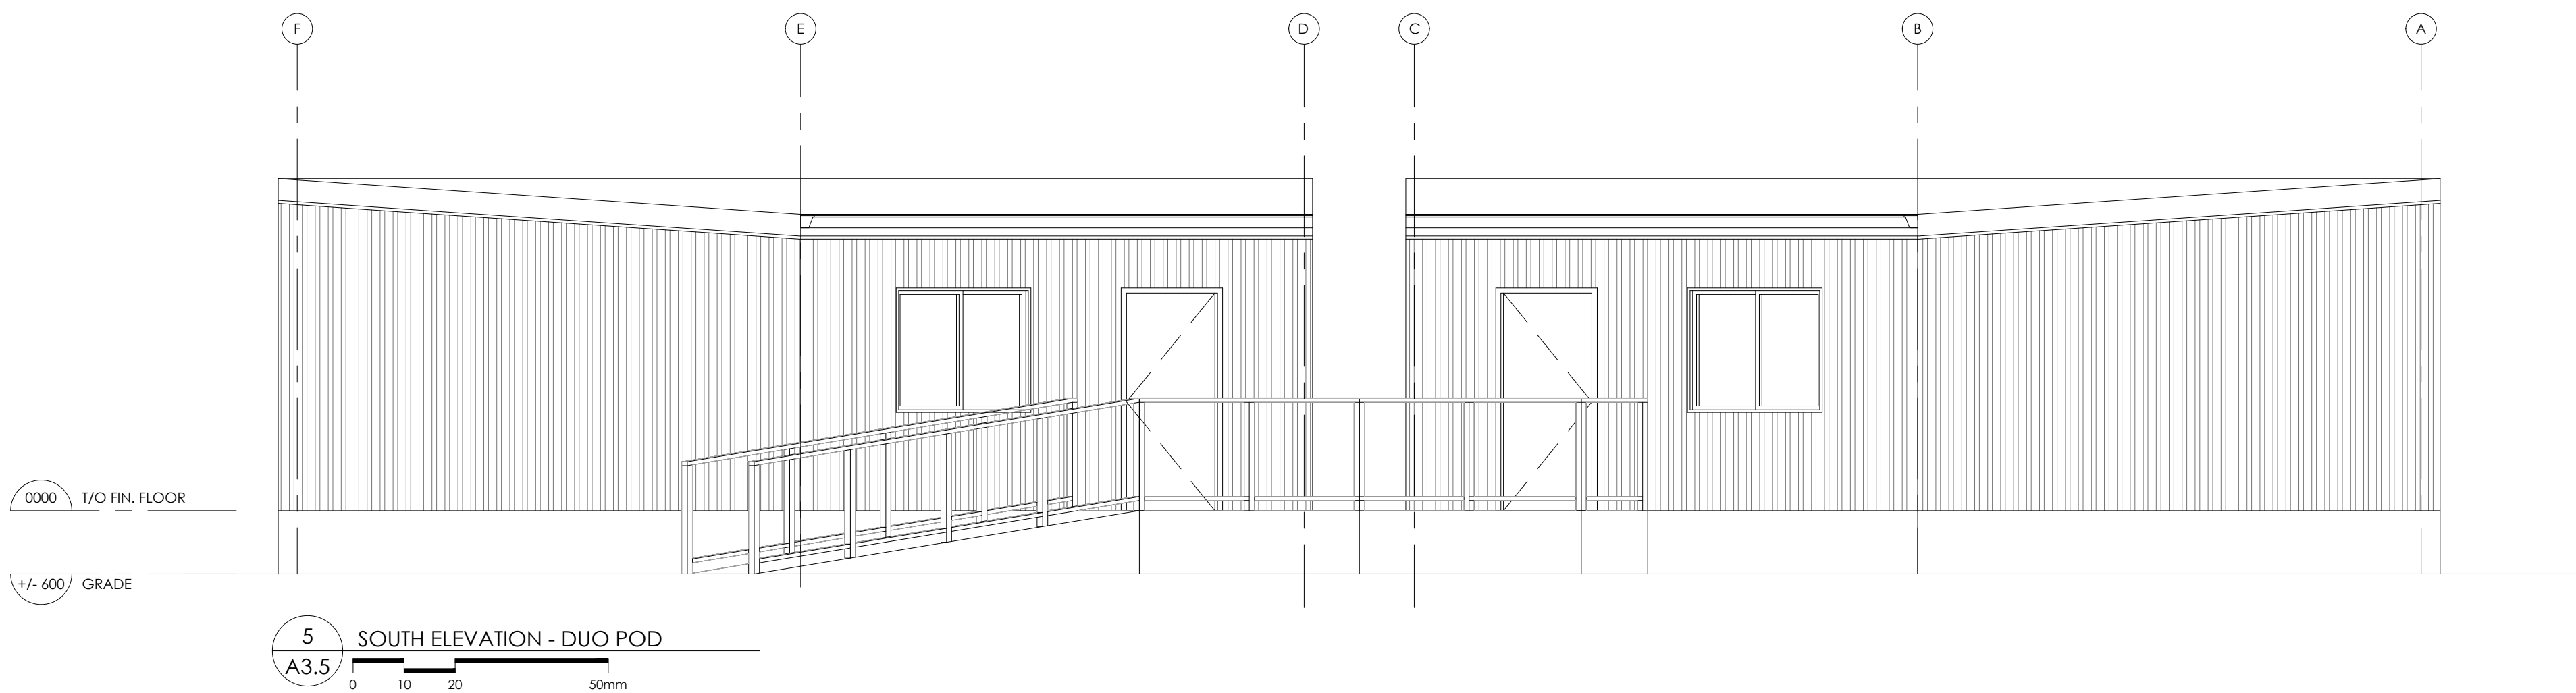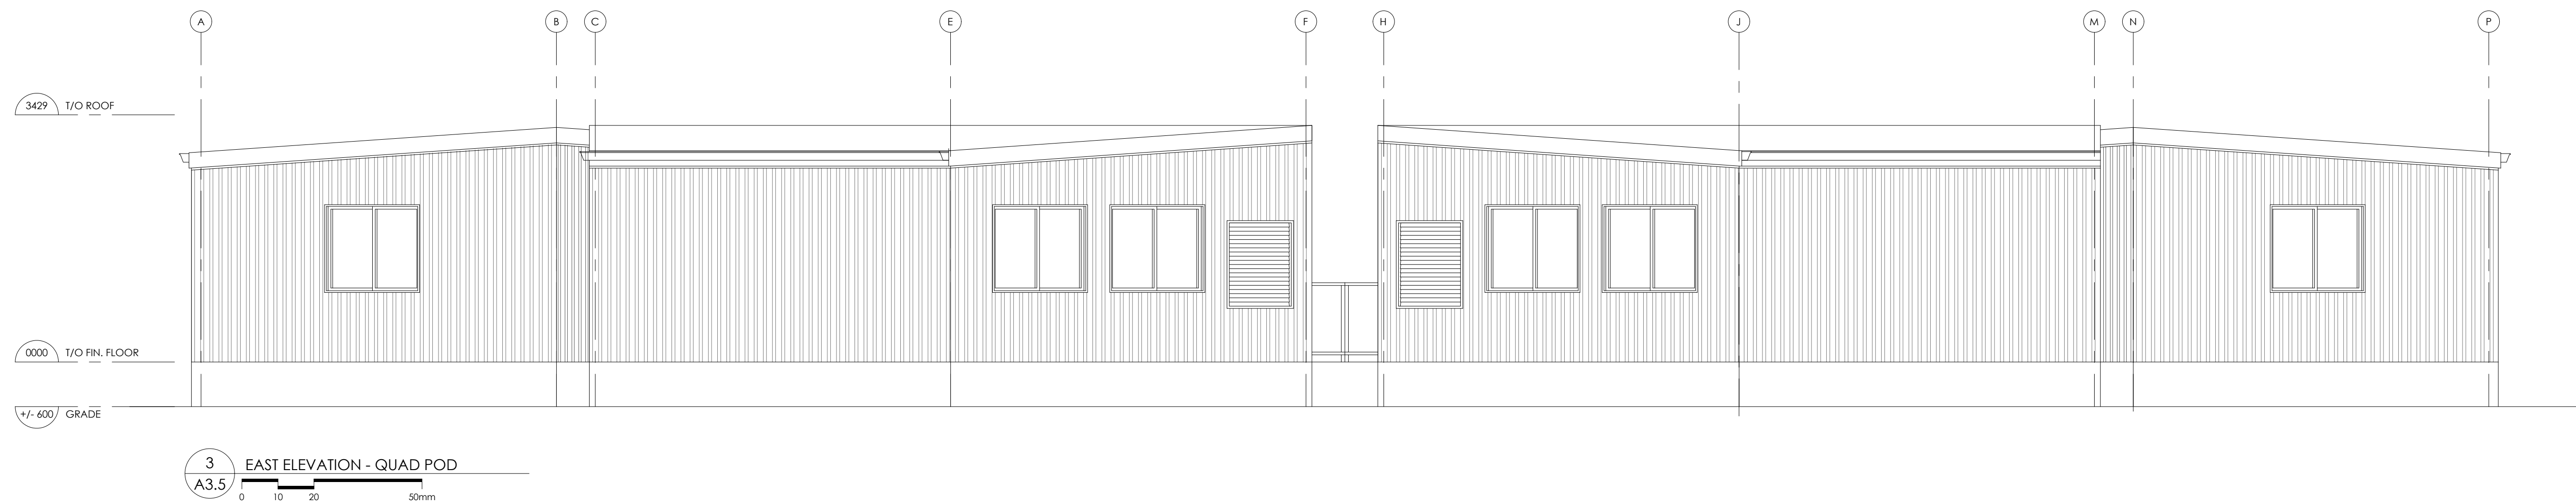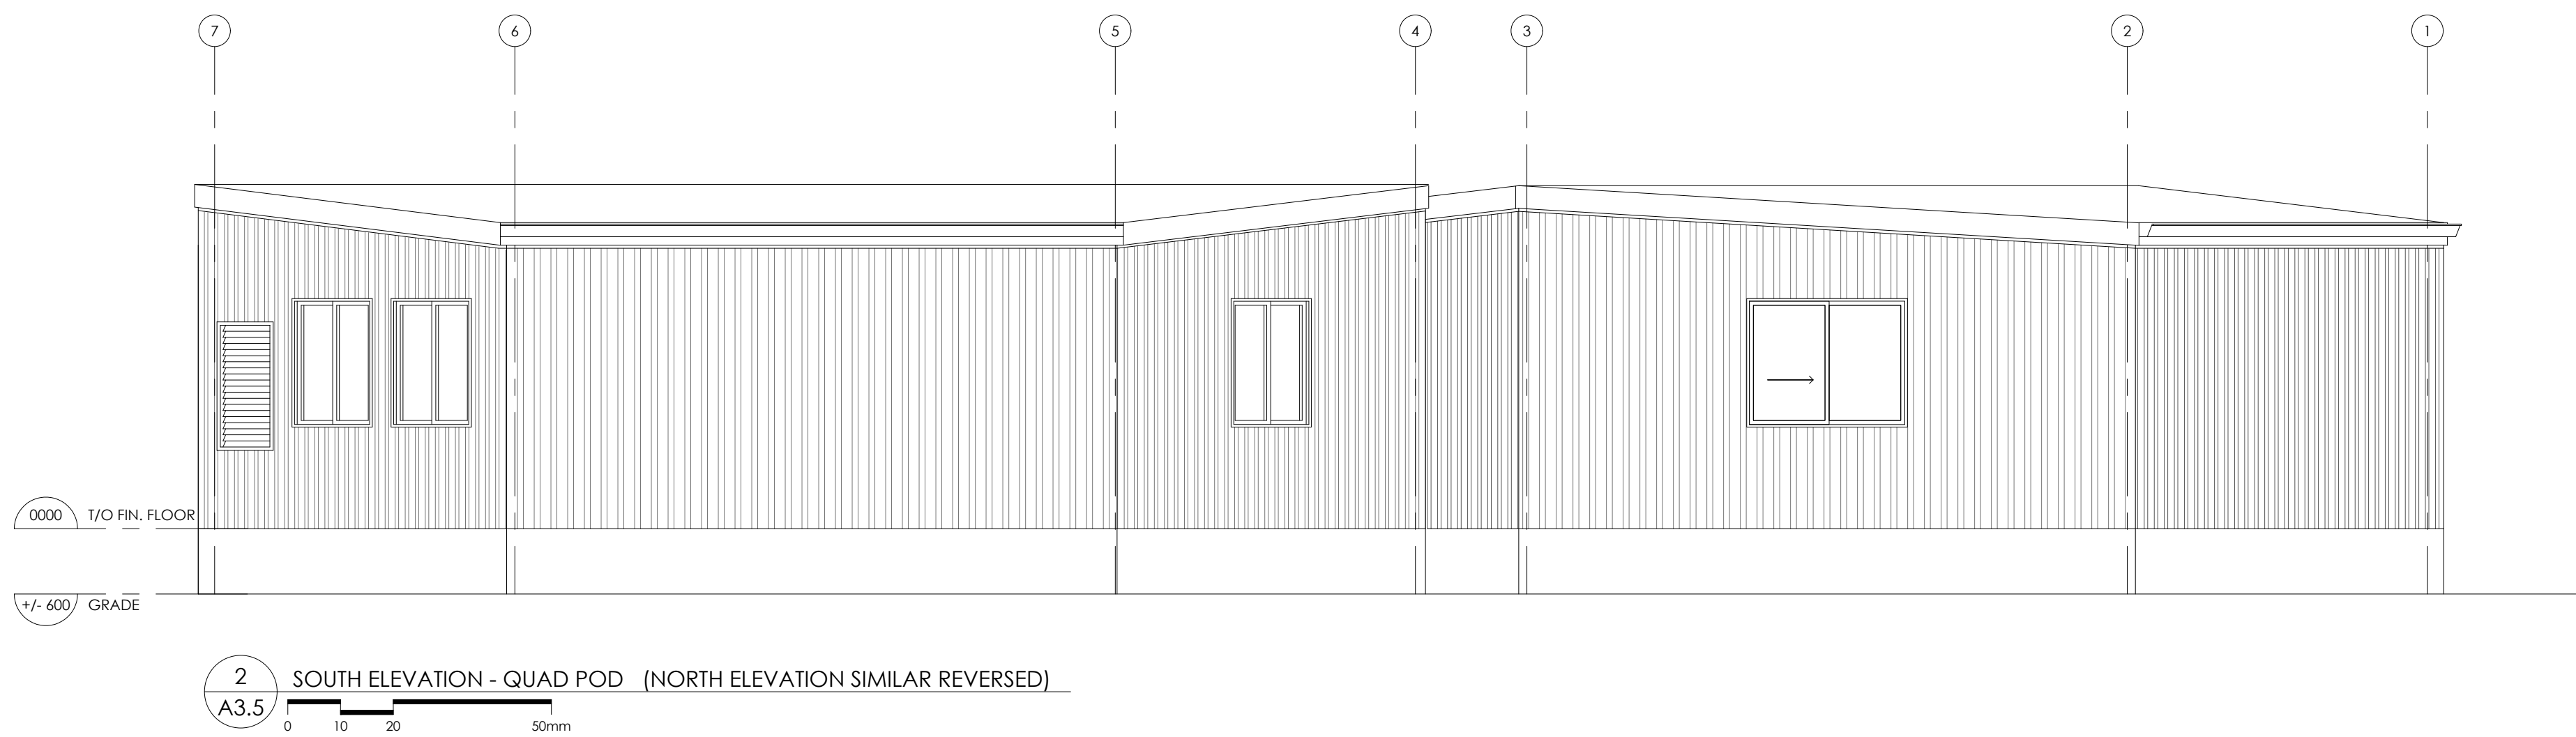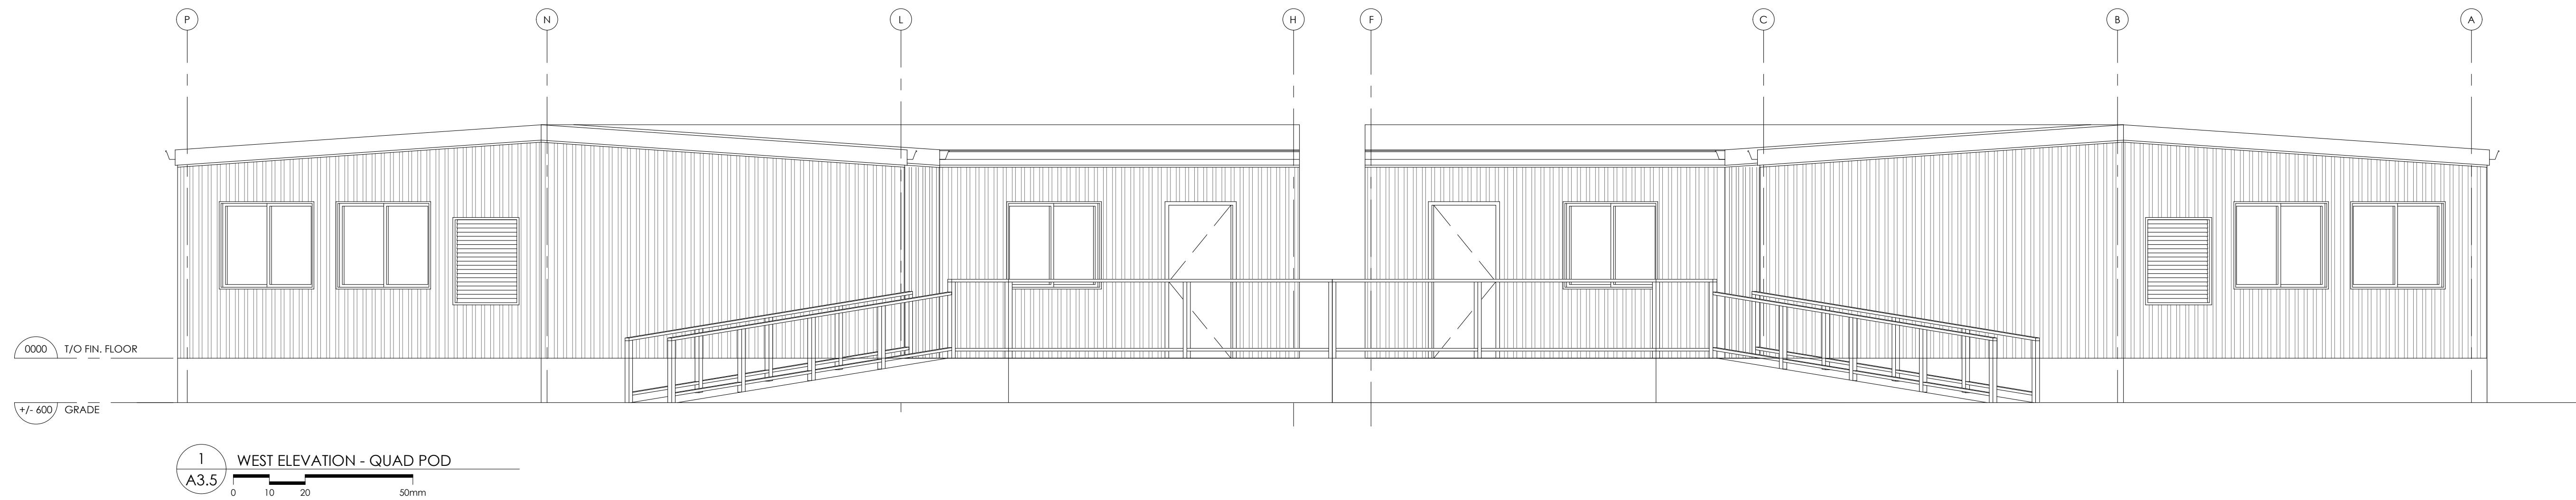

HEXPOD PORTABLE CLASSROOM DRAWINGS ARE SHOWN HERE FOR REFERENCE ONLY. PORTABLE CLASSROOMS TO BE PROVIDED BY EBS SHOP DRAWING PROVIDED WITH PERMIT PACKAGE. PAID FOR OUT OF THE CASH ALLOWANCE.

REVISIONS		
NO.	DATE	PARTICULAR
1	2022.04.06	ISSUED FOR 805 CLASS B COSTING
2	2022.06.18	ISSUED FOR SPA
3	2022.09.22	ISSUED FOR OWNERS REVIEW - RFS SET
4	2022.12.16	ISSUED FOR 2ND SPA SUBMISSION
5	2023.01.31	ISSUED FOR TENDER
6	2023.02.22	ISSUED FOR ADDENDUM 9
7	2023.08.23	ISSUED FOR CONVENIENCE
8	2023.11.20	ISSUED FOR PERMIT COMMENTS
9	2024.07.24	ISSUED FOR PERMIT COMMENTS
10	2024.02.15	ISSUED FOR PCN#308
11	2024.03.04	ISSUED FOR PCN#309
12	2024.03.10	ISSUED FOR SH#04
13	2024.05.14	ISSUED FOR SH#04
14	2024.07.22	ISSUED FOR SH#08
15	2024.08.07	ISSUED FOR SH#09
16	2024.10.02	ISSUED FOR PCN#15
17	2025.04.11	ISSUED FOR PCN#19
18	2025.05.01	ISSUED FOR CO#57
19	2025.05.28	ISSUED FOR PCN#20 - CO#10
20	2025.07.31	ISSUED FOR SH#13
21	2025.08.06	ISSUED FOR SH#14
22	2025.08.15	ISSUED FOR PCN#25 - CO#17
23	2025.08.25	ISSUED FOR PCN#27 - CO#21
24	2025.09.02	ISSUED FOR PCN#29
25	2025.09.02	ISSUED FOR SH#20 - CO#18
26	2025.09.08	ISSUED FOR PCN#31
27	2025.09.09	ISSUED FOR PCN#32 - CO#22
28	2025.09.10	ISSUED FOR PCN#33
29	2025.09.11	ISSUED FOR SH#22
30	2025.09.15	ISSUED FOR SH#23
31	2025.09.16	ISSUED FOR PCN #35 - CO#23
32	2025.09.30	ISSUED FOR PCN #37 - CO#19
33	2025.09.30	ISSUED FOR PCN #38 - CO#25
34	2025.10.04	ISSUED FOR PCN #39 - CO#24
35	2025.10.20	ISSUED FOR PCN #40
36	2025.10.30	ISSUED FOR PCN#41
37	2025.10.23	ISSUED FOR PCN #42
38	2025.11.21	ISSUED FOR PCN#221#1 - CO12 CO#26
39	2025.11.14	ISSUED FOR PCN#43
40	2025.11.26	ISSUED FOR PCN#43#1
41	2025.12.03	ISSUED FOR PCN#44 - CO#26
42	2026.02.04	ISSUED FOR RECORD SET UP TO CO#27

NOTES:

KEY PLAN:



CLIENT:

NEAR NORTH DISTRICT SCHOOL BOARD
NND58 Tender # 2023-015

PROJECT:

NEW PARRY SOUND K-12 SCHOOL & CHILDCARE

PARRY SOUND HIGH SCHOOL SITE

111 ISABELLA STREET
PARRY SOUND, ONTARIO

ORIGINAL PAGE SIZE ARCH E1 - 30" x 42"
KEY TO DETAIL LOCATION:
A - DETAIL NO.
B - DETAIL NO. ORIGIN



A3.3

DRAWN BY : SR






CHECKED BY : EB

HEX PODS - ELEVATIONS (CASH ALLOWANCE)

Reproduction of drawings and related documents in whole or in part is prohibited without written permission of the design firm.

Filename: K:\TVG\Brandford\Near North DSS\Parry Sound\School\22111\Drawings\Wd\Current\NND-A3.3_HEX Pod Elevations.dwg

Plot Date: Feb 03, 2026 - 5:13pm By: jkelly

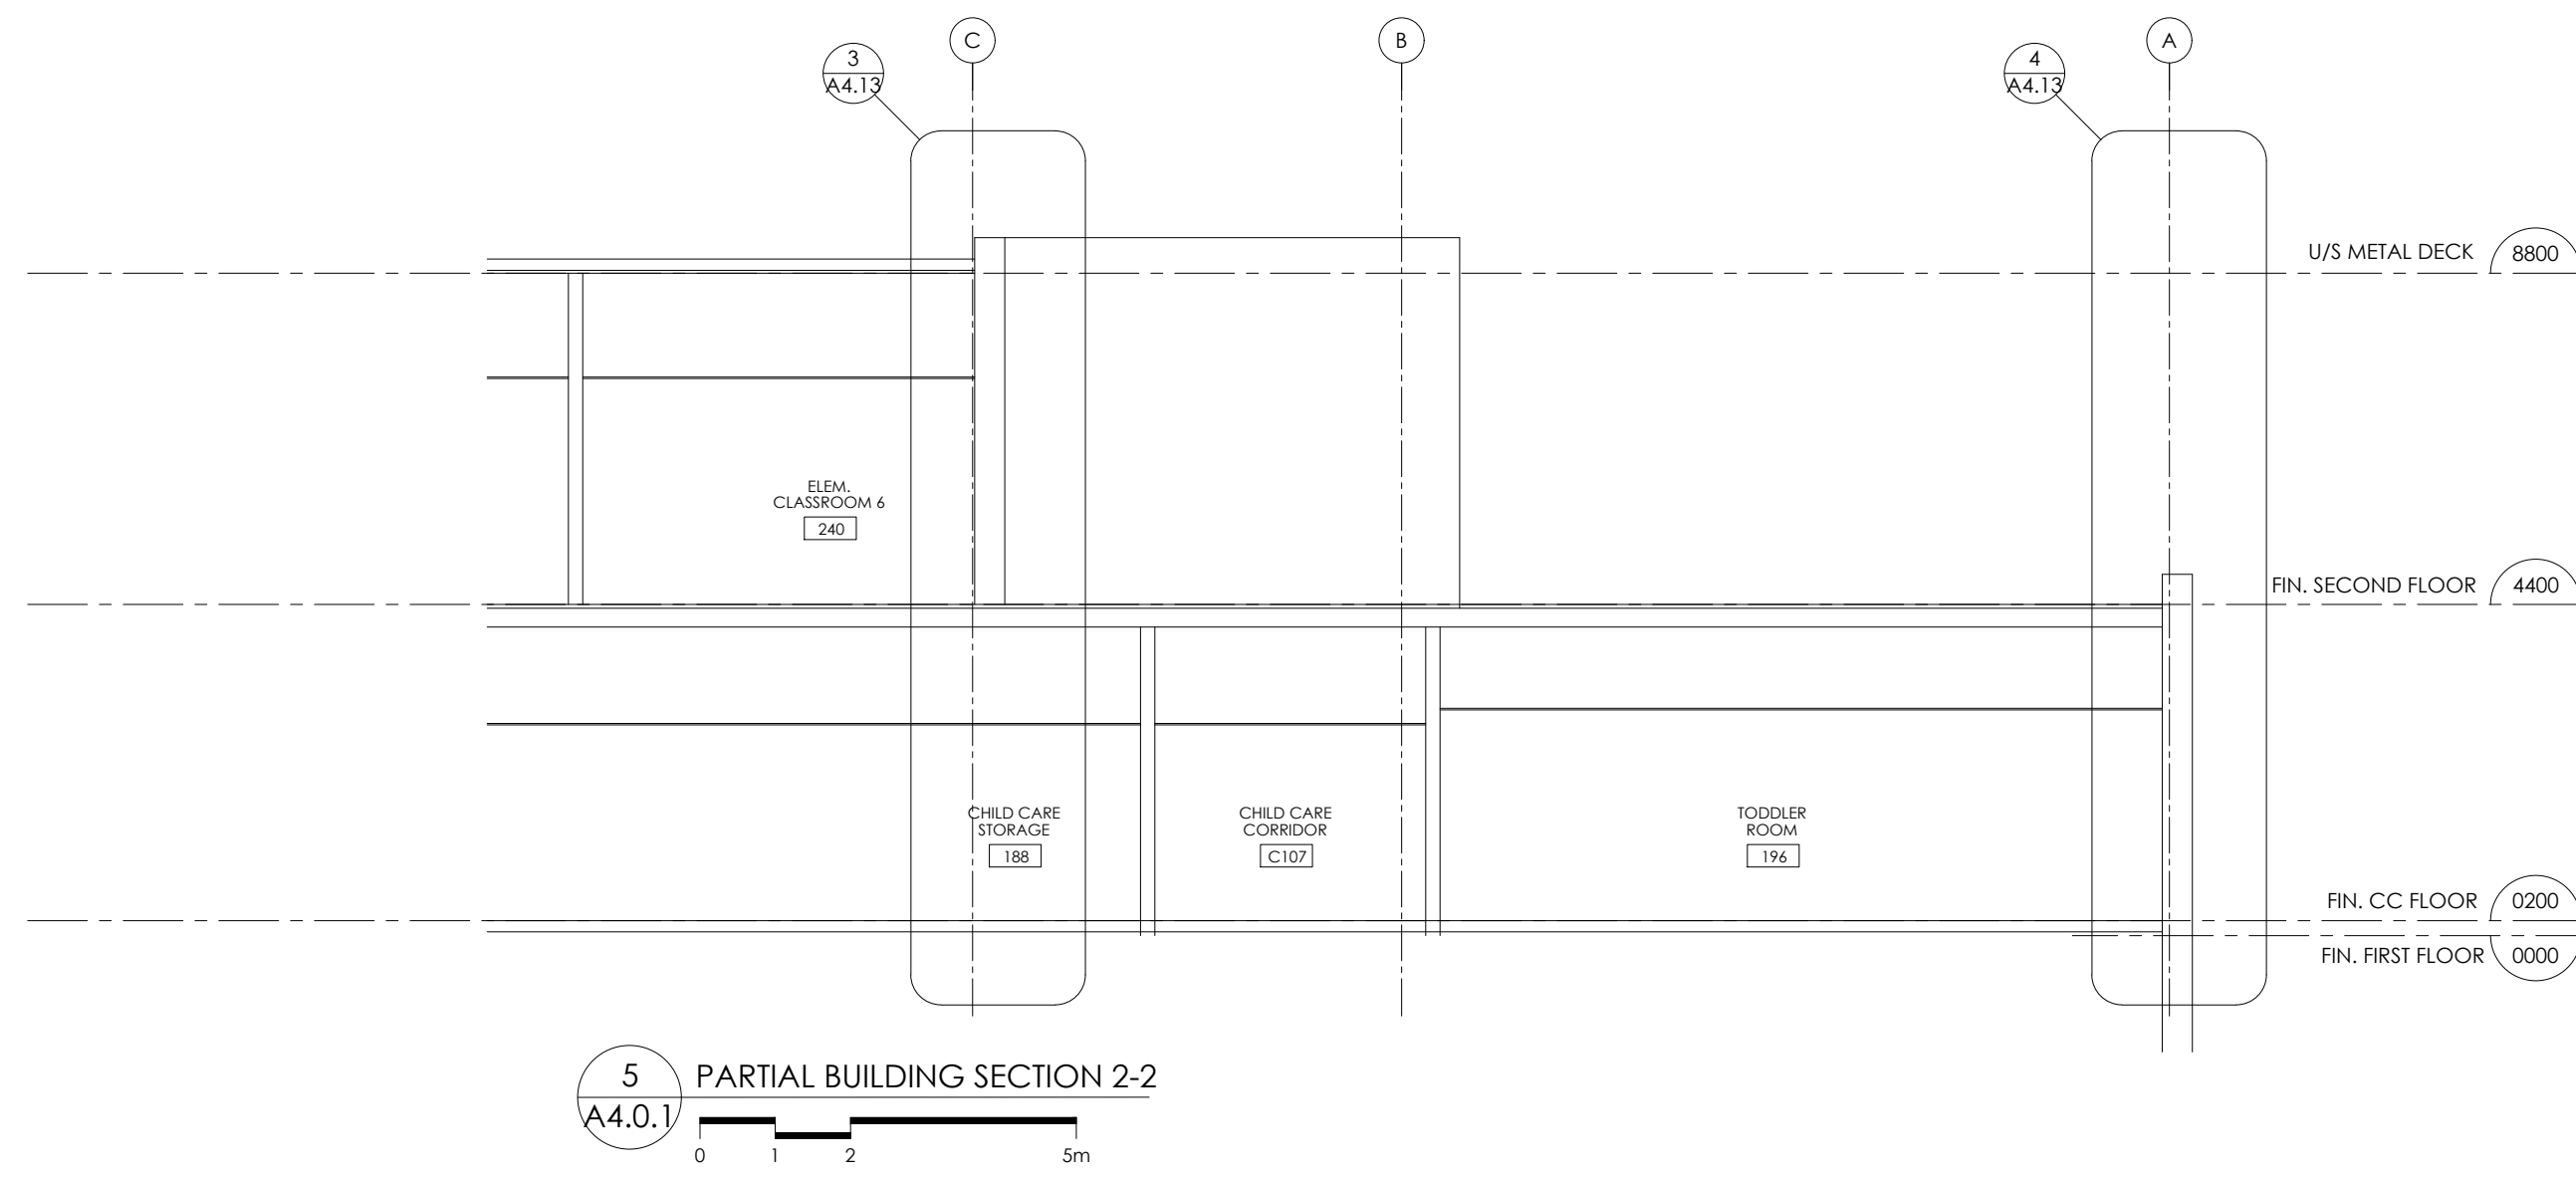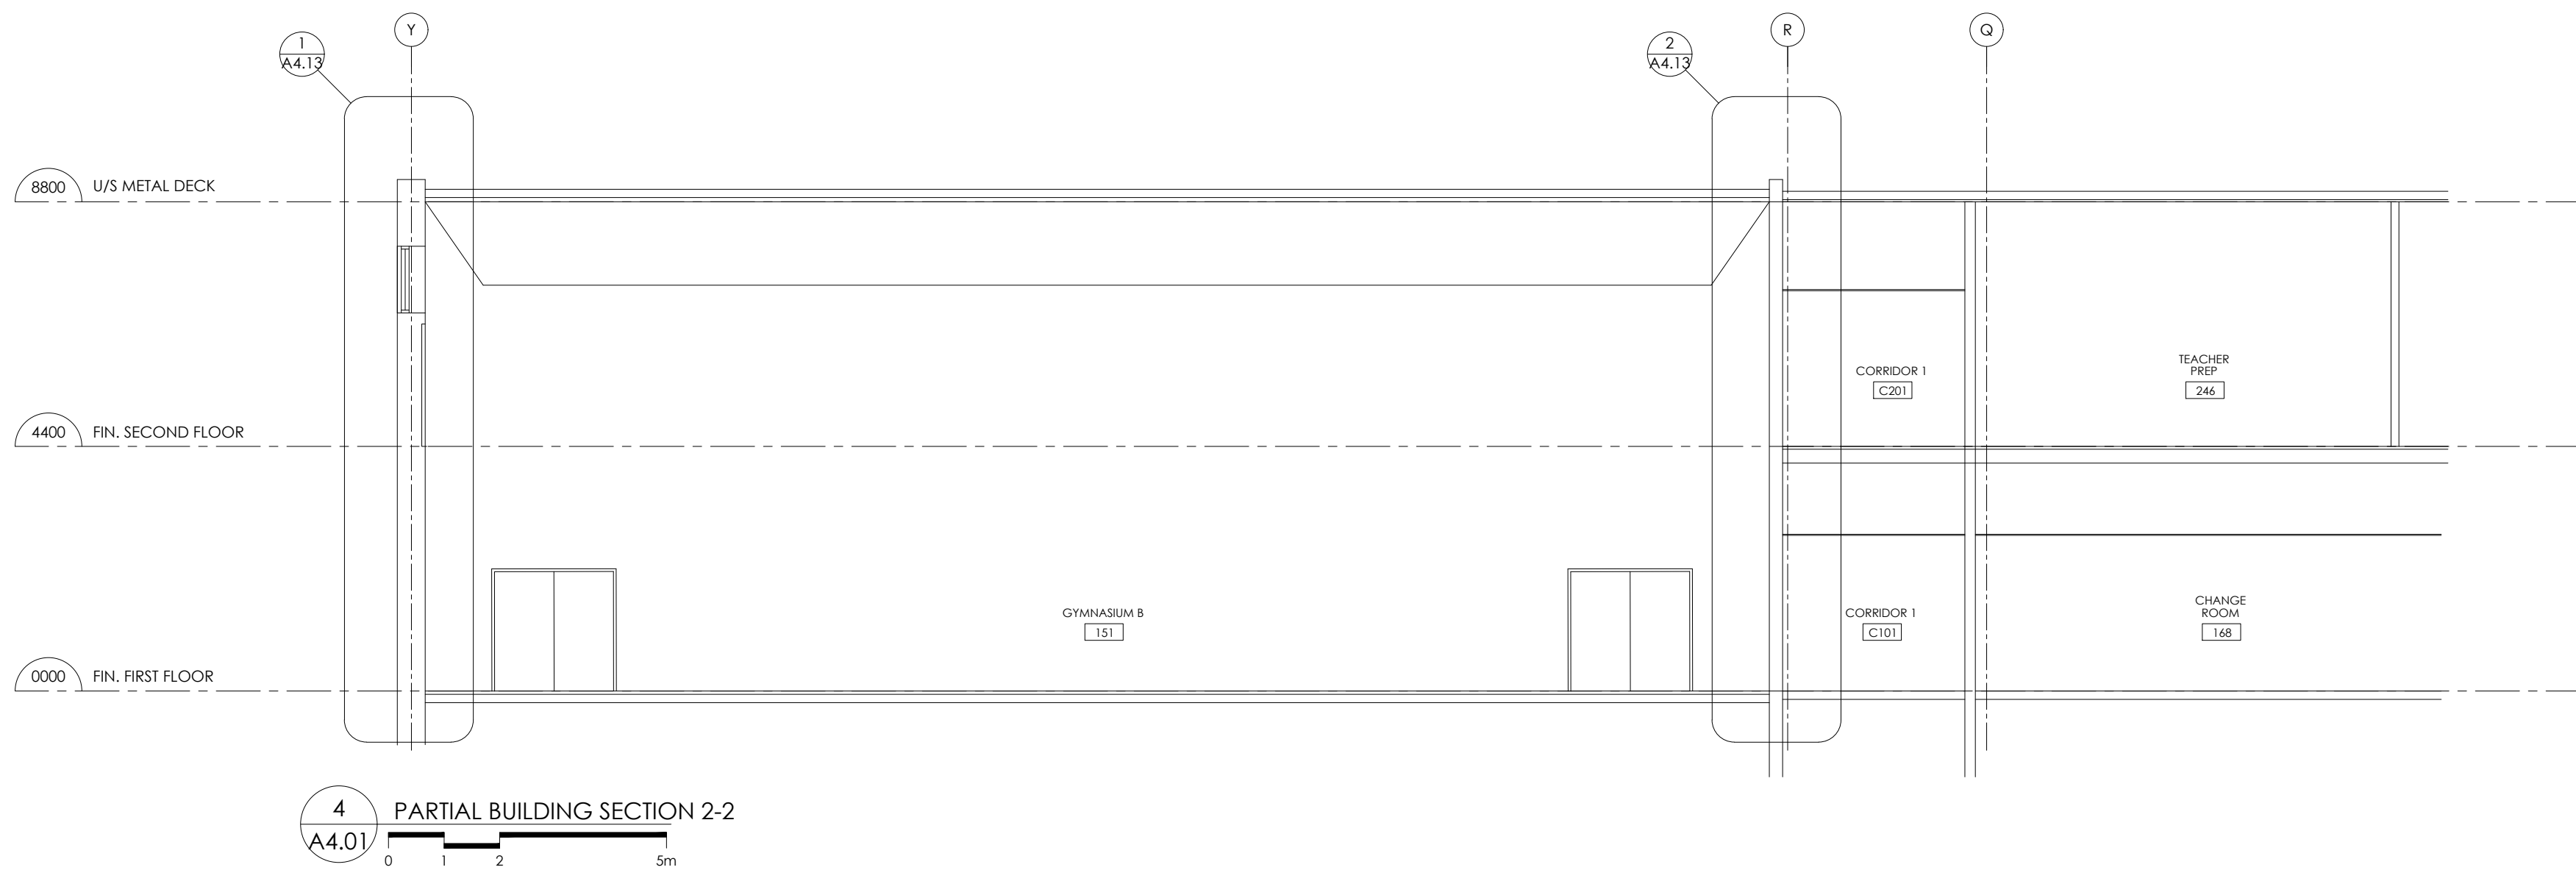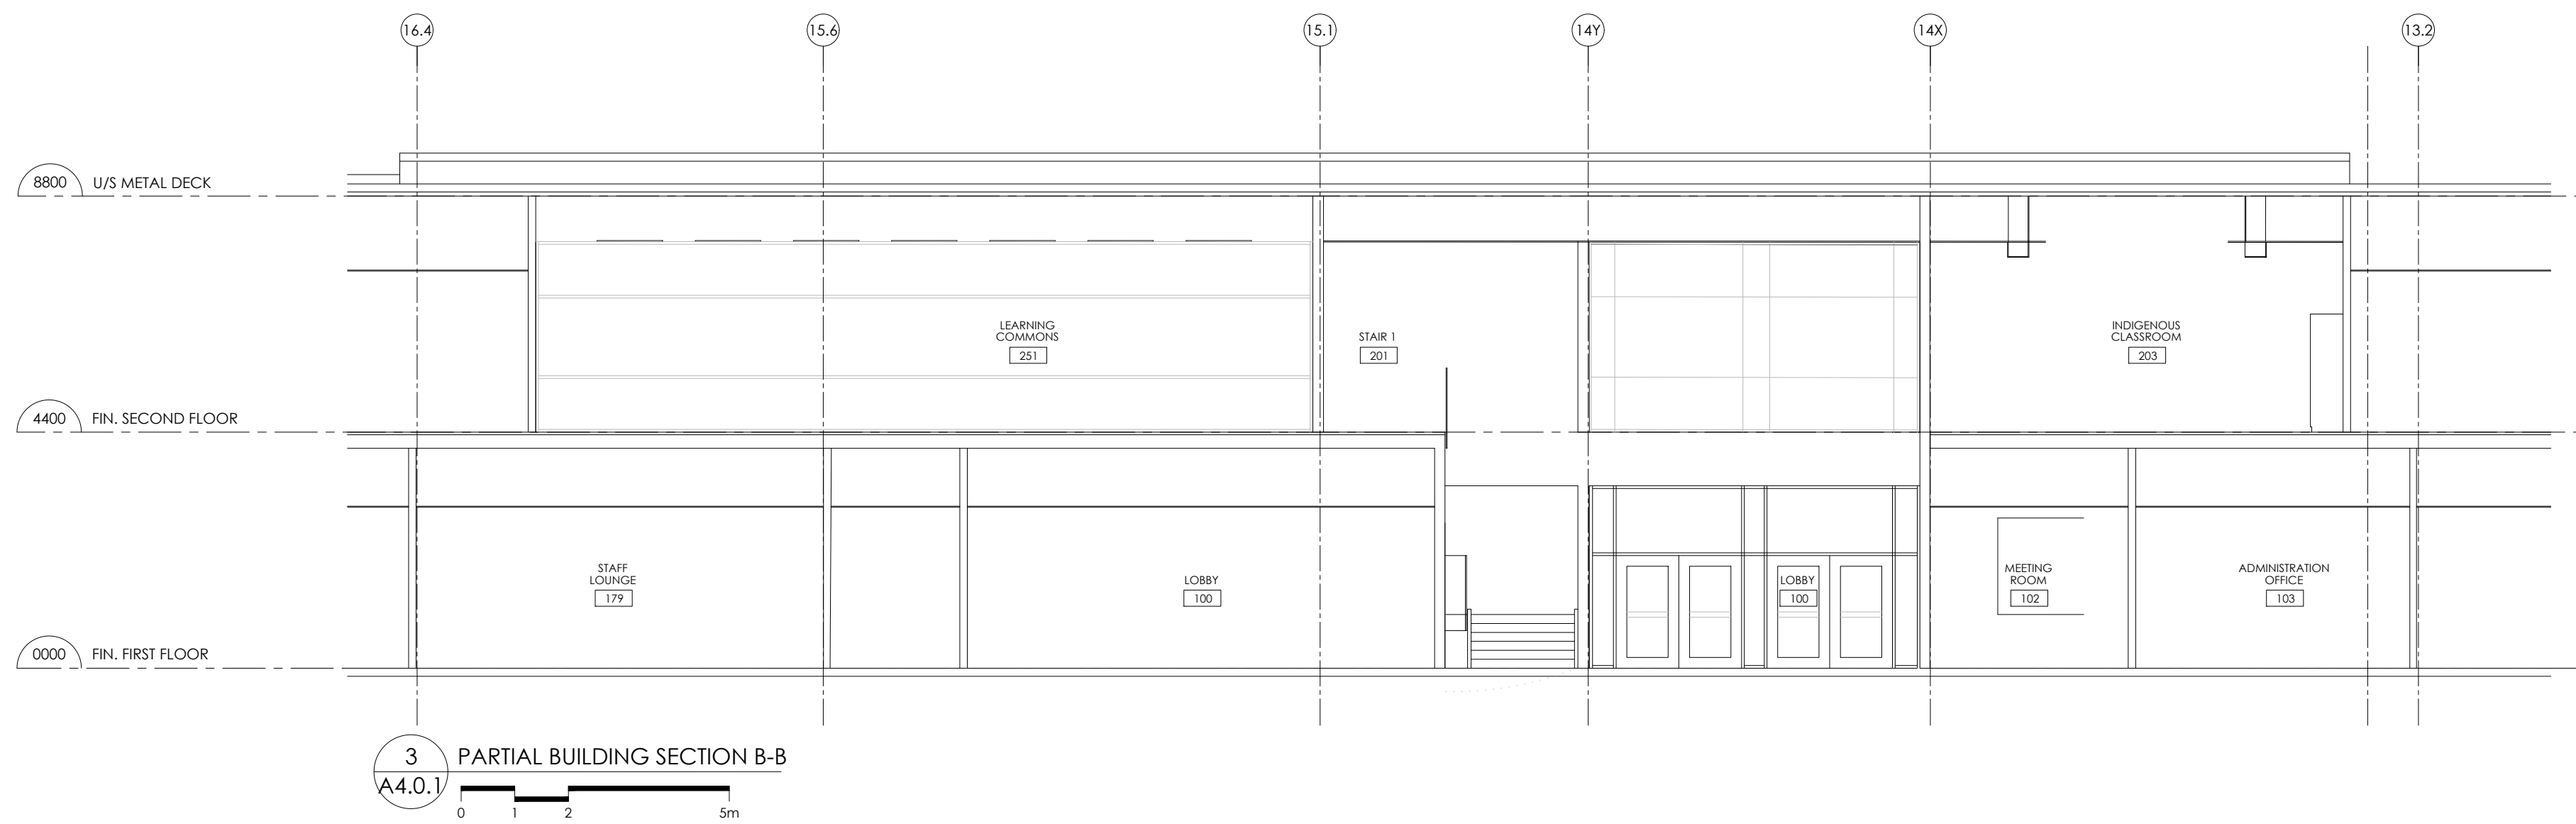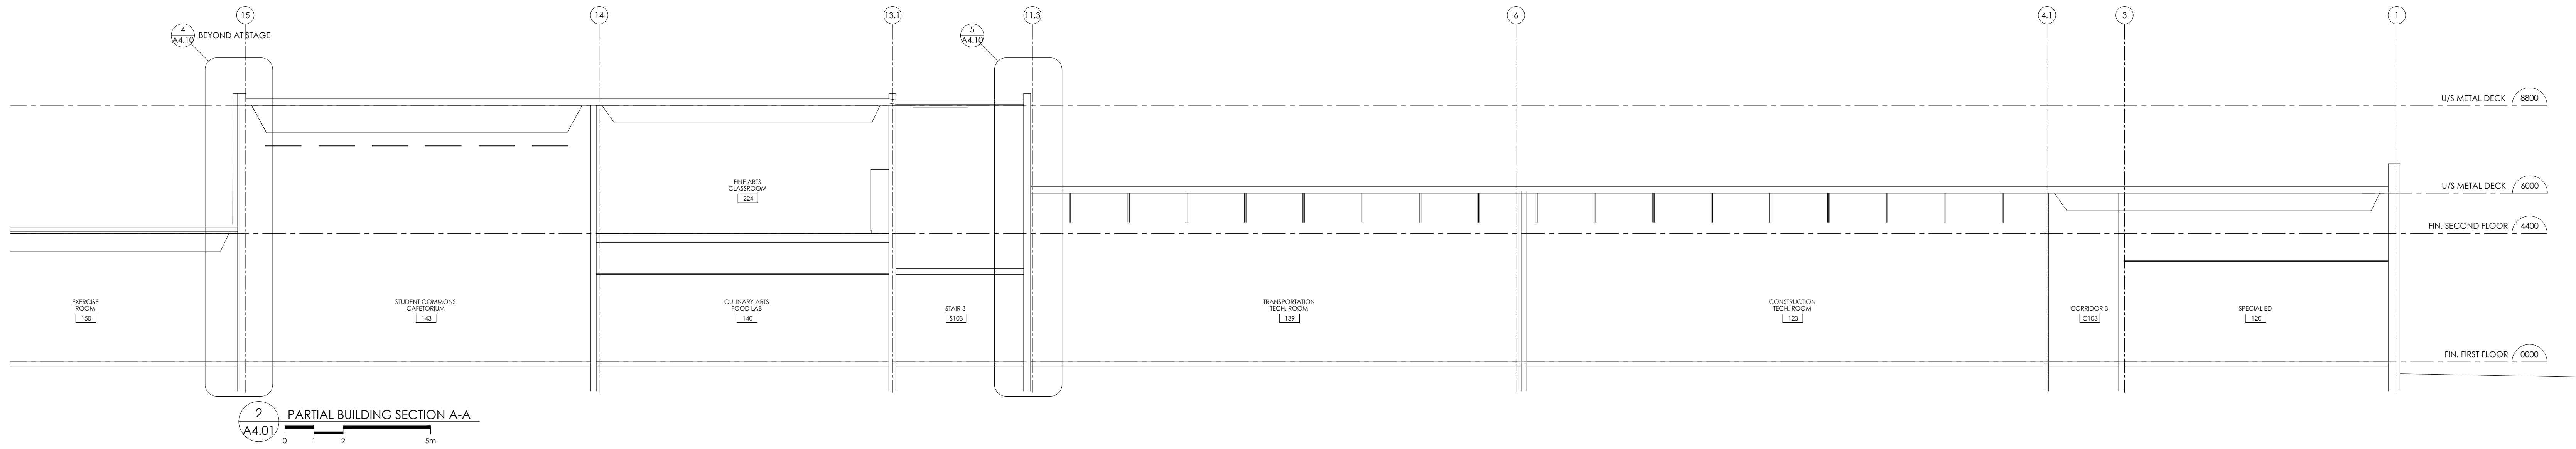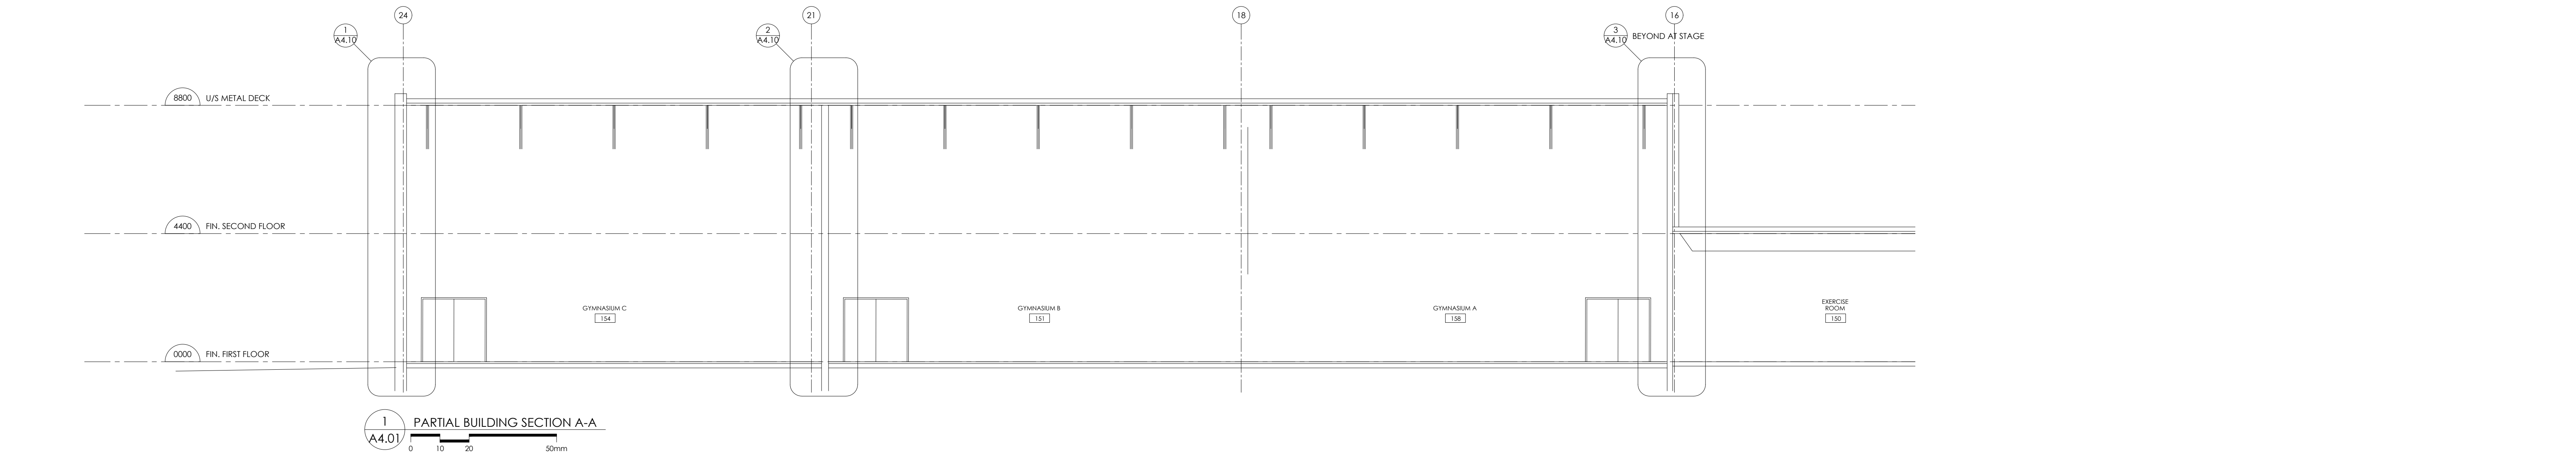

REVISIONS		
NO.	DATE	PARTICULAR
1	2022.04.06	ISSUED FOR 805 CLASS B COSTING
2	2022.06.18	ISSUED FOR SPA
3	2022.09.22	ISSUED FOR OWNERS REVIEW - RFS SET
4	2022.12.16	ISSUED FOR 2ND SPA SUBMISSION
5	2023.01.31	ISSUED FOR TENDER
6	2023.02.22	ISSUED FOR ADDENDUM 9
7	2023.08.23	ISSUED FOR CONVENIENCE
8	2023.11.20	ISSUED FOR PERMIT COMMENTS
9	2024.01.24	ISSUED FOR SH03
10	2024.02.15	ISSUED FOR PCN#08
11	2024.03.04	ISSUED FOR PCN#09
12	2024.03.10	ISSUED FOR SH04
13	2024.05.14	ISSUED FOR SH04
14	2024.07.22	ISSUED FOR SH08
15	2024.08.07	ISSUED FOR SH09
16	2024.10.02	ISSUED FOR PCN#15
17	2025.04.11	ISSUED FOR PCN#019
18	2025.05.01	ISSUED FOR CO#07
19	2025.05.28	ISSUED FOR PCN#20 - CO#010
20	2025.07.31	ISSUED FOR SH013
21	2025.08.06	ISSUED FOR SH014
22	2025.08.15	ISSUED FOR PCN#25 - CO#017
23	2025.08.25	ISSUED FOR PCN#27 - CO#021
24	2025.09.02	ISSUED FOR PCN#29
25	2025.09.02	ISSUED FOR SH00 - CO#018
26	2025.09.08	ISSUED FOR PCN#31
27	2025.09.09	ISSUED FOR PCN#32 - CO#022
28	2025.09.10	ISSUED FOR PCN#33
29	2025.09.11	ISSUED FOR SH022
30	2025.09.15	ISSUED FOR SH023
31	2025.09.16	ISSUED FOR PCN #33 - CO#023
32	2025.09.30	ISSUED FOR PCN #37 - CO#019
33	2025.09.30	ISSUED FOR PCN #38 - CO#025
34	2025.10.04	ISSUED FOR PCN #39 - CO#024
35	2025.10.20	ISSUED FOR PCN #40
36	2025.10.30	ISSUED FOR PCN#041
37	2025.10.23	ISSUED FOR PCN #42
38	2025.11.21	ISSUED FOR PCN#021#1 - CO12 COR04
39	2025.11.14	ISSUED FOR PCN#043
40	2025.11.26	ISSUED FOR PCN#048
41	2025.12.03	ISSUED FOR PCN#044 - CO#026
42	2026.02.04	ISSUED FOR RECORD SET UP TO CO#027

NOTES:

KEY PLAN:



CLIENT:
NEAR NORTH DISTRICT SCHOOL BOARD
NNDSS Tender # 2023-015

PROJECT:
NEW PARRY SOUND K-12 SCHOOL & CHILDCARE
PARRY SOUND HIGH SCHOOL SITE
111 ISABELLA STREET
PARRY SOUND, ONTARIO

ORIGINAL PAGE SIZE ARCH E1 - 30" x 42"
KEY TO DETAIL LOCATION:
A - DETAIL NO.
B - DETAIL NO. ORIGIN

VG ARCHITECTS
THE VENTIN GROUP LTD

A4.01

Plot Date: Feb.03, 2026 - 5:14pm By: Jeky



DRAWN BY: EB

CHECKED BY: PS

SCHEMATIC BUILDING SECTIONS

Reproduction of drawings and related documents in whole or in part is prohibited without written permission of the design group.

All dimensions and measurements must be checked and verified by the Senior Designer.

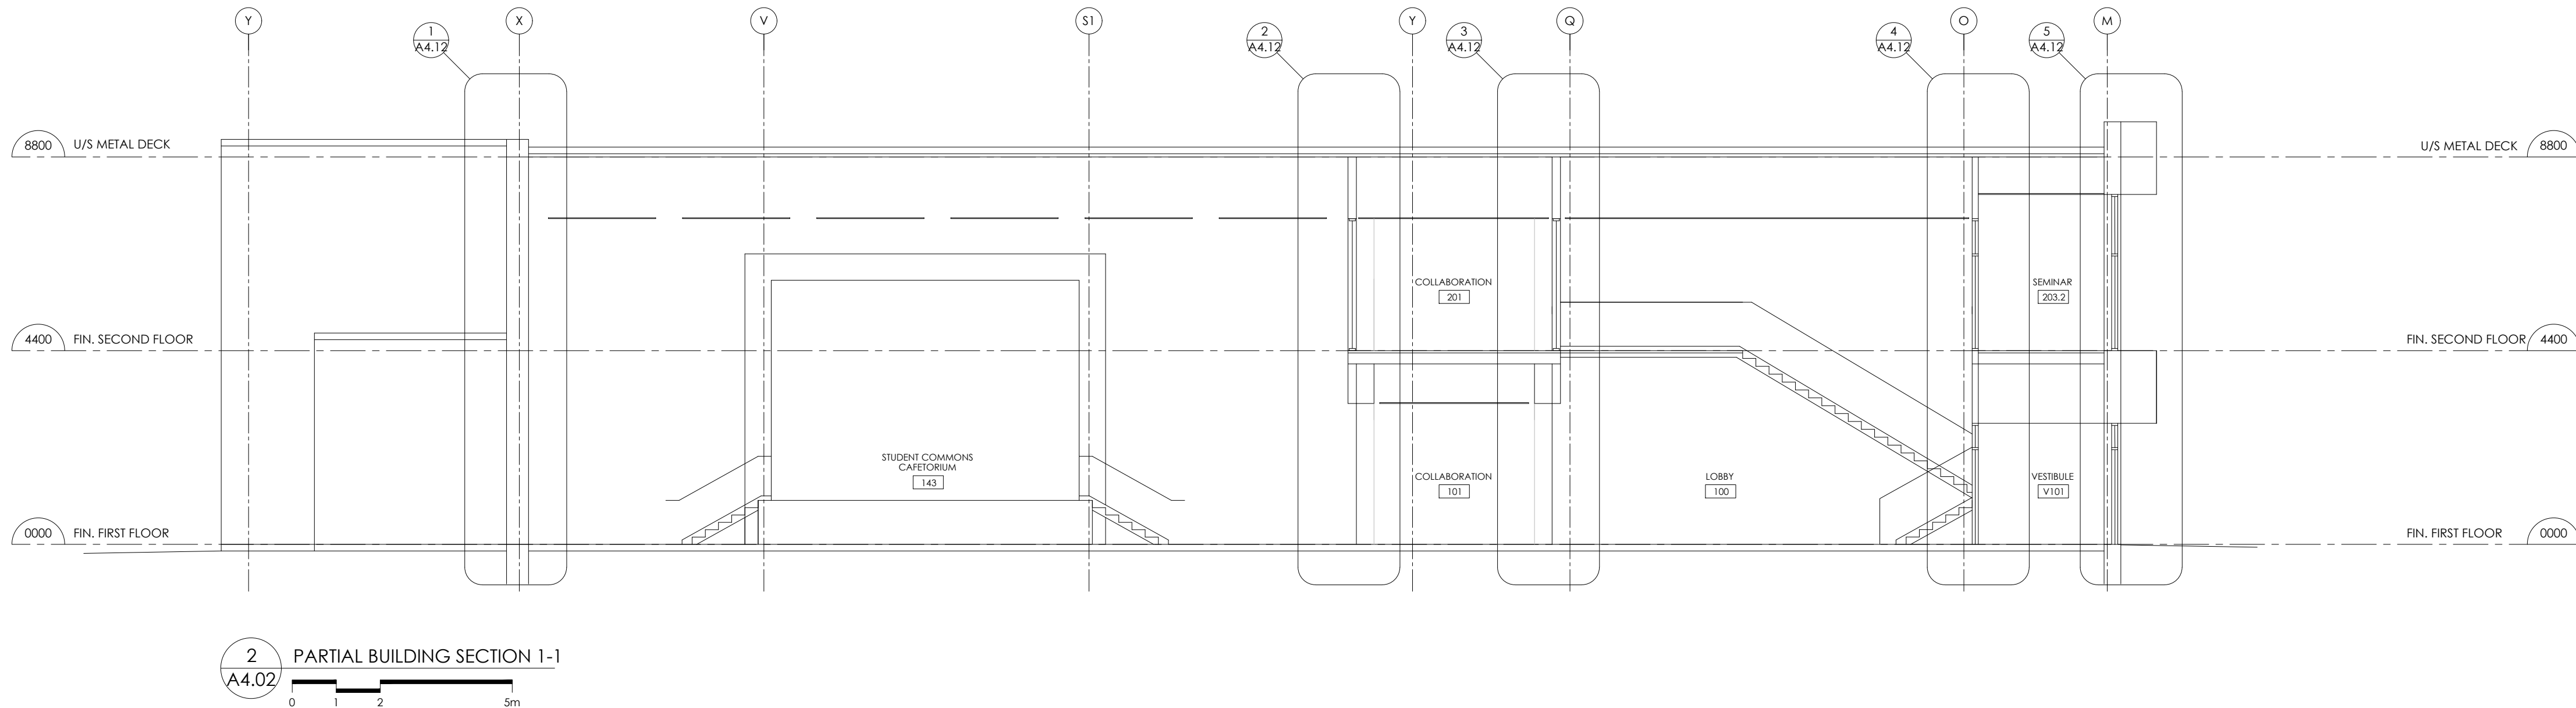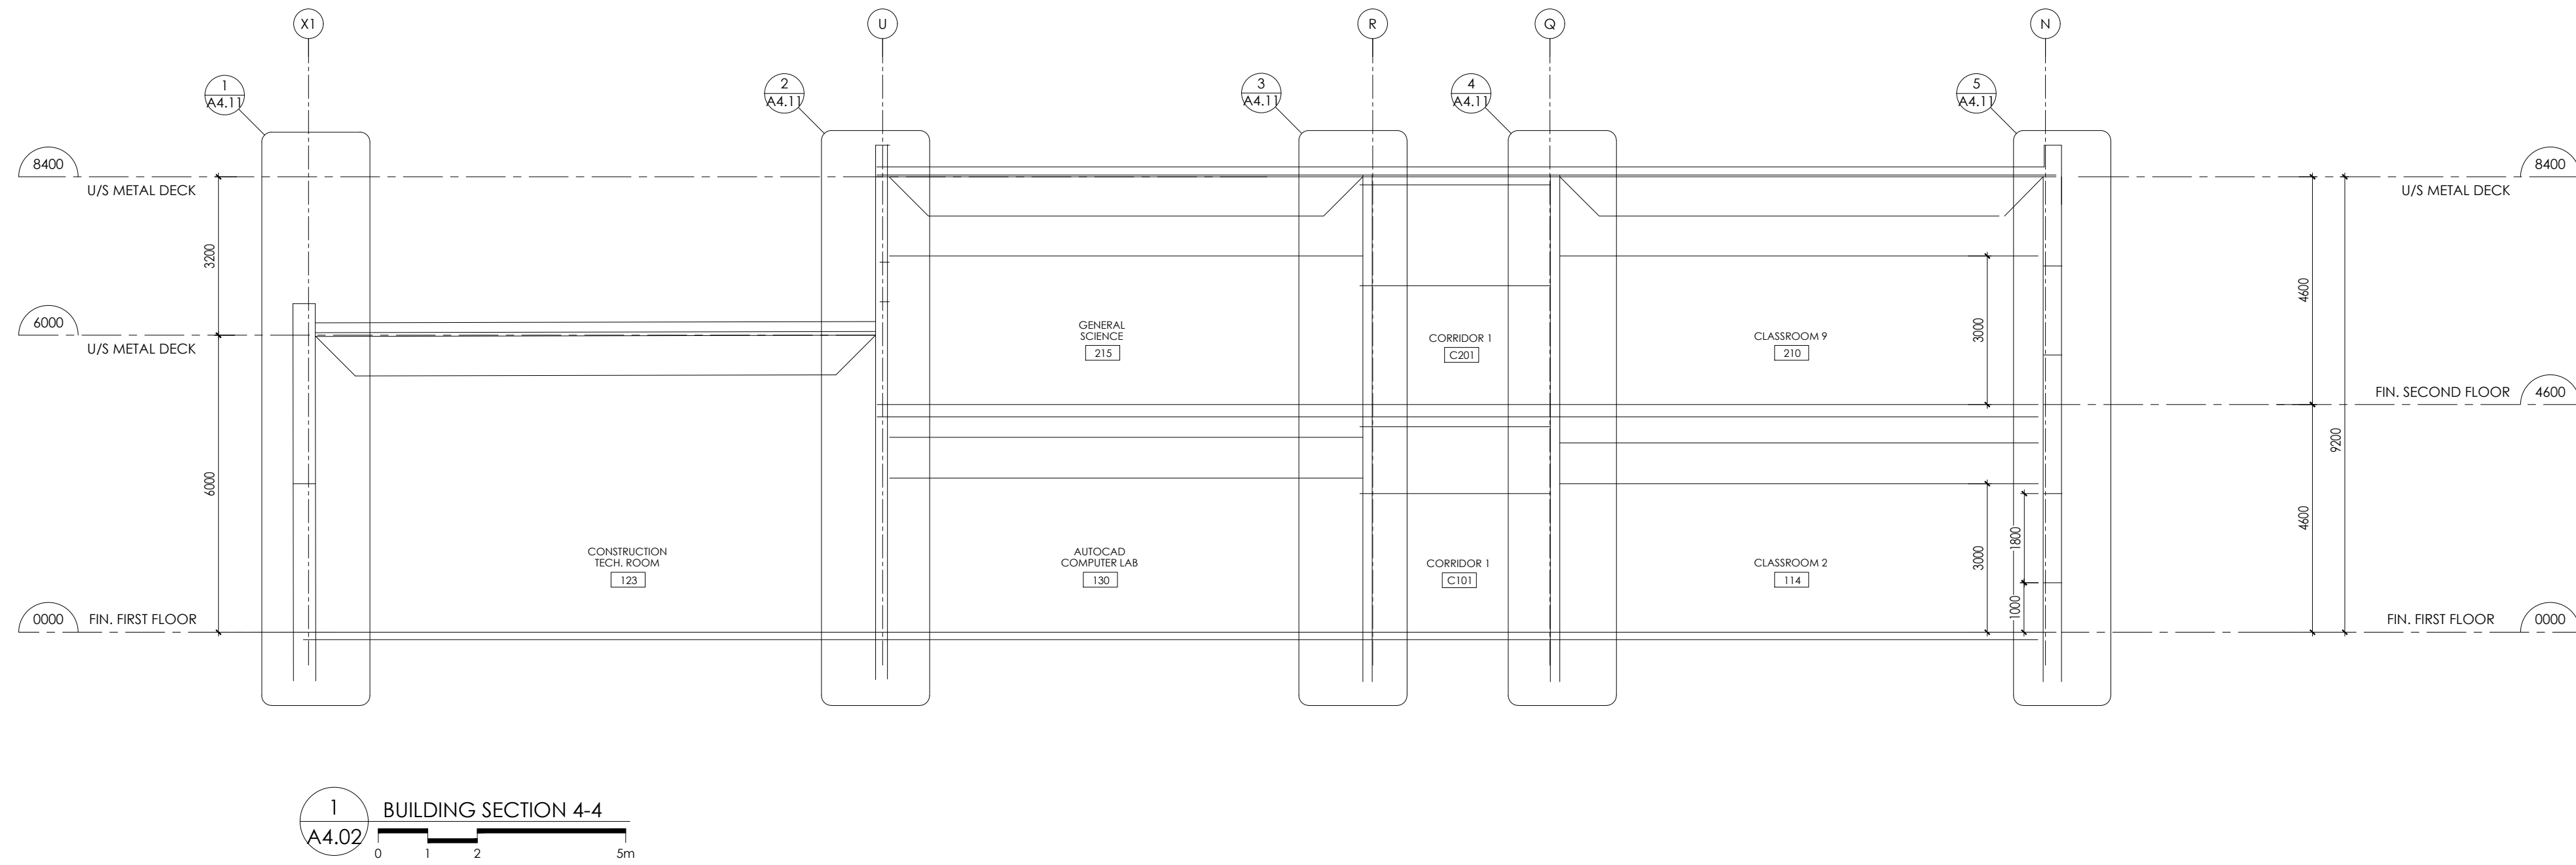

NO.	DATE	PARTICULAR
1	2022.04.06	ISSUED FOR 80% CLASS B COSTING
2	2022.06.18	ISSUED FOR SPA
3	2022.09.22	ISSUED FOR OWNERS REVIEW - RFS SET
4	2022.12.16	ISSUED FOR 2ND SPA SUBMISSION
5	2023.01.31	ISSUED FOR TENDER
6	2023.02.22	ISSUED FOR ADDENDUM 9
7	2023.08.23	ISSUED FOR CONVENIENCE
8	2023.11.20	ISSUED FOR PERMIT COMMENTS
9	2024.01.24	ISSUED FOR SH03
10	2024.02.15	ISSUED FOR PCH0308
11	2024.03.04	ISSUED FOR PCH0309
12	2024.03.10	ISSUED FOR SH004
13	2024.05.14	ISSUED FOR SH004
14	2024.07.22	ISSUED FOR SH008
15	2024.08.07	ISSUED FOR SH009
16	2024.10.02	ISSUED FOR PCH015
17	2025.04.11	ISSUED FOR PCH019
18	2025.05.01	ISSUED FOR CO#07
19	2025.05.28	ISSUED FOR PCH020 - CO#010
20	2025.07.31	ISSUED FOR SH013
21	2025.08.06	ISSUED FOR SH014
22	2025.08.15	ISSUED FOR PCH025 - CO#017
23	2025.08.25	ISSUED FOR PCH027 - CO#021
24	2025.09.02	ISSUED FOR PCH029
25	2025.09.02	ISSUED FOR SH020 - CO#018
26	2025.09.08	ISSUED FOR PCH031
27	2025.09.09	ISSUED FOR PCH032 - CO#022
28	2025.09.10	ISSUED FOR SH023
29	2025.09.11	ISSUED FOR SH022
30	2025.09.15	ISSUED FOR SH023
31	2025.09.16	ISSUED FOR PCH F33 - CO#023
32	2025.09.30	ISSUED FOR PCH F37 - CO#019
33	2025.09.30	ISSUED FOR PCH F38 - CO#025
34	2025.10.04	ISSUED FOR PCH F39 - CO#024
35	2025.10.20	ISSUED FOR PCH F40#1
36	2025.10.30	ISSUED FOR PCH041
37	2025.10.23	ISSUED FOR PCH F42
38	2025.11.21	ISSUED FOR PCH021#1 - CO12 CO#01
39	2025.11.14	ISSUED FOR PCH043
40	2025.11.26	ISSUED FOR PCH048#1
41	2025.12.03	ISSUED FOR PCH044 - CO#026
42	2026.02.04	ISSUED FOR RECORD SET UP TO CO#027

NOTES:

KEY PLAN:



CLIENT:

NEAR NORTH DISTRICT SCHOOL BOARD
NND\$B Tender # 2023-015

PROJECT:

NEW PARRY SOUND K-12 SCHOOL & CHILDCARE

PARRY SOUND HIGH SCHOOL SITE

111 ISABELLA STREET
PARRY SOUND, ONTARIO

ORIGINAL PAGE SIZE ARCH E1 - 30" x 42"
KEY TO DETAIL LOCATION:
A - DETAIL NO.
B - DETAIL NO. ORIGIN

+VG ARCHITECTS
THE VENTIN GROUP LTD

A4.02


DRAWN BY: EB

CHECKED BY: PS

SCHEMATIC BUILDING SECTIONS

Reproduction of drawings and related documents in whole or in part is
prohibited without written permission of the Ventin Group.

All dimensions and measurements must be
checked and verified by the General Contractor

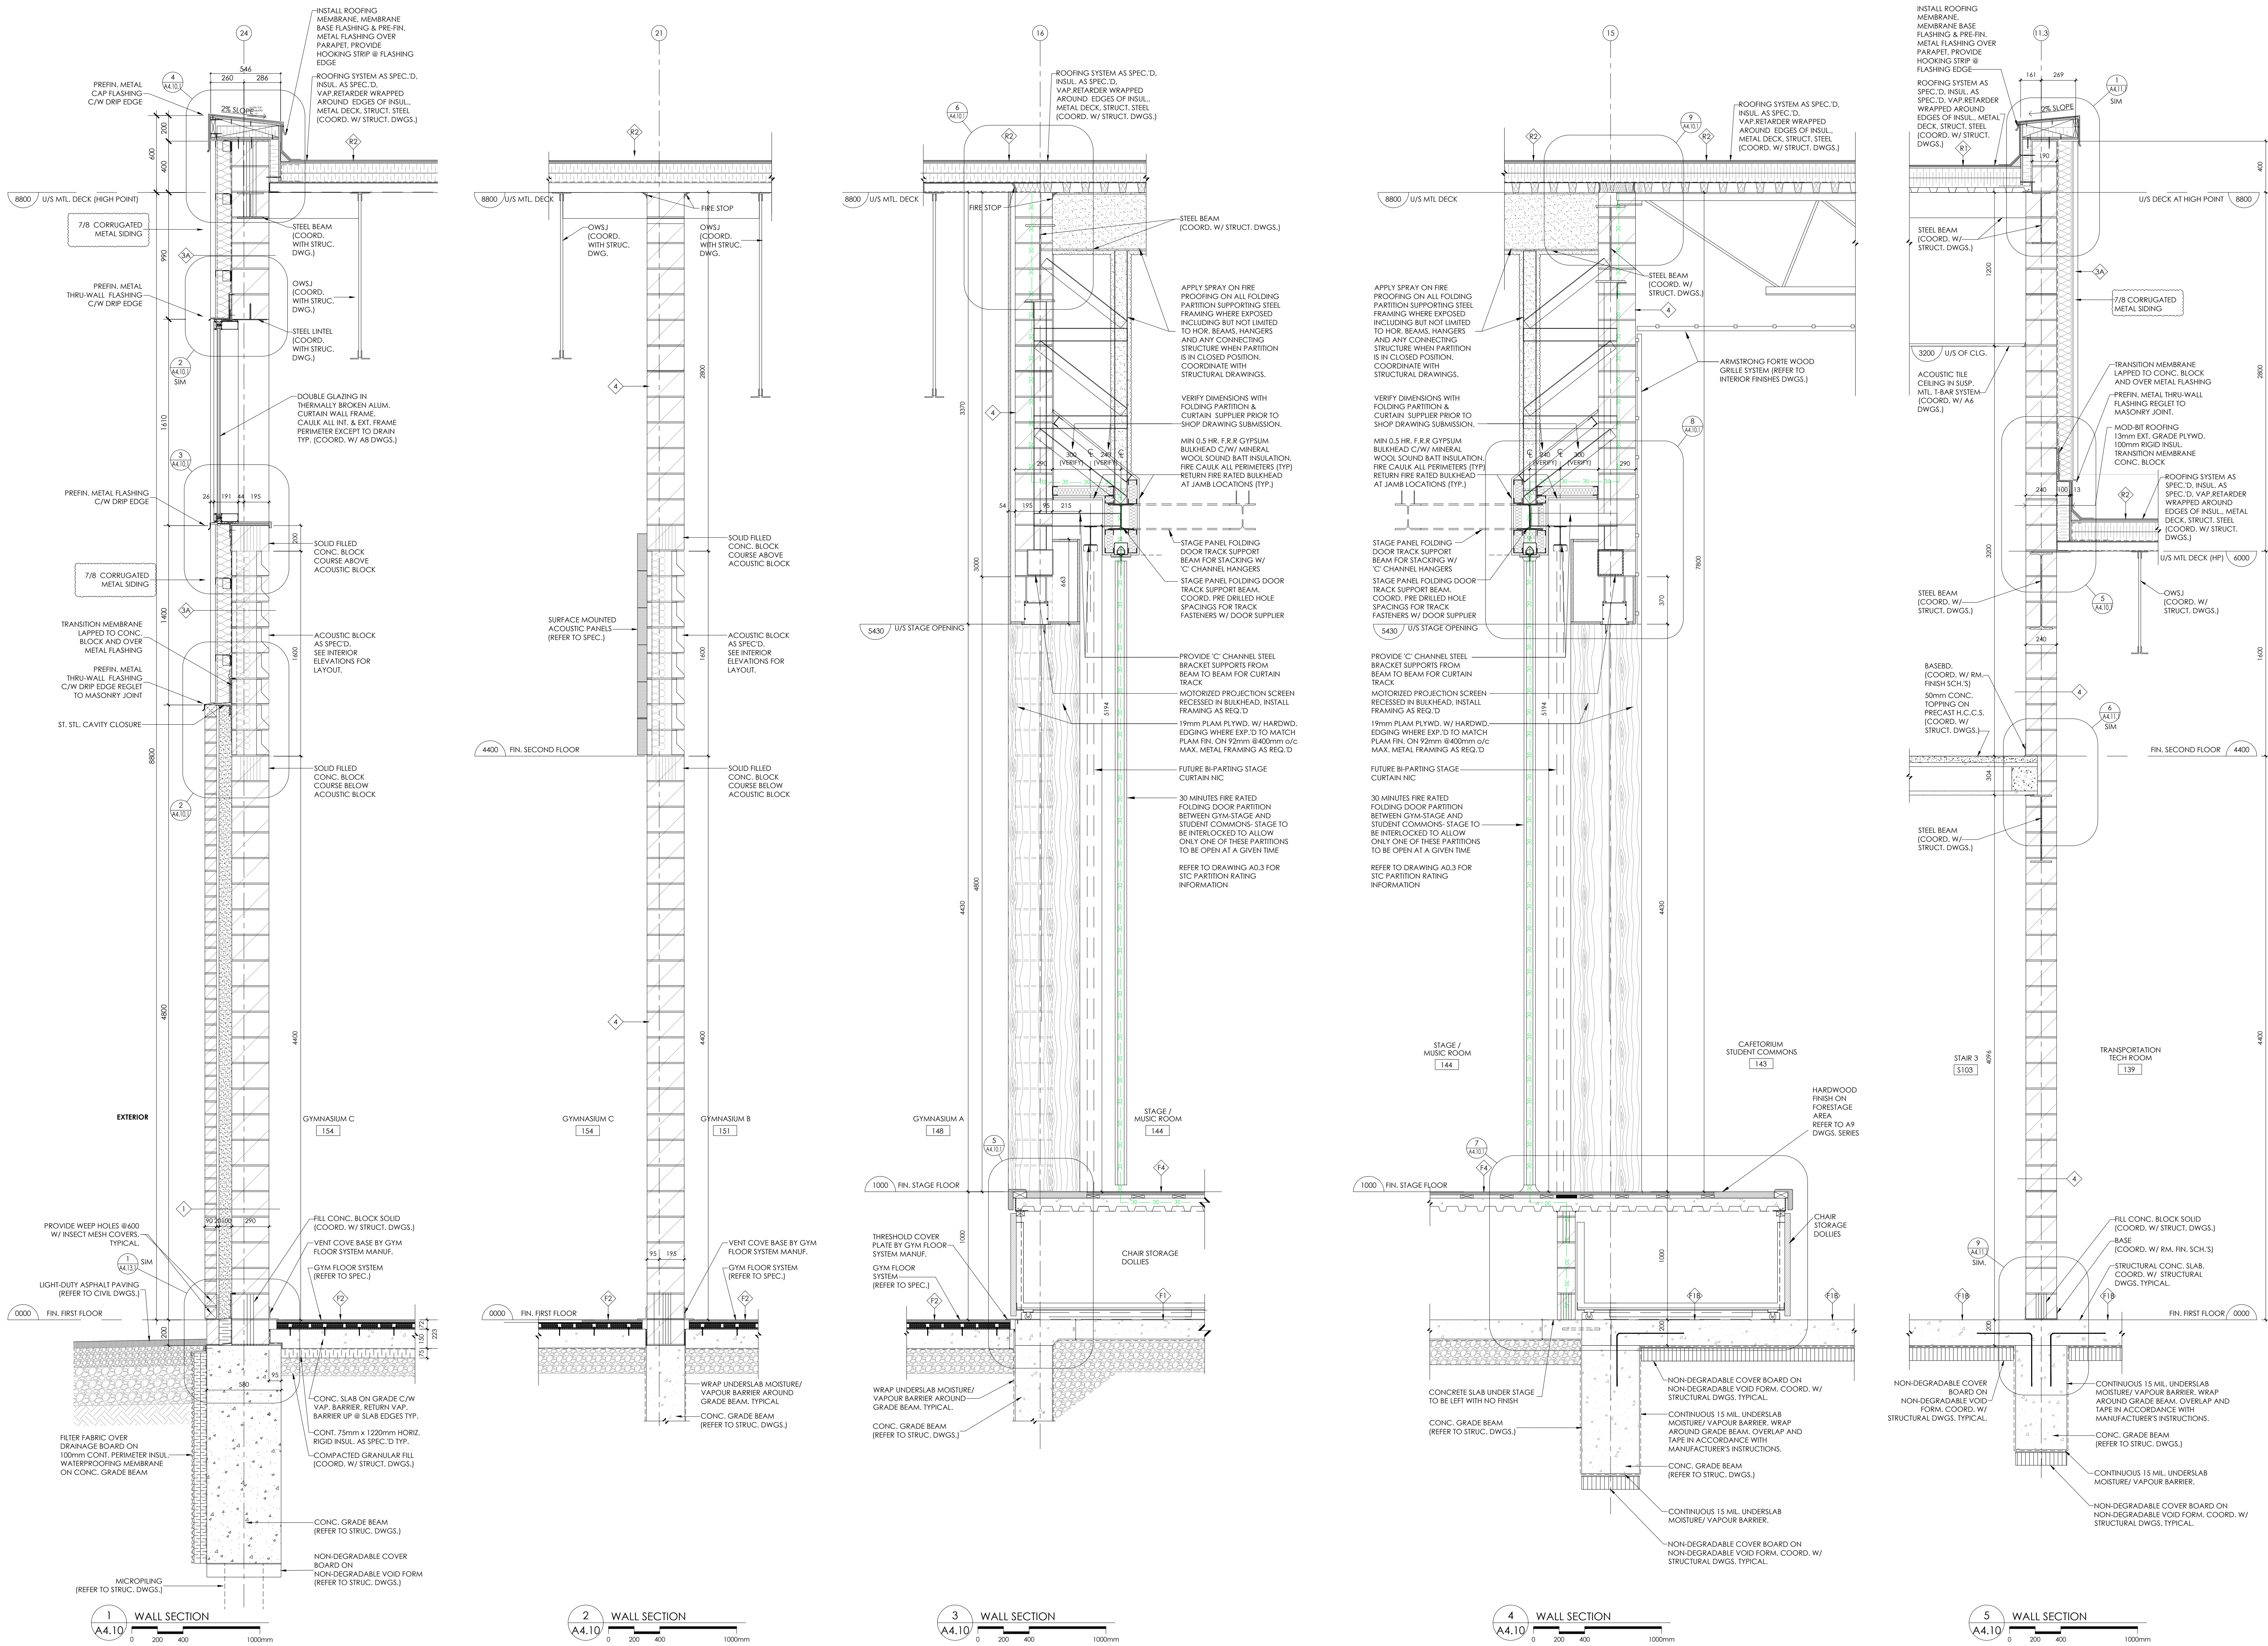

REVISIONS		
NO.	DATE	PARTICULAR
1	2022.04.06	ISSUED FOR 805 CLASS B COSTING
2	2022.06.18	ISSUED FOR SPA
3	2022.09.22	ISSUED FOR OWNERS REVIEW - RES SET
4	2022.12.16	ISSUED FOR 2ND SPA SUBMISSION
5	2023.01.31	ISSUED FOR TENDER
6	2023.02.22	ISSUED FOR ADDENDUM 9
7	2023.08.23	ISSUED FOR CONVENIENCE
8	2023.11.20	ISSUED FOR PERMIT COMMENTS
9	2024.01.24	ISSUED FOR SH03
10	2024.02.15	ISSUED FOR PCH038
11	2024.03.04	ISSUED FOR PCH039
12	2024.03.10	ISSUED FOR SH040
13	2024.05.14	ISSUED FOR SH040
14	2024.07.22	ISSUED FOR SH040
15	2024.08.07	ISSUED FOR SH040
16	2024.10.02	ISSUED FOR PCH015
17	2025.04.11	ISSUED FOR PCH019
18	2025.05.01	ISSUED FOR CO#07
19	2025.05.28	ISSUED FOR PCH020 - CO#010
20	2025.07.31	ISSUED FOR SH013
21	2025.08.06	ISSUED FOR SH014
22	2025.08.15	ISSUED FOR PCH025 - CO#017
23	2025.08.25	ISSUED FOR PCH027 - CO#021
24	2025.09.02	ISSUED FOR PCH029
25	2025.09.02	ISSUED FOR SH020 - CO#018
26	2025.09.08	ISSUED FOR PCH031
27	2025.09.09	ISSUED FOR PCH032 - CO#022
28	2025.09.10	ISSUED FOR PCH033
29	2025.09.11	ISSUED FOR SH022
30	2025.09.15	ISSUED FOR SH023
31	2025.09.16	ISSUED FOR PCH035 - CO#023
32	2025.09.30	ISSUED FOR PCH037 - CO#019
33	2025.09.30	ISSUED FOR PCH038 - CO#025
34	2025.10.04	ISSUED FOR PCH039 - CO#024
35	2025.10.20	ISSUED FOR PCH040
36	2025.10.30	ISSUED FOR PCH041
37	2025.10.23	ISSUED FOR PCH042
38	2025.11.21	ISSUED FOR PCH021/01 - CO12 CO#09
39	2025.11.14	ISSUED FOR PCH043
40	2025.11.26	ISSUED FOR PCH040/01
41	2025.12.03	ISSUED FOR PCH044 - CO#026
42	2026.02.04	ISSUED FOR RECORD SET UP TO CO#07

NOTES:

KEY PLAN:



CLIENT:
NEAR NORTH DISTRICT SCHOOL BOARD
NND58 Tender # 2023-015

PROJECT:
NEW PARRY SOUND K-12 SCHOOL & CHILDCARE
PARRY SOUND HIGH SCHOOL SITE

111 ISABELLA STREET
PARRY SOUND, ONTARIO

ORIGINAL PAGE SIZE ARCH E1 - 30" x 42"

KEY TO DETAIL LOCATION:


A - DETAIL NO.
B - DETAIL NO. ORIGIN



A4.10

BROWN BY: m. sr

CHECKED BY: JX

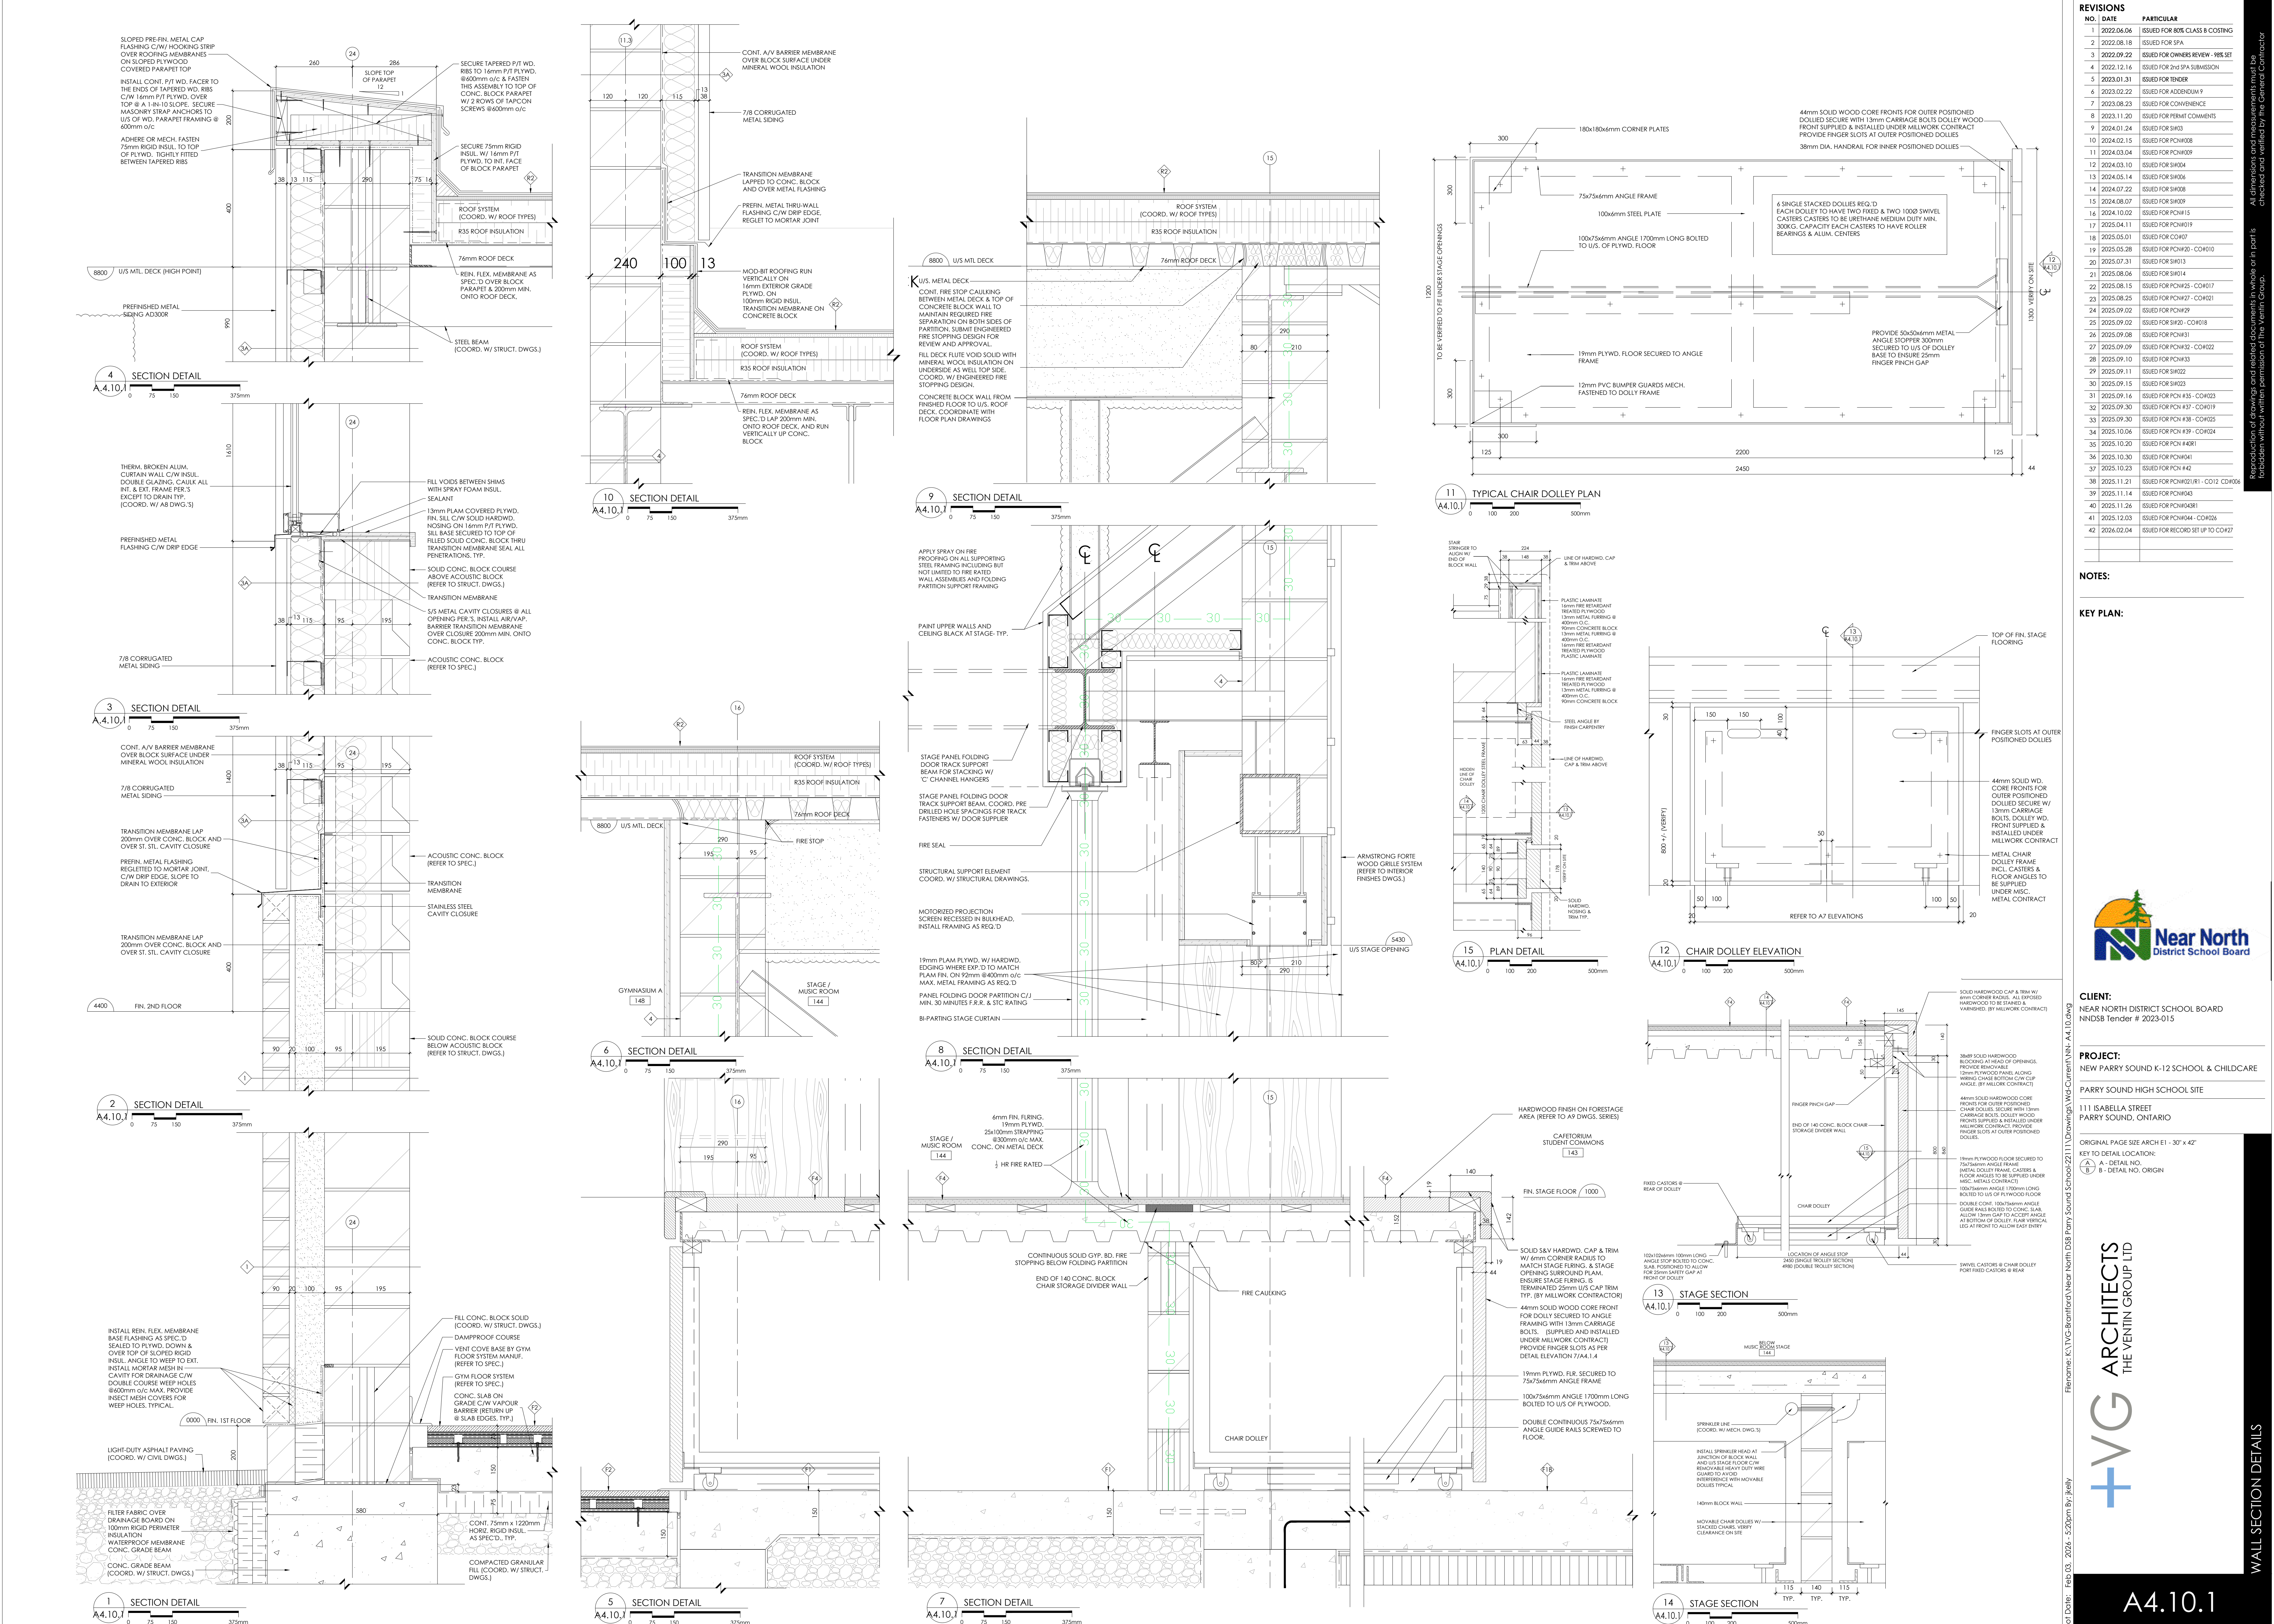

REVISIONS		
NO.	DATE	PARTICULAR
1	2022.04.06	ISSUED FOR 80% CLASS B COSTING
2	2022.06.18	ISSUED FOR SPA
3	2022.09.22	ISSUED FOR OWNERS REVIEW - RES SET
4	2022.12.16	ISSUED FOR 2nd SPA SUBMISSION
5	2023.01.31	ISSUED FOR TENDER
6	2023.02.22	ISSUED FOR ADDENDUM 9
7	2023.08.23	ISSUED FOR CONVENIENCE
8	2023.11.20	ISSUED FOR PERMIT COMMENTS
9	2024.01.24	ISSUED FOR SH03
10	2024.02.15	ISSUED FOR PCH038
11	2024.03.04	ISSUED FOR PCH039
12	2024.03.10	ISSUED FOR SH040
13	2024.03.14	ISSUED FOR SH040
14	2024.07.22	ISSUED FOR SH038
15	2024.08.07	ISSUED FOR SH039
16	2024.10.02	ISSUED FOR PCH045
17	2025.04.11	ISSUED FOR PCH049
18	2025.05.01	ISSUED FOR SH057
19	2025.05.28	ISSUED FOR PCH020 - CO#010
20	2025.07.31	ISSUED FOR SH013
21	2025.08.06	ISSUED FOR SH014
22	2025.08.15	ISSUED FOR PCH025 - CO#017
23	2025.08.25	ISSUED FOR PCH027 - CO#021
24	2025.09.02	ISSUED FOR PCH029
25	2025.09.02	ISSUED FOR SH020 - CO#018
26	2025.09.08	ISSUED FOR PCH031
27	2025.09.09	ISSUED FOR PCH032 - CO#022
28	2025.09.10	ISSUED FOR PCH033
29	2025.09.11	ISSUED FOR SH022
30	2025.09.15	ISSUED FOR SH023
31	2025.09.16	ISSUED FOR PCH035 - CO#023
32	2025.09.30	ISSUED FOR PCH037 - CO#019
33	2025.09.30	ISSUED FOR PCH038 - CO#025
34	2025.10.04	ISSUED FOR PCH039 - CO#024
35	2025.10.20	ISSUED FOR PCH040
36	2025.10.30	ISSUED FOR PCH041
37	2025.10.23	ISSUED FOR PCH042
38	2025.11.21	ISSUED FOR PCH021/01 - CO#020
39	2025.11.14	ISSUED FOR PCH043
40	2025.11.26	ISSUED FOR PCH048
41	2025.12.03	ISSUED FOR PCH044 - CO#026
42	2026.02.04	ISSUED FOR RECORD SET UP TO CO#027

NOTES:

KEY PLAN:



CLIENT:
NEAR NORTH DISTRICT SCHOOL BOARD
NDSB tender # 2023-015

PROJECT:
NEW PARRY SOUND K-12 SCHOOL & CHILDCARE
PARRY SOUND HIGH SCHOOL SITE

111 ISABELLA STREET
PARRY SOUND, ONTARIO

ORIGINAL PAGE SIZE ARCH E1 - 30" x 42"


KEY TO DETAIL LOCATION:

A - DETAIL NO.
B - DETAIL NO. ORIGIN

ARCHITECTS
THE YENTIN GROUP LTD

A4.10.1

Pot Date: Feb 03, 2026 - 5:20pm By: jkely
DRAWN BY: jkely
CHECKED BY: jkely

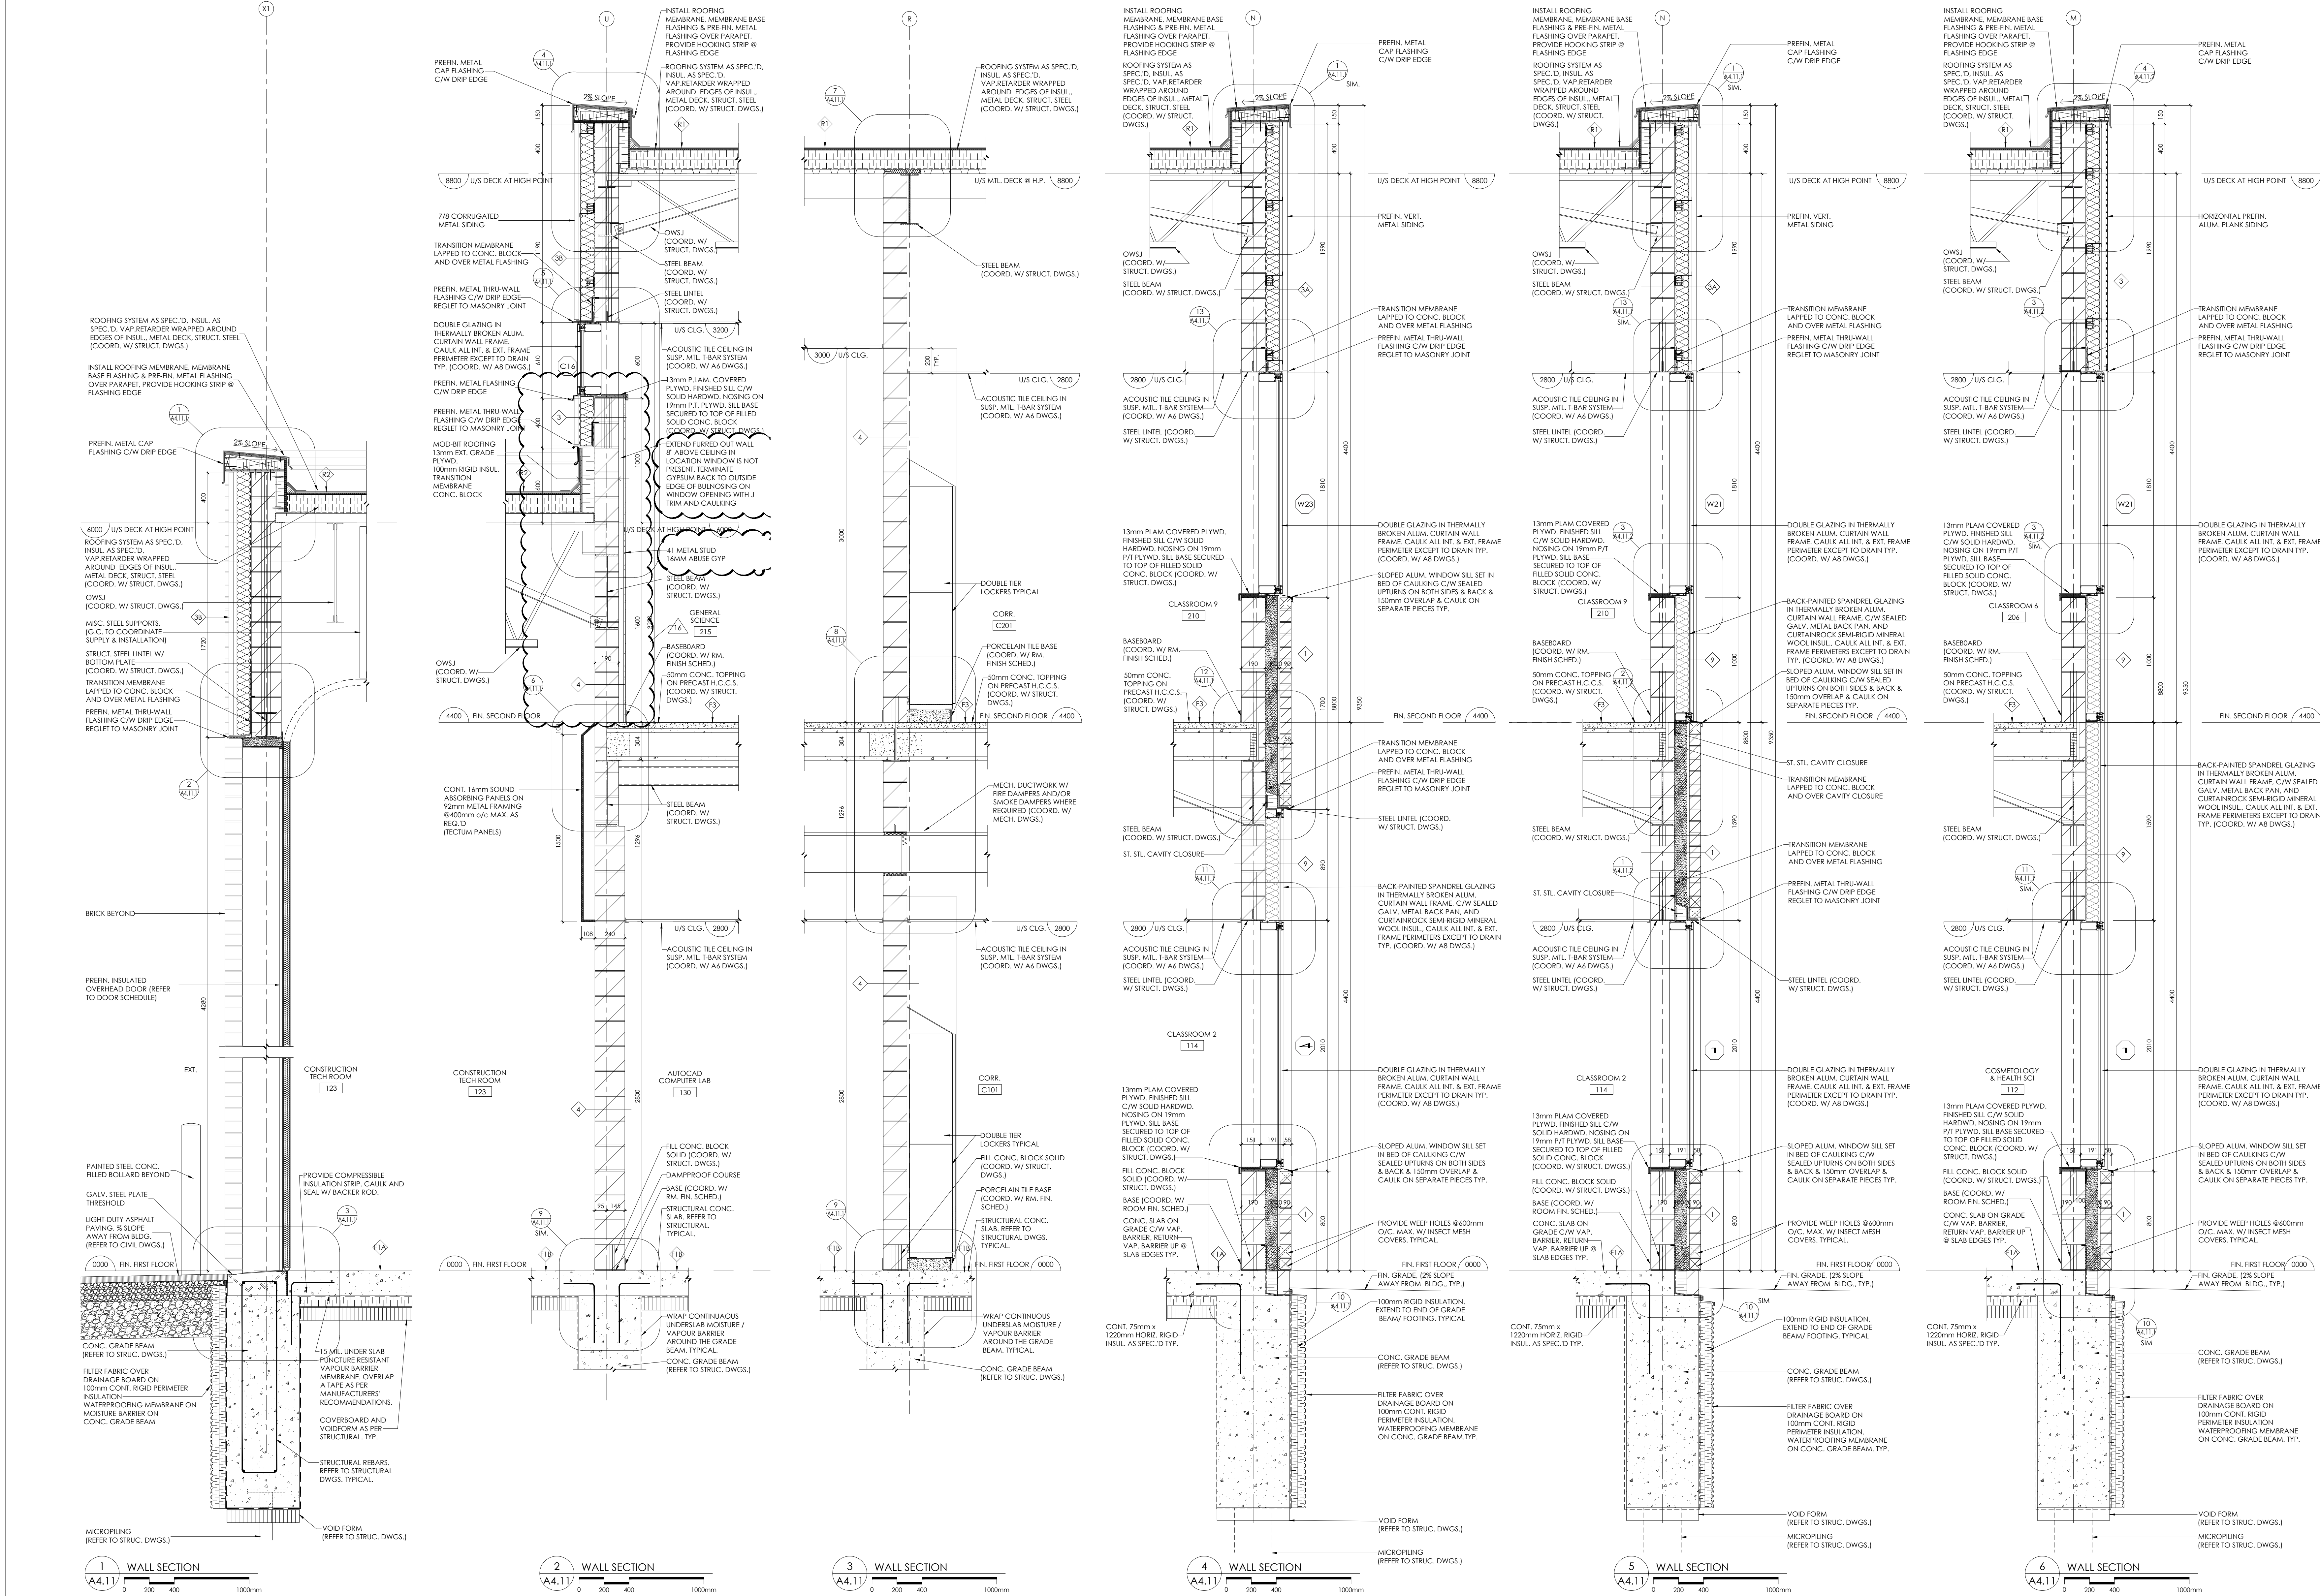

REVISIONS		
NO.	DATE	PARTICULAR
1	2022.04.06	ISSUED FOR 805 CLASS B COSTING
2	2022.06.18	ISSUED FOR SPA
3	2022.09.22	ISSUED FOR OWNERS REVIEW - RES SET
4	2022.12.16	ISSUED FOR 2ND SPA SUBMISSION
5	2023.01.31	ISSUED FOR TENDER
6	2023.02.22	ISSUED FOR ADDENDUM 9
7	2023.08.23	ISSUED FOR CONVENIENCE
8	2023.11.20	ISSUED FOR PERMIT COMMENTS
9	2024.01.24	ISSUED FOR SH03
10	2024.02.15	ISSUED FOR PCH038
11	2024.03.04	ISSUED FOR PCH039
12	2024.03.10	ISSUED FOR SH04
13	2024.05.14	ISSUED FOR SH04
14	2024.07.22	ISSUED FOR SH08
15	2024.08.07	ISSUED FOR SH09
16	2024.10.02	ISSUED FOR PCH015
17	2025.04.11	ISSUED FOR PCH019
18	2025.05.01	ISSUED FOR CO#07
19	2025.05.28	ISSUED FOR PCH020 - CO#010
20	2025.07.31	ISSUED FOR SH013
21	2025.08.06	ISSUED FOR SH014 - CO#017
22	2025.08.15	ISSUED FOR PCH025 - CO#017
23	2025.08.25	ISSUED FOR PCH027 - CO#021
24	2025.09.02	ISSUED FOR PCH029
25	2025.09.02	ISSUED FOR SH020 - CO#018
26	2025.09.08	ISSUED FOR PCH031
27	2025.09.09	ISSUED FOR PCH032 - CO#022
28	2025.09.10	ISSUED FOR PCH033
29	2025.09.11	ISSUED FOR SH022
30	2025.09.15	ISSUED FOR SH023
31	2025.09.16	ISSUED FOR PCH035 - CO#023
32	2025.09.30	ISSUED FOR PCH037 - CO#019
33	2025.09.30	ISSUED FOR PCH038 - CO#025
34	2025.10.04	ISSUED FOR PCH039 - CO#024
35	2025.10.20	ISSUED FOR PCH040
36	2025.10.30	ISSUED FOR PCH041
37	2025.10.23	ISSUED FOR PCH042
38	2025.11.21	ISSUED FOR PCH021/01 - CO12 CO#01
39	2025.11.14	ISSUED FOR PCH043
40	2025.11.26	ISSUED FOR PCH040/01
41	2025.12.03	ISSUED FOR PCH044 - CO#026
42	2026.02.04	ISSUED FOR RECORD SET UP TO CO#027

NOTES:

KEY PLAN:



CLIENT:
NEAR NORTH DISTRICT SCHOOL BOARD
NND58 tender # 2023-015

PROJECT:
NEW PARRY SOUND K-12 SCHOOL & CHILDCARE
PARRY SOUND HIGH SCHOOL SITE

111 ISABELLA STREET
PARRY SOUND, ONTARIO



ORIGINAL PAGE SIZE ARCH E1 - 30" x 42"
KEY TO DETAIL LOCATION:
A - DETAIL NO.
B - DETAIL NO. ORIGIN

ARCHITECTS
THE VENTIN GROUP LTD



A4.11

Pot Date: Feb 03, 2026 - 5:21pm By: jkelly
DRAWN BY: jkelly
CHECKED BY: jkelly



WALL SECTIONS

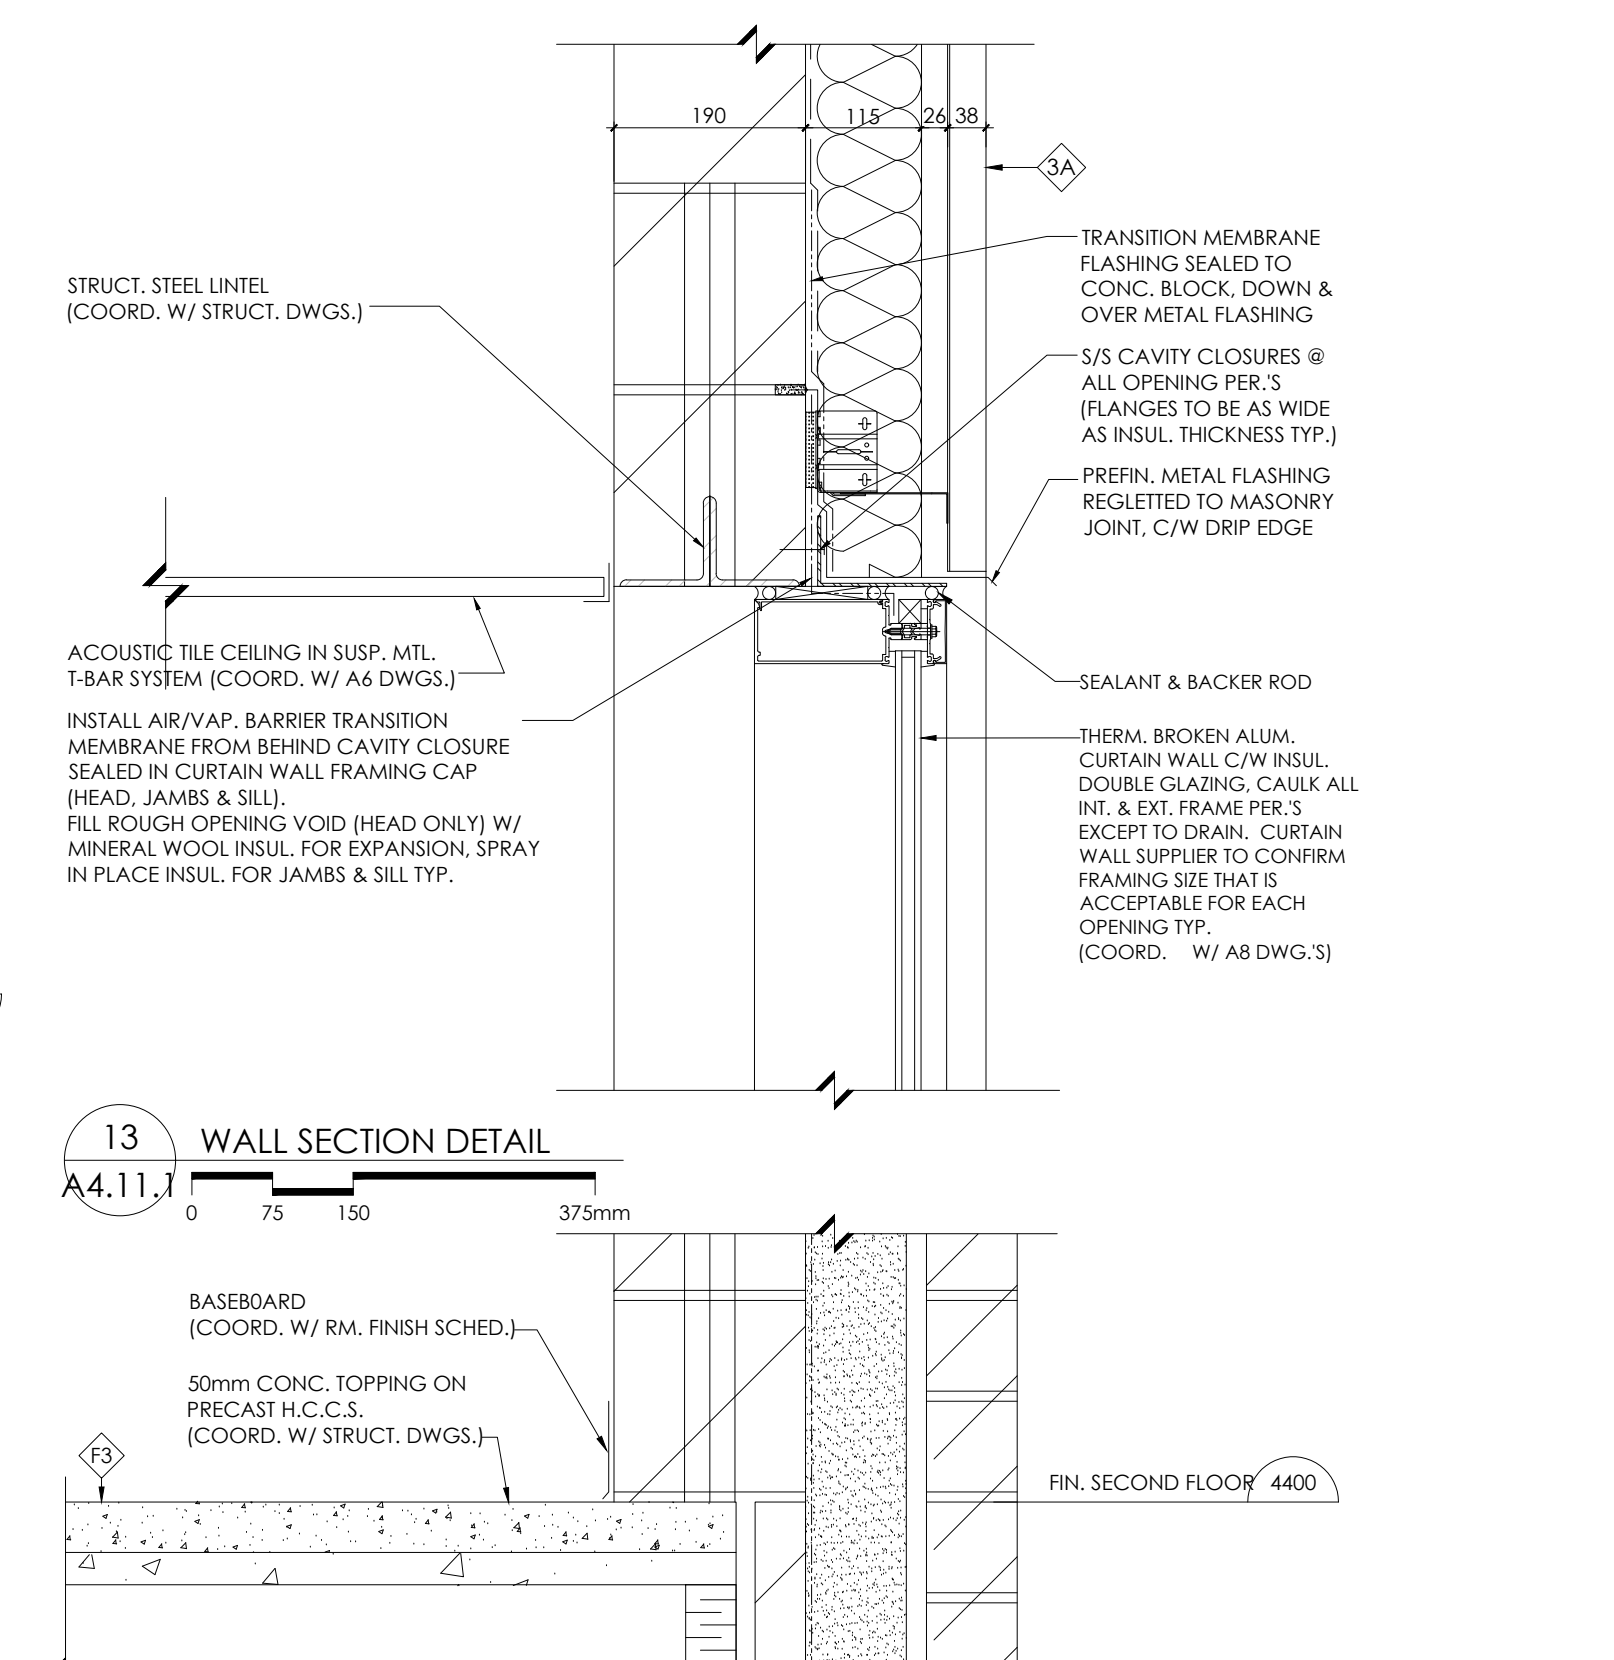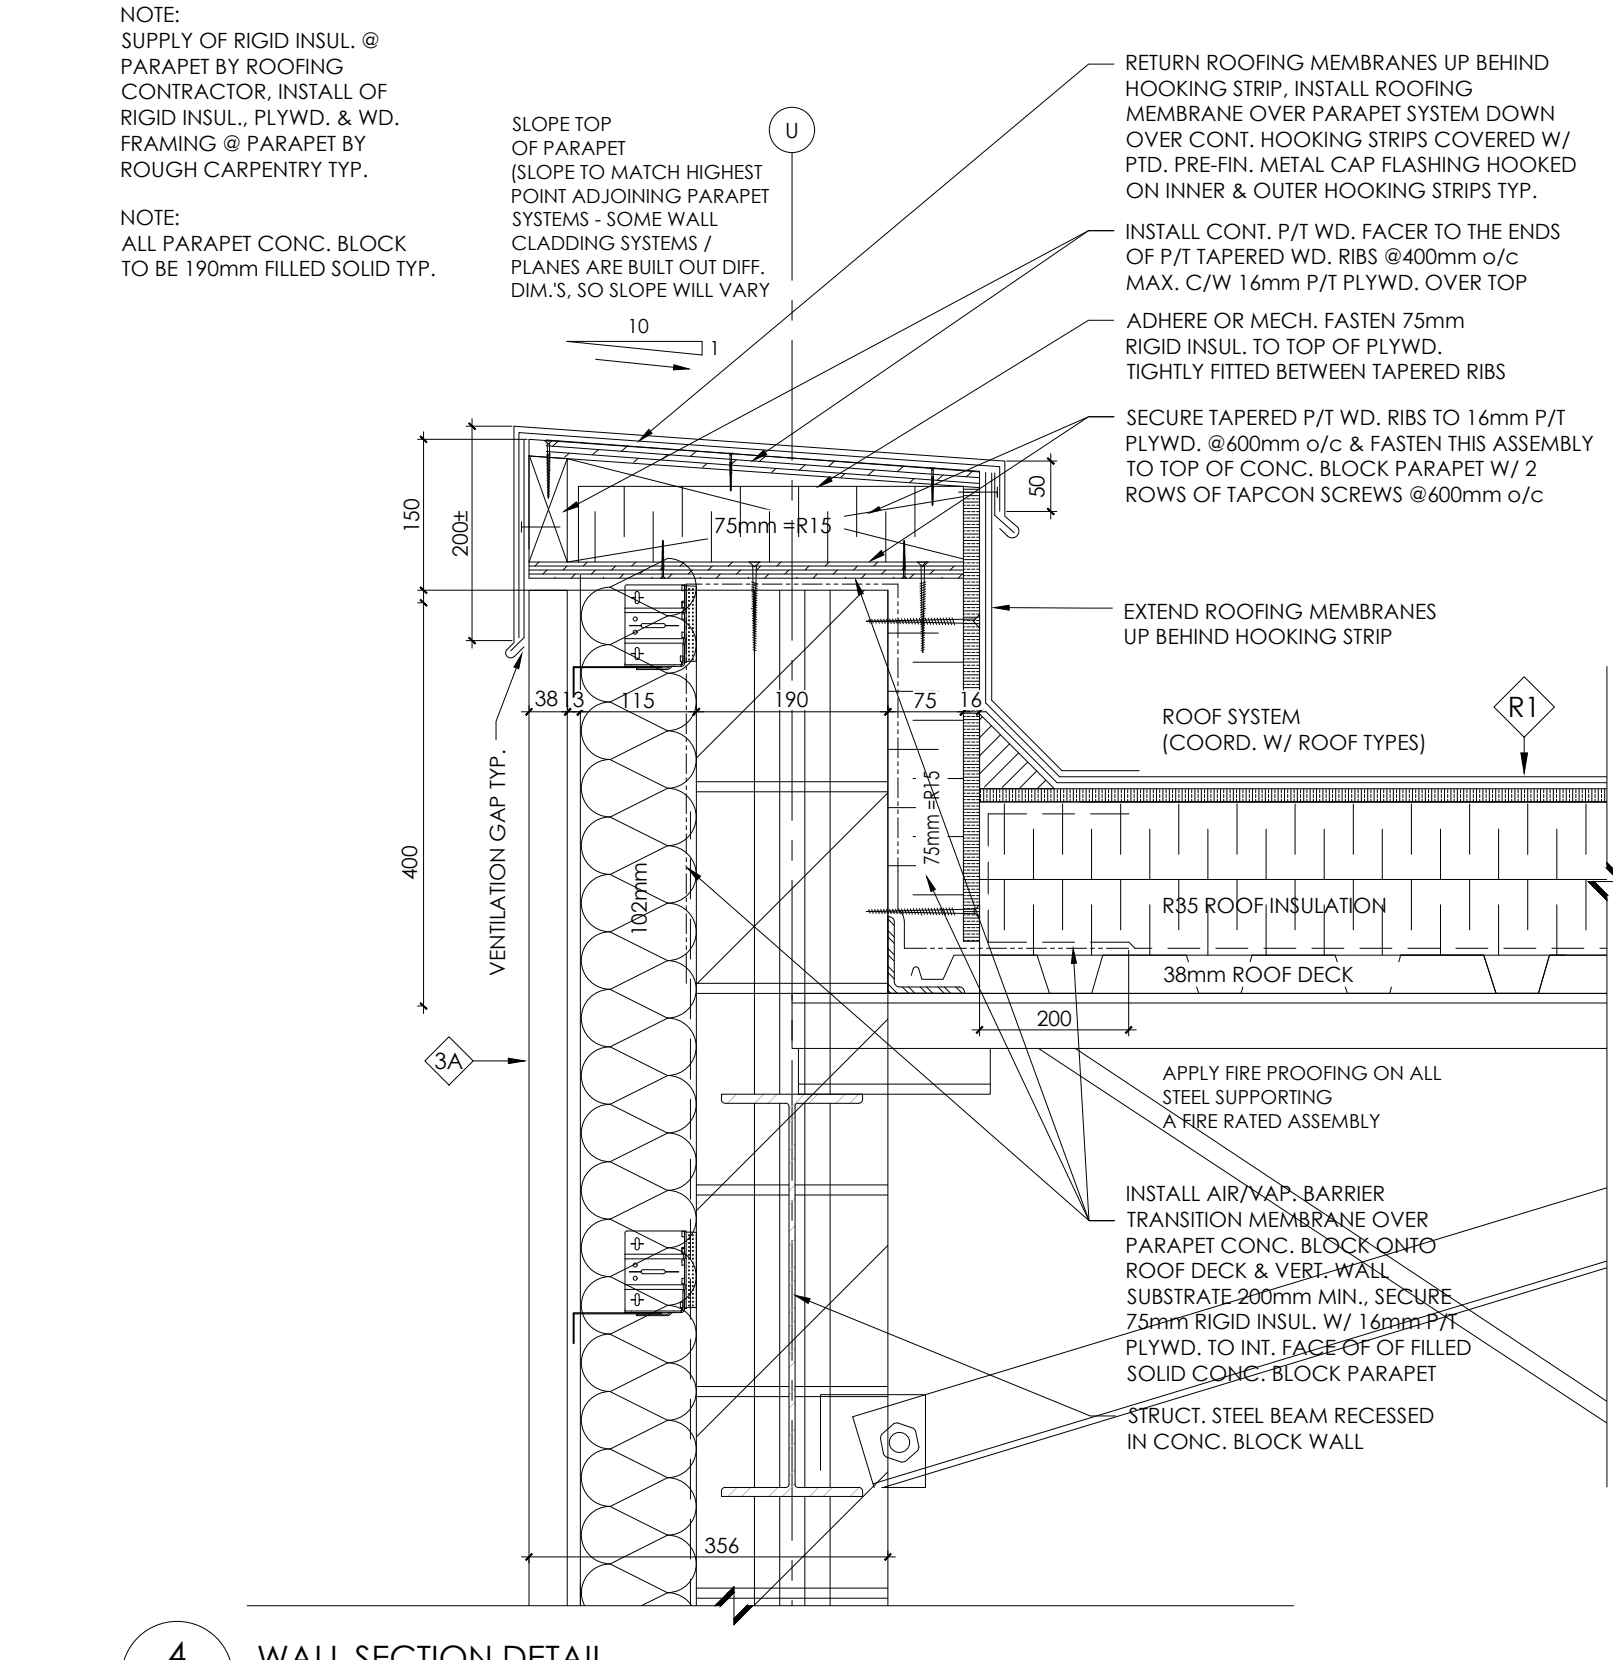


Reproduction of drawings and related documents in whole or in part is
prohibited without written permission of the Ventlin Group.

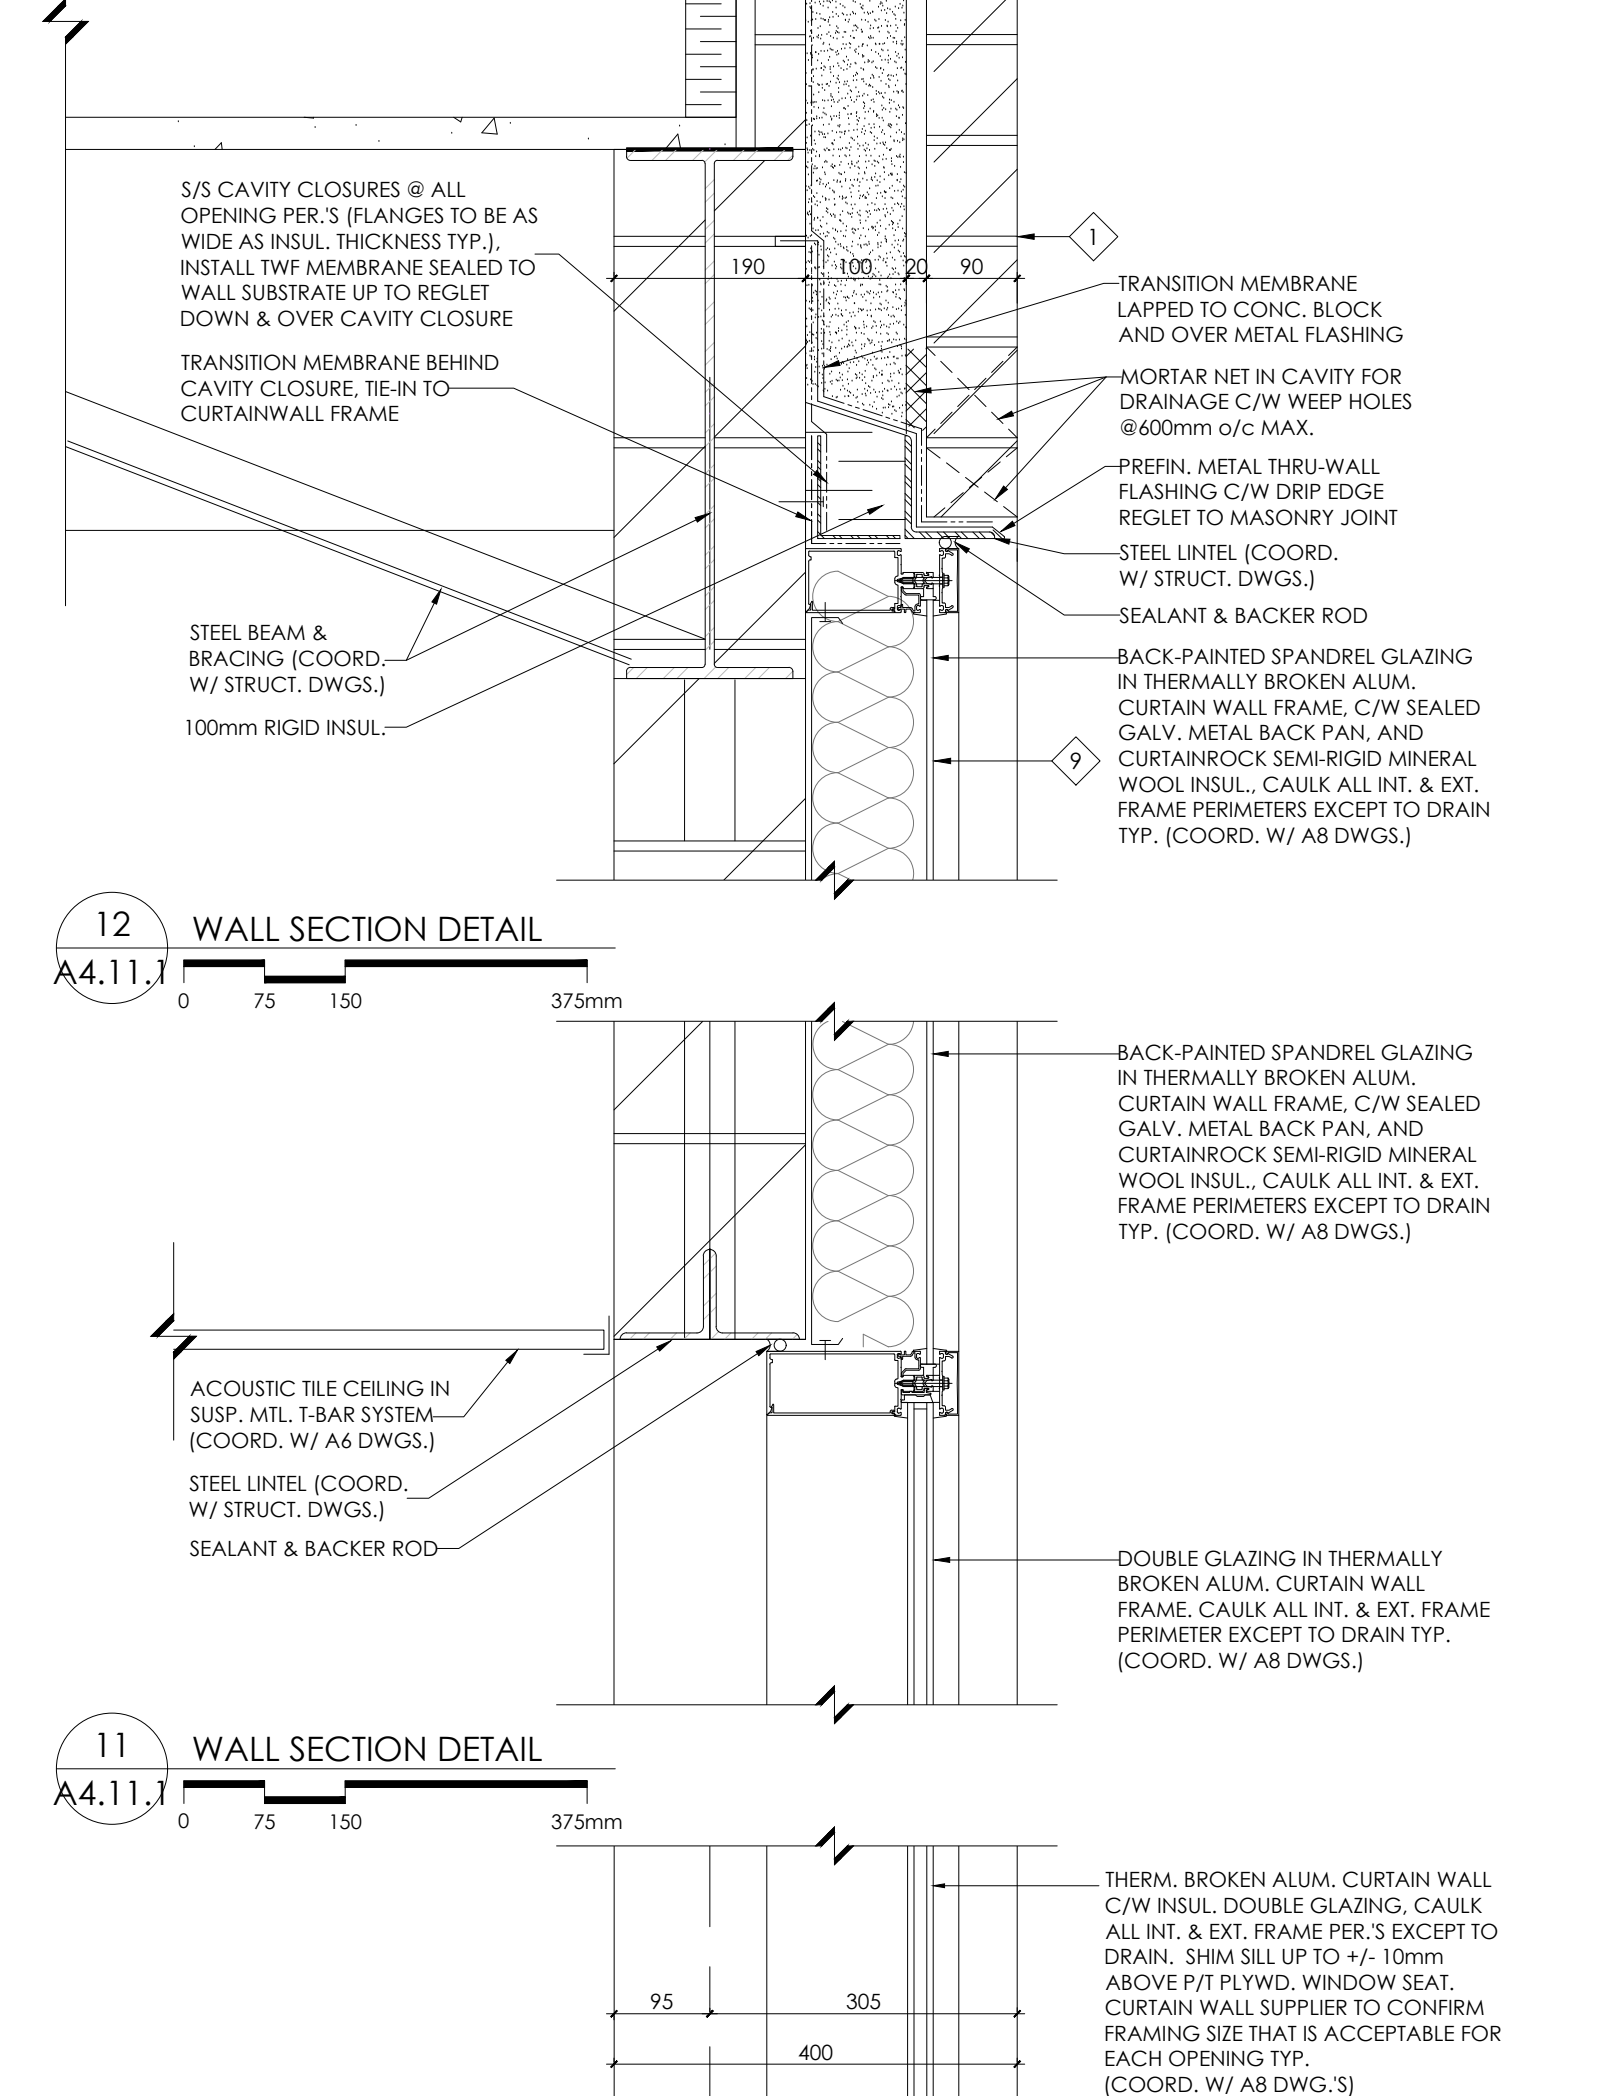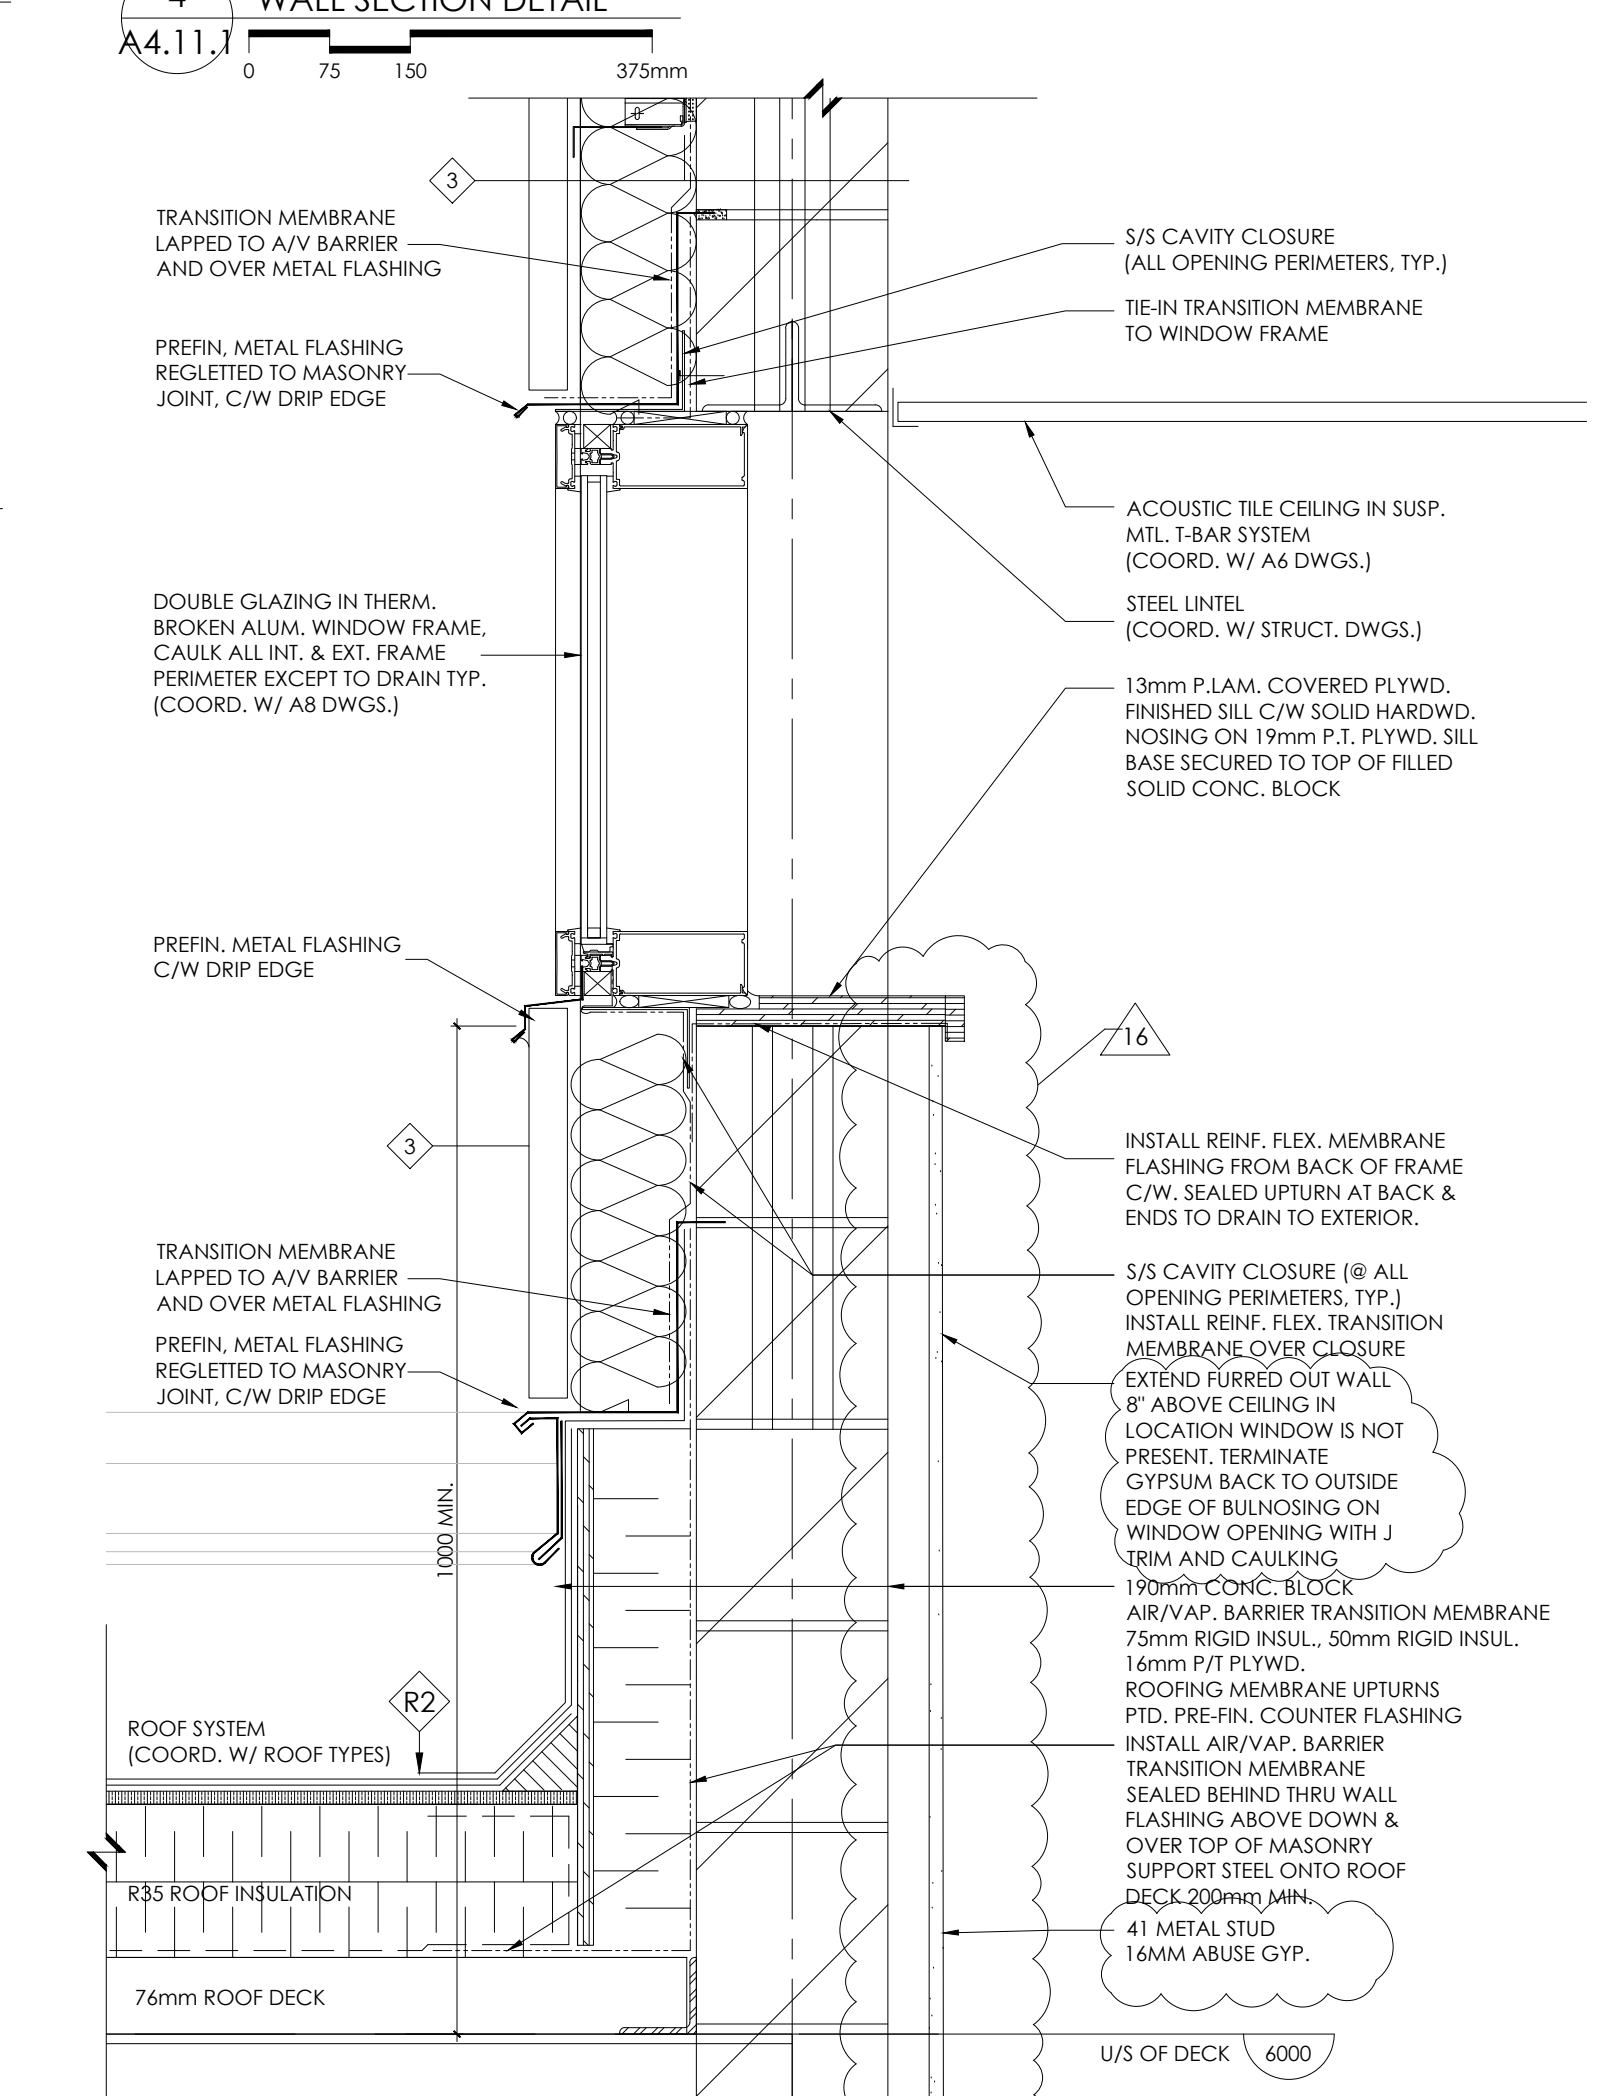

KEY PLAN:

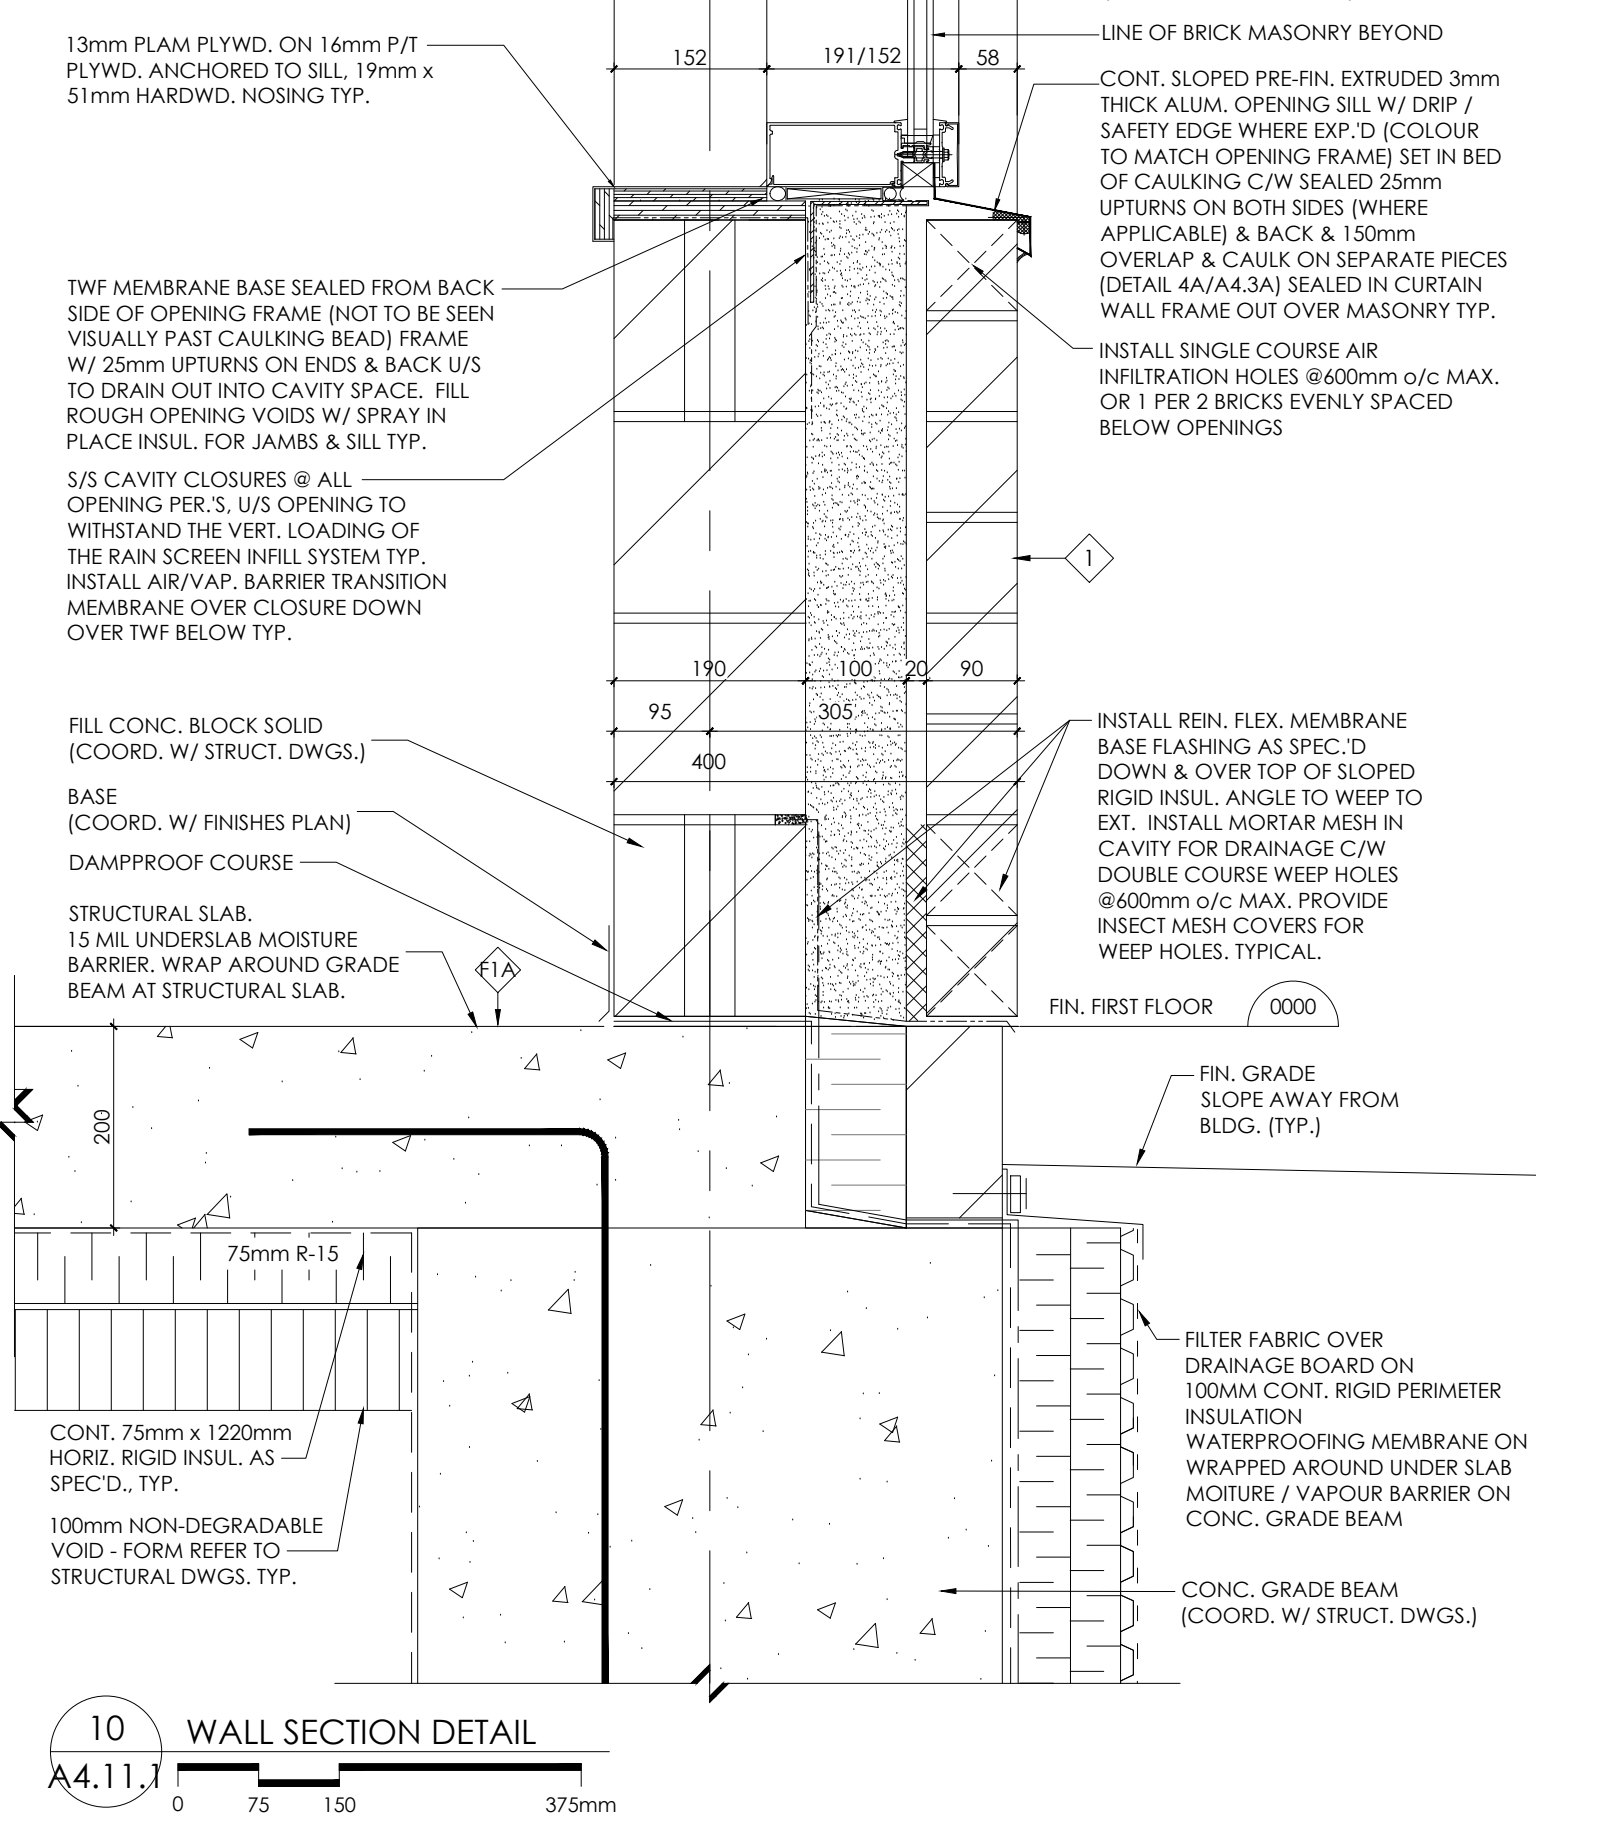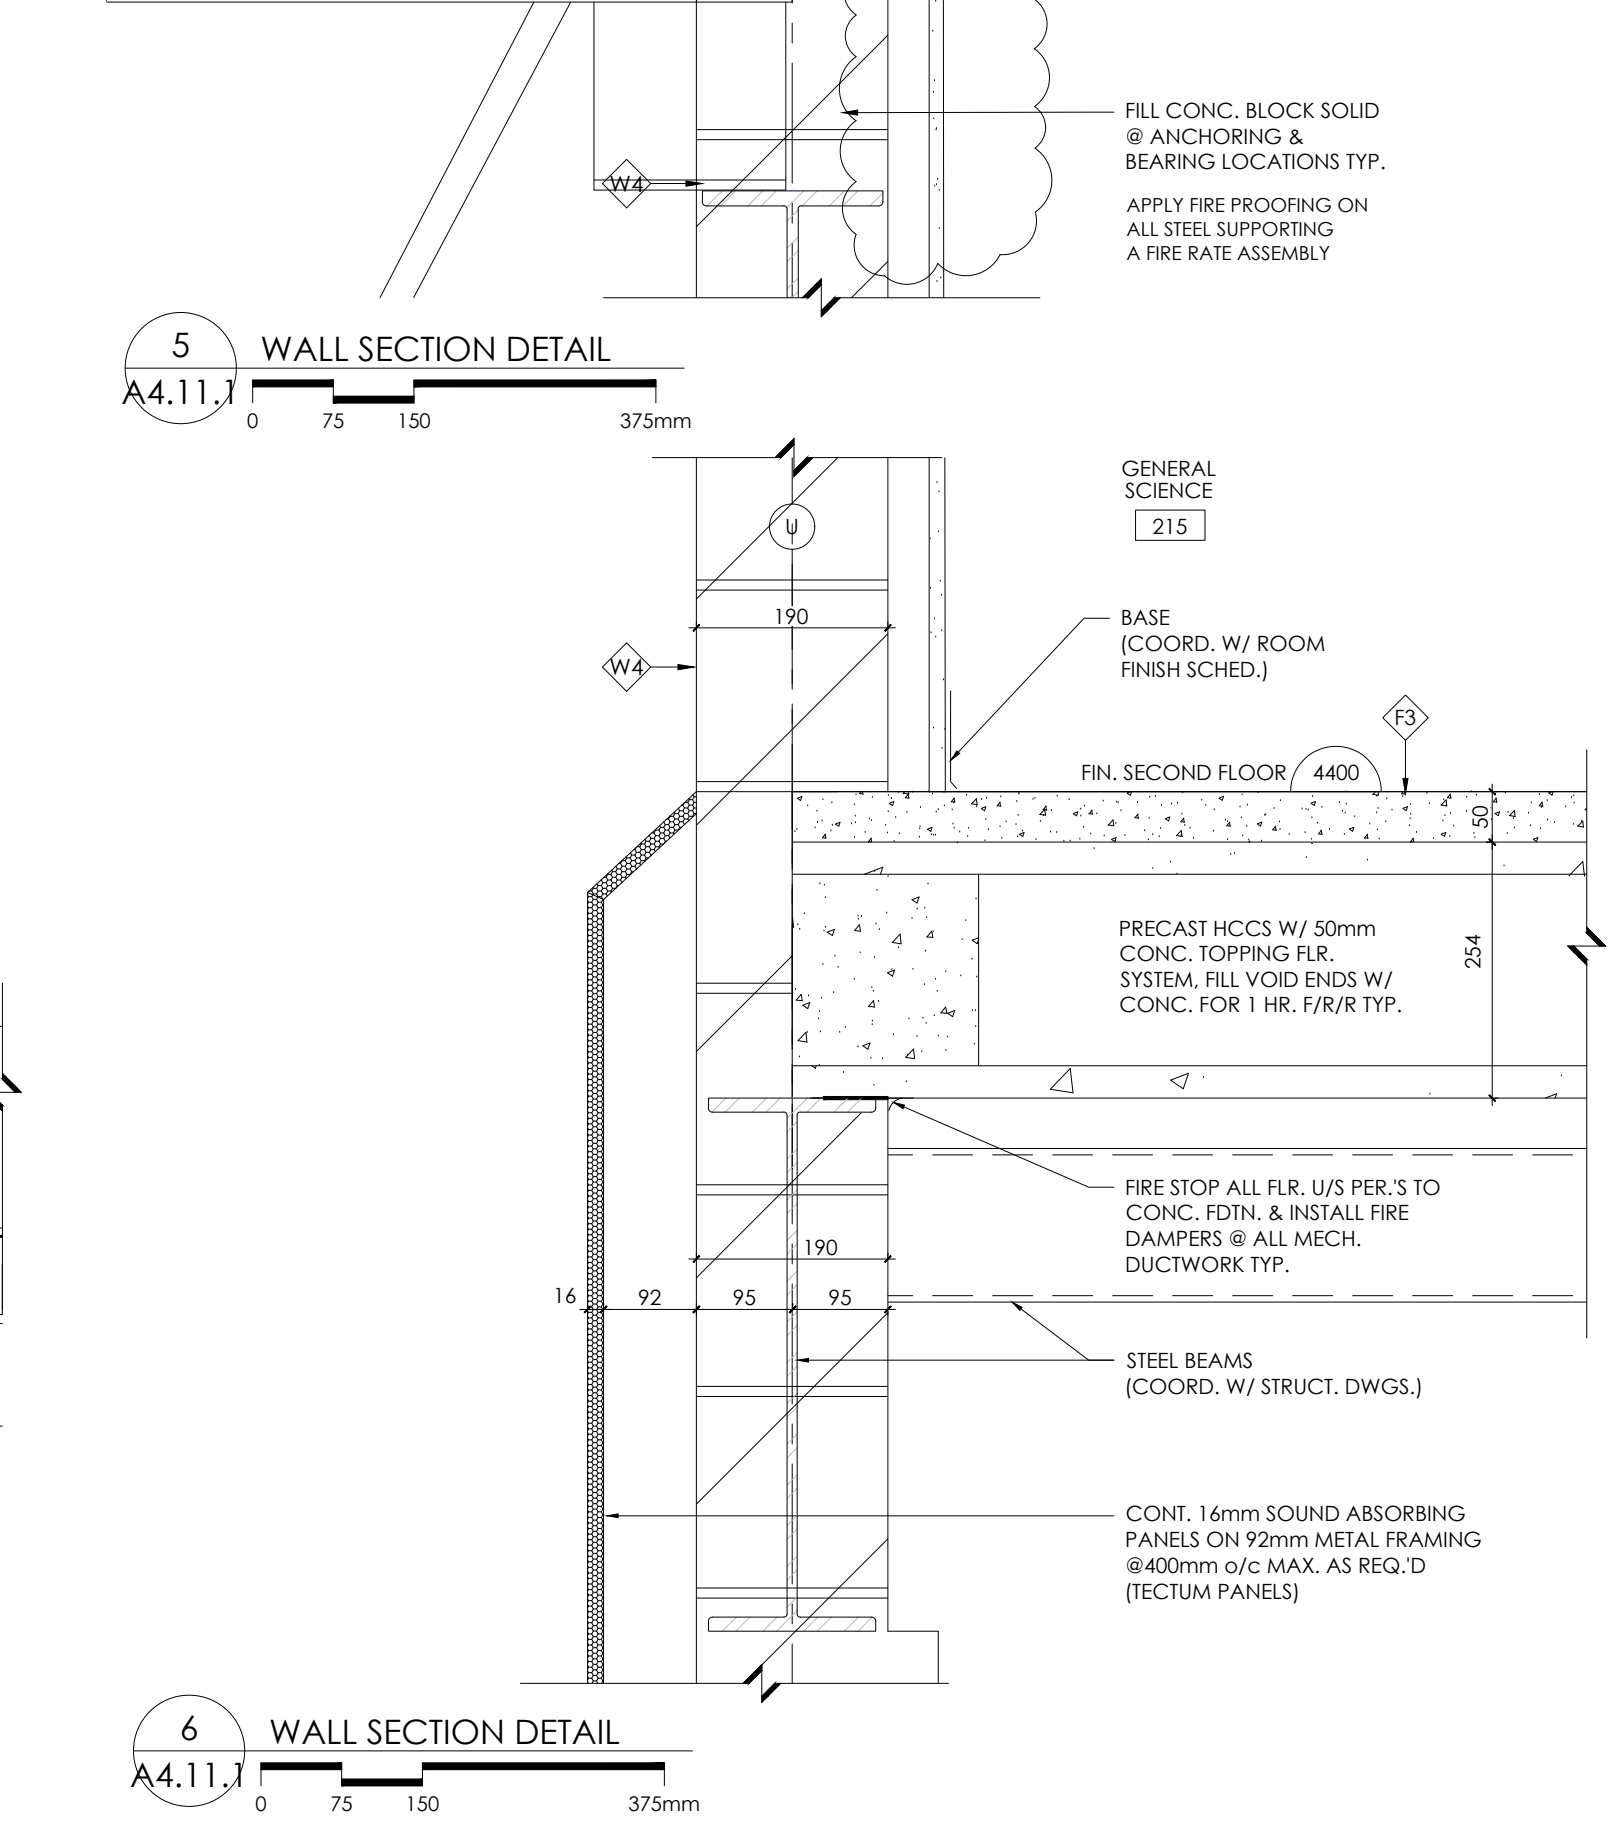


Pick [REDACTED]

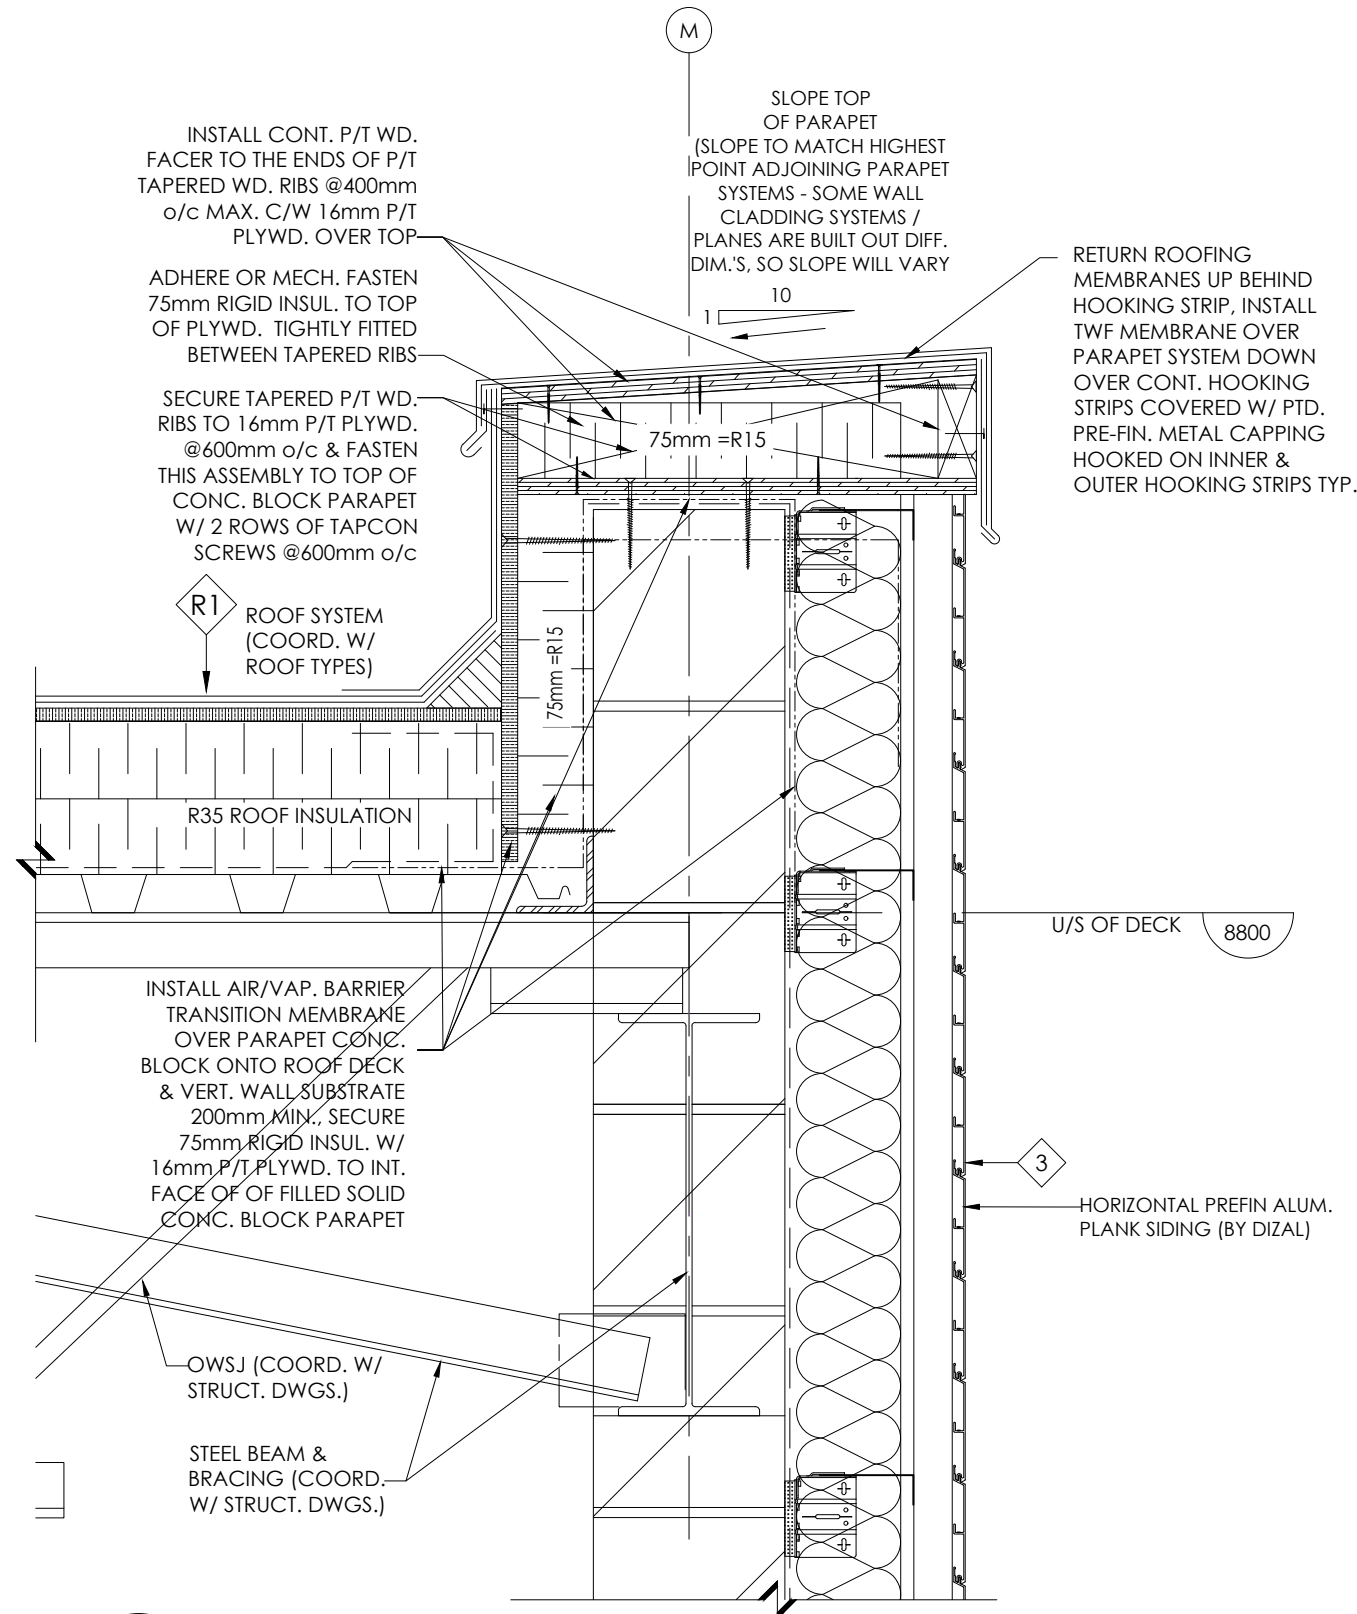


4 SECTION DETAIL

A4.11.2 0 75 150 375mm

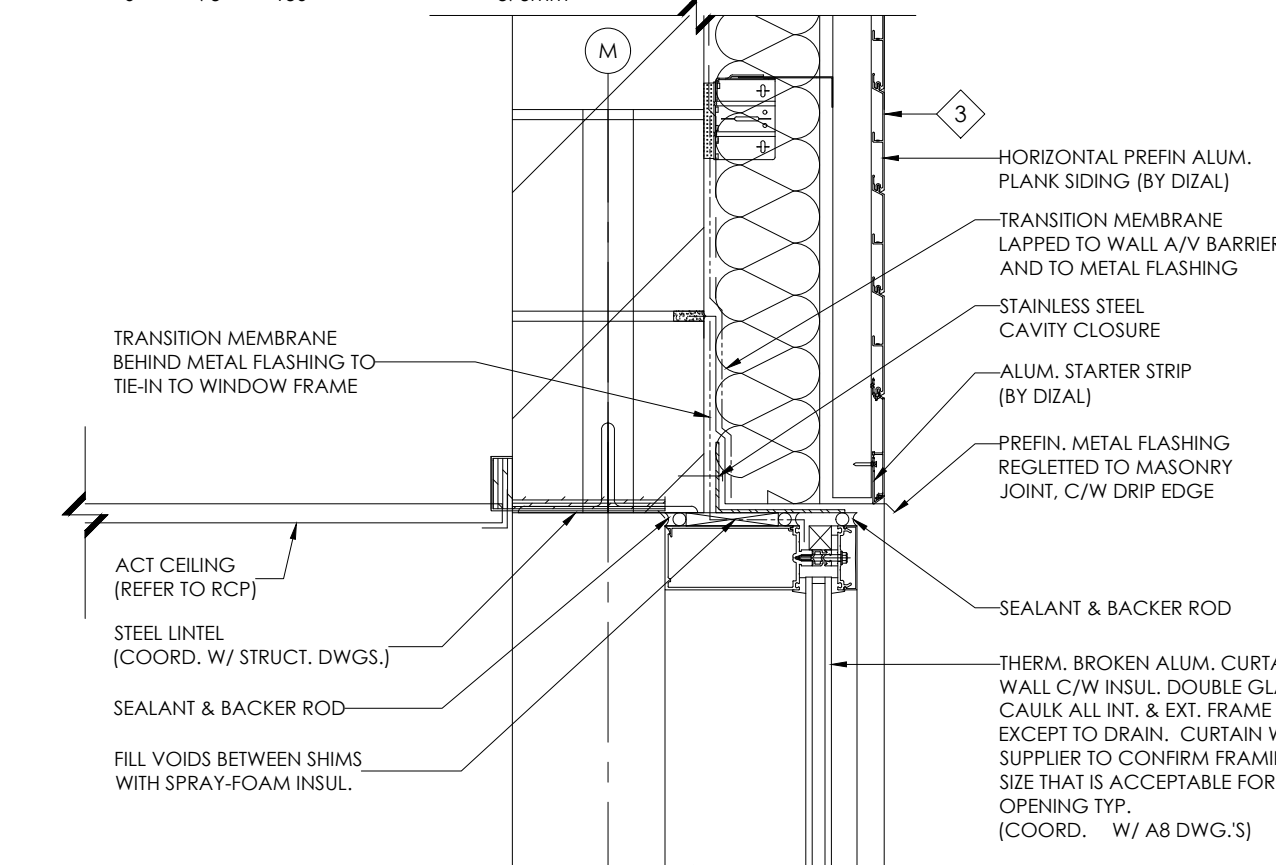


3 SECTION DETAIL

A4.11.2 0 75 150 375mm

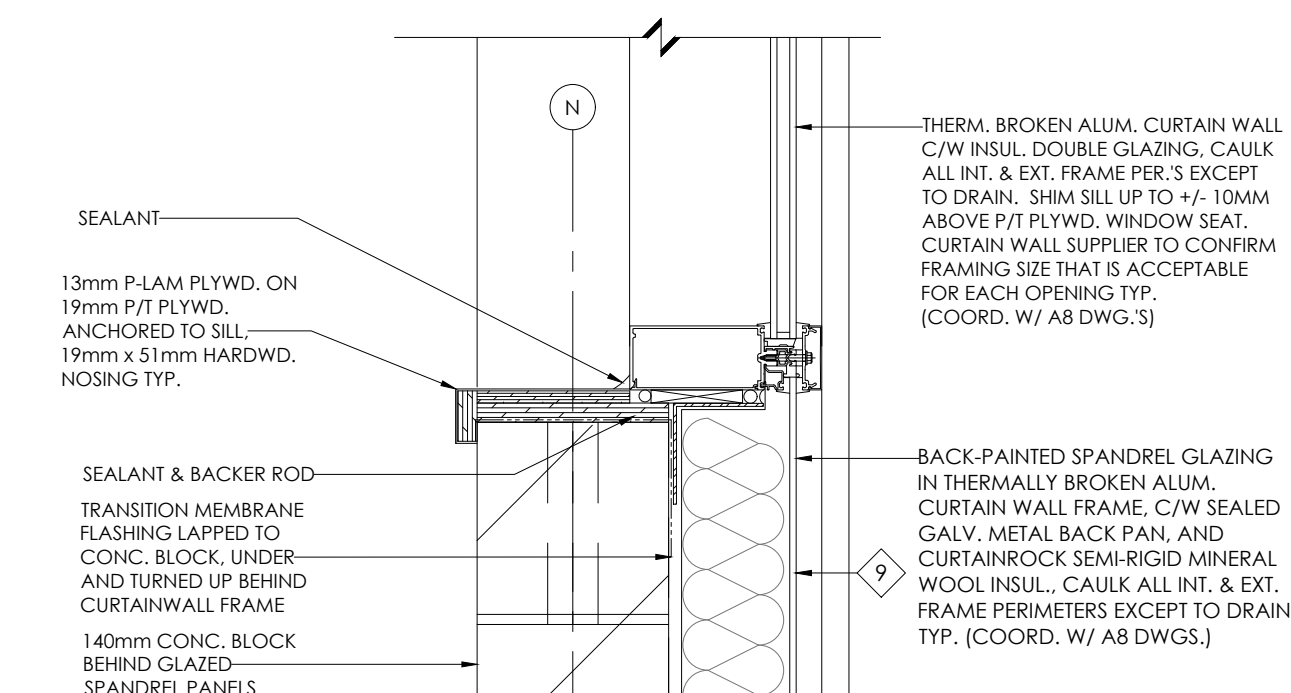


2 SECTION DETAIL

A4.11.2 0 75 150 375mm

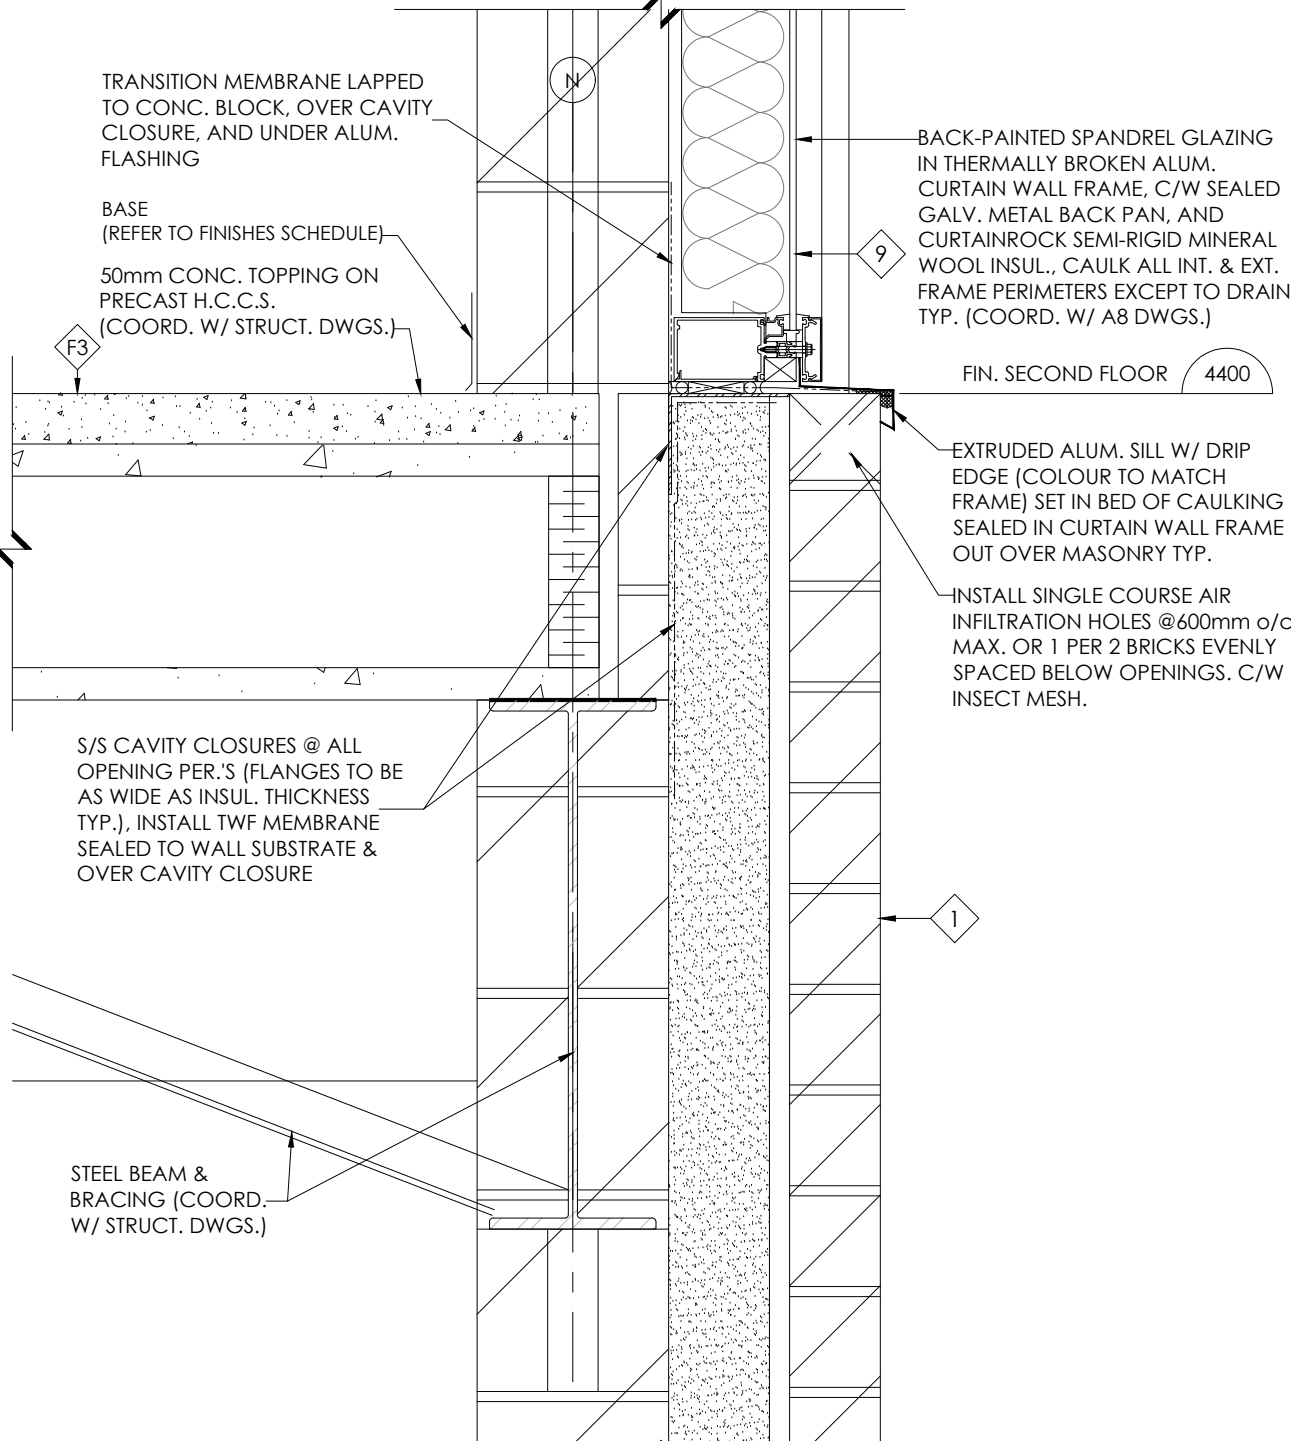

1 SECTION DETAIL

A4.11.2 0 75 150 375mm

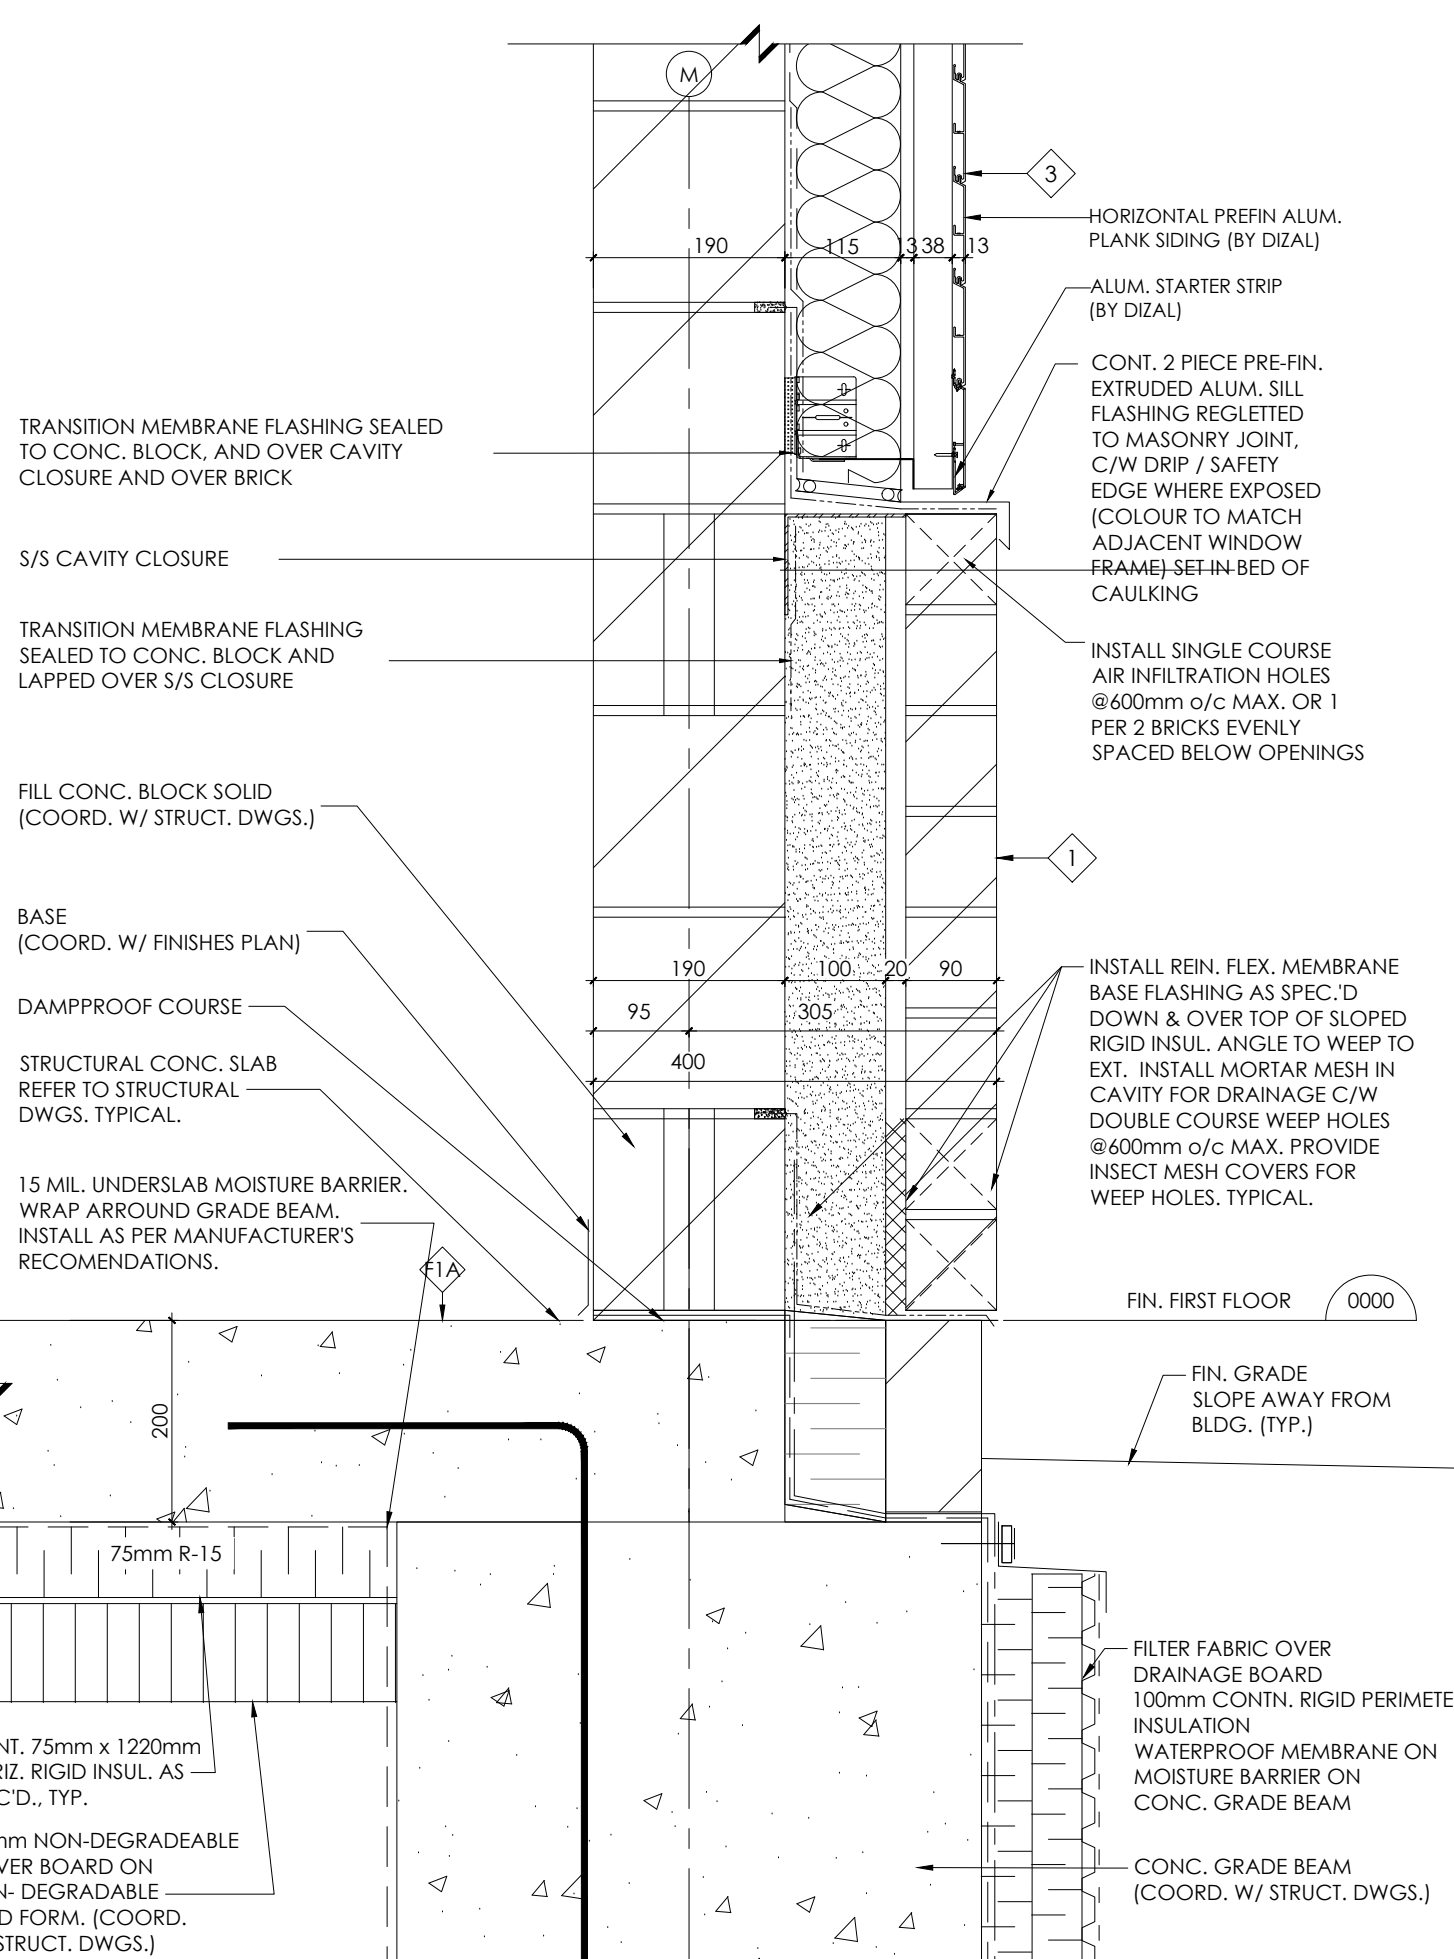

4 SECTION DETAIL

A4.11.2 0 75 150 375mm

REVISIONS		
NO.	DATE	PARTICULAR
1	2022.04.06	ISSUED FOR 805 CLASS B COSTING
2	2022.06.18	ISSUED FOR SPA
3	2022.09.22	ISSUED FOR OWNERS REVIEW - RES SET
4	2022.12.16	ISSUED FOR 2nd SPA SUBMISSION
5	2023.01.31	ISSUED FOR TENDER
6	2023.02.22	ISSUED FOR ADDENDUM 9
7	2023.08.23	ISSUED FOR CONVENIENCE
8	2023.11.20	ISSUED FOR PERMIT COMMENTS
9	2024.01.24	ISSUED FOR SH03
10	2024.02.15	ISSUED FOR PCH038
11	2024.03.04	ISSUED FOR PCH039
12	2024.03.10	ISSUED FOR SH040
13	2024.05.14	ISSUED FOR SH004
14	2024.07.22	ISSUED FOR SH008
15	2024.08.07	ISSUED FOR SH009
16	2024.10.02	ISSUED FOR PCH015
17	2025.04.11	ISSUED FOR PCH019
18	2025.05.01	ISSUED FOR CO#07
19	2025.05.28	ISSUED FOR PCH020 - CO#010
20	2025.07.31	ISSUED FOR SH013
21	2025.08.06	ISSUED FOR SH014
22	2025.08.15	ISSUED FOR PCH025 - CO#017
23	2025.08.25	ISSUED FOR PCH027 - CO#021
24	2025.09.02	ISSUED FOR PCH029
25	2025.09.02	ISSUED FOR SH020 - CO#018
26	2025.09.08	ISSUED FOR PCH031
27	2025.09.09	ISSUED FOR PCH032 - CO#022
28	2025.09.10	ISSUED FOR PCH033
29	2025.09.11	ISSUED FOR SH022
30	2025.09.15	ISSUED FOR SH023
31	2025.09.16	ISSUED FOR PCH F33 - CO#023
32	2025.09.30	ISSUED FOR PCH F37 - CO#019
33	2025.09.30	ISSUED FOR PCH F38 - CO#025
34	2025.10.04	ISSUED FOR PCH F39 - CO#024
35	2025.10.20	ISSUED FOR PCH F40
36	2025.10.30	ISSUED FOR PCH041
37	2025.10.23	ISSUED FOR PCH F42
38	2025.11.21	ISSUED FOR PCH020 R1 - CO12 CO#09
39	2025.11.14	ISSUED FOR PCH043
40	2025.11.26	ISSUED FOR PCH048
41	2025.12.03	ISSUED FOR PCH044 - CO#026
42	2026.02.04	ISSUED FOR RECORD SET UP TO CO#07

NOTES:

KEY PLAN:



CLIENT:
NEAR NORTH DISTRICT SCHOOL BOARD
NND58 Tender # 2023-015

PROJECT:
NEW PARRY SOUND K-12 SCHOOL & CHILDCARE
PARRY SOUND HIGH SCHOOL SITE

111 ISABELLA STREET
PARRY SOUND, ONTARIO

ORIGINAL PAGE SIZE ARCH E1 - 30" x 42"
KEY TO DETAIL LOCATION:
A - DETAIL NO.
B - DETAIL NO. ORIGIN


ARCHITECTS
THE VENTIN GROUP LTD



A4.11.2

DRAWN BY: jr

CHECKED BY: xx

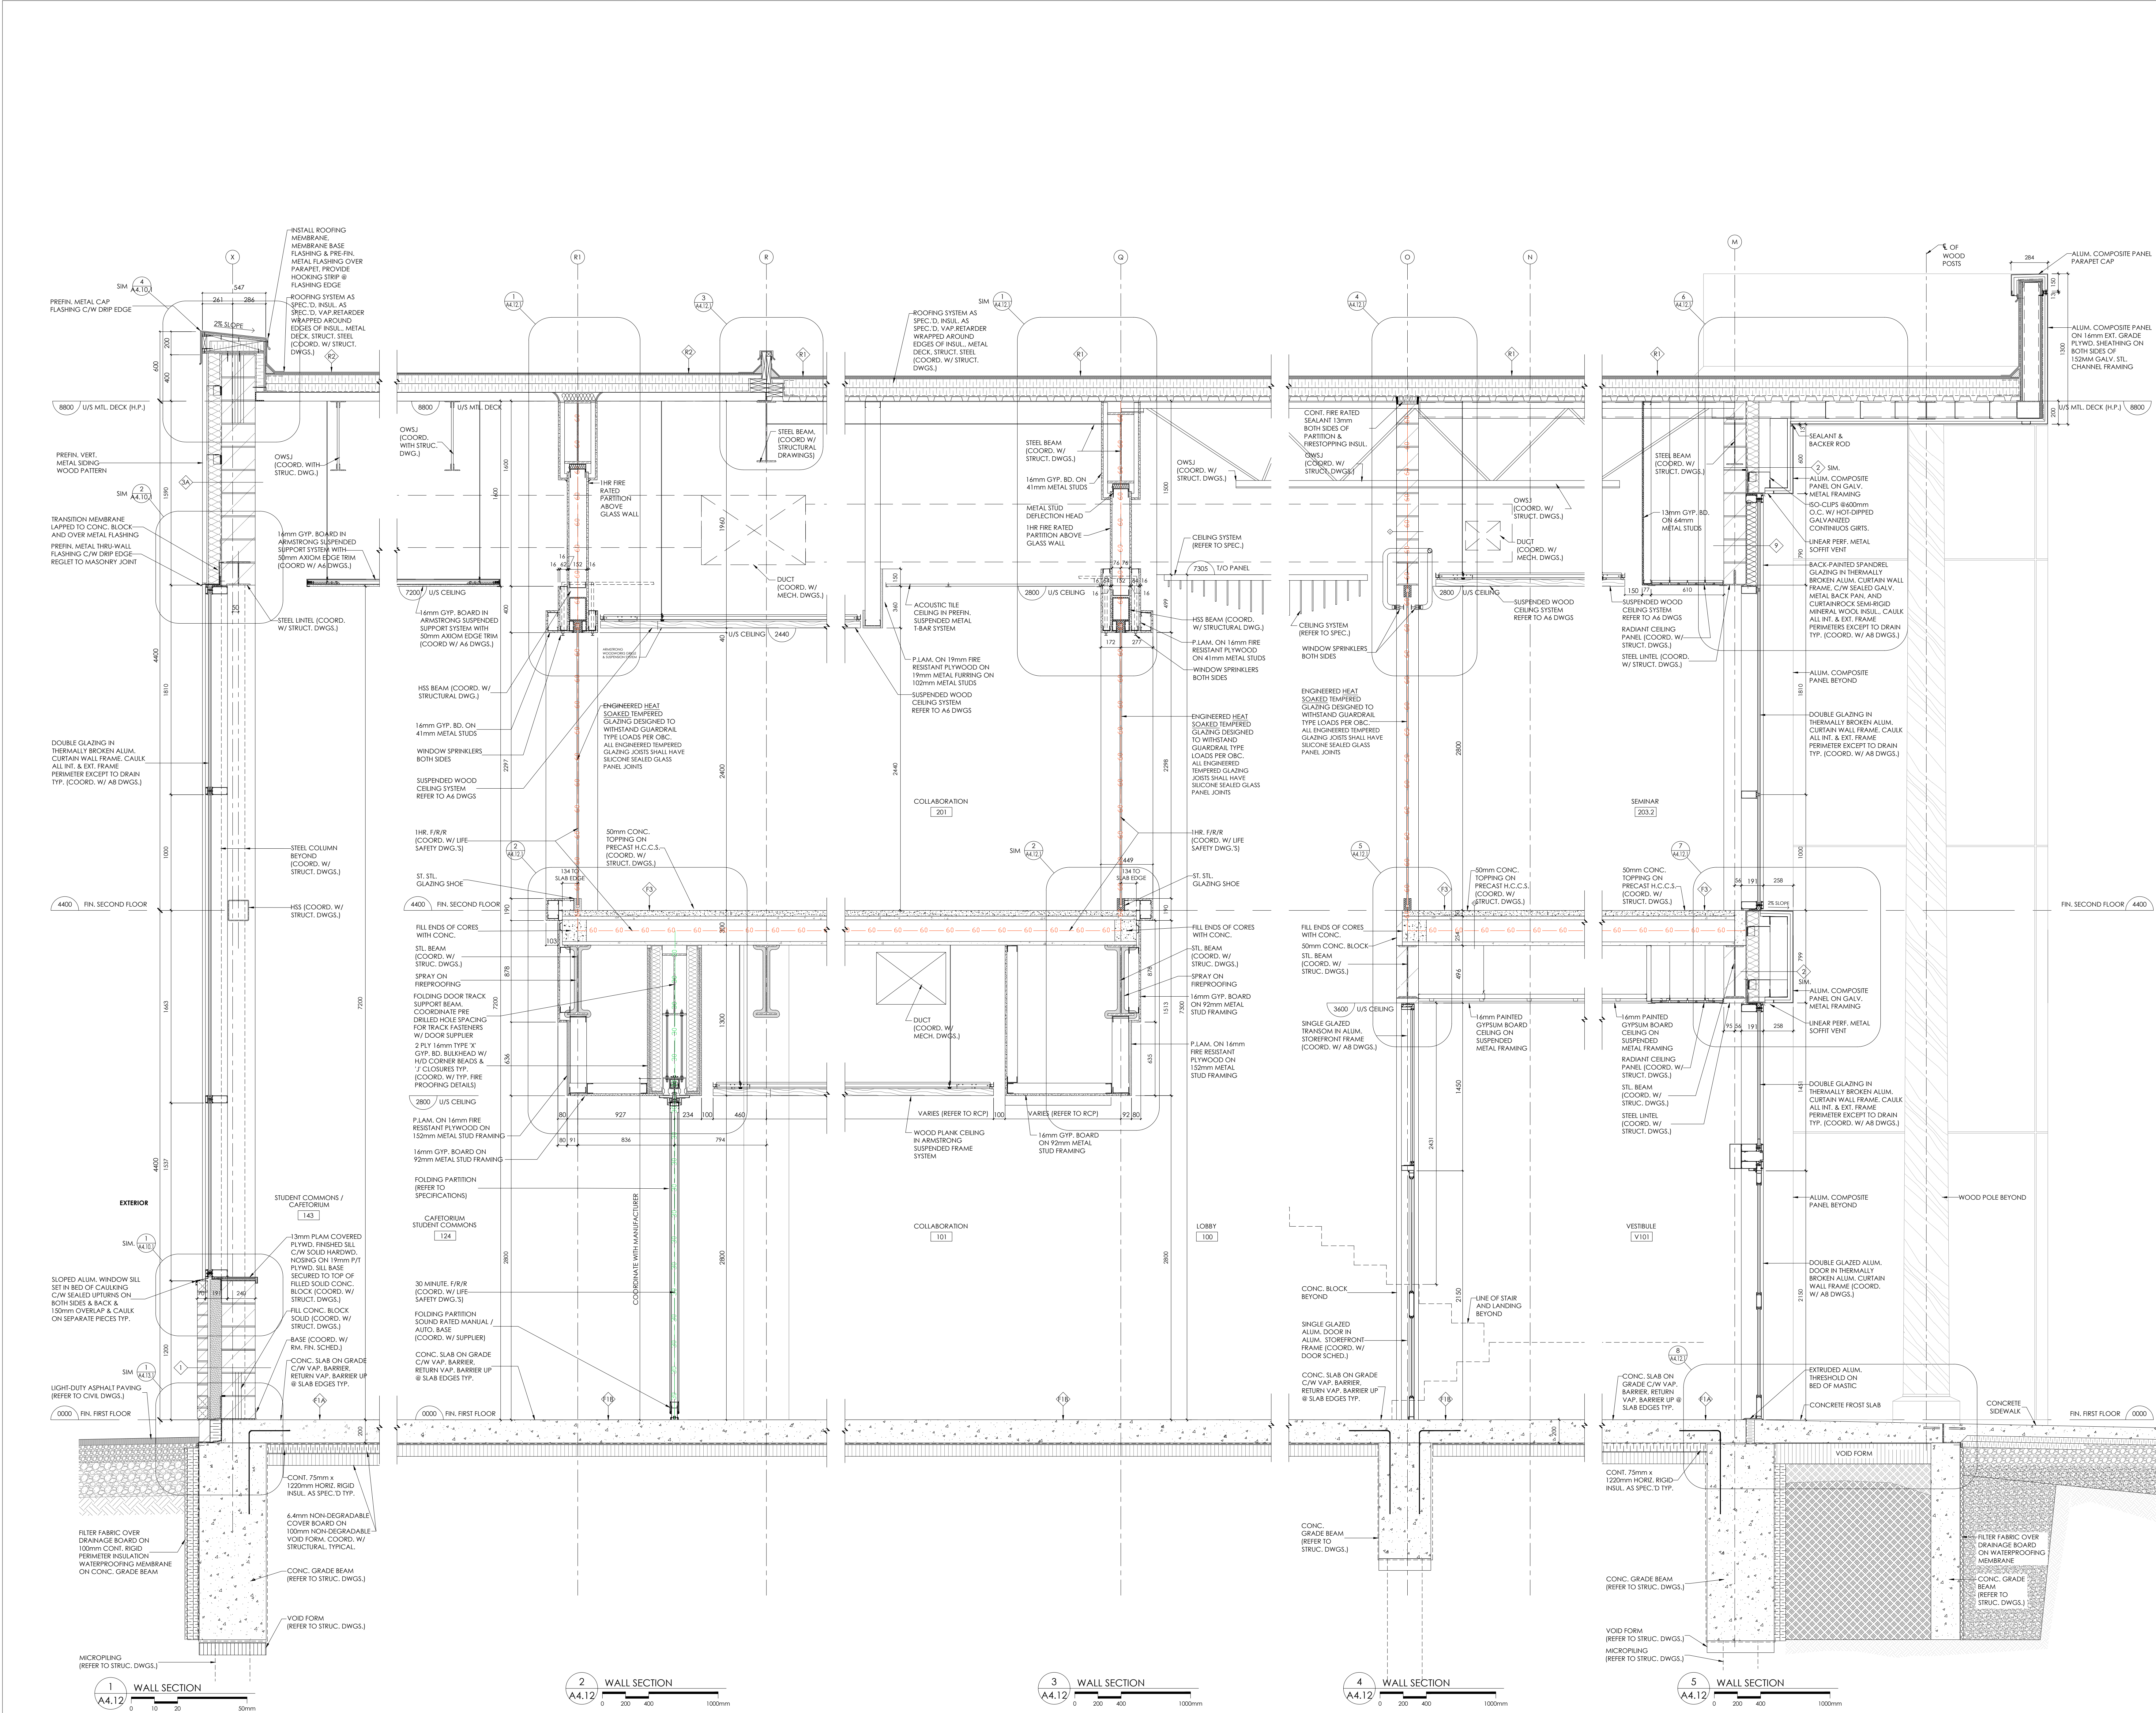

REVISIONS		
NO.	DATE	PARTICULAR
1	2022.04.06	ISSUED FOR 80% CLASS B COSTING
2	2022.06.18	ISSUED FOR SPA
3	2022.09.22	ISSUED FOR OWNERS REVIEW - RES SET
4	2022.12.16	ISSUED FOR 2nd SPA SUBMISSION
5	2023.01.31	ISSUED FOR TENDER
6	2023.02.22	ISSUED FOR ADDENDUM 9
7	2023.08.23	ISSUED FOR CONVENIENCE
8	2023.11.20	ISSUED FOR PERMIT COMMENTS
9	2024.01.24	ISSUED FOR SH03
10	2024.02.15	ISSUED FOR PCH038
11	2024.03.04	ISSUED FOR PCH039
12	2024.03.10	ISSUED FOR SH040
13	2024.03.14	ISSUED FOR SH040
14	2024.07.22	ISSUED FOR SH040
15	2024.08.07	ISSUED FOR SH040
16	2024.10.02	ISSUED FOR PCH015
17	2025.04.11	ISSUED FOR PCH015
18	2025.05.01	ISSUED FOR CO#07
19	2025.05.28	ISSUED FOR PCH020 - CO#010
20	2025.07.31	ISSUED FOR SH013
21	2025.08.06	ISSUED FOR SH014
22	2025.08.15	ISSUED FOR PCH025 - CO#017
23	2025.08.25	ISSUED FOR PCH027 - CO#021
24	2025.09.02	ISSUED FOR PCH029
25	2025.09.02	ISSUED FOR SH020 - CO#018
26	2025.09.08	ISSUED FOR PCH031
27	2025.09.09	ISSUED FOR PCH032 - CO#022
28	2025.09.10	ISSUED FOR PCH033
29	2025.09.11	ISSUED FOR SH022
30	2025.09.15	ISSUED FOR SH023
31	2025.09.16	ISSUED FOR PCH035 - CO#023
32	2025.09.30	ISSUED FOR PCH037 - CO#019
33	2025.09.30	ISSUED FOR PCH038 - CO#025
34	2025.10.04	ISSUED FOR PCH039 - CO#024
35	2025.10.20	ISSUED FOR PCH040
36	2025.10.30	ISSUED FOR PCH041
37	2025.10.23	ISSUED FOR PCH042
38	2025.11.21	ISSUED FOR PCH021/01 - CO12 CD030
39	2025.11.14	ISSUED FOR PCH043
40	2025.11.26	ISSUED FOR PCH043
41	2025.12.03	ISSUED FOR PCH044 - CO#026
42	2026.02.04	ISSUED FOR RECORD SET UP TO CO#027

NOTES:

KEY PLAN:



CLIENT:
NEAR NORTH DISTRICT SCHOOL BOARD
NND\$B tender # 2023-015

PROJECT:
NEW PARRY SOUND K-12 SCHOOL & CHILDCARE
PARRY SOUND HIGH SCHOOL SITE

111 ISABELLA STREET
PARRY SOUND, ONTARIO

ORIGINAL PAGE SIZE ARCH E1 - 30" x 42"
KEY TO DETAIL LOCATION:
A - DETAIL NO.
B - DETAIL NO. ORIGIN

VG ARCHITECTS
THE VENTIN GROUP LTD

A4.12

DRAWN BY: jr CHECKED BY: jk