



Addendum # 3

Bid Opportunity: 26-7848-RFT - Waterloo Collegiate Institute HVAC and Exterior Upgrades Phase 2

Closing Date: Thursday, March 26, 2026 2:00 PM

The following issued by the Board shall form part of the Bid / Proposal Solicitation document. The revisions and additions noted herein along with any attachments shall be read in conjunction with all other related documents. This Addendum shall, take precedence over the previously issued documents where differences occur. Receipt of this addendum must be acknowledged in the Bidding System, bids&tenders.

If you have already submitted a Bid / Proposal, it will be automatically withdrawn as a result of this addendum. You must resubmit the Bid / Proposal acknowledging all addenda and revising your Bid / Proposal to comply with all addenda.

Question 1:

On drawing A1.1 there is a demo note 8. Please confirm if this note says we are to repair all firestopping in the room or just at the locations of the existing ducts to

be removed. The entire room wasn't accessible during the walk through due to the existing unit in the room.

Answer 1:

Refer to Sheets A1.1, A1.3, and A1.6, dated 2026.03.26, attached and forming part of this addendum.

Question 2:

The specifications call for Curtain Wall systems, while the drawing details refer to 'Window Assemblies'—even though the details themselves appear to be for Curtain Walls. Consequently, we are assuming W1 through W10 and CW1/CW2 to be Curtain Wall unless otherwise noted

Answer 2:

Refer to Sheet A2.5 dated 2026.03.26, attached, and forming part of this addendum.

Question 3:

Section 10 51 13 identifies Lockers.

Please confirm lockers 18 inches x 18 inches x 72 inches are included within the tender. Please identify location of these lockers within drawings.

Answer 3:

Delete Specification, Section 10 51 13 (Page 2 of 4) in its entirety, and Replace with Section 10 51 13 R1, attached hereto and forming part of this addendum. Contractor to site verify locker dimensions. Refer to drawings for locker locations.

Question 4:

On drawing A1.2 demo note 12 can you please confirm the requirements of refinishing the rad cover. Are we just to paint it or is it required to have a powder coating on it?

Answer 4:

Refer to drawing 4/A1.5.

Question 5:

To properly price the firespray required we will need existing drawings for the structural steel.

Answer 5:

Refer to WCI – 1961 Addition Structural drawings, attached, and forming part of this addendum.

Question 6:

On drawings A1.3 it shows existing tiles to be removed, stored and, reinstalled. If the existing tiles are in bad shape will the replacement of them be extra to contract?

Answer 6:

Refer to A1.3, A1.5b, and A1.6, dated 2026.03.23, attached, and forming part of this addendum.

Question 7:

On drawing A4.1 Demo note D3 says reserved but is pointing to all the lights in the corridor.

Answer 7:

Refer to A1.4 dated 2026.03.23, attached, and forming part of this addendum.

Question 8:

Is heat trace cable required for any of the refrigerant or condensate lines.

Answer 8:

Heat tracing is not required on the refrigerant piping or condensate piping

Question 9:

On drawing A2.1 D4 - It is going to be much more cost effective to recap the existing columns then to patch and repair them. Also demo note 10 says to cut existing cover ceiling. The existing condition in this location is a bulkhead in front of the windows, what does the cover ceiling refer to?

Answer 9:

Thank you for the recommendation, but please proceed as per drawings. The Cove Ceiling referenced in the drawings refers to the bulkhead.

Question 10:

On A3.2 - The ceiling is hatched to be removed but no demolition notes are pointing the the corridor ceiling. It also doesn't note that there is to be a new ceiling installed either.

Answer 10:

Refer to all information on Sheet A3.2.

Question 11:

On A5.1 demo note D2 says to keep the existing ceiling. This is an old plaster ceiling that is already partially damaged.

Answer 11:

Refer to Sheet A5.1 and A5.2 dated 2026.03.23, attached, and forming part of this addendum.

Question 12:

There are two E3.1 drawings in the tender package.

Answer 12:

Duplicate sheet E3.1 appears to be a plotting issue. This duplicate drawing is to be removed from the package.

Question 13:

Locker specification 2.4.7 Doors, identifies 27 gauge. Please confirm Inner/outer door panel gauge. e. 14/20 ga 16/20 ga 14/24 ga. 27 gauge is not listed as a typical locker gauge.

Answer 13:

Delete Specification, Section 10 51 13 (Page 2 of 4 and Page 3 of 4) in its entirety, and Replace with Section 10 51 13 R1 (Page 2 of 4 and Page 3 of 4), attached hereto and forming part of this addendum.

Question 14:

Reference Drawing, A4.1 identifies 1. Existing to remain locker bodies, including shelves, exposed interior, exterior. 2. All lockers missing hooks to receive new hooks. 3. New Locker Doors to be installed on all existing locker bodies. The Locker Keynotes, identify Replace Missing Hooks, and Supply new Doors. Under Electric Painting - identifies Locker bodies to be painted. Please confirm interpretation of Locker Keynotes, Painting, and New Fronts.

Answer 14:

Refer to drawings A4.1 and A4.2 dated 2026.03.23, attached, and forming part of this addendum.

Question 15:

Please confirm location of Commercial Lockers, within drawings. Commercial Locker as noted within Locker Specification.

Answer 15:

Refer to Specification, Section 10 51 13 R1, Page 2 of 4, attached, and forming part of this addendum

Clarification Initiated by the Board/ Consultant

Clarification 1

Due to the absence of a detailed specification for the thermally broken storefront system indicated on drawing S01/ A5.2, please reference a thermally broken system of performance equivalent to the 451UT series to maintain continuity with the building envelope's high-performance thermal requirements, or approved equivalent.

Clarification 2

At this time, the specification for "Section 10 51 13 METAL LOCKERS" remains unchanged. Due to time constraints, alternates request cannot be reviewed as part of this tender and will not be accepted. Alternate products may be considered for future projects at the discretion of the Board.

Clarification 3

Contractors shall carry a Cash Allowance of \$20,000.00 for the Door Hardware Finish Schedule, to cover hardware supply and installation associated with the specified openings.

End of Addendum

2 Products

2.1 APPROVED PRODUCTS AND MANUFACTURERS

- .1 Basis-of-Design Products: Products named in this Section were used as the basis-of-design for the project; additional manufacturers offering similar products may be incorporated into the work of this Section provided they meet the performance requirements established by the named products and provided they submit requests for substitution in accordance with Division 01.
- .2 Subject to compliance with requirements, manufacturers offering products that may be incorporated into the Work include; but are not limited to, the following:
 - .1 ASI Storage Solutions Inc.
 - .2 Shanahan's Building Products
 - .3 GSS (General Storage Systems)
 - .4 Hadrian Manufacturing Inc.
- .3 ~~Commercial Lockers:~~ **Metal Lockers:**
 - .1 Size: ~~457mm (18") wide x 457mm (18") deep x 1829mm (72") high:~~
305mm +/- (12" +/-) wide x 381mm +/- (15" +/-) deep x 1829mm (72") high
 - .2 Construction:
 - .1 Doors: One-piece double wall envelope construction, complete with honeycomb core, welded construction, complete with recessed handle box.
 - .1 Outer Panel: 16 gauge thick.
 - .2 Inner Panel: 20 gauge thick.
 - .2 Frame: Minimum 16 gauge steel channel, welded construction complete with 11 gauge padlock hasp.
 - .3 Body: Minimum gauge requirements:
 - .1 Panels: 20 gauge.
 - .2 Shelves: 16 gauge.
 - .3 Fillers: 16 gauge.
 - .4 Bottoms: 16 gauge.
 - .5 End Panels: 16 gauge.
 - .6 Bolt Spacing: 229mm o.c. maximum spacing.
 - .4 Handle: Recessed lock pocket, one piece construction, 20 gauge.
 - .5 Tops: Sloped, continuous overtop of a bank of lockers, 20 gauge.
 - .6 Hinge: Continuous, heavy-duty full length 16 gauge piano hinge riveted to both door and frame.
 - .3 Configuration: Single tier.
 - .4 Basis of Design Product: SLM Deluxe Series Locker by Shanahan's Building Products.
 - .1 Acceptable alternate models and manufacturers:
 - .1 Tradition Plus Collection by ASI Storage Solutions Inc.
 - .2 Excalibur Locker by General Storage Systems Ltd.
 - .3 Atlas Institutional Lockers by Anthony Steel Manufacturing.

2.2 MATERIALS



- .1 Sheet Steel: Cold rolled carbon steel, commercial quality stretcher levelled or temper rolled to stretcher levelled standard of flatness free from surface imperfections and conforming to ASTM A366/A336M-91.
- .2 Locker Paint: Electrostatically applied, thermo-setting, high performance primer and powder coating.
- .3 Welding Materials: Conforming to CSA W59.
- .4 Fasteners: Non-corrosive type.
- .5 Steel Plate: Conforming to CAN/CSA-G40.20/G40.21, Grade 44W.
- .6 Chromeplating: Chrome plating on steel by "electroplating" method, with plating sequence as follows; 0.00035" thickness of Copper, followed by 0.00039" thickness of Nickel, followed by 0.00064" thickness of Chromium.
- .7 Polyurethane Coating: Oil modified, clear gloss or stain interior type conforming to CAN/CGSB-1.175-M.

2.3 FINISHES


- .1 Lockers:
 - .1 Specially treat metal locker surfaces by phosphate conversion process conforming to CGSB 31-GP-105a, ready to receive locker paint finish.
 - .2 Electrostatically apply locker paint to all metal locker surfaces. Colours as selected by Consultant from manufacturer's standard product range.

2.4 FABRICATION


- .1 General: Make work square, plumb, straight and true. Make joints and intersections tightly fitted and securely fastened.
- .2 Finish: All parts to be thoroughly degreased, cleaned and given a bonding, rust-retarding phosphate coat and two finish coats of powder coating. Material then to be baked to produce a hard durable finish.
- .3 Body: End sides to have double bend at front edge to add stiffness. Front edge of shelf to be bent to prevent small items from rolling off.
- .4 Sloping Tops: Constructed in long lengths, not less than 3658mm. Provide all angle and channel framing required. All fastenings to be concealed. Panels shall be accurately formed free of waves and buckles and set true to line horizontally and vertically.
- .5 Filler Panels: Minimum 20 gauge sheet steel, powder coated to match locker colour. Extend filler panels from finished floor to top of sloping top. Top of panel to be same slope as sloping top. Secure panels from inside of lockers.
- .6 Door Frames: Vertical members to have three right angle bends to reduce the danger of exposed edges and add strength. Horizontal members to be bent to channel shape of 19mm x 63.5mm x 19mm. Weld parts together to form a strong, rigid unit. Provide two rubber bumpers on lock side of frame approximately 38mm from top and bottom of door.
- .7 Doors: Fully enclosed at rear with a flush minimum ²⁰~~27~~ gauge thick reinforcing sheet to form a closed box and make a rigid, whip-free unit. Face of door to be free from protruding handles, locks, louvers, etc.
- .8 Bases (where concrete bases are not indicated): 18-gage sheet steel, powder coated to match locker colour, 100mm high, complete with top and bottom legs and intermediate vertical steel reinforcement at back.
- .9 Commercial Locker Ventilation: Cut slots at top and bottom of each locker to allow air to flow freely in and out of entire locker from bottom to top.

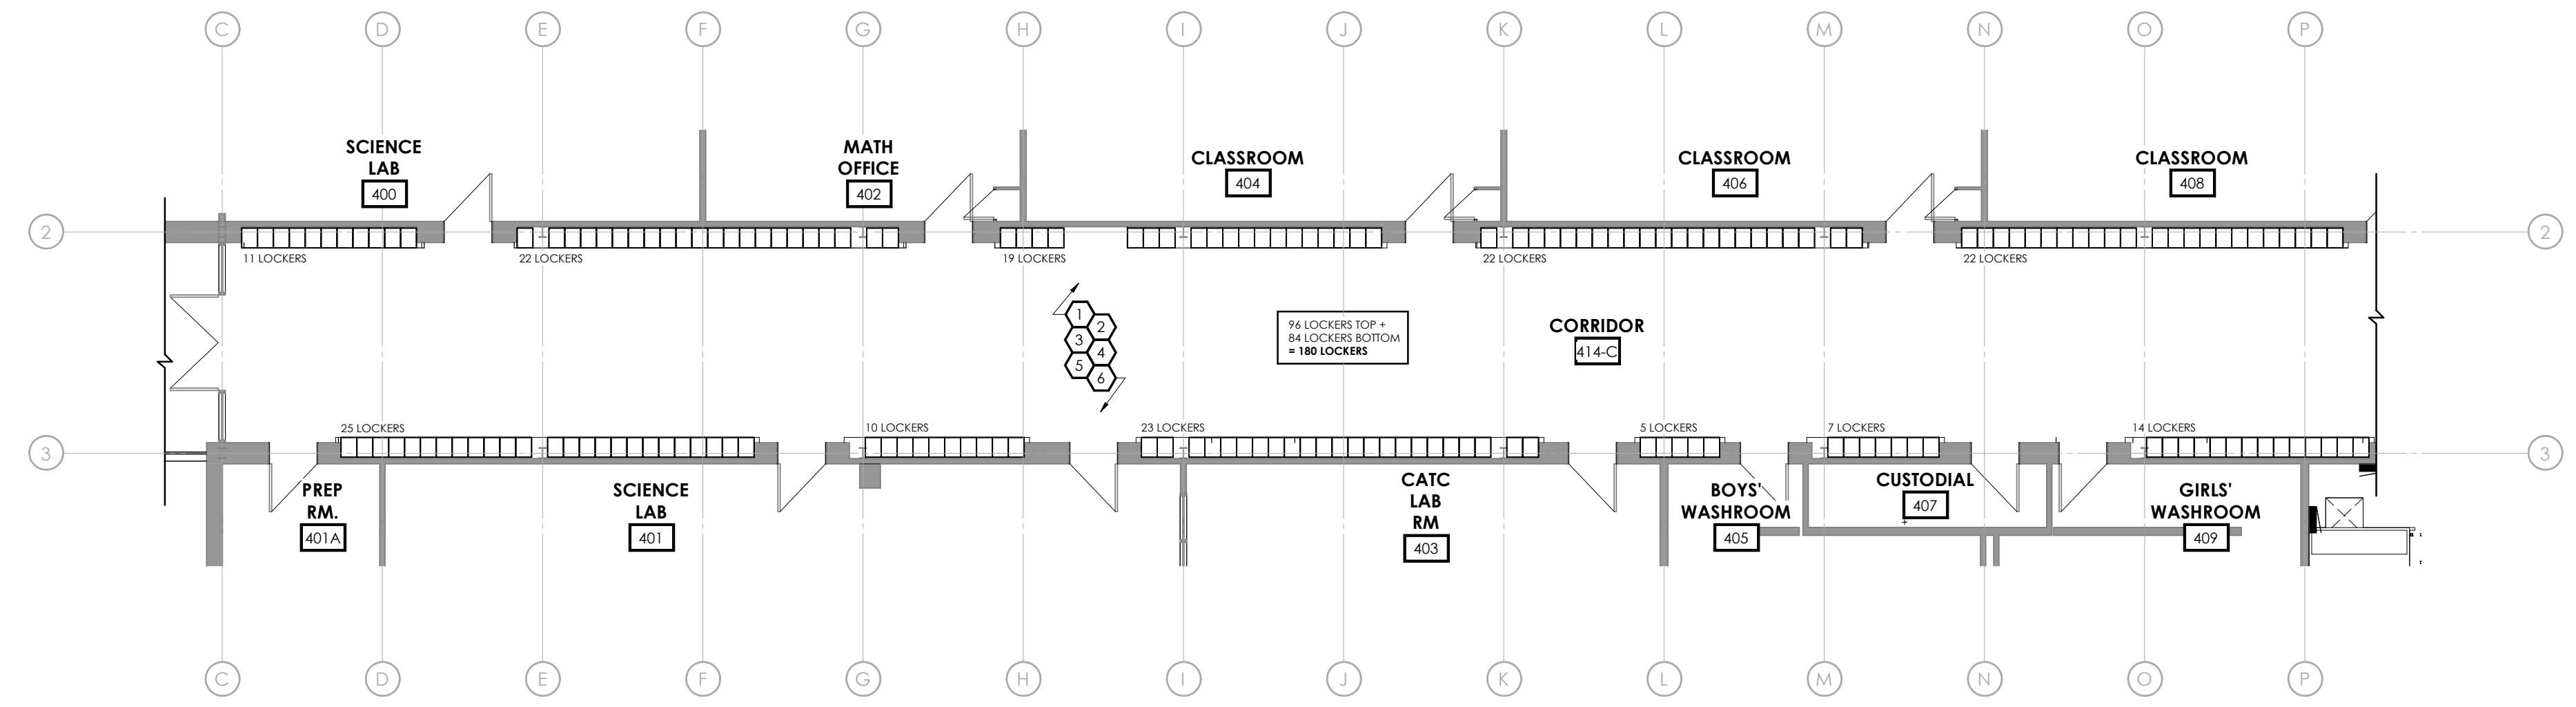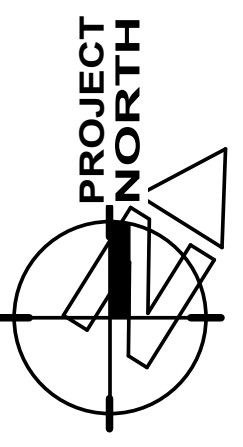

1 LOCKER IMPROVEMENTS - WING A 400 LEVEL UPPER - WEST
A4.2 1:100

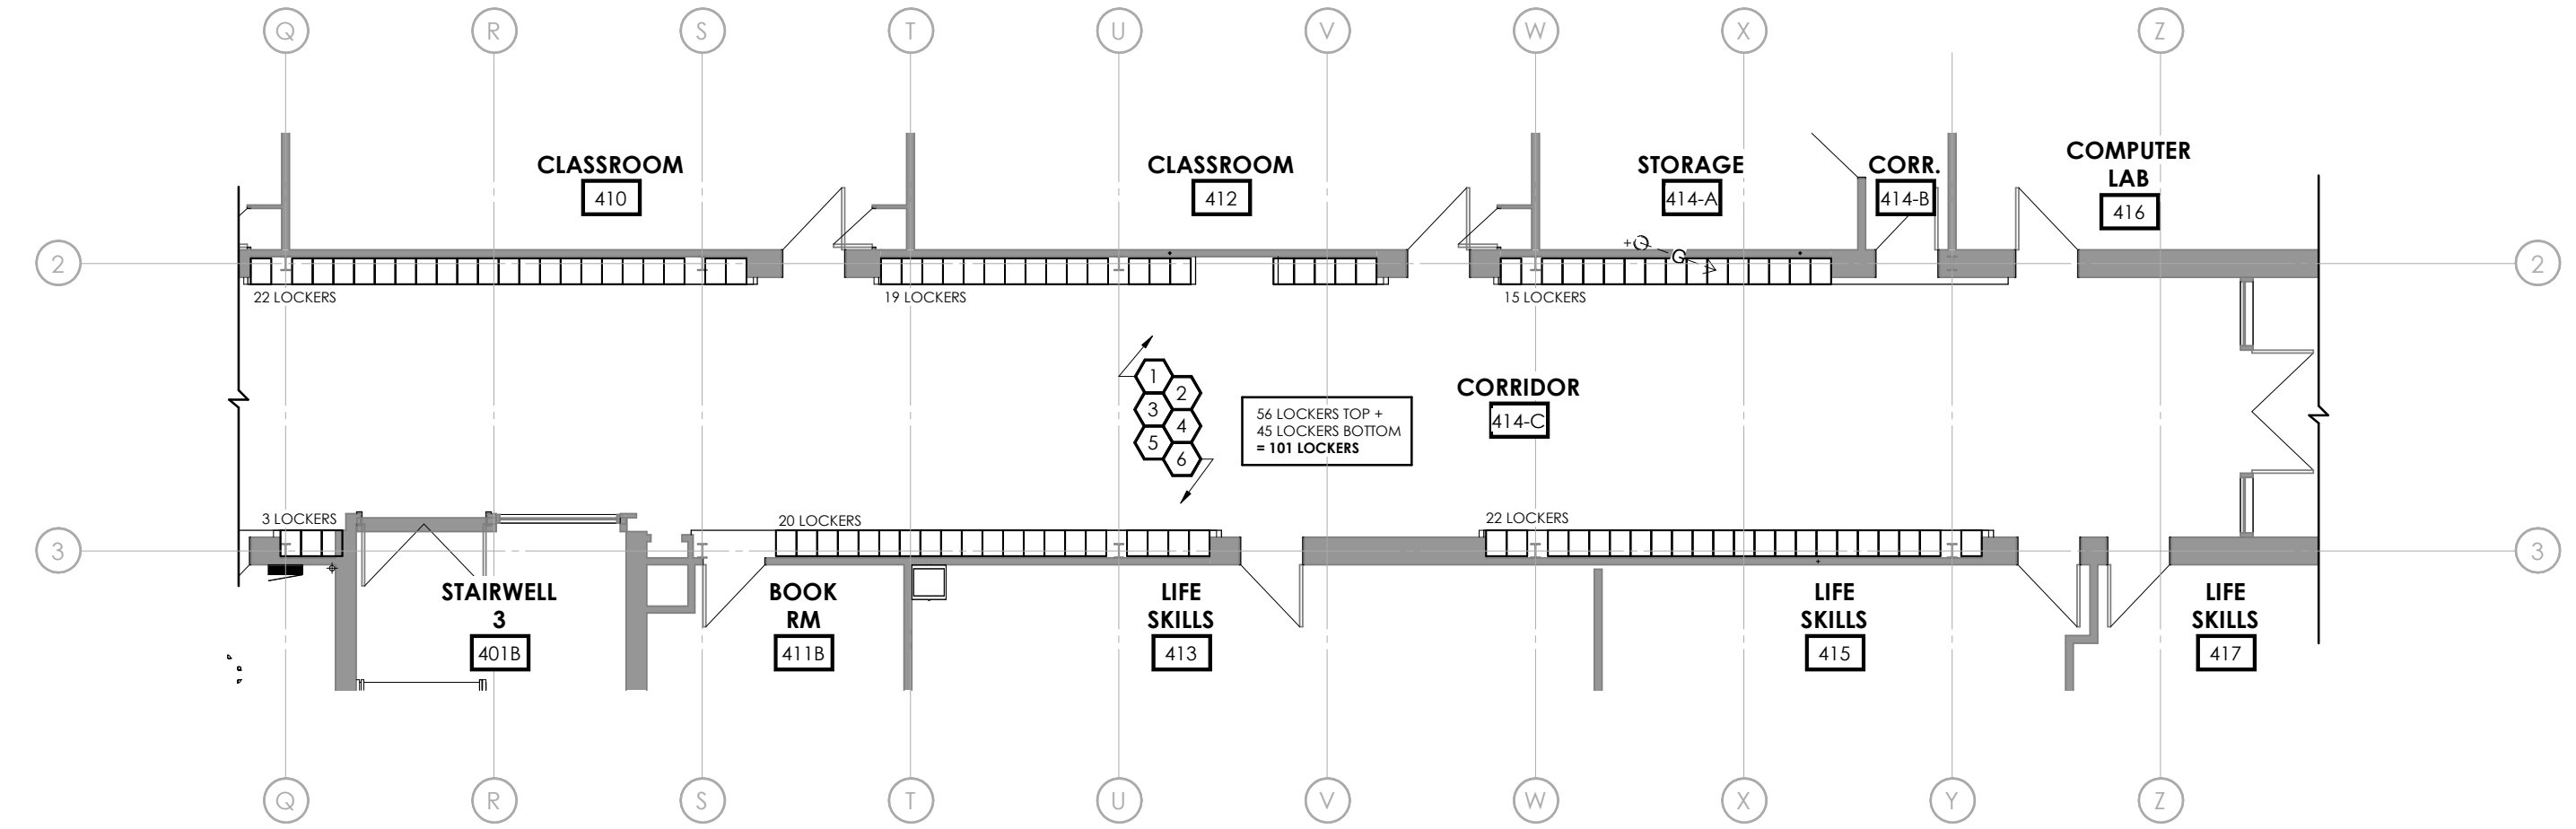

2 LOCKER IMPROVEMENTS - WING A 400 LEVEL UPPER - EAST
A4.2 1:100

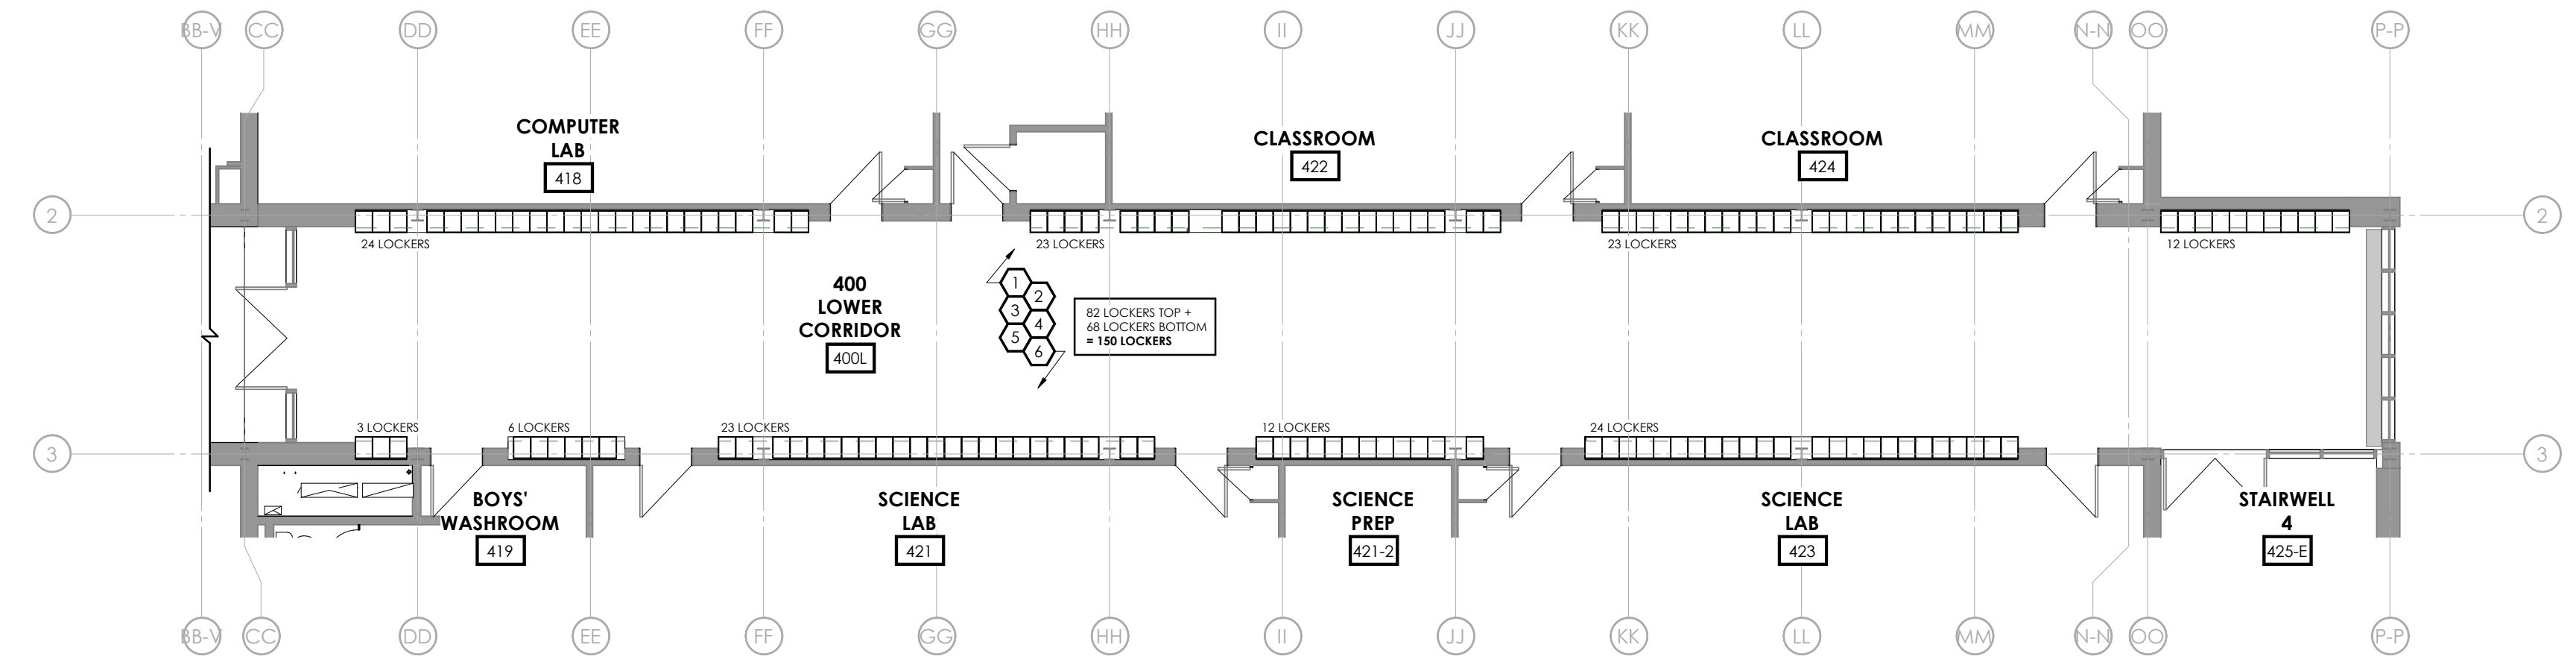

3 LOCKER IMPROVEMENTS - WING A 400 LEVEL LOWER
A4.2 1:100

LOCKER GENERAL NOTES

- QUANTITY OF LOCKERS INDICATED ON PLANS IS FOR REFERENCE ONLY. CONTRACTOR TO CONFIRM NUMBER OF LOCKERS ON SITE. CONFER WITH DESIGNER IF ANY UNANTICIPATED, IRREPARABLE COMPONENTS OF THE LOCKER BAYS ARE IDENTIFIED.
- ELECTROSTATIC PAINT FINISH TO MATCH EXISTING BLUE FINISH ON PREVIOUSLY RE-FINISHED LOCKERS THROUGHOUT SCHOOL.

LOCKER KEYNOTES

- EXISTING TO REMAIN LOCKER BODIES, INCLUDING SHELVES, EXPOSED INTERIOR CORNER AND FILLER PANELS, TO RECEIVE NEW ELECTROSTATIC PAINT FINISH.
- ALL LOCKERS MISSING HOOKS TO RECEIVE NEW HOOKS. STYLE AND LOCATION / HEIGHT TO MATCH EXISTING. REFER TO SPECIFICATIONS.
- REMOVE AND DISPOSE OF EXISTING LOCKER DOORS. NEW LOCKER DOORS TO BE INSTALLED ON ALL EXISTING LOCKER BODIES. CONTRACTOR TO SITE VERIFY LOCKER SIZES PRIOR TO ORDERING. STYLE AND COLOUR TO MATCH LOCKER DOORS IN CORRIDOR OF WING 'A' UPPER 300 LEVEL.
- ALL LOCKERS TO RECEIVE NEW RAISED BASE PANS OVER EXISTING BASE. COLOUR TO MATCH NEW LOCKER FINISH.
- ALL SHEET METAL INFILL PANELS OVER COLUMN LOCATIONS, ABOVE LOCKERS, TO RECEIVE NEW RAISED CAPS. TO RECEIVE NEW ELECTROSTATIC PAINT FINISH. COLOUR TO MATCH NEW LOCKER FINISH.
- ALL NEW LOCKERS TO MATCH EXISTING LOCKER NUMBERING AS VERIFIED BY THE SCHOOL BOARD. MANUFACTURER TO NOTE ALL EXISTING LOCKER NUMBERS FOR MATCHING AT INSTALLATION.

THIS DRAWING IS AN INSTRUMENT OF SERVICE & IS THE PROPERTY OF ABA ARCHITECTS INC. & CANNOT BE MODIFIED AND/OR REPRODUCED WITHOUT THE PERMISSION OF ABA ARCHITECTS INC.
THE CONTRACTOR MUST VERIFY ALL DIMENSIONS ON SITE AND REPORT ANY DISCREPANCIES TO THE ARCHITECT, BEFORE PROCEEDING WITH THE WORK.
DRAWINGS ARE NOT TO BE SCALED.

No.	REVISIONS	DATE
1	ADDENDUM 03	2026.03.23

***IMPORTANT NOTE TO ALL CONTRACTORS/SUB-CONTRACTORS:**
THIS SCOPE OF WORK CONTAINS ASBESTOS CONTAINING MATERIALS (ACM). ALL CONTRACTORS SHALL REFER TO THE ASBESTOS AUDIT AND SECTION 01 35 43, HAZARDOUS MATERIALS FOR APPROPRIATE PROTOCOLS THAT MUST BE FOLLOWED, REGARDLESS OF ABATEMENT OPERATIONS BEING CONDUCTED OR NOT.


ISSUED FOR PERMIT/TENDER	2026.03.03
ISSUED FOR COORDINATION	2026.02.26
CHRONOLOGY	DATE



CLIENT
**WATERLOO COLLEGIATE INSTITUTE
HVAC AND EXTERIOR UPGRADES PHASE 2**
300 HAZEL STREET, WATERLOO, ON. N2L 3P2

DRAWING TITLE
LOCKER IMPROVEMENTS - WING 'A' UPPER & LOWER 400 LEVEL


SCALE	As indicated	DRAWING NUMBER	A4.2
SHEET SIZE	609 x 914	PROJECT NUMBER	
PROJECT NUMBER	2025-153		

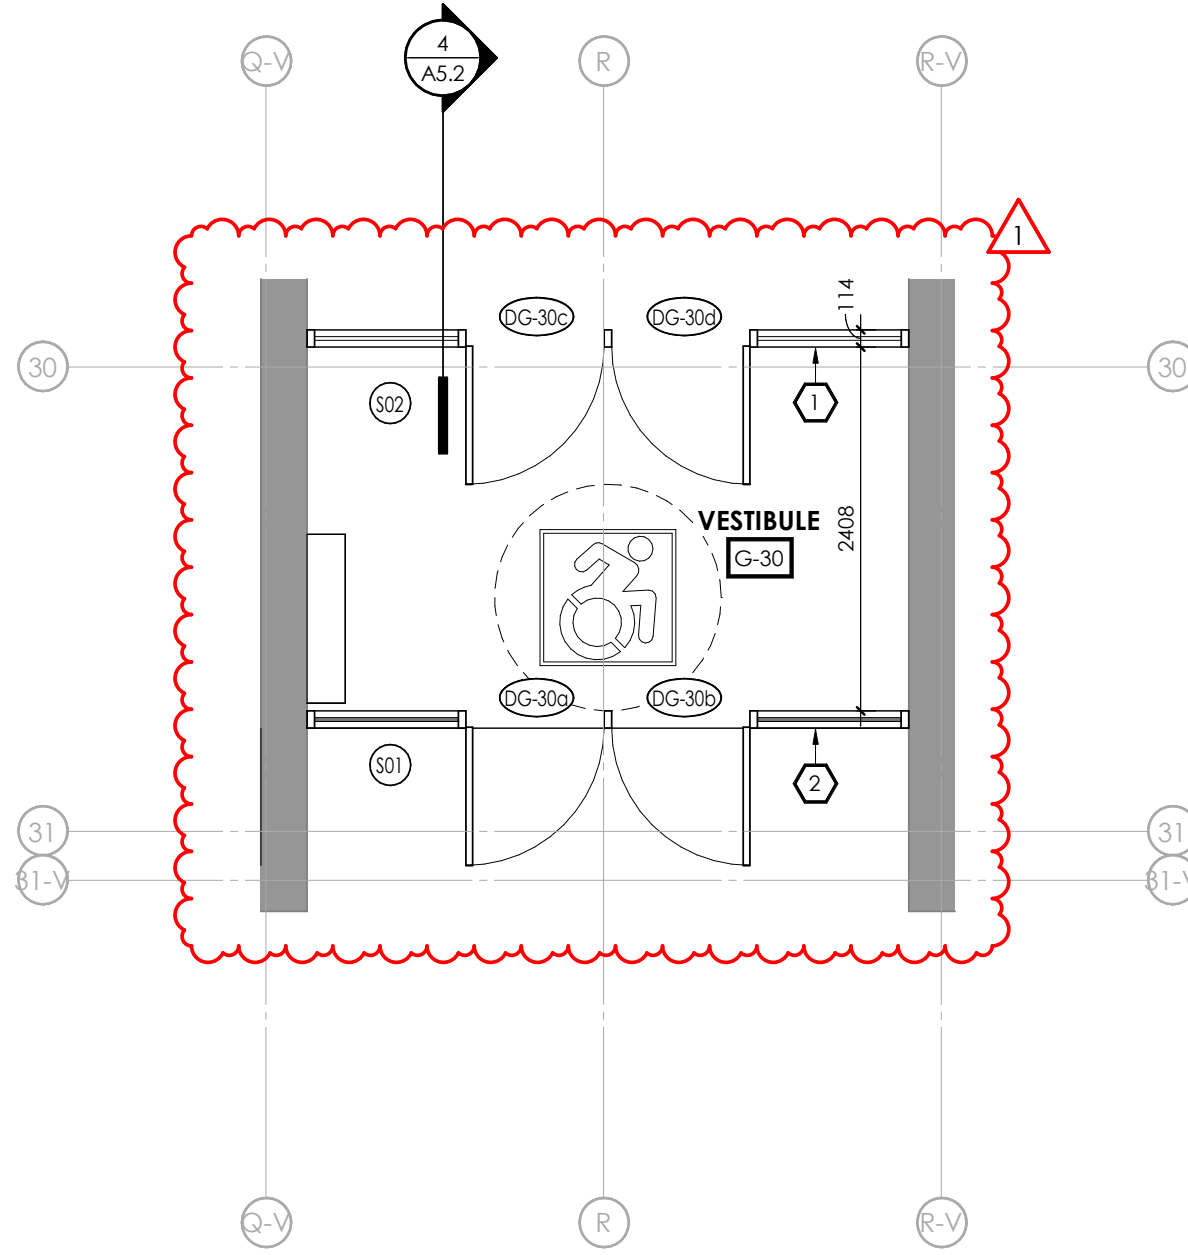

1 WING C - ENLARGED PLAN - VESTIBULE G-30 1:50

- ### FLOOR PLAN KEYNOTES
- 1 APPROXIMATE LOCATION OF NEW SCREEN ASSEMBLY, SITE VERIFY LOCATION.
 - 2 INSTALL NEW SCREEN ASSEMBLY IN SAME LOCATION AS PREVIOUS SCREEN ASSEMBLY, SITE VERIFY LOCATION AS REQUIRED.


- ### FLOOR PLAN LEGEND
- EXISTING WALL TO REMAIN (SHOWN SHADED)
 - PROPOSED WALL AS NOTED (REFER TO WALL SCHEDULE)
 - EXISTING DOOR AND FRAME TO REMAIN
 - PROPOSED DOOR AND FRAME AS NOTED (REFER TO DOOR SCHEDULE)
 - EXISTING WINDOW AND FRAME TO REMAIN
 - PROPOSED WINDOW TAG: (REFER TO WINDOW SCHEDULE)
 - PROPOSED SCREEN TAG: (REFER TO SCREEN SCHEDULE)
 - DENOTES EXISTING BUILDING TO REMAIN
 - DENOTES AREA N.I.C. UNLESS NOTED OTHERWISE

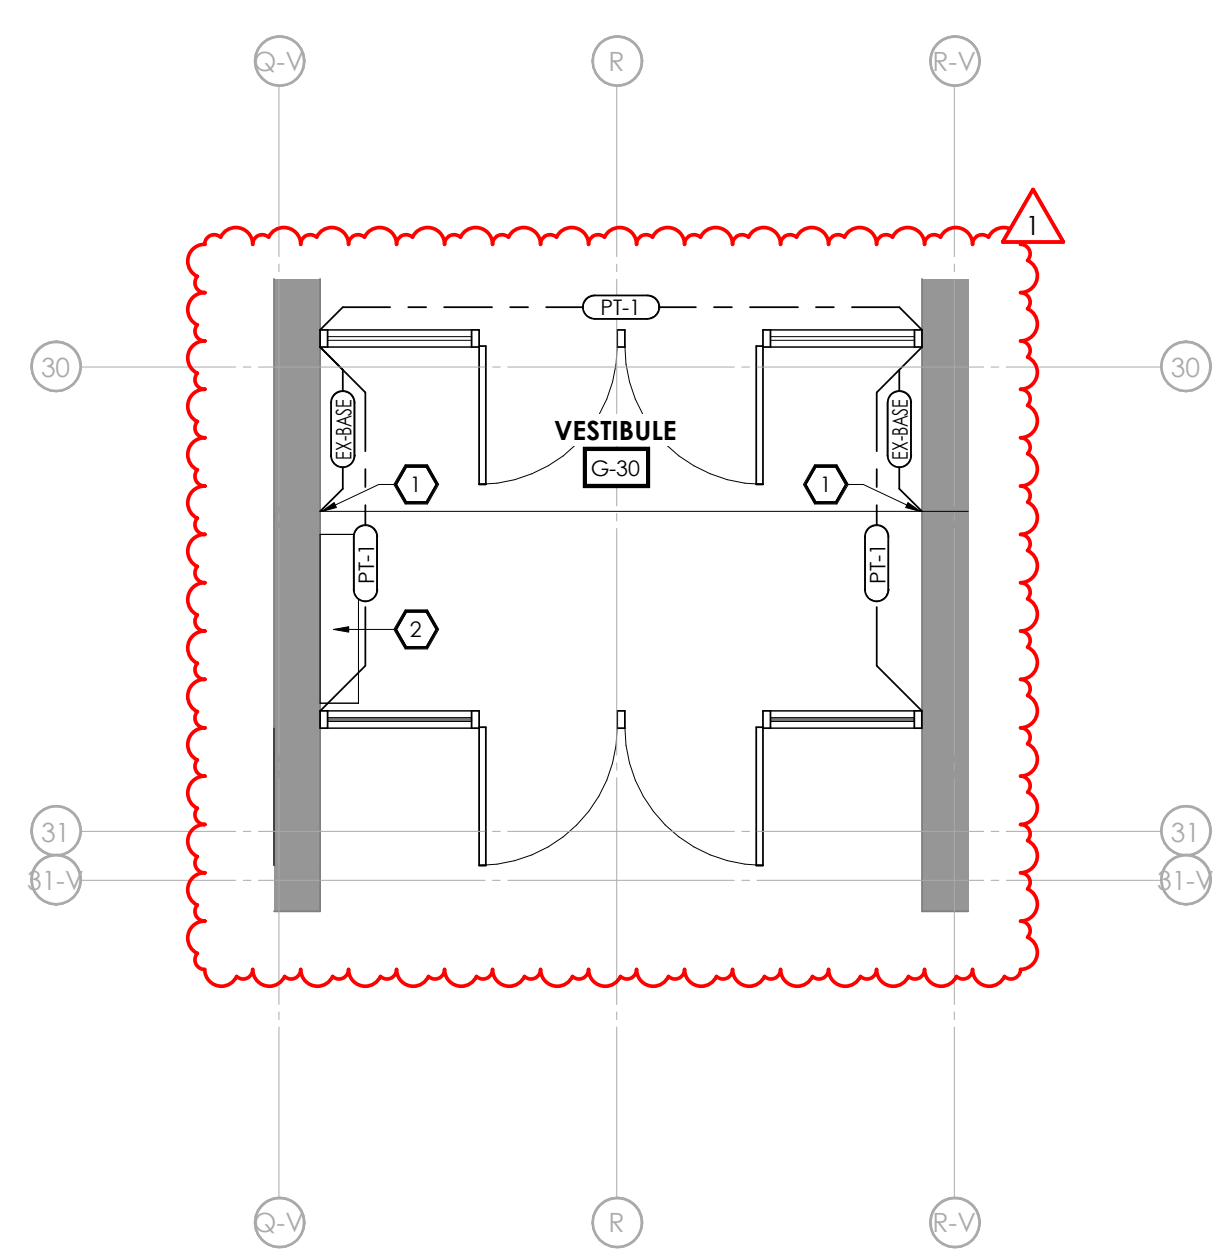


2 WING C - ENLARGED FINISHES PLAN - VESTIBULE G-30 1:50

- ### FINISH PLAN KEYNOTES
- 1 FINAL WALL CONDITION TO BE CONFIRMED FOLLOWING REMOVAL OF EXISTING SCREEN ASSEMBLY. WALL BASE TERMINATION TO BE INSTALLED AT EXTENT OF EXISTING WALL BASE. IF UNABLE TO COMPLETELY REMOVE CAULKING, ALTERNATIVE 152 WIDE ANODIZED ALUMINUM PLATE TO BE INSTALLED OVER TRANSITION BETWEEN BRICK AND CONCRETE BLOCK, ENSURING CAULKING AND WALL BLEMISHES ARE COVERED. SITE VERIFY AND COORDINATE WITH OWNER.
 - 2 EXISTING RADIATOR COVER TO RECEIVE NEW PAINT FINISH TO MATCH NEW WALL PAINT FINISH.


- ### FINISH MATERIAL SPECIFICATIONS
- PAINT**
- PT-1 (GENERAL WALL & CEILING COLOUR) BENJAMIN MOORE COLOUR: CC-20, DECORATOR'S WHITE PRODUCT: BENJAMIN MOORE PRE-CATALYZED WATERBORNE EPOXY (OR APPROVED ALTERNATE BY DULUX OR SHERWIN WILLIAMS) *EGGSHELL FINISH ON WALL APPLICATIONS IN CLASSROOMS (GLOSS LEVEL G3) **SEMI-GLOSS FINISH ON WALL APPLICATIONS IN CORRIDORS (GLOSS LEVEL G5) ***FLAT FINISH AT CEILING APPLICATIONS (GLOSS LEVEL G1) ****PAINT TO BE APPLIED AROUND EXISTING WALL MOUNTED FIXTURES (TACKBOARDS, ETC.), EXISTING FIXTURES TO BE PROTECTED PRIOR TO PAINTING.

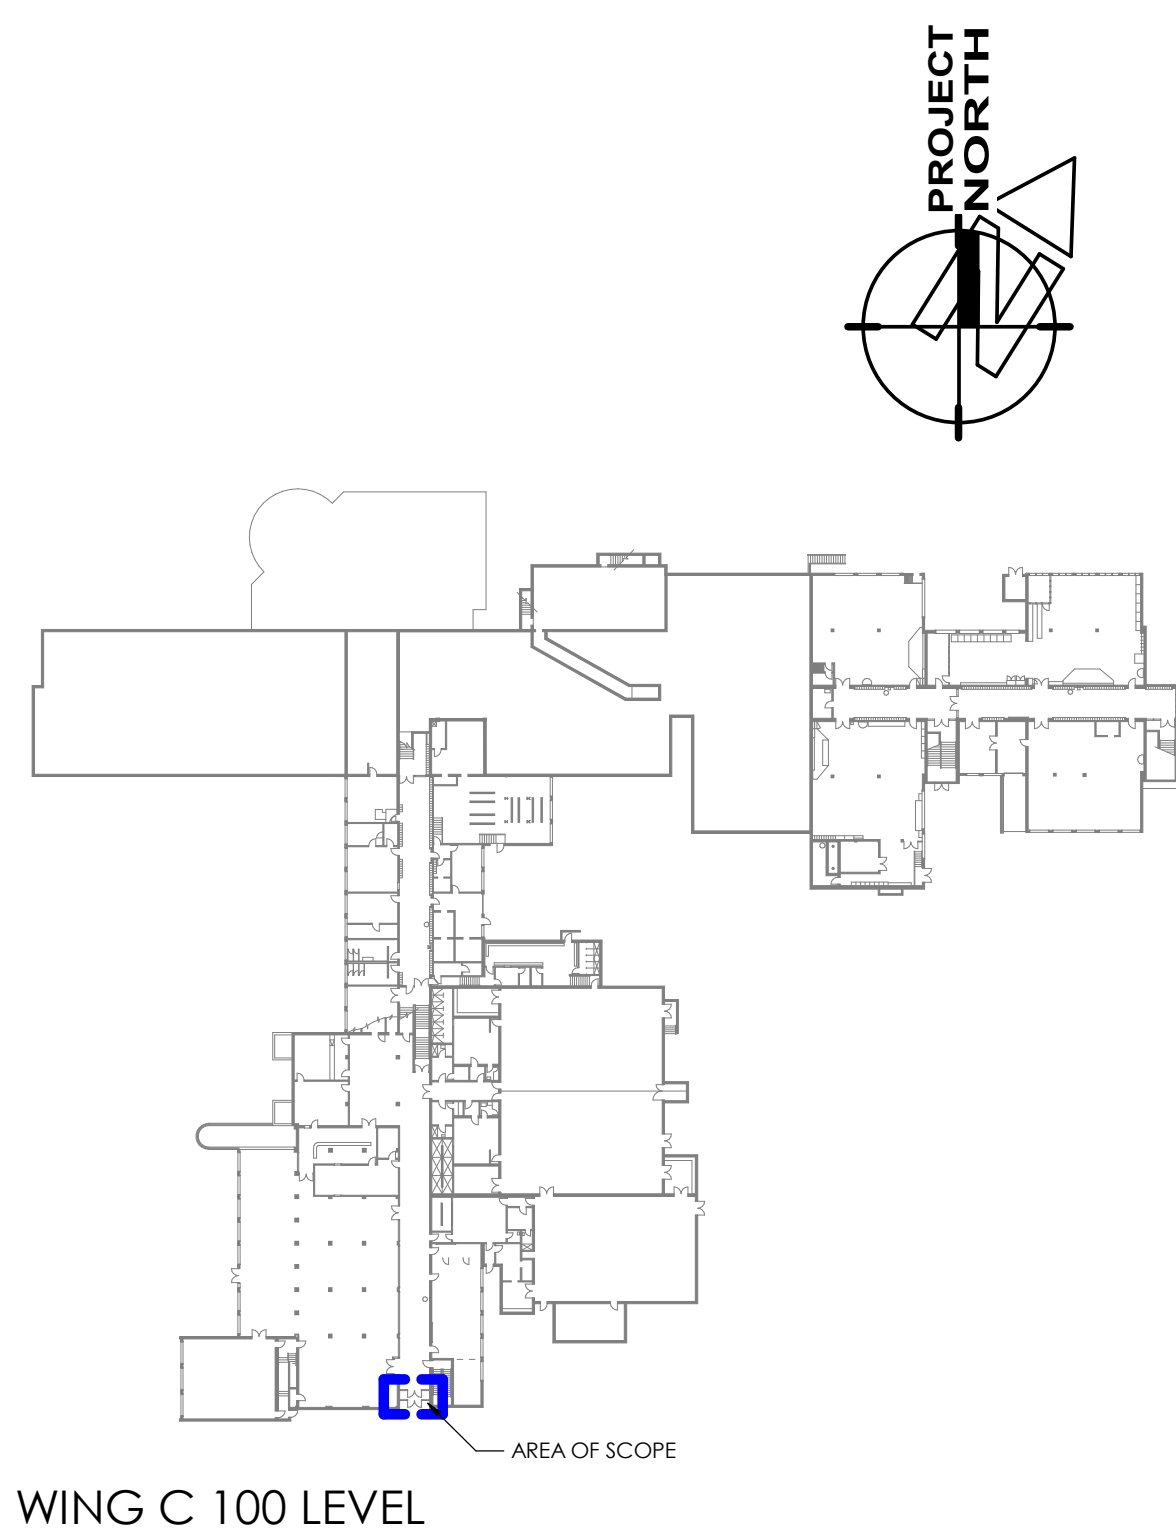

WING C 100 LEVEL

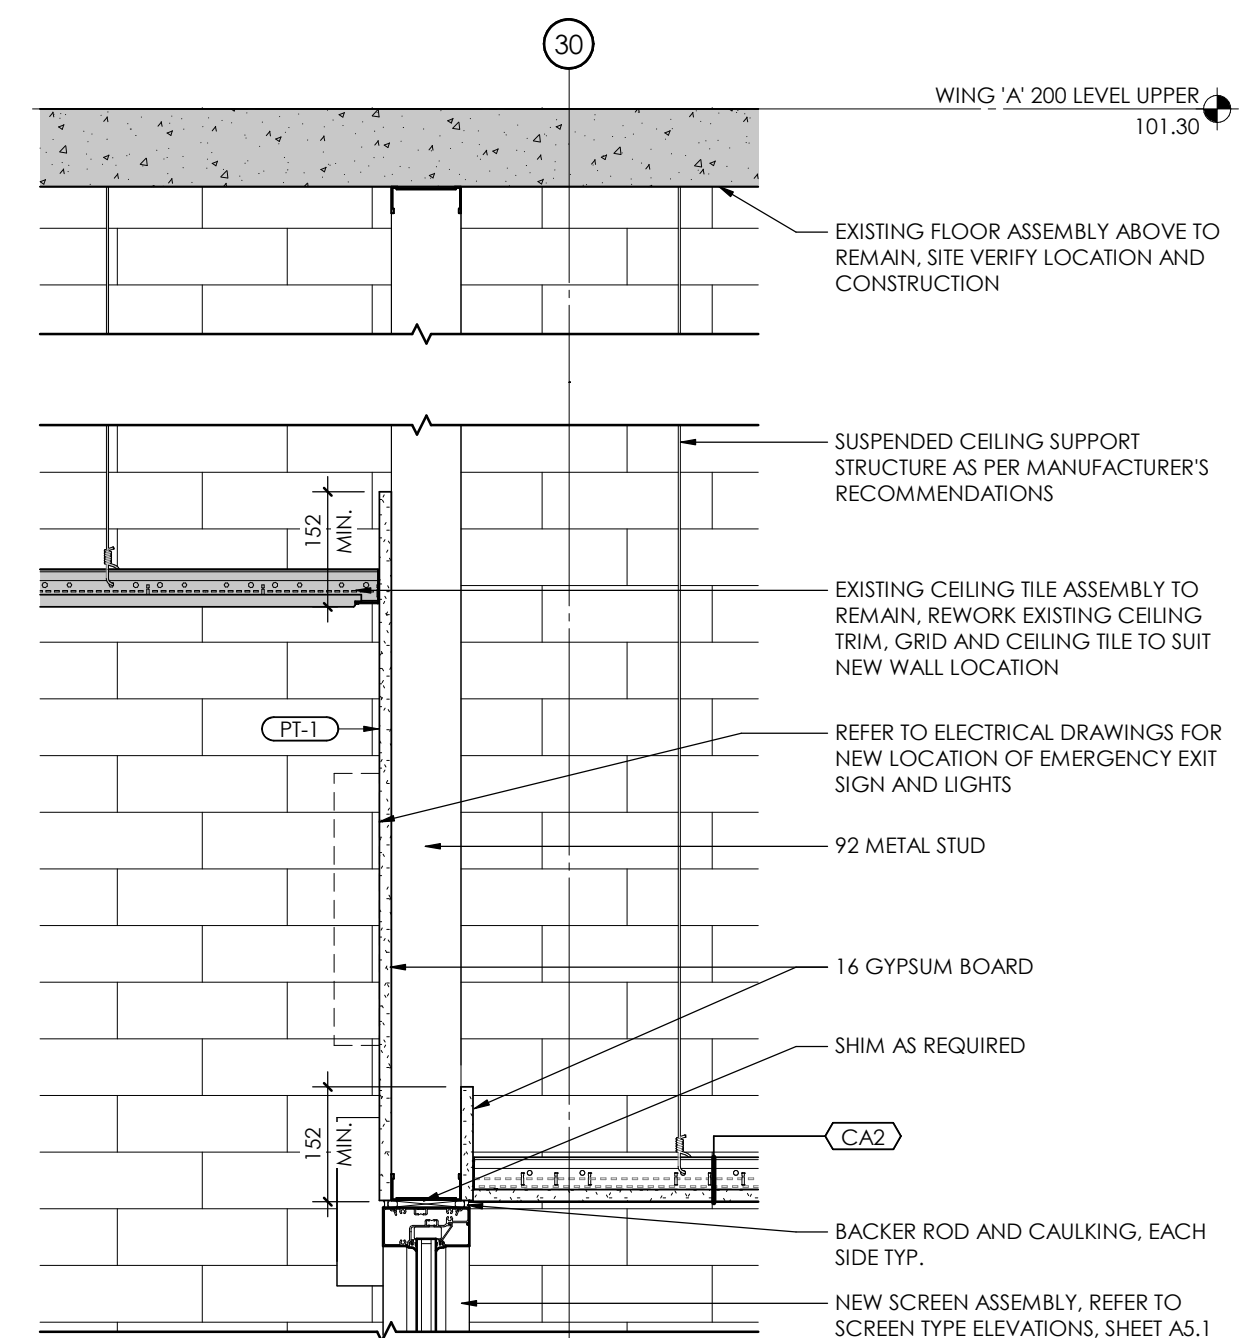

4 VESTIBULE G-30 - SECTION DETAIL 1:10

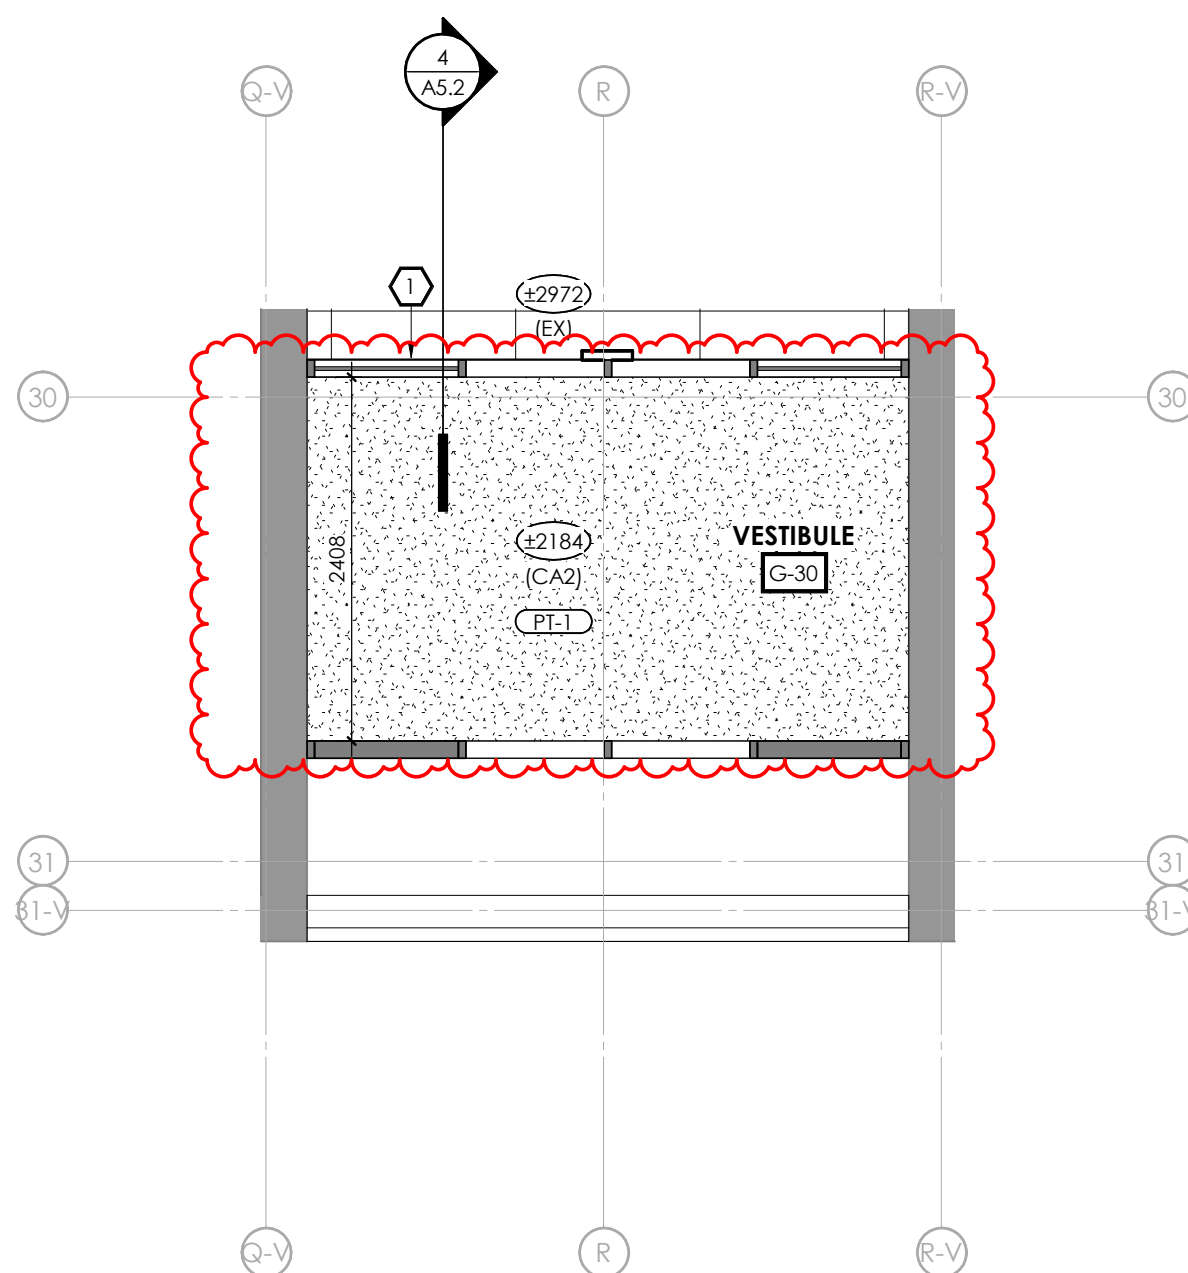

3 WING C - ENLARGED RCP - VESTIBULE G-30 1:50

- ### RCP KEYNOTES
- 1 REWORK SUSPENDED CEILING GRID TO ACCOMMODATE NEW SCREEN/WALL ASSEMBLY LOCATION.
 - 2 RESERVED



- ### RCP LEGEND
- EXISTING WALL TO REMAIN (SHOWN SHADED)
 - DENOTES EXISTING BUILDING
 - DENOTES AREA N.I.C. UNLESS NOTED OTHERWISE
 - EXISTING GYPSUM BOARD CEILING TO REMAIN
 - FIRE RETARDANT SPRAY ON UNDERSIDE OF DECK AND ALL SUPPORTING STRUCTURE IN THEIR ENTIRETY
 - EXISTING ACOUSTIC CEILING TILE SUSPENDED CEILING TO REMAIN
 - ACOUSTIC CEILING TILES AND SUSPENDED CEILING TILE GRID
 - 610x610 AND 610x1220 RECESSED LIGHT FIXTURE (REFER TO ELECTRICAL DWGS.)
 - SUSPENDED OR SURFACE MOUNT LIGHT FIXTURE (REFER TO ELECTRICAL DWGS.)
 - POT LIGHT (REFER TO ELECTRICAL DWGS.)
 - EXHAUST FAN (REFER TO MECHANICAL DWGS.)
 - SUPPLY AIR DIFFUSERS (REFER TO MECHANICAL DWGS.)
 - 2450 CEILING HEIGHT TAG

DOOR HARDWARE SCHEDULE

No.	F.R.R.	ELEV.	SIZE	MATERIAL	FINISH	GLAZ.	ELEV.	SCREEN ELEV.	MATERIAL	FINISH	HIVE PKG	REMARKS
H1												

DOOR AND FRAME SCHEDULE

No.	F.R.R.	ELEV.	SIZE	MATERIAL	FINISH	GLAZ.	ELEV.	SCREEN ELEV.	MATERIAL	FINISH	HIVE PKG	REMARKS
DG-30a	-	A	914 X 2138	ALUM.	ANOD.	SG1	-	S01	ALUM.	ANOD.	H1	
DG-30b	-	A	914 X 2138	ALUM.	ANOD.	SG1	-	S01	ALUM.	ANOD.	H1	
DG-30c	-	A	914 X 2138	ALUM.	ANOD.	SG1	-	S02	ALUM.	ANOD.	H1	
DG-30d	-	A	914 X 2138	ALUM.	ANOD.	SG1	-	S02	ALUM.	ANOD.	H1	

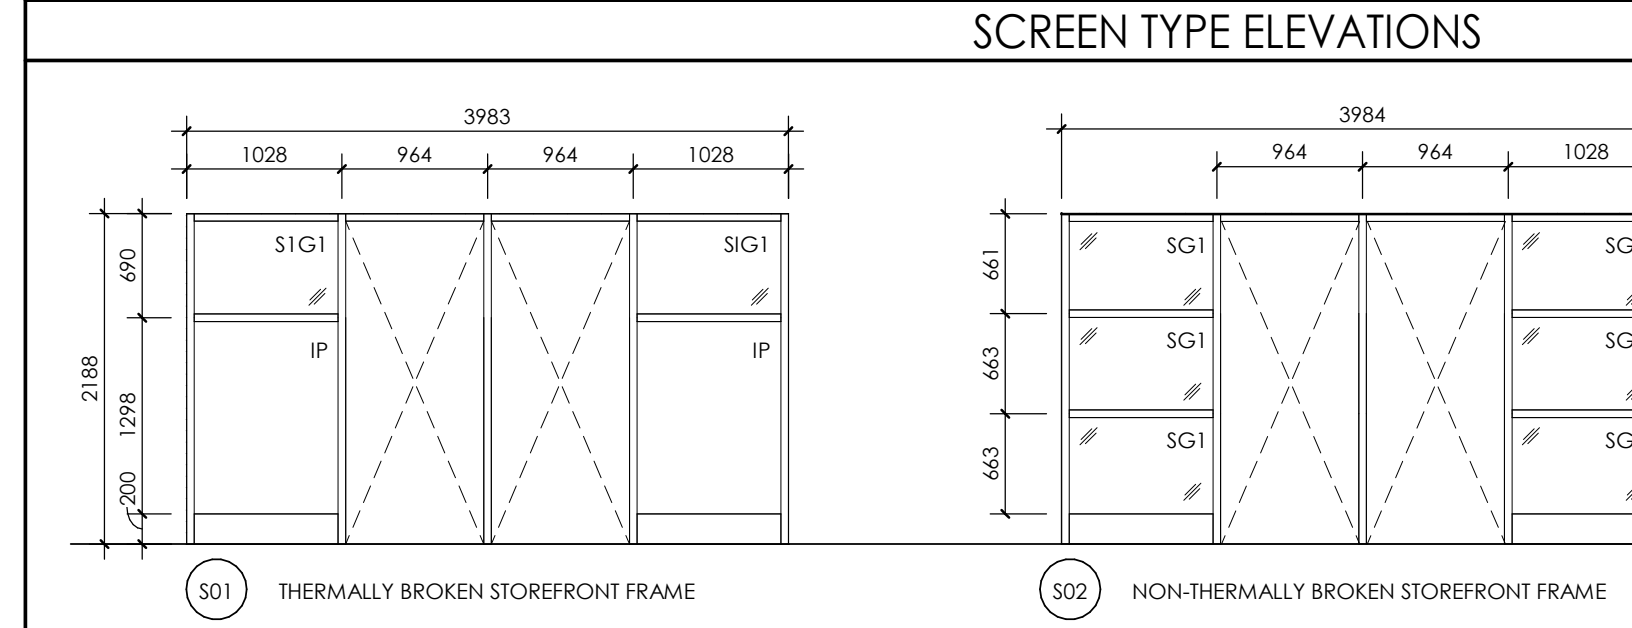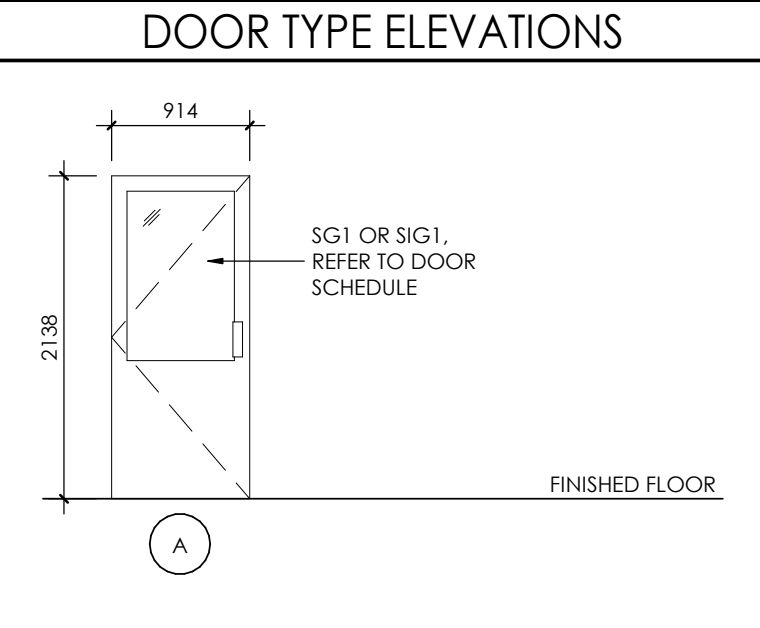

- GLAZING DESIGNATIONS:**
 SIG1 SEALED INSULATED GLAZED UNIT
 SG1 SINGLE GLAZED UNIT
- PANEL MATERIAL:**
 IP INSULATED ANODIZED ALUMINUM PANEL TO MATCH FRAMING

THIS DRAWING IS AN INSTRUMENT OF SERVICE & IS THE PROPERTY OF ABA ARCHITECTS INC. & CANNOT BE MODIFIED AND/OR REPRODUCED WITHOUT THE PERMISSION OF ABA ARCHITECTS INC.
 THE CONTRACTOR MUST VERIFY ALL DIMENSIONS ON SITE AND REPORT ANY DISCREPANCIES TO THE ARCHITECT, BEFORE PROCEEDING WITH THE WORK.
 DRAWINGS ARE NOT TO BE SCALED.

No.	REVISIONS	DATE
1	ADDENDUM 03	2026.03.23

***IMPORTANT NOTE TO ALL CONTRACTORS/SUB-CONTRACTORS:**
 THIS SCOPE OF WORK CONTAINS ASBESTOS CONTAINING MATERIALS (ACM). ALL CONTRACTORS SHALL REFER TO THE ASBESTOS AUDIT AND SECTION 01 35 43. HAZARDOUS MATERIALS FOR APPROPRIATE PROTOCOLS THAT MUST BE FOLLOWED, REGARDLESS OF ABATEMENT OPERATIONS BEING CONDUCTED OR NOT.


ISSUED FOR PERMIT/TENDER	2026.03.03
ISSUED FOR COORDINATION	2026.02.26
CHRONOLOGY	DATE



PROJECT NAME: WATERLOO COLLEGIATE INSTITUTE HVAC AND EXTERIOR UPGRADES PHASE 2
 300 HAZEL STREET, WATERLOO, ON. N2L 3P2

DRAWING TITLE: WING 'C' VESTIBULE DOOR REPLACEMENT

SCALE	DRAWING NUMBER
As indicated	
SHEET SIZE: 609 x 914	A5.2
PROJECT NUMBER: 2025-153	

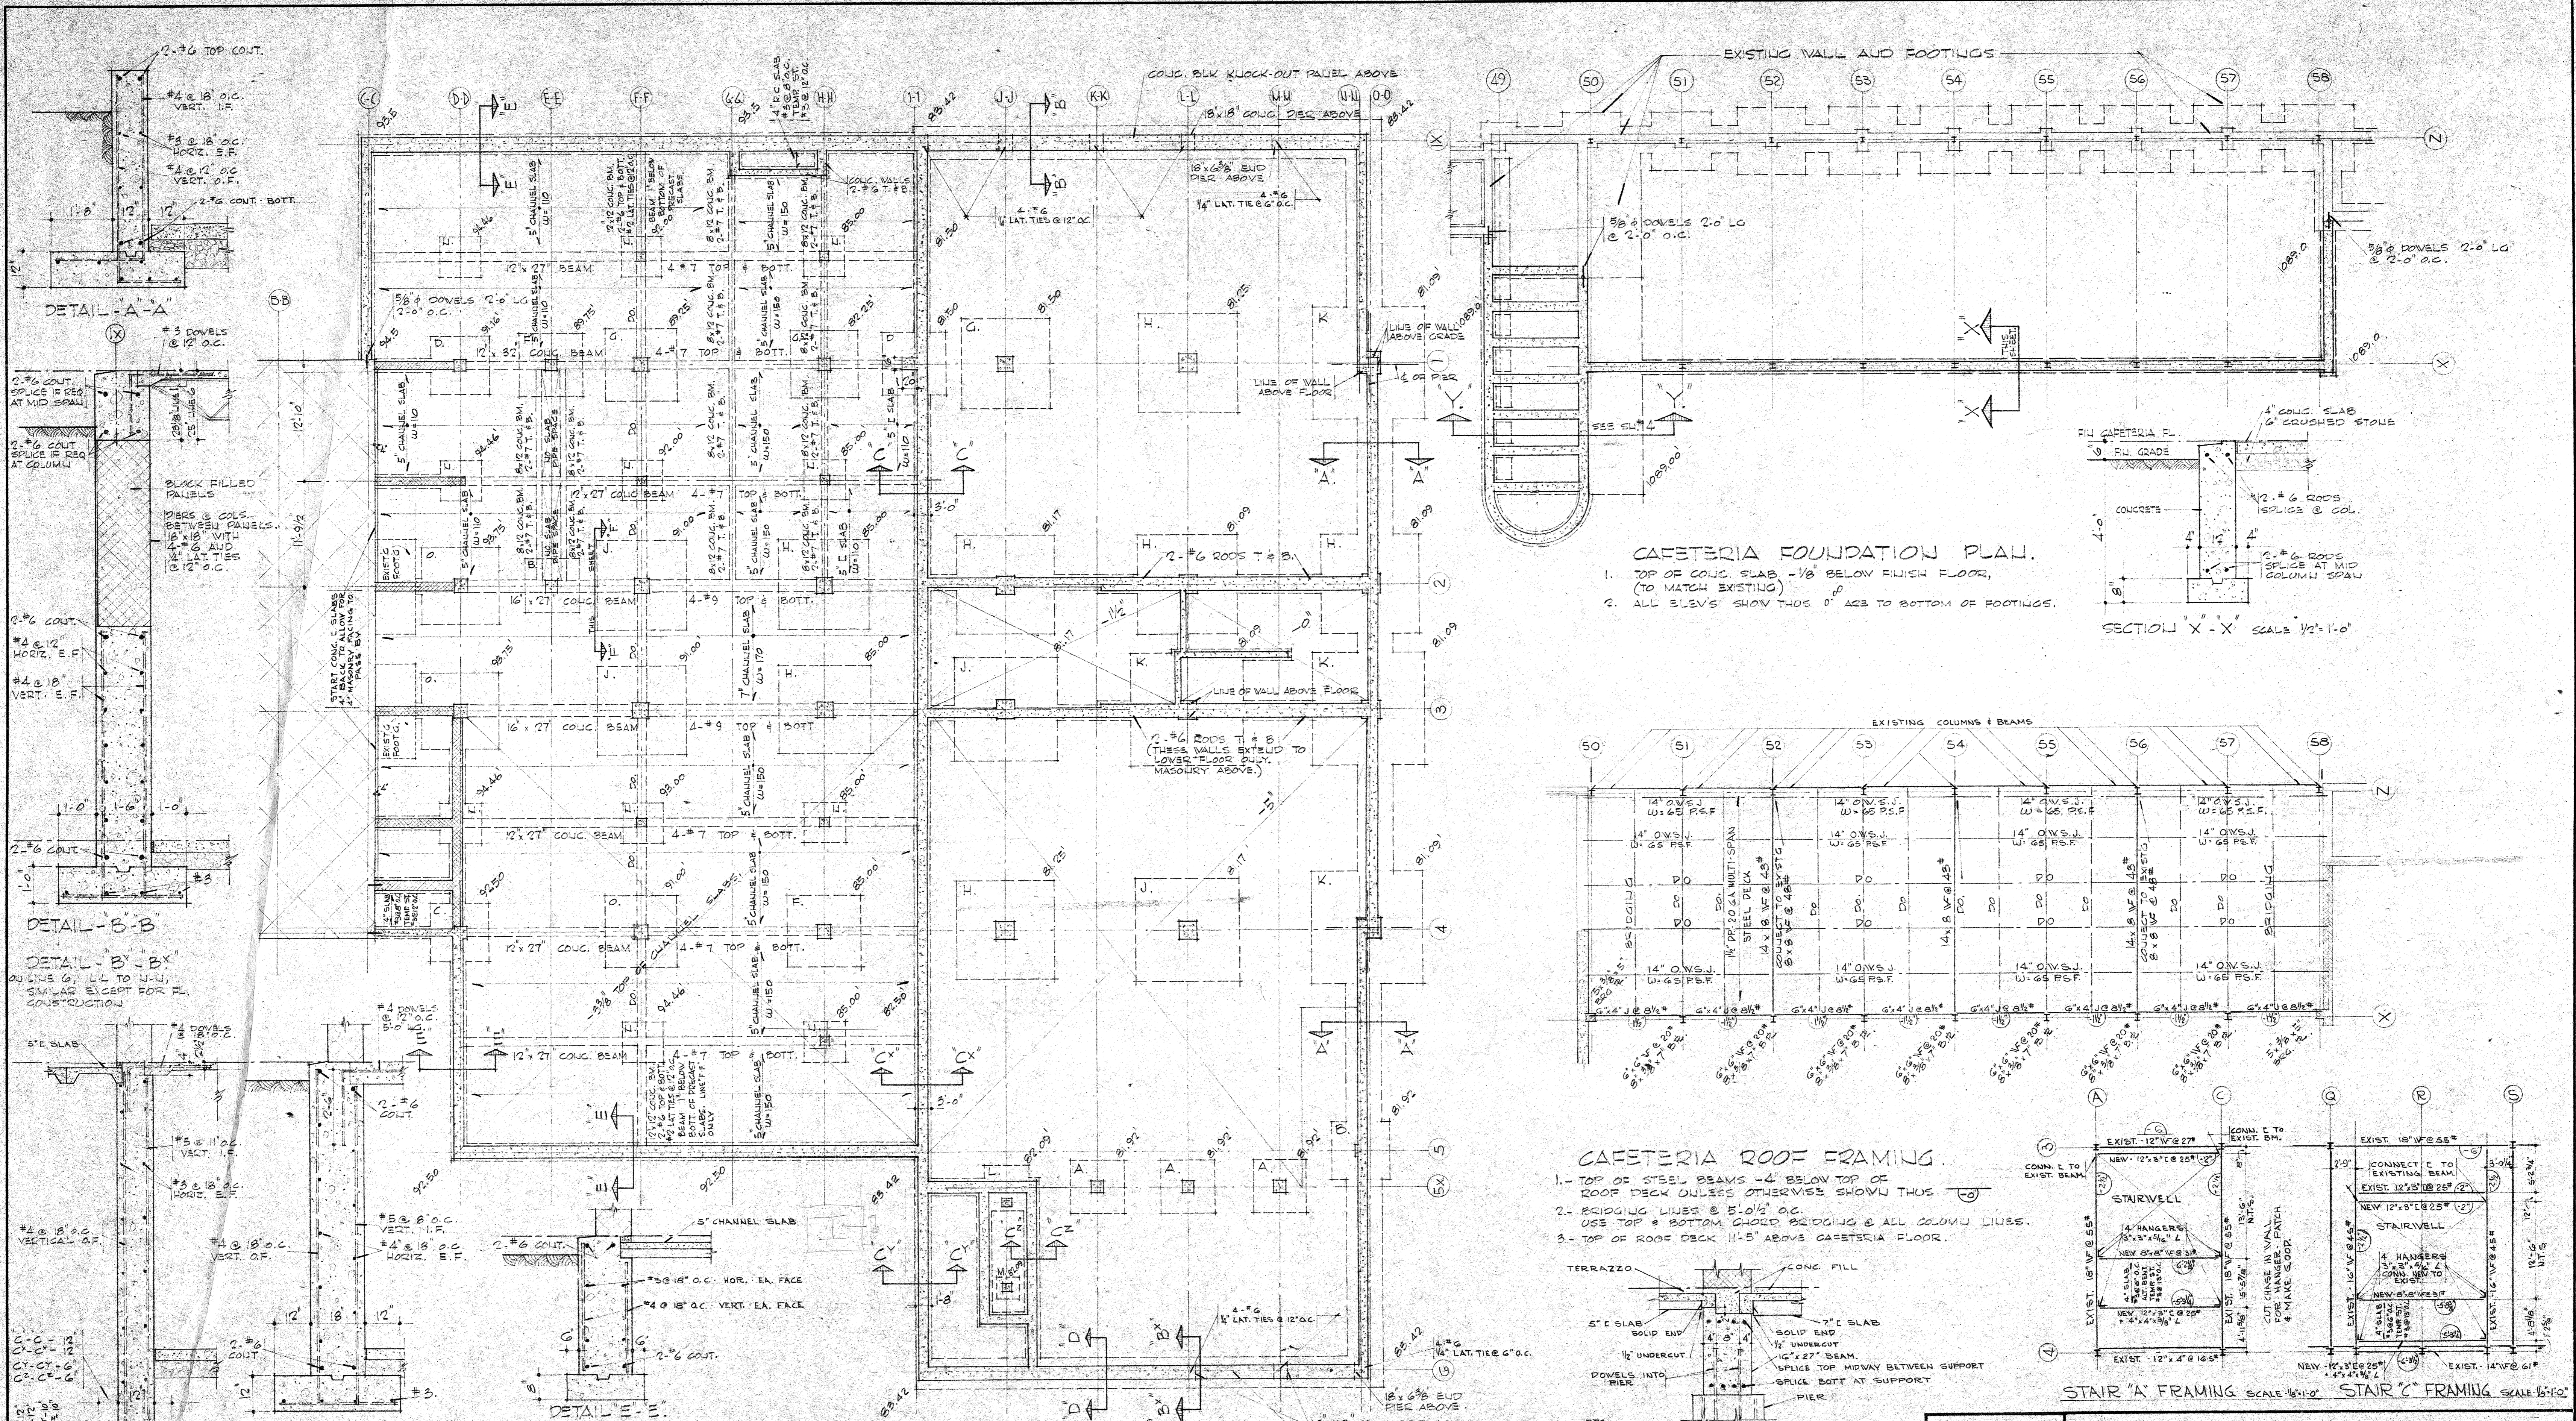


CAFETERIA FOUNDATION PLAN.

1. TOP OF CONG. SLAB $1/8$ " BELOW FINISH FLOOR, (TO MATCH EXISTING)
2. ALL ELEV'S SHOW THUS 0' ARE TO BOTTOM OF FOOTINGS.

SECTION 'X-X' SCALE $1/2"=1'-0"$

CAFETERIA ROOF FRAMING.

1. TOP OF STEEL BEAMS 4 " BELOW TOP OF ROOF DECK UNLESS OTHERWISE SHOWN THUS
2. BRIDGING LINES @ $5'-0 1/2$ " O.C. USE TOP & BOTTOM CHORD BRIDGING @ ALL COLUMN LINES.
3. TOP OF ROOF DECK $11'-5"$ ABOVE CAFETERIA FLOOR.

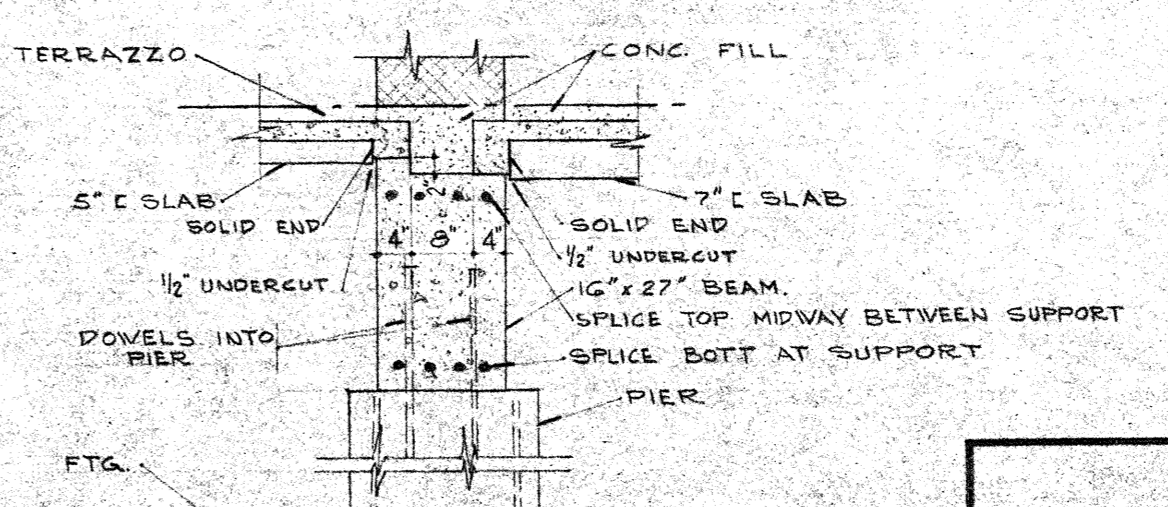

DETAIL 'F-F' SCALE $1/2"=1'-0"$

FOUNDATION PLAN - SHOP AREA.


1. ELEV. OF GROUND FLOOR, 98.21. TOP OF GROUND FLOOR PRECAST CHANNEL SLABS $1/2$ " BELOW FINISHED FL. EXCEPT AS CROSSED AND NOTED.
2. ELEV. OF LOWER FLOOR, 84.75. TOP OF LOWER FLOOR CONG. SLABS 10 " BELOW FINISHED FL. EXCEPT AS CROSSED AND NOTED.

3. ALL ELEV'S SHOWN THUS 0' ARE TO BOTTOM OF FOOTINGS.
4. ENTIRE AREA OF LOWER FL. & CAFETERIA 4 " SLAB ON GRADE. REINF. - # 3 @ 12 " S.M.
5. ALL AREAS OVER PRECAST SLABS SHALL HAVE $1 1/2$ " CONG. TOPPING EXCEPT WHERE TERRAZZO & WOOD FLOOR IS SPECIFIED.
6. TOP OF ALL CONG. BEAMS TO BE 6 " BELOW FINISHED FLOOR EXCEPT AS NOTED (12" BEAMS ON LINE P.F.) AND EXCEPT WHERE T. SLABS OCCUR. TOP OF BEAMS HERE SHALL BE 8 " BELOW FINISH FLOOR.
7. ALL CONG. & SLAB ENDS WITH MASONRY WALLS ABOVE SHALL BE SOLID.

STAIR 'A' FRAMING SCALE $1/4"=1'-0"$ STAIR 'C' FRAMING SCALE $1/4"=1'-0"$

FOUNDATION PLAN & CAFETERIA FRAMING LAYOUT

	DATE	OCT. 61		SCALE	AS NOTED
	DRAWN BY	E.S.G.		JOB	2-341-7
	CHECKED BY	EX.H.		SHEET	S-2
	ADDITION TO WATERLOO COLLEGIATE WATERLOO ONTARIO				

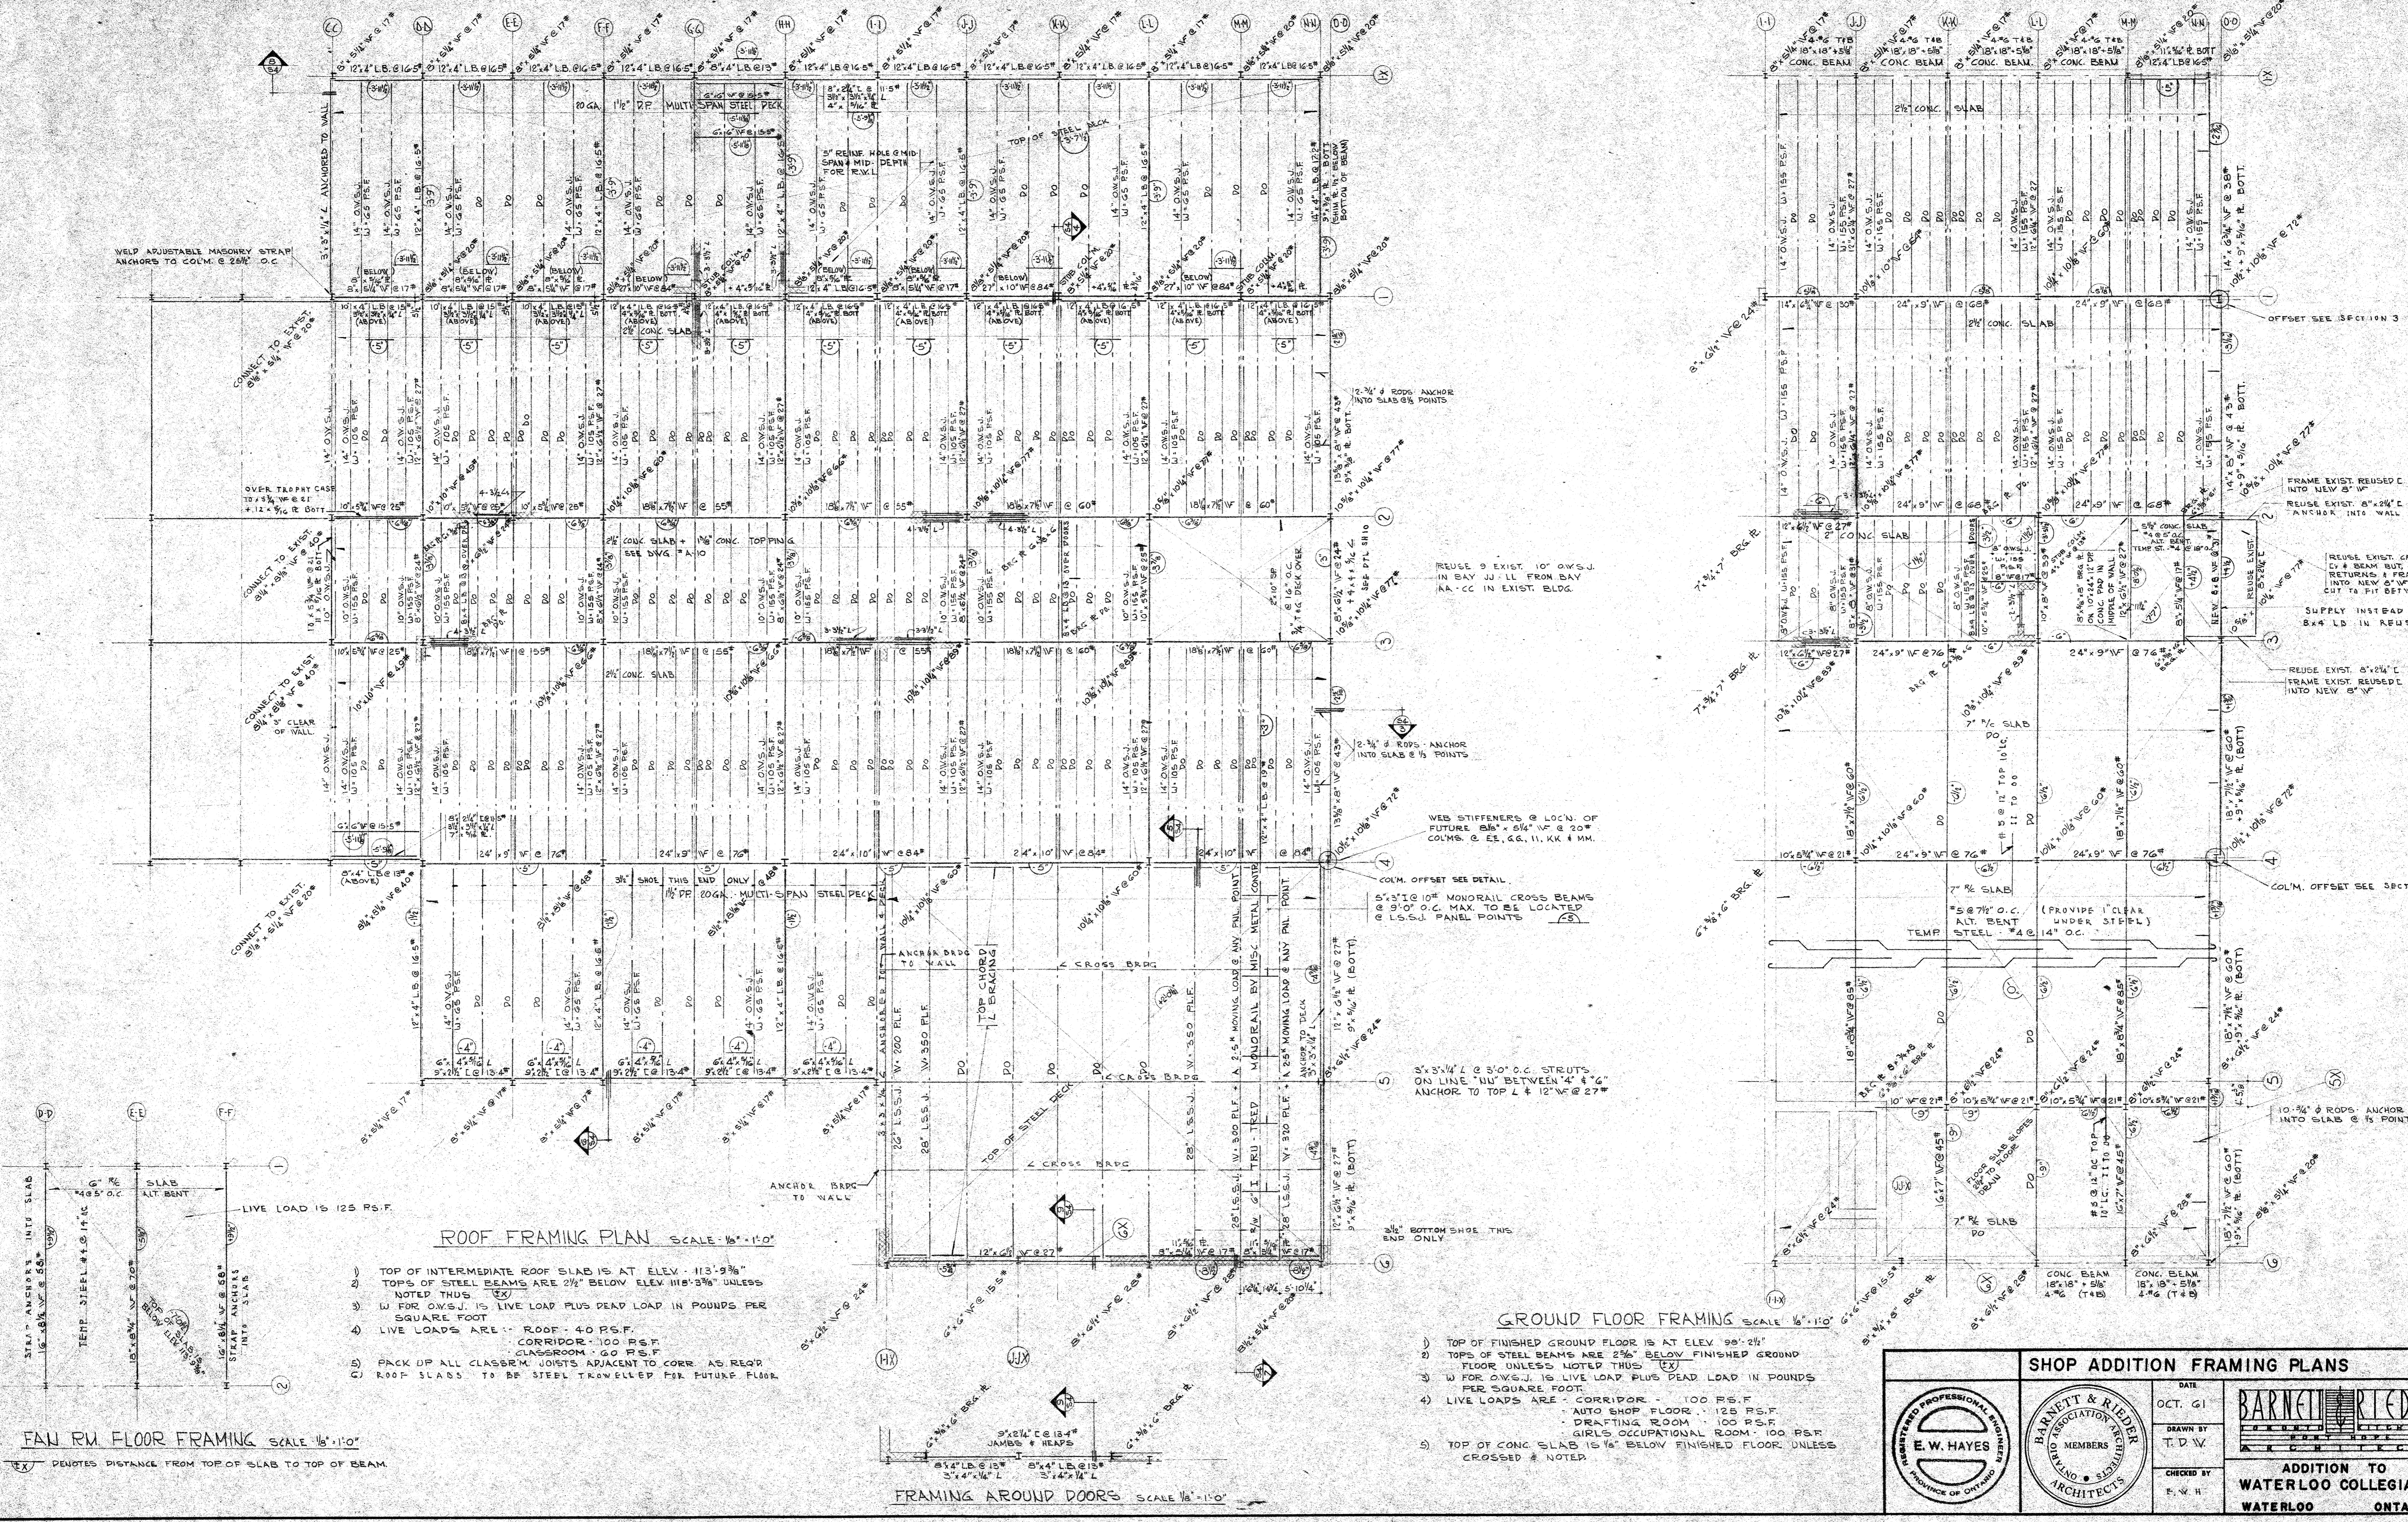

WELD ADJUSTABLE MASONRY STRAP ANCHORS TO COLM. @ 28" O.C.

CONNECT TO EXIST. 8" x 5 1/2" WF @ 20"

OVER TRAPRY CASE TO 2 1/2" WF @ 20" + 1/2" x 3/8" R. DOTT.

CONNECT TO EXIST. 8" x 5 1/2" WF @ 20"

CONNECT TO EXIST. 8" x 5 1/2" WF @ 20"

CONNECT TO EXIST. 8" x 5 1/2" WF @ 20"

LIVE LOAD IS 125 RS.F.

ROOF FRAMING PLAN SCALE 1/8" = 1'-0"

- 1) TOP OF INTERMEDIATE ROOF SLAB IS AT ELEV. 113'-9 3/8"
- 2) TOPS OF STEEL BEAMS ARE 2 1/2" BELOW ELEV. 113'-9 3/8" UNLESS NOTED THUS
- 3) W FOR OWS-J IS LIVE LOAD PLUS DEAD LOAD IN POUNDS PER SQUARE FOOT
- 4) LIVE LOADS ARE - ROOF - 40 RS.F. CORRIDOR - 100 RS.F. CLASSROOM - 60 RS.F.
- 5) PACK UP ALL CLASSRM. JOISTS ADJACENT TO CORR. AS REQD.
- 6) ROOF SLABS TO BE STEEL TRAVELLED FOR FUTURE FLOOR.

FAN RU FLOOR FRAMING SCALE 1/8" = 1'-0"

EX DENOTES DISTANCE FROM TOP OF SLAB TO TOP OF BEAM.

FRAMING AROUND DOORS SCALE 1/8" = 1'-0"

REUSE 9 EXIST. 10" OWS-J IN BAY JJ-LI FROM BAY AA-CC IN EXIST. BLDG.


WEB STIFFENERS @ LOCN. OF FUTURE 8" x 5 1/2" WF @ 20" COLMS. @ EE, GG, II, KK & MM.

5" x 3 1/2" L @ 35" O.C. STRUTS ON LINE "UU" BETWEEN "4" & "6" ANCHOR TO TOP L & 12" WF @ 27"

GROUND FLOOR FRAMING SCALE 1/8" = 1'-0"

- 1) TOP OF FINISHED GROUND FLOOR IS AT ELEV. 99'-2 1/2"
- 2) TOPS OF STEEL BEAMS ARE 2 1/2" BELOW FINISHED GROUND FLOOR UNLESS NOTED THUS
- 3) W FOR OWS-J IS LIVE LOAD PLUS DEAD LOAD IN POUNDS PER SQUARE FOOT.
- 4) LIVE LOADS ARE - CORRIDOR - 100 RS.F. AUTO SHOP FLOOR - 125 RS.F. DRAFTING ROOM - 100 RS.F. GIRLS OCCUPATIONAL ROOM - 100 RS.F.
- 5) TOP OF CONC. SLAB IS 1/2" BELOW FINISHED FLOOR UNLESS CROSSED & NOTED.

SHOP ADDITION FRAMING PLANS

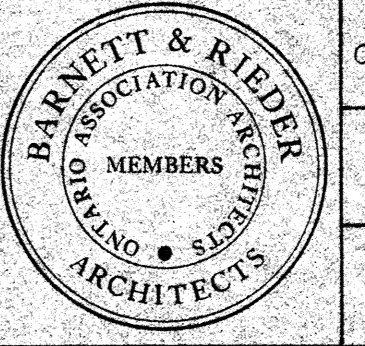

DATE	OCT. 61
DRAWN BY	T.D.W.
CHECKED BY	E.W.H.
ADDITION TO WATERLOO COLLEGIATE WATERLOO ONTARIO	

SCALE	AS NOTED
JOB	2-341-7
SHEET	53