

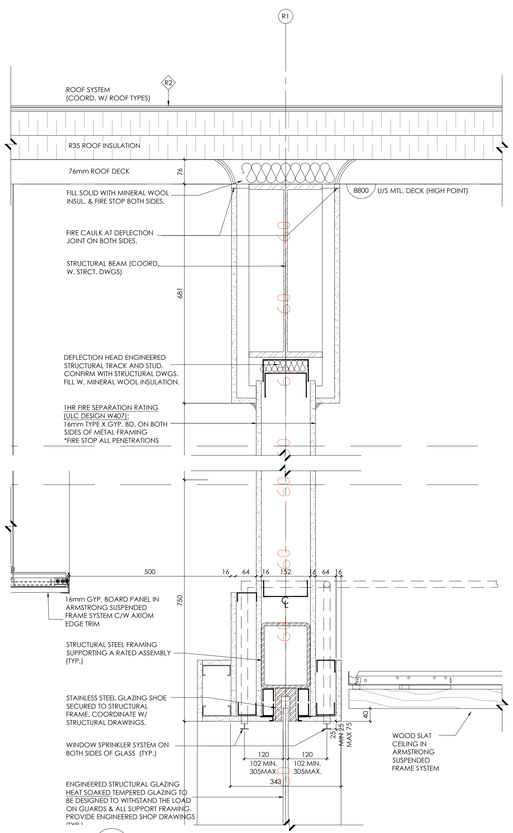



1 SECTION DETAIL
A4.12.1
0 75 150 375mm

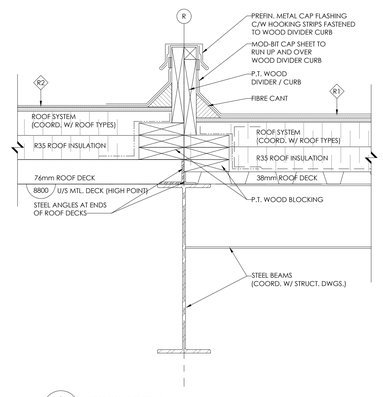


3 SECTION DETAIL
A4.12.1
0 75 150 375mm

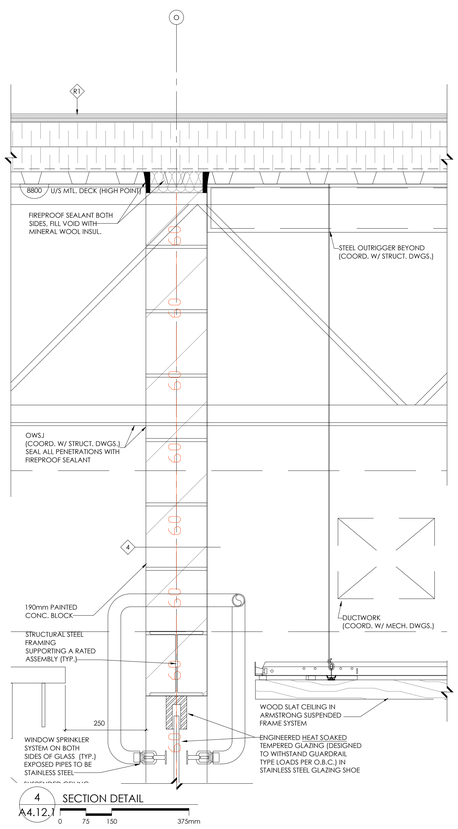


4 SECTION DETAIL
A4.12.1
0 75 150 375mm

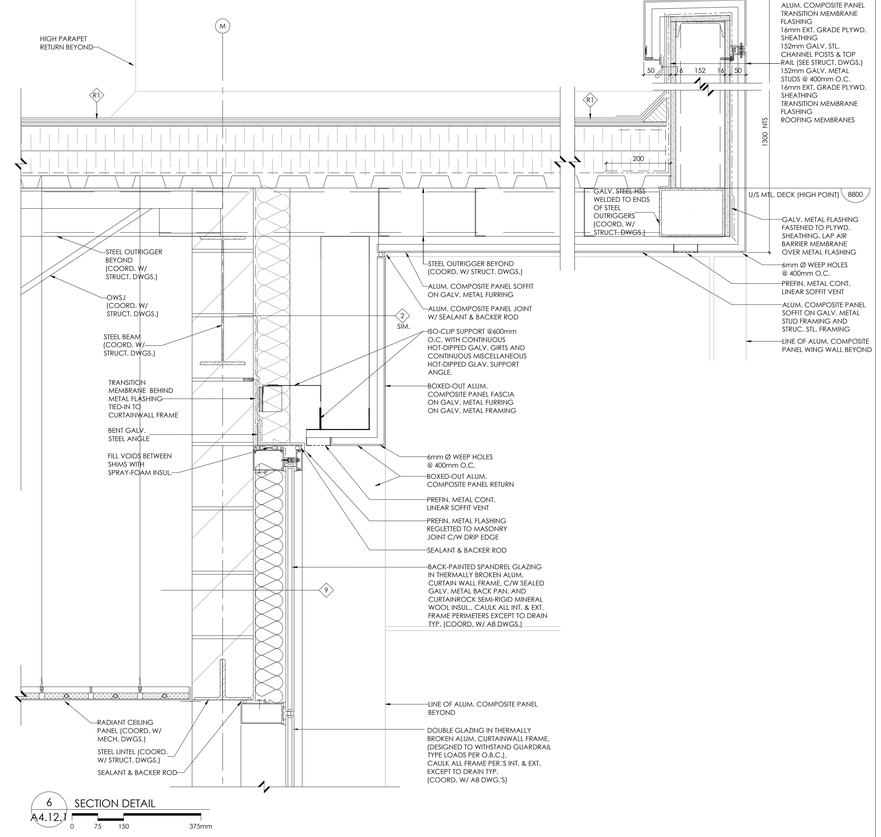


6 SECTION DETAIL
A4.12.1
0 75 150 375mm

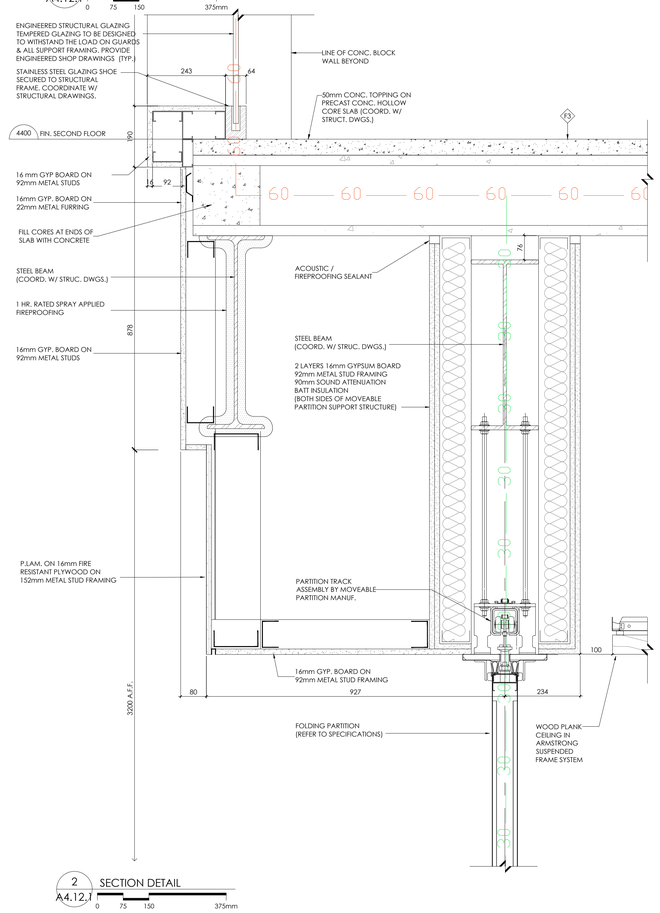


2 SECTION DETAIL
A4.12.1
0 75 150 375mm

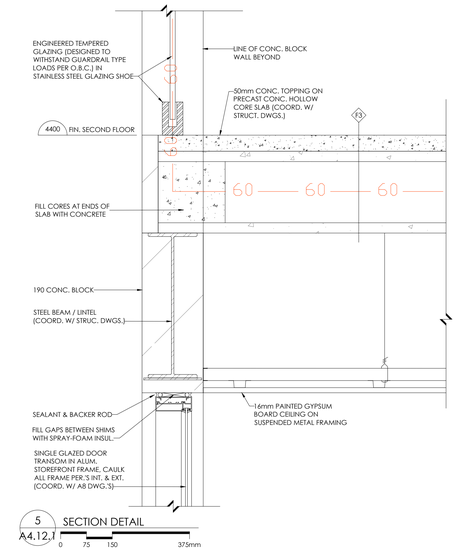

5 SECTION DETAIL
A4.12.1
0 75 150 375mm

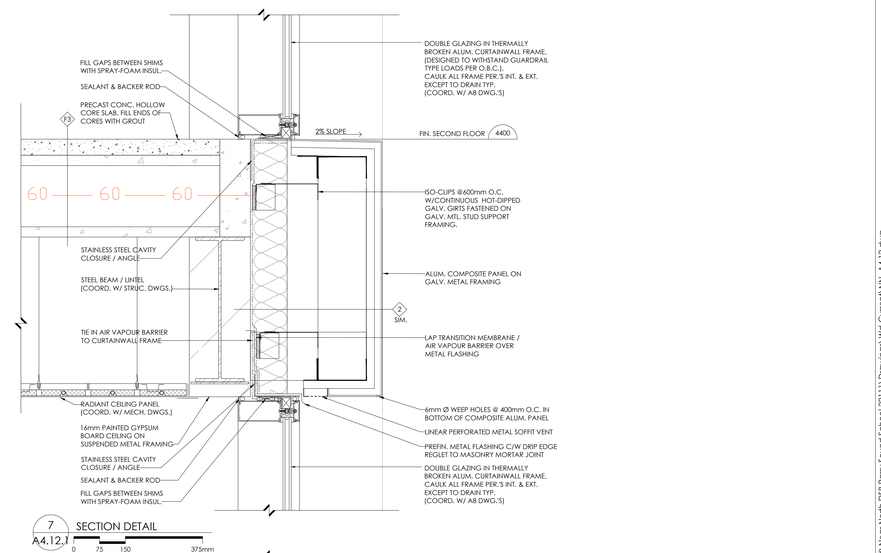

7 SECTION DETAIL
A4.12.1
0 75 150 375mm

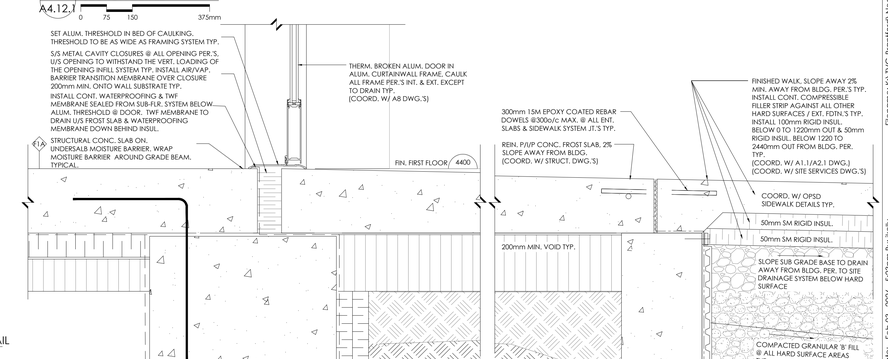

8 FROST SLAB SECTION DETAIL
A4.12.1
0 75 150 375mm

REVISIONS

NO.	DATE	PARTICULAR
1	2022.06.06	ISSUED FOR 80% CLASS B COSTING
2	2022.08.18	ISSUED FOR SPA
3	2022.09.22	ISSUED FOR OWNERS REVIEW - 98% SET
4	2022.12.16	ISSUED FOR 2nd SPA SUBMISSION
5	2023.01.31	ISSUED FOR TENDER
6	2023.02.22	ISSUED FOR ADDENDUM 9
7	2023.08.23	ISSUED FOR CONVENIENCE
8	2023.11.20	ISSUED FOR PERMIT COMMENTS
9	2024.01.24	ISSUED FOR SI#03
10	2024.02.15	ISSUED FOR PCN#008
11	2024.03.04	ISSUED FOR PCN#009
12	2024.03.10	ISSUED FOR SI#004
13	2024.05.14	ISSUED FOR SI#006
14	2024.07.22	ISSUED FOR SI#008
15	2024.08.07	ISSUED FOR SI#009
16	2024.10.02	ISSUED FOR PCN#15
17	2025.04.11	ISSUED FOR PCN#019
18	2025.05.01	ISSUED FOR CO#07
19	2025.05.28	ISSUED FOR PCN#20 - CO#010
20	2025.07.31	ISSUED FOR SI#013
21	2025.08.06	ISSUED FOR SI#014
22	2025.08.15	ISSUED FOR PCN#25 - CO#017
23	2025.08.25	ISSUED FOR PCN#27 - CO#021
24	2025.09.02	ISSUED FOR PCN#29
25	2025.09.02	ISSUED FOR SI#20 - CO#018
26	2025.09.08	ISSUED FOR PCN#31
27	2025.09.09	ISSUED FOR PCN#32 - CO#022
28	2025.09.10	ISSUED FOR SI#33
29	2025.09.11	ISSUED FOR SI#022
30	2025.09.15	ISSUED FOR SI#023
31	2025.09.16	ISSUED FOR PCN #35 - CO#023
32	2025.09.30	ISSUED FOR PCN #37 - CO#029
33	2025.09.30	ISSUED FOR PCN #38 - CO#025
34	2025.10.06	ISSUED FOR PCN #39 - CO#024
35	2025.10.20	ISSUED FOR PCN #40R1
36	2025.10.30	ISSUED FOR PCN#041
37	2025.10.23	ISSUED FOR PCN #42
38	2025.11.21	ISSUED FOR PCN#021/R1 - CO12 CD#006
39	2025.11.14	ISSUED FOR PCN#043
40	2025.11.26	ISSUED FOR PCN#043R1
41	2025.12.03	ISSUED FOR PCN#044 - CO#026
42	2026.02.04	ISSUED FOR RECORD SET UP TO CO#27

NOTES:

KEY PLAN:

All dimensions and measurements must be checked and verified by the General Contractor

Reproduction of drawings and related documents in whole or in parts forbidden without written permission of the Ventin Group.

Near North District School Board

CLIENT:
NEAR NORTH DISTRICT SCHOOL BOARD
NNDSB Tender # 2023-015

PROJECT:
NEW PARRY SOUND K-12 SCHOOL & CHILDCARE

PARRY SOUND HIGH SCHOOL SITE

111 ISABELLA STREET
PARRY SOUND, ONTARIO

ORIGINAL PAGE SIZE ARCH E1 - 30" x 42"
KEY TO DETAIL LOCATION:
(A) A - DETAIL NO.
(8) B - DETAIL NO. ORIGIN


+VG ARCHITECTS
THE VENTIN GROUP LTD


Filename: K:\VG-Brantford\Near North DSB Parry Sound School\2111\Drawings\Wd Current\NN-A4.12.dwg
Plot Date: Feb 03, 2026 - 5:23pm By: jkelly


WALL SECTION DETAILS


A4.12.1


DRAWN BY : sr
CHECKED BY : XX

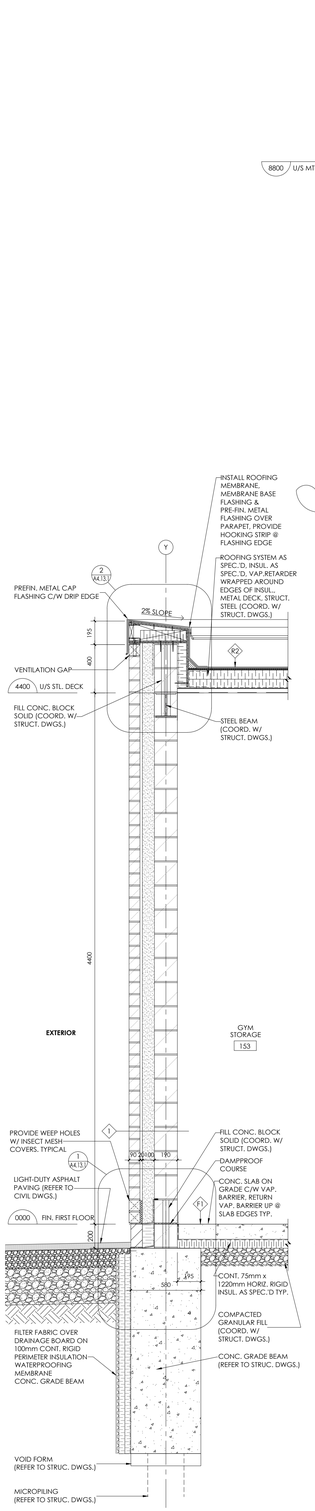

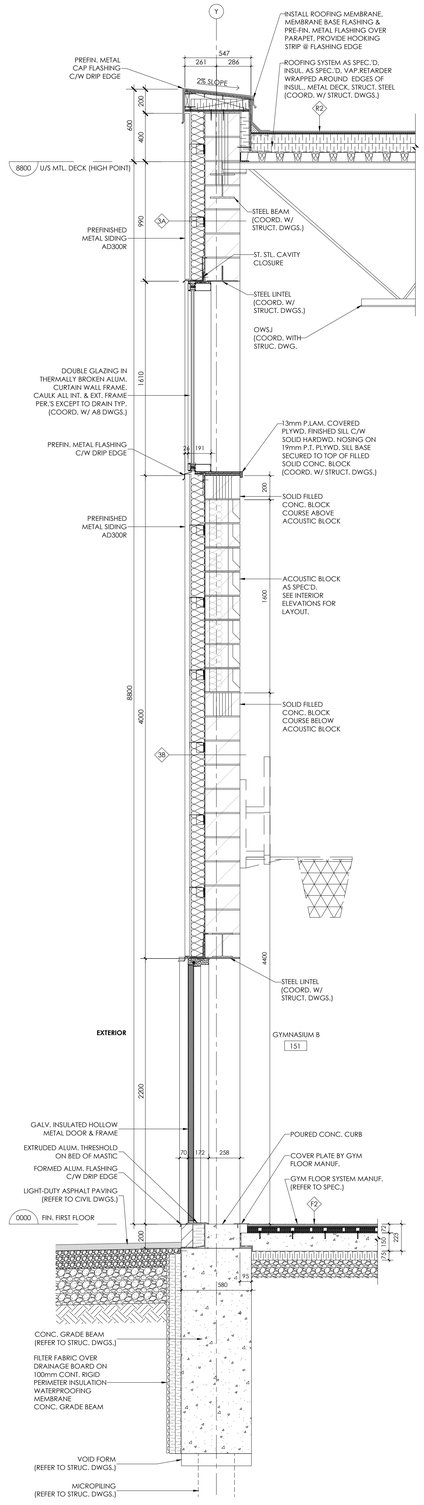

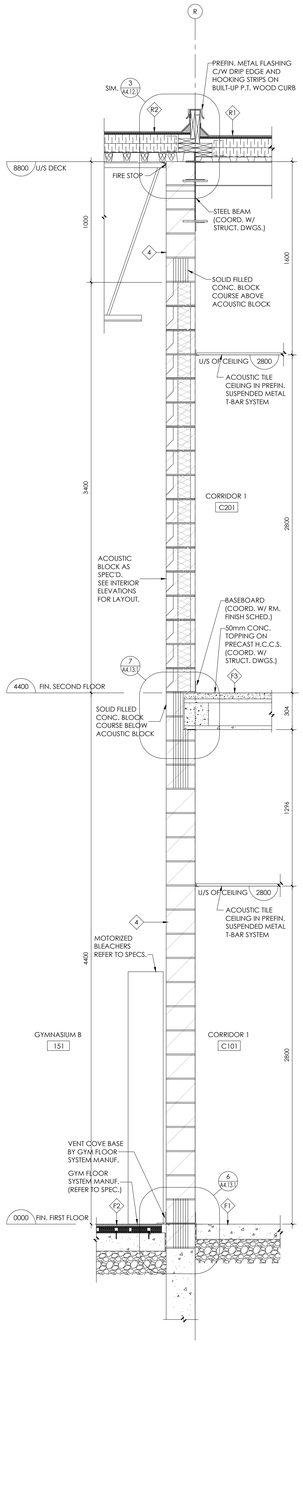

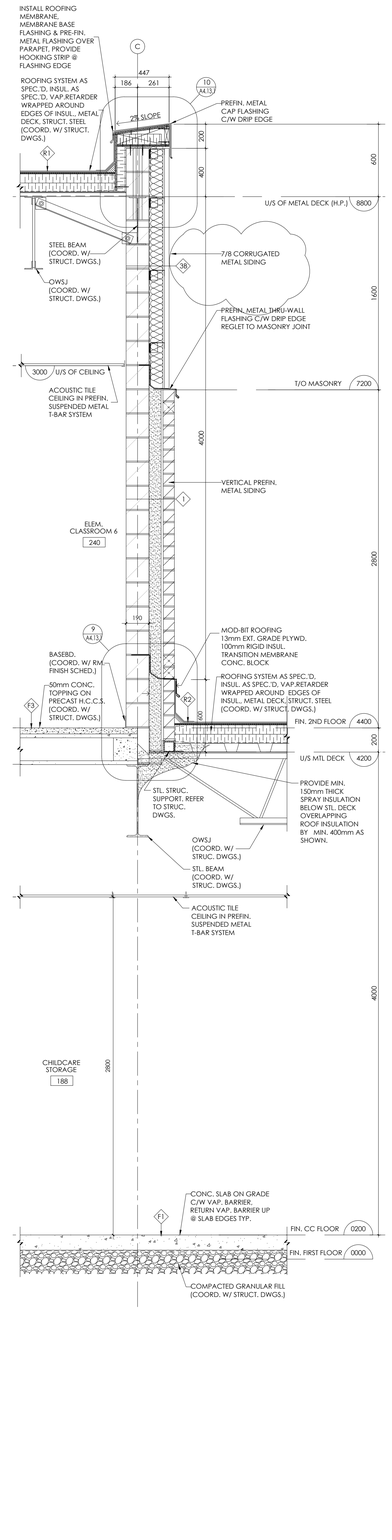

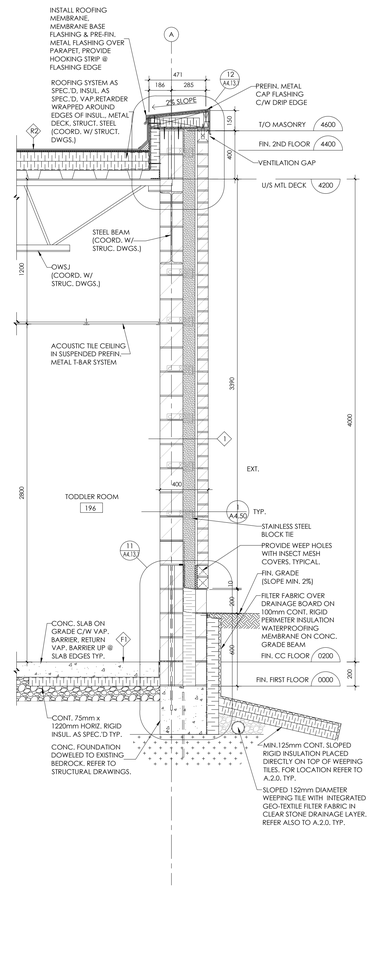

REVISIONS

NO.	DATE	PARTICULAR
1	2022.06.06	ISSUED FOR 80% CLASS B COSTING
2	2022.08.18	ISSUED FOR SPA
3	2022.09.22	ISSUED FOR OWNERS REVIEW - 98% SET
4	2022.12.16	ISSUED FOR 2nd SPA SUBMISSION
5	2023.01.31	ISSUED FOR TENDER
6	2023.02.22	ISSUED FOR ADDENDUM 9
7	2023.08.23	ISSUED FOR CONVENIENCE
8	2023.11.20	ISSUED FOR PERMIT COMMENTS
9	2024.01.24	ISSUED FOR SI#03
10	2024.02.15	ISSUED FOR PCN#008
11	2024.03.04	ISSUED FOR PCN#009
12	2024.03.10	ISSUED FOR SI#004
13	2024.05.14	ISSUED FOR SI#006
14	2024.07.22	ISSUED FOR SI#008
15	2024.08.07	ISSUED FOR SI#009
16	2024.10.02	ISSUED FOR PCN#15
17	2025.04.11	ISSUED FOR PCN#019
18	2025.05.01	ISSUED FOR CO#07
19	2025.05.28	ISSUED FOR PCN#20 - CO#010
20	2025.07.31	ISSUED FOR SI#013
21	2025.08.06	ISSUED FOR SI#014
22	2025.08.15	ISSUED FOR PCN#25 - CO#017
23	2025.08.25	ISSUED FOR PCN#27 - CO#021
24	2025.09.02	ISSUED FOR PCN#29
25	2025.09.02	ISSUED FOR SI#20 - CO#018
26	2025.09.08	ISSUED FOR PCN#31
27	2025.09.09	ISSUED FOR PCN#32 - CO#022
28	2025.09.10	ISSUED FOR SI#33
29	2025.09.11	ISSUED FOR SI#022
30	2025.09.15	ISSUED FOR SI#023
31	2025.09.16	ISSUED FOR PCN #35 - CO#023
32	2025.09.30	ISSUED FOR PCN #37 - CO#039
33	2025.09.30	ISSUED FOR PCN #38 - CO#025
34	2025.10.06	ISSUED FOR PCN #39 - CO#024
35	2025.10.20	ISSUED FOR PCN #4081
36	2025.10.30	ISSUED FOR PCN#041
37	2025.10.23	ISSUED FOR PCN #42
38	2025.11.21	ISSUED FOR PCN#021/R1 - CO12 CD#006
39	2025.11.14	ISSUED FOR PCN#043
40	2025.11.26	ISSUED FOR PCN#043R1
41	2025.12.03	ISSUED FOR PCN#044 - CO#026
42	2026.02.04	ISSUED FOR RECORD SET UP TO CO#27

NOTES:

KEY PLAN:

All dimensions and measurements must be checked and verified by the General Contractor

Reproduction of drawings and related documents in whole or in part is forbidden without written permission of the Ventin Group.

Near North District School Board

CLIENT:
NEAR NORTH DISTRICT SCHOOL BOARD
NNDSB Tender # 2023-015

PROJECT:
NEW PARRY SOUND K-12 SCHOOL & CHILDCARE

PARRY SOUND HIGH SCHOOL SITE

111 ISABELLA STREET
PARRY SOUND, ONTARIO

ORIGINAL PAGE SIZE ARCH E1 - 30" x 42"

KEY TO DETAIL LOCATION:
(A / B) A - DETAIL NO. B - DETAIL NO. ORIGIN


+VG ARCHITECTS
THE VENTIN GROUP LTD

WALL SECTIONS


A4.13

Plot Date: Feb 03, 2026 - 5:24pm By: jkelly
Filename: K:\VG Brantford\Near North DSB Parry Sound School\2211\Drawings\Wall Current\NN - A4.13.dwg


DRAWN BY : sr
CHECKED BY : XX

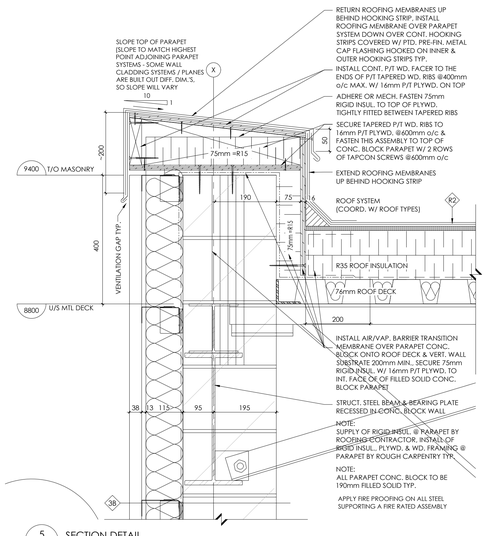


5 SECTION DETAIL A4.13.1 — 0 10 20 50mm

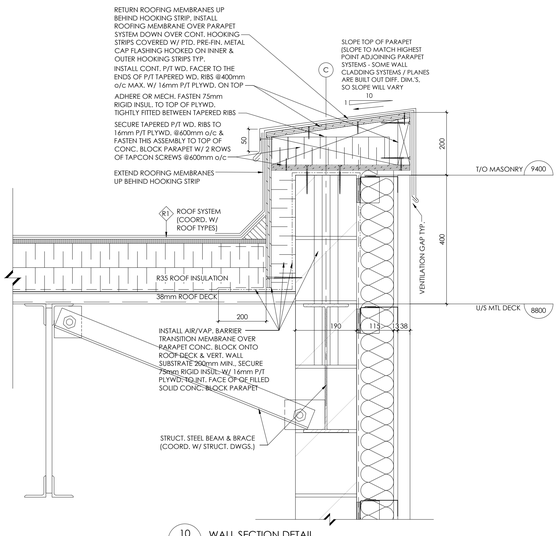


10 WALL SECTION DETAIL A4.13.1 — 0 75 150 375mm

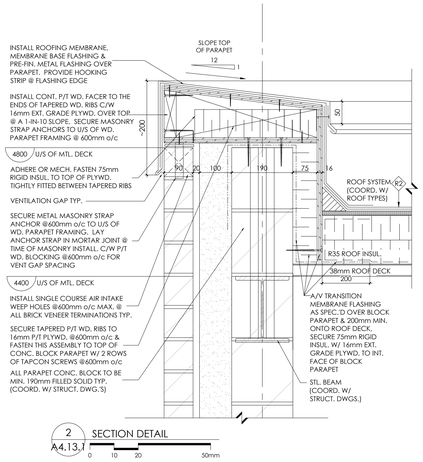


2 SECTION DETAIL A4.13.1 — 0 10 20 50mm

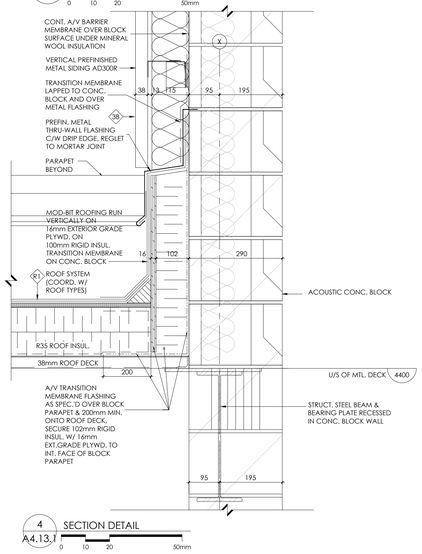


4 SECTION DETAIL A4.13.1 — 0 10 20 50mm

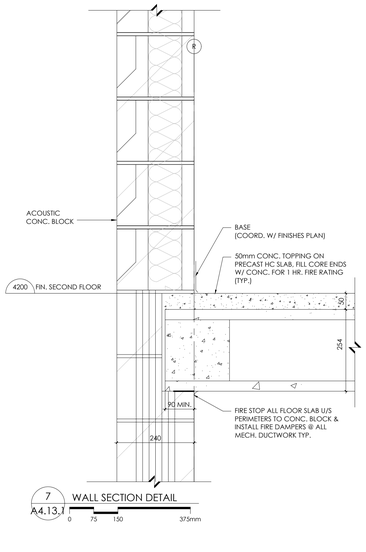

7 WALL SECTION DETAIL A4.13.1 — 0 75 150 375mm

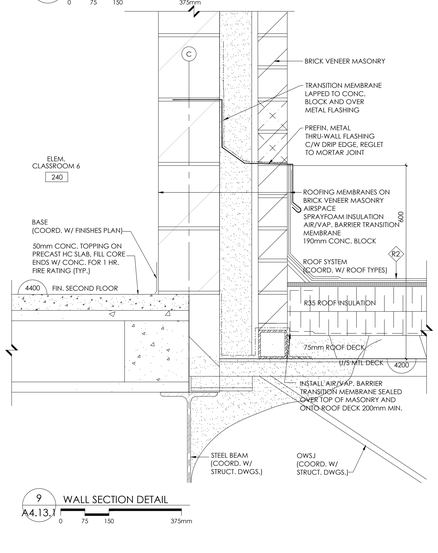


9 WALL SECTION DETAIL A4.13.1 — 0 75 150 375mm

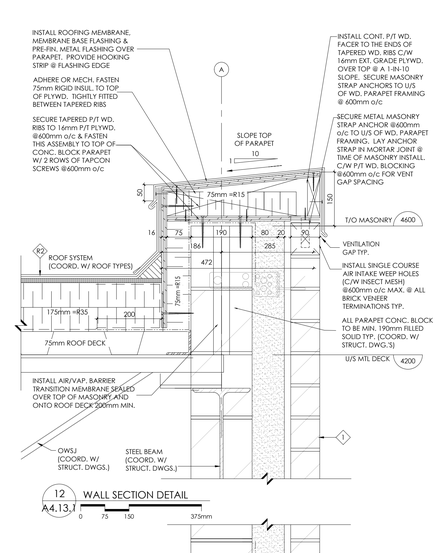


12 WALL SECTION DETAIL A4.13.1 — 0 75 150 375mm


1 SECTION DETAIL A4.13.1 — 0 10 20 50mm

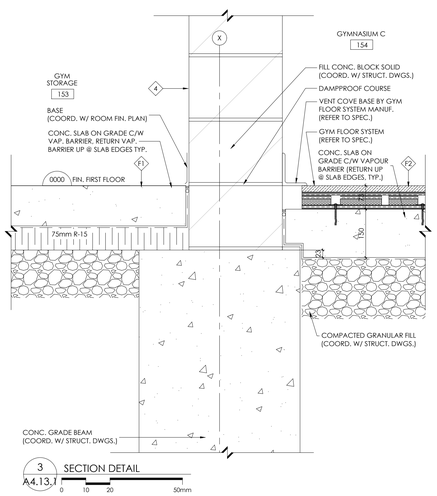

3 SECTION DETAIL A4.13.1 — 0 10 20 50mm

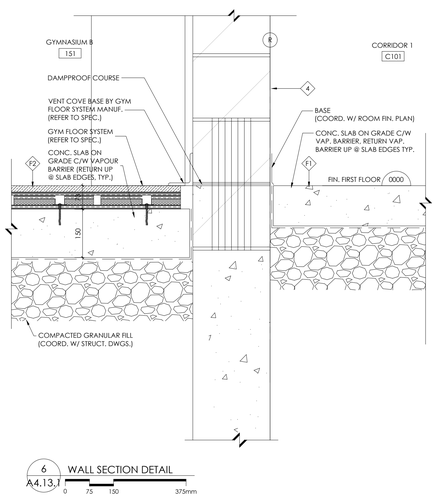

6 WALL SECTION DETAIL A4.13.1 — 0 75 150 375mm

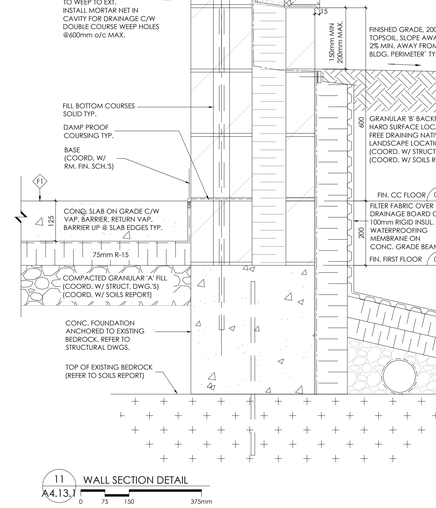

11 WALL SECTION DETAIL A4.13.1 — 0 75 150 375mm

REVISIONS

NO.	DATE	PARTICULAR
1	2022.06.06	ISSUED FOR 80% CLASS B COSTING
2	2022.08.18	ISSUED FOR SPA
3	2022.09.22	ISSUED FOR OWNERS REVIEW - 98% SET
4	2022.12.16	ISSUED FOR 2nd SPA SUBMISSION
5	2023.01.31	ISSUED FOR TENDER
6	2023.02.22	ISSUED FOR ADDENDUM 9
7	2023.08.23	ISSUED FOR CONVENIENCE
8	2023.11.20	ISSUED FOR PERMIT COMMENTS
9	2024.01.24	ISSUED FOR SI#03
10	2024.02.15	ISSUED FOR PCN#008
11	2024.03.04	ISSUED FOR PCN#009
12	2024.03.10	ISSUED FOR SI#004
13	2024.05.14	ISSUED FOR SI#006
14	2024.07.22	ISSUED FOR SI#008
15	2024.08.07	ISSUED FOR SI#009
16	2024.10.02	ISSUED FOR PCN#15
17	2025.04.11	ISSUED FOR PCN#019
18	2025.05.01	ISSUED FOR CO#07
19	2025.05.28	ISSUED FOR PCN#20 - CO#010
20	2025.07.31	ISSUED FOR SI#013
21	2025.08.06	ISSUED FOR SI#014
22	2025.08.15	ISSUED FOR PCN#25 - CO#017
23	2025.08.25	ISSUED FOR PCN#27 - CO#021
24	2025.09.02	ISSUED FOR PCN#29
25	2025.09.02	ISSUED FOR SI#20 - CO#018
26	2025.09.08	ISSUED FOR PCN#31
27	2025.09.09	ISSUED FOR PCN#32 - CO#022
28	2025.09.10	ISSUED FOR SI#33
29	2025.09.11	ISSUED FOR SI#022
30	2025.09.15	ISSUED FOR SI#023
31	2025.09.16	ISSUED FOR PCN #35 - CO#023
32	2025.09.30	ISSUED FOR PCN #37 - CO#039
33	2025.09.30	ISSUED FOR PCN #38 - CO#025
34	2025.10.06	ISSUED FOR PCN #39 - CO#024
35	2025.10.20	ISSUED FOR PCN #4081
36	2025.10.30	ISSUED FOR PCN#041
37	2025.10.23	ISSUED FOR PCN #42
38	2025.11.21	ISSUED FOR PCN#021/R1 - CO12 CD#006
39	2025.11.14	ISSUED FOR PCN#043
40	2025.11.26	ISSUED FOR PCN#043R1
41	2025.12.03	ISSUED FOR PCN#044 - CO#026
42	2026.02.04	ISSUED FOR RECORD SET UP TO CO#27

NOTES:

KEY PLAN:

Reproduction of drawings and related documents in whole or in part is forbidden without written permission of the Ventin Group.

All dimensions and measurements must be checked and verified by the General Contractor

Near North District School Board

CLIENT:
NEAR NORTH DISTRICT SCHOOL BOARD
NNDSB Tender # 2023-015

PROJECT:
NEW PARRY SOUND K-12 SCHOOL & CHILDCARE

PARRY SOUND HIGH SCHOOL SITE

111 ISABELLA STREET
PARRY SOUND, ONTARIO

ORIGINAL PAGE SIZE ARCH E1 - 30" x 42"
KEY TO DETAIL LOCATION:
(A) A - DETAIL NO.
(B) B - DETAIL NO. ORIGIN


+VG ARCHITECTS
THE VENTIN GROUP LTD

WALL SECTION DETAILS

A4.13.1


DRAWN BY : sr CHECKED BY : XX

Plot Date: Feb 03, 2026 - 5:24pm By: jkelly Filename: K:\TVG Branford\Near North DSB Parry Sound School\2211\Drawings\Wed Current\VN-A4.13.dwg

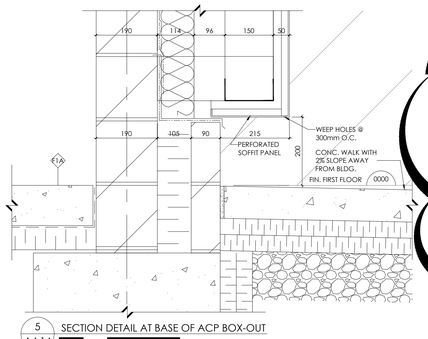


5 A4.14 SECTION DETAIL AT BASE OF ACP BOX-OUT

0 50 100 250mm

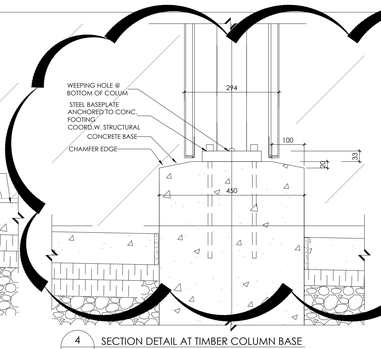


4 A4.14 SECTION DETAIL AT TIMBER COLUMN BASE

0 50 100 250mm

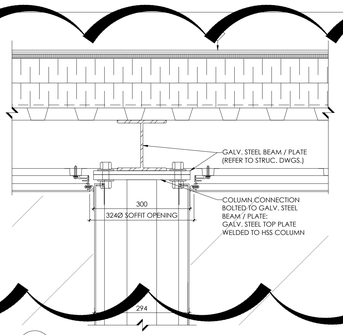

2 A4.14 SECTION DETAIL AT TIMBER COLUMN & SOFFIT


0 50 100 250mm

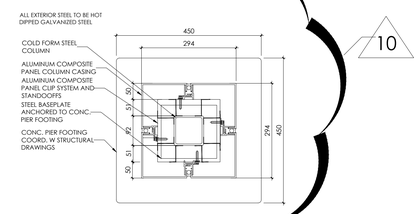

3 A4.14 PLAN DETAIL - DECORATIVE COLUMNS


0 50 100 250mm

10

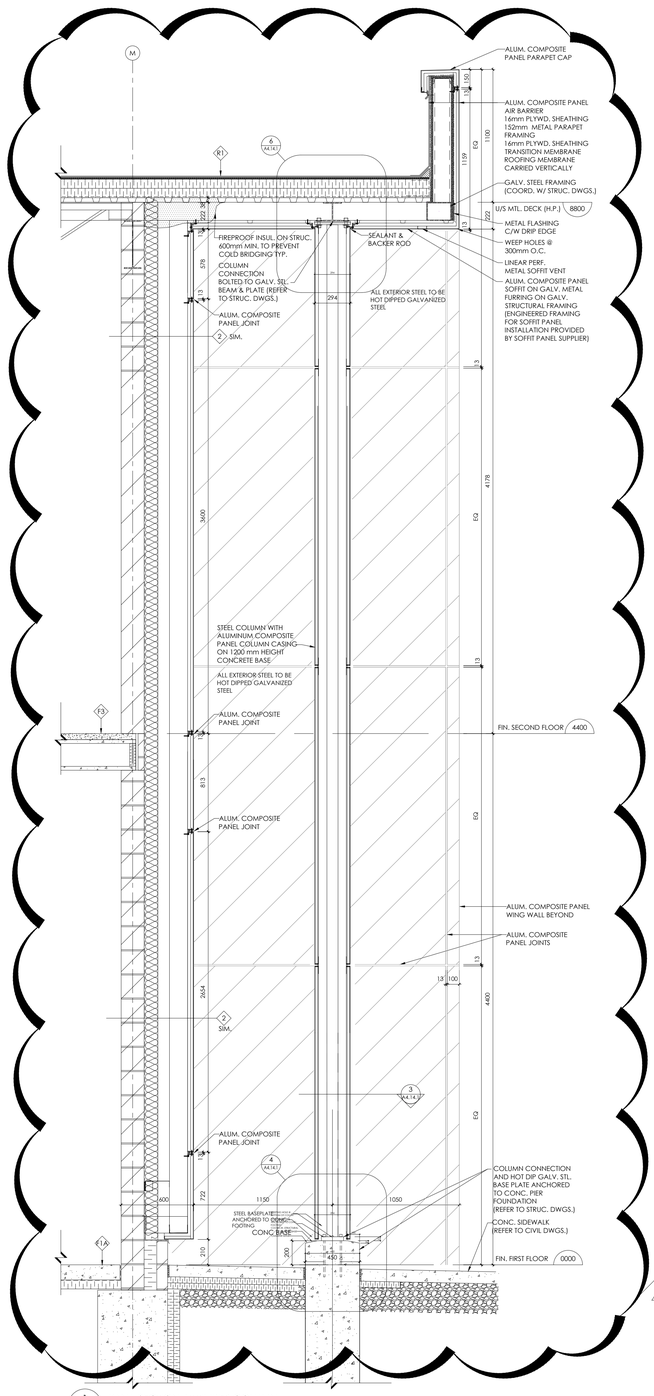


1 A4.14 WALL SECTION AT TIMBER COLUMN

0 150 300 750mm

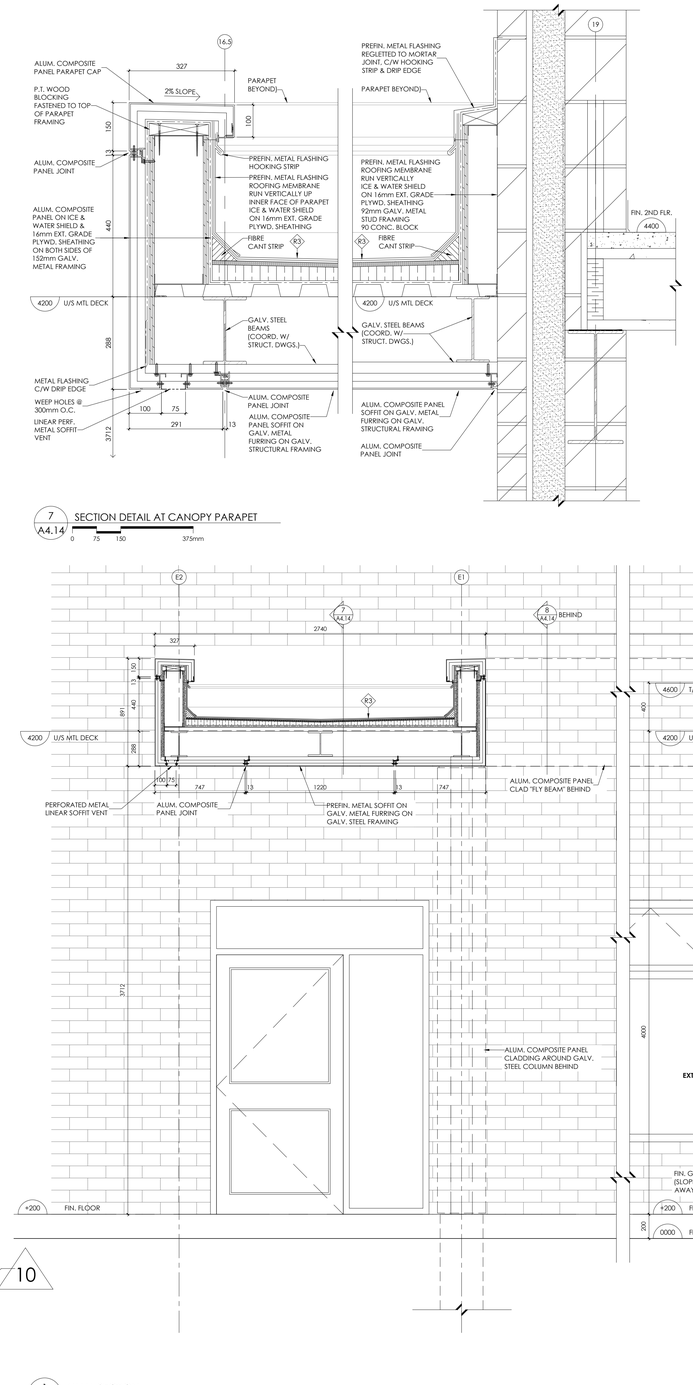


7 A4.14 SECTION DETAIL AT CANOPY PARAPET

0 75 150 375mm

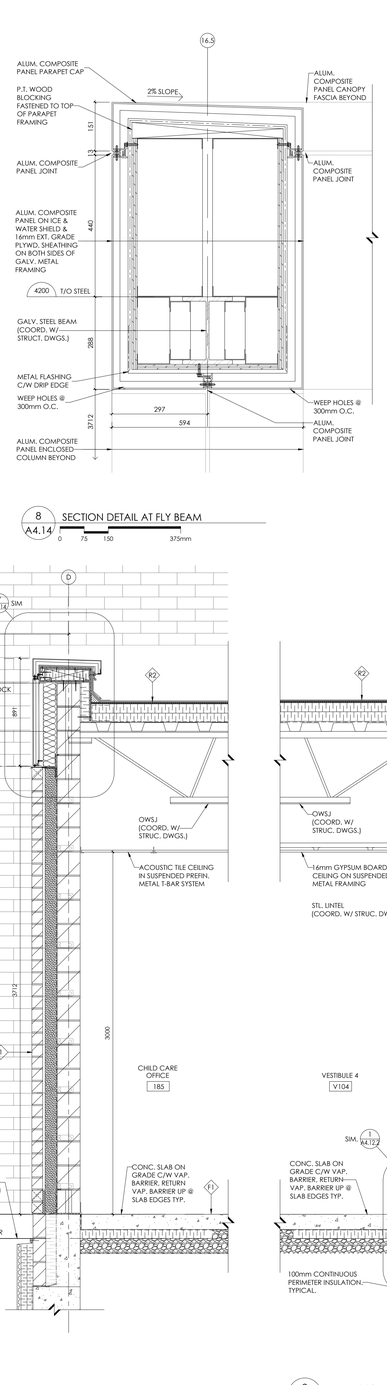

8 A4.14 SECTION DETAIL AT FLY BEAM

0 75 150 375mm

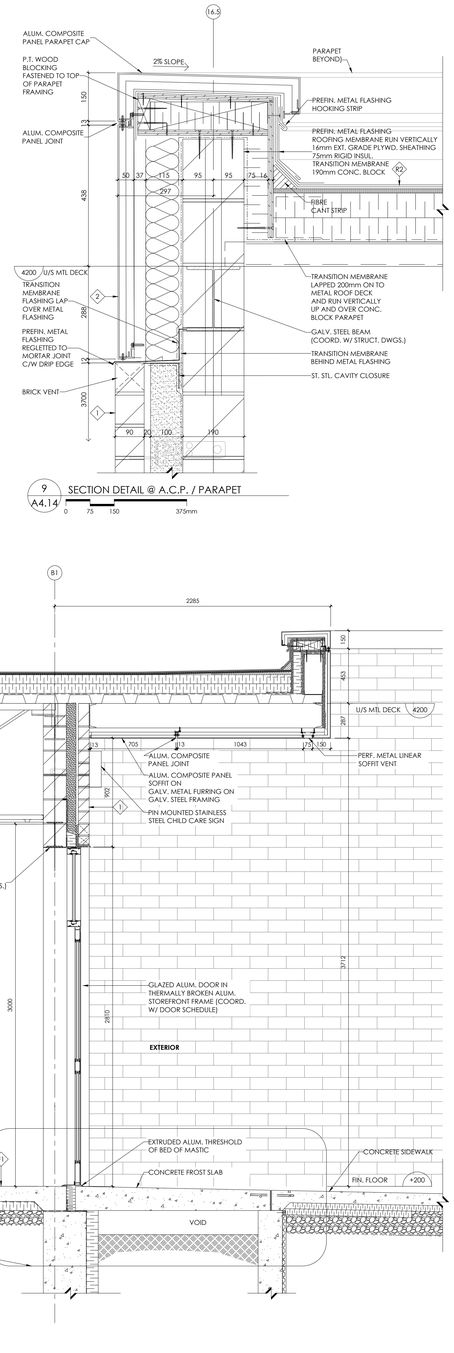

9 A4.14 SECTION DETAIL @ A.C.P. / PARAPET

0 75 150 375mm

1 A4.14 WALL SECTION

0 200 400 1000mm

2 A4.14 WALL SECTION

0 200 400 1000mm

REVISIONS

NO.	DATE	PARTICULAR
1	2022.06.06	ISSUED FOR 80% CLASS B COSTING
2	2022.08.18	ISSUED FOR SPA
3	2022.09.22	ISSUED FOR OWNERS REVIEW - 98% SET
4	2022.12.16	ISSUED FOR 2nd SPA SUBMISSION
5	2023.01.31	ISSUED FOR TENDER
6	2023.02.22	ISSUED FOR ADDENDUM 9
7	2023.08.23	ISSUED FOR CONVENIENCE
8	2023.11.20	ISSUED FOR PERMIT COMMENTS
9	2024.01.24	ISSUED FOR SI#03
10	2024.02.15	ISSUED FOR PCN#008
11	2024.03.04	ISSUED FOR PCN#009
12	2024.03.10	ISSUED FOR SI#004
13	2024.05.14	ISSUED FOR SI#006
14	2024.07.22	ISSUED FOR SI#008
15	2024.08.07	ISSUED FOR SI#009
16	2024.10.02	ISSUED FOR PCN#15
17	2025.04.11	ISSUED FOR PCN#019
18	2025.05.01	ISSUED FOR CO#07
19	2025.05.28	ISSUED FOR PCN#20 - CO#010
20	2025.07.31	ISSUED FOR SI#013
21	2025.08.06	ISSUED FOR SI#014
22	2025.08.15	ISSUED FOR PCN#25 - CO#017
23	2025.08.25	ISSUED FOR PCN#27 - CO#021
24	2025.09.02	ISSUED FOR PCN#29
25	2025.09.02	ISSUED FOR SI#20 - CO#018
26	2025.09.08	ISSUED FOR PCN#31
27	2025.09.09	ISSUED FOR PCN#32 - CO#022
28	2025.09.10	ISSUED FOR PCN#33
29	2025.09.11	ISSUED FOR SI#022
30	2025.09.15	ISSUED FOR SI#023
31	2025.09.16	ISSUED FOR PCN #35 - CO#023
32	2025.09.30	ISSUED FOR PCN #37 - CO#029
33	2025.09.30	ISSUED FOR PCN #38 - CO#025
34	2025.10.06	ISSUED FOR PCN #39 - CO#024
35	2025.10.20	ISSUED FOR PCN #4081
36	2025.10.30	ISSUED FOR PCN#041
37	2025.10.23	ISSUED FOR PCN #42
38	2025.11.21	ISSUED FOR PCN#021/R1 - CO12 CD#006
39	2025.11.14	ISSUED FOR PCN#043
40	2025.11.26	ISSUED FOR PCN#043R1
41	2025.12.03	ISSUED FOR PCN#044 - CO#026
42	2026.02.04	ISSUED FOR RECORD SET UP TO CO#27

NOTES:

KEY PLAN:

Reproduction of drawings and related documents in whole or in part is forbidden without written permission of The Ventin Group.

All dimensions and measurements must be checked and verified by the General Contractor

Near North District School Board

CLIENT:
NEAR NORTH DISTRICT SCHOOL BOARD
NNDSB Tender # 2023-015

PROJECT:
NEW PARRY SOUND K-12 SCHOOL & CHILDCARE

PARRY SOUND HIGH SCHOOL SITE

111 ISABELLA STREET
PARRY SOUND, ONTARIO

ORIGINAL PAGE SIZE ARCH E1 - 30" x 42"

KEY TO DETAIL LOCATION:
(A) A - DETAIL NO.
(B) B - DETAIL NO. ORIGIN


+VG ARCHITECTS
THE VENTIN GROUP LTD

WALL SECTIONS


A4.14

Plot Date: Feb 03, 2026 - 5:26pm By: jkelly Filename: K:\1VG-Brantford\Near North DSB Parry Sound School-22111\Drawings\Wds Current\NN - A4.14.dwg

DRAWN BY : sr CHECKED BY : XX

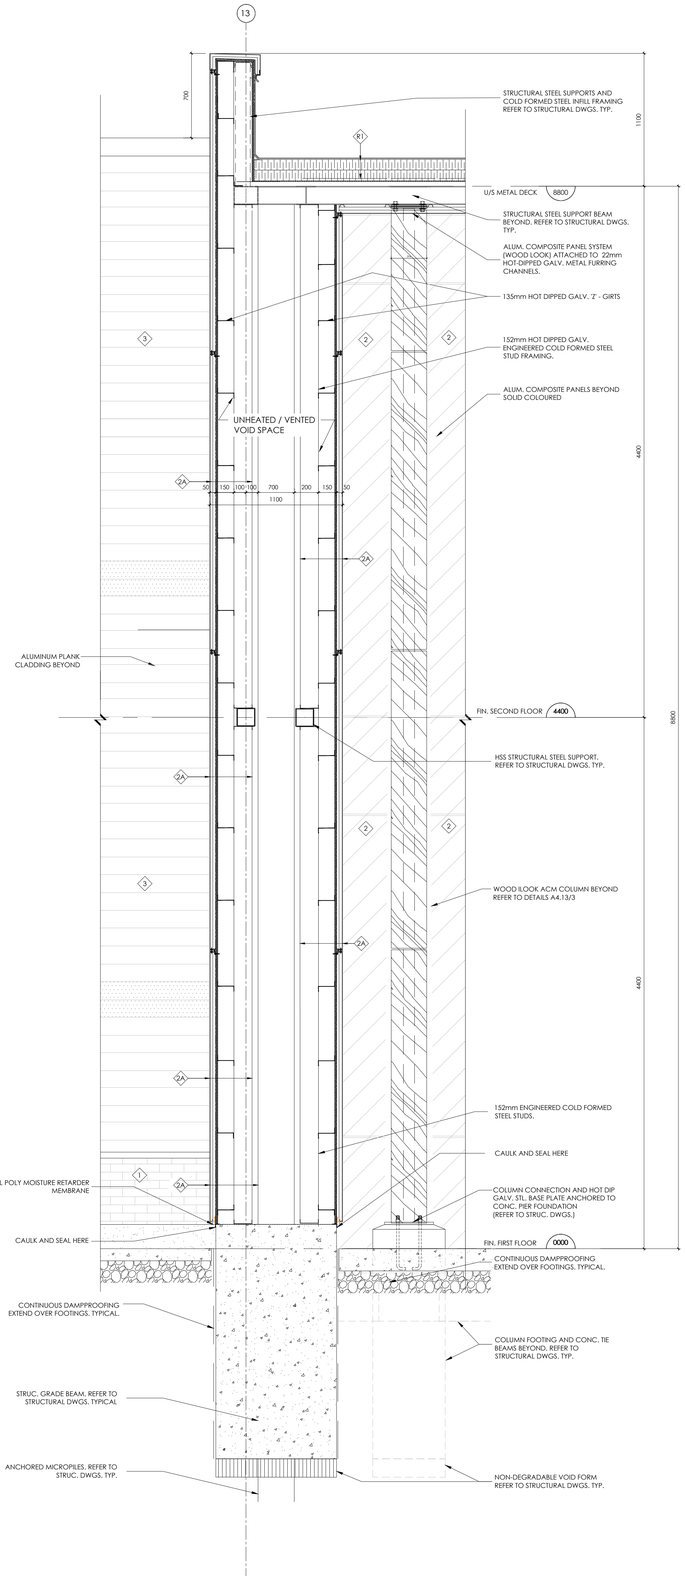

1 WALL SECTION
A4.15 0 200 400 1000mm

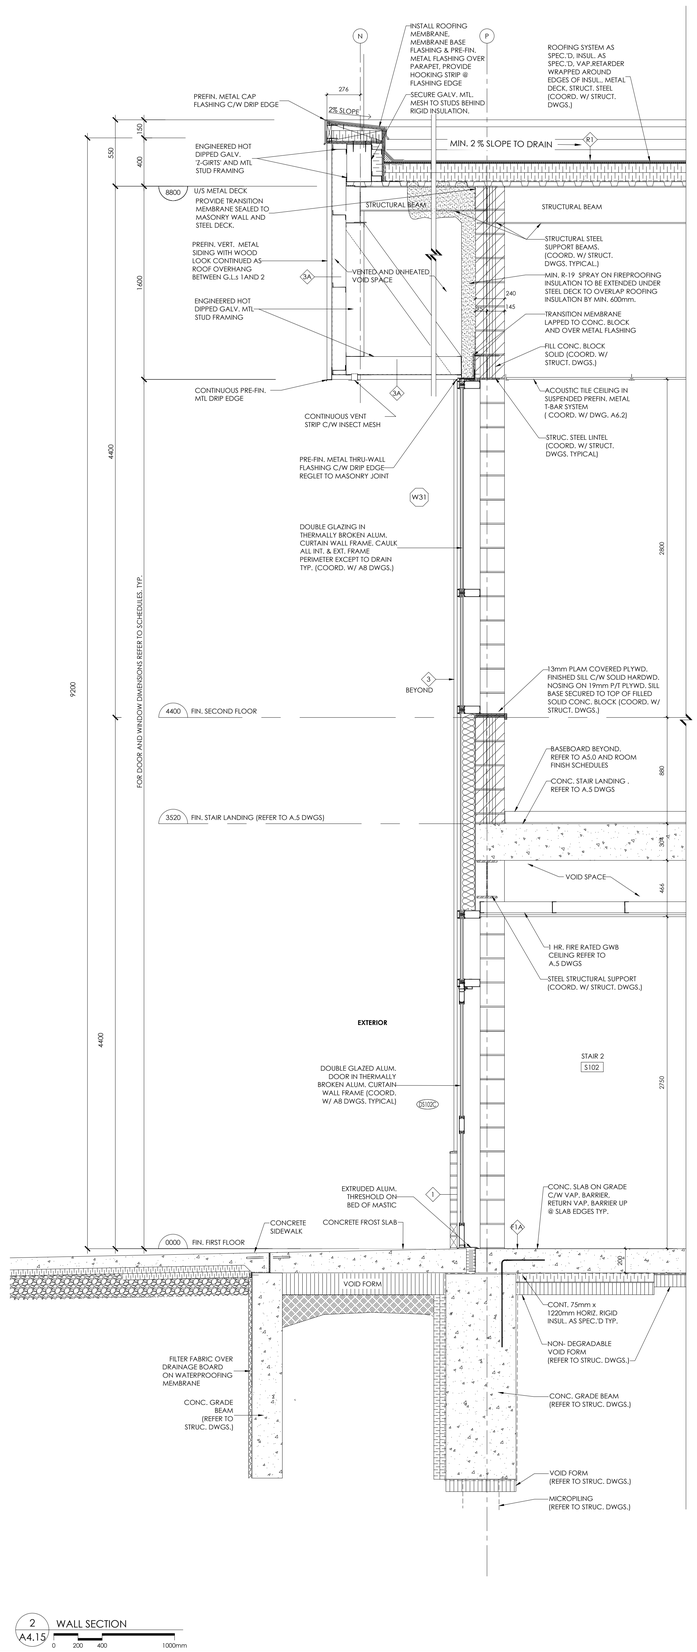

2 WALL SECTION
A4.15 0 200 400 1000mm

REVISIONS

NO.	DATE	PARTICULAR
1	2022.06.06	ISSUED FOR 80% CLASS B COSTING
2	2022.08.18	ISSUED FOR SPA
3	2022.09.22	ISSUED FOR OWNERS REVIEW - 98% SET
4	2022.12.16	ISSUED FOR 2nd SPA SUBMISSION
5	2023.01.31	ISSUED FOR TENDER
6	2023.02.22	ISSUED FOR ADDENDUM 9
7	2023.08.23	ISSUED FOR CONVENIENCE
8	2023.11.20	ISSUED FOR PERMIT COMMENTS
9	2024.01.24	ISSUED FOR SI#03
10	2024.02.15	ISSUED FOR PCN#008
11	2024.03.04	ISSUED FOR PCN#009
12	2024.03.10	ISSUED FOR SI#004
13	2024.05.14	ISSUED FOR SI#006
14	2024.07.22	ISSUED FOR SI#008
15	2024.08.07	ISSUED FOR SI#009
16	2024.10.02	ISSUED FOR PCN#15
17	2025.04.11	ISSUED FOR PCN#019
18	2025.05.01	ISSUED FOR CO#07
19	2025.05.28	ISSUED FOR PCN#20 - CO#010
20	2025.07.31	ISSUED FOR SI#013
21	2025.08.06	ISSUED FOR SI#014
22	2025.08.15	ISSUED FOR PCN#25 - CO#017
23	2025.08.25	ISSUED FOR PCN#27 - CO#021
24	2025.09.02	ISSUED FOR PCN#29
25	2025.09.02	ISSUED FOR SI#20 - CO#018
26	2025.09.08	ISSUED FOR PCN#31
27	2025.09.09	ISSUED FOR PCN#32 - CO#022
28	2025.09.10	ISSUED FOR PCN#33
29	2025.09.11	ISSUED FOR SI#022
30	2025.09.15	ISSUED FOR SI#023
31	2025.09.16	ISSUED FOR PCN #35 - CO#023
32	2025.09.30	ISSUED FOR PCN #37 - CO#029
33	2025.09.30	ISSUED FOR PCN #38 - CO#025
34	2025.10.06	ISSUED FOR PCN #39 - CO#024
35	2025.10.20	ISSUED FOR PCN #40R1
36	2025.10.30	ISSUED FOR PCN#041
37	2025.10.23	ISSUED FOR PCN #42
38	2025.11.21	ISSUED FOR PCN#021/R1 - CO12 CD#006
39	2025.11.14	ISSUED FOR PCN#043
40	2025.11.26	ISSUED FOR PCN#043R1
41	2025.12.03	ISSUED FOR PCN#044 - CO#026
42	2026.02.04	ISSUED FOR RECORD SET UP TO CO#27

NOTES:

KEY PLAN:

All dimensions and measurements must be checked and verified by the General Contractor

Reproduction of drawings and related documents in whole or in part is forbidden without written permission of the Ventin Group.

Near North District School Board

CLIENT:
NEAR NORTH DISTRICT SCHOOL BOARD
NNDSB Tender # 2023-015

PROJECT:
NEW PARRY SOUND K-12 SCHOOL & CHILDCARE

PARRY SOUND HIGH SCHOOL SITE

111 ISABELLA STREET
PARRY SOUND, ONTARIO

ORIGINAL PAGE SIZE ARCH E1 - 30" x 42"
KEY TO DETAIL LOCATION:
A - DETAIL NO.
B - DETAIL NO. ORIGIN


+VG ARCHITECTS
THE VENTIN GROUP LTD

WALL SECTIONS


A4.15

DRAWN BY : MK CHECKED BY : XX


Plot Date: Feb 03, 2026 - 5:26pm By: jkelly Filename: K:\1VG-Brantford\Near North DSB Parry Sound School\2111\Drawings\Wd Current\NN- A4.15.dwg

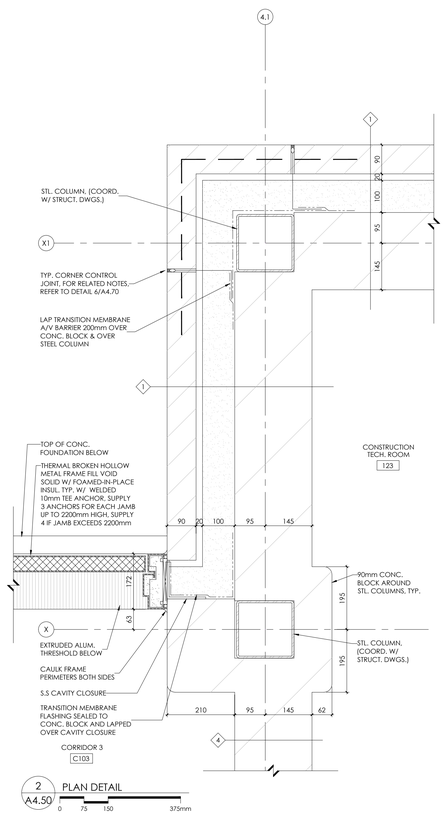


2 PLAN DETAIL A4.50 — 0 75 150 375mm

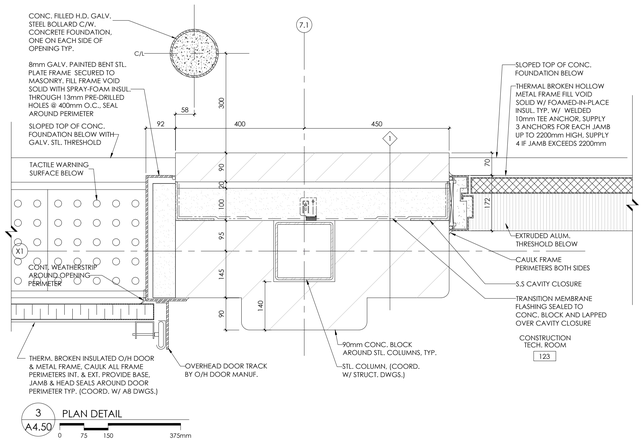


3 PLAN DETAIL A4.50 — 0 75 150 375mm

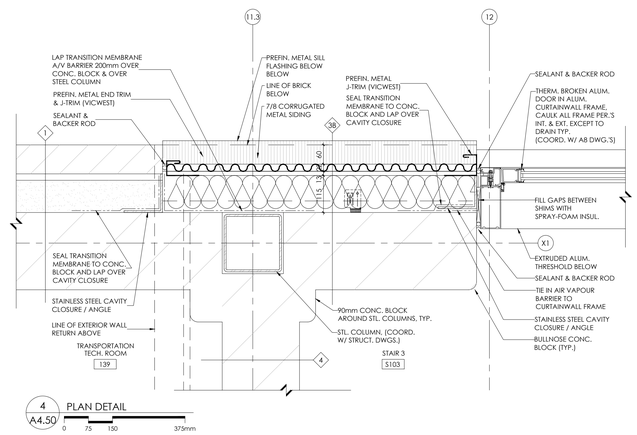


4 PLAN DETAIL A4.50 — 0 75 150 375mm

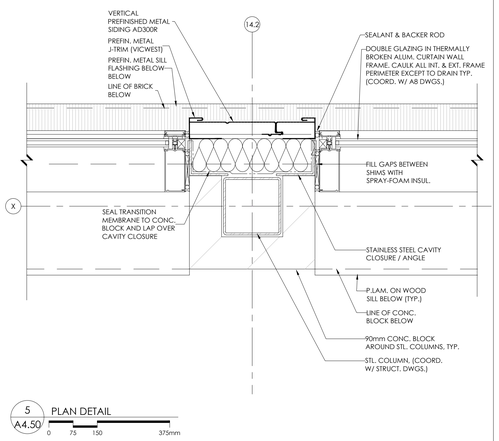


5 PLAN DETAIL A4.50 — 0 75 150 375mm

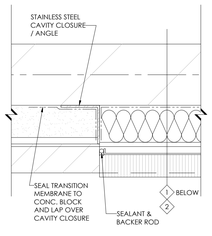


6 PLAN DETAIL A4.50 — 0 75 150 375mm

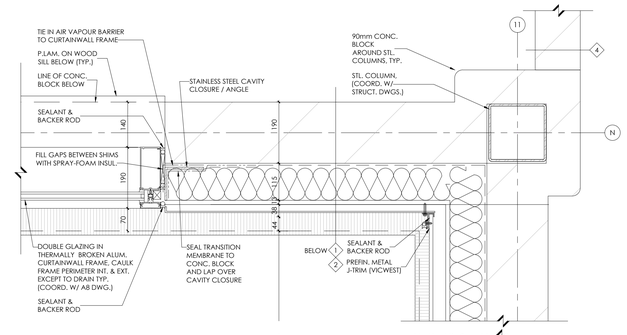


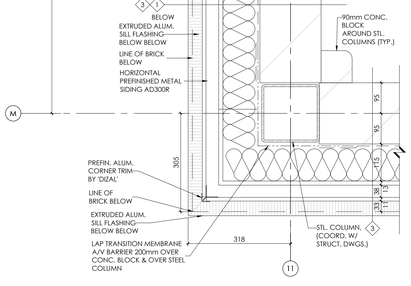

7 PLAN DETAIL A4.50 — 0 75 150 375mm

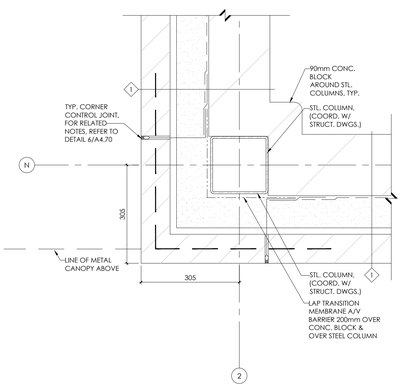



1 PLAN DETAIL A4.50 — 0 75 150 375mm

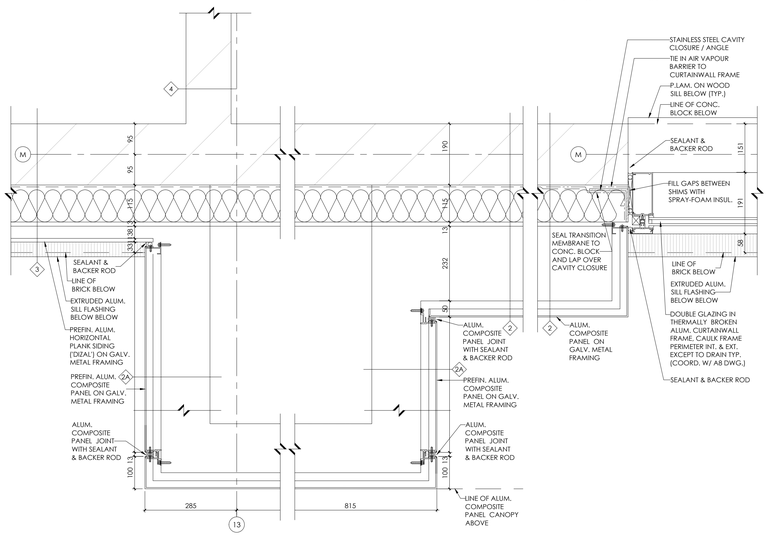


8 PLAN DETAIL A4.50 — 0 75 150 375mm

9 PLAN DETAIL A4.50 — 0 75 150 375mm

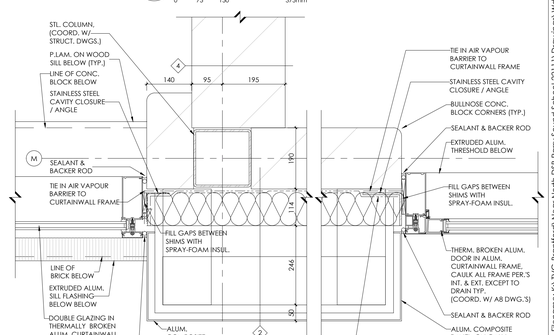

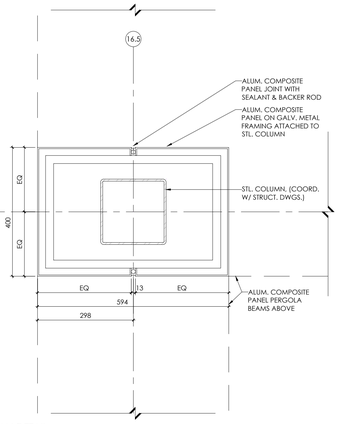

10 PLAN DETAIL A4.50 — 0 75 150 375mm

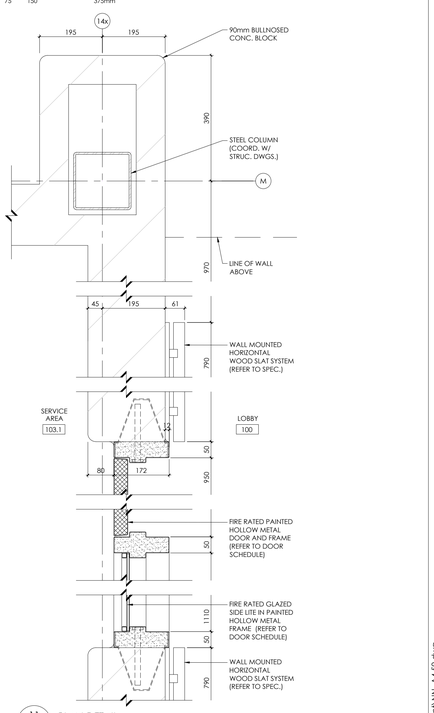

11 PLAN DETAIL A4.50 — 0 75 150 375mm

REVISIONS

NO.	DATE	PARTICULAR
1	2022.06.06	ISSUED FOR 80% CLASS B COSTING
2	2022.08.18	ISSUED FOR SPA
3	2022.09.22	ISSUED FOR OWNERS REVIEW - 98% SET
4	2022.12.16	ISSUED FOR 2nd SPA SUBMISSION
5	2023.01.31	ISSUED FOR TENDER
6	2023.02.22	ISSUED FOR ADDENDUM 9
7	2023.08.23	ISSUED FOR CONVENIENCE
8	2023.11.20	ISSUED FOR PERMIT COMMENTS
9	2024.01.24	ISSUED FOR SI#03
10	2024.02.15	ISSUED FOR PCN#008
11	2024.03.04	ISSUED FOR PCN#009
12	2024.03.10	ISSUED FOR SI#004
13	2024.05.14	ISSUED FOR SI#006
14	2024.07.22	ISSUED FOR SI#008
15	2024.08.07	ISSUED FOR SI#009
16	2024.10.02	ISSUED FOR PCN#15
17	2025.04.11	ISSUED FOR PCN#019
18	2025.05.01	ISSUED FOR CO#07
19	2025.05.28	ISSUED FOR PCN#20 - CO#010
20	2025.07.31	ISSUED FOR SI#013
21	2025.08.06	ISSUED FOR SI#014
22	2025.08.15	ISSUED FOR PCN#25 - CO#017
23	2025.08.25	ISSUED FOR PCN#27 - CO#021
24	2025.09.02	ISSUED FOR PCN#29
25	2025.09.02	ISSUED FOR SI#20 - CO#018
26	2025.09.08	ISSUED FOR PCN#31
27	2025.09.09	ISSUED FOR PCN#32 - CO#022
28	2025.09.10	ISSUED FOR SI#33
29	2025.09.11	ISSUED FOR SI#022
30	2025.09.15	ISSUED FOR SI#023
31	2025.09.16	ISSUED FOR PCN #35 - CO#023
32	2025.09.30	ISSUED FOR PCN #37 - CO#029
33	2025.09.30	ISSUED FOR PCN #38 - CO#025
34	2025.10.06	ISSUED FOR PCN #39 - CO#024
35	2025.10.20	ISSUED FOR PCN #4081
36	2025.10.30	ISSUED FOR PCN#041
37	2025.10.23	ISSUED FOR PCN #42
38	2025.11.21	ISSUED FOR PCN#021/R1 - CO12 CD#006
39	2025.11.14	ISSUED FOR PCN#043
40	2025.11.26	ISSUED FOR PCN#043R1
41	2025.12.03	ISSUED FOR PCN#044 - CO#026
42	2026.02.04	ISSUED FOR RECORD SET UP TO CO#27

NOTES:

KEY PLAN:

All dimensions and measurements must be checked and verified by the General Contractor

Reproduction of drawings and related documents in whole or in part is forbidden without written permission of the Ventin Group.

Near North District School Board

CLIENT:
NEAR NORTH DISTRICT SCHOOL BOARD
NNDSB Tender # 2023-015

PROJECT:
NEW PARRY SOUND K-12 SCHOOL & CHILDCARE

PARRY SOUND HIGH SCHOOL SITE

111 ISABELLA STREET
PARRY SOUND, ONTARIO

ORIGINAL PAGE SIZE ARCH E1 - 30" x 42"
KEY TO DETAIL LOCATION:
(A) A - DETAIL NO.
(B) B - DETAIL NO. ORIGIN


+VG ARCHITECTS
THE VENTIN GROUP LTD


PLAN DETAILS - FIRST FLOOR


A4.50


Plot Date: Feb 03, 2026 - 5:27pm By: jkelly
Filename: K:\VG-Brantford\Near North DSB Parry Sound School\2111 Drawings\Wd-Current\NN - A4.50.dwg


DRAWN BY : sr
CHECKED BY : XX

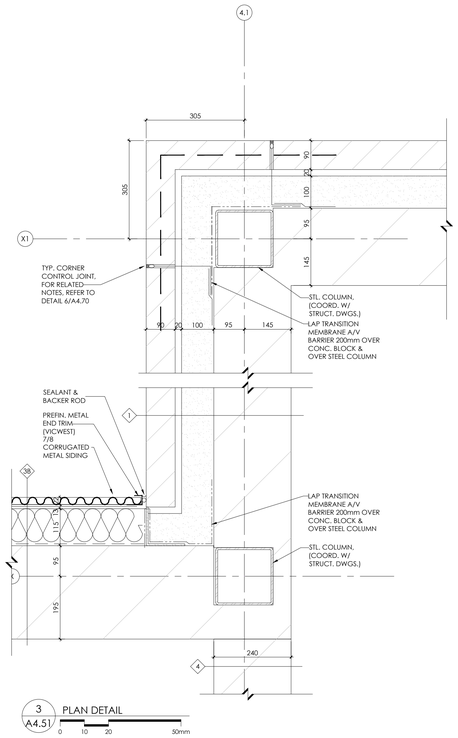

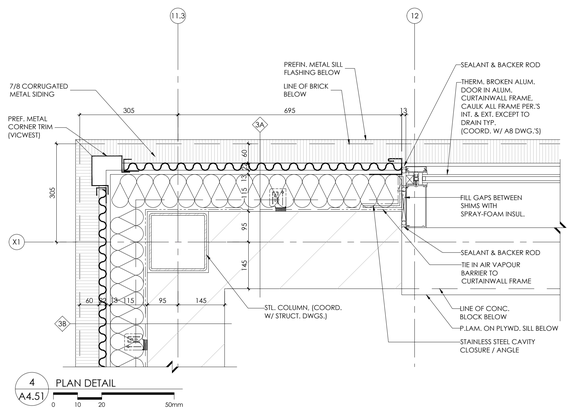

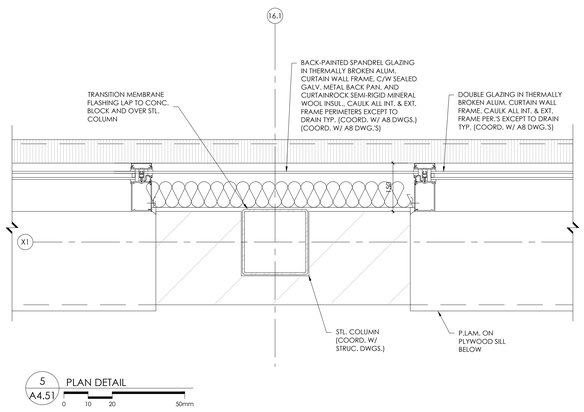

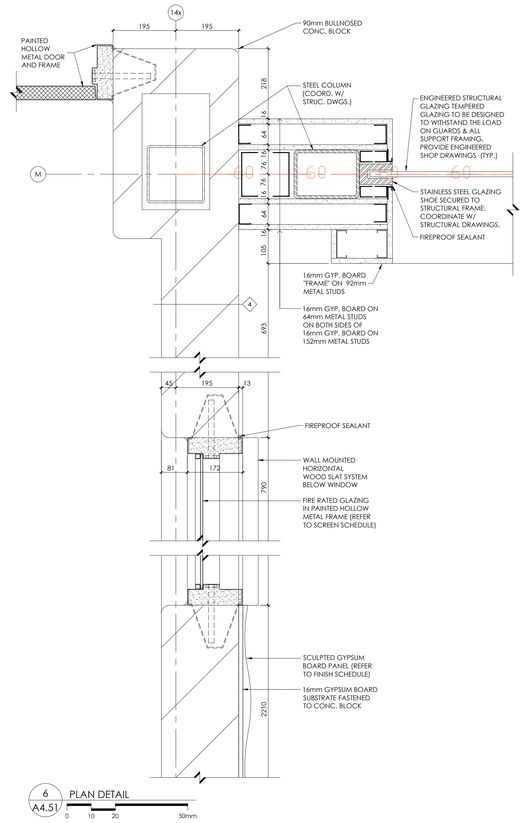

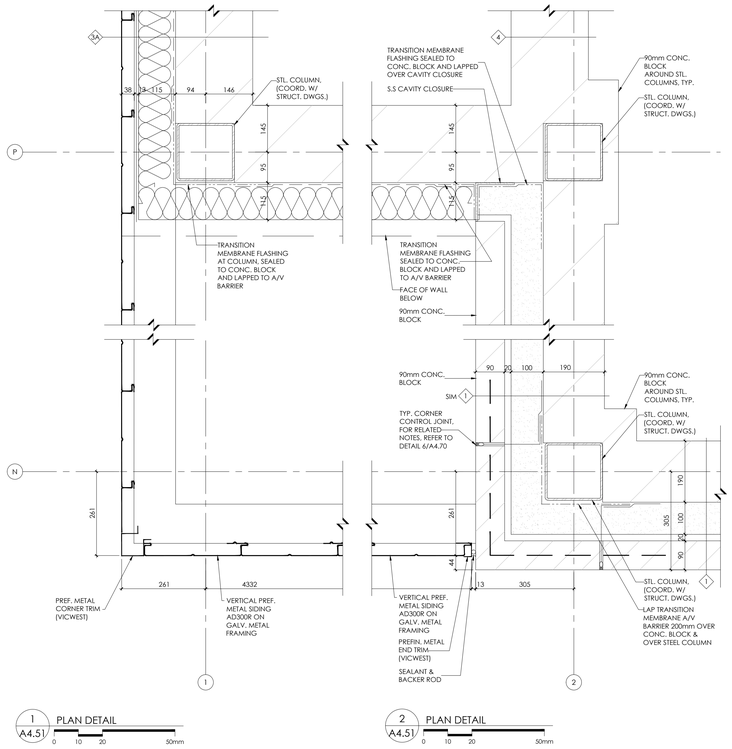

REVISIONS

NO.	DATE	PARTICULAR
1	2022.06.06	ISSUED FOR 80% CLASS B COSTING
2	2022.08.18	ISSUED FOR SPA
3	2022.09.22	ISSUED FOR OWNERS REVIEW - 98% SET
4	2022.12.16	ISSUED FOR 2nd SPA SUBMISSION
5	2023.01.31	ISSUED FOR TENDER
6	2023.02.22	ISSUED FOR ADDENDUM 9
7	2023.08.23	ISSUED FOR CONVENIENCE
8	2023.11.20	ISSUED FOR PERMIT COMMENTS
9	2024.01.24	ISSUED FOR SI#03
10	2024.02.15	ISSUED FOR PCN#008
11	2024.03.04	ISSUED FOR PCN#009
12	2024.03.10	ISSUED FOR SI#004
13	2024.05.14	ISSUED FOR SI#006
14	2024.07.22	ISSUED FOR SI#008
15	2024.08.07	ISSUED FOR SI#009
16	2024.10.02	ISSUED FOR PCN#15
17	2025.04.11	ISSUED FOR PCN#019
18	2025.05.01	ISSUED FOR CO#07
19	2025.05.28	ISSUED FOR PCN#20 - CO#010
20	2025.07.31	ISSUED FOR SI#013
21	2025.08.06	ISSUED FOR SI#014
22	2025.08.15	ISSUED FOR PCN#25 - CO#017
23	2025.08.25	ISSUED FOR PCN#27 - CO#021
24	2025.09.02	ISSUED FOR PCN#29
25	2025.09.02	ISSUED FOR SI#20 - CO#018
26	2025.09.08	ISSUED FOR PCN#31
27	2025.09.09	ISSUED FOR PCN#32 - CO#022
28	2025.09.10	ISSUED FOR PCN#33
29	2025.09.11	ISSUED FOR SI#022
30	2025.09.15	ISSUED FOR SI#023
31	2025.09.16	ISSUED FOR PCN #35 - CO#023
32	2025.09.30	ISSUED FOR PCN #37 - CO#029
33	2025.09.30	ISSUED FOR PCN #38 - CO#025
34	2025.10.06	ISSUED FOR PCN #39 - CO#024
35	2025.10.20	ISSUED FOR PCN #40#1
36	2025.10.30	ISSUED FOR PCN#041
37	2025.10.23	ISSUED FOR PCN #42
38	2025.11.21	ISSUED FOR PCN#021/R1 - CO12 CD#006
39	2025.11.14	ISSUED FOR PCN#043
40	2025.11.26	ISSUED FOR PCN#043R1
41	2025.12.03	ISSUED FOR PCN#044 - CO#026
42	2026.02.04	ISSUED FOR RECORD SET UP TO CO#27

NOTES:

KEY PLAN:

All dimensions and measurements must be checked and verified by the General Contractor

Reproduction of drawings and related documents in whole or in part is forbidden without written permission of the VentinGroup.

Near North District School Board

CLIENT:
NEAR NORTH DISTRICT SCHOOL BOARD
NNDSB Tender # 2023-015

PROJECT:
NEW PARRY SOUND K-12 SCHOOL & CHILDCARE

PARRY SOUND HIGH SCHOOL SITE

111 ISABELLA STREET
PARRY SOUND, ONTARIO

ORIGINAL PAGE SIZE ARCH E1 - 30" x 42"

KEY TO DETAIL LOCATION:
A - DETAIL NO.
B - DETAIL NO. ORIGIN

+VG ARCHITECTS
THE VENTIN GROUP LTD


CN

PLAN DETAILS - SECOND FLOOR

A4.51


Plot Date: Feb 03, 2026 - 5:28pm By: jkelly
Filename: K:\1VG-Brantford\Near North DSB Parry Sound School\2211\1Drawings\Wd-Current\NN-A4.51.dwg

DRAWN BY : sr
CHECKED BY : XX

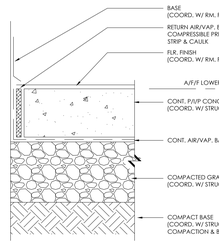


1 A4.70 TYPICAL SLAB ON GRADE DETAIL

0 50 100 250mm

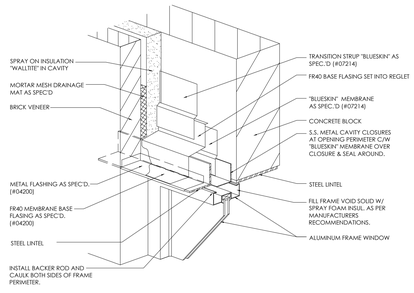


2 A4.70 TYPICAL ISOMETRIC - HEAD DETAIL

0 10 20 50mm

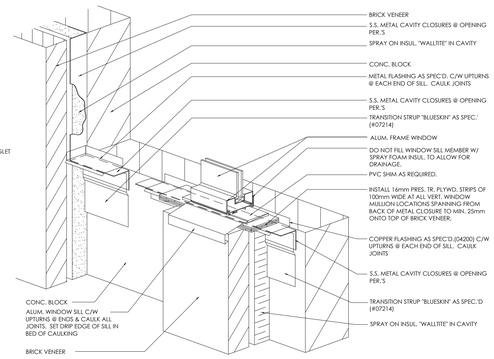


3 A4.70 TYPICAL ISOMETRIC - JAMB & SILL DETAIL

0 10 20 50mm

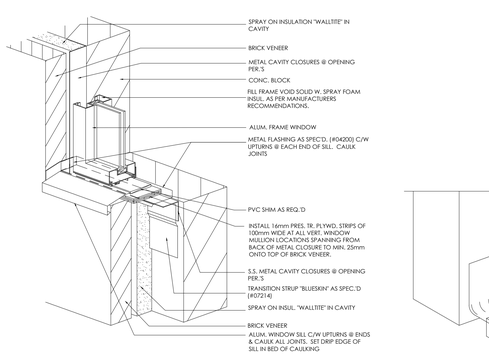

4 A4.70 TYPICAL ISOMETRIC - JAMB & SILL DETAIL

0 10 20 50mm

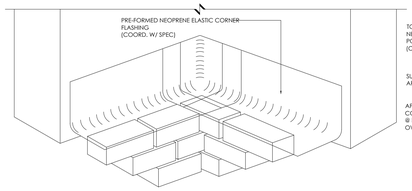

5 A4.70 TYPICAL ELASTIC FLASHING CORNER DETAIL

0 10 20 50mm




A FACE BRICK

B CONC. BLOCK


C BRICK & BLOCK -SECTION DETAIL

10 A4.70 TYPICAL BRICK & BLOCK CONTROL JOINTS


0 50 100 250mm

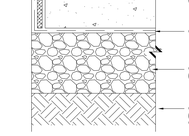

A SCHEMATIC ELEVATION

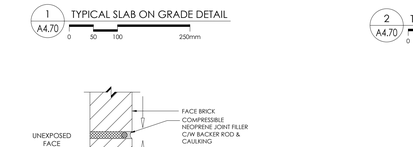


B PLAN SECTION

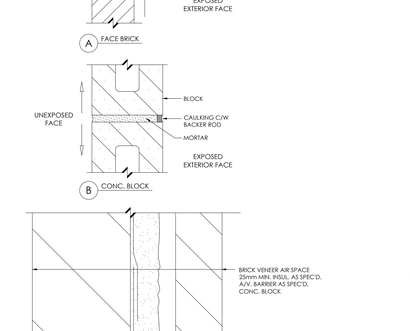

C WALL SECTION


15 A4.70 TYPICAL PARAPET SCUPPER DRAIN SECTION DETAIL

0 10 20 50mm

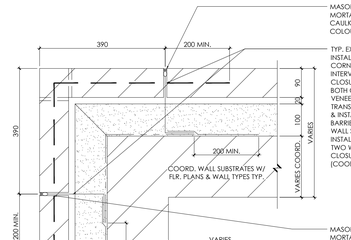


6 A4.70 TYPICAL CORNER PLAN DETAIL

0 75 150 375mm

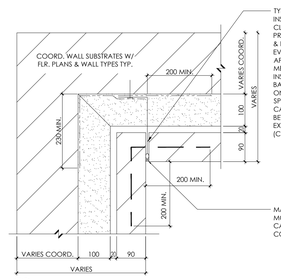


7 A4.70 TYPICAL EXISTING CORNER C/C/J PLAN DETAIL

0 75 150 375mm

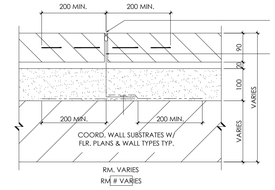


8 A4.70 TYPICAL MASONRY VENEER C/C/J

0 75 150 375mm

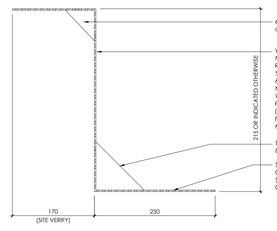

9 A4.70 METAL SUPPORT FASCIA DETAIL

0 30 100 250mm

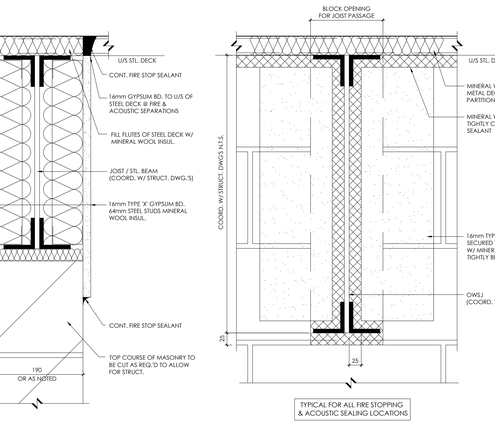

11 A4.70 TYPICAL WALL SECTION DETAIL


0 50 100 250mm

12 A4.70 TYPICAL WALL SECTION DETAIL

0 50 100 250mm


13 A4.70 TYPICAL WALL SECTION DETAIL

0 50 100 250mm

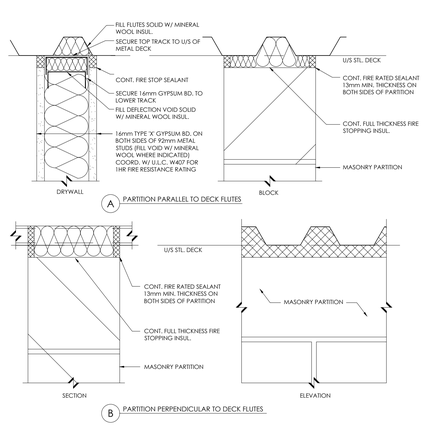

14 A4.70 TYPICAL TOP OF PARTITION WALL

0 50 100 250mm

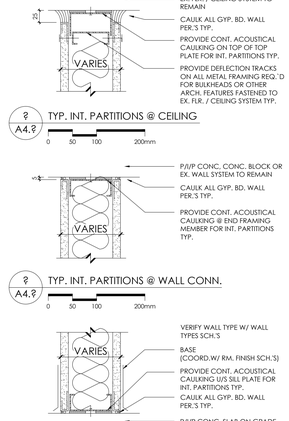


? A4.8 TYP. INT. PARTITIONS @ CEILING

0 50 100 200mm


? A4.8 TYP. INT. PARTITIONS @ WALL CONN.

0 50 100 200mm

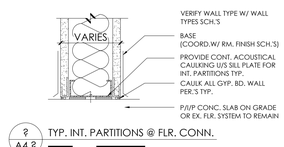

? A4.8 TYP. INT. PARTITIONS @ FLR. CONN.

0 50 100 200mm

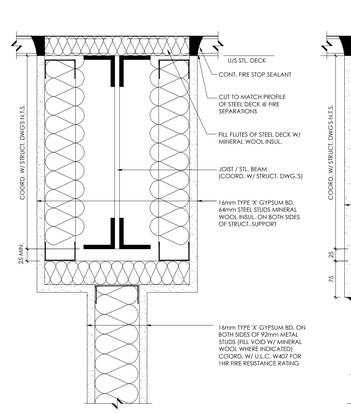

11 A4.70 TYPICAL WALL SECTION DETAIL

0 50 100 250mm

12 A4.70 TYPICAL WALL SECTION DETAIL

0 50 100 250mm

13 A4.70 TYPICAL WALL SECTION DETAIL

0 50 100 250mm

14 A4.70 TYPICAL TOP OF PARTITION WALL

0 50 100 250mm

? A4.8 TYP. INT. PARTITIONS @ CEILING


0 50 100 200mm

? A4.8 TYP. INT. PARTITIONS @ WALL CONN.

0 50 100 200mm


? A4.8 TYP. INT. PARTITIONS @ FLR. CONN.

0 50 100 200mm

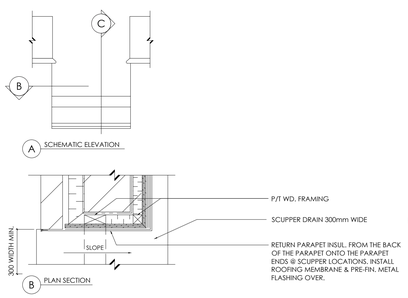

A SCHEMATIC ELEVATION


B PLAN SECTION

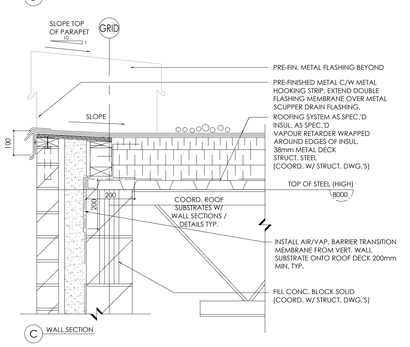

C WALL SECTION


15 A4.70 TYPICAL PARAPET SCUPPER DRAIN SECTION DETAIL

0 10 20 50mm

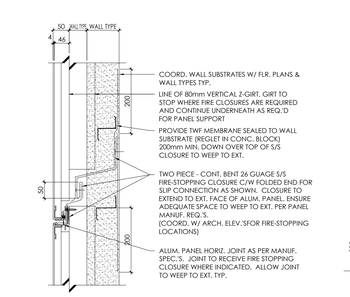


19 A4.6 TYP. FIRESTOPPING SECTION DETAIL @ ALUM. PANEL

0 100 200 300mm

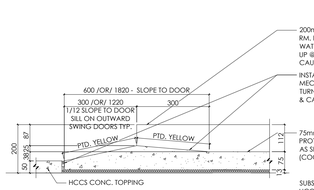


6 A4.6 MECH. RM. SLAB WATERPROOFING SYSTEM

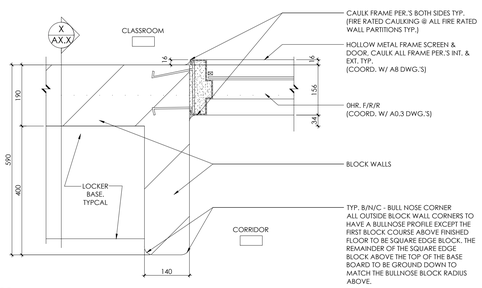

? A4.8 TYP. NIB WALL @ OPENING PLAN DETAIL

0 100 200 300mm

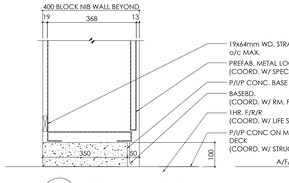

17 A4.8 LOCKER BASE SECTION DETAIL

0 100 200 500mm

REVISIONS

NO.	DATE	PARTICULAR
1	2022.06.06	ISSUED FOR 80% CLASS B COSTING
2	2022.08.18	ISSUED FOR SPA
3	2022.09.22	ISSUED FOR OWNERS REVIEW - 98% SET
4	2022.12.16	ISSUED FOR 2nd SPA SUBMISSION
5	2023.01.31	ISSUED FOR TENDER
6	2023.02.22	ISSUED FOR ADDENDUM 9
7	2023.08.23	ISSUED FOR CONVENIENCE
8	2023.11.20	ISSUED FOR PERMIT COMMENTS
9	2024.01.24	ISSUED FOR SI#03
10	2024.02.15	ISSUED FOR PCN#008
11	2024.03.04	ISSUED FOR PCN#009
12	2024.03.10	ISSUED FOR SI#04
13	2024.05.14	ISSUED FOR SI#06
14	2024.07.22	ISSUED FOR SI#08
15	2024.08.07	ISSUED FOR SI#09
16	2024.10.02	ISSUED FOR PCN#15
17	2025.04.11	ISSUED FOR PCN#019
18	2025.05.01	ISSUED FOR CO#07
19	2025.05.28	ISSUED FOR PCN#20 - CO#010
20	2025.07.31	ISSUED FOR SI#013
21	2025.08.06	ISSUED FOR SI#014
22	2025.08.15	ISSUED FOR PCN#25 - CO#017
23	2025.08.25	ISSUED FOR PCN#27 - CO#021
24	2025.09.02	ISSUED FOR PCN#29
25	2025.09.02	ISSUED FOR SI#20 - CO#018
26	2025.09.08	ISSUED FOR PCN#31
27	2025.09.09	ISSUED FOR PCN#32 - CO#022
28	2025.09.10	ISSUED FOR PCN#33
29	2025.09.11	ISSUED FOR SI#022
30	2025.09.15	ISSUED FOR SI#023
31	2025.09.16	ISSUED FOR PCN #35 - CO#023
32	2025.09.30	ISSUED FOR PCN #37 - CO#029
33	2025.09.30	ISSUED FOR PCN #38 - CO#025
34	2025.10.06	ISSUED FOR PCN #39 - CO#024
35	2025.10.20	ISSUED FOR PCN #4081
36	2025.10.30	ISSUED FOR PCN#041
37	2025.10.23	ISSUED FOR PCN #42
38	2025.11.21	ISSUED FOR PCN#021/R1 - CO12 CD#006
39	2025.11.14	ISSUED FOR PCN#043
40	2025.11.26	ISSUED FOR PCN#043R1
41	2025.12.03	ISSUED FOR PCN#044 - CO#026
42	2026.02.04	ISSUED FOR RECORD SET UP TO CO#27

NOTES:

KEY PLAN:

Reproduction of drawings and related documents in whole or in part is forbidden without written permission of the Ventin Group.

All dimensions and measurements must be checked and verified by the General Contractor

Near North District School Board

CLIENT:
NEAR NORTH DISTRICT SCHOOL BOARD
NNDSB Tender # 2023-015


PROJECT:
NEW PARRY SOUND K-12 SCHOOL & CHILDCARE

PARRY SOUND HIGH SCHOOL SITE


111 ISABELLA STREET
PARRY SOUND, ONTARIO

ORIGINAL PAGE SIZE ARCH E1 - 30" x 42"
KEY TO DETAIL LOCATION:
(A) A - DETAIL NO.
(B) B - DETAIL NO. ORIGIN


+VG ARCHITECTS
THE V

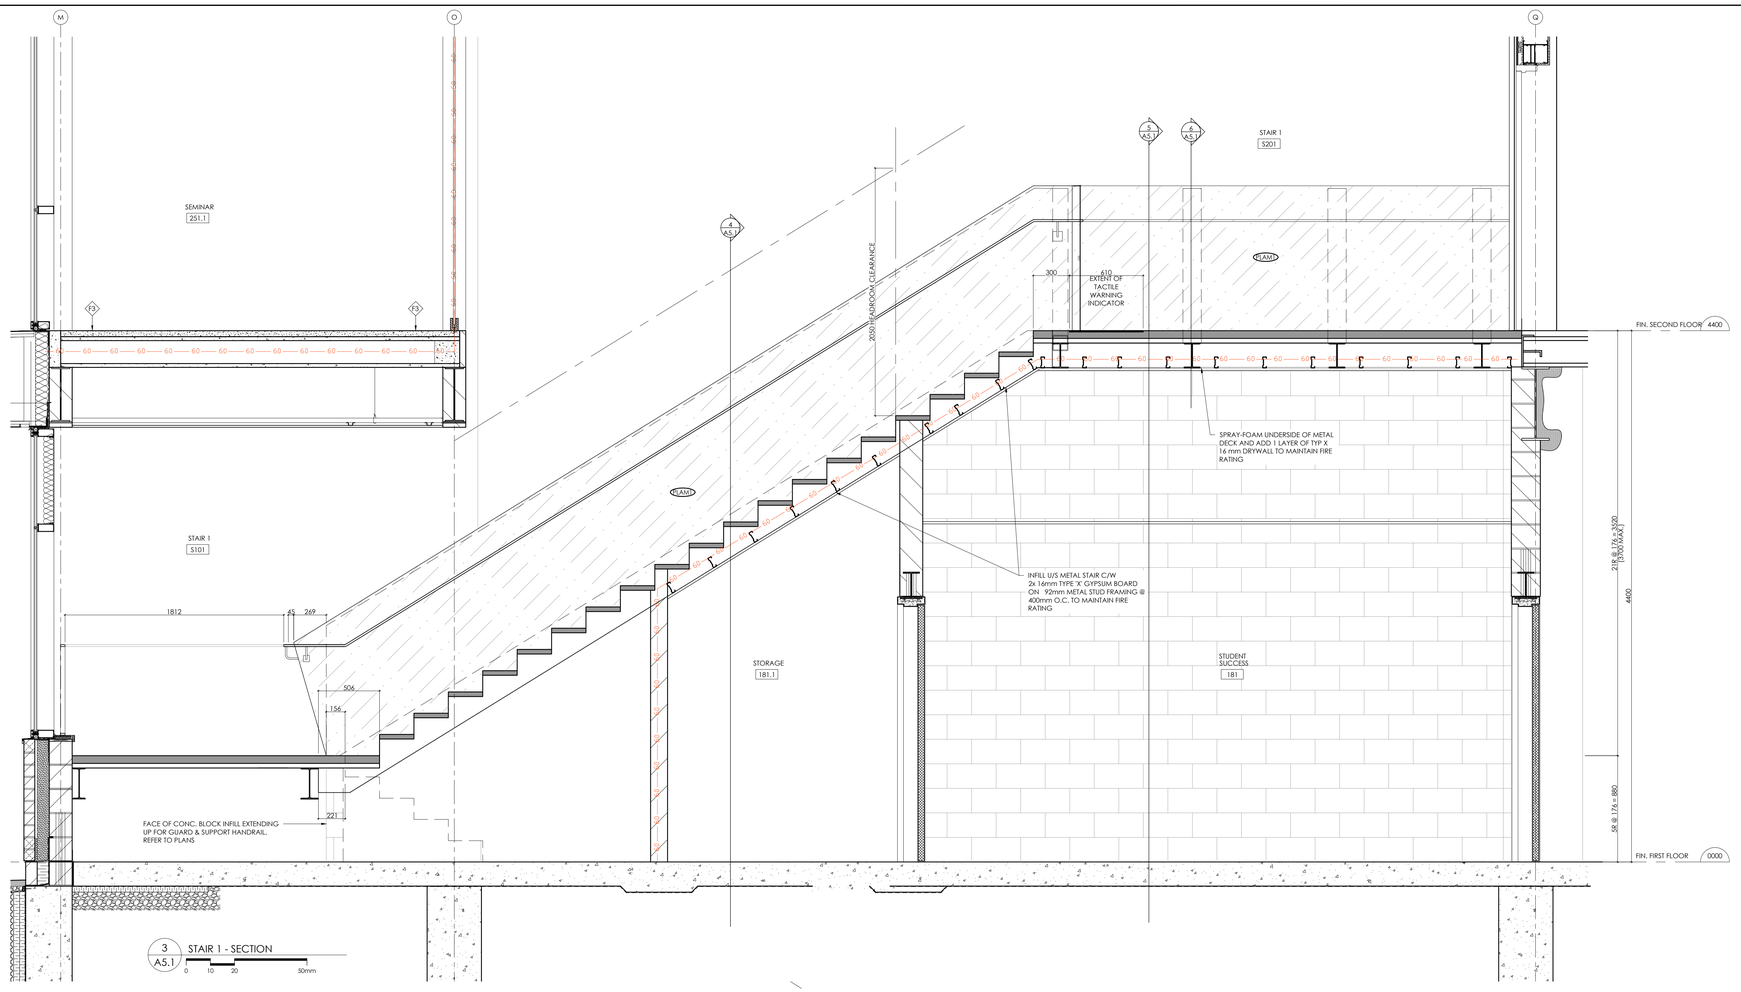


3 A5.1 STAIR 1 - SECTION
0 10 20 50mm

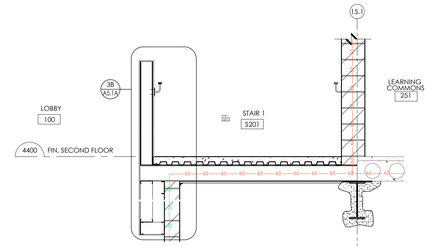


6 A5.1 SECTION - STAIR #1 @ SECOND FLOOR LANDING THROUGH STEEL POST
0 300 600 1500mm

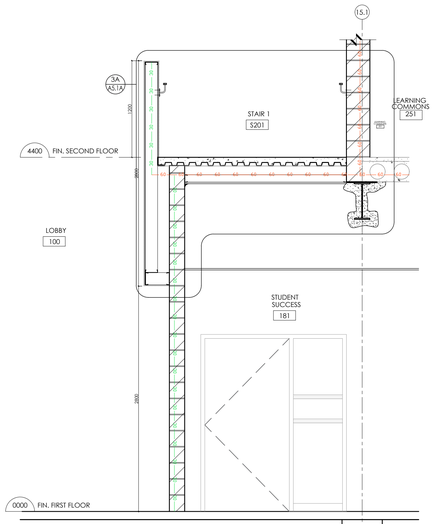

5 A5.1 SECTION - STAIR #1 @ SECOND FLOOR LANDING THROUGH STUD WALL
0 300 600 1500mm

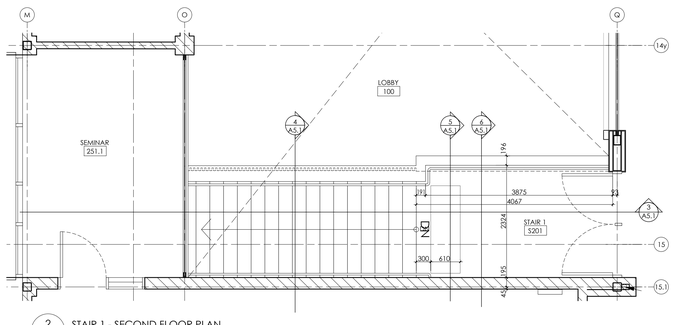

2 A5.1 STAIR 1 - SECOND FLOOR PLAN
0 500 1000 2500mm

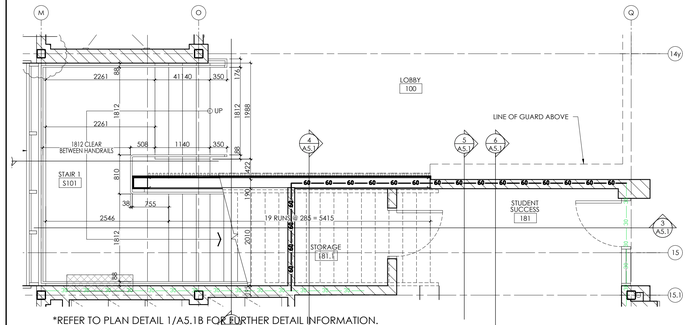

*REFER TO PLAN DETAIL 1/A5.1B FOR FURTHER DETAIL INFORMATION.

1 A5.1 STAIR 1 - FIRST FLOOR PLAN
0 500 1000 2500mm

3 A5.1 STAIR 1 - SECTION
0 10 20 50mm


4 A5.1 STAIR #1 - TYPICAL HANDRAIL SECTION THROUGH STAIR RISE
0 300 600 1500mm

REVISIONS

NO.	DATE	PARTICULAR
1	2022.06.06	ISSUED FOR 80% CLASS B COSTING
2	2022.08.18	ISSUED FOR SPA
3	2022.09.22	ISSUED FOR OWNERS REVIEW - 98% SET
4	2022.12.16	ISSUED FOR 2nd SPA SUBMISSION
5	2023.01.31	ISSUED FOR TENDER
6	2023.02.22	ISSUED FOR ADDENDUM 9
7	2023.08.23	ISSUED FOR CONVENIENCE
8	2023.11.20	ISSUED FOR PERMIT COMMENTS
9	2024.01.24	ISSUED FOR SI#03
10	2024.02.15	ISSUED FOR PCN#008
11	2024.03.04	ISSUED FOR PCN#009
12	2024.03.10	ISSUED FOR SI#004
13	2024.05.14	ISSUED FOR SI#006
14	2024.07.22	ISSUED FOR SI#008
15	2024.08.07	ISSUED FOR SI#009
16	2024.10.02	ISSUED FOR PCN#15
17	2025.04.11	ISSUED FOR PCN#019
18	2025.05.01	ISSUED FOR CO#07
19	2025.05.28	ISSUED FOR PCN#20 - CO#010
20	2025.07.31	ISSUED FOR SI#013
21	2025.08.06	ISSUED FOR SI#014
22	2025.08.15	ISSUED FOR PCN#25 - CO#017
23	2025.08.25	ISSUED FOR PCN#27 - CO#021
24	2025.09.02	ISSUED FOR PCN#29
25	2025.09.02	ISSUED FOR SI#20 - CO#018
26	2025.09.08	ISSUED FOR PCN#31
27	2025.09.09	ISSUED FOR PCN#32 - CO#022
28	2025.09.10	ISSUED FOR PCN#33
29	2025.09.11	ISSUED FOR SI#022
30	2025.09.15	ISSUED FOR SI#023
31	2025.09.16	ISSUED FOR PCN #35 - CO#023
32	2025.09.30	ISSUED FOR PCN #37 - CO#029
33	2025.09.30	ISSUED FOR PCN #38 - CO#025
34	2025.10.06	ISSUED FOR PCN #39 - CO#024
35	2025.10.20	ISSUED FOR PCN #40R1
36	2025.10.30	ISSUED FOR PCN#041
37	2025.10.23	ISSUED FOR PCN #42
38	2025.11.21	ISSUED FOR PCN#021/R1 - CO12 CD#006
39	2025.11.14	ISSUED FOR PCN#043
40	2025.11.26	ISSUED FOR PCN#043R1
41	2025.12.03	ISSUED FOR PCN#044 - CO#026
42	2026.02.04	ISSUED FOR RECORD SET UP TO CO#27

NOTES:

KEY PLAN:

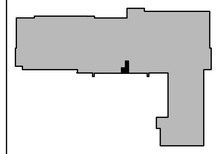

All dimensions and measurements must be checked and verified by the General Contractor

Reproduction of drawings and related documents in whole or in part is forbidden without written permission of the Ventin Group.

Near North District School Board

CLIENT:
NEAR NORTH DISTRICT SCHOOL BOARD
NNDSB Tender # 2023-015

PROJECT:
NEW PARRY SOUND K-12 SCHOOL & CHILDCARE

PARRY SOUND HIGH SCHOOL SITE

111 ISABELLA STREET
PARRY SOUND, ONTARIO

ORIGINAL PAGE SIZE ARCH E1 - 30" x 42"

KEY TO DETAIL LOCATION:
A - DETAIL NO.
B - DETAIL NO. ORIGIN

+VG ARCHITECTS
THE VENTIN GROUP LTD


Filename: K:\VG-Brantford\Near North DSB Parry Sound School\2211\Drawings\Wrk-Current\ NN-A5.1.dwg

Plot Date: Feb 03, 2026 - 5:50pm By Jkelly


STAIR 1 - PLANS & SECTIONS

A5.1


DRAWN BY : KH CHECKED BY : PS

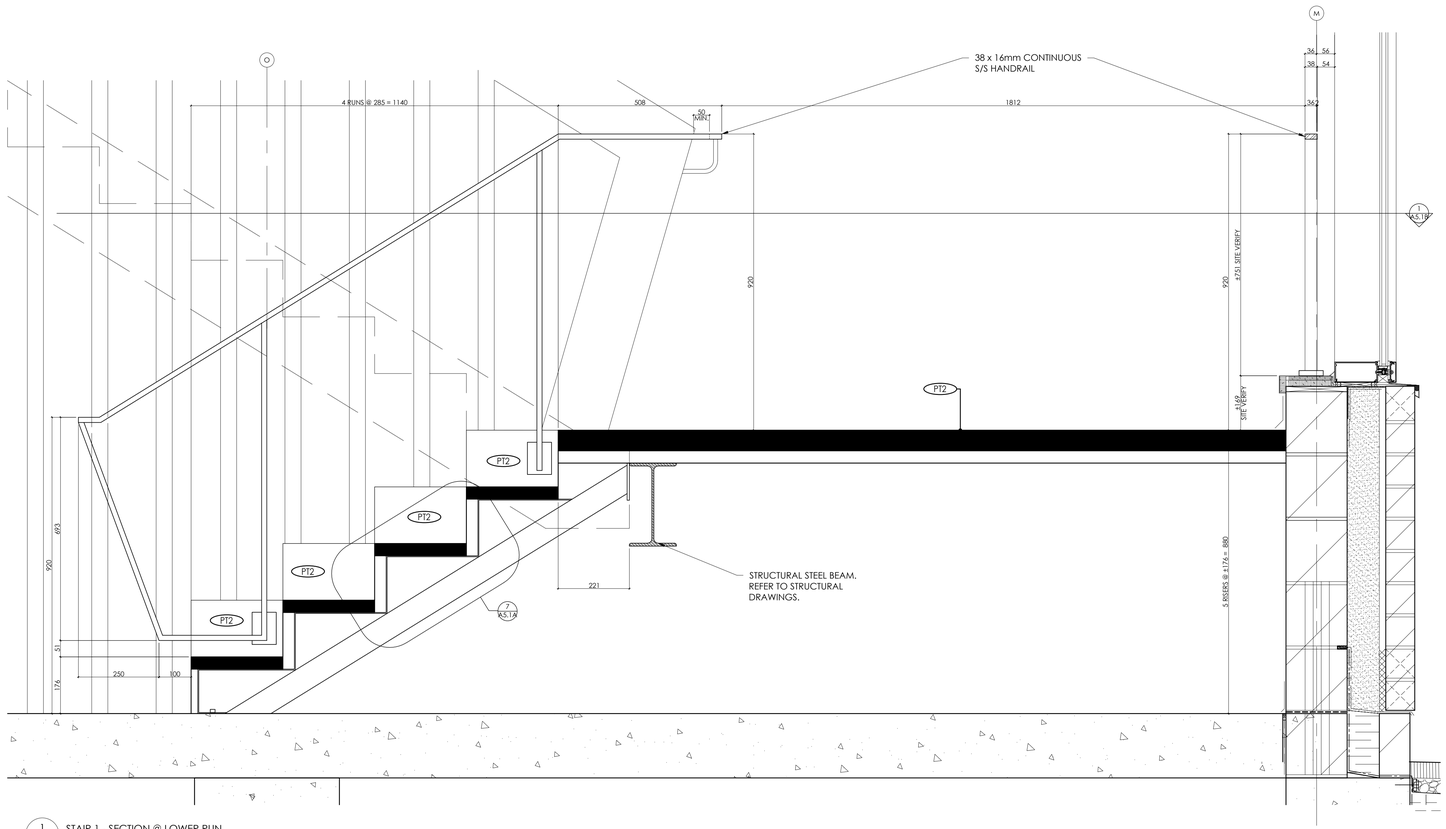


1 A5.1A STAIR 1 - SECTION @ LOWER RUN
0 75 150 375mm

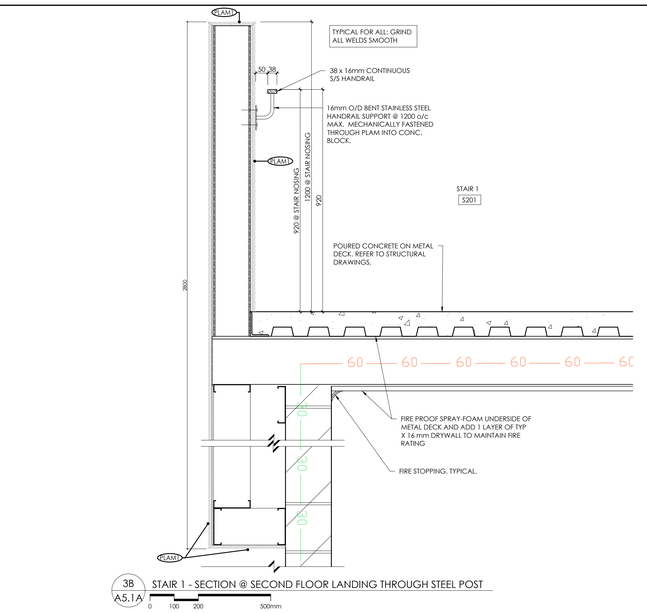


3B A5.1A STAIR 1 - SECTION @ SECOND FLOOR LANDING THROUGH STEEL POST
0 100 200 500mm

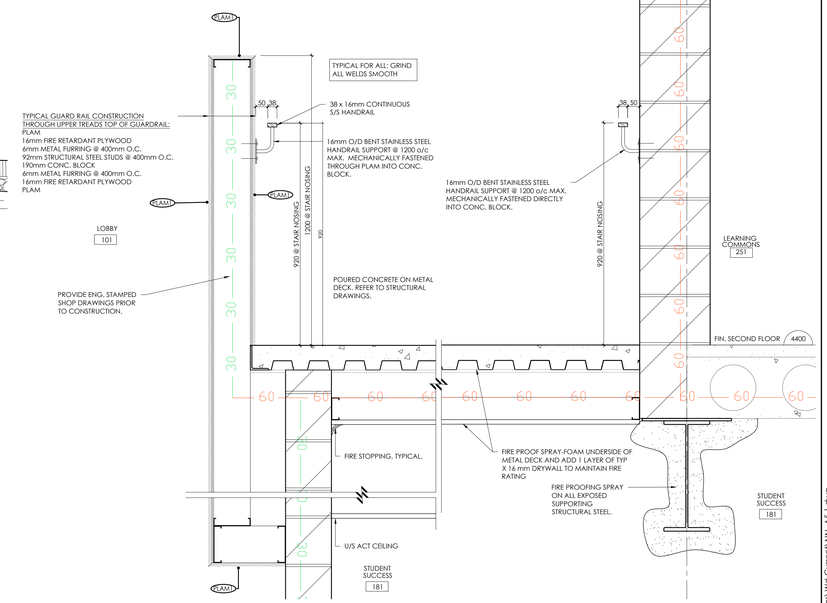


3A A5.1A STAIR 1 - SECTION @ SECOND FLOOR LANDING THROUGH STEEL STUD INFILL
0 100 200 500mm

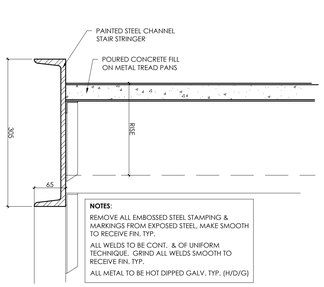


4 A5.1A TYP. CONC. FILLED METAL PAN DETAIL SECTION
0 10 20 50mm

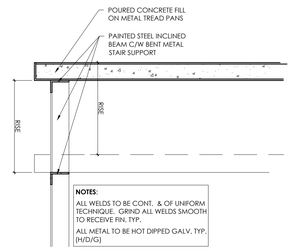


5 A5.1A TYP. CONC. FILLED METAL PAN DETAIL SECTION
0 10 20 50mm

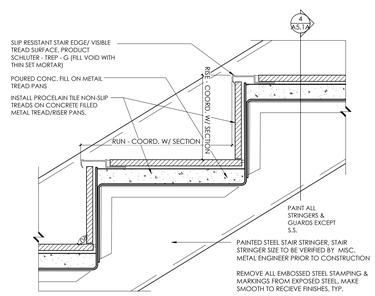

6 A5.1A TYP. CONC. FILLED METAL PAN W/ TILE TREAD & RISER SECTION
0 10 20 50mm

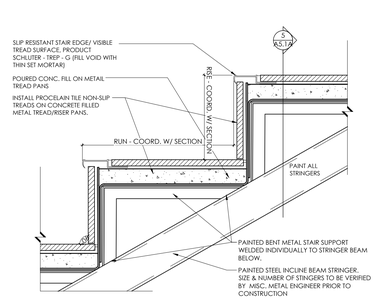

7 A5.1A TYP. CONC. FILLED METAL PAN W/ TILE TREAD & RISER SECTION
0 10 20 50mm

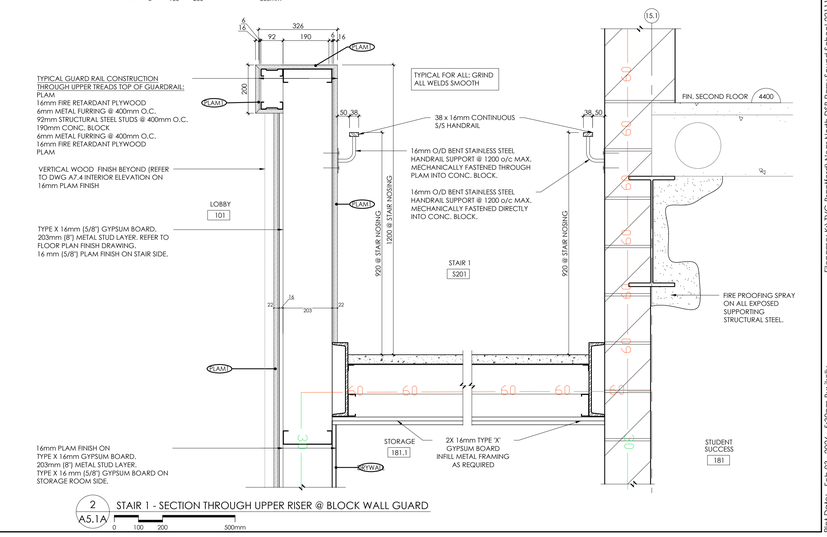


2 A5.1A STAIR 1 - SECTION THROUGH UPPER RISER @ BLOCK WALL GUARD
0 100 200 500mm

REVISIONS

NO.	DATE	PARTICULAR
1	2022.06.06	ISSUED FOR 80% CLASS B COSTING
2	2022.08.18	ISSUED FOR SPA
3	**2022.09.22**	**ISSUED FOR OWNERS REVIEW - 90% SET**
4	2022.12.16	ISSUED FOR 2nd SPA SUBMISSION
5	**2023.01.31**	**ISSUED FOR TENDER**
6	2023.02.22	ISSUED FOR ADDENDUM 9
7	2023.08.23	ISSUED FOR CONVENIENCE
8	2023.11.20	ISSUED FOR PERMIT COMMENTS
9	2024.01.24	ISSUED FOR SI#03
10	2024.02.15	ISSUED FOR PCN#008
11	2024.03.04	ISSUED FOR PCN#009
12	2024.03.10	ISSUED FOR SI#004
13	2024.05.14	ISSUED FOR SI#006
14	2024.07.22	ISSUED FOR SI#008
15	2024.08.07	ISSUED FOR SI#009
16	2024.10.02	ISSUED FOR PCN#15
17	2025.04.11	ISSUED FOR PCN#019
18	2025.05.01	ISSUED FOR CO#07
19	2025.05.28	ISSUED FOR PCN#20 - CO#010
20	2025.07.31	ISSUED FOR SI#013
21	2025.08.06	ISSUED FOR SI#014
22	2025.08.15	ISSUED FOR PCN#25 - CO#017
23	2025.08.25	ISSUED FOR PCN#27 - CO#021
24	2025.09.02	ISSUED FOR PCN#29
25	2025.09.02	ISSUED FOR SI#20 - CO#018
26	2025.09.08	ISSUED FOR PCN#31
27	2025.09.09	ISSUED FOR PCN#32 - CO#022
28	2025.09.10	ISSUED FOR PCN#33
29	2025.09.11	ISSUED FOR SI#022
30	2025.09.15	ISSUED FOR SI#023
31	2025.09.16	ISSUED FOR PCN #35 - CO#023
32	2025.09.30	ISSUED FOR PCN #37 - CO#029
33	2025.09.30	ISSUED FOR PCN #38 - CO#025
34	2025.10.06	ISSUED FOR PCN #39 - CO#024
35	2025.10.20	ISSUED FOR PCN #40R1
36	2025.10.30	ISSUED FOR PCN#041
37	2025.10.23	ISSUED FOR PCN #42
38	2025.11.21	ISSUED FOR PCN#021/R1 - CO12 CD#006
39	2025.11.14	ISSUED FOR PCN#043
40	2025.11.26	ISSUED FOR PCN#043R1
41	2025.12.03	ISSUED FOR PCN#044 - CO#026
42	2026.02.04	ISSUED FOR RECORD SET UP TO CO#27

NOTES:

KEY PLAN:

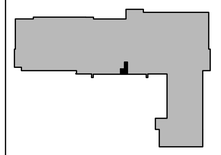

All dimensions and measurements must be checked and verified by the General Contractor

Reproduction of drawings and related documents in whole or in part is forbidden without written permission of the VenTin Group.

Near North District School Board

CLIENT:
NEAR NORTH DISTRICT SCHOOL BOARD
NNDSB Tender # 2023-015

PROJECT:
NEW PARRY SOUND K-12 SCHOOL & CHILDCARE

PARRY SOUND HIGH SCHOOL SITE

111 ISABELLA STREET
PARRY SOUND, ONTARIO

ORIGINAL PAGE SIZE ARCH E1 - 30" x 42"
KEY TO DETAIL LOCATION:
1/A5.1A A - DETAIL NO.
B - DETAIL NO. ORIGIN


+VG ARCHITECTS
THE VENTIN GROUP LTD

STAIR 1 - SECTIONS & DETAILS

A5.1A

DRAWN BY : KH CHECKED BY : PS

Plot Date: Feb 03, 2026 - 5:30pm By: jkelly
Filename: c:\VG-Brantford\Near North DSB Parry Sound School\2111 Orrwelegh Wd-Current\NN-A5.1.dwg

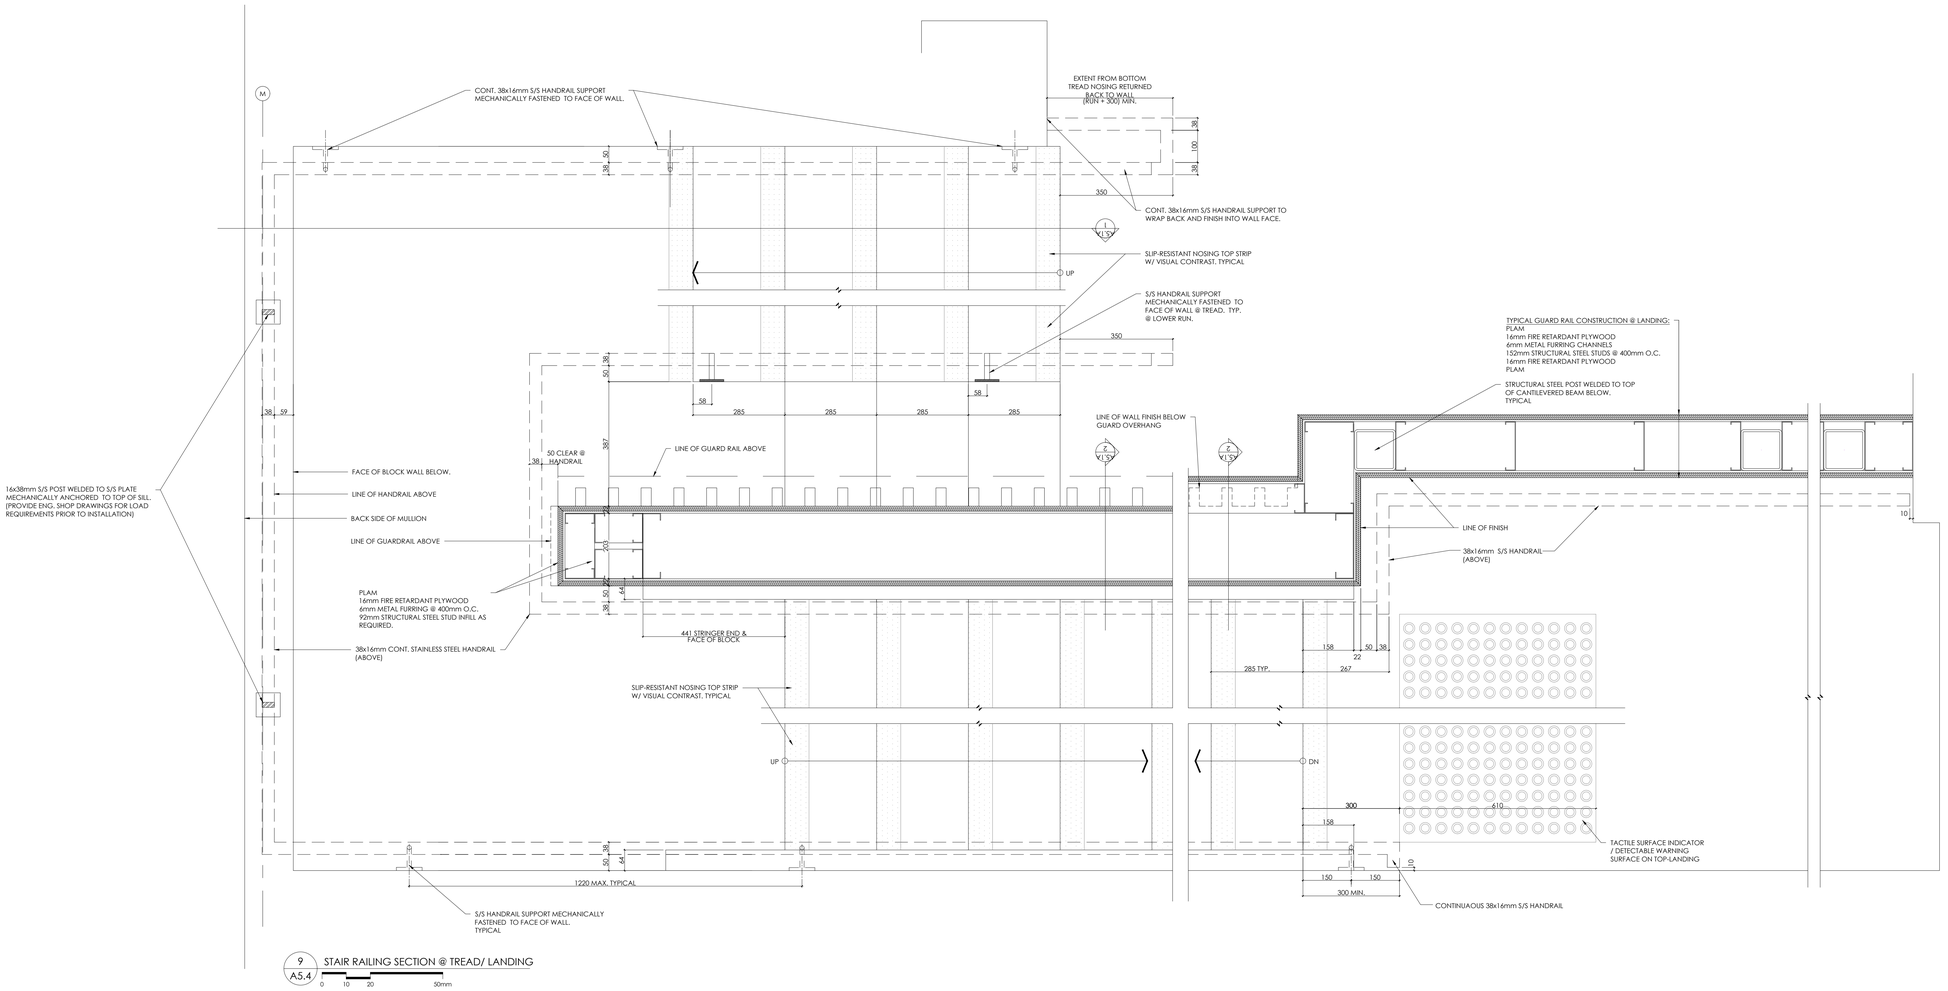

9 A5.4 STAIR RAILING SECTION @ TREAD/ LANDING


0 10 20 50mm

REVISIONS

NO.	DATE	PARTICULAR
1	2022.06.06	ISSUED FOR 80% CLASS B COSTING
2	2022.08.18	ISSUED FOR SPA
3	**2022.09.22**	**ISSUED FOR OWNERS REVIEW - 98% SET**
4	2022.12.16	ISSUED FOR 2nd SPA SUBMISSION
5	**2023.01.31**	**ISSUED FOR TENDER**
6	2023.02.22	ISSUED FOR ADDENDUM 9
7	2023.08.23	ISSUED FOR CONVENIENCE
8	2023.11.20	ISSUED FOR PERMIT COMMENTS
9	2024.01.24	ISSUED FOR SI#03
10	2024.02.15	ISSUED FOR PCN#008
11	2024.03.04	ISSUED FOR PCN#009
12	2024.03.10	ISSUED FOR SI#004
13	2024.05.14	ISSUED FOR SI#006
14	2024.07.22	ISSUED FOR SI#008
15	2024.08.07	ISSUED FOR SI#009
16	2024.10.02	ISSUED FOR PCN#15
17	2025.04.11	ISSUED FOR PCN#019
18	2025.05.01	ISSUED FOR CO#07
19	2025.05.28	ISSUED FOR PCN#20 - CO#010
20	2025.07.31	ISSUED FOR SI#013
21	2025.08.06	ISSUED FOR SI#014
22	2025.08.15	ISSUED FOR PCN#25 - CO#017
23	2025.08.25	ISSUED FOR PCN#27 - CO#021
24	2025.09.02	ISSUED FOR PCN#29
25	2025.09.02	ISSUED FOR SI#20 - CO#018
26	2025.09.08	ISSUED FOR PCN#31
27	2025.09.09	ISSUED FOR PCN#32 - CO#022
28	2025.09.10	ISSUED FOR PCN#33
29	2025.09.11	ISSUED FOR SI#022
30	2025.09.15	ISSUED FOR SI#023
31	2025.09.16	ISSUED FOR PCN #35 - CO#023
32	2025.09.30	ISSUED FOR PCN #37 - CO#029
33	2025.09.30	ISSUED FOR PCN #38 - CO#025
34	2025.10.06	ISSUED FOR PCN #39 - CO#024
35	2025.10.20	ISSUED FOR PCN #40#1
36	2025.10.30	ISSUED FOR PCN#041
37	2025.10.23	ISSUED FOR PCN #42
38	2025.11.21	ISSUED FOR PCN#021/R1 - CO12 CD#006
39	2025.11.14	ISSUED FOR PCN#043
40	2025.11.26	ISSUED FOR PCN#043R1
41	2025.12.03	ISSUED FOR PCN#044 - CO#026
42	2026.02.04	ISSUED FOR RECORD SET UP TO CO#27

NOTES:

KEY PLAN:

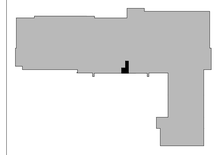

All dimensions and measurements must be checked and verified by the General Contractor

Reproduction of drawings and related documents in whole or in part is forbidden without written permission of the Ventin Group.

Near North District School Board

CLIENT:
NEAR NORTH DISTRICT SCHOOL BOARD
NNDSB Tender # 2023-015

PROJECT:
NEW PARRY SOUND K-12 SCHOOL & CHILDCARE

PARRY SOUND HIGH SCHOOL SITE

111 ISABELLA STREET
PARRY SOUND, ONTARIO

ORIGINAL PAGE SIZE ARCH E1 - 30" x 42"

KEY TO DETAIL LOCATION:
A - DETAIL NO.
B - DETAIL NO. ORIGIN


+VG ARCHITECTS
THE VENTIN GROUP LTD

STAIR 1 - STRINGER & HANDRAIL PLAN DETAIL

A5.1B


DRAWN BY : KH CHECKED BY : PS

Plot Date: Feb 03, 2026 - 5:50pm By: jkelly
Filename: K:\1VG-Brantford\Near North DSB Parry Sound School\2211\Drawings\Wed-Current\NN-A5.1.dwg

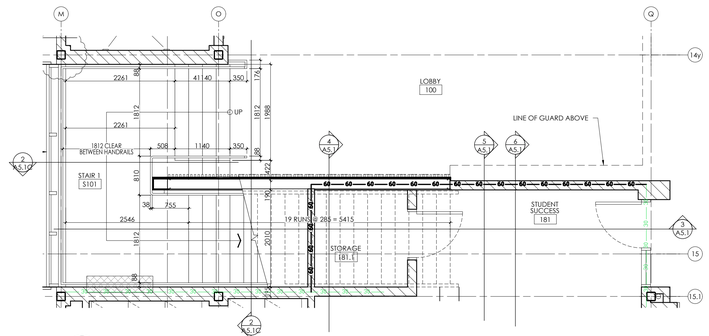

1 A5.1 STAIR 1 - FIRST FLOOR PLAN
0 500 1000 2500mm

*REFER TO PLAN DETAIL 1/A5.1B FOR FURTHER DETAIL INFORMATION.

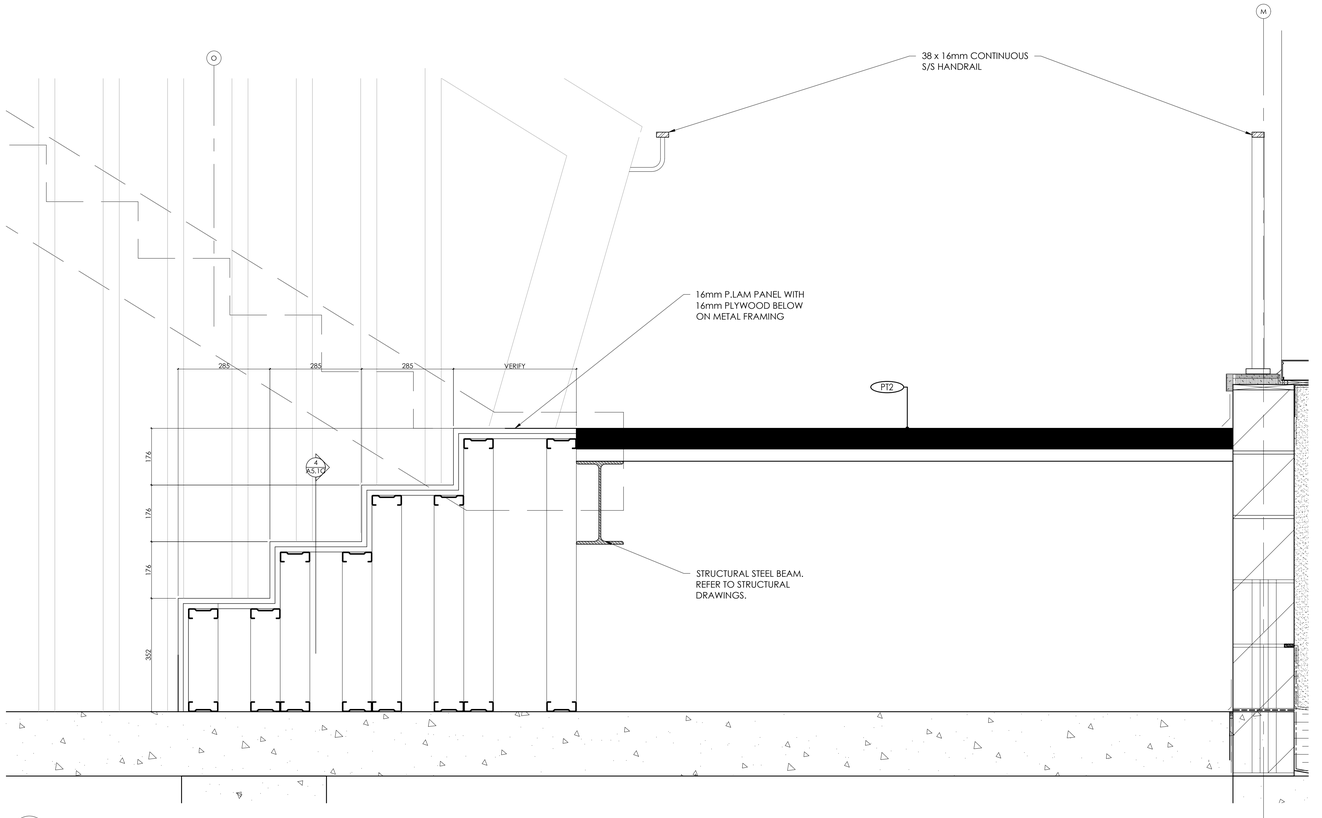

2 A5.1C STAIR 1 - SECTION @ LOWER RUN
0 75 150 375mm

3 A5.1C SECTION - STAIR #1 @ SECOND FLOOR LANDING THROUGH STUD WALL
0 300 600 1500mm


4 A5.1C STAIR 1 - SECTION @ LOWER RUN
0 75 150 375mm

REVISIONS

NO.	DATE	PARTICULAR
1	2022.06.06	ISSUED FOR 80% CLASS B COSTING
2	2022.08.18	ISSUED FOR SPA
3	2022.09.22	ISSUED FOR OWNERS REVIEW - 98% SET
4	2022.12.16	ISSUED FOR 2nd SPA SUBMISSION
5	2023.01.31	ISSUED FOR TENDER
6	2023.02.22	ISSUED FOR ADDENDUM 9
7	2023.08.23	ISSUED FOR CONVENIENCE
8	2023.11.20	ISSUED FOR PERMIT COMMENTS
9	2024.01.24	ISSUED FOR SI#03
10	2024.02.15	ISSUED FOR PCN#008
11	2024.03.04	ISSUED FOR PCN#009
12	2024.03.10	ISSUED FOR SI#004
13	2024.05.14	ISSUED FOR SI#006
14	2024.07.22	ISSUED FOR SI#008
15	2024.08.07	ISSUED FOR SI#009
16	2024.10.02	ISSUED FOR PCN#15
17	2025.04.11	ISSUED FOR PCN#019
18	2025.05.01	ISSUED FOR CO#07
19	2025.05.28	ISSUED FOR PCN#20 - CO#010
20	2025.07.31	ISSUED FOR SI#013
21	2025.08.06	ISSUED FOR SI#014
22	2025.08.15	ISSUED FOR PCN#25 - CO#017
23	2025.08.25	ISSUED FOR PCN#27 - CO#021
24	2025.09.02	ISSUED FOR PCN#29
25	2025.09.02	ISSUED FOR SI#20 - CO#018
26	2025.09.08	ISSUED FOR PCN#31
27	2025.09.09	ISSUED FOR PCN#32 - CO#022
28	2025.09.10	ISSUED FOR PCN#33
29	2025.09.11	ISSUED FOR SI#022
30	2025.09.15	ISSUED FOR SI#023
31	2025.09.16	ISSUED FOR PCN #35 - CO#023
32	2025.09.30	ISSUED FOR PCN #37 - CO#019
33	2025.09.30	ISSUED FOR PCN #38 - CO#025
34	2025.10.06	ISSUED FOR PCN #39 - CO#024
35	2025.10.20	ISSUED FOR PCN #40R1
36	2025.10.30	ISSUED FOR PCN#041
37	2025.10.23	ISSUED FOR PCN #42
38	2025.11.21	ISSUED FOR PCN#021/R1 - CO12 CD#006
39	2025.11.14	ISSUED FOR PCN#043
40	2025.11.26	ISSUED FOR PCN#043R1
41	2025.12.03	ISSUED FOR PCN#044 - CO#026
42	2026.02.04	ISSUED FOR RECORD SET UP TO CO#27

NOTES:

KEY PLAN:

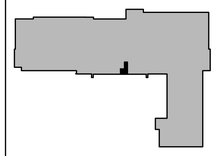

All dimensions and measurements must be checked and verified by the General Contractor

Reproduction of drawings and related documents in whole or in part is forbidden without written permission of the Ventin Group.

Near North District School Board

CLIENT:
NEAR NORTH DISTRICT SCHOOL BOARD
NNDSB Tender # 2023-015

PROJECT:
NEW PARRY SOUND K-12 SCHOOL & CHILDCARE

PARRY SOUND HIGH SCHOOL SITE

111 ISABELLA STREET
PARRY SOUND, ONTARIO

ORIGINAL PAGE SIZE ARCH E1 - 30" x 42"
KEY TO DETAIL LOCATION:
A - DETAIL NO.
B - DETAIL NO. ORIGIN


+VG ARCHITECTS
THE VENTIN GROUP LTD


STAIR 1 - PLANS & SECTIONS

A5.1C

DRAWN BY : KH CHECKED BY : PS

Plot Date: Feb 03, 2026 - 5:30pm By Jeely
Filename: K:\VG-Brantford\Near North DSB Parry Sound School 2021\Drawings\Wd-Current\NN-A5.1.dwg

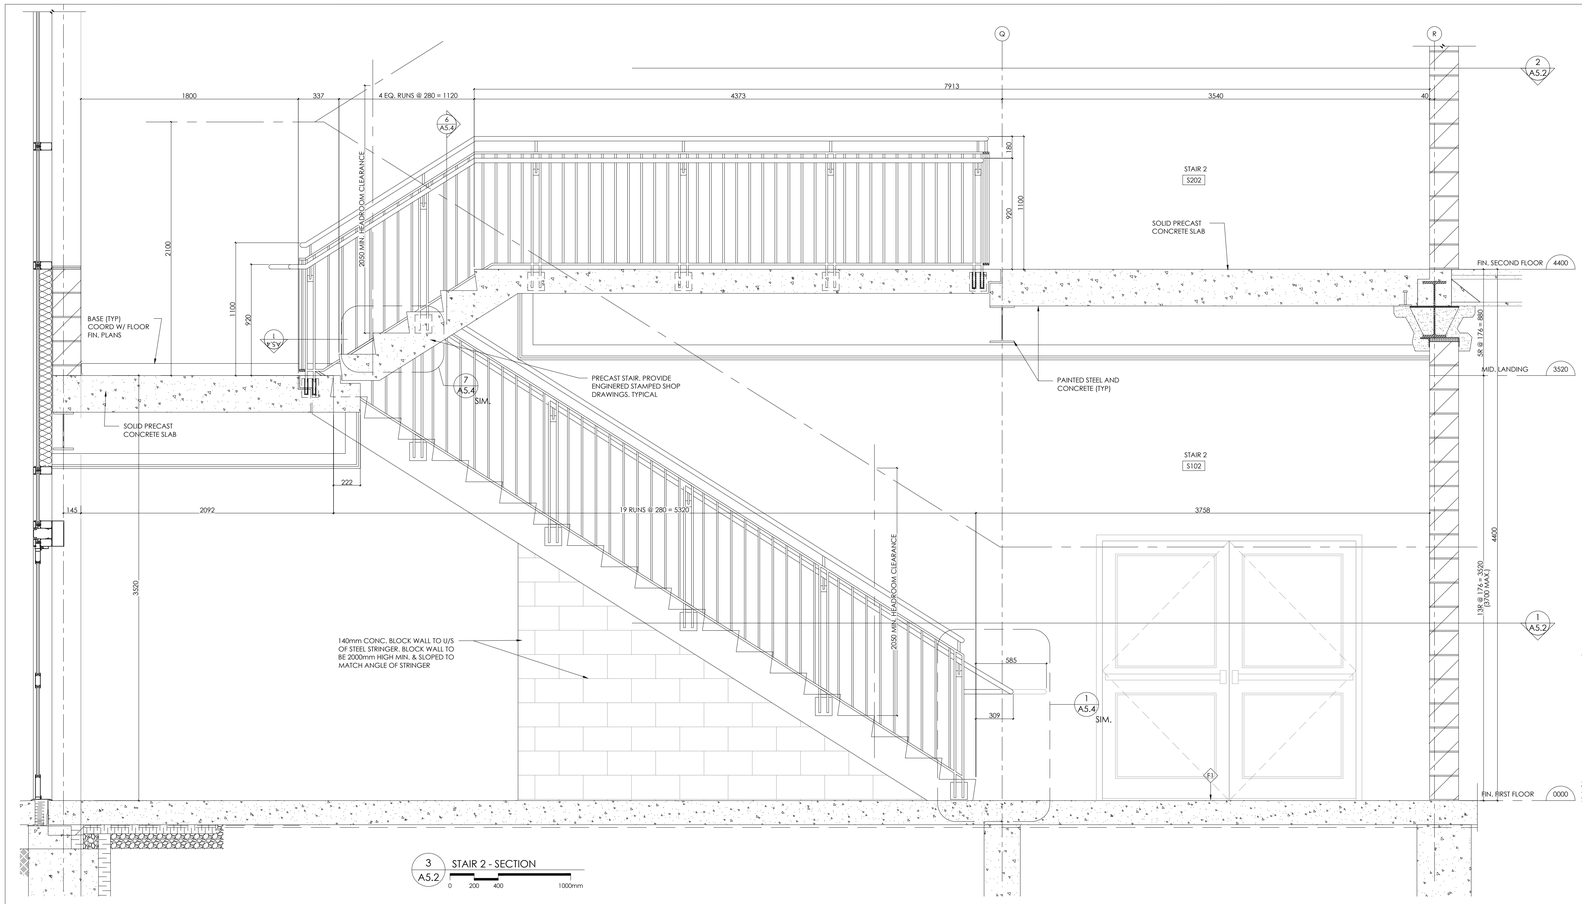

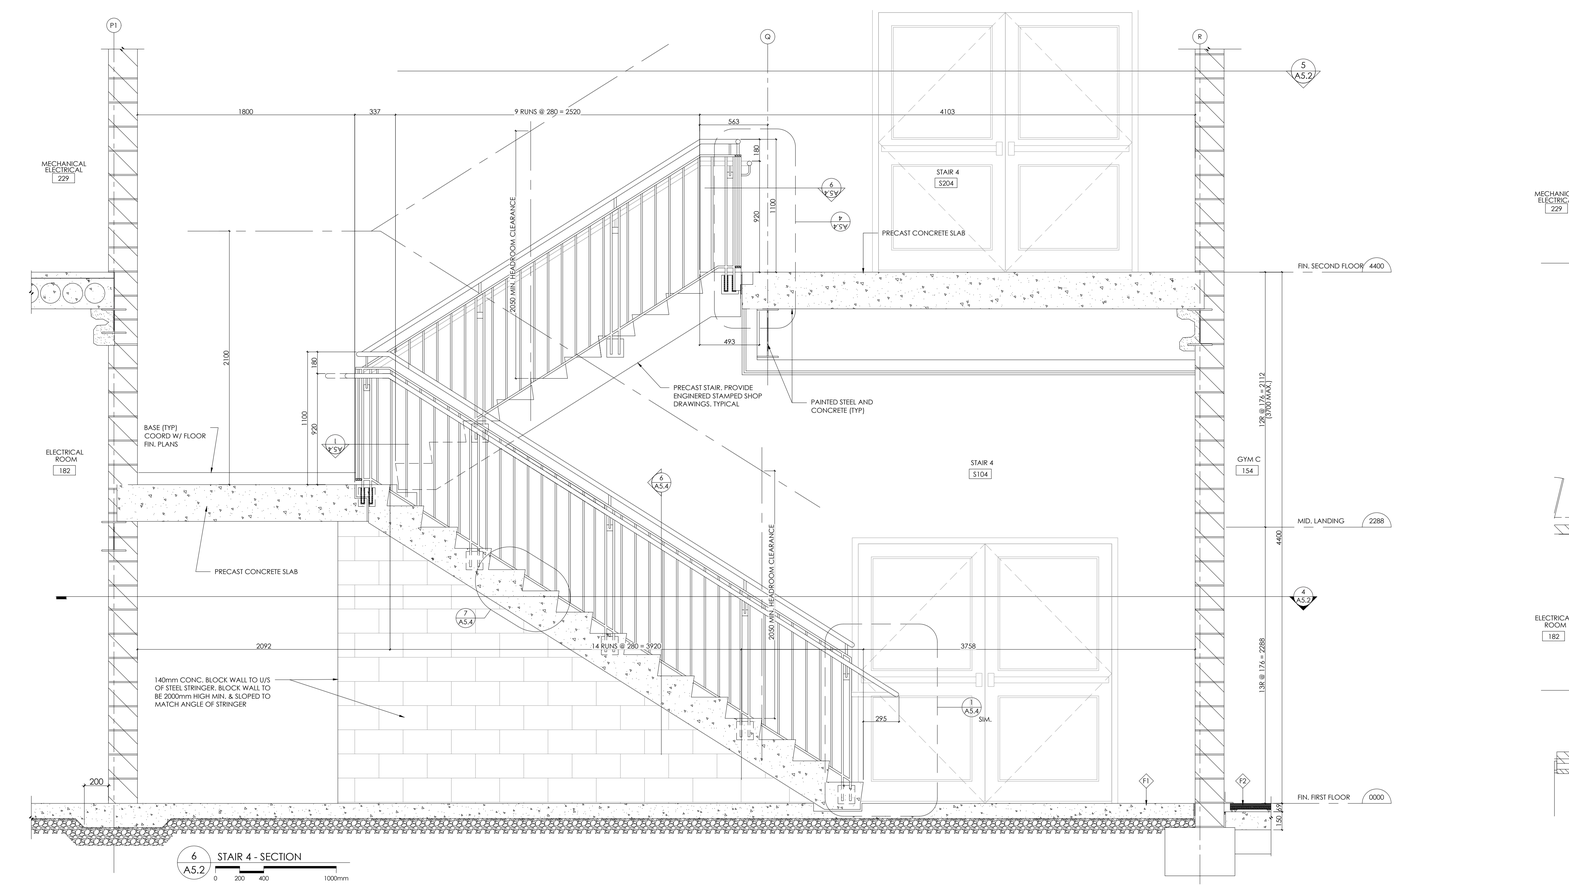


REVISIONS

NO.	DATE	PARTICULAR
1	2022.06.06	ISSUED FOR 80% CLASS B COSTING
2	2022.08.18	ISSUED FOR SPA
3	2022.09.22	ISSUED FOR OWNERS REVIEW - 98% SET
4	2022.12.16	ISSUED FOR 2nd SPA SUBMISSION
5	2023.01.31	ISSUED FOR TENDER
6	2023.02.22	ISSUED FOR ADDENDUM 9
7	2023.08.23	ISSUED FOR CONVENIENCE
8	2023.11.20	ISSUED FOR PERMIT COMMENTS
9	2024.01.24	ISSUED FOR SI#03
10	2024.02.15	ISSUED FOR PCN#008
11	2024.03.04	ISSUED FOR PCN#009
12	2024.03.10	ISSUED FOR SI#004
13	2024.05.14	ISSUED FOR SI#006
14	2024.07.22	ISSUED FOR SI#008
15	2024.08.07	ISSUED FOR SI#009
16	2024.10.02	ISSUED FOR PCN#15
17	2025.04.11	ISSUED FOR PCN#019
18	2025.05.01	ISSUED FOR CO#07
19	2025.05.28	ISSUED FOR PCN#20 - CO#010
20	2025.07.31	ISSUED FOR SI#013
21	2025.08.06	ISSUED FOR SI#014
22	2025.08.15	ISSUED FOR PCN#25 - CO#017
23	2025.08.25	ISSUED FOR PCN#27 - CO#021
24	2025.09.02	ISSUED FOR PCN#29
25	2025.09.02	ISSUED FOR SI#20 - CO#018
26	2025.09.08	ISSUED FOR PCN#31
27	2025.09.09	ISSUED FOR PCN#32 - CO#022
28	2025.09.10	ISSUED FOR PCN#33
29	2025.09.11	ISSUED FOR SI#022
30	2025.09.15	ISSUED FOR SI#023
31	2025.09.16	ISSUED FOR PCN #35 - CO#023
32	2025.09.30	ISSUED FOR PCN #37 - CO#029
33	2025.09.30	ISSUED FOR PCN #38 - CO#025
34	2025.10.06	ISSUED FOR PCN #39 - CO#024
35	2025.10.20	ISSUED FOR PCN #4081
36	2025.10.30	ISSUED FOR PCN#041
37	2025.10.23	ISSUED FOR PCN #42
38	2025.11.21	ISSUED FOR PCN#021/R1 - CO12 CD#006
39	2025.11.14	ISSUED FOR PCN#043
40	2025.11.26	ISSUED FOR PCN#043R1
41	2025.12.03	ISSUED FOR PCN#044 - CO#026
42	2026.02.04	ISSUED FOR RECORD SET UP TO CO#27

NOTES:

KEY PLAN:

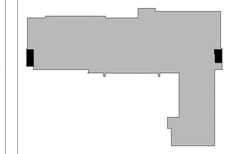

Reproduction of drawings and related documents in whole or in part is forbidden without written permission of The Ventin Group.

All dimensions and measurements must be checked and verified by the General Contractor

Near North District School Board

CLIENT:
NEAR NORTH DISTRICT SCHOOL BOARD
NNDSB Tender # 2023-015

PROJECT:
NEW PARRY SOUND K-12 SCHOOL & CHILDCARE

PARRY SOUND HIGH SCHOOL SITE

111 ISABELLA STREET
PARRY SOUND, ONTARIO


ORIGINAL PAGE SIZE ARCH E1 - 30" x 42"
KEY TO DETAIL LOCATION:
(A) A - DETAIL NO.
(B) B - DETAIL NO. ORIGIN

+VG ARCHITECTS
THE VENTIN GROUP LTD


STAIRS 2 & 4 - PLANS & SECTIONS

A5.2


Plot Date: Feb 03, 2026 - 5:31pm By: jkelly
Filename: K:\1VG-Brantford\Near North DSB Parry Sound School\2211\Drawings\Wd-Current\NN-A5.1.dwg
DRAWN BY : KH
CHECKED BY : PS

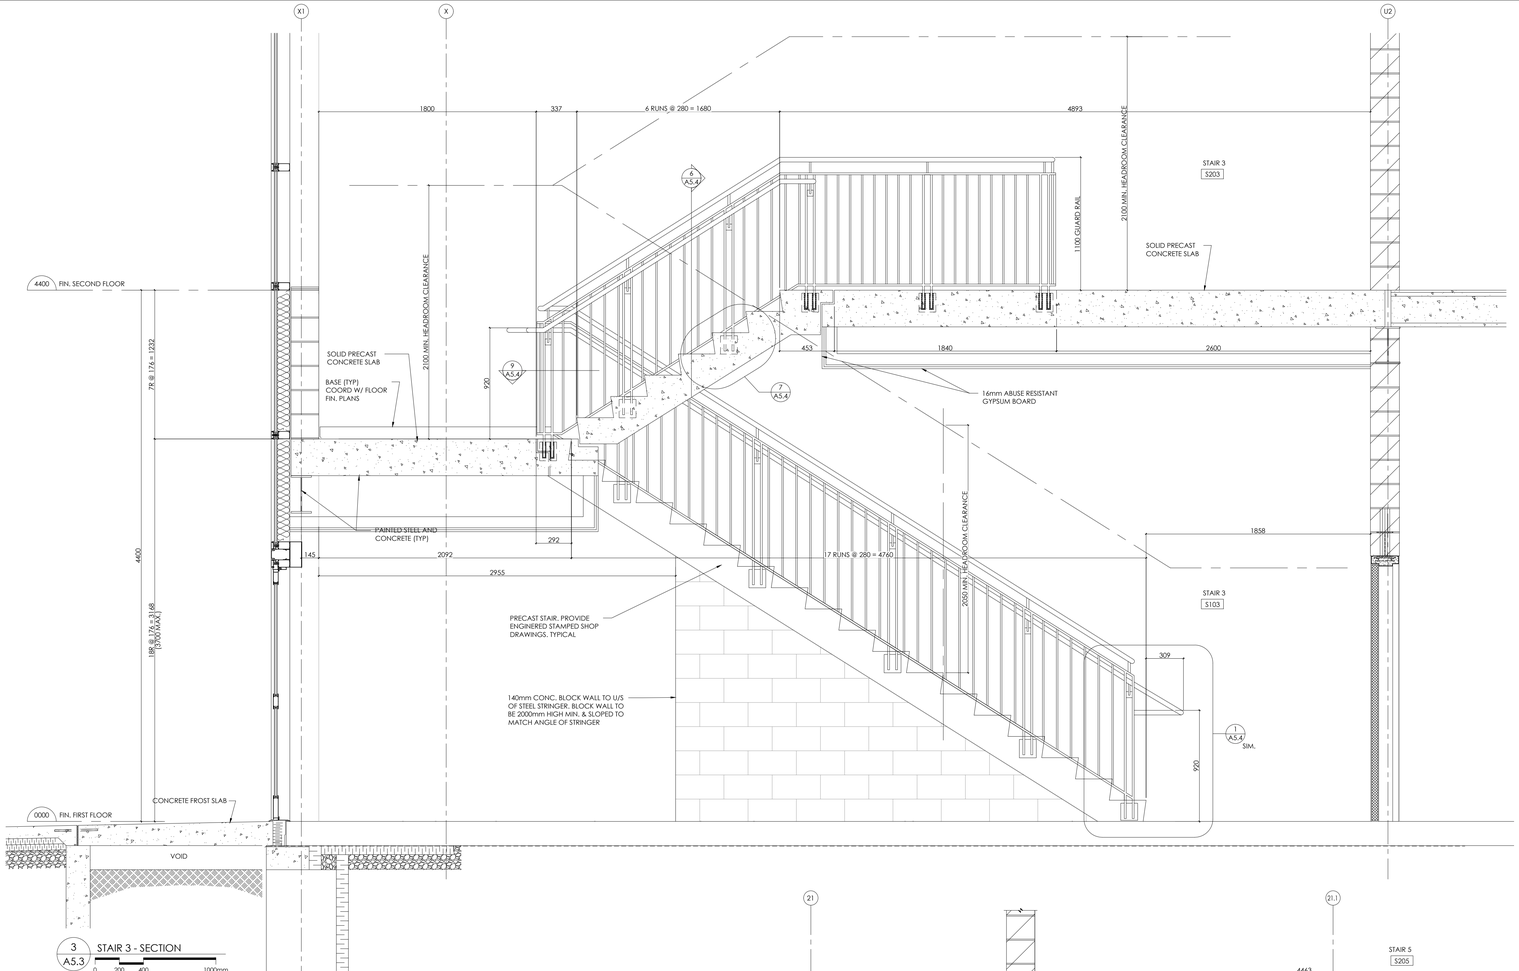


3 A5.3 STAIR 3 - SECTION
0 200 400 1000mm

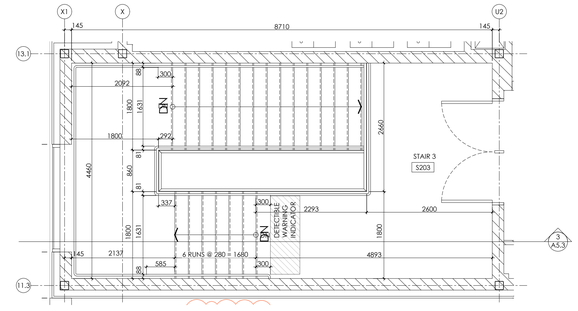


2 A5.3 STAIR 3 - SECOND FLOOR PLAN
0 500 1000 2500mm

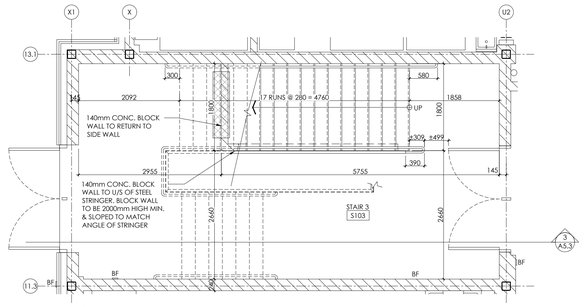


1 A5.3 STAIR 3 - FIRST FLOOR PLAN
0 500 1000 2500mm

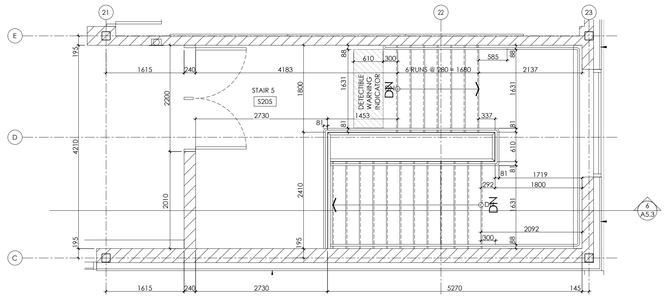

5 A5.3 STAIR 5 - SECOND FLOOR PLAN
0 10 20 50mm

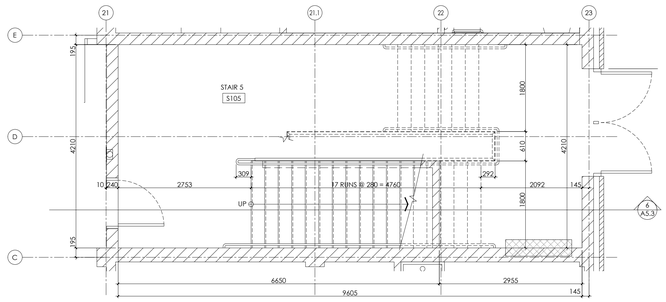

4 A5.3 STAIR 5 - FIRST FLOOR PLAN
0 10 20 50mm

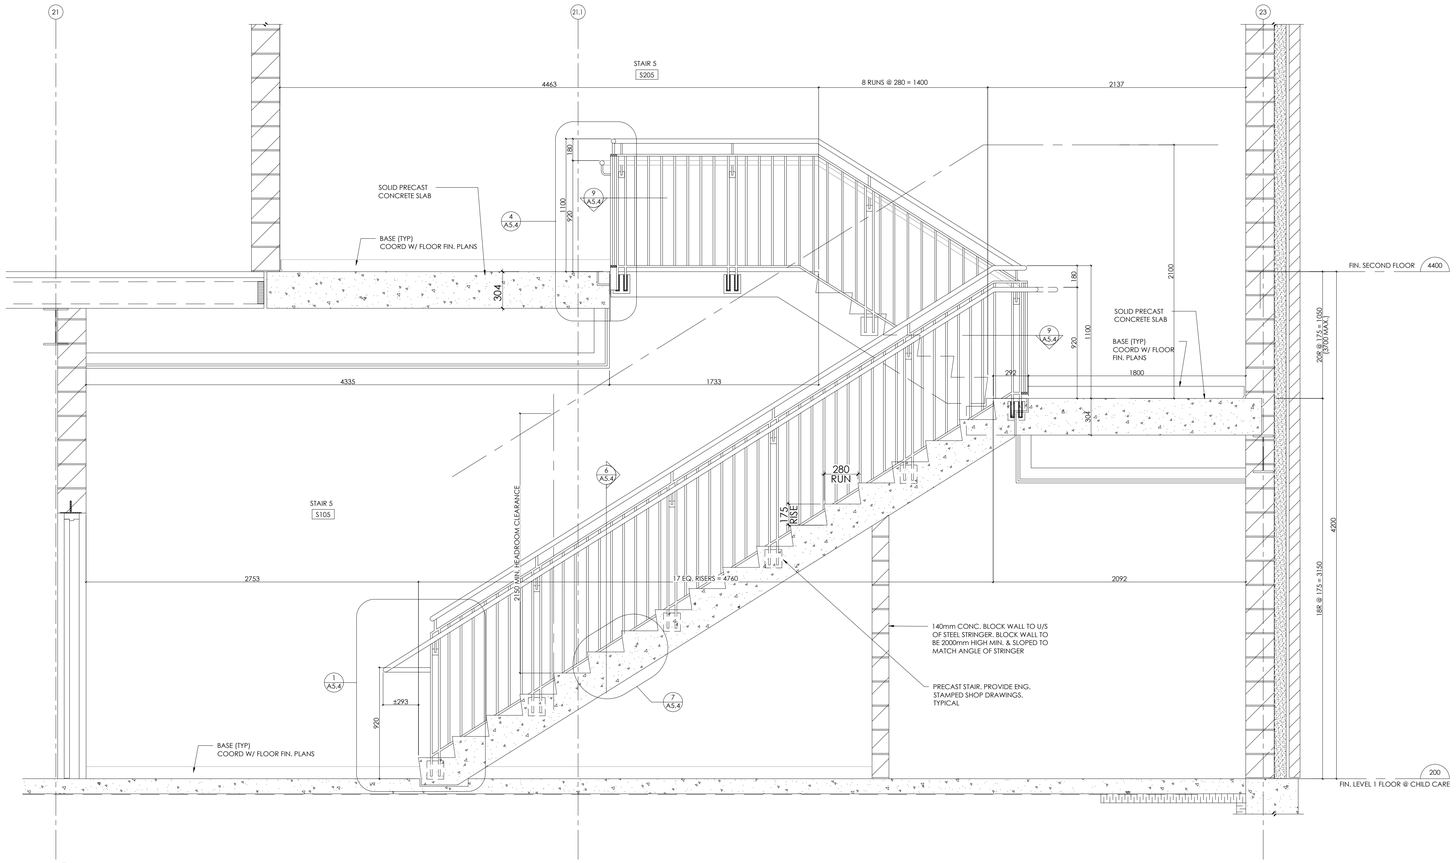


6 A5.3 STAIR 5 - SECTION
0 10 20 50mm

REVISIONS

NO.	DATE	PARTICULAR
1	2022.06.06	ISSUED FOR 80% CLASS B COSTING
2	2022.08.18	ISSUED FOR SPA
3	2022.09.22	ISSUED FOR OWNERS REVIEW - 98% SET
4	2022.12.16	ISSUED FOR 2nd SPA SUBMISSION
5	2023.01.31	ISSUED FOR TENDER
6	2023.02.22	ISSUED FOR ADDENDUM 9
7	2023.08.23	ISSUED FOR CONVENIENCE
8	2023.11.20	ISSUED FOR PERMIT COMMENTS
9	2024.01.24	ISSUED FOR SI#03
10	2024.02.15	ISSUED FOR PCN#008
11	2024.03.04	ISSUED FOR PCN#009
12	2024.03.10	ISSUED FOR SI#004
13	2024.05.14	ISSUED FOR SI#006
14	2024.07.22	ISSUED FOR SI#008
15	2024.08.07	ISSUED FOR SI#009
16	2024.10.02	ISSUED FOR PCN#15
17	2025.04.11	ISSUED FOR PCN#019
18	2025.05.01	ISSUED FOR CO#07
19	2025.05.28	ISSUED FOR PCN#20 - CO#010
20	2025.07.31	ISSUED FOR SI#013
21	2025.08.06	ISSUED FOR SI#014
22	2025.08.15	ISSUED FOR PCN#25 - CO#017
23	2025.08.25	ISSUED FOR PCN#27 - CO#021
24	2025.09.02	ISSUED FOR PCN#29
25	2025.09.02	ISSUED FOR SI#20 - CO#018
26	2025.09.08	ISSUED FOR PCN#31
27	2025.09.09	ISSUED FOR PCN#32 - CO#022
28	2025.09.10	ISSUED FOR PCN#33
29	2025.09.11	ISSUED FOR SI#022
30	2025.09.15	ISSUED FOR SI#023
31	2025.09.16	ISSUED FOR PCN #35 - CO#023
32	2025.09.30	ISSUED FOR PCN #37 - CO#029
33	2025.09.30	ISSUED FOR PCN #38 - CO#025
34	2025.10.06	ISSUED FOR PCN #39 - CO#024
35	2025.10.20	ISSUED FOR PCN #4081
36	2025.10.30	ISSUED FOR PCN#041
37	2025.10.23	ISSUED FOR PCN #42
38	2025.11.21	ISSUED FOR PCN#021/R1 - CO12 CD#006
39	2025.11.14	ISSUED FOR PCN#043
40	2025.11.26	ISSUED FOR PCN#043R1
41	2025.12.03	ISSUED FOR PCN#044 - CO#026
42	2026.02.04	ISSUED FOR RECORD SET UP TO CO#27

NOTES:

KEY PLAN:

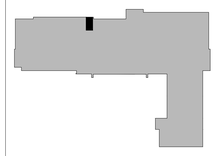

Reproduction of drawings and related documents in whole or in part is forbidden without written permission of the VenTin Group.

All dimensions and measurements must be checked and verified by the General Contractor

Near North District School Board

CLIENT:
NEAR NORTH DISTRICT SCHOOL BOARD
NNDSB Tender # 2023-015

PROJECT:
NEW PARRY SOUND K-12 SCHOOL & CHILDCARE

PARRY SOUND HIGH SCHOOL SITE

111 ISABELLA STREET
PARRY SOUND, ONTARIO

ORIGINAL PAGE SIZE ARCH E1 - 30" x 42"

KEY TO DETAIL LOCATION:
A - A - DETAIL NO.
B - B - DETAIL NO. ORIGIN


+VG ARCHITECTS
THE VENTIN GROUP LTD

STAIR 3 - PLANS & SECTION


A5.3

DRAWN BY : KH CHECKED BY : PS


Plot Date: Feb 03, 2026 - 5:31pm By: jkelly Filename: K:\1VG-Brantford\Near North DSB Parry Sound School-2211\Drawings\Wd-Current\NN-_A5.1.dwg

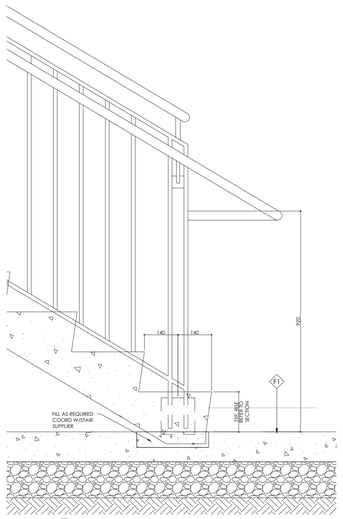


1 A5.4 PRECAST CONC. STAIR TREAD TYPICAL

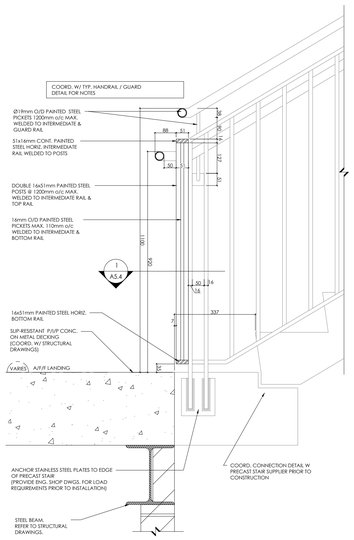


2 A5.4 BETWEEN PRECAST SECTIONS @ SOLID CONC. LANDING SECTION DETAIL

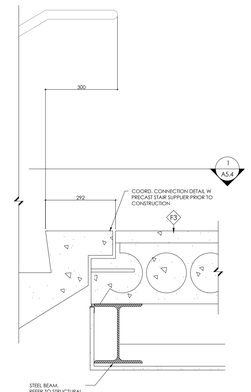


3 A5.4 BETWEEN PRECAST SECTIONS @ TOP HOLLOW CORE SLAB W/ POURED CONC. TOPPING CONT. STAIR DETAIL

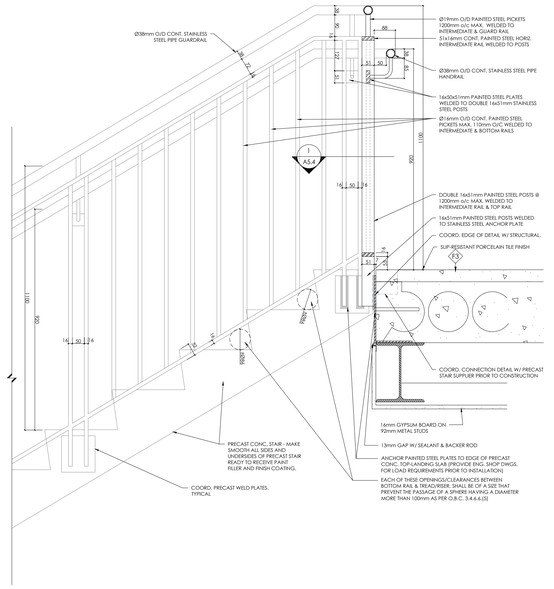


4 A5.4 HOLLOW CORE SLAB THROUGH GUARD RAIL DETAIL W/ PRECAST STAIR & RAILING BEYOND

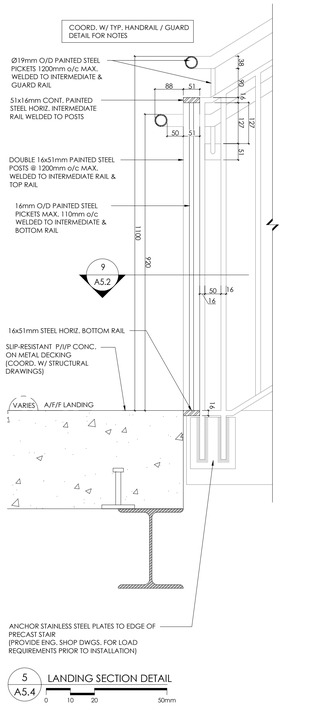


5 A5.4 LANDING SECTION DETAIL

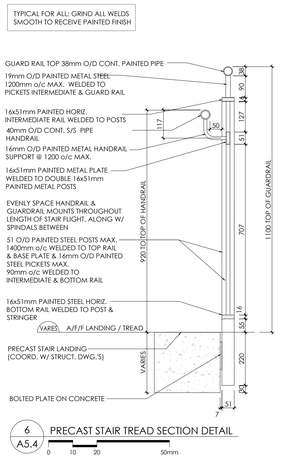


6 A5.4 PRECAST STAIR TREAD SECTION DETAIL

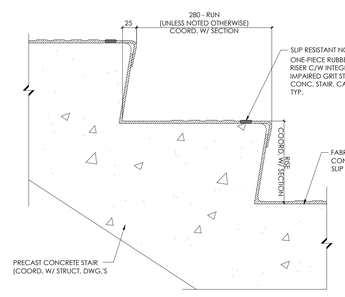

7 A5.4 PRECAST CONC. STAIR W/ RUBBER TREAD TYPICAL

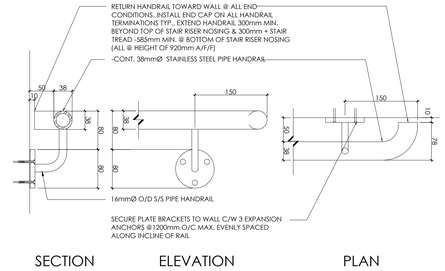

8 A5.4 STAIR WALL MOUNTED HANDRAIL DETAILS

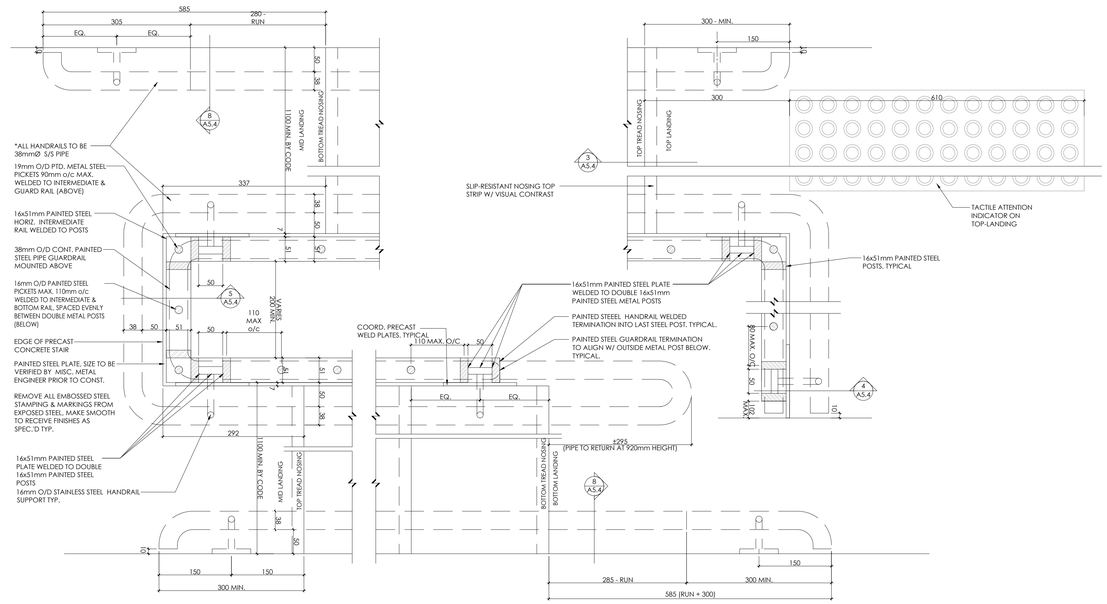

9 A5.4 STAIR RAILING SECTION @ TREAD/ LANDING

REVISIONS

NO.	DATE	PARTICULAR
1	2022.06.06	ISSUED FOR 80% CLASS B COSTING
2	2022.08.18	ISSUED FOR SPA
3	2022.09.22	ISSUED FOR OWNERS REVIEW - 98% SET
4	2022.12.16	ISSUED FOR 2nd SPA SUBMISSION
5	2023.01.31	ISSUED FOR TENDER
6	2023.02.22	ISSUED FOR ADDENDUM 9
7	2023.08.23	ISSUED FOR CONVENIENCE
8	2023.11.20	ISSUED FOR PERMIT COMMENTS
9	2024.01.24	ISSUED FOR SI#03
10	2024.02.15	ISSUED FOR PCN#008
11	2024.03.04	ISSUED FOR PCN#009
12	2024.03.10	ISSUED FOR SI#004
13	2024.05.14	ISSUED FOR SI#006
14	2024.07.22	ISSUED FOR SI#008
15	2024.08.07	ISSUED FOR SI#009
16	2024.10.02	ISSUED FOR PCN#15
17	2025.04.11	ISSUED FOR PCN#019
18	2025.05.01	ISSUED FOR CO#07
19	2025.05.28	ISSUED FOR PCN#20 - CO#010
20	2025.07.31	ISSUED FOR SI#013
21	2025.08.06	ISSUED FOR SI#014
22	2025.08.15	ISSUED FOR PCN#25 - CO#017
23	2025.08.25	ISSUED FOR PCN#27 - CO#021
24	2025.09.02	ISSUED FOR PCN#29
25	2025.09.02	ISSUED FOR SI#20 - CO#018
26	2025.09.08	ISSUED FOR PCN#31
27	2025.09.09	ISSUED FOR PCN#32 - CO#022
28	2025.09.10	ISSUED FOR PCN#33
29	2025.09.11	ISSUED FOR SI#022
30	2025.09.15	ISSUED FOR SI#023
31	2025.09.16	ISSUED FOR PCN #35 - CO#023
32	2025.09.30	ISSUED FOR PCN #37 - CO#029
33	2025.09.30	ISSUED FOR PCN #38 - CO#025
34	2025.10.06	ISSUED FOR PCN #39 - CO#024
35	2025.10.20	ISSUED FOR PCN #40R1
36	2025.10.30	ISSUED FOR PCN#041
37	2025.10.23	ISSUED FOR PCN #42
38	2025.11.21	ISSUED FOR PCN#021/R1 - CO12 CD#006
39	2025.11.14	ISSUED FOR PCN#043
40	2025.11.26	ISSUED FOR PCN#043R1
41	2025.12.03	ISSUED FOR PCN#044 - CO#026
42	2026.02.04	ISSUED FOR RECORD SET UP TO CO#27

NOTES:

KEY PLAN:

All dimensions and measurements must be checked and verified by the General Contractor

Reproduction of drawings and related documents in whole or in part is forbidden without written permission of the VentinGroup.

Near North District School Board

CLIENT:
NEAR NORTH DISTRICT SCHOOL BOARD
NNDSB Tender # 2023-015

PROJECT:
NEW PARRY SOUND K-12 SCHOOL & CHILDCARE

PARRY SOUND HIGH SCHOOL SITE

111 ISABELLA STREET
PARRY SOUND, ONTARIO

ORIGINAL PAGE SIZE ARCH E1 - 30" x 42"
KEY TO DETAIL LOCATION:
(A) A - DETAIL NO.
(B) B - DETAIL NO. ORIGIN


+VG ARCHITECTS
THE VENTIN GROUP LTD

PRECAST STAIR DETAILS

A5.4


Plot Date: Feb 03, 2026 - 5:31pm By: jkelly
Filename: K:\1VG-Brantford\Near North DSB Parry Sound School\2211\1Drawings\Working\Current\NN-A5.1.dwg

DRAWN BY : KH
CHECKED BY : PS

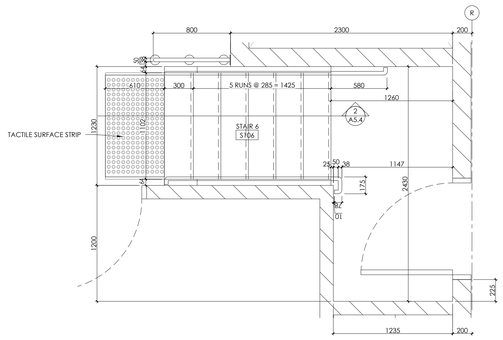


1 A5.5 STAIR 6 - FLOOR PLAN

0 250 500 1250mm

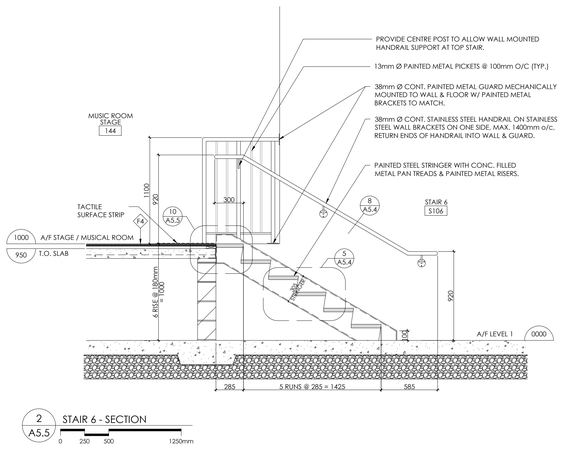


2 A5.5 STAIR 6 - SECTION

0 250 500 1250mm

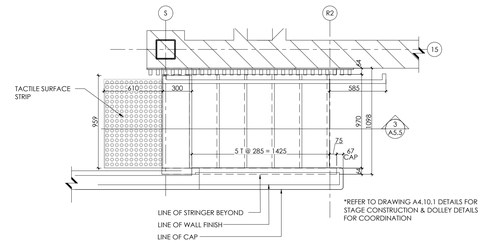


3 A5.5 STAIR 7 - FLOOR PLAN (STAIR 8 SIMILAR)

0 250 500 1250mm

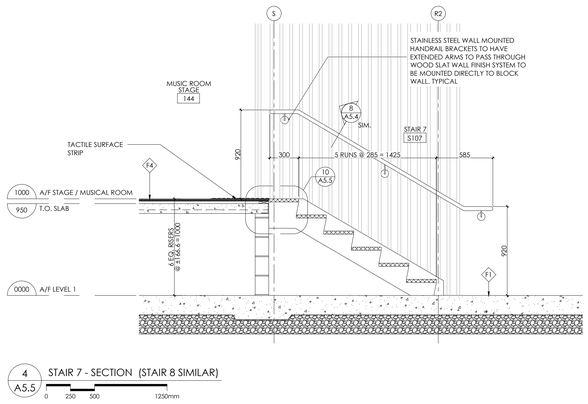

4 A5.5 STAIR 7 - SECTION (STAIR 8 SIMILAR)

0 250 500 1250mm

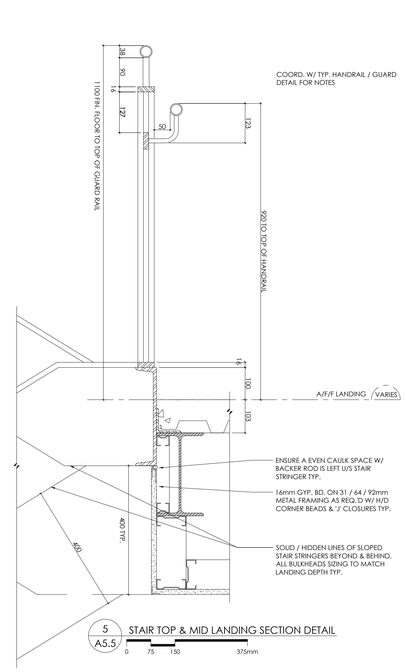


6 A5.5 STAIR TREAD SECTION DETAIL

0 75 150 375mm


5 A5.5 STAIR TOP & MID LANDING SECTION DETAIL

0 75 150 375mm

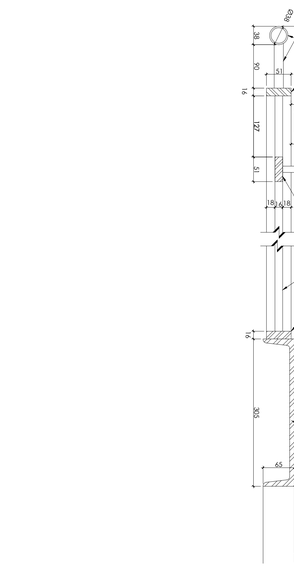


7 A5.5 GUARD SECTION

0 10 20 50mm

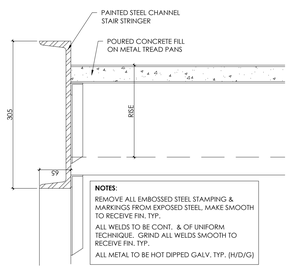


8 A5.5 TYP. CONC. FILLED METAL PAN DETAIL SECTION

0 50 100 250mm

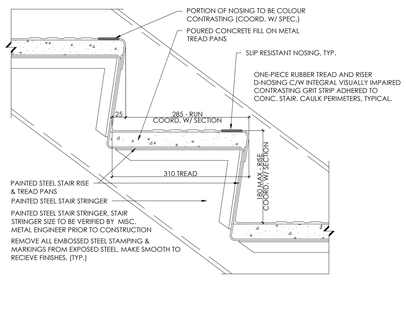

9 A5.5 TYP. CONC. FILLED METAL PAN TREAD DETAIL W/ RUBBER FINISH

0 50 100 250mm

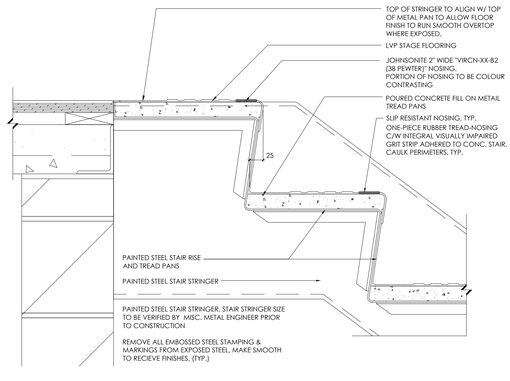

10 A5.5 TYP. CONC. FILLED METAL PAN TOP TREAD DETAIL W/ RUBBER FINISH

0 50 100 250mm

REVISIONS

NO.	DATE	PARTICULAR
1	2022.06.06	ISSUED FOR 80% CLASS B COSTING
2	2022.08.18	ISSUED FOR SPA
3	2022.09.22	ISSUED FOR OWNERS REVIEW - 98% SET
4	2022.12.16	ISSUED FOR 2nd SPA SUBMISSION
5	2023.01.31	ISSUED FOR TENDER
6	2023.02.22	ISSUED FOR ADDENDUM 9
7	2023.08.23	ISSUED FOR CONVENIENCE
8	2023.11.20	ISSUED FOR PERMIT COMMENTS
9	2024.01.24	ISSUED FOR SI#03
10	2024.02.15	ISSUED FOR PCN#008
11	2024.03.04	ISSUED FOR PCN#009
12	2024.03.10	ISSUED FOR SI#004
13	2024.05.14	ISSUED FOR SI#006
14	2024.07.22	ISSUED FOR SI#008
15	2024.08.07	ISSUED FOR SI#009
16	2024.10.02	ISSUED FOR PCN#15
17	2025.04.11	ISSUED FOR PCN#019
18	2025.05.01	ISSUED FOR CO#07
19	2025.05.28	ISSUED FOR PCN#20 - CO#010
20	2025.07.31	ISSUED FOR SI#013
21	2025.08.06	ISSUED FOR SI#014
22	2025.08.15	ISSUED FOR PCN#25 - CO#017
23	2025.08.25	ISSUED FOR PCN#27 - CO#021
24	2025.09.02	ISSUED FOR PCN#29
25	2025.09.02	ISSUED FOR SI#20 - CO#018
26	2025.09.08	ISSUED FOR PCN#31
27	2025.09.09	ISSUED FOR PCN#32 - CO#022
28	2025.09.10	ISSUED FOR SI#33
29	2025.09.11	ISSUED FOR SI#022
30	2025.09.15	ISSUED FOR SI#023
31	2025.09.16	ISSUED FOR PCN #35 - CO#023
32	2025.09.30	ISSUED FOR PCN #37 - CO#029
33	2025.09.30	ISSUED FOR PCN #38 - CO#025
34	2025.10.06	ISSUED FOR PCN #39 - CO#024
35	2025.10.20	ISSUED FOR PCN #4081
36	2025.10.30	ISSUED FOR PCN#041
37	2025.10.23	ISSUED FOR PCN #42
38	2025.11.21	ISSUED FOR PCN#021/R1 - CO12 CD#006
39	2025.11.14	ISSUED FOR PCN#043
40	2025.11.26	ISSUED FOR PCN#043R1
41	2025.12.03	ISSUED FOR PCN#044 - CO#026
42	2026.02.04	ISSUED FOR RECORD SET UP TO CO#27

NOTES:

KEY PLAN:



Reproduction of drawings and related documents in whole or in part is forbidden without written permission of the Ventin Group.

All dimensions and measurements must be checked and verified by the General Contractor

Near North District School Board

CLIENT:
NEAR NORTH DISTRICT SCHOOL BOARD
NNDSB Tender # 2023-015

PROJECT:
NEW PARRY SOUND K-12 SCHOOL & CHILDCARE

PARRY SOUND HIGH SCHOOL SITE

111 ISABELLA STREET
PARRY SOUND, ONTARIO

ORIGINAL PAGE SIZE ARCH E1 - 30" x 42"
KEY TO DETAIL LOCATION:
(A) A - DETAIL NO.
(B) B - DETAIL NO. ORIGIN


+VG ARCHITECTS
THE VENTIN GROUP LTD

STAIR 1 DETAILS & STAGE STAIRS 6, 7 & 8 - PLANS, SECTIONS & DETAILS

A5.5


Plot Date: Feb 03, 2026 - 5:31pm By: jkelly
Filename: K:\VG-Brantford-Near North DSB Parry Sound School\2211\Drawings\WIP-Current\NN-A5.1.dwg

DRAWN BY : KH CHECKED BY : PS

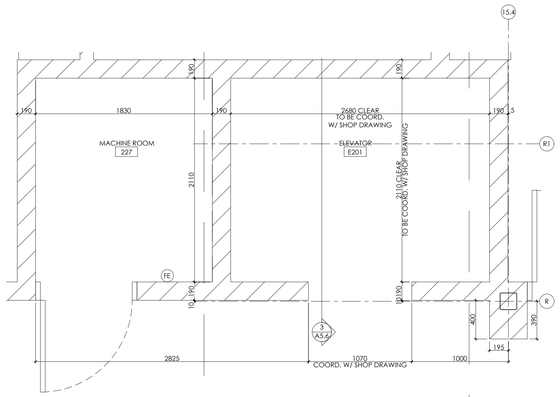

2 A5.6 ELEVATOR E201 - FLOOR PLAN

0 250 500 1250mm

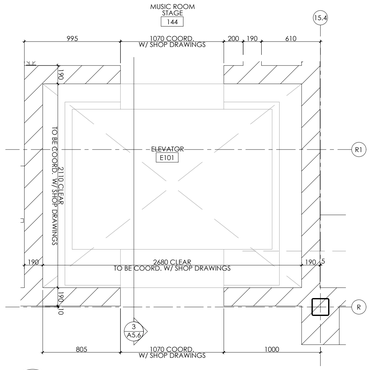


1 A5.6 ELEVATOR E101 - FLOOR PLAN

0 250 500 1250mm

STAIR LADDER PART PLAN

4 A5.6 ELEVATOR PIT LADDER SECTION DETAIL

0 200 400 1000mm

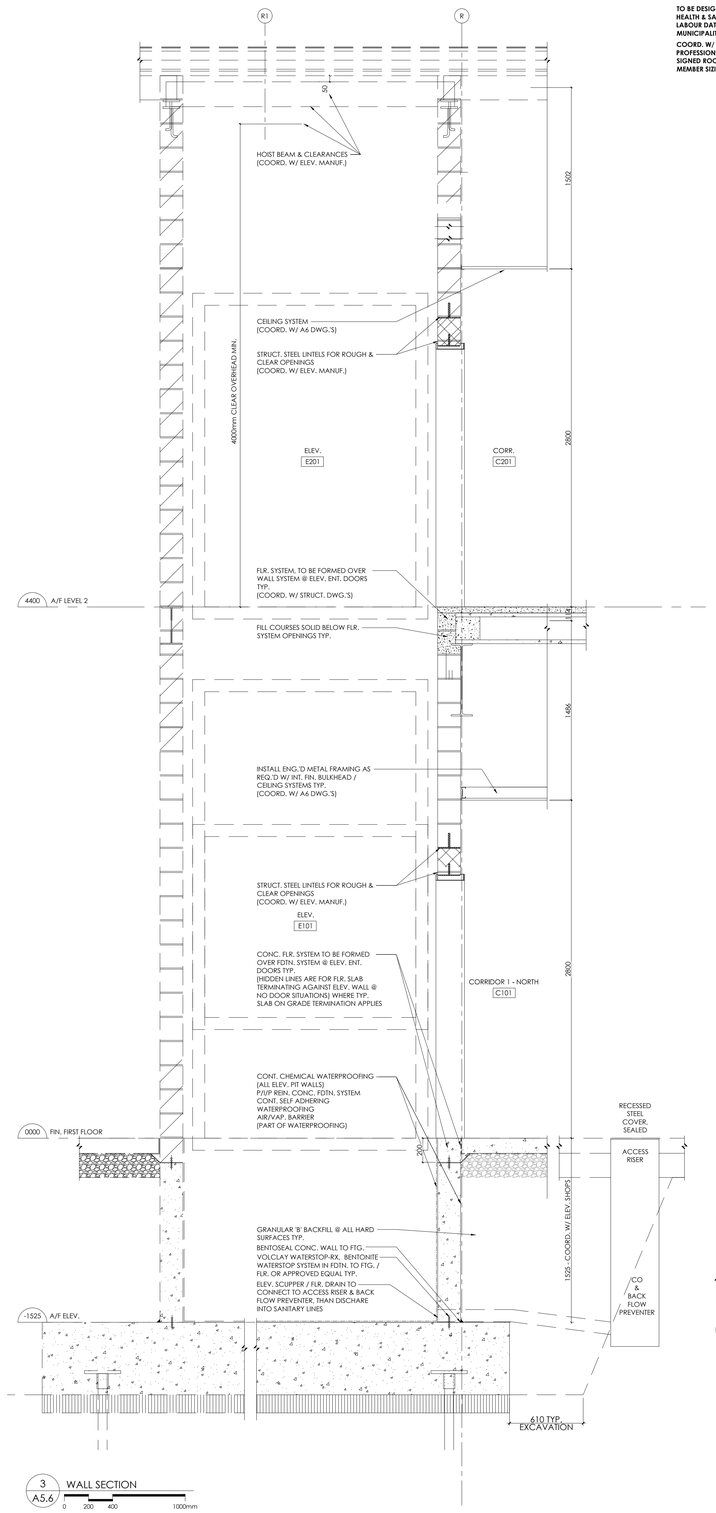


3 A5.6 WALL SECTION

0 200 400 1000mm

TO BE DESIGNED TO OBC SB-8, HEALTH & SAFETY ACT, MINISTRY OF LABOUR DATA SHEET 2-04 & MUNICIPALITY REGULATING STD.'S

COORD. W/ MISC. METALS PROFESSIONAL ENG. FOR STAMPED & SIGNED ROOF LADDER CONST. / MEMBER SIZING & ANCHORAGE / ETC.

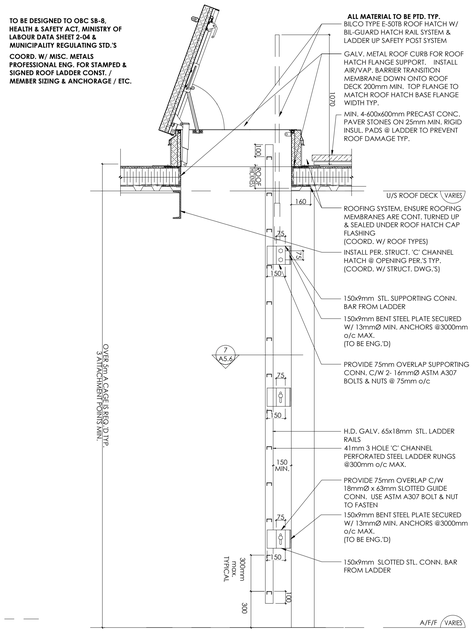


6 A5.6 TYPICAL ROOF ACCESS LADDER SECTION

0 200 400 1000mm

COORD. W/ MISC. METALS PROFESSIONAL ENG. FOR STAMPED & SIGNED ROOF LADDER CONST. / MEMBER SIZING & ANCHORAGE / ETC.

TO BE DESIGNED TO OBC SB-8, HEALTH & SAFETY ACT, MINISTRY OF LABOUR DATA SHEET 2-04 & MUNICIPALITY REGULATING STD.'S

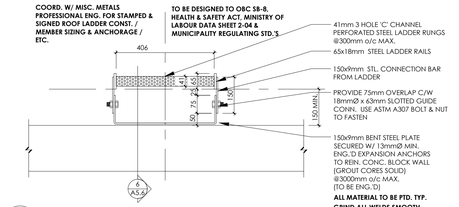

5 A5.6 TYPICAL PLAN DETAIL - ROOF ACCESS LADDER / HATCH


0 100 200 500mm

TO BE DESIGNED TO OBC SB-8, HEALTH & SAFETY ACT, MINISTRY OF LABOUR DATA SHEET 2-04 & MUNICIPALITY REGULATING STD.'S

COORD. W/ MISC. METALS PROFESSIONAL ENG. FOR STAMPED & SIGNED ROOF LADDER CONST. / MEMBER SIZING & ANCHORAGE / ETC.

ALL MATERIAL TO BE H/D/G TYP.

GRIND ALL WELDS SMOOTH. FABRICATE LADDER & CAGE TO LATEST MINISTRY OF LABOUR MIN. REQ.'S

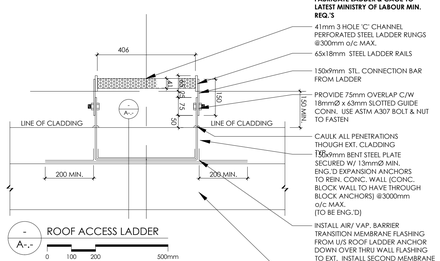

- A-.- ROOF ACCESS LADDER


0 100 200 500mm

TO BE DESIGNED TO OBC SB-8, HEALTH & SAFETY ACT, MINISTRY OF LABOUR DATA SHEET 2-04 & MUNICIPALITY REGULATING STD.'S

COORD. W/ MISC. METALS PROFESSIONAL ENG. FOR STAMPED & SIGNED ROOF LADDER CONST. / MEMBER SIZING & ANCHORAGE / ETC.

ALL MATERIAL TO BE H/D/G TYP.

GRIND ALL WELDS SMOOTH. FABRICATE LADDER & CAGE TO LATEST MINISTRY OF LABOUR MIN. REQ.'S

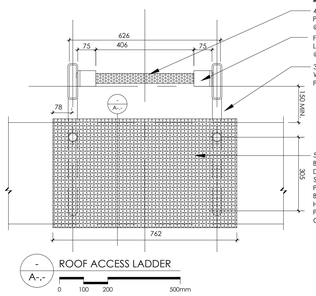


- A-.- ROOF ACCESS LADDER

0 100 200 500mm

TO BE DESIGNED TO OBC SB-8, HEALTH & SAFETY ACT, MINISTRY OF LABOUR DATA SHEET 2-04 & MUNICIPALITY REGULATING STD.'S

COORD. W/ MISC. METALS PROFESSIONAL ENG. FOR STAMPED & SIGNED ROOF LADDER CONST. / MEMBER SIZING & ANCHORAGE / ETC.

ALL MATERIAL TO BE H/D/G TYP.

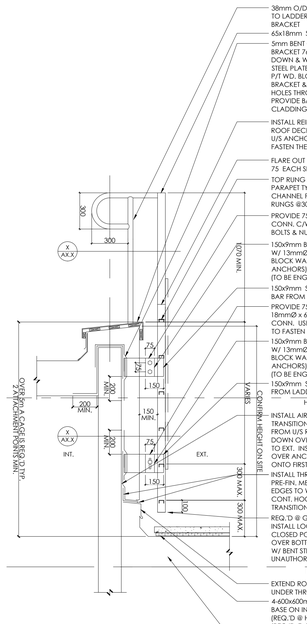

X AX.X ROOF ACCESS LADDER


0 200 300 1000mm

REVISIONS

NO.	DATE	PARTICULAR
1	2022.06.06	ISSUED FOR 80% CLASS B COSTING
2	2022.08.18	ISSUED FOR SPA
3	2022.09.22	ISSUED FOR OWNERS REVIEW - 98% SET
4	2022.12.16	ISSUED FOR 2nd SPA SUBMISSION
5	2023.01.31	ISSUED FOR TENDER
6	2023.02.22	ISSUED FOR ADDENDUM 9
7	2023.08.23	ISSUED FOR CONVENIENCE
8	2023.11.20	ISSUED FOR PERMIT COMMENTS
9	2024.01.24	ISSUED FOR SI#03
10	2024.02.15	ISSUED FOR PCN#008
11	2024.03.04	ISSUED FOR PCN#009
12	2024.03.10	ISSUED FOR SI#004
13	2024.05.14	ISSUED FOR SI#006
14	2024.07.22	ISSUED FOR SI#008
15	2024.08.07	ISSUED FOR SI#009
16	2024.10.02	ISSUED FOR PCN#15
17	2025.04.11	ISSUED FOR PCN#019
18	2025.05.01	ISSUED FOR CO#07
19	2025.05.28	ISSUED FOR PCN#20 - CO#010
20	2025.07.31	ISSUED FOR SI#013
21	2025.08.06	ISSUED FOR SI#014
22	2025.08.15	ISSUED FOR PCN#25 - CO#017
23	2025.08.25	ISSUED FOR PCN#27 - CO#021
24	2025.09.02	ISSUED FOR PCN#29
25	2025.09.02	ISSUED FOR SI#20 - CO#018
26	2025.09.08	ISSUED FOR PCN#31
27	2025.09.09	ISSUED FOR PCN#32 - CO#022
28	2025.09.10	ISSUED FOR SI#33
29	2025.09.11	ISSUED FOR SI#022
30	2025.09.15	ISSUED FOR SI#023
31	2025.09.16	ISSUED FOR PCN #35 - CO#023
32	2025.09.30	ISSUED FOR PCN #37 - CO#029
33	2025.09.30	ISSUED FOR PCN #38 - CO#025
34	2025.10.06	ISSUED FOR PCN #39 - CO#024
35	2025.10.20	ISSUED FOR PCN #4081
36	2025.10.30	ISSUED FOR PCN#041
37	2025.10.23	ISSUED FOR PCN #42
38	2025.11.21	ISSUED FOR PCN#021/R1 - CO12 CD#006
39	2025.11.14	ISSUED FOR PCN#043
40	2025.11.26	ISSUED FOR PCN#043R1
41	2025.12.03	ISSUED FOR PCN#044 - CO#026
42	2026.02.04	ISSUED FOR RECORD SET UP TO CO#27

NOTES:

KEY PLAN:

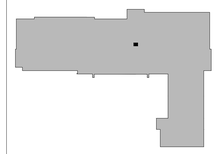

All dimensions and measurements must be checked and verified by the General Contractor

Reproduction of drawings and related documents in whole or in part is forbidden without written permission of the VenTin Group.

Near North District School Board

CLIENT:
NEAR NORTH DISTRICT SCHOOL BOARD
NNDSB Tender # 2023-015

PROJECT:
NEW PARRY SOUND K-12 SCHOOL & CHILDCARE

PARRY SOUND HIGH SCHOOL SITE

111 ISABELLA STREET
PARRY SOUND, ONTARIO

ORIGINAL PAGE SIZE ARCH E1 - 30" x 42"

KEY TO DETAIL LOCATION:
A - A - DETAIL NO.
B - B - DETAIL NO. ORIGIN


+VG ARCHITECTS
THE VENTIN GROUP LTD

ELEVATOR & ROOF LADDER HATCH - PLANS & SECTIONS

A5.6


Plot Date: Feb 03, 2026 - 5:32pm By: jkelly
Filename: K:\VG-Brantford\Near North DSB Parry Sound School\2211\Drawings\Wd Current\Vnt\ A5.1.dwg

DRAWN BY : KH CHECKED BY : PS

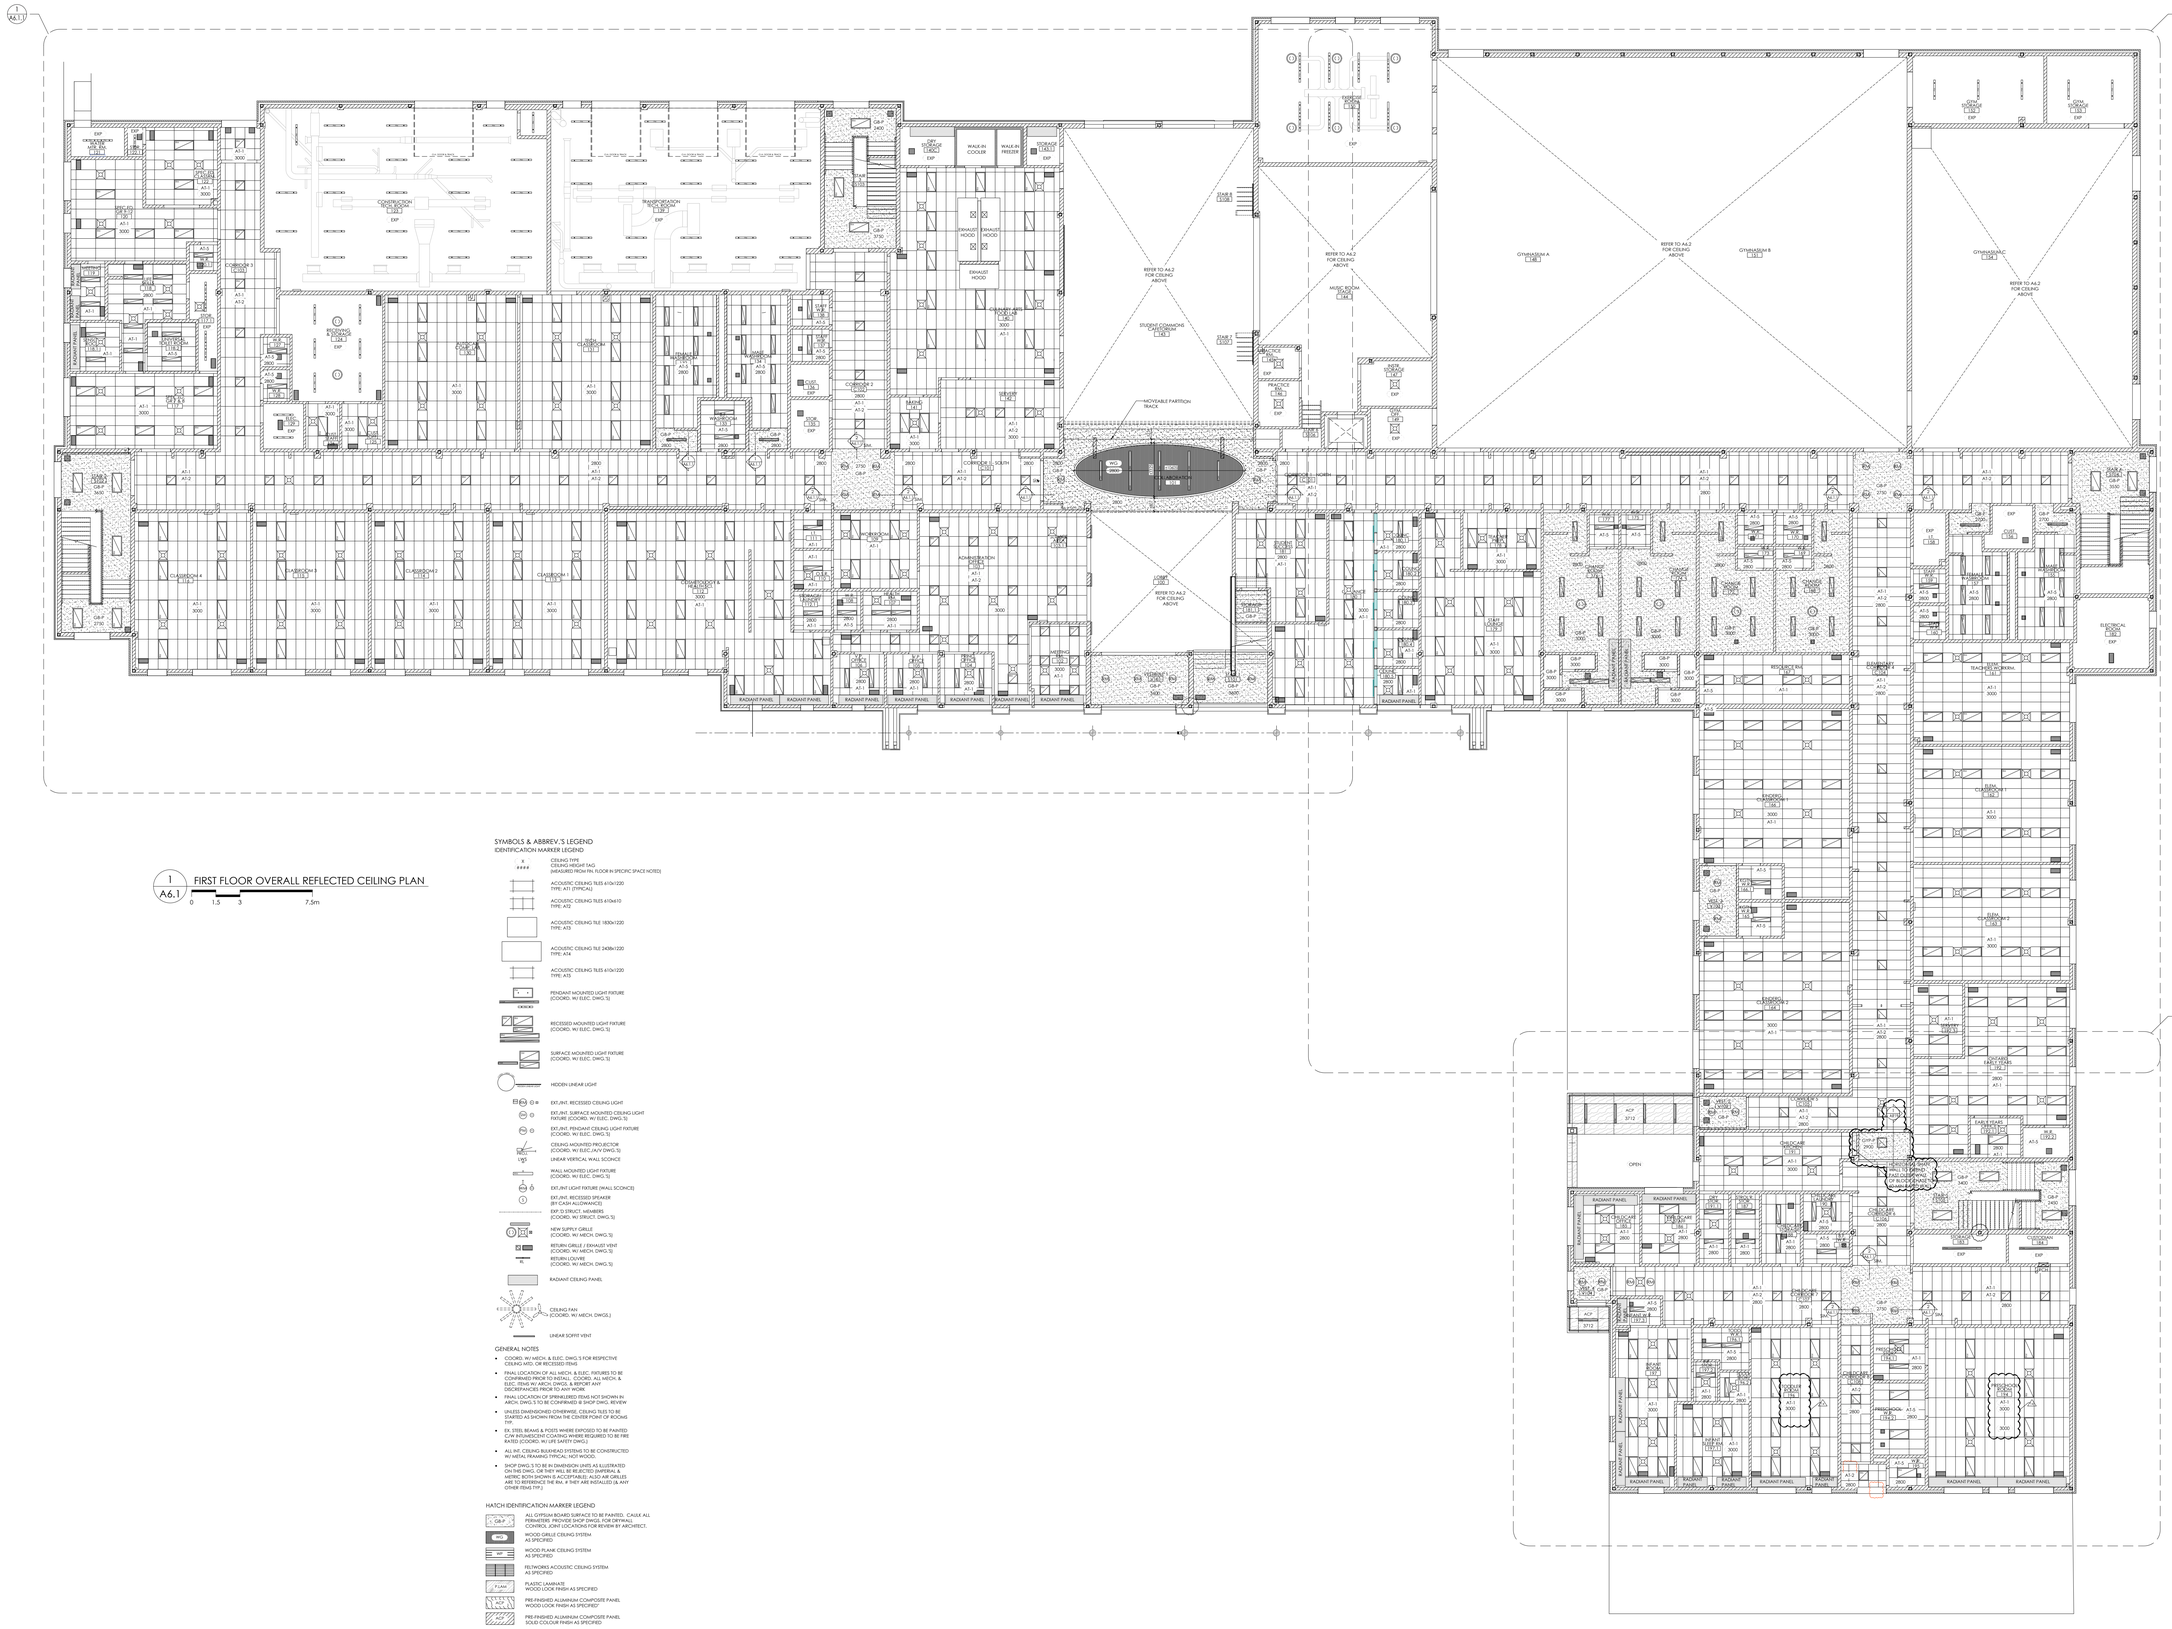
1
A1.1
1
A1.2
1
A6.1.3
CLASSROOM 4
CLASSROOM 3
CLASSROOM 2
CLASSROOM 1
CONSTRUCTION TECHNOLOGY
TRANSPORTATION TECHNOLOGY
CORRIDOR 3
CORRIDOR 2
CORRIDOR 1
STAIR 1
STAIR 2
STAIR




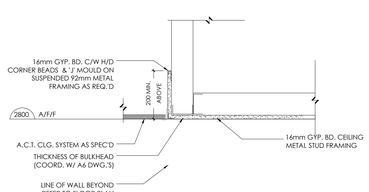

1 BULKHEAD DETAIL
A6.1.1 — 0 100 200 500mm

SYMBOLS & ABBREV.'S LEGEND

IDENTIFICATION MARKER LEGEND

- CEILING TYPE / CEILING HEIGHT TAG (MEASURED FROM FIN. FLOOR IN SPECIFIC SPACE NOTED)
- ACOUSTIC CEILING TILES 610X1220 TYPE: AT1 (TYPICAL)
- ACOUSTIC CEILING TILES 610X610 TYPE: AT2
- ACOUSTIC CEILING TILE 1830X1220 TYPE: AT3
- ACOUSTIC CEILING TILE 2438X1220 TYPE: AT4
- ACOUSTIC CEILING TILES 610X1220 TYPE: AT5
- PENDANT MOUNTED LIGHT FIXTURE (COORD. W/ ELEC. DWG.'S)
- RECESSED MOUNTED LIGHT FIXTURE (COORD. W/ ELEC. DWG.'S)
- SURFACE MOUNTED LIGHT FIXTURE (COORD. W/ ELEC. DWG.'S)
- HIDDEN LINEAR LIGHT
- EXT./INT. RECESSED CEILING LIGHT
- EXT./INT. SURFACE MOUNTED CEILING LIGHT FIXTURE (COORD. W/ ELEC. DWG.'S)
- EXT./INT. PENDANT CEILING LIGHT FIXTURE (COORD. W/ ELEC. DWG.'S)
- CEILING MOUNTED PROJECTOR (COORD. W/ ELEC./A/V DWG.'S)
- LINEAR VERTICAL WALL SCONCE
- WALL MOUNTED LIGHT FIXTURE (COORD. W/ ELEC. DWG.'S)
- EXT./INT. LIGHT FIXTURE (WALL SCONCE)
- EXT./INT. RECESSED SPEAKER (BY CASH ALLOWANCE)
- EXP. TO STRUCT. MEMBERS (COORD. W/ STRUCT. DWG.'S)
- NEW SUPPLY GRILLE (COORD. W/ MECH. DWG.'S)
- RETURN GRILLE / EXHAUST VENT (COORD. W/ MECH. DWG.'S)
- RETURN LOUVRE (COORD. W/ MECH. DWG.'S)
- RADIANT CEILING PANEL
- CEILING FAN (COORD. W/ MECH. DWG.'S)
- LINEAR SOFFIT VENT

GENERAL NOTES

- COORD. W/ MECH. & ELEC. DWG.'S FOR RESPECTIVE CEILING MTD. OR RECESSED ITEMS
- FINAL LOCATION OF ALL MECH. & ELEC. FIXTURES TO BE CONFIRMED PRIOR TO INSTALL. COORD. ALL MECH. & ELEC. ITEMS W/ ARCH. DWGS. & REPORT ANY DISCREPANCIES PRIOR TO ANY WORK
- FINAL LOCATION OF SPRINKLERED ITEMS NOT SHOWN IN ARCH. DWG.'S TO BE CONFIRMED @ SHOP DWG. REVIEW
- UNLESS DIMENSIONED OTHERWISE, CEILING TILES TO BE STARTED AS SHOWN FROM THE CENTER POINT OF ROOMS
- EX. STEEL BEAMS & POSTS WHERE EXPOSED TO BE PAINTED C/W INTUMESCENT COATING WHERE REQUIRED TO BE FIRE RATED (COORD. W/ LIFE SAFETY DWG.)
- ALL INT. CEILING BULKHEAD SYSTEMS TO BE CONSTRUCTED W/ METAL FRAMING TYPICAL, NOT WOOD.
- SHOP DWG.'S TO BE IN DIMENSION UNITS AS ILLUSTRATED ON THE DRAWINGS (IE. IMPERIAL OR METRIC) ONLY ONE METRIC BOX SHOWN IS ACCEPTABLE. ALSO AIR GRILLES ARE TO REFERENCE THE RM. # THEY ARE INSTALLED (& ANY OTHER ITEMS TYP.)

HATCH IDENTIFICATION MARKER LEGEND


- GYP — ALL GYPSUM BOARD SURFACE TO BE PAINTED. CAULK ALL PERIMETERS. PROVIDE SHOP DWG'S. FOR DRYWALL CONTROL JOINT LOCATIONS FOR REVIEW BY ARCHITECT.
- WOOD — WOOD GRILLE CEILING SYSTEM AS SPECIFIED
- WP — WOOD PLANK CEILING SYSTEM AS SPECIFIED
- FELT — FELTWORKS ACOUSTIC CEILING SYSTEM AS SPECIFIED
- P. LAM — PLASTIC LAMINATE WOOD LOOK FINISH AS SPECIFIED
- ALUM — PRE-FINISHED ALUMINUM COMPOSITE PANEL WOOD LOOK FINISH AS SPECIFIED
- PRE-FINISHED ALUMINUM COMPOSITE PANEL SOLID COLOUR FINISH AS SPECIFIED
- EXP — ALL EXPOSED CEILING SURFACES NOTED TO BE PAINTED, INCLUDING ALL EXPOSED SERVICE LINES, DUCTS & EXPOSED STEEL LINTELS / STRUCT. AT ALL MASONRY OPENINGS. PAINT TO BE APPLIED TO ALL SURFACES BETWEEN EXPOSED STRUCT. MEMBERS TYP. (ALLOW FOR 3 PAINT COLOURS FOR GYM. CEILING: 1 FOR ROOF DECK, JOISTS & EXPOSED STEEL, 1 FOR MECH. DUCTWORK)
- C.J. — CONTROL JOINT (ALL CONTROL JOINTS TO BE REVIEWED BY ARCHITECT @ SHOP DWG. REVIEW)

REVISIONS

NO.	DATE	PARTICULAR
1	2022.06.06	ISSUED FOR 80% CLASS B COSTING
2	2022.08.18	ISSUED FOR SPA
3	2022.09.22	ISSUED FOR OWNERS REVIEW - 98% SET
4	2022.12.16	ISSUED FOR 2nd SPA SUBMISSION
5	2023.01.31	ISSUED FOR TENDER
6	2023.02.22	ISSUED FOR ADDENDUM 9
7	2023.08.23	ISSUED FOR CONVENIENCE
8	2023.11.20	ISSUED FOR PERMIT COMMENTS
9	2024.01.24	ISSUED FOR SI#03
10	2024.02.15	ISSUED FOR PCN#008
11	2024.03.04	ISSUED FOR PCN#009
12	2024.03.10	ISSUED FOR SI#004
13	2024.05.14	ISSUED FOR SI#006
14	2024.07.22	ISSUED FOR SI#008
15	2024.08.07	ISSUED FOR SI#009
16	2024.10.02	ISSUED FOR PCN#15
17	2025.04.11	ISSUED FOR PCN#019
18	2025.05.01	ISSUED FOR CO#07
19	2025.05.28	ISSUED FOR PCN#20 - CO#010
20	2025.07.31	ISSUED FOR SI#013
21	2025.08.06	ISSUED FOR SI#014
22	2025.08.15	ISSUED FOR PCN#25 - CO#017
23	2025.08.25	ISSUED FOR PCN#27 - CO#021
24	2025.09.02	ISSUED FOR PCN#29
25	2025.09.02	ISSUED FOR SI#20 - CO#018
26	2025.09.08	ISSUED FOR PCN#31
27	2025.09.09	ISSUED FOR PCN#32 - CO#022
28	2025.09.10	ISSUED FOR PCN#33
29	2025.09.11	ISSUED FOR SI#022
30	2025.09.15	ISSUED FOR SI#023
31	2025.09.16	ISSUED FOR PCN #35 - CO#023
32	2025.09.30	ISSUED FOR PCN #37 - CO#029
33	2025.09.30	ISSUED FOR PCN #38 - CO#025
34	2025.10.06	ISSUED FOR PCN #39 - CO#024
35	2025.10.20	ISSUED FOR PCN #40R1
36	2025.10.30	ISSUED FOR PCN#041
37	2025.10.23	ISSUED FOR PCN #42
38	2025.11.21	ISSUED FOR PCN#021/R1 - CO12 CD#006
39	2025.11.14	ISSUED FOR PCN#043
40	2025.11.26	ISSUED FOR PCN#043R1
41	2025.12.03	ISSUED FOR PCN#044 - CO#026
42	2026.02.04	ISSUED FOR RECORD SET UP TO CO#27

NOTES:

KEY PLAN:

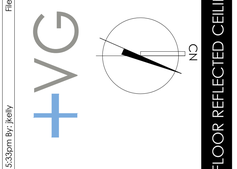

Reproduction of drawings and related documents in whole or in part is forbidden without written permission of The Ventin Group.

All dimensions and measurements must be checked and verified by the General Contractor

Near North District School Board

CLIENT:
NEAR NORTH DISTRICT SCHOOL BOARD
NNDSB Tender # 2023-015

PROJECT:
NEW PARRY SOUND K-12 SCHOOL & CHILDCARE

PARRY SOUND HIGH SCHOOL SITE

111 ISABELLA STREET
PARRY SOUND, ONTARIO

ORIGINAL PAGE SIZE ARCH E1 - 30" x 42"

KEY TO DETAIL LOCATION:
(A) A - DETAIL NO.
(B) B - DETAIL NO. ORIGIN


+VG ARCHITECTS
THE VENTIN GROUP LTD

FIRST FLOOR REFLECTED CEILING PLAN - SOUTH WING

A6.1.1

DRAWN BY : EB CHECKED BY : PS

Plot Date: Feb 03, 2026 - 5:53pm By Jkelly Filename: K:\1VG-Brantford-Near North\08 Parry Sound School\21 I\1 Drawings\Wd Current\NN-A6.1.dwg

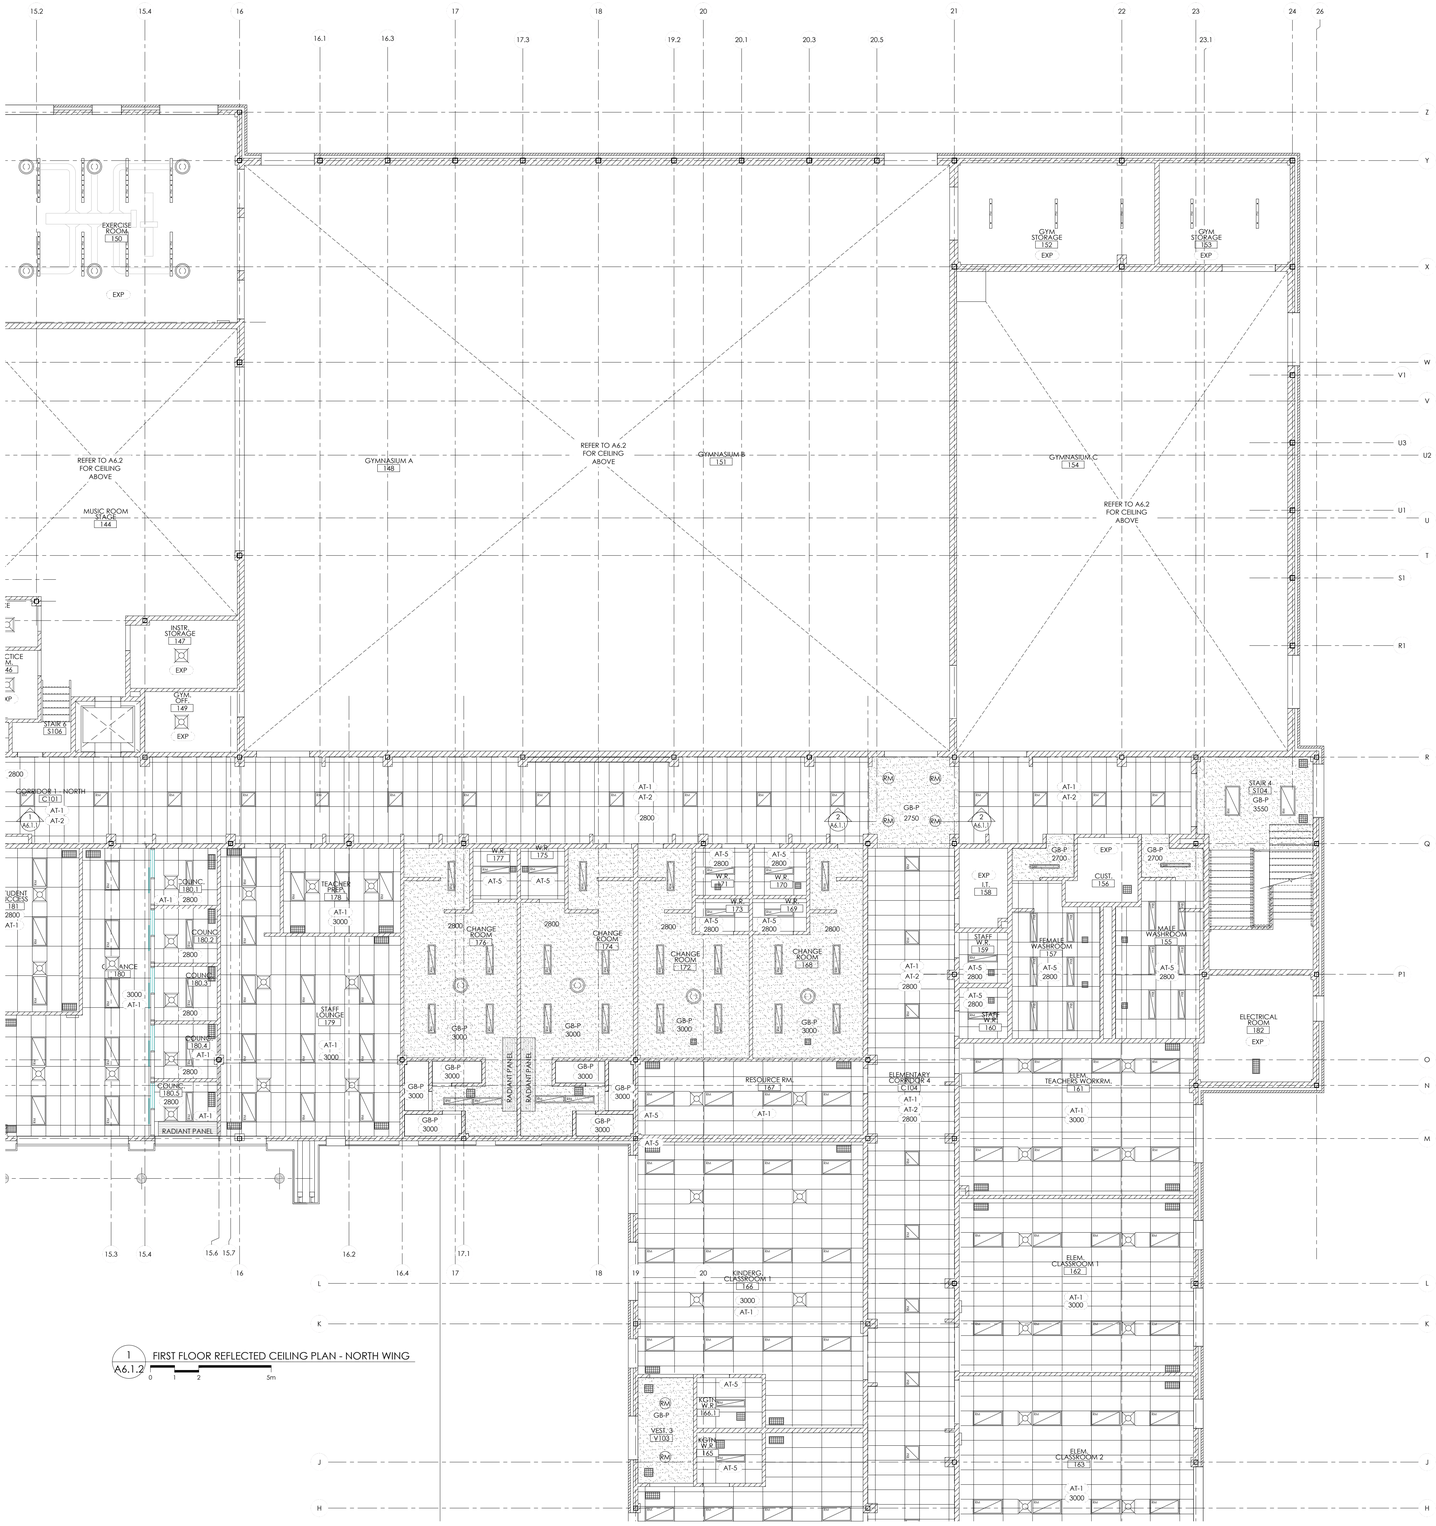

SYMBOLS & ABBREV.'S LEGEND

IDENTIFICATION MARKER LEGEND

- X / #### — CEILING TYPE / CEILING HEIGHT TAG (MEASURED FROM FIN. FLOOR IN SPECIFIC SPACE NOTED)
- ACOUSTIC CEILING TILES 610x1220 TYPE: AT1 (TYPICAL)
- ACOUSTIC CEILING TILES 610x610 TYPE: AT2
- ACOUSTIC CEILING TILE 1830x1220 TYPE: AT3
- ACOUSTIC CEILING TILE 2438x1220 TYPE: AT4
- ACOUSTIC CEILING TILES 610x1220 TYPE: AT5
- PENDANT MOUNTED LIGHT FIXTURE (COORD. W/ ELEC. DWG.'S) — EXISTING
- RECESSED MOUNTED LIGHT FIXTURE (COORD. W/ ELEC. DWG.'S)
- SURFACE MOUNTED LIGHT FIXTURE (COORD. W/ ELEC. DWG.'S)
- HIDDEN LINEAR LIGHT
- EXT./INT. RECESSED CEILING LIGHT
- EXT./INT. SURFACE MOUNTED CEILING LIGHT FIXTURE (COORD. W/ ELEC. DWG.'S)
- EXT./INT. PENDANT CEILING LIGHT FIXTURE (COORD. W/ ELEC. DWG.'S)
- CEILING MOUNTED PROJECTOR (COORD. W/ ELEC./A/V DWG.'S)
- LWS — LINEAR VERTICAL WALL SCONCE
- WALL MOUNTED LIGHT FIXTURE (COORD. W/ ELEC. DWG.'S)
- EXT./INT LIGHT FIXTURE (WALL SCONCE)
- EXT./INT. RECESSED SPEAKER (BY CASH ALLOWANCE)
- EXP — EXP'D STRUCT. MEMBERS (COORD. W/ STRUCT. DWG.'S)
- NEW SUPPLY GRILLE (COORD. W/ MECH. DWG.'S)
- RETURN GRILLE / EXHAUST VENT (COORD. W/ MECH. DWG.'S)
- RETURN LOUVER (COORD. W/ MECH. DWG.'S)
- RADIANT CEILING PANEL
- CEILING FAN (COORD. W/ MECH. DWG.'s)
- LINEAR SOFFIT VENT

GENERAL NOTES

- COORD. W/ MECH. & ELEC. DWG.'S FOR RESPECTIVE CEILING MTD. OR RECESSED ITEMS
- FINAL LOCATION OF ALL MECH. & ELEC. FIXTURES TO BE CONFIRMED PRIOR TO INSTALL. COORD. ALL MECH. & ELEC. ITEMS W/ ARCH. DWGS. & REPORT ANY DISCREPANCIES TO ARCH. PRIOR
- FINAL LOCATION OF SPRINKLERED ITEMS NOT SHOWN IN ARCH. DWG.'S TO BE CONFIRMED @ SHOP DWG. REVIEW
- UNLESS DIMENSIONED OTHERWISE, CEILING TILES TO BE CENTRED AS SHOWN FROM THE CENTER POINT OF ROOMS TYP.
- EX. STEEL BEAMS & POSTS WHERE EXPOSED TO BE PAINTED C/W INTUMESCING COATING WHERE REQUIRED TO BE FIRE RATED (COORD. W/ LIFE SAFETY DWG.)
- ALL INT. CEILING BULKHEAD SYSTEMS TO BE CONSTRUCTED W/ METAL FRAMING TYPICAL; NOT WOOD.
- SHOP DWG.'S TO BE IN DIMENSION UNITS AS ILLUSTRATED ON THIS DWG. OR THEY WILL BE REJECTED (IMPERIAL & METRIC BOTH SHOWN IS ACCEPTABLE). ALSO AIR GRILLES ARE TO REFERENCE THE RM.# THEY ARE INSTALLED (& ANY OTHER ITEMS TYP.)

HATCH IDENTIFICATION MARKER LEGEND


- GB-P — ALL GYPSUM BOARD SURFACE TO BE PAINTED. CAULK ALL PERIMETERS. PROVIDE SHOP DWGS. FOR DRYWALL CONTROL JOINT LOCATIONS FOR REVIEW BY ARCHITECT.
- WOOD GRILLE CEILING SYSTEM AS SPECIFIED
- WOOD PLANK CEILING SYSTEM AS SPECIFIED
- FELTWORKS ACOUSTIC CEILING SYSTEM AS SPECIFIED
- PLAM — PLASTIC LAMINATE WOOD LOOK FINISH AS SPECIFIED
- PREFINISHED ALUMINUM COMPOSITE PANEL WOOD LOOK FINISH AS SPECIFIED
- PREFINISHED ALUMINUM COMPOSITE PANEL SOLID COLOUR FINISH AS SPECIFIED
- EXP — ALL EXPOSED CEILING SURFACES NOTED TO BE PAINTED, INCLUDING ALL EXPOSED SERVICE LINES, DUCTS & EXPOSED STEEL UNISTL2 / STRUCT. AT ALL MASONRY OPENINGS. INSTALL ALL LIGHT FIXTURES CENTERED BETWEEN EXPOSED STRUCTURAL MEMBERS. ALLOW FOR 3 PAINT COLOURS FOR GYM CEILING: 1 FOR ROOF DECK, JOISTS & EXPOSED STEEL, 1 FOR MECH. DUCTWORK)
- CJ — CONTROL JOINT (ALL CONTROL JOINTS TO BE REVIEWED BY ARCHITECT @ SHOP DWG. REVIEW)

REVISIONS

NO.	DATE	PARTICULAR
1	2022.06.06	ISSUED FOR 80% CLASS B COSTING
2	2022.08.18	ISSUED FOR SPA
3	2022.09.22	ISSUED FOR OWNERS REVIEW - 98% SET
4	2022.12.16	ISSUED FOR 2nd SPA SUBMISSION
5	2023.01.31	ISSUED FOR TENDER
6	2023.02.22	ISSUED FOR ADDENDUM 9
7	2023.08.23	ISSUED FOR CONVENIENCE
8	2023.11.20	ISSUED FOR PERMIT COMMENTS
9	2024.01.24	ISSUED FOR SI#03
10	2024.02.15	ISSUED FOR PCN#008
11	2024.03.04	ISSUED FOR PCN#009
12	2024.03.10	ISSUED FOR SI#004
13	2024.05.14	ISSUED FOR SI#006
14	2024.07.22	ISSUED FOR SI#008
15	2024.08.07	ISSUED FOR SI#009
16	2024.10.02	ISSUED FOR PCN#15
17	2025.04.11	ISSUED FOR PCN#019
18	2025.05.01	ISSUED FOR CO#07
19	2025.05.28	ISSUED FOR PCN#20 - CO#010
20	2025.07.31	ISSUED FOR SI#013
21	2025.08.06	ISSUED FOR SI#014
22	2025.08.15	ISSUED FOR PCN#25 - CO#017
23	2025.08.25	ISSUED FOR PCN#27 - CO#021
24	2025.09.02	ISSUED FOR PCN#29
25	2025.09.02	ISSUED FOR SI#20 - CO#018
26	2025.09.08	ISSUED FOR PCN#31
27	2025.09.09	ISSUED FOR PCN#32 - CO#022
28	2025.09.10	ISSUED FOR PCN#33
29	2025.09.11	ISSUED FOR SI#022
30	2025.09.15	ISSUED FOR SI#023
31	2025.09.16	ISSUED FOR PCN #35 - CO#023
32	2025.09.30	ISSUED FOR PCN #37 - CO#039
33	2025.09.30	ISSUED FOR PCN #38 - CO#025
34	2025.10.06	ISSUED FOR PCN #39 - CO#024
35	2025.10.20	ISSUED FOR PCN #40R1
36	2025.10.30	ISSUED FOR PCN#041
37	2025.10.23	ISSUED FOR PCN #42
38	2025.11.21	ISSUED FOR PCN#021/R1 - CO12 CD#006
39	2025.11.14	ISSUED FOR PCN#043
40	2025.11.26	ISSUED FOR PCN#043R1
41	2025.12.03	ISSUED FOR PCN#044 - CO#026
42	2026.02.04	ISSUED FOR RECORD SET UP TO CO#27

NOTES:

KEY PLAN:

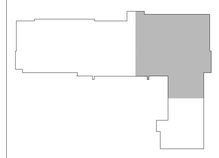

All dimensions and measurements must be checked and verified by the General Contractor

Reproduction of drawings and related documents in whole or in part is forbidden without written permission of the Ventin Group.

Near North District School Board

CLIENT:
NEAR NORTH DISTRICT SCHOOL BOARD
NNDSB Tender # 2023-015

PROJECT:
NEW PARRY SOUND K-12 SCHOOL & CHILDCARE

PARRY SOUND HIGH SCHOOL SITE

111 ISABELLA STREET
PARRY SOUND, ONTARIO

ORIGINAL PAGE SIZE ARCH E1 - 30" x 42"

KEY TO DETAIL LOCATION:
A - A - DETAIL NO.
B - B - DETAIL NO. ORIGIN


+VG ARCHITECTS
THE VENTIN GROUP LTD

FIRST FLOOR REFLECTED CEILING PLAN - NORTH WING

A6.1.2

DRAWN BY : EB CHECKED BY : PS

Plot Date: Feb 03, 2026 - 5:33pm By: jkelly
Filename: IC:\TVG-Brantford\Near North DSB Parry Sound School-22111\Drawings\Wd-Current\NN-A6.1.dwg

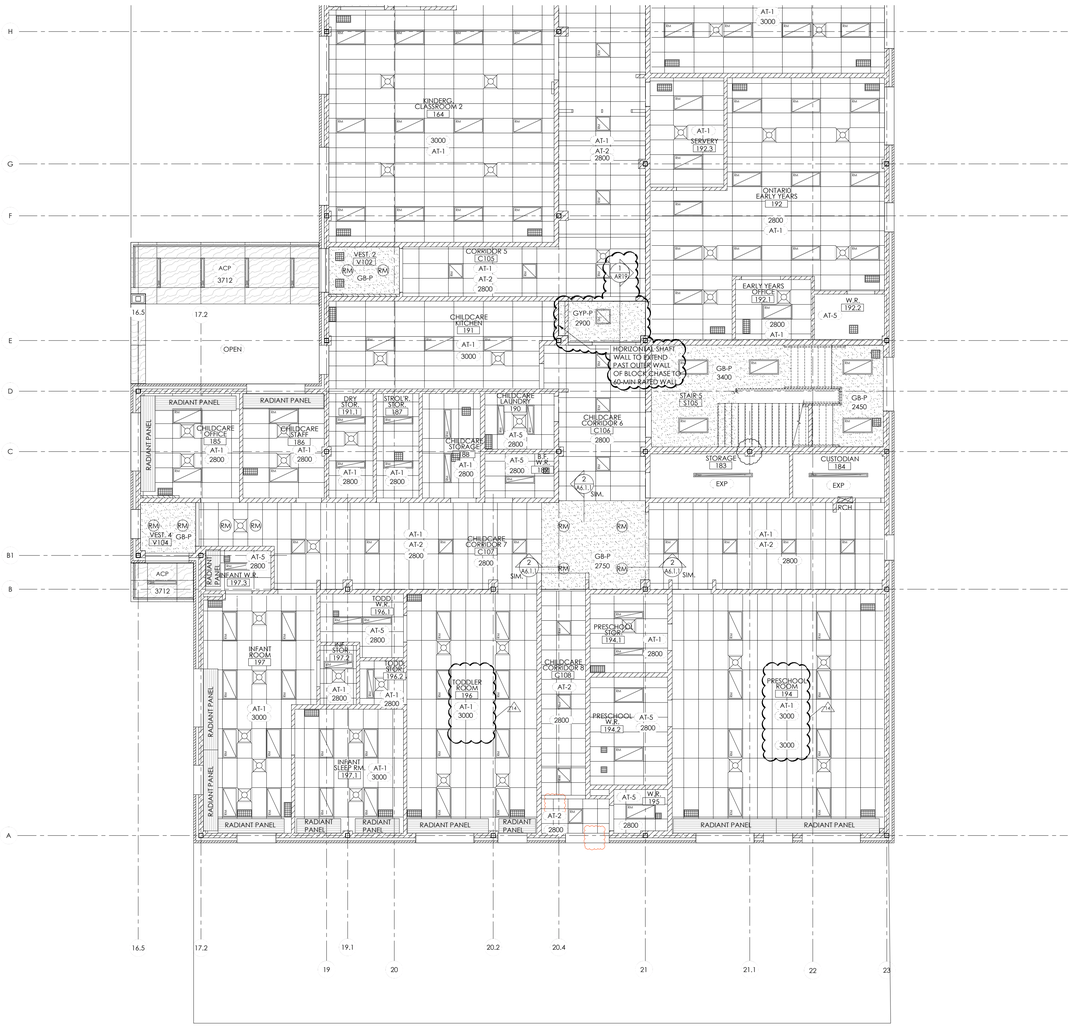

1 A6.1.3 FIRST FLOOR REFLECTED CEILING PLAN - CHILDCARE WING

0 1 2 5m

SYMBOLS & ABBREV.'S LEGEND

IDENTIFICATION MARKER LEGEND

- x / #### — CEILING TYPE / CEILING HEIGHT TAG (MEASURED FROM FIN. FLOOR IN SPECIFIC SPACE NOTED)
- ACOUSTIC CEILING TILES 610x1220 TYPE: AT1 (TYPICAL)
- ACOUSTIC CEILING TILES 610x610 TYPE: AT2
- ACOUSTIC CEILING TILE 1830x1220 TYPE: AT3
- ACOUSTIC CEILING TILE 2438x1220 TYPE: AT4
- ACOUSTIC CEILING TILES 610x1220 TYPE: AT5
- PENDANT MOUNTED LIGHT FIXTURE (COORD. W/ ELEC. DWG.'S)
- RECESSED MOUNTED LIGHT FIXTURE (COORD. W/ ELEC. DWG.'S)
- SURFACE MOUNTED LIGHT FIXTURE (COORD. W/ ELEC. DWG.'S)
- HIDDEN LINEAR LIGHT
- EXT./INT. RECESSED CEILING LIGHT
- EXT./INT. SURFACE MOUNTED CEILING LIGHT FIXTURE (COORD. W/ ELEC. DWG.'S)
- EXT./INT. PENDANT CEILING LIGHT FIXTURE (COORD. W/ ELEC. DWG.'S)
- CEILING MOUNTED PROJECTOR (COORD. W/ ELEC./A/V DWG.'S)
- LINEAR VERTICAL WALL SCONCE
- WALL MOUNTED LIGHT FIXTURE (COORD. W/ ELEC. DWG.'S)
- EXT./INT LIGHT FIXTURE (WALL SCONCE)
- EXT./INT. RECESSED SPEAKER (BY CASH ALLOWANCE)
- EXP.'S STRUCT. MEMBERS (COORD. W/ STRUCT. DWG.'S)
- NEW SUPPLY GRILLE (COORD. W/ MECH. DWG.'S)
- RETURN GRILLE / EXHAUST VENT (COORD. W/ MECH. DWG.'S)
- RETURN LOUVRE (COORD. W/ MECH. DWG.'S)
- RADIANT CEILING PANEL
- CEILING FAN (COORD. W/ MECH. DWGS.)
- LINEAR SOFFIT VENT

GENERAL NOTES

- COORD. W/ MECH. & ELEC. DWG.'S FOR RESPECTIVE CEILING MTD. OR RECESSED ITEMS
- FINAL LOCATION OF ALL MECH. & ELEC. FIXTURES TO BE CONFIRMED PRIOR TO INSTALL. COORD. ALL MECH. & ELEC. ITEMS W/ ARCH. DWGS. & REPORT ANY DISCREPANCIES PRIOR TO ANY WORK
- FINAL LOCATION OF SPRINKLERED ITEMS NOT SHOWN IN ARCH. DWG.'S TO BE CONFIRMED IN SHOP DWG. REVIEW
- UNLESS DIMENSIONED OTHERWISE, CEILING TILES TO BE STARTED AS SHOWN FROM THE CENTER POINT OF ROOMS
- EX. STEEL BEAMS & POSTS WHERE EXPOSED TO BE PAINTED C/W INTUMESCENT COATING WHERE REQUIRED TO BE FIRE RATED (COORD. W/ LIFE SAFETY DWG.)
- ALL MT. CEILING BULKHEAD SYSTEMS TO BE CONSTRUCTED W/ METAL FRAMING TYPICAL, NO WOOD.
- SHOP DWG.'S TO BE IN DIMENSION UNITS AS ILLUSTRATED ON ARCH. DWG.'S (IMPERIAL OR METRIC MATERIAL). IMPERIAL METRIC BOTH SHOWN IS ACCEPTABLE. ALSO AIR GRILLES ARE TO REFERENCE THE RM. # THEY ARE INSTALLED (& ANY OTHER ITEMS TYP.)

HATCH IDENTIFICATION MARKER LEGEND

- GB-P — ALL GYPSUM BOARD SURFACE TO BE PAINTED. CAULK ALL PERIMETERS. PROVIDE SHOP DWGS. FOR DRYWALL CONTROL JOINT LOCATIONS FOR REVIEW BY ARCHITECT.
- WG — WOOD GRILLE CEILING SYSTEM AS SPECIFIED
- WP — WOOD PLANK CEILING SYSTEM AS SPECIFIED
- FELT — FELTWORKS ACOUSTIC CEILING SYSTEM AS SPECIFIED
- PLAM — PLASTIC LAMINATE WOOD LOOK FINISH AS SPECIFIED
- ACP — PRE-FINISHED ALUMINUM COMPOSITE PANEL WOOD LOOK FINISH AS SPECIFIED
- PRE-FINISHED ALUMINUM COMPOSITE PANEL SOLID COLOUR FINISH AS SPECIFIED
- EXP — ALL EXPOSED CEILING SURFACES NOTED TO BE PAINTED, INCLUDING ALL EXPOSED SERVICE LINES, DUCTS & EXPOSED STEEL LINTELS / STRUCT. AT ALL MASONRY OPENINGS. PAINT ALL EXPOSED STRUCTURE LOCATED BETWEEN EXPOSED STRUCT. MEMBERS TYP. (ALLOW FOR 2 PAINT COLOURS FOR GYM CEILING: 1 FOR ROOF DECK, JOISTS & EXPOSED STEEL, 1 FOR MECH. DUCTWORK)
- CJ — CONTROL JOINT (ALL CONTROL JOINTS TO BE REVIEWED BY ARCHITECT @ SHOP DWG. REVIEW)

REVISIONS

NO.	DATE	PARTICULAR
1	2022.06.06	ISSUED FOR 80% CLASS B COSTING
2	2022.08.18	ISSUED FOR SPA
3	2022.09.22	ISSUED FOR OWNERS REVIEW - 98% SET
4	2022.12.16	ISSUED FOR 2nd SPA SUBMISSION
5	2023.01.31	ISSUED FOR TENDER
6	2023.02.22	ISSUED FOR ADDENDUM 9
7	2023.08.23	ISSUED FOR CONVENIENCE
8	2023.11.20	ISSUED FOR PERMIT COMMENTS
9	2024.01.24	ISSUED FOR SI#03
10	2024.02.15	ISSUED FOR PCN#008
11	2028.03.24	ISSUED FOR PCN#009R1 / CD#006
12	2024.03.10	ISSUED FOR SI#004
13	2024.05.14	ISSUED FOR SI#006
14	2024.07.22	ISSUED FOR SI#008
15	2024.08.07	ISSUED FOR SI#009
16	2024.10.02	ISSUED FOR PCN#15
17	2025.04.11	ISSUED FOR PCN#019
18	2025.05.01	ISSUED FOR CO#07
19	2025.05.28	ISSUED FOR PCN#20 - CO#010
20	2025.07.31	ISSUED FOR SI#013
21	2025.08.06	ISSUED FOR SI#014
22	2025.08.15	ISSUED FOR PCN#25 - CO#017
23	2025.08.25	ISSUED FOR PCN#27 - CO#021
24	2025.09.02	ISSUED FOR PCN#29
25	2025.09.02	ISSUED FOR SI#20 - CO#018
26	2025.09.08	ISSUED FOR PCN#31
27	2025.09.09	ISSUED FOR PCN#32 - CO#022
28	2025.09.10	ISSUED FOR PCN#33
29	2025.09.11	ISSUED FOR SI#022
30	2025.09.15	ISSUED FOR SI#023
31	2025.09.16	ISSUED FOR PCN #35 - CO#023
32	2025.09.30	ISSUED FOR PCN #37 - CO#019
33	2025.09.30	ISSUED FOR PCN #38 - CO#025
34	2025.10.06	ISSUED FOR PCN #39 - CO#024
35	2025.10.20	ISSUED FOR PCN #40R1
36	2025.10.30	ISSUED FOR PCN#041
37	2025.10.23	ISSUED FOR PCN #42
38	2025.11.21	ISSUED FOR PCN#021/R1 - CO12 CD#006
39	2025.11.14	ISSUED FOR PCN#043
40	2025.11.26	ISSUED FOR PCN#043R1
41	2025.12.03	ISSUED FOR PCN#044 - CO#026
42	2026.02.04	ISSUED FOR RECORD SET UP TO CO#27

NOTES:

KEY PLAN:



Near North District School Board

CLIENT:
NEAR NORTH DISTRICT SCHOOL BOARD
NND5B Tender # 2023-015

PROJECT:
NEW PARRY SOUND K-12 SCHOOL & CHILDCARE

PARRY SOUND HIGH SCHOOL SITE

111 ISABELLA STREET
PARRY SOUND, ONTARIO

ORIGINAL PAGE SIZE ARCH E1 - 30" x 42"

KEY TO DETAIL LOCATION:
A - DETAIL NO.
B - DETAIL NO. ORIGIN

+VG ARCHITECTS
THE VENTIN GROUP LTD

NO

FIRST FLOOR REFLECTED CEILING PLAN - CHILDCARE WING

A6.1.3


DRAWN BY : EB CHECKED BY : PS


All dimensions and measurements must be checked and verified by the General Contractor

Reproduction of drawings and related documents in whole or in part is forbidden without written permission of The Ventin Group.


Filename: K:\TVG-Brantford\Near North DSB-Parry Sound School\22111\Drawings\Wd-Current\NN-A6.1.dwg

Plot Date: Feb 03, 2026 - 5:33pm By: jkelly

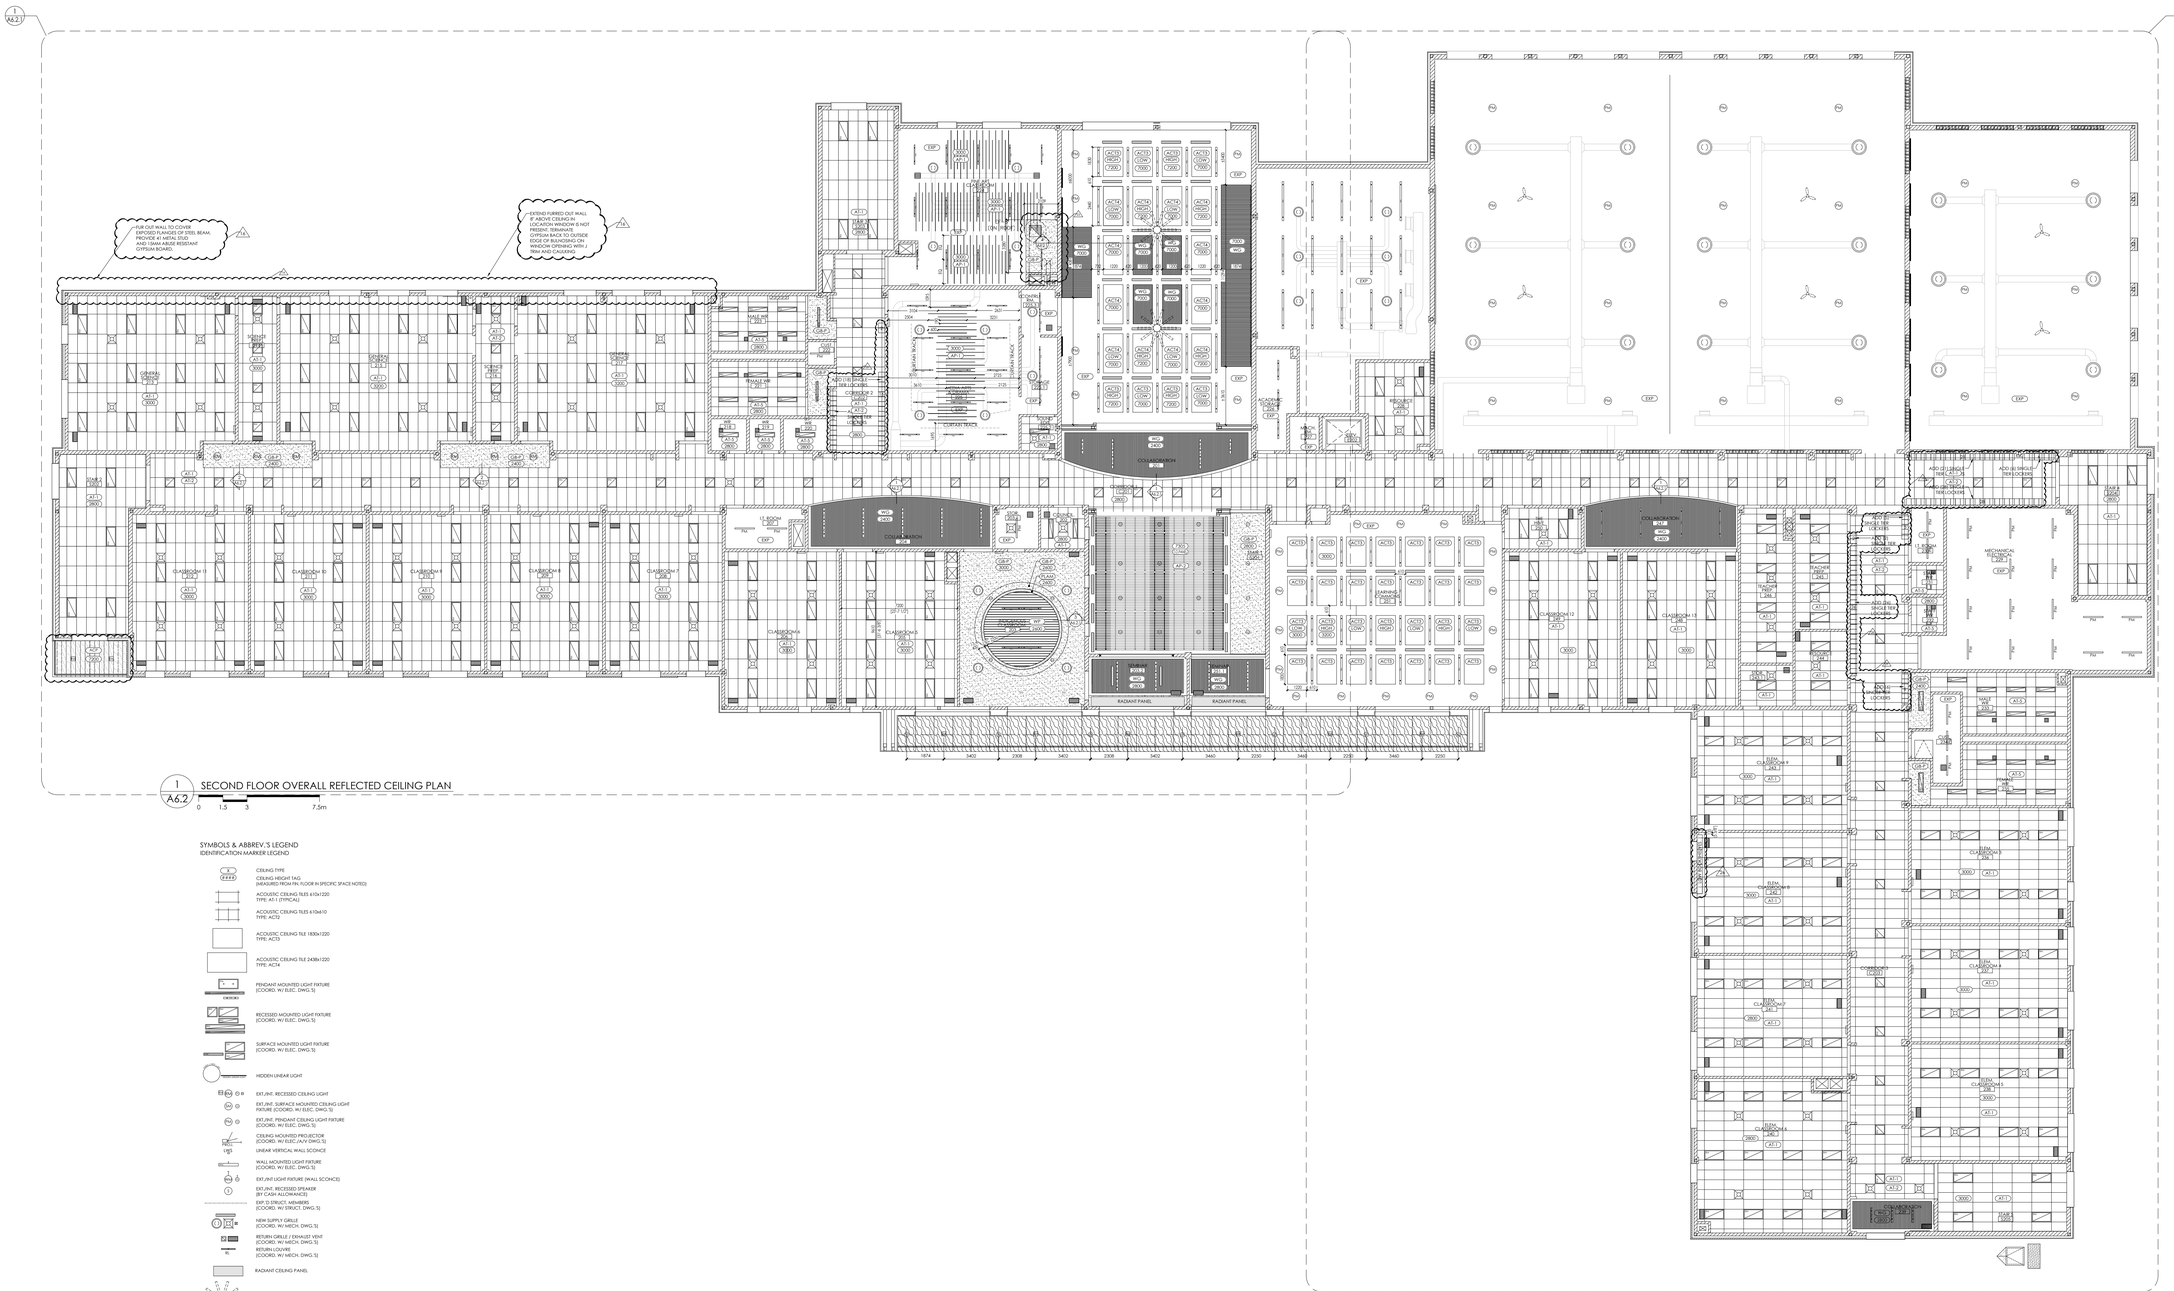

1 A6.2
1 A6.2.2
FUR OUT WALL TO COVER EXPOSED COLUMN OR STEEL BEAM. PROVIDE AT METAL STUD AND 15MM ABOVE RESISTANT GYPSUM BOARD.
EXTEND FURRED OUT WALL TO UNDERSIDE OF DECK. LOCATION: WINDOW IS NOT PRESENT. TERMINATE GYPSUM BACK TO OUTSIDE EDGE OF BULKHEADING ON WINDOW SIDE AND WITH J TRIM AND CAULKING

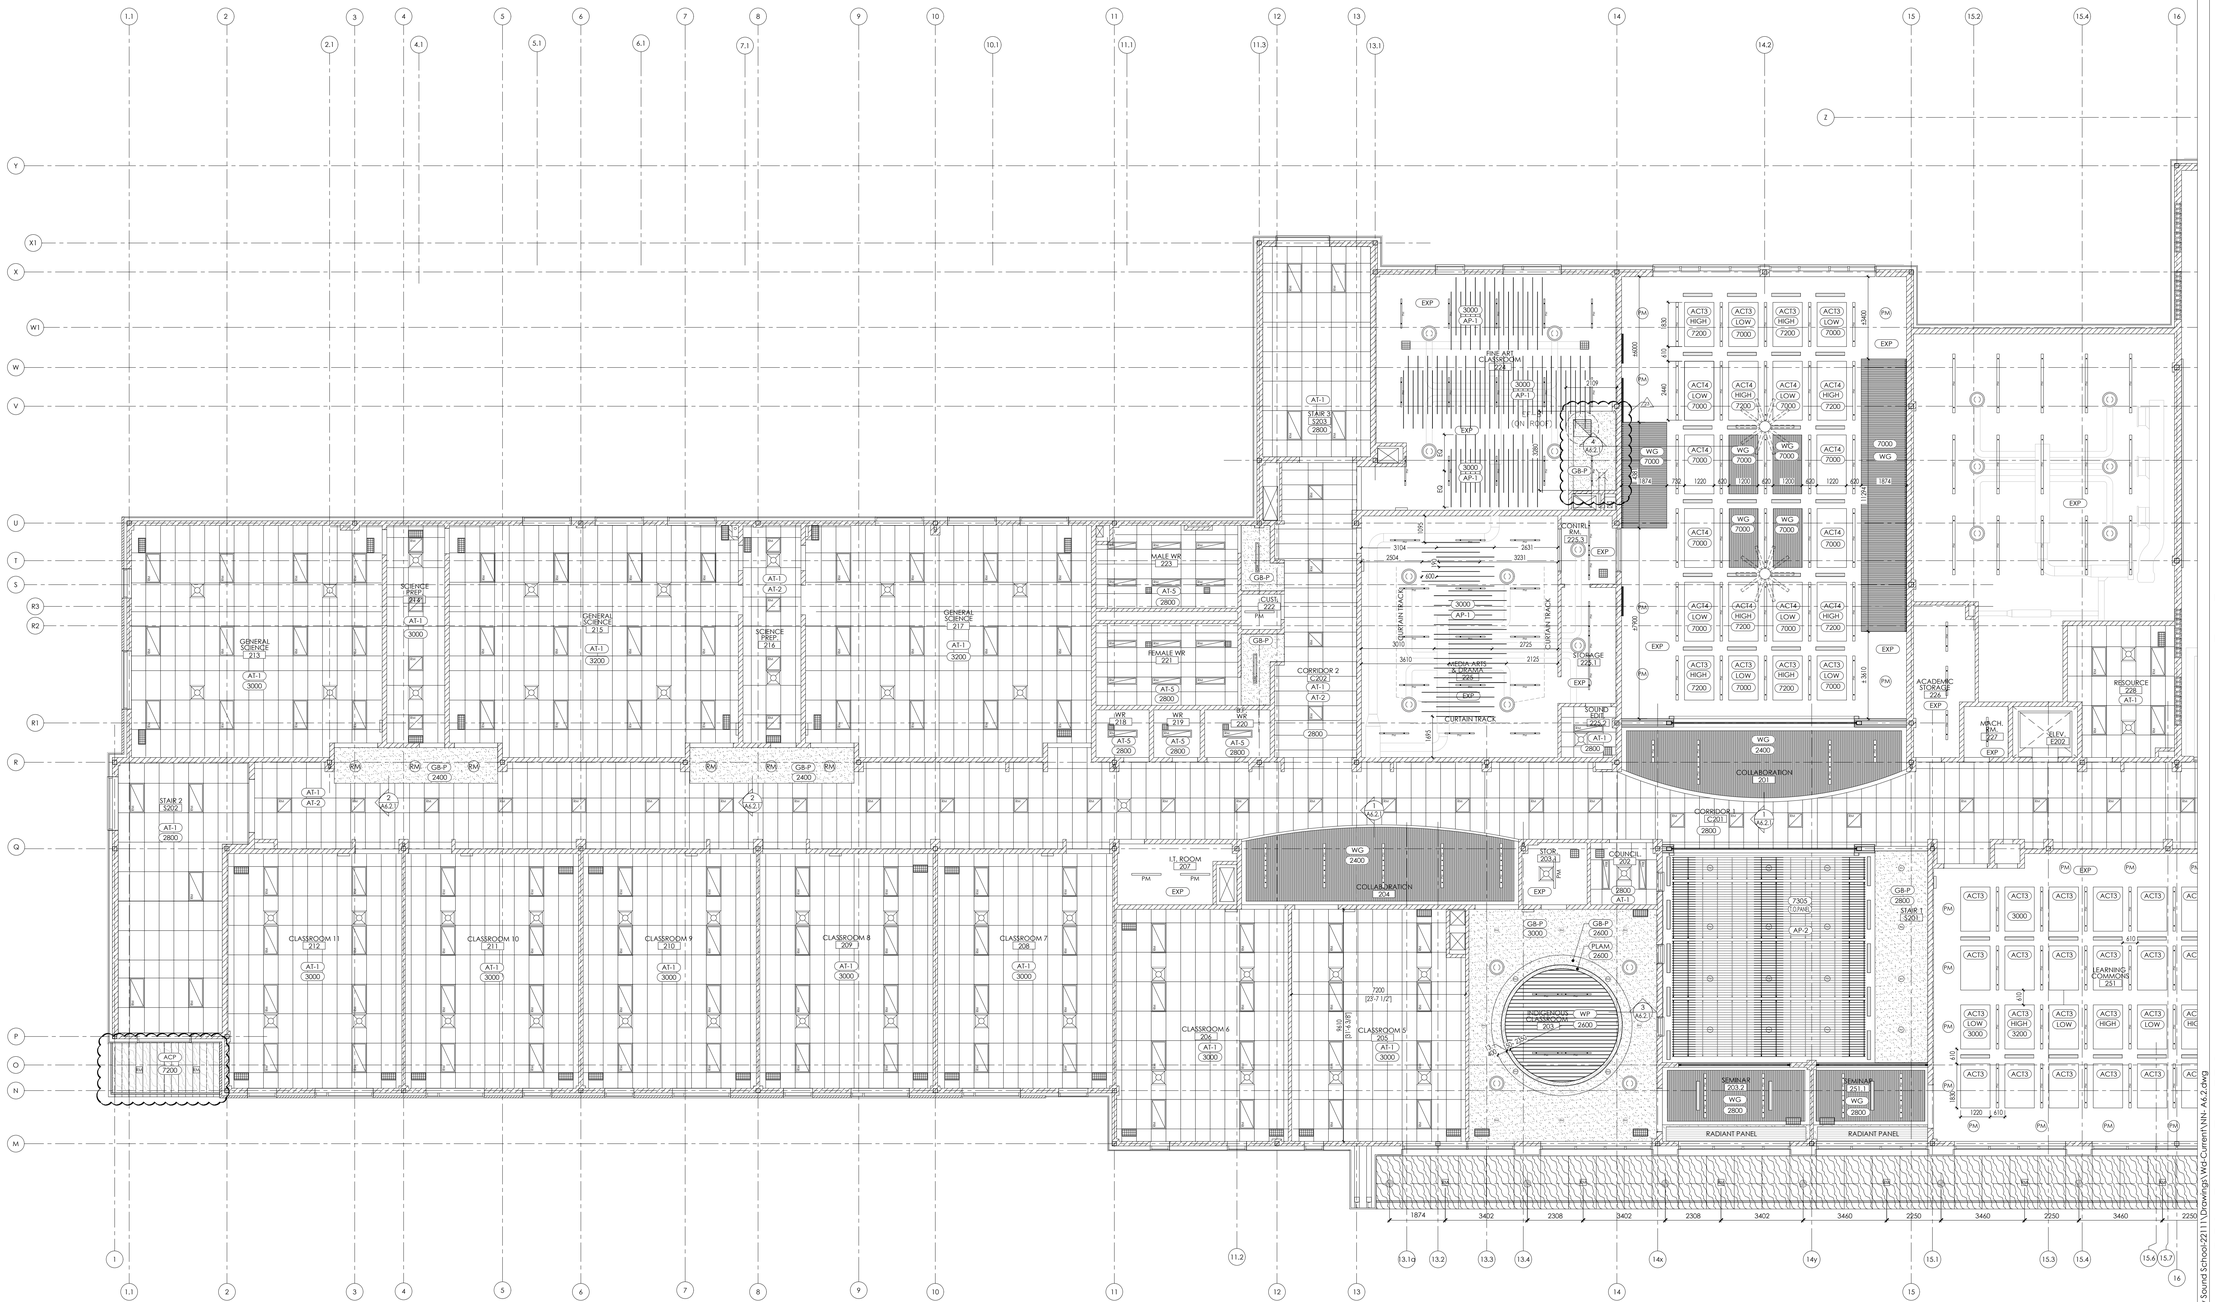


1 A6.2.1 SECOND FLOOR REFLECTED CEILING PLAN - SOUTH WING
0 1 2 5m

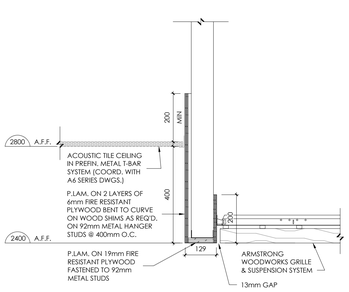


1 A6.2.1 BULKHEAD DETAIL COLLABORATION AREA
0 100 200 500mm

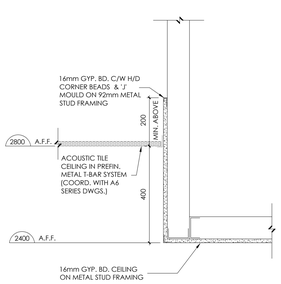

2 A6.2.1 BULKHEAD DETAIL CLASSROOM ENTRANCES
0 100 200 500mm

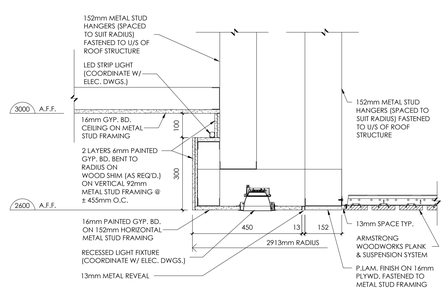

3 A6.2.1 BULKHEAD DETAIL INDIGENOUS CLASSROOM
0 100 200 500mm

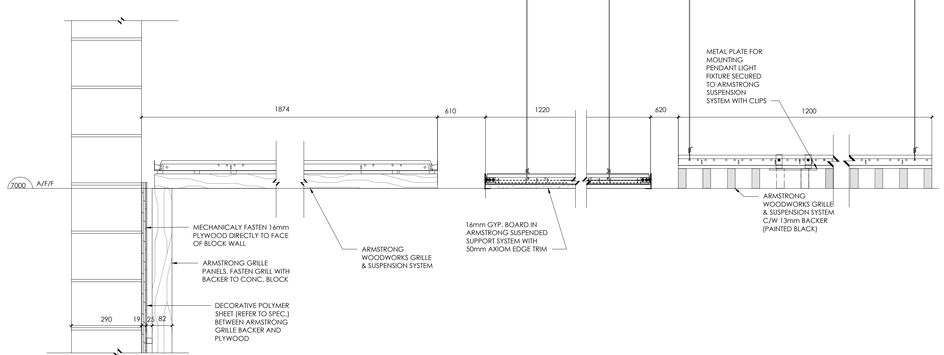


4 A6.2.1 CEILING DETAIL CAFETERIA
0 100 200 500mm

REVISIONS

NO.	DATE	PARTICULAR
1	2022.06.06	ISSUED FOR 80% CLASS B COSTING
2	2022.08.18	ISSUED FOR SPA
3	2022.09.22	ISSUED FOR OWNERS REVIEW - 98% SET
4	2022.12.16	ISSUED FOR 2nd SPA SUBMISSION
5	2023.01.31	ISSUED FOR TENDER
6	2023.02.22	ISSUED FOR ADDENDUM 9
7	2023.08.23	ISSUED FOR CONVENIENCE
8	2023.11.20	ISSUED FOR PERMIT COMMENTS
9	2024.01.24	ISSUED FOR SI#03
10	2024.02.15	ISSUED FOR PCN#008
11	2024.03.04	ISSUED FOR PCN#009
12	2024.03.10	ISSUED FOR SI#004
13	2024.05.14	ISSUED FOR SI#006
14	2024.07.22	ISSUED FOR SI#008
15	2024.08.07	ISSUED FOR SI#009
16	2024.10.02	ISSUED FOR PCN#15
17	2025.04.11	ISSUED FOR PCN#019
18	2025.05.01	ISSUED FOR CO#07
19	2025.05.28	ISSUED FOR PCN#20 - CO#010
20	2025.07.31	ISSUED FOR SI#013
21	2025.08.06	ISSUED FOR SI#014
22	2025.08.15	ISSUED FOR PCN#25 - CO#017
23	2025.08.25	ISSUED FOR PCN#27 - CO#021
24	2025.09.02	ISSUED FOR PCN#29
25	2025.09.02	ISSUED FOR SI#20 - CO#018
26	2025.09.08	ISSUED FOR PCN#31
27	2025.09.09	ISSUED FOR PCN#32 - CO#022
28	2025.09.10	ISSUED FOR PCN#33
29	2025.09.11	ISSUED FOR SI#022
30	2025.09.15	ISSUED FOR SI#023
31	2025.09.16	ISSUED FOR PCN #35 - CO#023
32	2025.09.30	ISSUED FOR PCN #37 - CO#029
33	2025.09.30	ISSUED FOR PCN #38 - CO#025
34	2025.10.06	ISSUED FOR PCN #39 - CO#024
35	2025.10.20	ISSUED FOR PCN #4081
36	2025.10.30	ISSUED FOR PCN#041
37	2025.10.23	ISSUED FOR PCN #42
38	2025.11.21	ISSUED FOR PCN#021/R1 - CO12 CD#006
39	2025.11.14	ISSUED FOR PCN#043
40	2025.11.26	ISSUED FOR PCN#043R1
41	2025.12.03	ISSUED FOR PCN#044 - CO#026
42	2026.02.04	ISSUED FOR RECORD SET UP TO CO#27

NOTES:

KEY PLAN:

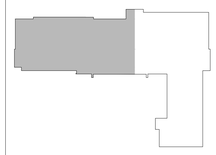

All dimensions and measurements must be checked and verified by the General Contractor

Reproduction of drawings and related documents in whole or in part is forbidden without written permission of The Ventin Group.

Near North District School Board

CLIENT:
NEAR NORTH DISTRICT SCHOOL BOARD
NNDSB Tender # 2023-015

PROJECT:
NEW PARRY SOUND K-12 SCHOOL & CHILDCARE

PARRY SOUND HIGH SCHOOL SITE

111 ISABELLA STREET
PARRY SOUND, ONTARIO

ORIGINAL PAGE SIZE ARCH E1 - 30" x 42"

KEY TO DETAIL LOCATION:
(A) A - DETAIL NO.
(B) B - DETAIL NO. ORIGIN


+VG ARCHITECTS
THE VENTIN GROUP LTD

SECOND FLOOR REFLECTED CEILING PLAN - SOUTH WING

A6.2.1


Plot Date: Feb 03, 2026 - 5:34pm By: jkelly Filename: K:\1VG-Brantford\Near North DSB Parry Sound School\2211 Drawings\1 WD\Current NN\ - A6.2.dwg

DRAWN BY : EB CHECKED BY : PS

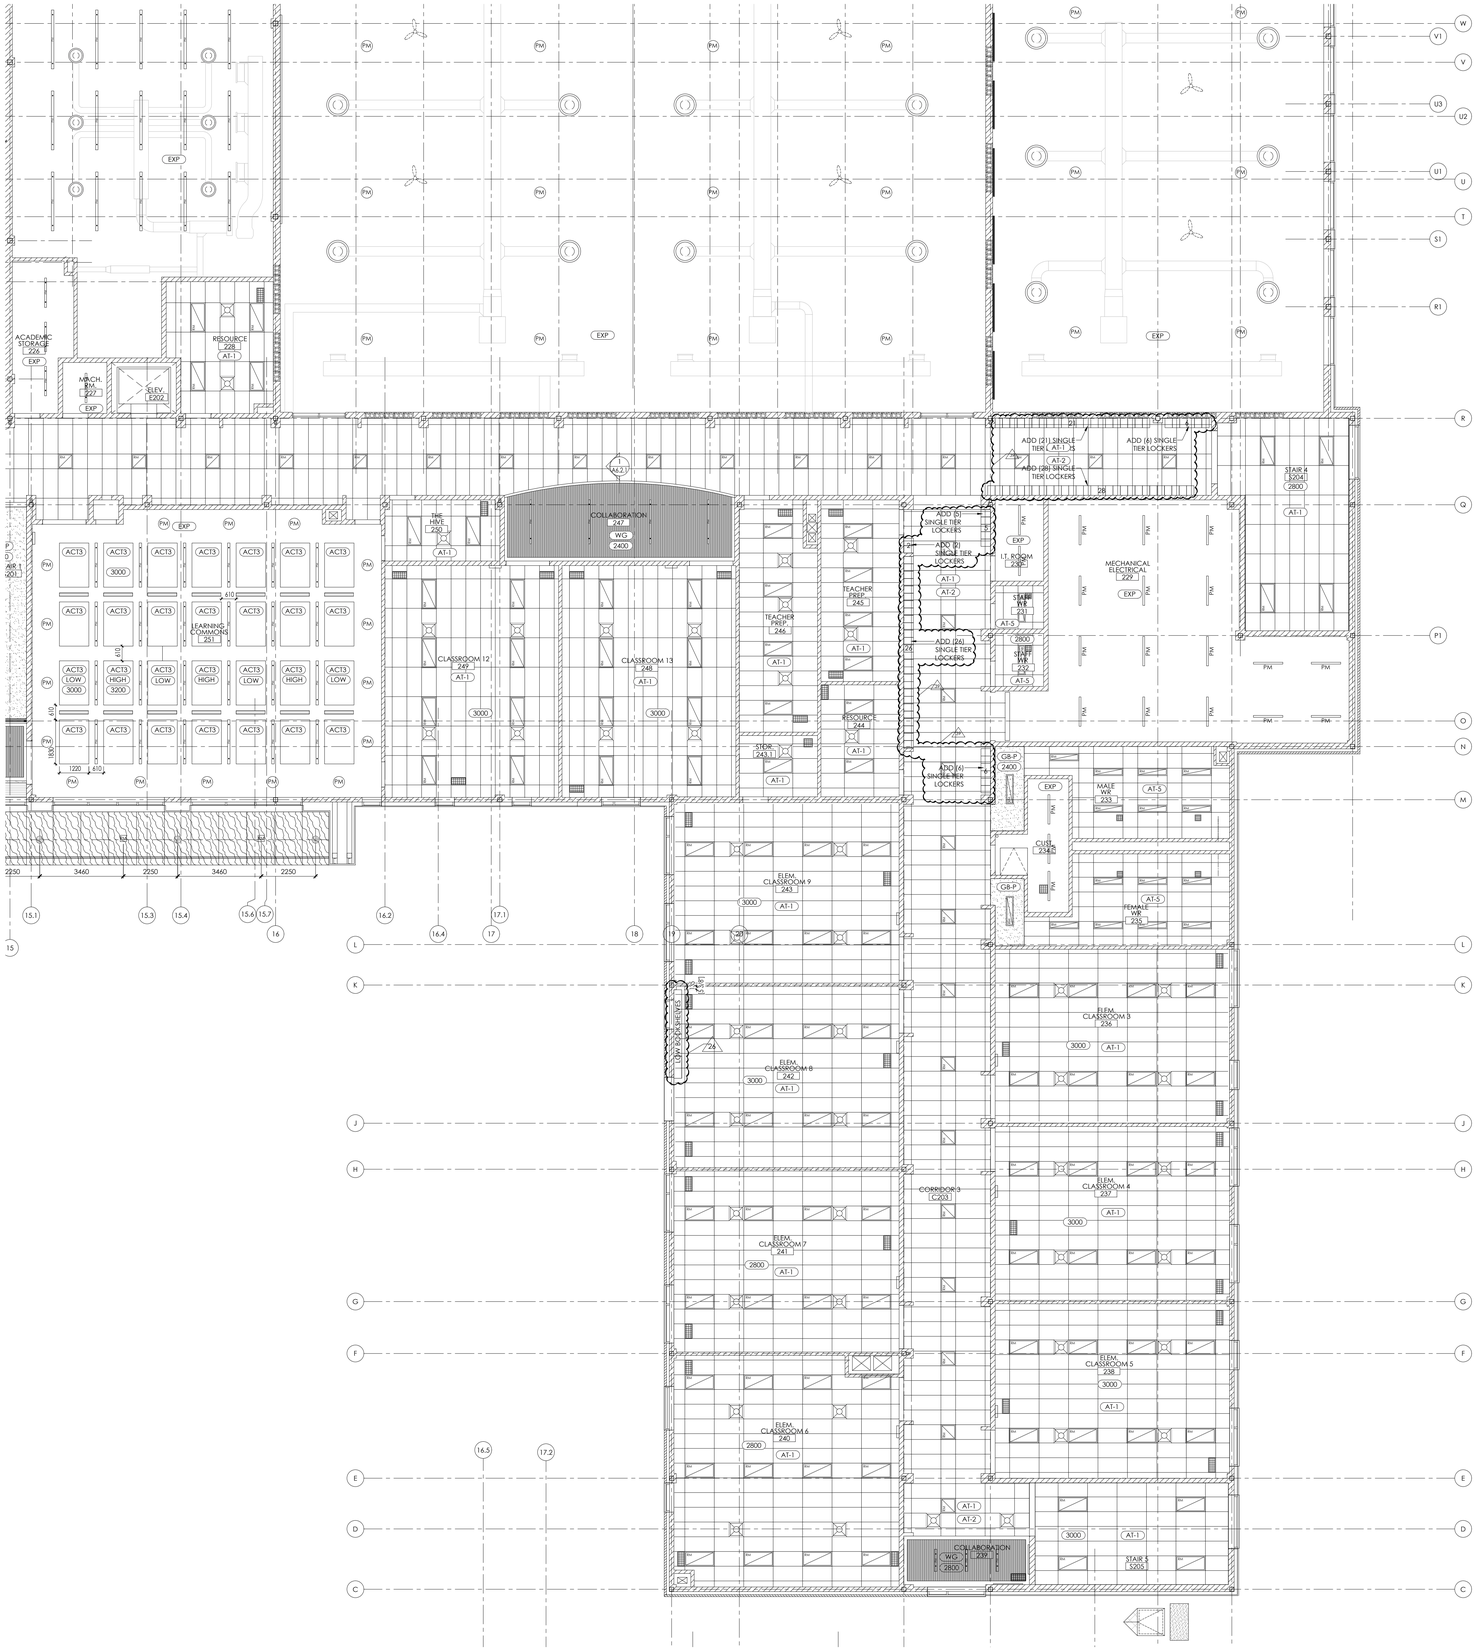

1 A6.2.2 SECOND FLOOR REFLECTED CEILING PLAN - NORTH & CHILDCARE WING

0 1 2 5m

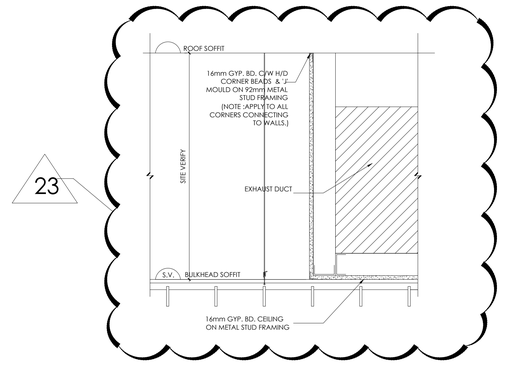

2 A6.2.2 BULKHEAD FINE ARTS CLASSROOM


0 100 200 500mm

REVISIONS

NO.	DATE	PARTICULAR
1	2022.06.06	ISSUED FOR 80% CLASS B COSTING
2	2022.08.18	ISSUED FOR SPA
3	2022.09.22	ISSUED FOR OWNERS REVIEW - 98% SET
4	2022.12.16	ISSUED FOR 2nd SPA SUBMISSION
5	2023.01.31	ISSUED FOR TENDER
6	2023.02.22	ISSUED FOR ADDENDUM 9
7	2023.08.23	ISSUED FOR CONVENIENCE
8	2023.11.20	ISSUED FOR PERMIT COMMENTS
9	2024.01.24	ISSUED FOR SI#03
10	2024.02.15	ISSUED FOR PCN#008
11	2024.03.04	ISSUED FOR PCN#009
12	2024.03.10	ISSUED FOR SI#004
13	2024.05.14	ISSUED FOR SI#006
14	2024.07.22	ISSUED FOR SI#008
15	2024.08.07	ISSUED FOR SI#009
16	2024.10.02	ISSUED FOR PCN#15
17	2025.04.11	ISSUED FOR PCN#019
18	2025.05.01	ISSUED FOR CO#07
19	2025.05.28	ISSUED FOR PCN#20 - CO#010
20	2025.07.31	ISSUED FOR SI#013
21	2025.08.06	ISSUED FOR SI#014
22	2025.08.15	ISSUED FOR PCN#25 - CO#017
23	2025.08.25	ISSUED FOR PCN#27 - CO#021
24	2025.09.02	ISSUED FOR PCN#29
25	2025.09.02	ISSUED FOR SI#20 - CO#018
26	2025.09.08	ISSUED FOR PCN#31
27	2025.09.09	ISSUED FOR PCN#32 - CO#022
28	2025.09.10	ISSUED FOR SI#33
29	2025.09.11	ISSUED FOR SI#022
30	2025.09.15	ISSUED FOR SI#023
31	2025.09.16	ISSUED FOR PCN #35 - CO#023
32	2025.09.30	ISSUED FOR PCN #37 - CO#029
33	2025.09.30	ISSUED FOR PCN #38 - CO#025
34	2025.10.06	ISSUED FOR PCN #39 - CO#024
35	2025.10.20	ISSUED FOR PCN #4081
36	2025.10.30	ISSUED FOR PCN#041
37	2025.10.23	ISSUED FOR PCN #42
38	2025.11.21	ISSUED FOR PCN#021/R1 - CO12 CD#006
39	2025.11.14	ISSUED FOR PCN#043
40	2025.11.26	ISSUED FOR PCN#043R1
41	2025.12.03	ISSUED FOR PCN#044 - CO#026
42	2026.02.04	ISSUED FOR RECORD SET UP TO CO#27

NOTES:

KEY PLAN:

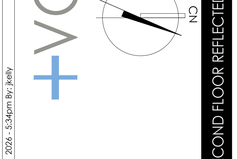

All dimensions and measurements must be checked and verified by the General Contractor

Reproduction of drawings and related documents in whole or in part is forbidden without written permission of the Ventin Group.

Filename: K:\1VG-Brantford\Near North DSB Parry Sound School\22111\Drawings\Wed-Current\NN-A6.2.dwg

Plot Date: Feb 03, 2026 - 5:54pm By: jkelly

Near North District School Board

CLIENT:
NEAR NORTH DISTRICT SCHOOL BOARD
NNDSB Tender # 2023-015

PROJECT:
NEW PARRY SOUND K-12 SCHOOL & CHILDCARE

PARRY SOUND HIGH SCHOOL SITE

111 ISABELLA STREET
PARRY SOUND, ONTARIO

ORIGINAL PAGE SIZE ARCH E1 - 30" x 42"


KEY TO DETAIL LOCATION:
A - DETAIL NO.
B - DETAIL NO. ORIGIN

+VG ARCHITECTS
THE VENTIN GROUP LTD

SECOND FLOOR REFLECTED CEILING PLAN - NORTH & CHILDCARE WING


A6.2.2

DRAWN BY : EB CHECKED BY : PS

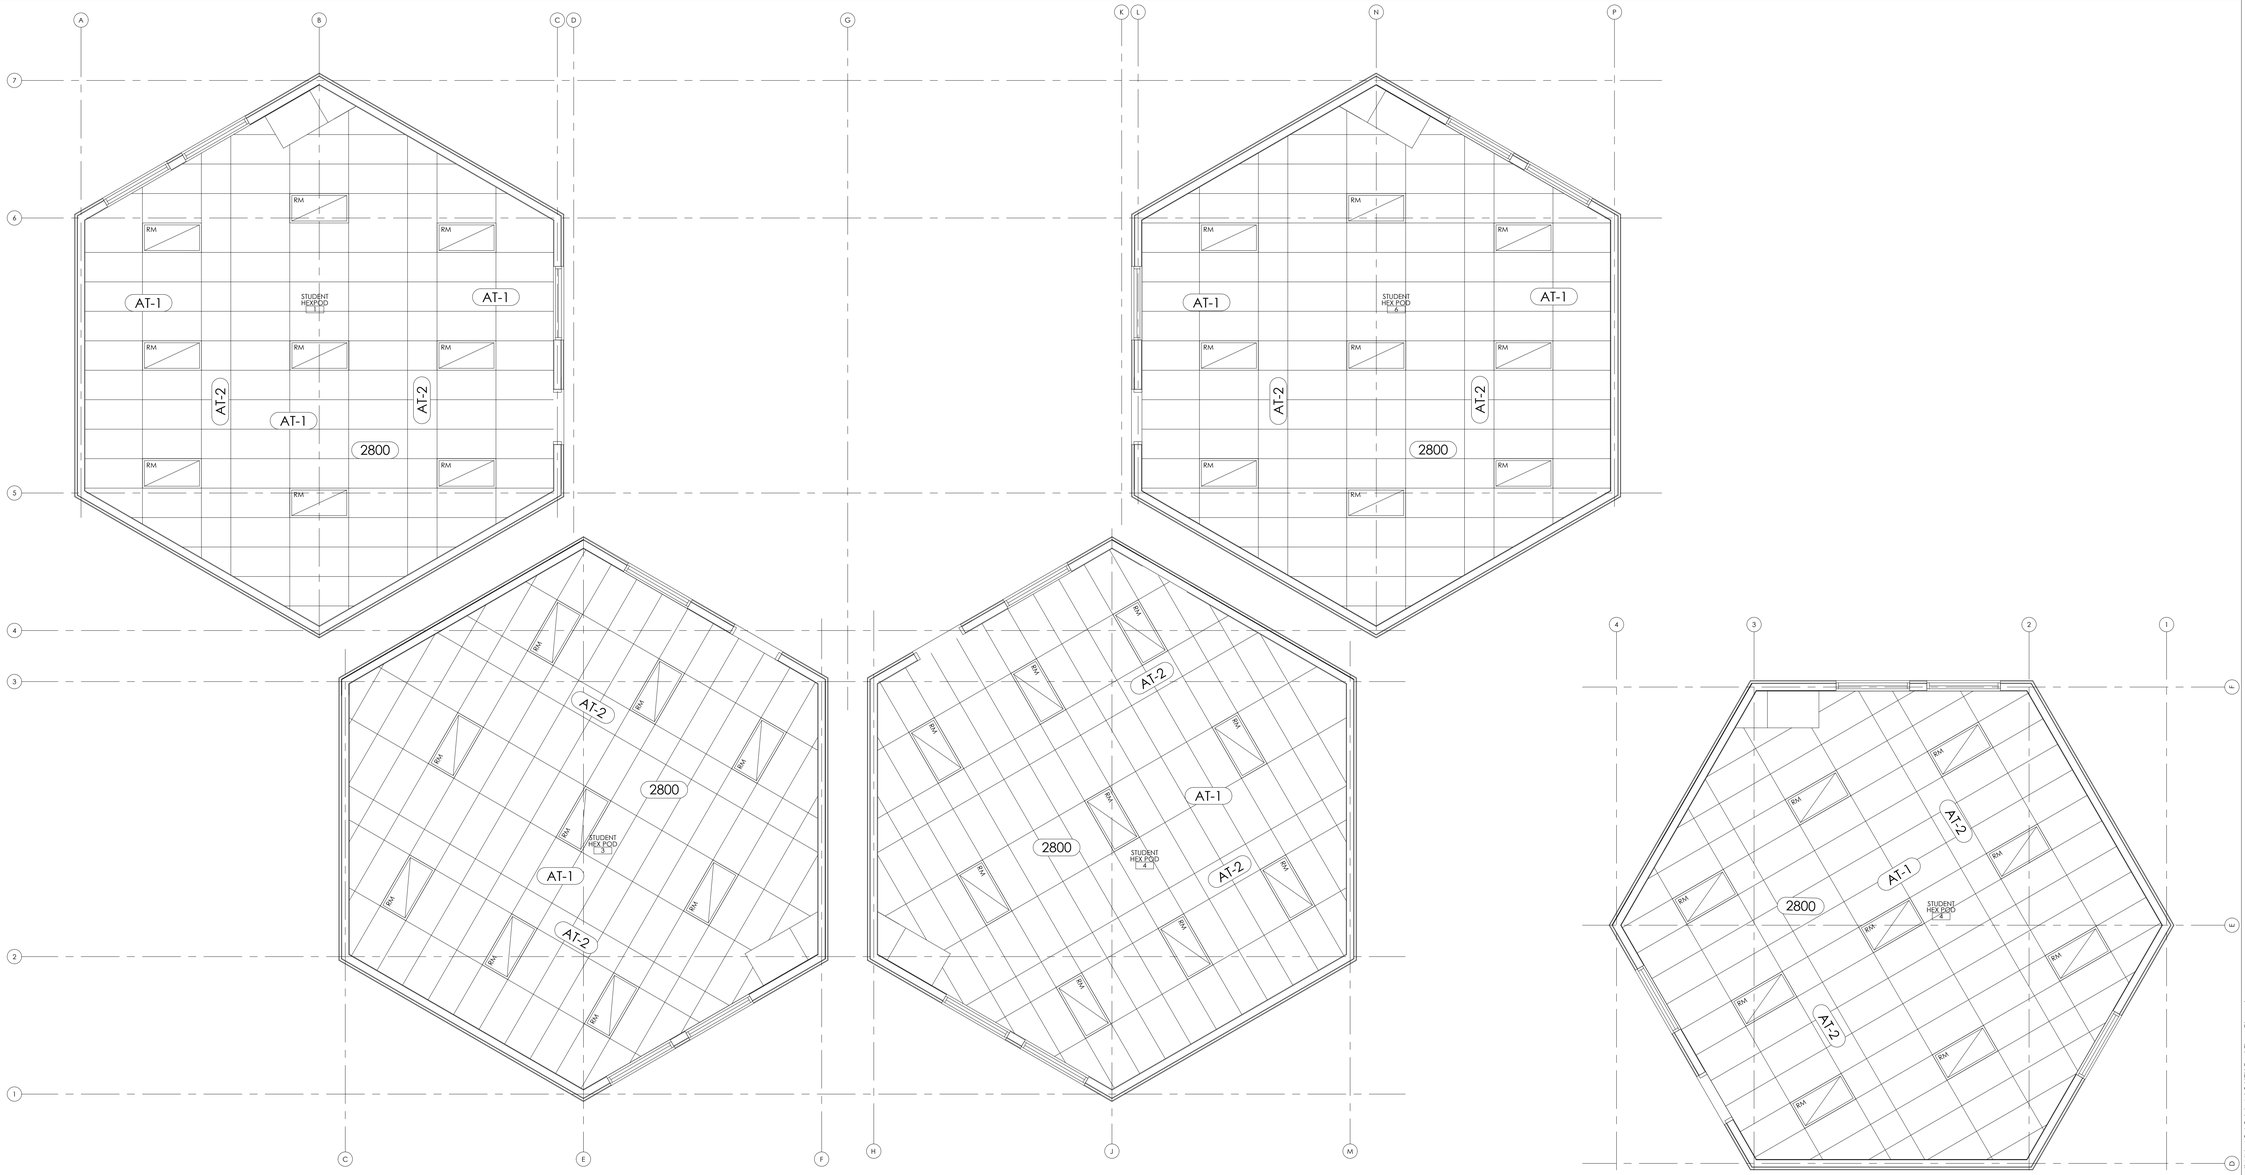

1 A6.3 REFLECTED CEILING PLAN - QUAD POD
0 500 1000 2500mm

HEXPOD PORTABLE CLASSROOM DRAWINGS ARE SHOWN HERE FOR REFERENCE ONLY.
PORTABLE CLASSROOMS & FOUNDATIONS, WOOD DECKS & RAMPS TO BE PROVIDED EBS AND PAID FOR OUT OF THE CASH ALLOWANCE.

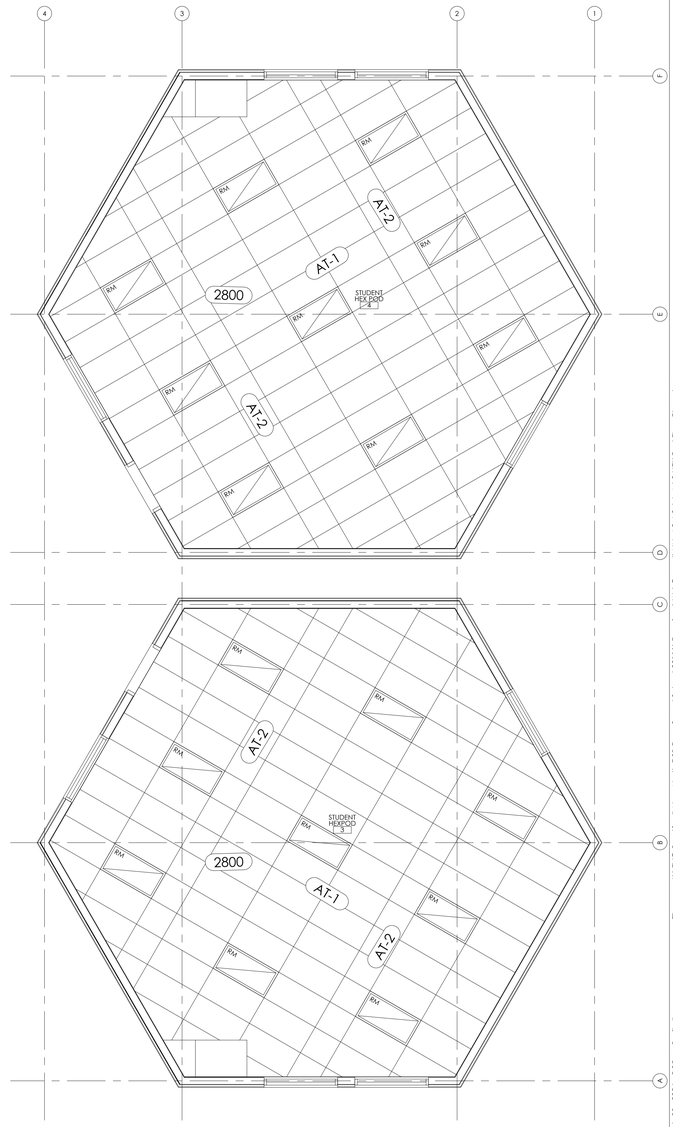

2 A6.3 REFLECTED CEILING PLAN - DUO POD
0 500 1000 2500mm

REVISIONS

NO.	DATE	PARTICULAR
1	2022.06.06	ISSUED FOR 80% CLASS B COSTING
2	2022.08.18	ISSUED FOR SPA
3	2022.09.22	ISSUED FOR OWNERS REVIEW - 98% SET
4	2022.12.16	ISSUED FOR 2nd SPA SUBMISSION
5	2023.01.31	ISSUED FOR TENDER
6	2023.02.22	ISSUED FOR ADDENDUM 9
7	2023.08.23	ISSUED FOR CONVENIENCE
8	2023.11.20	ISSUED FOR PERMIT COMMENTS
9	2024.07.24	ISSUED FOR PORTABLE PERMIT
10	2024.02.15	ISSUED FOR PCN#008
11	2024.03.04	ISSUED FOR PCN#009
12	2024.03.10	ISSUED FOR SI#004
13	2024.05.14	ISSUED FOR SI#006
14	2024.07.22	ISSUED FOR SI#008
15	2024.08.07	ISSUED FOR SI#009
16	2024.10.02	ISSUED FOR PCN#15
17	2025.04.11	ISSUED FOR PCN#019
18	2025.05.01	ISSUED FOR CO#07
19	2025.05.28	ISSUED FOR PCN#20 - CO#010
20	2025.07.31	ISSUED FOR SI#013
21	2025.08.06	ISSUED FOR SI#014
22	2025.08.15	ISSUED FOR PCN#25 - CO#017
23	2025.08.25	ISSUED FOR PCN#27 - CO#021
24	2025.09.02	ISSUED FOR PCN#29
25	2025.09.02	ISSUED FOR SI#20 - CO#018
26	2025.09.08	ISSUED FOR PCN#31
27	2025.09.09	ISSUED FOR PCN#32 - CO#022
28	2025.09.10	ISSUED FOR PCN#33
29	2025.09.11	ISSUED FOR SI#022
30	2025.09.15	ISSUED FOR SI#023
31	2025.09.16	ISSUED FOR PCN #35 - CO#023
32	2025.09.30	ISSUED FOR PCN #37 - CO#029
33	2025.09.30	ISSUED FOR PCN #38 - CO#025
34	2025.10.06	ISSUED FOR PCN #39 - CO#024
35	2025.10.20	ISSUED FOR PCN #40R1
36	2025.10.30	ISSUED FOR PCN#041
37	2025.10.23	ISSUED FOR PCN #42
38	2025.11.21	ISSUED FOR PCN#021/R1 - CO12 CD#006
39	2025.11.14	ISSUED FOR PCN#043
40	2025.11.26	ISSUED FOR PCN#043R1
41	2025.12.03	ISSUED FOR PCN#044 - CO#026
42	2026.02.04	ISSUED FOR RECORD SET UP TO CO#27

NOTES:

KEY PLAN:

All dimensions and measurements must be checked and verified by the General Contractor

Reproduction of drawings and related documents in whole or in part is forbidden without written permission of the VenTin Group.

Near North District School Board

CLIENT:
NEAR NORTH DISTRICT SCHOOL BOARD
NNDSB Tender # 2023-015

PROJECT:
NEW PARRY SOUND K-12 SCHOOL & CHILDCARE

PARRY SOUND HIGH SCHOOL SITE

111 ISABELLA STREET
PARRY SOUND, ONTARIO


ORIGINAL PAGE SIZE ARCH E1 - 30" x 42"
KEY TO DETAIL LOCATION:
A - DETAIL NO.
B - DETAIL NO. ORIGIN


+VG ARCHITECTS
THE VENTIN GROUP LTD

HEX PODS - REFLECTED CEILING PLAN (CASH ALLOWANCE)

A6.3

Filename: K:\VG-Brantford\Near North DSB Parry Sound School\2211\Drawings\Wd Current\Nth A2.4,2.6 & A6.3 HEX Pod Floor Plans.dwg
Plot Date: Feb 03, 2026 - 5:35pm By: jkelly
DRAWN BY : SR
CHECKED BY : EB

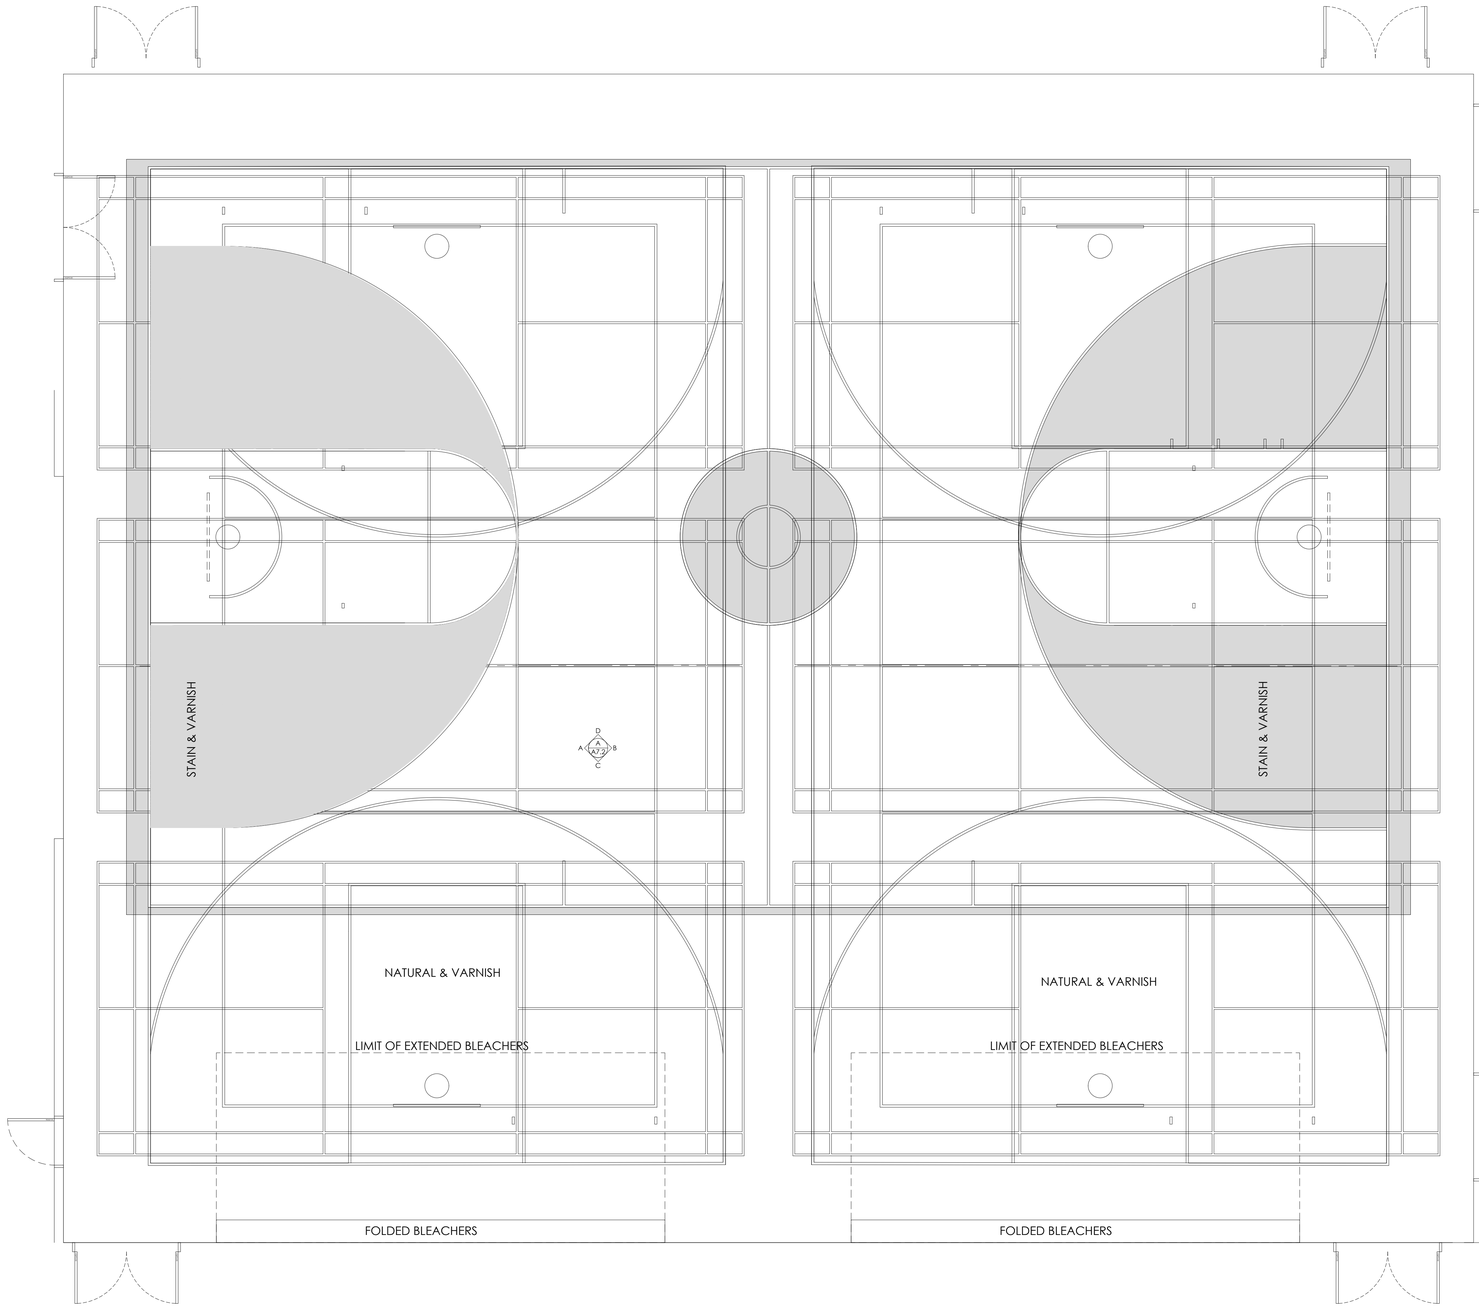

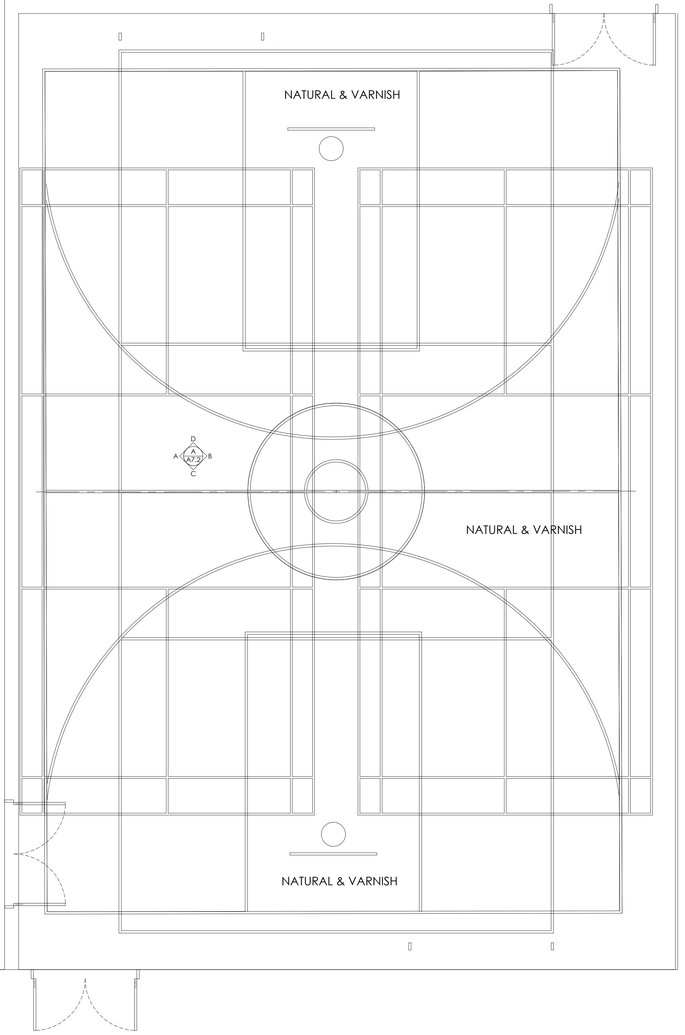


REVISIONS

NO.	DATE	PARTICULAR
1	2022.06.06	ISSUED FOR 80% CLASS B COSTING
2	2022.08.18	ISSUED FOR SPA
3	2022.09.22	ISSUED FOR OWNERS REVIEW - 98% SET
4	2022.12.16	ISSUED FOR 2nd SPA SUBMISSION
5	2023.01.31	ISSUED FOR TENDER
6	2023.02.22	ISSUED FOR ADDENDUM 9
7	2023.08.23	ISSUED FOR CONVENIENCE
8	2023.11.20	ISSUED FOR PERMIT COMMENTS
9	2024.01.24	ISSUED FOR SI#03
10	2024.02.15	ISSUED FOR PCN#008
11	2024.03.04	ISSUED FOR PCN#009
12	2024.03.10	ISSUED FOR SI#004
13	2024.05.14	ISSUED FOR SI#006
14	2024.07.22	ISSUED FOR SI#008
15	2024.08.07	ISSUED FOR SI#009
16	2024.10.02	ISSUED FOR PCN#15
17	2025.04.11	ISSUED FOR PCN#019
18	2025.05.01	ISSUED FOR CO#07
19	2025.05.28	ISSUED FOR PCN#20 - CO#010
20	2025.07.31	ISSUED FOR SI#013
21	2025.08.06	ISSUED FOR SI#014
22	2025.08.15	ISSUED FOR PCN#25 - CO#017
23	2025.08.25	ISSUED FOR PCN#27 - CO#021
24	2025.09.02	ISSUED FOR PCN#29
25	2025.09.02	ISSUED FOR SI#20 - CO#018
26	2025.09.08	ISSUED FOR PCN#31
27	2025.09.09	ISSUED FOR PCN#32 - CO#022
28	2025.09.10	ISSUED FOR PCN#33
29	2025.09.11	ISSUED FOR SI#022
30	2025.09.15	ISSUED FOR SI#023
31	2025.09.16	ISSUED FOR PCN #35 - CO#023
32	2025.09.30	ISSUED FOR PCN #37 - CO#029
33	2025.09.30	ISSUED FOR PCN #38 - CO#025
34	2025.10.06	ISSUED FOR PCN #39 - CO#024
35	2025.10.20	ISSUED FOR PCN #40R1
36	2025.10.30	ISSUED FOR PCN#041
37	2025.10.23	ISSUED FOR PCN #42
38	2025.11.21	ISSUED FOR PCN#021/R1 - CO12 CD#006
39	2025.11.14	ISSUED FOR PCN#043
40	2025.11.26	ISSUED FOR PCN#043R1
41	2025.12.03	ISSUED FOR PCN#044 - CO#026
42	2026.02.04	ISSUED FOR RECORD SET UP TO CO#27

NOTES:

KEY PLAN:

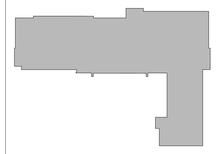

All dimensions and measurements must be checked and verified by the General Contractor

Reproduction of drawings and related documents in whole or in part is forbidden without written permission of the Ventin Group.

Near North District School Board

CLIENT:
NEAR NORTH DISTRICT SCHOOL BOARD
NND5B Tender # 2023-015

PROJECT:
NEW PARRY SOUND K-12 SCHOOL & CHILDCARE

PARRY SOUND HIGH SCHOOL SITE

111 ISABELLA STREET
PARRY SOUND, ONTARIO

ORIGINAL PAGE SIZE ARCH E1 - 30" x 42"

KEY TO DETAIL LOCATION:
A - DETAIL NO.
B - DETAIL NO. ORIGIN


+VG ARCHITECTS
THE VENTIN GROUP LTD

GYMNASIUM COURT LAYOUTS

A7.1


DRAWN BY : EB/KH CHECKED BY : XX

Plot Date: Feb 03, 2026 - 5:35pm By: jkelly Filename: K:\TVG-Brantford\Near North DSB-Parry Sound School\2211\Drawings\ Wd Current\NN-A7.1 gym layout.dwg

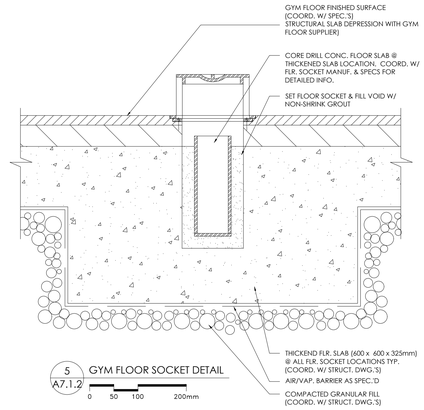


5 A7.1.2 GYM FLOOR SOCKET DETAIL

0 50 100 200mm

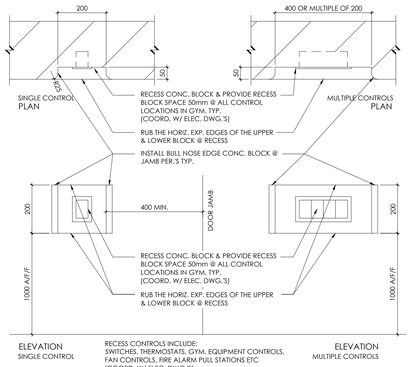

4 A7.1.2 RECESSED CONTROLS IN GYMNASIUM


0 100 200 500mm

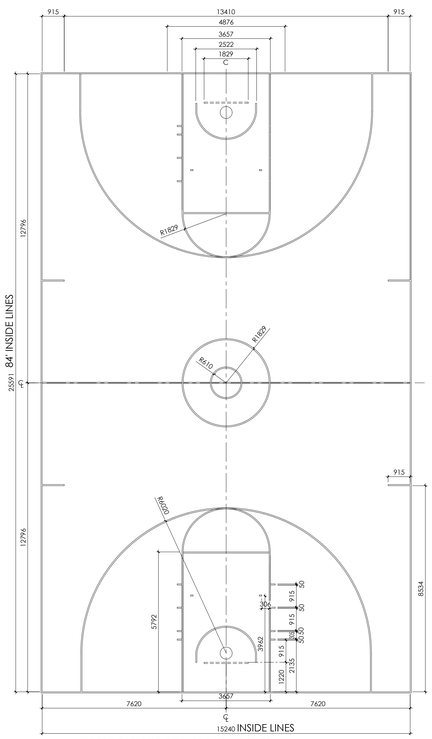

LINES TO BE BLACK COLOUR 50mm INT. & 100mm EXT. WIDE

6 A7.1.2 MAIN BASKETBALL COURT LAYOUT


0 1 2 5m

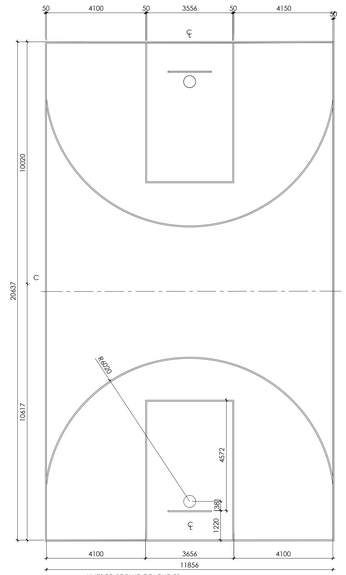

LINES TO BE BLUE COLOUR 50mm

7 A7.1.2 PRACTICE BASKETBALL COURT LAYOUT

0 1 2 5m

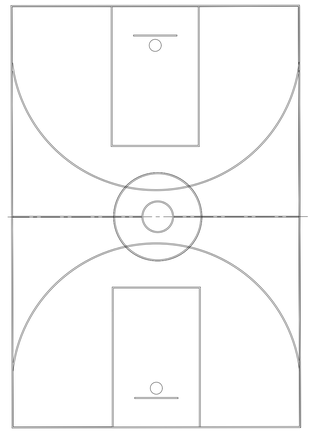


LEGEND

BFS - BADMINTON FLOOR SOCKET

VFS - VOLLEYBALL FLOOR SOCKET


GENERAL NOTES

1. ALL COURT LAYOUTS, LOCATIONS, COLOURS ETC. TO BE VERIFIED PRIOR TO CONSTRUCTION
2. THE COURT LINE OVERLAPPING IN ORDER OF PRIORITY SHALL BE:
   A. MAIN BASKETBALL GAME LINES: BLACK COLOUR - 50mm WIDE - INTERIOR BLACK COLOUR - 100mm WIDE - PERIMETER
   B. PRACTICE BASKETBALL GAME LINES: BLUE COLOUR - 50mm WIDE
   C. VOLLEYBALL GAME LINES: RED COLOUR - 50mm THICK
   D. PRACTICE VOLLEYBALL GAME LINES; GREEN COLOUR - 50mm THICK
   E. MAIN BADMINTON GAME LINES: YELLOW COLOUR - 38mm WIDE
3. GYM FLOOR TO BE HARDWOOD WITH PAINTED GAME LINES REFER TO SPECIFICATIONS

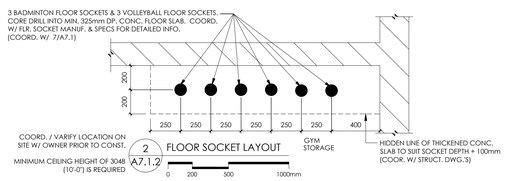


2 A7.1.2 FLOOR SOCKET LAYOUT

0 200 500 1000mm

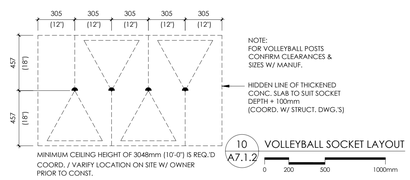


10 A7.1.2 VOLLEYBALL SOCKET LAYOUT

0 200 500 1000mm

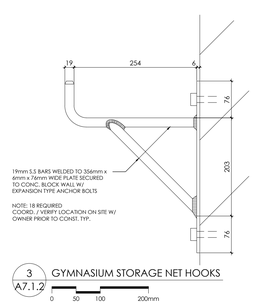

3 A7.1.2 GYMNASIUM STORAGE NET HOOKS

0 50 100 200mm

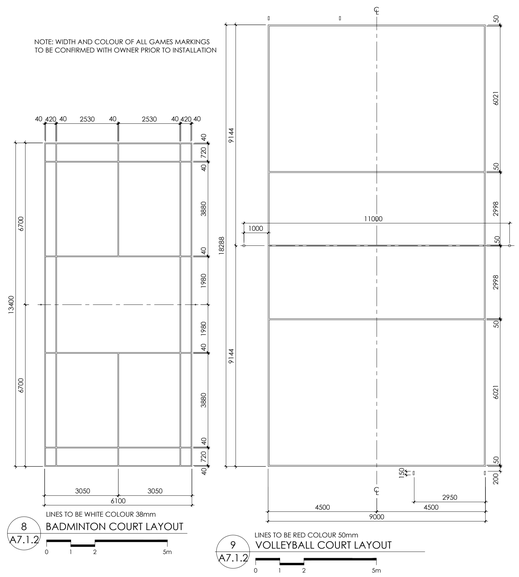

8 A7.1.2 BADMINTON COURT LAYOUT

0 1 2 5m

LINES TO BE RED COLOUR 50mm

9 A7.1.2 VOLLEYBALL COURT LAYOUT

0 1 2 5m

REVISIONS

NO.	DATE	PARTICULAR
1	2022.06.06	ISSUED FOR 80% CLASS B COSTING
2	2022.08.18	ISSUED FOR SPA
3	2022.09.22	ISSUED FOR OWNERS REVIEW - 98% SET
4	2022.12.16	ISSUED FOR 2nd SPA SUBMISSION
5	2023.01.31	ISSUED FOR TENDER
6	2023.02.22	ISSUED FOR ADDENDUM 9
7	2023.08.23	ISSUED FOR CONVENIENCE
8	2023.11.20	ISSUED FOR PERMIT COMMENTS
9	2024.01.24	ISSUED FOR SI#03
10	2024.02.15	ISSUED FOR PCN#008
11	2024.03.04	ISSUED FOR PCN#009
12	2024.03.10	ISSUED FOR SI#004
13	2024.05.14	ISSUED FOR SI#006
14	2024.07.22	ISSUED FOR SI#008
15	2024.08.07	ISSUED FOR SI#009
16	2024.10.02	ISSUED FOR PCN#15
17	2025.04.11	ISSUED FOR PCN#019
18	2025.05.01	ISSUED FOR CO#07
19	2025.05.28	ISSUED FOR PCN#20 - CO#010
20	2025.07.31	ISSUED FOR SI#013
21	2025.08.06	ISSUED FOR SI#014
22	2025.08.15	ISSUED FOR PCN#25 - CO#017
23	2025.08.25	ISSUED FOR PCN#27 - CO#021
24	2025.09.02	ISSUED FOR PCN#29
25	2025.09.02	ISSUED FOR SI#20 - CO#018
26	2025.09.08	ISSUED FOR PCN#31
27	2025.09.09	ISSUED FOR PCN#32 - CO#022
28	2025.09.10	ISSUED FOR PCN#33
29	2025.09.11	ISSUED FOR SI#022
30	2025.09.15	ISSUED FOR SI#023
31	2025.09.16	ISSUED FOR PCN #35 - CO#023
32	2025.09.30	ISSUED FOR PCN #37 - CO#019
33	2025.09.30	ISSUED FOR PCN #38 - CO#025
34	2025.10.06	ISSUED FOR PCN #39 - CO#024
35	2025.10.20	ISSUED FOR PCN #40R1
36	2025.10.30	ISSUED FOR PCN#041
37	2025.10.23	ISSUED FOR PCN #42
38	2025.11.21	ISSUED FOR PCN#021/R1 - CO12 CD#006
39	2025.11.14	ISSUED FOR PCN#043
40	2025.11.26	ISSUED FOR PCN#043R1
41	2025.12.03	ISSUED FOR PCN#044 - CO#026
42	2026.02.04	ISSUED FOR RECORD SET UP TO CO#27

NOTES:

KEY PLAN:

All dimensions and measurements must be checked and verified by the General Contractor

Reproduction of drawings and related documents in whole or in part is forbidden without written permission of the Ventin Group.

Near North District School Board

CLIENT:
NEAR NORTH DISTRICT SCHOOL BOARD
NNDSB Tender # 2023-015

PROJECT:
NEW PARRY SOUND K-12 SCHOOL & CHILDCARE

PARRY SOUND HIGH SCHOOL SITE

111 ISABELLA STREET
PARRY SOUND, ONTARIO

ORIGINAL PAGE SIZE ARCH E1 - 30" x 42"
KEY TO DETAIL LOCATION:
(A) A - DETAIL NO.
(5) B - DETAIL NO. ORIGIN


+VG ARCHITECTS
THE VENTIN GROUP LTD

GYMNASIUM COURT DIMENSIONS & DETAILS


A7.1.2

DRAWN BY : EB/KH CHECKED BY : XX


Plot Date: Feb 03, 2026 - 5:35pm By: jkelly Filename: K:\VG-Brantford\Near North DSB Parry Sound School\2111\Drawings\Wd Current\NN-A7.1 gym layout.dwg

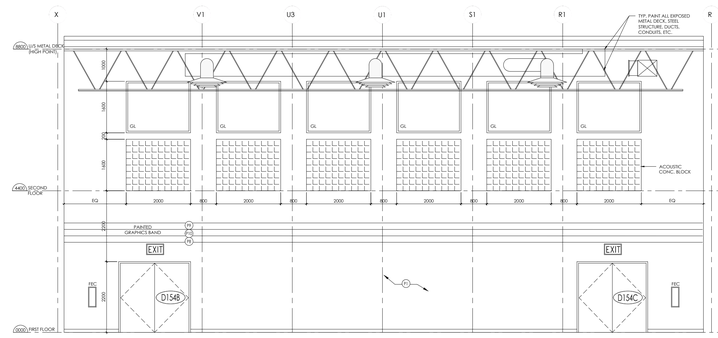


1 A7.2 GYMNASIUM C - NORTH ELEVATION
0 750 1500 3750mm

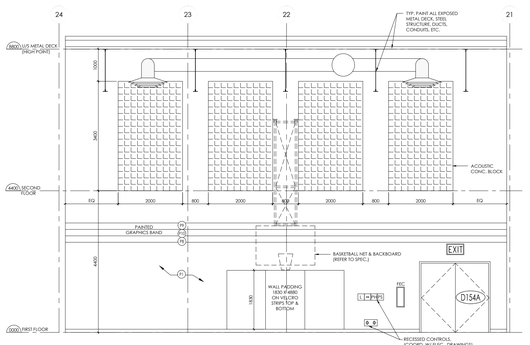


2 A7.2 GYMNASIUM C - EAST ELEVATION
0 750 1500 3750mm

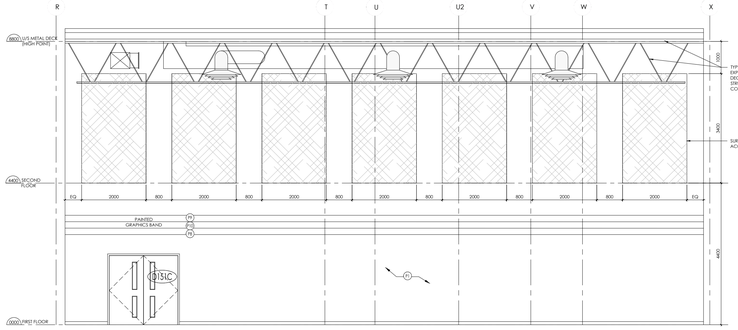


3 A7.2 GYMNASIUM C - SOUTH ELEVATION
0 750 1500 3750mm

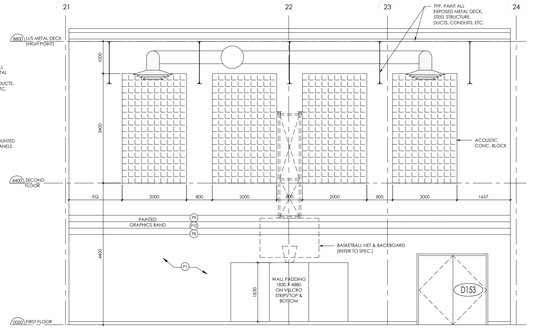


4 A7.2 GYMNASIUM C - WEST ELEVATION
0 750 1500 3750mm

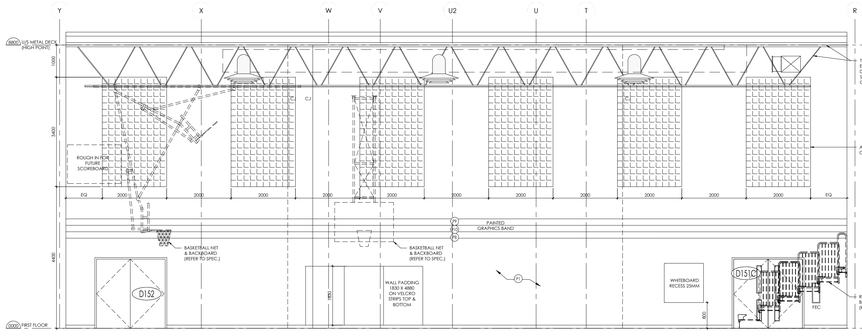


5 A7.2 GYMNASIUM B - NORTH ELEVATION
0 750 1500 3750mm

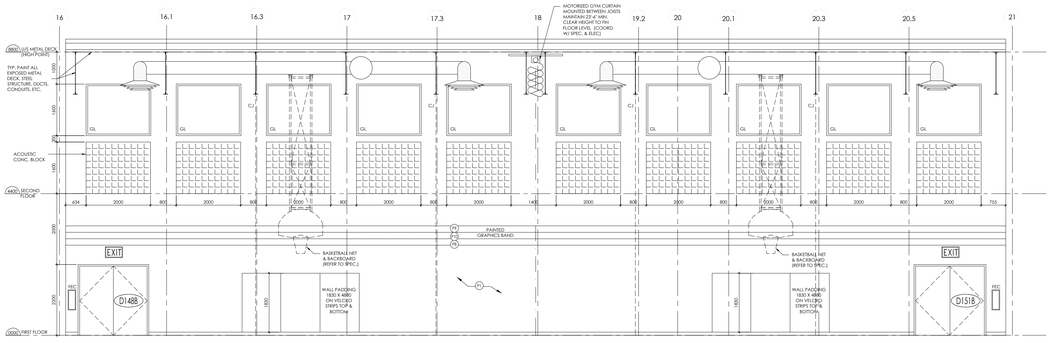

6 A7.2 GYMNASIUM A & B - WEST ELEVATION
0 750 1500 3750mm

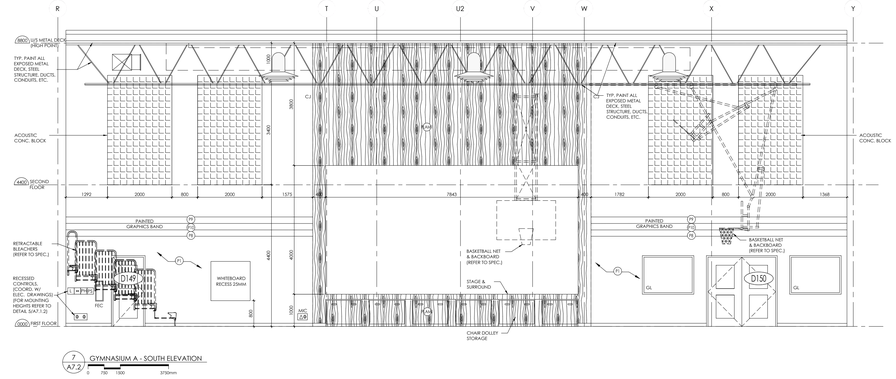

7 A7.2 GYMNASIUM A - SOUTH ELEVATION
0 750 1500 3750mm

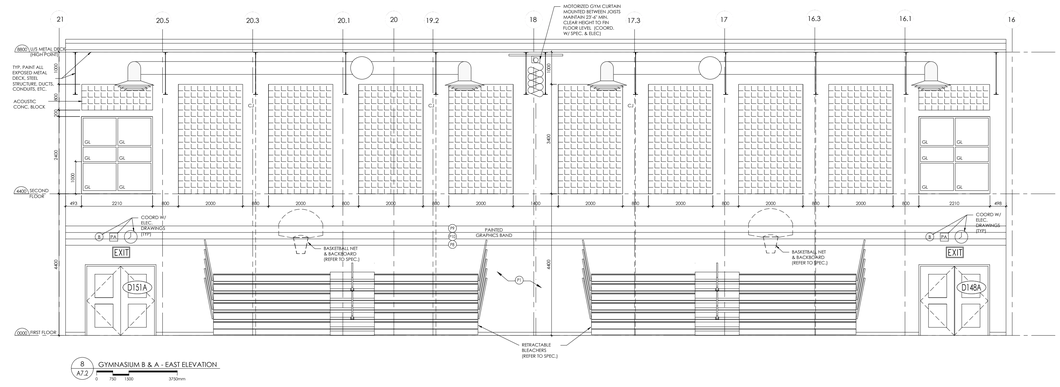

8 A7.2 GYMNASIUM B & A - EAST ELEVATION
0 750 1500 3750mm

SYMBOLS & ABBREV.'S LEGEND

IDENTIFICATION MARKER LEGEND

L	LIGHT SWITCHES (COORD. W/ ELEC. DWG.'S)
PA	PERSONAL ADDRESS SYSTEM W/WIRE GUARD (COORD. W/ ELEC. DW.'S)
PS	PULL STATION W/ WIRE GUARD (COORD. W/ ELEC. DWG.'S) (COORD. W/ MECH. DWG.'S)
PH	PHONE HANDSET IN RECESSED CABINET (COORD. W/ ELEC. DWG.'S)
•	KEY OPERATED SWITCHES (COORD. W/ ELEC. DWG.'S)
	WALL CLOCK W/ WIRE GUARD
B	COMBINATION ALARM BELL / STROBE LIGHT W/ WIRE GUARD (COORD. W/ ELEC. DWG.'S)
MIC REC	ELEC. RECEPTACLE / MICROPHONE OUTLET (COORD. W/ ELEC. DWG.'S)
EXIT	EXIT SIGN W/ EMERGENCY LIGHTING & WIRE GUARD (COORD. W/ ELEC. DWG.'S)
ML	MECHANICAL LOUVRES TO BE PTD. (COORD. W/ MECH. DWG.'S)

GENERAL NOTES

1. COORD. ALL LOCATIONS OF ELEC. SWITCHES & OUTLETS NOT TO CONFLICT W/ WALL PADDING
2. ALL SWITCHES TO BE RECESSED - REFER TO TYP. DETAILS ON DWG A7.1

HATCH IDENTIFICATION MARKER LEGEND

ACOUSTIC BLOCK AS SPEC.'D

GL GLAZING

REVISIONS

NO.	DATE	PARTICULAR
1	2022.06.06	ISSUED FOR 80% CLASS B COSTING
2	2022.08.18	ISSUED FOR SPA
3	2022.09.22	ISSUED FOR OWNERS REVIEW - 98% SET
4	2022.12.16	ISSUED FOR 2nd SPA SUBMISSION
5	2023.01.31	ISSUED FOR TENDER
6	2023.02.22	ISSUED FOR ADDENDUM 9
7	2023.08.23	ISSUED FOR CONVENIENCE
8	2023.11.20	ISSUED FOR PERMIT COMMENTS
9	2024.01.24	ISSUED FOR SI#03
10	2024.02.15	ISSUED FOR PCN#008
11	2024.03.04	ISSUED FOR PCN#009
12	2024.03.10	ISSUED FOR SI#004
13	2024.05.14	ISSUED FOR SI#006
14	2024.07.22	ISSUED FOR SI#008
15	2024.08.07	ISSUED FOR SI#009
16	2024.10.02	ISSUED FOR PCN#15
17	2025.04.11	ISSUED FOR PCN#019
18	2025.05.01	ISSUED FOR CO#07
19	2025.05.28	ISSUED FOR PCN#20 - CO#010
20	2025.07.31	ISSUED FOR SI#013
21	2025.08.06	ISSUED FOR SI#014
22	2025.08.15	ISSUED FOR PCN#25 - CO#017
23	2025.08.25	ISSUED FOR PCN#27 - CO#021
24	2025.09.02	ISSUED FOR PCN#29
25	2025.09.02	ISSUED FOR SI#20 - CO#018
26	2025.09.08	ISSUED FOR PCN#31
27	2025.09.09	ISSUED FOR PCN#32 - CO#022
28	2025.09.10	ISSUED FOR PCN#33
29	2025.09.11	ISSUED FOR SI#022
30	2025.09.15	ISSUED FOR SI#023
31	2025.09.16	ISSUED FOR PCN #35 - CO#023
32	2025.09.30	ISSUED FOR PCN #37 - CO#029
33	2025.09.30	ISSUED FOR PCN #38 - CO#025
34	2025.10.06	ISSUED FOR PCN #39 - CO#024
35	2025.10.20	ISSUED FOR PCN #40R1
36	2025.10.30	ISSUED FOR PCN#041
37	2025.10.23	ISSUED FOR PCN #42
38	2025.11.21	ISSUED FOR PCN#021/R1 - CO12 CD#006
39	2025.11.14	ISSUED FOR PCN#043
40	2025.11.26	ISSUED FOR PCN#043R1
41	2025.12.03	ISSUED FOR PCN#044 - CO#026
42	2026.02.04	ISSUED FOR RECORD SET UP TO CO#27

NOTES:

KEY PLAN:

Reproduction of drawings and related documents in whole or in part is forbidden without written permission of the Ventin Group.

All dimensions and measurements must be checked and verified by the General Contractor

Near North District School Board

CLIENT:
NEAR NORTH DISTRICT SCHOOL BOARD
NNDSB Tender # 2023-015

PROJECT:
NEW PARRY SOUND K-12 SCHOOL & CHILDCARE

PARRY SOUND HIGH SCHOOL SITE

111 ISABELLA STREET
PARRY SOUND, ONTARIO

ORIGINAL PAGE SIZE ARCH E1 - 30" x 42"

KEY TO DETAIL LOCATION:
A - DETAIL NO.
B - DETAIL NO. ORIGIN


+VG ARCHITECTS
THE VENTIN GROUP LTD

GYMNASIUM INTERIOR ELEVATIONS


A7.2

DRAWN BY : VS CHECKED BY : EB


Plot Date: Feb 03, 2026 - 5:36pm By: jkelly Filename: K:\VG-Brantford\Near North DSB Parry Sound School\2211\Drawings\Wd-Content\NN- A7.2 gym elevations.dwg

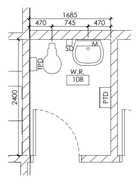


1 WR 108 - ENLARGED PLAN
A7.3.1 — 0 500 1000 2500mm

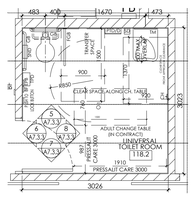


2 UNIV. WR 118.2 - ENLARGED PLAN
A7.3.1 — 0 500 1000 2500mm

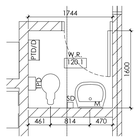


3 WR 120.1 - ENLARGED PLAN
A7.3.1 — 0 500 1000 2500mm

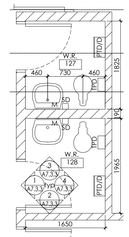


4 WR 127 &128 - ENLARGED PLAN
A7.3.1 — 0 500 1000 2500mm

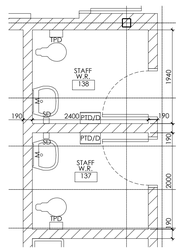


5 STAFF WR 137 &138 - ENLARGED PLAN
A7.3.1 — 0 500 1000 2500mm

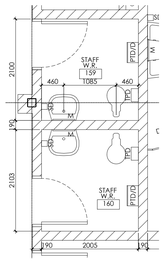


6 STAFF WR 159 &160 - ENLARGED PLAN
A7.3.1 — 0 500 1000 2500mm

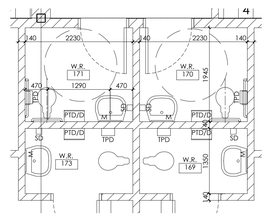


7 WR 169, 170, 171 & 173 - ENLARGED PLAN
A7.3.1 — 0 500 1000 2500mm

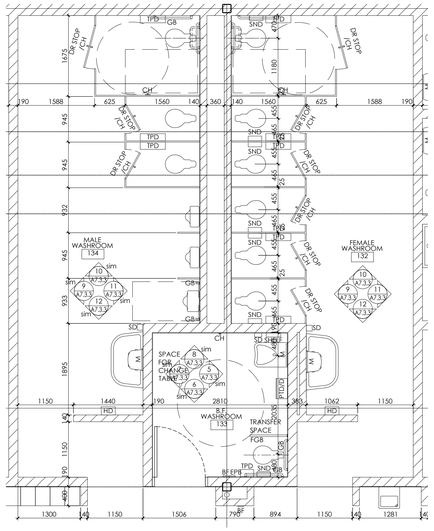


10 MALE WR 134, FEMALE WR 132 & BF WR 133 - ENLARGED PLAN
A7.3.1 — 0 500 1000 2500mm

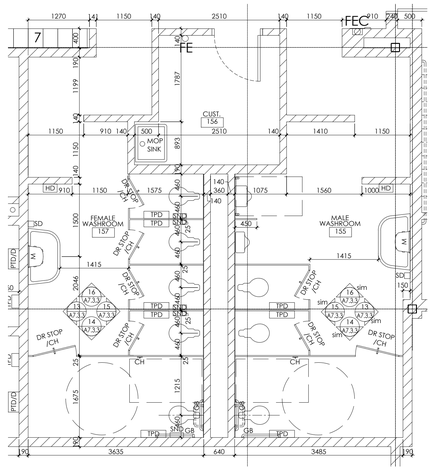


11 MALE WR 155, FEMALE WR 157 - ENLARGED PLAN
A7.3.1 — 0 500 1000 2500mm

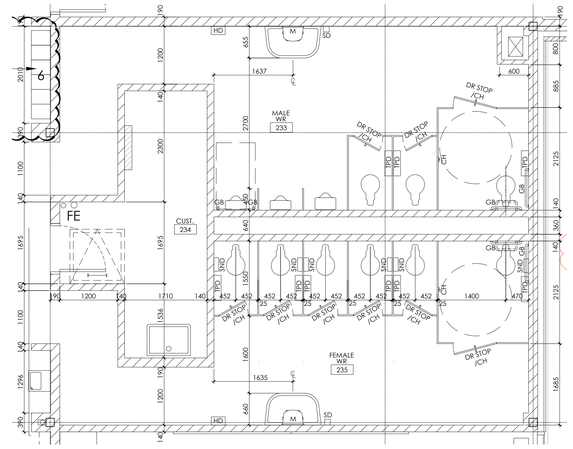


12 MALE WR 233 & FEMALE WR 235 - ENLARGED PLAN
A7.3.1 — 0 500 1000 2500mm

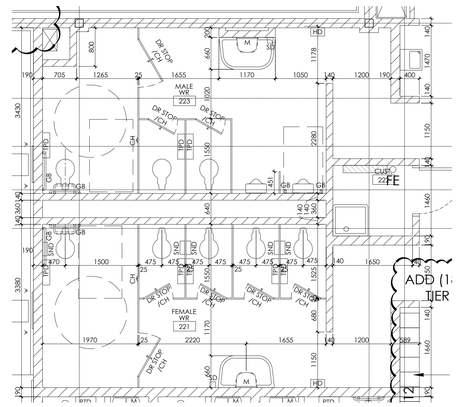


13 MALE WR 223 & FEMALE WR 221 - ENLARGED PLAN
A7.3.1 — 0 500 1000 2500mm

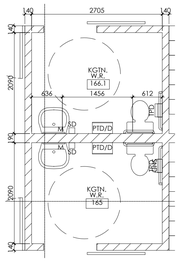


14 KINDERGARTEN WR 165 & 166.1 - ENLARGED PLAN
A7.3.1 — 0 500 1000 2500mm

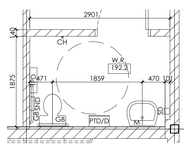


15 WR 192.2 - ENLARGED PLAN
A7.3.1 — 0 500 1000 2500mm

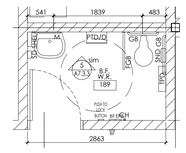


16 BF WR 189 - ENLARGED PLAN
A7.3.1 — 0 500 1000 2500mm

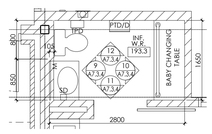


17 BF WR 193.3 - ENLARGED PLAN
A7.3.1 — 0 500 1000 2500mm

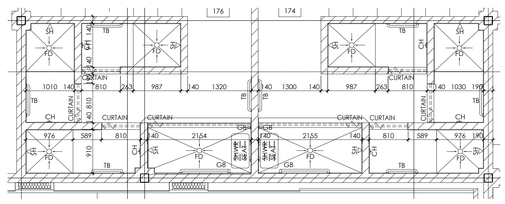


18 CHANGEROOM 174 & 176 - ENLARGED PLAN
A7.3.1 — 0 500 1000 2500mm

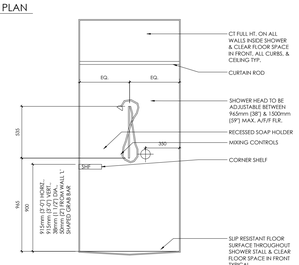


18b TYPE. CHANGEROOM 174 & 176 SHOWER
A7.3.1 — 0 250 500 1250mm

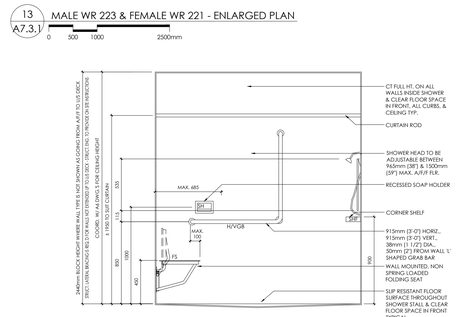


18a TYPE. CHANGEROOM 174 & 176 SHOWER
A7.3.1 — 0 250 500 1250mm

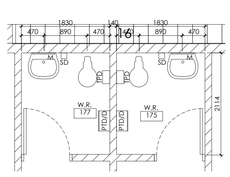


19 WR 175 & 177 - ENLARGED PLAN
A7.3.1 — 0 500 1000 2500mm

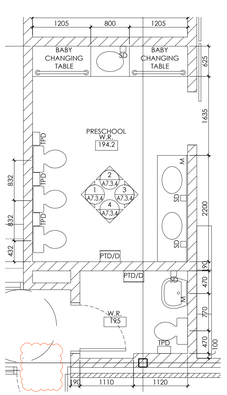


20 PRESCHOOL WR 194.2 & WR 195 - ENLARGED PLAN
A7.3.1 — 0 500 1000 2500mm

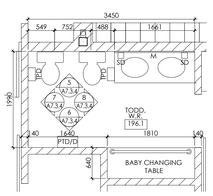

21 TODDLER WR 196.1 - ENLARGED PLAN
A7.3.1 — 0 500 1000 2500mm

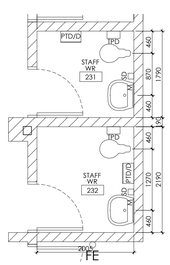

22 STAFF WR 231 & 232 - ENLARGED PLAN
A7.3.1 — 0 500 1000 2500mm

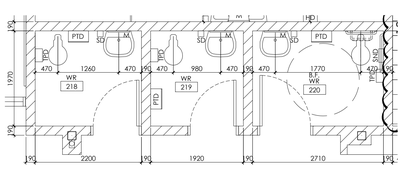

23 WR 218, 219 & BF WR 220 - ENLARGED PLAN
A7.3.1 — 0 500 1000 2500mm

SYMBOLS & ABBREV.'S LEGEND

IDENTIFICATION MARKER LEGEND

CH	- COAT HOOK
CT	- CERAMIC TILE
CV	- CONTROL VALVE
DF	- DRINKING FOUNTAIN
ECS	- EMERGENCY CALL SWITCH
FD	- FLOOR DRAIN
FGB	- FOLD DOWN GRAB BAR
FS	- FOLD DOWN SHOWER SEAT
GB	- GRAB BAR
GD	- GARBAGE DISPOSAL (NOT IN CONTRACT)
HD	- HAND DRYER
M	- MIRROR (MAX. 100 ABOVE SINK)
MS	- MOP SINK
PB	- POWER OPERATOR PUSH BUTTON
PT	- PORCELAIN TILE
PTD/D	- PAPER TOWEL DISPENSER/DISPOSAL
PTL	- PUSH TO LOCK DOOR BUTTON
SAN	- SANITARY NAPKIN DISPENSER
SPD	- SOAP DISPENSER
SH	- SOAP HOLDER
SHF	- SHELF
SND	- SANITARY NAPKIN DISPOSAL
TOB	- TOWEL BAR
TPD	- TOILET PAPER DISPENSER
WR	- WASTE RECEPTACLE

WALL FINISH
REFER INTERIOR DESIGN DRAWINGS FLOOR AND WALL FINISH PLANS FOR EXTENT AND LOCATIONS OF INTERIOR FINISHES

GENERAL NOTES

- CONTRACTOR SHALL VERIFY ALL ROUGH-IN & PLUMBING ROUGH-IN, FIXTURE & ACCESSORY MOUNTING HEIGHTS FOR ALL KINDERGARTENS, DAYCARE, SPECIAL ED, & OTHER SIMILAR NON-TYPICAL SPACES W/ OWNER / OPERATOR PRIOR TO CONST. THE ABOVE NOTED HEIGHTS SHALL BE CONFIRMED TO BE IN ACCORDANCE W/ THE LATEST O.B.C. PRIOR TO ROUGH-IN & INSTALLATION
- REINFORCE MASONRY WALLS WHEREVER CHANGE TABLES ARE INDICATED.
- CONC. BLOCK IN WASHROOMS W/ TILE WALL FIN. TO HAVE TILE BASE
- CONC. BLOCK IN WASHROOMS W/O WALL FIN. TO HAVE SPECIAL PERFORMANCE COATING APPLIED W/ RUBBER BASE
- CONC. BLOCK AROUND DRINKING FTN.'S W/ TILE WALL FIN. TO HAVE TILE BASE (TO START ON CENTER LINE OF DF TYP.)

  CONC. BLOCK AROUND DRINKING FTN.'S W/O WALL FIN. TO HAVE SPECIAL PERFORMANCE COATING APPLIED W/ RUBBER BASE
- COORD. W/ MILLWORK A9 DWG.'S FOR FIXED MILLWORK
- SHOP DWG.'S TO BE IN DIMENSION UNITS AS ILLUSTRATED ON THIS DWG., OR THEY WILL BE REJECTED (IMPERIAL & METRIC BOTH SHOWN IS ACCEPTABLE)
- ALL DIMENSIONS SHOWN ARE MEASURED TO CONCRETE BLOCK UNLESS INDICATED OTHERWISE.

REVISIONS

NO.	DATE	PARTICULAR
1	2022.06.06	ISSUED FOR 80% CLASS B COSTING
2	2022.08.18	ISSUED FOR SPA
3	2022.09.22	ISSUED FOR OWNERS REVIEW - 98% SET
4	2022.12.16	ISSUED FOR 2nd SPA SUBMISSION
5	2023.01.31	ISSUED FOR TENDER
6	2023.02.22	ISSUED FOR ADDENDUM 9
7	2023.08.23	ISSUED FOR CONVENIENCE
8	2023.11.20	ISSUED FOR PERMIT COMMENTS
9	2024.01.24	ISSUED FOR SI#03
10	2024.02.15	ISSUED FOR PCN#008
11	2024.03.04	ISSUED FOR PCN#009
12	2024.03.10	ISSUED FOR SI#004
13	2024.05.14	ISSUED FOR SI#006
14	2024.07.22	ISSUED FOR SI#008
15	2024.08.07	ISSUED FOR SI#009
16	2024.10.02	ISSUED FOR PCN#15
17	2025.04.11	ISSUED FOR PCN#019
18	2025.05.01	ISSUED FOR CO#07
19	2025.05.28	ISSUED FOR PCN#20 - CO#010
20	2025.07.31	ISSUED FOR SI#013
21	2025.08.06	ISSUED FOR SI#014
22	2025.08.15	ISSUED FOR PCN#25 - CO#017
23	2025.08.25	ISSUED FOR PCN#27 - CO#021
24	2025.09.02	ISSUED FOR PCN#29
25	2025.09.02	ISSUED FOR SI#20 - CO#018
26	2025.09.08	ISSUED FOR PCN#31
27	2025.09.09	ISSUED FOR PCN#32 - CO#022
28	2025.09.10	ISSUED FOR PCN#33
29	2025.09.11	ISSUED FOR SI#022
30	2025.09.15	ISSUED FOR SI#023
31	2025.09.16	ISSUED FOR PCN #35 - CO#023
32	2025.09.30	ISSUED FOR PCN #37 - CO#019
33	2025.09.30	ISSUED FOR PCN #38 - CO#025
34	2025.10.06	ISSUED FOR PCN #39 - CO#024
35	2025.10.20	ISSUED FOR PCN #40R1
36	2025.10.30	ISSUED FOR PCN#041
37	2025.10.23	ISSUED FOR PCN #42
38	2025.11.21	ISSUED FOR PCN#021/R1 - CO12 CD#006
39	2025.11.14	ISSUED FOR PCN#043
40	2025.11.26	ISSUED FOR PCN#043R1
41	2025.12.03	ISSUED FOR PCN#044 - CO#026
42	2026.02.04	ISSUED FOR RECORD SET UP TO CO#27

NOTES:

KEY PLAN:

All dimensions and measurements must be checked and verified by the General Contractor

Reproduction of drawings and related documents in whole or in part is forbidden without written permission of The Ventin Group.

Near North District School Board

CLIENT:
NEAR NORTH DISTRICT SCHOOL BOARD
NNDSB Tender # 2023-015

PROJECT:
NEW PARRY SOUND K-12 SCHOOL & CHILDCARE

PARRY SOUND HIGH SCHOOL SITE

111 ISABELLA STREET
PARRY SOUND, ONTARIO

ORIGINAL PAGE SIZE ARCH E1 - 30" x 42"
KEY TO DETAIL LOCATION:
(A) A - DETAIL NO.
(B) B - DETAIL NO. ORIGIN


+VG ARCHITECTS
THE VENTIN GROUP LTD

ENLARGED FLOOR PLANS - WASHROOMS


A7.3.1

DRAWN BY : NK
CHECKED BY : .


Plot Date: Feb 03, 2026 - 5:38pm By: jkelly
Filename: K:\VG-Brantford\Near North\D2B Parry Sound School\22111\Drawings\Wd-Current\NN - A7.3 Enlarged WR.dwg

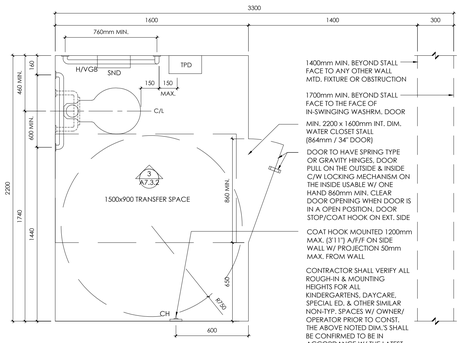


1 A7.3.2 TYP. BARRIER FREE W.C. STALL PLAN (PARTIAL)
0 200 500 1000mm

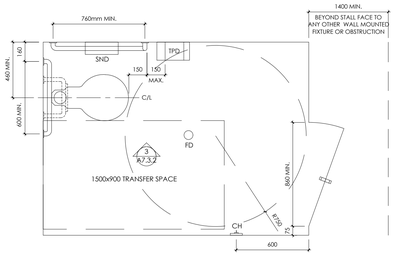


2 A7.3.2 TYPICAL BARRIER FREE W.C. STALL PLAN (PARTIAL)
0 200 400 1000mm

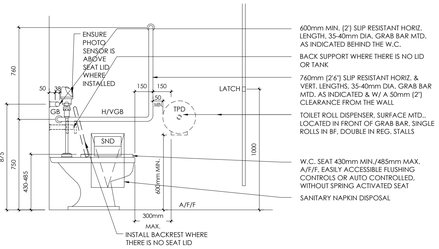


3 A7.3.2 TYP. BARRIER FREE W.C. STALL ELEV. (PARTIAL)
0 200 500 1000mm

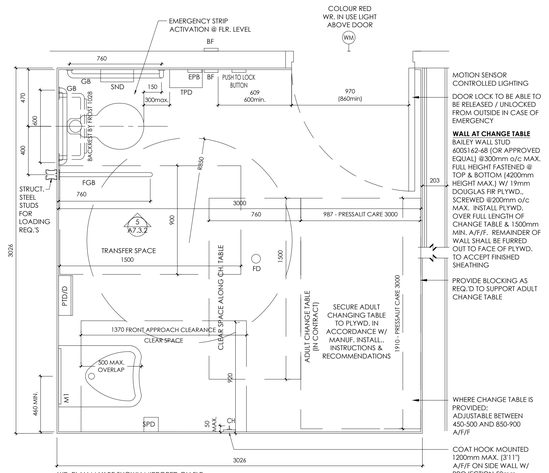


4 A7.3.2 TYPICAL UNIVERSAL WASHROOM PLAN
0 10 20 50mm

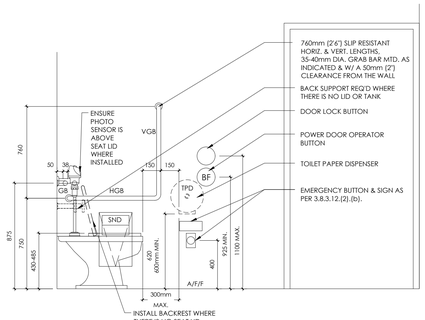


5 A7.3.2 TYPICAL UNIVERSAL WASHROOM ELEVATION
0 10 20 50mm

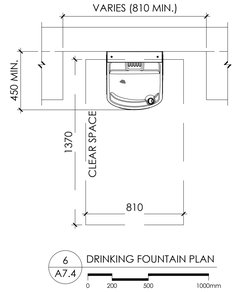


6 A7.4 DRINKING FOUNTAIN PLAN
0 200 500 1000mm

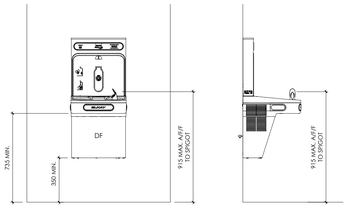


7 A7.6 TYPICAL DRINKING FOUNTAIN ELEVATION & SECTION
0 200 500 1000mm

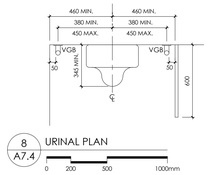


8 A7.4 URINAL PLAN
0 200 500 1000mm

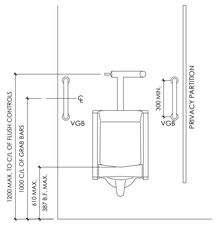


9 A7.6 URINAL ELEV.
0 200 500 1000mm

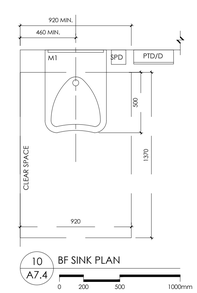


10 A7.4 BF SINK PLAN
0 200 500 1000mm

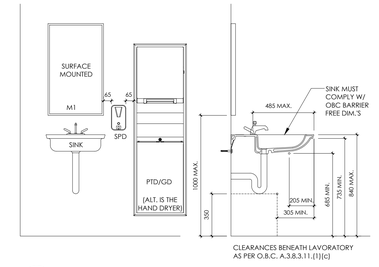


11 A7.6 BF SINK ELEV. & SECTION
0 200 500 1000mm

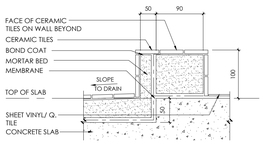


12 A7.3.2 TYPICAL SHOWER CURB
0 10 20 50mm

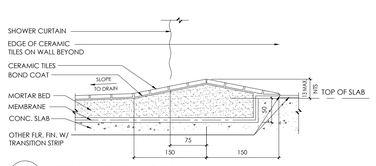


13 A7.3.2 TYPICAL SHOWER BF CURB
0 10 20 50mm

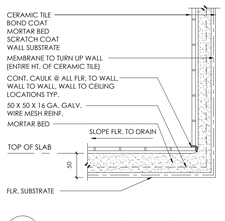


14 A7.3.2 TYPICAL SHOWER BASE DETAIL
0 10 20 50mm

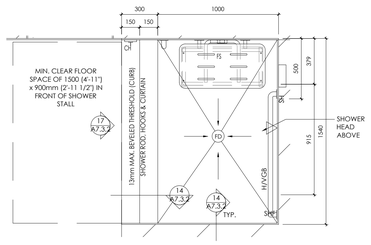


16 A7.3.2 TYP. BARRIER FREE SHOWER PLAN
0 10 20 50mm

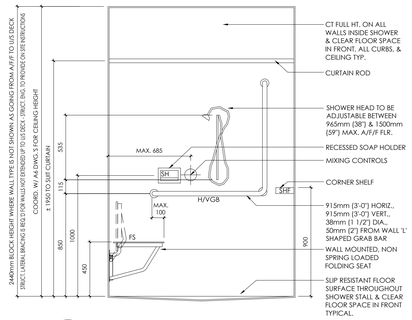

17 A7.3.2 TYP. BARRIER FREE SHOWER ELEVATION
0 10 20 50mm

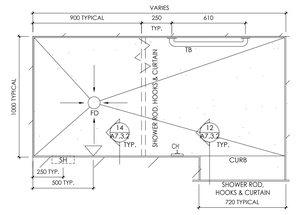

18 A7.3.2 TYPICAL NON-BARRIER FREE SHOWER PLAN
0 10 20 50mm

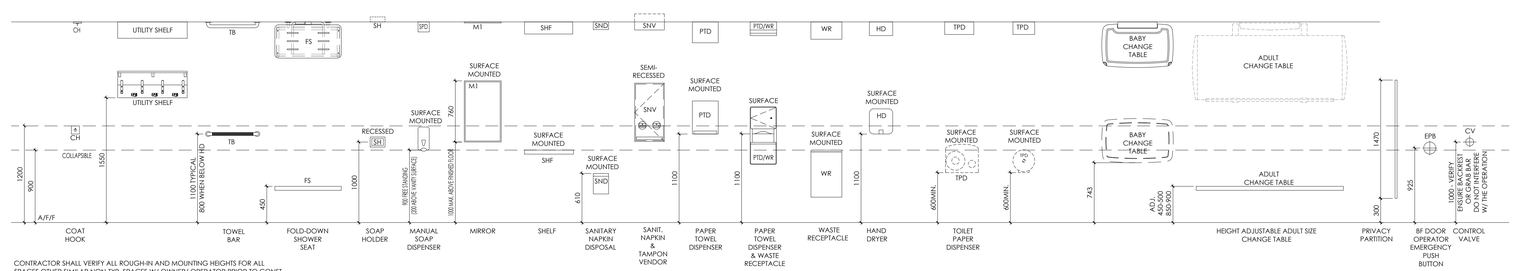

CONTRACTOR SHALL VERIFY ALL ROUGH-IN AND MOUNTING HEIGHTS FOR ALL SPACES OTHER SIMILAR NON-TYP. SPACES W/ OWNER/ OPERATOR PRIOR TO CONST. THE ABOVE NOTED HEIGHTS SHALL BE CONFIRMED TO BE IN ACCORDANCE W/ THE LATEST OBC PRIOR TO ROUGH-IN & INSTALL.

15 A7.3.2 ACCESSORY MOUNTING HEIGHTS
0 300 600 1500mm

REVISIONS

NO.	DATE	PARTICULAR
1	2022.06.06	ISSUED FOR 80% CLASS B COSTING
2	2022.08.18	ISSUED FOR SPA
3	2022.09.22	ISSUED FOR OWNERS REVIEW - 98% SET
4	2022.12.16	ISSUED FOR 2nd SPA SUBMISSION
5	2022.01.31	ISSUED FOR TENDER
6	2023.02.22	ISSUED FOR ADDENDUM 9
7	2023.08.23	ISSUED FOR CONVENIENCE
8	2023.11.20	ISSUED FOR PERMIT COMMENTS
9	2024.01.24	ISSUED FOR SI#03
10	2024.02.15	ISSUED FOR PCN#008
11	2024.03.04	ISSUED FOR PCN#009
12	2024.03.10	ISSUED FOR SI#004
13	2024.05.14	ISSUED FOR SI#006
14	2024.07.22	ISSUED FOR SI#008
15	2024.08.07	ISSUED FOR SI#009
16	2024.10.02	ISSUED FOR PCN#15
17	2025.04.11	ISSUED FOR PCN#019
18	2025.05.01	ISSUED FOR CO#07
19	2025.05.28	ISSUED FOR PCN#20 - CO#010
20	2025.07.31	ISSUED FOR SI#013
21	2025.08.06	ISSUED FOR SI#014
22	2025.08.15	ISSUED FOR PCN#25 - CO#017
23	2025.08.25	ISSUED FOR PCN#27 - CO#021
24	2025.09.02	ISSUED FOR PCN#29
25	2025.09.02	ISSUED FOR SI#20 - CO#018
26	2025.09.08	ISSUED FOR PCN#31
27	2025.09.09	ISSUED FOR PCN#32 - CO#022
28	2025.09.10	ISSUED FOR PCN#33
29	2025.09.11	ISSUED FOR SI#022
30	2025.09.15	ISSUED FOR SI#023
31	2025.09.16	ISSUED FOR PCN #35 - CO#023
32	2025.09.30	ISSUED FOR PCN #37 - CO#019
33	2025.09.30	ISSUED FOR PCN #38 - CO#025
34	2025.10.06	ISSUED FOR PCN #39 - CO#024
35	2025.10.20	ISSUED FOR PCN #40R1
36	2025.10.30	ISSUED FOR PCN#041
37	2025.10.23	ISSUED FOR PCN #42
38	2025.11.21	ISSUED FOR PCN#021/R1 - CO12 CD#006
39	2025.11.14	ISSUED FOR PCN#043
40	2025.11.26	ISSUED FOR PCN#043R1
41	2025.12.03	ISSUED FOR PCN#044 - CO#026
42	2026.02.04	ISSUED FOR RECORD SET UP TO CO#27

NOTES:

KEY PLAN:

Reproduction of drawings and related documents in whole or in part is forbidden without written permission of The Ventin Group.

All dimensions and measurements must be checked and verified by the General Contractor

Near North District School Board

CLIENT:
NEAR NORTH DISTRICT SCHOOL BOARD
NNDSB Tender # 2023-015

PROJECT:
NEW PARRY SOUND K-12 SCHOOL & CHILDCARE

PARRY SOUND HIGH SCHOOL SITE

111 ISABELLA STREET
PARRY SOUND, ONTARIO

ORIGINAL PAGE SIZE ARCH E1 - 30" x 42"
KEY TO DETAIL LOCATION:
A - DETAIL NO.
B - DETAIL NO. ORIGIN


+VG ARCHITECTS
THE VENTIN GROUP LTD

WASHROOM DETAILS


A7.3.2

Plot Date: Feb 03, 2026 - 5:39pm By: jkelly
Filename: K:\VG-Brantford\Near North D38 Parry Sound School\221111\Drawings\VG-Current\NN- A7.3 Enlarged WR.dwg


DRAWN BY : NK
CHECKED BY : .

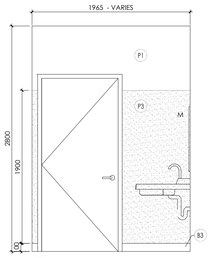


1 A7.3.3 TYP. SINGLE WR WALL ELEV.
0 300 600 1500mm

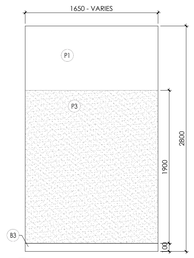


2 A7.3.3 TYP. SINGLE WR WALL ELEV.
0 300 600 1500mm

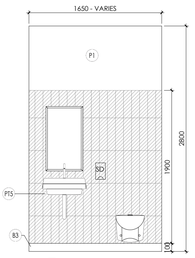


3 A7.3.3 TYP. SINGLE WR WALL TILE ELEV.
0 300 600 1500mm

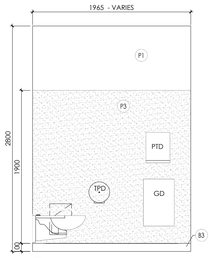


4 A7.3.3 TYP. SINGLE WR WALL ELEV.
0 300 600 1500mm

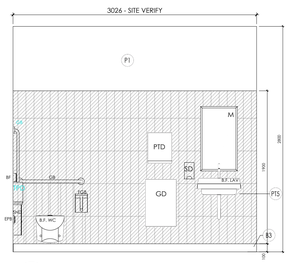


5 A7.3.3 TYP. UNIVERSAL WASHROOM WALL ELEVATION
0 300 600 1500mm

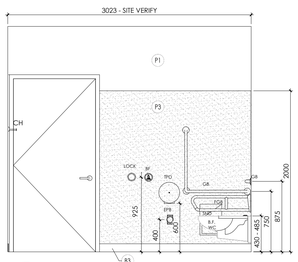


6 A7.3.3 TYP. UNIVERSAL WASHROOM WALL ELEVATION
0 300 600 1500mm

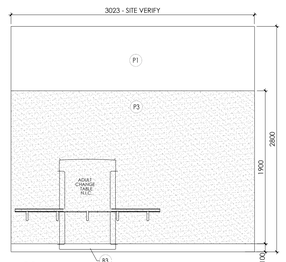


7 A7.3.3 TYP. UNIVERSAL WASHROOM WALL ELEVATION
0 300 600 1500mm

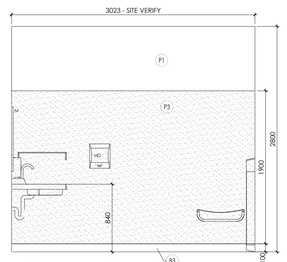


8 A7.3.3 TYP. UNIVERSAL WASHROOM WALL ELEVATION
0 300 600 1500mm

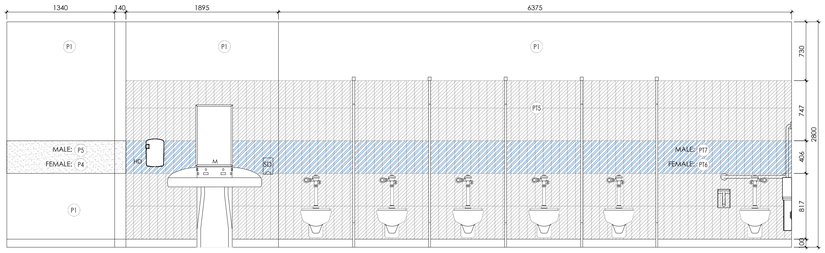


9 A7.3.3 FEMALE WASHROOM 132 ELEVATION - TILE PATTERN
0 300 600 1500mm
MALE WASHROOM 134, SIMILAR/MIRRORED

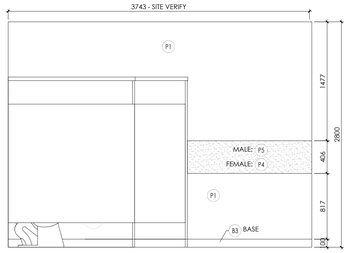


10 A7.3.3 FEMALE WASHROOM 132 ELEVATION - TILE PATTERN
0 300 600 1500mm
MALE WASHROOM 134, SIMILAR/MIRRORED

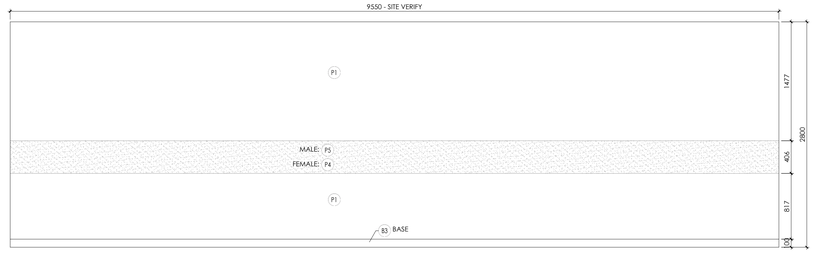


11 A7.3.3 FEMALE WASHROOM 132 ELEVATION - TILE PATTERN
0 300 600 1500mm
MALE WASHROOM 134, SIMILAR/MIRRORED

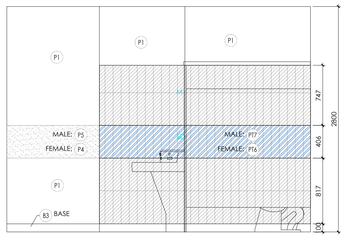


12 A7.3.3 FEMALE WASHROOM 132 ELEVATION - TILE PATTERN
0 300 600 1500mm
MALE WASHROOM 134, SIMILAR/MIRRORED

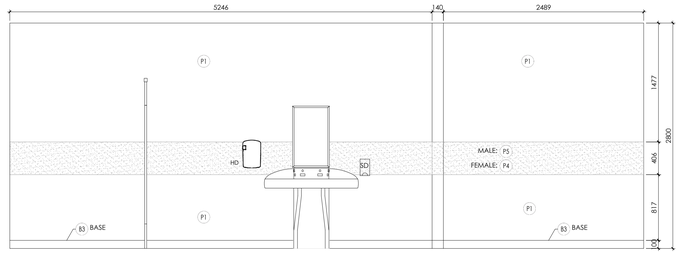


13 A7.3.3 FEMALE WASHROOM 157 ELEVATION - TILE PATTERN
0 300 600 1500mm
MALE WR 155, 223, 233 & FEMALE WR 221, 235 ARE SIMILAR/MIRRORED

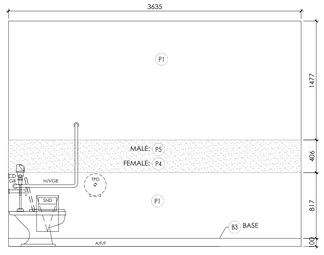

14 A7.3.3 FEMALE WASHROOM 157 ELEVATION - TILE PATTERN
0 300 600 1500mm
MALE WR 155, 223, 233 & FEMALE WR 221, 235 ARE SIMILAR/MIRRORED

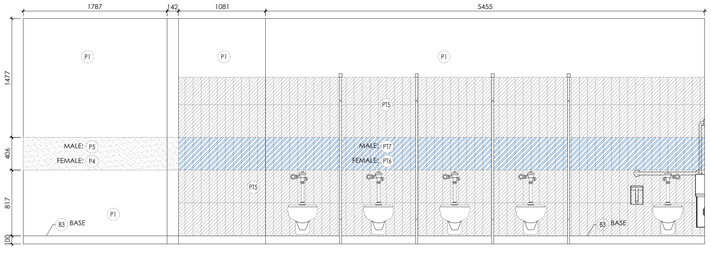

15 A7.3.3 FEMALE WASHROOM 157 ELEVATION - TILE PATTERN
0 300 600 1500mm
MALE WR 155, 223, 233 & FEMALE WR 221, 235 ARE SIMILAR/MIRRORED

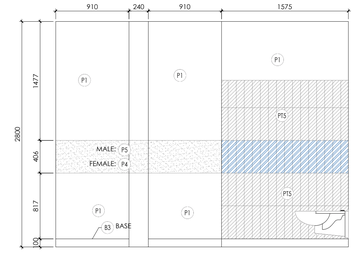


16 A7.3.3 FEMALE WASHROOM 157 ELEVATION - TILE PATTERN
0 300 600 1500mm
MALE WR 155, 223, 233 & FEMALE WR 221, 235 ARE SIMILAR/MIRRORED

HATCH IDENTIFICATION MARKER LEGEND

- CERAMIC TILE CT1 (SCORED 50mm x 200mm)
- CERAMIC TILE CT2
- PTD, CONC. BLOCK

PT- 300mm X 600mm FIELD TILE & BASE

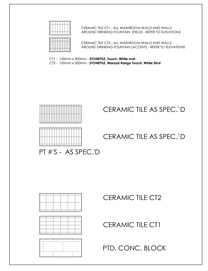

PT #'S - AS SPEC.'D

- SHOP DWG.'S TO BE IN DIMENSION UNITS AS ILLUSTRATED ON THIS DWG. OR THEY WILL BE REGJECTED

REVISIONS

NO.	DATE	PARTICULAR
1	2022.06.06	ISSUED FOR 80% CLASS B COSTING
2	2022.08.18	ISSUED FOR SPA
3	2022.09.22	ISSUED FOR OWNERS REVIEW - 98% SET
4	2022.12.16	ISSUED FOR 2nd SPA SUBMISSION
5	2022.01.31	ISSUED FOR TENDER
6	2023.02.22	ISSUED FOR ADDENDUM 9
7	2023.08.23	ISSUED FOR CONVENIENCE
8	2023.11.20	ISSUED FOR PERMIT COMMENTS
9	2024.01.24	ISSUED FOR SI#03
10	2024.02.15	ISSUED FOR PCN#008
11	2024.03.04	ISSUED FOR PCN#009
12	2024.03.10	ISSUED FOR SI#004
13	2024.05.14	ISSUED FOR SI#006
14	2024.07.22	ISSUED FOR SI#008
15	2024.08.07	ISSUED FOR SI#009
16	2024.10.02	ISSUED FOR PCN#15
17	2025.04.11	ISSUED FOR PCN#019
18	2025.05.01	ISSUED FOR CO#07
19	2025.05.28	ISSUED FOR PCN#20 - CO#010
20	2025.07.31	ISSUED FOR SI#013
21	2025.08.06	ISSUED FOR SI#014
22	2025.08.15	ISSUED FOR PCN#25 - CO#017
23	2025.08.25	ISSUED FOR PCN#27 - CO#021
24	2025.09.02	ISSUED FOR PCN#29
25	2025.09.02	ISSUED FOR SI#20 - CO#018
26	2025.09.08	ISSUED FOR PCN#31
27	2025.09.09	ISSUED FOR PCN#32 - CO#022
28	2025.09.10	ISSUED FOR PCN#33
29	2025.09.11	ISSUED FOR SI#022
30	2025.09.15	ISSUED FOR SI#023
31	2025.09.16	ISSUED FOR PCN #35 - CO#023
32	2025.09.30	ISSUED FOR PCN #37 - CO#019
33	2025.09.30	ISSUED FOR PCN #38 - CO#025
34	2025.10.06	ISSUED FOR PCN #39 - CO#024
35	2025.10.20	ISSUED FOR PCN #40R1
36	2025.10.30	ISSUED FOR PCN#041
37	2025.10.23	ISSUED FOR PCN #42
38	2025.11.21	ISSUED FOR PCN#021/R1 - CO12 CD#006
39	2025.11.14	ISSUED FOR PCN#043
40	2025.11.26	ISSUED FOR PCN#043R1
41	2025.12.03	ISSUED FOR PCN#044 - CO#026
42	2026.02.04	ISSUED FOR RECORD SET UP TO CO#27

NOTES:

KEY PLAN:

All dimensions and measurements must be checked and verified by the General Contractor

Reproduction of drawings and related documents in whole or in part is forbidden without written permission of The Ventin Group.

Near North District School Board

CLIENT:
NEAR NORTH DISTRICT SCHOOL BOARD
NNDSB Tender # 2023-015

PROJECT:
NEW PARRY SOUND K-12 SCHOOL & CHILDCARE

PARRY SOUND HIGH SCHOOL SITE

111 ISABELLA STREET
PARRY SOUND, ONTARIO

ORIGINAL PAGE SIZE ARCH E1 - 30" x 42"
KEY TO DETAIL LOCATION:
A - DETAIL NO.
B - DETAIL NO. ORIGIN


+VG ARCHITECTS
THE VENTIN GROUP LTD

WASHROOM ELEVATIONS

A7.3.3


DRAWN BY : NK
CHECKED BY :

Plot Date: Feb 03, 2026 - 5:39pm By: jkelly
Filename: K:\VG-Brantford\Near North DSB Parry Sound School\2211\Drawings\Wrk Current\Nth A7.3 Enlarged WR.dwg

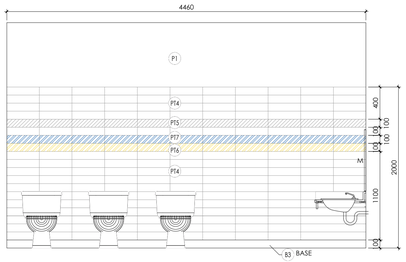


1 A7.3.4 PRESCHOOL WR 194.2 ELEVATION - TILE PATTERN

0 300 600 1500mm

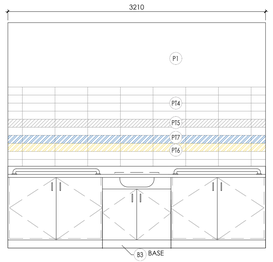


2 A7.3.4 PRESCHOOL WR 194.2 ELEVATION - TILE PATTERN

0 300 600 1500mm

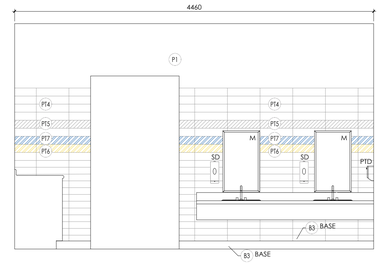


3 A7.3.4 PRESCHOOL WR 194.2 ELEVATION - TILE PATTERN

0 300 600 1500mm

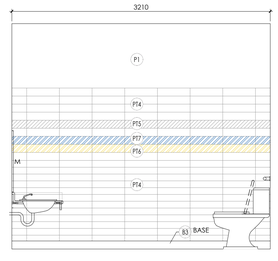


4 A7.3.4 PRESCHOOL WR 194.2 ELEVATION - TILE PATTERN

0 300 600 1500mm

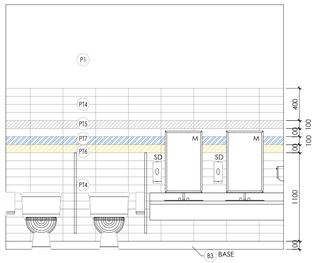


5 A7.3.4 TODDLER WR 196.1 ELEVATION - TILE PATTERN

0 300 600 1500mm

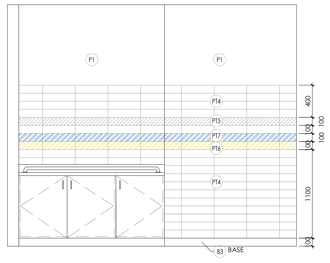


6 A7.3.4 TODDLER WR 196.1 ELEVATION - TILE PATTERN

0 300 600 1500mm

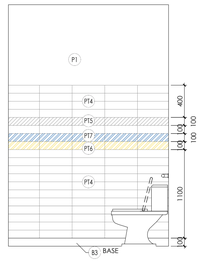


7 A7.3.4 TODDLER WR 196.1 ELEVATION - TILE PATTERN

0 300 600 1500mm

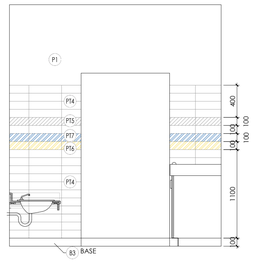


8 A7.3.4 TODDLER WR 196.1 ELEVATION - TILE PATTERN

0 300 600 1500mm

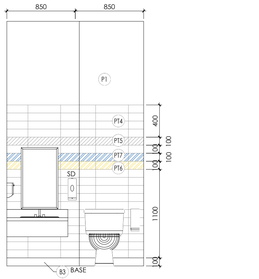


9 A7.3.4 INFANT WR 193.3 ELEVATION - TILE PATTERN

0 300 600 1500mm

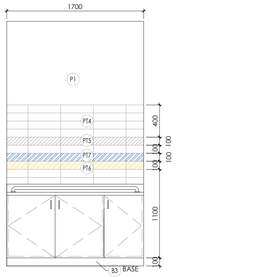


10 A7.3.4 INFANT WR 193.3 ELEVATION - TILE PATTERN

0 300 600 1500mm

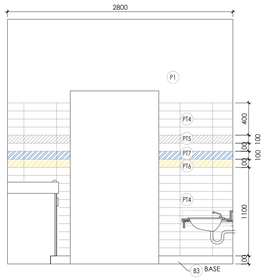

11 A7.3.4 INFANT WR 193.3 ELEVATION - TILE PATTERN

0 300 600 1500mm

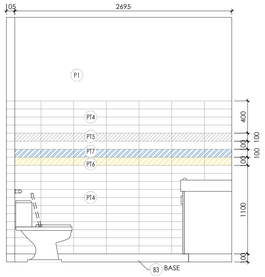

12 A7.3.4 INFANT WR 193.3 ELEVATION - TILE PATTERN

0 300 600 1500mm

REVISIONS

NO.	DATE	PARTICULAR
1	2022.06.06	ISSUED FOR 80% CLASS B COSTING
2	2022.08.18	ISSUED FOR SPA
3	2022.09.22	ISSUED FOR OWNERS REVIEW - 98% SET
4	2022.12.16	ISSUED FOR 2nd SPA SUBMISSION
5	2022.01.31	ISSUED FOR TENDER
6	2023.02.22	ISSUED FOR ADDENDUM 9
7	2023.08.23	ISSUED FOR CONVENIENCE
8	2023.11.20	ISSUED FOR PERMIT COMMENTS
9	2024.01.24	ISSUED FOR SI#33
10	2024.02.15	ISSUED FOR PCN#008
11	2024.03.04	ISSUED FOR PCN#009
12	2024.03.10	ISSUED FOR SI#004
13	2024.05.14	ISSUED FOR SI#006
14	2024.07.22	ISSUED FOR SI#008
15	2024.08.07	ISSUED FOR SI#009
16	2024.10.02	ISSUED FOR PCN#15
17	2025.04.11	ISSUED FOR PCN#019
18	2025.05.01	ISSUED FOR CO#07
19	2025.05.28	ISSUED FOR PCN#20 - CO#010
20	2025.07.31	ISSUED FOR SI#013
21	2025.08.06	ISSUED FOR SI#014
22	2025.08.15	ISSUED FOR PCN#25 - CO#017
23	2025.08.25	ISSUED FOR PCN#27 - CO#021
24	2025.09.02	ISSUED FOR PCN#29
25	2025.09.02	ISSUED FOR SI#20 - CO#018
26	2025.09.08	ISSUED FOR PCN#31
27	2025.09.09	ISSUED FOR PCN#32 - CO#022
28	2025.09.10	ISSUED FOR PCN#33
29	2025.09.11	ISSUED FOR SI#022
30	2025.09.15	ISSUED FOR SI#023
31	2025.09.16	ISSUED FOR PCN #35 - CO#023
32	2025.09.30	ISSUED FOR PCN #37 - CO#019
33	2025.09.30	ISSUED FOR PCN #38 - CO#025
34	2025.10.06	ISSUED FOR PCN #39 - CO#024
35	2025.10.20	ISSUED FOR PCN #40R1
36	2025.10.30	ISSUED FOR PCN#041
37	2025.10.23	ISSUED FOR PCN #42
38	2025.11.21	ISSUED FOR PCN#021/R1 - CO12 CD#006
39	2025.11.14	ISSUED FOR PCN#043
40	2025.11.26	ISSUED FOR PCN#043R1
41	2025.12.03	ISSUED FOR PCN#044 - CO#026
42	2026.02.04	ISSUED FOR RECORD SET UP TO CO#27

NOTES:

KEY PLAN:

All dimensions and measurements must be checked and verified by the General Contractor

Reproduction of drawings and related documents in whole or in part is forbidden without written permission of The Ventin Group.

Near North District School Board

CLIENT:
NEAR NORTH DISTRICT SCHOOL BOARD
NNDSB Tender # 2023-015

PROJECT:
NEW PARRY SOUND K-12 SCHOOL & CHILDCARE

PARRY SOUND HIGH SCHOOL SITE

111 ISABELLA STREET
PARRY SOUND, ONTARIO

ORIGINAL PAGE SIZE ARCH E1 - 30" x 42"
KEY TO DETAIL LOCATION:
A - DETAIL NO.
B - DETAIL NO. ORIGIN


+VG ARCHITECTS
THE VENTIN GROUP LTD

WASHROOM ELEVATIONS

A7.3.4


DRAWN BY : NK
CHECKED BY : _

Plot Date: Feb 03, 2026 - 5:39pm By: jkelly
Filename: K:\VG-Brantford\Near North DSB Parry Sound School\22111\Drawings\Wd-Current\NN- A7.3 Enlarged WR.dwg

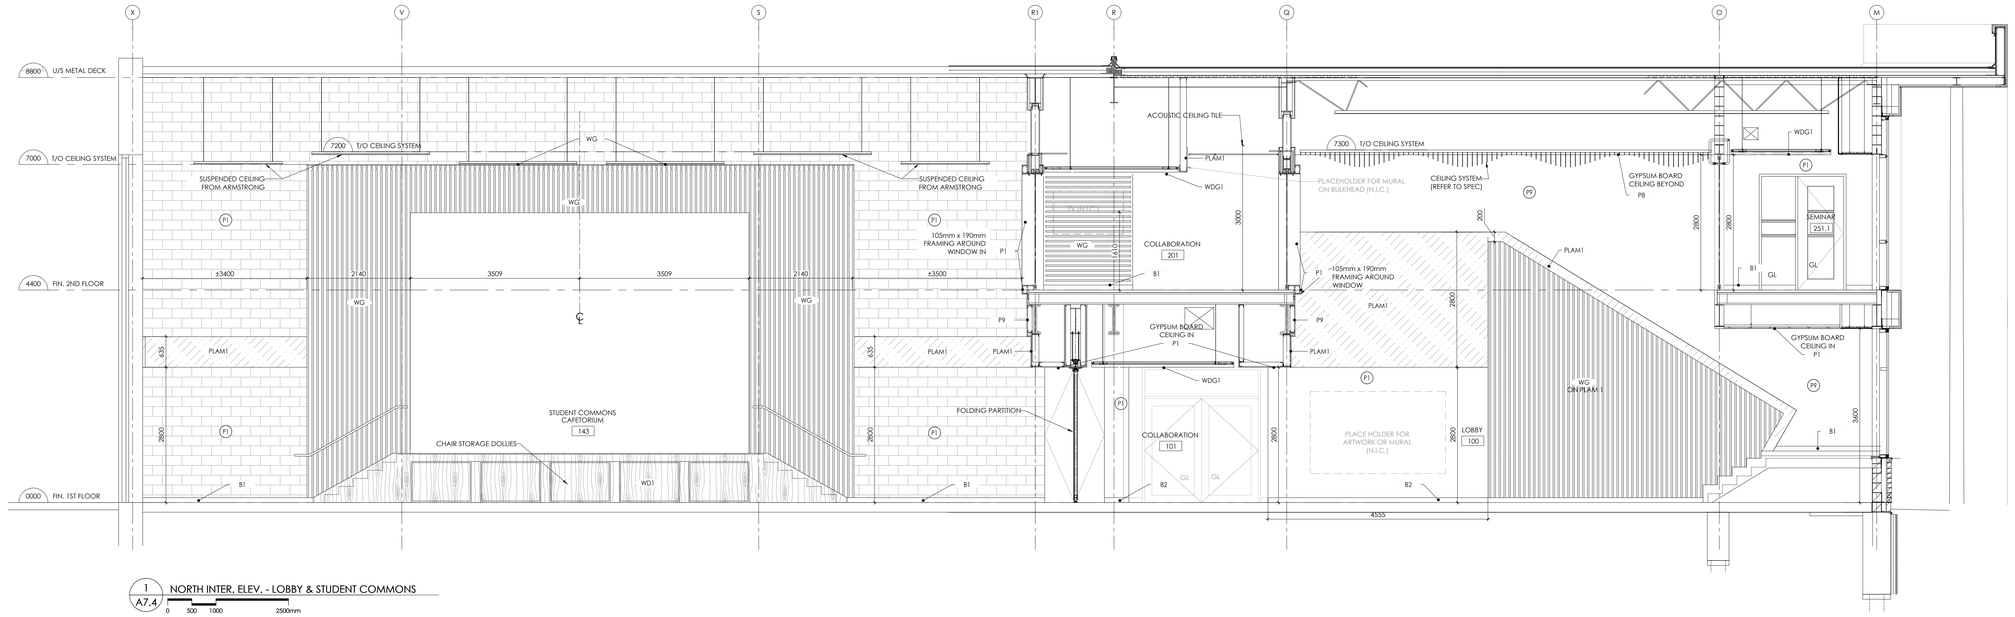

1 / A7.4 NORTH INTER. ELEV. - LOBBY & STUDENT COMMONS

0 500 1000 2500mm

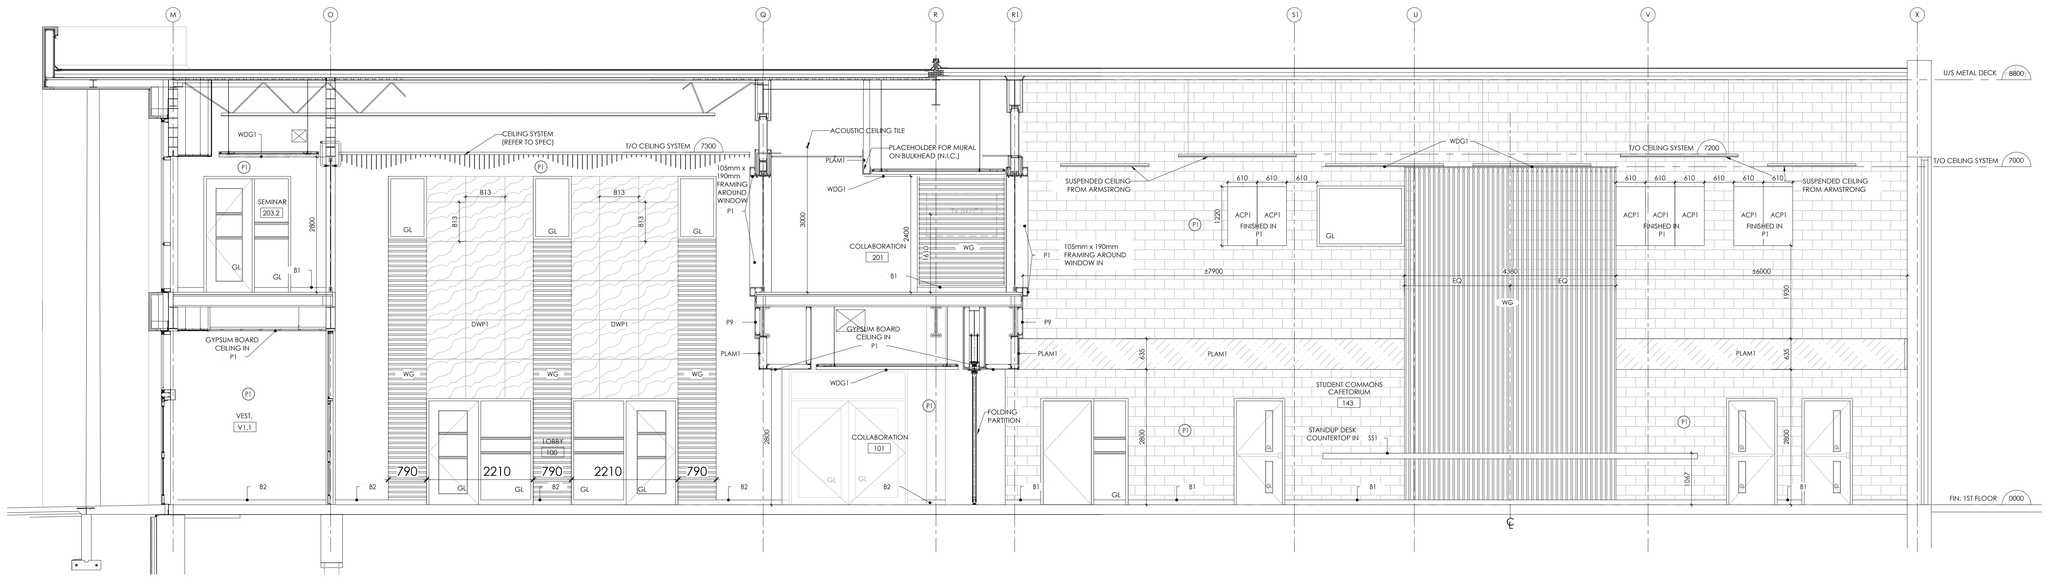

2 / A7.4 SOUTH INTER. ELEV. - LOBBY & STUDENT COMMONS

0 500 1000 2500mm

REVISIONS

NO.	DATE	PARTICULAR
1	2022.06.06	ISSUED FOR 80% CLASS B COSTING
2	2022.08.18	ISSUED FOR SPA
3	2022.09.22	ISSUED FOR OWNERS REVIEW - 98% SET
4	2022.12.16	ISSUED FOR 2nd SPA SUBMISSION
5	2023.01.31	ISSUED FOR TENDER
6	2023.02.22	ISSUED FOR ADDENDUM 9
7	2023.08.23	ISSUED FOR CONVENIENCE
8	2023.11.20	ISSUED FOR PERMIT COMMENTS
9	2024.01.24	ISSUED FOR SI#03
10	2024.02.15	ISSUED FOR PCN#008
11	2024.03.04	ISSUED FOR PCN#009
12	2024.03.10	ISSUED FOR SI#004
13	2024.05.14	ISSUED FOR SI#006
14	2024.07.22	ISSUED FOR SI#008
15	2024.08.07	ISSUED FOR SI#009
16	2024.10.02	ISSUED FOR PCN#15
17	2025.04.11	ISSUED FOR PCN#019
18	2025.05.01	ISSUED FOR CO#07
19	2025.05.28	ISSUED FOR PCN#20 - CO#010
20	2025.07.31	ISSUED FOR SI#013
21	2025.08.06	ISSUED FOR SI#014
22	2025.08.15	ISSUED FOR PCN#25 - CO#017
23	2025.08.25	ISSUED FOR PCN#27 - CO#021
24	2025.09.02	ISSUED FOR PCN#29
25	2025.09.02	ISSUED FOR SI#20 - CO#018
26	2025.09.08	ISSUED FOR PCN#31
27	2025.09.09	ISSUED FOR PCN#32 - CO#022
28	2025.09.10	ISSUED FOR PCN#33
29	2025.09.11	ISSUED FOR SI#022
30	2025.09.15	ISSUED FOR SI#023
31	2025.09.16	ISSUED FOR PCN #35 - CO#023
32	2025.09.30	ISSUED FOR PCN #37 - CO#029
33	2025.09.30	ISSUED FOR PCN #38 - CO#025
34	2025.10.06	ISSUED FOR PCN #39 - CO#024
35	2025.10.20	ISSUED FOR PCN #40R1
36	2025.10.30	ISSUED FOR PCN#041
37	2025.10.23	ISSUED FOR PCN #42
38	2025.11.21	ISSUED FOR PCN#021/R1 - CO12 CD#006
39	2025.11.14	ISSUED FOR PCN#043
40	2025.11.26	ISSUED FOR PCN#043R1
41	2025.12.03	ISSUED FOR PCN#044 - CO#026
42	2026.02.04	ISSUED FOR RECORD SET UP TO CO#27

NOTES:

KEY PLAN:

All dimensions and measurements must be checked and verified by the General Contractor

Reproduction of drawings and related documents in whole or in part is forbidden without written permission of the Ventin Group.

Near North District School Board

CLIENT:
NEAR NORTH DISTRICT SCHOOL BOARD
NNDSB Tender # 2023-015

PROJECT:
NEW PARRY SOUND K-12 SCHOOL & CHILDCARE

PARRY SOUND HIGH SCHOOL SITE

111 ISABELLA STREET
PARRY SOUND, ONTARIO


ORIGINAL PAGE SIZE ARCH E1 - 30" x 42"
KEY TO DETAIL LOCATION:
A - DETAIL NO.
B - DETAIL NO. ORIGIN

+VG ARCHITECTS
THE VENTIN GROUP LTD

INTERIOR ELEVATIONS


A7.4

Filename: K:\1VG-Brantford\Near North DSB Parry Sound School\2211\Drawings\Wd-Content\NN- A7.4 Interior Elevations.dwg
Plot Date: Feb 03, 2026 - 5:40pm By: jkelly
DRAWN BY : PS CHECKED BY : EB

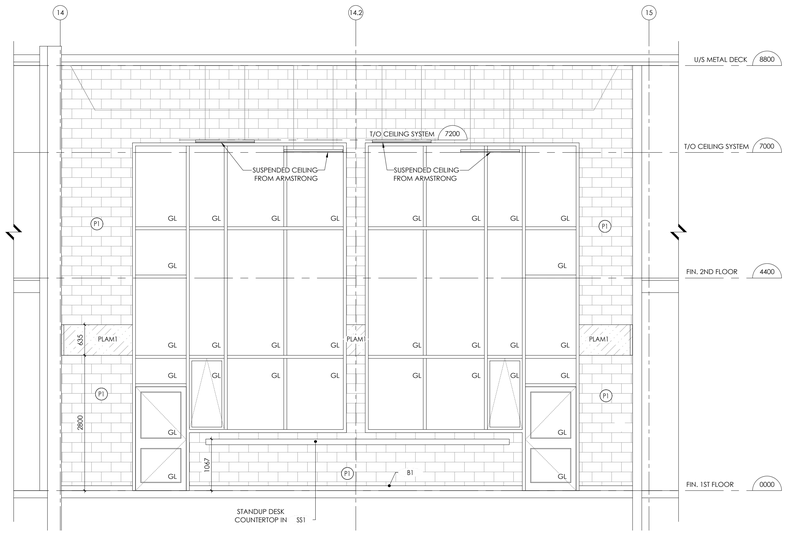


1 / A7.5 WEST INTER. ELEV. - STUDENT COMMONS

0 500 1000 2500mm

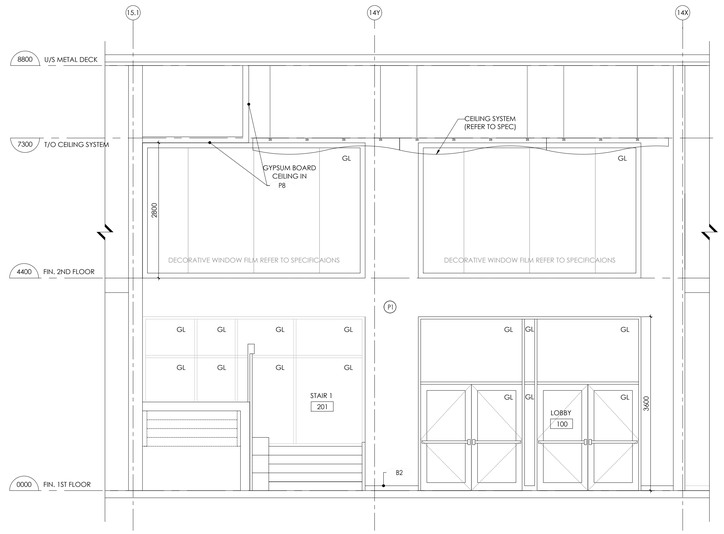


2 / A7.5 EAST INTER. ELEV. - LOBBY

0 500 1000 2500mm

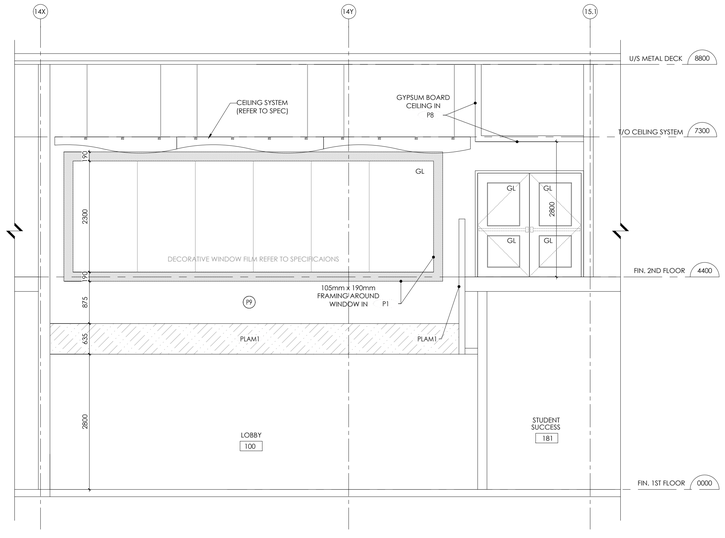

3 / A7.5 WEST INTER. ELEV. - LOBBY

0 500 1000 2500mm

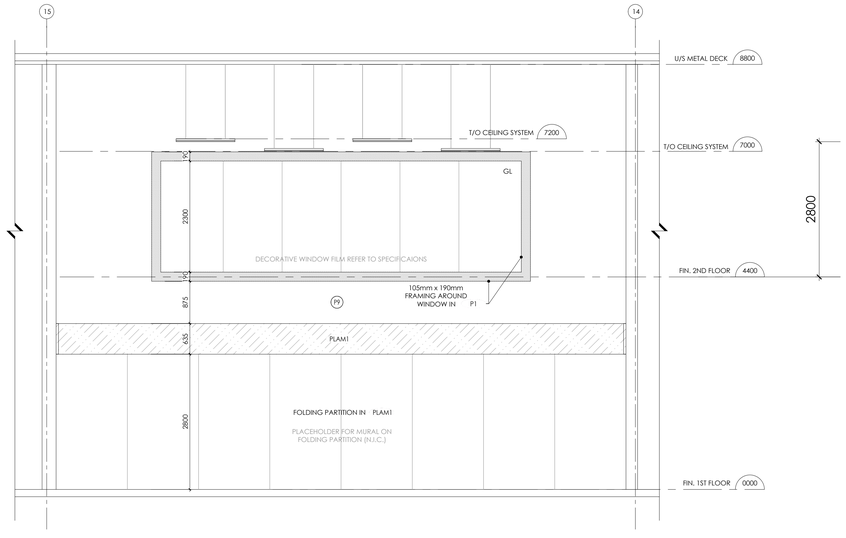

4 / A7.5 EAST INTER. ELEV. - CAFETERIA

0 500 1000 2500mm

REVISIONS

NO.	DATE	PARTICULAR
1	2022.06.06	ISSUED FOR 80% CLASS B COSTING
2	2022.08.18	ISSUED FOR SPA
3	2022.09.22	ISSUED FOR OWNERS REVIEW - 98% SET
4	2022.12.16	ISSUED FOR 2nd SPA SUBMISSION
5	2023.01.31	ISSUED FOR TENDER
6	2023.02.22	ISSUED FOR ADDENDUM 9
7	2023.08.23	ISSUED FOR CONVENIENCE
8	2023.11.20	ISSUED FOR PERMIT COMMENTS
9	2024.01.24	ISSUED FOR SI#03
10	2024.02.15	ISSUED FOR PCN#008
11	2024.03.04	ISSUED FOR PCN#009
12	2024.03.10	ISSUED FOR SI#004
13	2024.05.14	ISSUED FOR SI#006
14	2024.07.22	ISSUED FOR SI#008
15	2024.08.07	ISSUED FOR SI#009
16	2024.10.02	ISSUED FOR PCN#15
17	2025.04.11	ISSUED FOR PCN#019
18	2025.05.01	ISSUED FOR CO#07
19	2025.05.28	ISSUED FOR PCN#20 - CO#010
20	2025.07.31	ISSUED FOR SI#013
21	2025.08.06	ISSUED FOR SI#014
22	2025.08.15	ISSUED FOR PCN#25 - CO#017
23	2025.08.25	ISSUED FOR PCN#27 - CO#021
24	2025.09.02	ISSUED FOR PCN#29
25	2025.09.02	ISSUED FOR SI#20 - CO#018
26	2025.09.08	ISSUED FOR PCN#31
27	2025.09.09	ISSUED FOR PCN#32 - CO#022
28	2025.09.10	ISSUED FOR PCN#33
29	2025.09.11	ISSUED FOR SI#022
30	2025.09.15	ISSUED FOR SI#023
31	2025.09.16	ISSUED FOR PCN #35 - CO#023
32	2025.09.30	ISSUED FOR PCN #37 - CO#029
33	2025.09.30	ISSUED FOR PCN #38 - CO#025
34	2025.10.06	ISSUED FOR PCN #39 - CO#024
35	2025.10.20	ISSUED FOR PCN #40R1
36	2025.10.30	ISSUED FOR PCN#041
37	2025.10.23	ISSUED FOR PCN #42
38	2025.11.21	ISSUED FOR PCN#021/R1 - CO12 CD#006
39	2025.11.14	ISSUED FOR PCN#043
40	2025.11.26	ISSUED FOR PCN#043R1
41	2025.12.03	ISSUED FOR PCN#044 - CO#026
42	2026.02.04	ISSUED FOR RECORD SET UP TO CO#27

NOTES:

KEY PLAN:

All dimensions and measurements must be checked and verified by the General Contractor

Reproduction of drawings and related documents in whole or in part is forbidden without written permission of the Ventin Group.

Near North District School Board

CLIENT:
NEAR NORTH DISTRICT SCHOOL BOARD
NNDSB Tender # 2023-015

PROJECT:
NEW PARRY SOUND K-12 SCHOOL & CHILDCARE

PARRY SOUND HIGH SCHOOL SITE

111 ISABELLA STREET
PARRY SOUND, ONTARIO

ORIGINAL PAGE SIZE ARCH E1 - 30" x 42"

KEY TO DETAIL LOCATION:
A - DETAIL NO.
B - DETAIL NO. ORIGIN

+VG ARCHITECTS
THE VENTIN GROUP LTD

INTERIOR ELEVATIONS

A7.5

DRAWN BY : PS CHECKED BY : EB

Plot Date: Feb 03, 2026 - 5:40pm By: jkelly Filename: I:\1VG-Brantford\Near North DSB Parry Sound School\2111\Drawings\Wd-Current\NN_A7.4 Interior Elevations.dwg


DOOR SCHEDULE - FIRST FLOOR continued....

DOOR NO.	LOCATION	DOOR SIZE	TYPE	MATL.	FIN.	FRAME TYPE	FRAME MATL.	FRAME FIN.	HEAD	JAMB	DEPTH	FIRE RATING FOR WALLS (LISTED IN MINUTES - COORD. W/ FIRE SEPARATION DRAWINGS)	GLASS	REMOVABLE MULLION	OFFICE LOCK	PASSAGE WASHROOM DOOR PACKAGE	PUSH BUTTON OPERATOR	POWER DOOR OPENER/BOTTOM	PUSH BUTTON LOCK	PUSH TO UNLOCK BUTTON	HOLD OPEN	ELECTRIC STRIKE	DOOR CLOSER	SOUND SEAL AT HEAD & SIDES & DOOR BOTTOM	CARD READER	COMBINATION DOOR LOCK AND READER/KEYPAD	MAGNETIC LOCK	ELECTRO-MECHA NICAL LATCH (DET. TYPE)	INTERCOM	LOCAL AUDIBLE ALARM	MOTION DETECTOR	DOOR STATUS SWITCH	LOCK STATUS SWITCH	WEATHER STRIPPING AT JAMBS, HEAD & DOOR BOTTOM	NOTES
D180.1	COUNC.	1050 x 2150	J	WSC	PLAM	MW1	AL	ANO					T																						MOVABLE PARTITION. SLIDING DOOR & HARDWARE BY MOVABLE WALL MANUFACTURER. REFER TO SPEC.
D180.2	COUNC.	1050 x 2150	J	WSC	PLAM	MW1	AL	ANO					T																						MOVABLE PARTITION. SLIDING DOOR & HARDWARE BY MOVABLE WALL MANUFACTURER. REFER TO SPEC.
D180.3	COUNC.	1050 x 2150	J	WSC	PLAM	MW1	AL	ANO					T																						MOVABLE PARTITION. SLIDING DOOR & HARDWARE BY MOVABLE WALL MANUFACTURER. REFER TO SPEC.
D180.4	COUNC.	1050 x 2150	J	WSC	PLAM	MW1	AL	ANO					T																						MOVABLE PARTITION. SLIDING DOOR & HARDWARE BY MOVABLE WALL MANUFACTURER. REFER TO SPEC.
D180.5	COUNC.	1050 x 2150	J	WSC	PLAM	MW1	AL	ANO					T																						MOVABLE PARTITION. SLIDING DOOR & HARDWARE BY MOVABLE WALL MANUFACTURER. REFER TO SPEC.
D181	STUDENT SUCCESS	950 x 2150	A	HM	P	F4	HM	P	50	50	222	30	T										•											
D181.1	STORAGE	950 x 2150	A	HM	FF	F1	HM	P	50	50	172																							
D182	ELECTRICAL ROOM	950 x 2150	A	HM	P	F1	HM	P	50	50	172																							•
D183	STORAGE	950 x 2150	C	HM	P	F1	HM	P	50	50	222	00	T																					
D184	CUSTODIAN	950 x 2150	C	HM	P	F1	HM	P	50	50	222	00	T										•											
D185	CHILDCARE OFFICE	950 x 2150	A	HM	P	F3	HM	P	50	50	222	00	T										•											
D186	CHILDCARE STAFF	950 x 2150	D	HM	P	F1	HM	P	50	50	222	00	T										•											
D188	CHILDCARE STORAGE	950 x 2150	C	HM	P	F1	HM	P	50	50	172	00																						
D189	B.F. WASHROOM	1050 x 2150	A	HM	P	F1	HM	P	50	50	222	00		•		•	•	•	•				•											
D190	CHILDCARE LAUNDRY	950 x 2150	D	HM	P	F1	HM	P	50	50	222	00	T																					
D191	CHILDCARE KITCHEN	950 x 2150	D	HM	P	F1	HM	P	50	50	222	60	FIRE LITE										•											
D192	ONTARIO EARLY YEARS	950 x 2150	D	HM	P	F10	HM	P	50	50	222	00	T										•											
D192.1	EARLY YEARS OFFICE	950 x 2150	D	HM	P	F3	HM	P	50	50	172		T																					
D192.2	WASHROOM	950 x 2150	A	HM	P	F1	HM	P	50	50	172												•											
D192.3	SERVERY	1200 x 2250	E	WSC	PLAM								T																					S/S HARDWARE TO OBC FOR BF ACCESSIBILITY (PROTRUDING HARDWARE). PROVIDE TRACK MOUNTED STOP TO SUIT DOOR LOCATION (MIN. CLEAR OPENING 900mm) PROVIDE LATCH (COORD. W/ HARDWARE SUPPLIER)
D193	INFANT ROOM	950 x 2150	D	HM	P	F3	HM	P	50	50	222	00	T										•											
D193.1	INFANT SLEEP ROOM	1200 x 2250	E	WSC	PLAM								T																					S/S HARDWARE TO OBC FOR BF ACCESSIBILITY (PROTRUDING HARDWARE). PROVIDE TRACK MOUNTED STOP TO SUIT DOOR LOCATION (MIN. CLEAR OPENING 900mm) PROVIDE LATCH (COORD. W/ HARDWARE SUPPLIER)
D193.2	INFANT STORAGE	1200 x 2250	E	WSC	PLAM								T																					S/S HARDWARE TO OBC FOR BF ACCESSIBILITY (PROTRUDING HARDWARE). PROVIDE TRACK MOUNTED STOP TO SUIT DOOR LOCATION (MIN. CLEAR OPENING 900mm) PROVIDE LATCH (COORD. W/ HARDWARE SUPPLIER)
D193.3	INFANT WASHROOM	1200 x 2250	E	WSC	PLAM								T																					S/S HARDWARE TO OBC FOR BF ACCESSIBILITY (PROTRUDING HARDWARE). PROVIDE TRACK MOUNTED STOP TO SUIT DOOR LOCATION (MIN. CLEAR OPENING 900mm) PROVIDE LATCH (COORD. W/ HARDWARE SUPPLIER)
D194	PRESCHOOL ROOM	950 x 2150	D	HM	P	F3	HM	P	50	50	222	00	T										•											
D194.1	PRESCHOOL STORAGE	1200 x 2250	E	WSC	PLAM								T																					S/S HARDWARE TO OBC FOR BF ACCESSIBILITY (PROTRUDING HARDWARE). PROVIDE TRACK MOUNTED STOP TO SUIT DOOR LOCATION (MIN. CLEAR OPENING 900mm) PROVIDE LATCH (COORD. W/ HARDWARE SUPPLIER)
D194.2	PRESCHOOL WASHROOM	1200 x 2250	E	WSC	PLAM								T																					S/S HARDWARE TO OBC FOR BF ACCESSIBILITY (PROTRUDING HARDWARE). PROVIDE TRACK MOUNTED STOP TO SUIT DOOR LOCATION (MIN. CLEAR OPENING 900mm) PROVIDE LATCH (COORD. W/ HARDWARE SUPPLIER)
D195	WASHROOM	950 x 2150	A	HM	P	F1	HM	P	50	50	222	00											•											
D196	TODDLER ROOM	950 x 2150	D	HM	P	F3	HM	P	50	50	222	00	T										•											
D196.1	TODDLER WASHROOM	1200 x 2250	E	WSC	PLAM								T																					S/S HARDWARE TO OBC FOR BF ACCESSIBILITY (PROTRUDING HARDWARE). PROVIDE TRACK MOUNTED STOP TO SUIT DOOR LOCATION (MIN. CLEAR OPENING 900mm) PROVIDE LATCH (COORD. W/ HARDWARE SUPPLIER)
D196.2	TODDLER STORAGE	1200 x 2250	E	WSC	PLAM								T																					S/S HARDWARE TO OBC FOR BF ACCESSIBILITY (PROTRUDING HARDWARE). PROVIDE TRACK MOUNTED STOP TO SUIT DOOR LOCATION (MIN. CLEAR OPENING 900mm) PROVIDE LATCH (COORD. W/ HARDWARE SUPPLIER)
DC101A	CORRIDOR 1 - SOUTH	2 - 1200 x 2150	D	HM	P	F6	HM	P	50	50	222	30	T	•								EL	•											
DC101B	CORRIDOR 1 - NORTH	2 - 1200 x 2150	D	HM	P	F6	HM	P	50	50	222	30	T	•								EL	•											
DC106	CHILDCARE CORRIDOR 6	1050 x 2150	D	HM	P	F4	HM	P	50	50	222	60	FIRE LITE										•											
DC107	CHILDCARE CORRIDOR 7	1050 x 2150	A	HM	P	F1	HM	P	50	50	172											•	•											•
DS102A	STAIR 2	2 - 1050 x 2150	G	AL	ANO	W18	AL	ANO	64	64	154		LSG	•			•	•					•	•										•
DS102B	STAIR 2	2 - 1050 x 2150	D	HM	P	F2	HM	P	50	50	172	60	FIRE LITE	•			•	•					•	•										
DS102C	STAIR 2	2 - 1050 x 2150	G	AL	ANO	W31	AL	ANO	64	64	154		LSG	•			•	•					•	•										•
DS103A	STAIR 3	2 - 1050 x 2150	G	AL	ANO	W20	AL	ANO	64	64	154		LSG	•									•	•										•
DS103B	STAIR 3	2 - 1050 x 2150	D	HM	P	F2	HM	P	50	50	172	60	FIRE LITE	•										•										
DS104A	STAIR 4	2 - 1050 x 2150	G	AL	ANO	W18	AL	ANO	64	64	154		LSG	•										•										•
DS104B	STAIR 4	2 - 1050 x 2150	D	HM	P	F2	HM	P	50	50	172	60	FIRE LITE	•										•										
DS105A	STAIR 5	2 - 1050 x 2150	G	AL	ANO	W16	AL	ANO	64	64	154		LSG	•										•										•
DS105B	STAIR 5	950 x 2150	D	HM	P	F1	HM	P	50	50	172	60	FIRE LITE											•										
DS106	MUSIC ROOM STAGE	950 x 2150	C	HM	P	F1	HM	P	50	50	222	30	FIRE LITE											•	•									
DV101A	VESTIBULE 1	2 - 1050 x 2150	F	AL	ANO	W7	AL	ANO	64	64	191		LSG	•									•	•										•
DV101B	VESTIBULE 1	2 - 1050 x 2150	F	AL	ANO	W7	AL	ANO	64	64	191		LSG	•			•	•					•	•		•								•
DV101C	VESTIBULE 1	2 - 1050 x 2150	F	AL	ANO	F11	AL	ANO	50	50	114		T										•	•										
DV101D	VESTIBULE 1	2 - 1050 x 2150	F	AL	ANO	F11	AL	ANO	50	50	114		T				•	•					•	•										
DV102A	VEST. 2	1050 x 2150	G	AL	ANO	W10	AL	ANO	50	50	154		LSG				•	•					•											•
DV102B	VEST. 2	1050 x 2150	D	HM	P	F4	HM	P	50	50	172		T				•	•					•											
DV103A	VEST. 3	950 x 2150	G	AL	ANO	W9	AL	ANO	64	64	152		LSG										•											•
DV104A	VEST. 4	1050 x 2150	G	AL	ANO	W11	AL	ANO	50	50	154		LSG				•	•					•	•		•								•
DV104B	VEST. 4	1050 x 2150	D	HM	P	F4	HM	P	50	50	172		T				•	•					•											
DV105A	VEST. 5	2 - 1050 x 2150	C	HM	P	F6	HM	P	50	50	172		LSG	•									•											•
DV105B	VEST. 5	2 - 1050 x 2150	C	HM	P	F6	HM	P	50	50	222		T	•									•											
DV106A	VEST. 6	1050 x 2150	G	AL	ANO	W13	AL	ANO	64	64	152		LSG										•											•
DV106B	VEST. 6	1050 x 2150	D	HM	P	F4	HM	P	50	50	172		T										•											


SCREEN SCHEDULE

ROOM #	LOCATION	TYPE	MATL.	FIN.	HEAD	JAMB	DEPTH	FIRE RATING FOR WALLS (LISTED IN MINUTES - COORD. W/ FIRE SEPARATION DWGS)	GLASS	NOTES
104	PRINCIPAL OFFICE	S2	HM	P	50	50	172		T	
107	HEALTH ROOM	S3	HM	P	50	50	172		T	
141	BAKING	S4	HM	P	50	50	222	60	FIRE LITE	
142	SERVERY	S1	HM	P	50	50	222	60	FIRE LITE	
150	EXERCISE ROOM	S2	HM	P	50	50	172		T	
150	EXERCISE ROOM	S2	HM	P	50	50	172		T	
201	COLLABORATION	S5	S/S	FF				60	T	• C.R. LAURENCE, OR APPROVED EQUAL, STAINLESS STEEL SHOE, HEAD & JAMBS. GLAZING TO BE ENGINEERED AS GUARD PER OBC MIN. 16mm TEMPERED GLASS. • WINDOW SPRINKLERS REQUIRED BOTH SIDES OF GLASS. CLEAR SILICONE JOINTS. (COORD. W/ LIFE SAFETY DWGS)
203.2	SEMINAR	S9	S/S	FF				60	T	• C.R. LAWRENCE STAINLESS STEEL SHOE, HEAD & JAMBS. GLAZING TO BE ENGINEERED AS GUARD PER OBC MIN. 16mm TEMPERED GLASS. WINDOW SPRINKLERS REQUIRED ON BOTH SIDES OF GLASS. CLEAR SILICONE JOINTS. •SCREEN TO BE DESIGNED & ENGINEERED TO WITHSTAND THE LOADS ON GUARDS FOR FRAMES & GLAZING AS PER LATEST OBC.
225.3	CONTROL ROOM	S6	HM	P	50	50	172	60	FIRE LITE	
225.3	CONTROL ROOM	S7	HM	P	50	50	172		T	• VINYL FILM REQUIRED. REFER TO INTERIOR ELEVATIONS • OPERATING SASH REQUIRED AT CONTROL BOOTH
251.1	SEMINAR	S10	S/S	FF				60	T	• C.R. LAWRENCE STAINLESS STEEL SHOE, HEAD & JAMBS. GLAZING TO BE ENGINEERED AS GUARD PER OBC MIN. 16mm TEMPERED GLASS. WINDOW SPRINKLERS REQUIRED ON BOTH SIDES OF GLASS. CLEAR SILICONE JOINTS. •SCREEN TO BE DESIGNED & ENGINEERED TO WITHSTAND THE LOADS ON GUARDS FOR FRAMES & GLAZING AS PER LATEST OBC
C201	CORRIDOR 1	S5	S/S	FF				60	T	• C.R. LAURENCE, OR APPROVED EQUAL, STAINLESS STEEL SHOE, HEAD & JAMBS. GLAZING TO BE ENGINEERED AS GUARD PER OBC MIN. 16mm TEMPERED GLASS. • WINDOW SPRINKLERS REQUIRED BOTH SIDES OF GLASS. CLEAR SILICONE JOINTS. (COORD. W/ LIFE SAFETY DWGS)
C201	CORRIDOR 1 @ GYM A	S8	HM	P	50	50	172	60	FIRE LITE	• VINYL FILM REQUIRED • DESIGN & ENGINEER TO WITHSTAND THE LOADS ON GUARDS FOR FRAMES & GLAZING AS PER LATEST OBC.
C201	CORRIDOR 1 @ GYM B	S8	HM	P	50	50	172	60	FIRE LITE	• VINYL FILM REQUIRED • DESIGN & ENGINEER TO WITHSTAND THE LOADS ON GUARDS FOR FRAMES & GLAZING AS PER LATEST OBC.
202	COUNCIL.	S11	HM	P	50	50	172	60	FIRE LITE	• VINYL FILM REQUIRED • DESIGN & ENGINEER TO WITHSTAND THE LOADS ON GUARDS FOR FRAMES & GLAZING AS PER LATEST OBC.

SCREEN TYPES

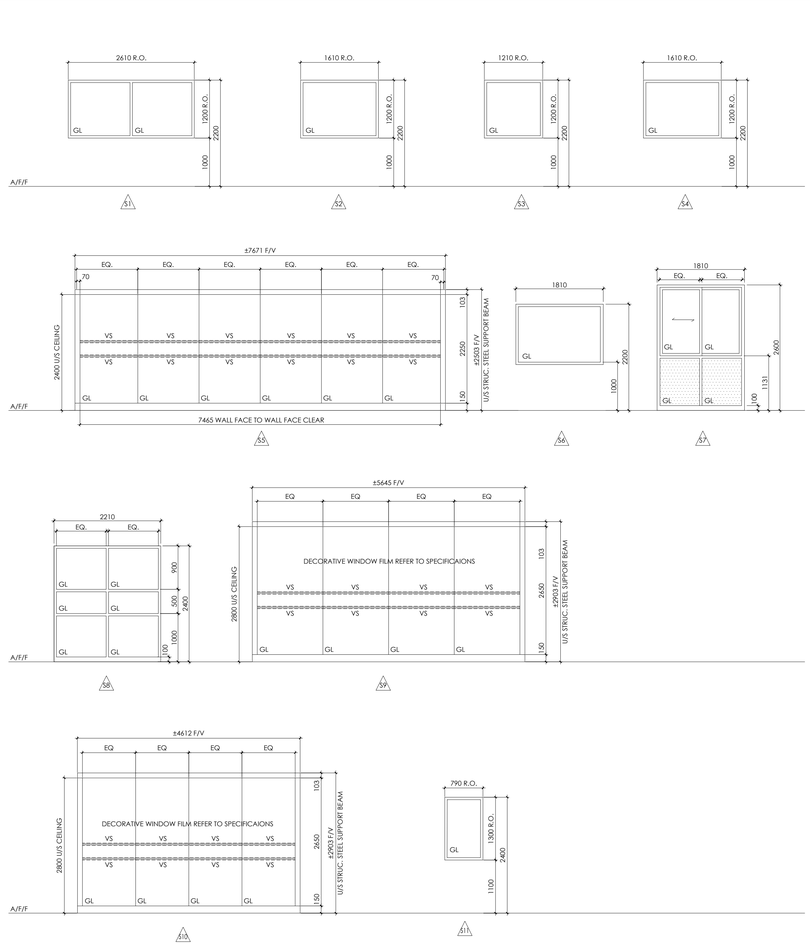

MOVEABLE PARTITION

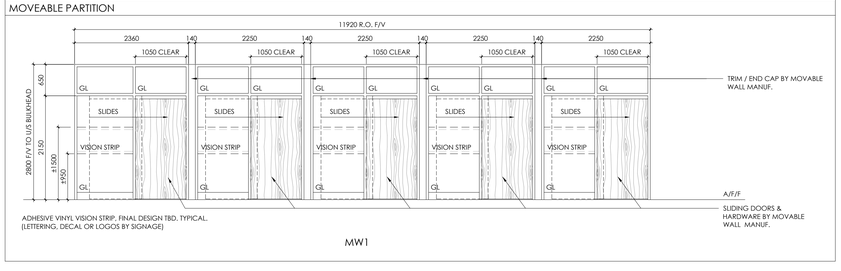

MW1

REVISIONS

NO.	DATE	PARTICULAR
1	2022.06.06	ISSUED FOR 80% CLASS B COSTING
2	2022.08.18	ISSUED FOR SPA
3	2022.09.22	ISSUED FOR OWNERS REVIEW - 98% SET
4	2022.12.16	ISSUED FOR 2nd SPA SUBMISSION
5	2023.01.31	ISSUED FOR TENDER
6	2023.02.22	ISSUED FOR ADDENDUM 9
7	2023.08.23	ISSUED FOR CONVENIENCE
8	2023.11.20	ISSUED FOR PERMIT COMMENTS
9	2024.01.24	ISSUED FOR SI#03
10	2024.02.15	ISSUED FOR PCN#008
11	2024.03.04	ISSUED FOR PCN#009
12	2024.03.10	ISSUED FOR SI#004
13	2024.05.14	ISSUED FOR SI#006
14	2024.07.22	ISSUED FOR SI#008
15	2024.08.07	ISSUED FOR SI#009
16	2024.10.02	ISSUED FOR PCN#15
17	2025.04.11	ISSUED FOR PCN#019
18	2025.05.01	ISSUED FOR CO#07
19	2025.05.28	ISSUED FOR PCN#20 - CO#010
20	2025.07.31	ISSUED FOR SI#013
21	2025.08.06	ISSUED FOR SI#014
22	2025.08.15	ISSUED FOR PCN#25 - CO#017
23	2025.08.25	ISSUED FOR PCN#27 - CO#021
24	2025.09.02	ISSUED FOR PCN#29
25	2025.09.02	ISSUED FOR SI#20 - CO#018
26	2025.09.08	ISSUED FOR PCN#31
27	2025.09.09	ISSUED FOR PCN#32 - CO#022
28	2025.09.10	ISSUED FOR PCN#33
29	2025.09.11	ISSUED FOR SI#022
30	2025.09.15	ISSUED FOR SI#023
31	2025.09.16	ISSUED FOR PCN #35 - CO#023
32	2025.09.30	ISSUED FOR PCN #37 - CO#029
33	2025.09.30	ISSUED FOR PCN #38 - CO#025
34	2025.10.06	ISSUED FOR PCN #39 - CO#024
35	2025.10.20	ISSUED FOR PCN #40#81
36	2025.10.30	ISSUED FOR PCN#041
37	2025.10.23	ISSUED FOR PCN #42
38	2025.11.21	ISSUED FOR PCN#021/R1 - CO12 CD#006
39	2025.11.14	ISSUED FOR PCN#043
40	2025.11.26	ISSUED FOR PCN#043R1
41	2025.12.03	ISSUED FOR PCN#044 - CO#026
42	2026.02.04	ISSUED FOR RECORD SET UP TO CO#27

NOTES:

KEY PLAN:

All dimensions and measurements must be checked and verified by the General Contractor

Reproduction of drawings and related documents in whole or in part is forbidden without written permission of the Ventin Group.

Near North District School Board

CLIENT:
NEAR NORTH DISTRICT SCHOOL BOARD
NNDSB Tender # 2023-015

PROJECT:
NEW PARRY SOUND K-12 SCHOOL & CHILDCARE

PARRY SOUND HIGH SCHOOL SITE

111 ISABELLA STREET
PARRY SOUND, ONTARIO

ORIGINAL PAGE SIZE ARCH E1 - 30" x 42"
KEY TO DETAIL LOCATION:
A - DETAIL NO.
B - DETAIL NO. ORIGIN

+VG ARCHITECTS
THE VENTIN GROUP LTD

DOOR SCHEDULE - FIRST FLOOR CONTINUED, SCREEN SCHEDULE, SCREEN TYPES & MOVEABLE WALL SCHEDULE

A8.2

Filename: K:\VG-Brantford\Near North DSB Parry Sound School\2211\Drawings\Wd Current\ NN- A8.1.dwg
Plot Date: Feb 03, 2026 - 5:41pm By: jkelly

DRAWN BY : KH CHECKED BY : EB


DOOR SCHEDULE - FIRST FLOOR

DOOR						FRAME																															
NO.	LOCATION	DOOR SIZE	TYPE	MATL.	FIN.	TYPE	MATL.	FIN.	HEAD	JAMB	DEPTH	FIRE RATING FOR WALLS (LISTED IN MINUTES - COORD. W/ FIRE SEPARATION DRAWINGS)	GLASS	REMOVABLE MULLION	GRILLE	UNIVERSAL WASHROOM DOOR ACCESS	POWER DOOR OPERATOR	POWER DOOR OPENER BUTTON	PUSH TO LOCK BUTTON	PUSH TO UNLOCK BUTTON	HOLD OPEN	ELECTRIC STRIKE	DOOR CLOSER	SCHLAGE S & T HEAD, JAMBS & DOOR BOTTOM	CARD READER	COMBINATION PROXIMITY CARD READER/KEYPAD	MAGNETIC LOCK	ELECTRO-MECHANICAL LOCK (DET. TYPE)	INTERCOM	LOCAL AUDIBLE ALARM	MOTION SENSOR	DOOR STATUS SWITCH	LOCK STATUS SWITCH	WEATHER STRIPPING AT HEAD, JAMBS & DOOR BOTTOM	NOTES
D102	MEETING ROOM	950 x 2150	A	HM	P	F8	HM	P	50	50	172		T										•	•												
D103	ADMINISTRATION OFFICE	950 x 2150	B	HM	P	F9	HM	P	50	50	222	30	FIRE LITE										•													
D103.1	SERVICE AREA	950 x 2150	B	HM	P	F9	HM	P	50	50	222	30	FIRE LITE										•													
D104	PRINCIPAL OFFICE	950 x 2150	A	HM	P	F4	HM	P	50	50	172		T											•												
D105	VP OFFICE	950 x 2150	A	HM	P	F4	HM	P	50	50	172		T											•												
D106	VP OFFICE	950 x 2150	A	HM	P	F4	HM	P	50	50	172		T											•												
D107	HEALTH ROOM	950 x 2150	C	HM	P	F1	HM	P	50	50	172		T																							
D108	WASHROOM	950 x 2150	A	HM	P	F1	HM	P	50	50	172												•													
D109A	WORKROOM	950 x 2150	C	HM	P	F1	HM	P	50	50	172		T										•													
D109B	WORKROOM	950 x 2150	C	HM	P	F1	HM	P	50	50	222	00	T										•													
D110	O.S.R.	950 x 2150	C	HM	P	F1	HM	P	50	50	172	60	FIRE LITE										•	•												
D111	I.T.	950 x 2150	A	HM	P	F1	HM	P	50	50	222	60											•													
D112	COSMETOLOGY & HEALTH SCIENCE	950 x 2150	D	HM	P	F1	HM	P	50	50	222	00	T										•													
D112.1	STORAGE / LAUNDRY	950 x 2150	C	HM	P	F1	HM	P	50	50	172		T																							
D113	CLASSROOM 1	950 x 2150	A	HM	P	F4	HM	P	50	50	222	00	T										•													
D114	CLASSROOM 2	950 x 2150	A	HM	P	F4	HM	P	50	50	222	00	T										•													
D115	CLASSROOM 3	950 x 2150	A	HM	P	F4	HM	P	50	50	222	00	T										•													
D116	CLASSROOM 4	950 x 2150	A	HM	P	F4	HM	P	50	50	222	00	T										•													
D117	SPEC. ED, GR 7 & 8	950 x 2150	A	HM	P	F4	HM	P	50	50	222	60	FIRE LITE										•													
D117.1A	STORAGE	1200 x 2250	E	WSC	PLAM								T																							S/S HARDWARE TO OBC FOR BF ACCESSIBILITY (PROTRUDING HARDWARE). PROVIDE TRACK MOUNTED STOP TO SUIT DOOR LOCATION (MIN. CLEAR OPENING 900mm) PROVIDE LOCKSET (COORD. W/ HARDWARE SUPPLIER)
D117.1B	STORAGE	950 x 2150	C	HM	P	F1	HM	P	50	50	222		T																							
D118.1	SENSORY ROOM	950 x 2150	C	HM	P	F1	HM	P	50	50	172		T										•	•												
D118.2	UNIVERSAL TOILET ROOM	1050 x 2150		HM	P	F1	HM	P	50	50	172					•																				
D118A	LIFE SKILLS	1200 x 2250	E	WSC	PLAM								T																							S/S HARDWARE TO OBC FOR BF ACCESSIBILITY (PROTRUDING HARDWARE). PROVIDE TRACK MOUNTED STOP TO SUIT DOOR LOCATION (MIN. CLEAR OPENING 900mm) PROVIDE LATCH (COORD. W/ HARDWARE SUPPLIER)
D118B	LIFE SKILLS	1200 x 2250	E	WSC	PLAM								T																							S/S HARDWARE TO OBC FOR BF ACCESSIBILITY (PROTRUDING HARDWARE). PROVIDE TRACK MOUNTED STOP TO SUIT DOOR LOCATION (MIN. CLEAR OPENING 900mm) PROVIDE LATCH (COORD. W/ HARDWARE SUPPLIER)
D119	MEETING	950 x 2150	C	HM	P	F1	HM	P	50	50	222		T											•	•											
D120	SPEC. ED, GR 9-12	950 x 2150	A	HM	P	F4	HM	P	50	50	222	60	FIRE LITE											•												
D120.1	WASHROOM	950 x 2150	A	HM	P	F1	HM	P	50	50	222				•									•												
D121	WATER METER ROOM	950 x 2150	A	HM	P	F1	HM	P	50	50	172																							•		
D122	SPEC. ED, CLASSROOM	2 - 1200 x 2250	E	WSC	PLAM								T																							S/S HARDWARE TO OBC FOR BF ACCESSIBILITY (PROTRUDING HARDWARE). PROVIDE TRACK MOUNTED STOP TO SUIT DOOR LOCATION (MIN. CLEAR OPENING 900mm)
D122.1	STORAGE	950 x 2150	C	HM	P	F1	HM	P	50	50	222		T																							
D123A	CONSTRUCTION TECH. ROOM	2 - 1050 x 2150	D	HM	P	F2	HM	P	50	50	172	60	FIRE LITE	•										•	•												
D123B	CONSTRUCTION TECH. ROOM	950 x 2150	A	HM	P	F3	HM	P	50	50	172	60	FIRE LITE											•	•												
D123C	AIR COMPRESSOR	950 x 2150	A	HM	P	F1	HM	P	50	50	222																									
D123D	CONSTRUCTION TECH. ROOM	1050 x 2150	C	HM	P	F7	HM	P	50	50	172		LSG											•											•		
D123E	CONSTRUCTION TECH. ROOM	3600 x 3000	H	HM	P	F5	BSP	GALV/P					LSG																						•	REFER TO SPEC
D124	RECEIVING & STORAGE	2 - 1050 x 2150	C	HM	P	F2	HM	P	50	50	222	00	T												•											
D125	CUST. OFFICE	950 x 2150	C	HM	P	F1	HM	P	50	50	172		T																							
D126	CUST. STAFF	950 x 2150	C	HM	P	F1	HM	P	50	50	172		T																							
D127	WASHROOM	950 x 2150	A	HM	P	F1	HM	P	50	50	222	00											•													
D128	WASHROOM	950 x 2150	A	HM	P	F1	HM	P	50	50	222	00											•													
D129	ELEC.	950 x 2150	A	HM	P	F1	HM	P	50	50	222	60																								
D130A	AUTOCAD COMP. LAB	950 x 2150	A	HM	P	F4	HM	P	50	50	222	00	T										•													
D130B	AUTOCAD COMP. LAB	950 x 2150	A	HM	P	F3	HM	P	50	50	172		T										•													
D131	TECH. CLASSROOM	950 x 2150	A	HM	P	F4	HM	P	50	50	222	00	T										•													
D133	BARRIER FREE WASHROOM	1050 x 2150	A	HM	P	F1	HM	P	50	50	222	00					•	•	•	•			•													
D135	STORAGE	950 x 2150	C	HM	P	F1	HM	P	50	50	222	00											•													
D136	CUST.	950 x 2150	C	HM	P	F1	HM	P	50	50	222	00											•													
D137	STAFF WASHROOM	950 x 2150	A	HM	P	F1	HM	P	50	50	222	00											•													
D138	STAFF WASHROOM	950 x 2150	A	HM	P	F1	HM	P	50	50	222	00											•													
D139A	TRANSPORATION TECH ROOM	2 - 1050 x 2150	D	HM	P	F2	HM	P	50	50	172	60	FIRE LITE	•									•													
D139B	TRANSPORATION TECH ROOM	950 x 2150	A	HM	P	F3	HM	P	50	50	172	60	FIRE LITE										•													
D139C	TRANSPORATION TECH ROOM	1050 x 2150	C	HM	P	F7	HM	P	50	50	172		LSG										•											•		
D139D	TRANSPORATION TECH ROOM	3000 x 3000	H	HM	P	F5	BSP	GALV/P					LSG																					•	REFER TO SPEC
D139E	TRANSPORATION TECH ROOM	3000 x 3000	H	HM	P	F5	BSP	GALV/P					LSG																					•	REFER TO SPEC
D139F	TRANSPORATION TECH ROOM	3000 x 3000	H	HM	P	F5	BSP	GALV/P					LSG																					•	REFER TO SPEC
D140A	CULINARY ARTS FOOD LABS	950 x 2150	C	HM	P	F1	HM	P	50	50	172	60	FIRE LITE										•													
D140B	CULINARY ARTS FOOD LABS	950 x 2150	C	HM	P	F1	HM	P	50	50	172	60	FIRE LITE										•													
D140C	DRY STORAGE	950 x 2150	C	HM	P	F1	HM	P	50	50	172		T										•													
D140D	WALK-IN COOLER	950 x 2150		S/S																															MANUFACTURER TO SUPPLY
D140E	WALK-IN FREEZER	950 x 2150		S/S																															MANUFACTURER TO SUPPLY
D140F	CULINARY ARTS FOOD LABS	950 x 2150	C	HM	P	F1	HM	P	50	50	172	60	FIRE LITE										•													
D141	BAKING	950 x 2150	D	HM	P	F1	HM	P	50	50	172		T										•													
D142A	SERVERY	950 x 2150	D	HM	P	F1	HM	P	50	50	222	60	FIRE LITE										•													
D142B	SERVERY	950 x 2150	A	HM	P	F4	HM	P	50	50	222	60	FIRE LITE										•													
D142C	SERVERY	950 x 2150	D	HM	P	F1	HM	P	50	50	172		T																							
D143.1	STORAGE	950 x 2150	C	HM	P	F1	HM	P	50	50	172																									
D143A	STUDENT COMMONS CAFETORIUM	1050 x 2150	G	AL	ANO		AL	ANO	64	64	191		LSG										•											•		
D143B	STUDENT COMMONS CAFETORIUM	1050 x 2150	G	AL	ANO		AL	ANO	64	64	191		LSG										•											•		
D143C	STUDENT COMMONS CAFETORIUM	1050 x 2150	D	HM	P	F3	HM	P	50	50	172		T					•	•				•													
D143D	STUDENT COMMONS CAFETORIUM	1050 x 2150	D	HM	P	F3	HM	P	50	50	172		T					•	•				•													
D145	PRACTICE ROOM	950 x 2150	C	HM	P	F1	HM	P	50	50	172		T										•	•												ACOUSTIC DOOR
D146	PRACTICE ROOM	950 x 2150	C	HM	P	F1	HM	P	50	50	172		T										•	•												ACOUSTIC DOOR
D147	INSTRUMENT STORAGE	950 x 2150	C	HM	P	F1	HM	P	50	50	172		T																							
D148A	GYMNASIUM A	2 - 1050 x 2150	D	HM	P	F2	HM	P	50	50	172	30	FIRE LITE	•									•													
D148B	GYMNASIUM A	2 - 1050 x 2150	A	HM	P	F2	HM	P	50	50	172			•									•											•		
D149	GYM OFFICE	950 x 2150	D	HM	P	F1	HM	P	50	50	172		T																							
D150	EXERCISE ROOM	2 - 1050 x 2150	D	HM	P	F2	HM	P	50	50	172		T	•									•													
D151A	GYMNASIUM B	2 - 1050 x 2150	D	HM	P	F2	HM	P	50	50	172	30	FIRE LITE	•									•													
D151B	GYMNASIUM B	2 - 1050 x 2150	A	HM	P	F2	HM	P	50	50	172			•									•											•		
D151C	GYMNASIUM B	2 - 1050 x 2150	C	HM	P	F2	HM	P	50	50	172		T										•													
D152	GYM STORAGE	2 - 1050 x 2150	C	HM	P	F2	HM	P	50	50	172		T																							
D153	GYM STORAGE	2 - 1050 x 2150	A	HM	P	F2	HM	P	50	50	172																									
D154A	GYMNASIUM C	2 - 1050 x 2150	A	HM	P	F2	HM	P	50	50	172	30	FIRE LITE	•									•													
D154B	GYMNASIUM C	2 - 1050 x 2150	A	HM	P	F2	HM	P	50	50	172			•									•											•		
D154C	GYMNASIUM C	2 - 1050 x 2150	A	EX	P	F2	HM	P	50	50	172			•									•											•		
D156	CUST.	950 x 2150	C	HM	P	F1	HM	P	50	50	172	00	T										•													
D158	I.T.	950 x 2150	A	HM	P	F1	HM	P	50	50	222	00											•													
D159	STAFF WASHROOM	950 x 2150	A	HM	P	F1	HM	P	50	50	222	00											•													
D160	STAFF WASHROOM	950 x 2150	A	HM	P	F1	HM	P	50	50	222	00											•													
D161	ELEM. TEACHERS WORKROOM	950 x 2150	C	HM	P	F1	HM	P	50	50	222	00	T										•													
D162	ELEM. CLASSROOM 1	950 x 2150	A	HM	P	F4	HM	P	50	50	222	00	T										•													
D163	ELEM. CLASSROOM 2	950 x 2150	A	HM	P	F4	HM	P	50	50	222	00	T										•													
D164A	KINDERG. CLASSROOM 2	950 x 2150	A	HM	P	F4	HM	P	50	50	222	00	T										•													
D164B	KINDERG. CLASSROOM 2	950 x 2150	A	HM	P	F4	HM	P	50	50	172		T										•													
D165	KINDERGARTEN WASHROOM	1200 x 2250	E	WSC	PLAM								T																							S/S HARDWARE TO OBC FOR BF ACCESSIBILITY (PROTRUDING HARDWARE). PROVIDE TRACK MOUNTED STOP TO SUIT DOOR LOCATION (MIN. CLEAR OPENING 900mm) PROVIDE LATCH (COORD. W/ HARDWARE SUPPLIER)
D166.1	KINDERGARTEN WASHROOM	1200 x 2250	E	WSC	PLAM								T																							S/S HARDWARE TO OBC FOR BF ACCESSIBILITY (PROTRUDING HARDWARE). PROVIDE TRACK MOUNTED STOP TO SUIT DOOR LOCATION (MIN. CLEAR OPENING 900mm) PROVIDE LATCH (COORD. W/ HARDWARE SUPPLIER)
D166A	KINDERG. CLASSROOM 1	950 x 2150	A	HM	P	F4	HM	P	50	50	222	00	T										•													
D166B	KINDERG. CLASSROOM 1	950 x 2150	A	HM	P	F4	HM	P	50	50	172		T										•													
D167	RESOURCE ROOM	950 x 2150	C	HM	P	F1	HM	P	50	50	222	00	T										•													
D168	CHANGE ROOM	950 x 2150	A	HM	P	F1	HM	P	50	50	222	00											•													
D169	WASHROOM	950 x 2150	A	HM	P	F1	HM	P	50	50	172												•													
D170	WASHROOM	950 x 2150	A	HM	P	F1	HM	P	50	50	222	00											•													
D171	WASHROOM	950 x 2150	A	HM	P	F1	HM	P	50	50	222	00											•													
D172	CHANGE ROOM	950 x 2150	A	HM	P	F1	HM	P	50	50	222	00											•													
D173	WASHROOM	950 x 2150	A	HM	P	F1	HM	P	50	50	172												•													
D174	CHANGE ROOM	950 x 2150	A	HM	P	F1	HM	P	50	50	222	00											•													
D175	WASHROOM	950 x 2150	A	HM	P	F1	HM	P	50	50	172												•													
D176	CHANGE ROOM	950 x 2150	A	HM	P	F1	HM	P	50	50	222	00											•													
D177	WASHROOM	950 x 2150	A	HM	P	F1	HM	P	50	50	172												•													
D178	TEACHER PREP.	950 x 2150	C	HM	P	F1	HM	P	50	50	222	00	T										•													
D179	STAFF LOUNGE	950 x 2150	C	HM	P	F1	HM	P	50	50	222	00	T										•													
D180	GUIDANCE	950 x 2150	C	HM	P	F1	HM	P	50	50	222	00	T										•													


DOOR TYPES

DESCRIPTION


TYPE A

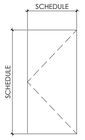


TYPE B

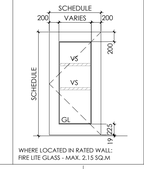


TYPE C

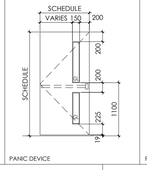


TYPE D

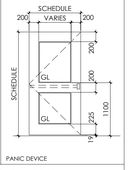

TYPE E - BARN DOOR

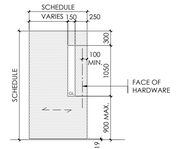


TYPE F - ALUMINUM

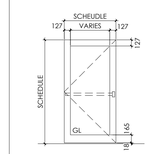


- EXTERIOR (KAWNEER 560 INSULCLAD) (USE CONCEALED EXIT DEVICE WHERE REQUIRED)
- INTERIOR (KAWNEER 500 WIDE STILE) 50mm FRAMING FOR ENTRANCE

TYPE G - ALUMINUM

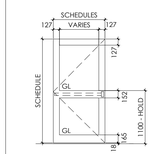


- EXTERIOR (KAWNEER 560 INSULCLAD W/ MID-RAIL)
- INTERIOR (KAWNEER 500 WIDE STILE) 50mm FRAMING FOR ENTRANCE


TYPE H

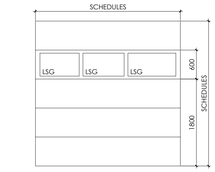

TYPE J

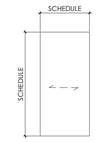

DOOR FRAMES

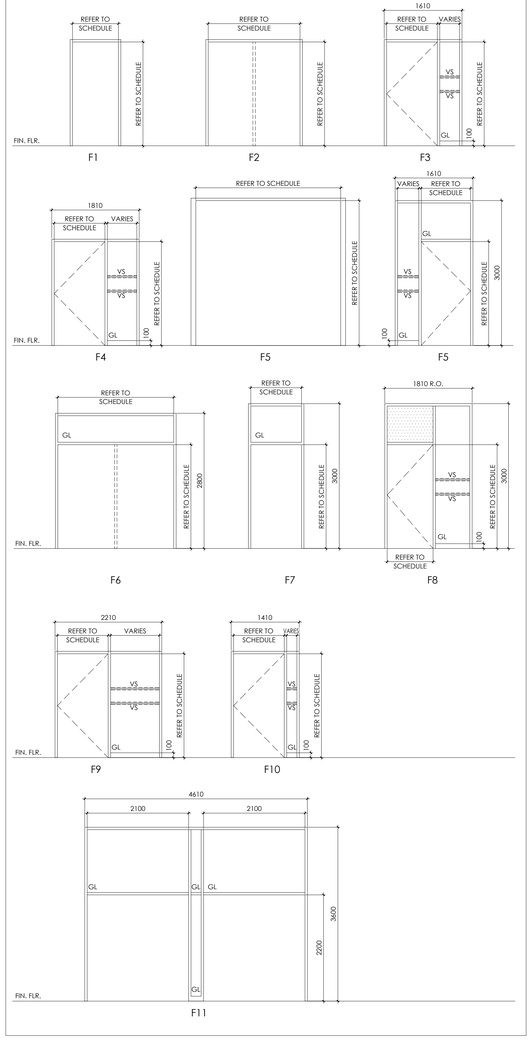

LEGEND

- #### DATUM — FIN. FLR. LEVEL (ABOVE FINISHED FLOOR)
- W# — WINDOW #
- # — SCREEN #
- D### — ROOM NUMBER

ABBREVIATIONS

ANO	ANODIZED FINISH
AL	ALUMINUM
FF	FACTORY FINISH
FIRE LITE	FIRE RATED GLASS
GALV	GALVANIZED
HM	HOLLOW METAL
LSG	LAMINATED SAFETY GLAZING
O/H	OVERHEAD DOOR
P	PAINTED
S&V	STAIN & VARNISH
S/S	STAINLESS STEEL
T	TEMPERED GLASS
TDG	TEMPERED DOUBLE GLAZING
WSC	WOOD SOLID CORE

HATCHES

- GL — VISION GLAZING (REFER TO SPEC) REFER TO DOOR SCHEDULE FOR GLASS TYPE
- SPANDREL GLAZING W/ INSUL. METAL BACKPAN (LIGHT COLOUR)
- PRE-FINISHED ALUM. SOLID/COMPOSITE PANEL (COLOUR)
- PLAM (COLOUR)

GENERAL NOTES

- CONTRACTOR TO VERIFY ALL OPENINGS ON SITE PRIOR TO FABRICATION
- COORD. W/ BLDG. ELEVATIONS & FLR. PLANS FOR LOCATIONS & QUANTITY OF CURTAIN WALLS
- COORD. W/ BLDG. ELEVATION FOR LOCATIONS WHERE OPERATOR LOCATIONS ARE REVERSED & OR UNITS ARE MIRROR IMAGES OF UNITS SHOWN ON THIS SCH.
- SHOP DWG.'S TO BE IN DIMENSION UNITS AS ILLUSTRATED ON THIS DWG. OR THEY WILL BE REJECTED (IMPERIAL & METRIC BOTH SHOWN IS ACCEPTABLE)

DOOR & FRAME / SCREEN SCH. NOTES

IT IS THE RESPONSIBILITY OF THE DOOR, FRAME & HARDWARE MANUFACTURER TRADES TO CO-ORDINATE & EXECUTE THEIR WORK TOGETHER.

DIMENSIONS INDICATED ARE R.O. - VERIFY ALL OPENING DIMENSIONS ON SITE PRIOR TO FABRICATION & ORDERING

COORD. WITH TYPICAL DOOR & WINDOW DETAILS PROVIDED

1. COORD. W/ FLOOR PLANS ON LIFE SAFETY DRAWING'S) FOR FIRE SEPARATIONS REQUIRING FIRE RATED DOORS.
2HR. FIRE SEPARATION TO HAVE 1 ½ HR. FIRE RATED DOORS/FRAMES.
1HR. FIRE SEPARATIONS TO HAVE 3/4 HR. FIRE RATED DOORS/FRAMES.
1/2 HR. FIRE SEPARATIONS TO HAVE 20 MIN. FIRE RATED DOORS/FRAMES.

2. ALL FIRE RATED DOORS & SCREENS W/ GLAZING "GL" TO HAVE "FIRELITE" GLAZING AS REQ.'D INCLUDING ALL EXPOSURE SITUATIONS, ALL NON RATED GLAZING TO BE TEMPERED TYP. ALL EXTERIOR DOOR GLAZING TO BE LAMINATED SAFETY GLASS. ALL EXTERIOR DOORS & SCREENS TO HAVE INSULATED DOUBLE GLAZING, ALL INTERIOR DOORS & SCREENS TO HAVE SINGLE GLAZING.

3. FRAMES FOR CONC. BLOCK WALLS SHALL BE WRAP AROUND TYPE FOR WALL THICKNESS' UP TO 190mm.
140mm CONC. BLOCK WALLS TO RECEIVE 168mm FRAMES.
190mm CONC. BLOCK WALLS TO RECEIVE 222mm FRAMES.
240mm OR OVER CONC. BLOCK WALLS TO RECEIVE 172mm FRAMES.
(COORD. W/ FLR. PLANS FOR WALL THICKNESS)
(COORD. W/ A8 DETAILS)

GENERAL NOTES:

COORD. W/ FLOOR PLANS & ELEVATIONS FOR LOCATIONS, REQ.'D FRAME WIDTH. 170° DOOR SWINGS & QUANTITY OF REQUIRED DOORS, FRAMES & SCREENS.

ALL FINISH HARDWARE INFO. SHOWN TO BE COORDINATED & VERIFIED W/ THE APPROVED HARDWARE SCHEDULE, INCLUDING BUT NOT LIMITED TO HOLD OPEN DEVICES, ELECTRIC STRIKES, SECURITY KEYPADS, AUTO DOOR OPENERS, CLOSERS, PANIC DEVICES, MAGNETIC HOLD-OPENS, OVERHEAD STOPS, PUSH PLATES, KICK PLATES & ANY OTHER DOOR HARDWARE REQUIREMENTS.

SOUND / ACOUSTIC RATINGS:
COORD. W/ WALL TYPES FOR SOUND RATINGS (STC) & FLOOR PLANS FOR WALL TYPE LOCATIONS. ALL DOORS, DOOR FRAMES, SCREENS & GLAZING THAT REQUIRE SOUND RATINGS TO HAVE SOUND PROOFING, SEALS @ PER.'S, RECESSED AUTOMATIC DROP DOWN SILLS, DOUBLE GLAZING.
WOOD FRAMES SHIM VOID FILLED SOLID W/ SOUND BATT INSULATION.
HM FRAMES ON CONC. BLOCK CONST. FILLED SOLID W/ MORTAR:
HM FRAMES ON METAL / WD. FRAME CONST. TO HAVE BATT INSULATION OF 50mm+25mm FRICTION FIT INTO FRAME BEFORE INSTALL TO ENSURE COMPRESSION OF BATT WHEN INSTALLED

COORD. W/ ELEC. DWG.'S FOR EXIT SIGN & ELEC. EQUIP. LOCATIONS.

ALL ALUMINUM DOORS TO HAVE CONT. HINGES. ALL H.M. & PLAM COVERED WOOD DOORS TO HAVE 3 BALLBEARING HINGES. ALL EXTERIOR H.M. DOORS TO HAVE 4 HINGES.

ALL EXTERIOR HM. DOORS TO BE INSULATED, 16 Ga., CONT. WELDED C/W STIFFENER PLATES C/W WEATHER STRIPPING, FRAMES TO BE THERMALLY BROKEN

THERMAL BROKEN FRAMES, FILL VOID SOLID W/ SPRAY-IN-PLACE INSUL. TYP, W/ WELDED 10mm TEE ANCHOR, SUPPLY 3 ANCHORS FOR EACH JAMB UP TO 2200mm HIGH, SUPPLY 4 IF JAMB EXCEEDS 2200mm

IN ALL CORRIDOR DOORS & HIGH TRAFFIC AREAS, PROVIDE 16 GAUGE CONTINUOUS WELDED DOORS & HINGES.

ALL WASHROOM DOORS TO BE UNDERCUT BY 25mm (1") UNLESS NOTED BY MECH. MAX. UNDERCUT FOR FIRE RATED DOORS IS 19mm (¾")

ALL DOORS TO HAVE DOOR STOPS

ALL DOORS TO HAVE KICK PLATES BOTH SIDES, FINISH TO MATCH DOOR HARDWARE TYPICAL

DOORS TO HAVE PROVISION FOR ELECTRIC STRIKE & CARD READERS (EXCEPT WASHROOMS) & ONLY PROVIDE CARD READER WHERE ASKED ON DOOR HARDWARE SCHEDULE.
(LOCATION OF CARD READER ON DOOR FRAME OR ADJACENT TO DOOR FRAME SHALL BE CONFIRMED BY ARCHITECT & CLIENT PRIOR TO INSTALLATION) COORDINATE WITH ELECTRICAL DRAWINGS.

ALL DOORS INDICATED W/ HOLD OPENS LOCATED IN FIRE SEPARATION SHOULD HAVE A MAGNETIC HOLD OPEN DEVICE TO RELEASE UPON ACTIVATION OF THE FIRE ALARM C/W CLOSER.


ALL DOORS INDICATED W/ HOLD OPENS LOCATED WHERE THERE IS NO FIRE SEPARATION S


DOOR SCHEDULE - SECOND FLOOR


DOOR						FRAME						FIRE RATING FOR WALLS (LISTED IN MINUTES - COORD. W/ FIRE SEPARATION DRAWINGS)	GLASS	REMOVABLE MULLION	GRILLE	UNIVERSAL WASHROOM DOOR PACKAGE	POWER DOOR OPERATOR	POWER DOOR OPENER BUTTON	PUSH TO LOCK BUTTON	PUSH TO UNLOCK BUTTON	HOLD OPEN	ELECTRIC STRIKE	DOOR CLOSER	SOUND SEAL AT HEAD, JAMBS & DOOR BOTTOM	CARD READER COMBINATION PROXIMITY CARD READER/KEYPAD	MAGNETIC LOCK	ELECTRO-MECHANICAL LOCK (DET. 7 TYPE)	INTERCOM	LOCAL AUDIBLE ALARM	MOTION SENSOR	DOOR STATUS SWITCH	LOCK STATUS SWITCH	WEATHER STRIPPING AT HEAD, JAMBS & DOOR BOTTOM	NOTES
NO.	LOCATION	DOOR SIZE	TYPE	MATL.	FIN.	TYPE	MATL.	FIN.	HEAD	JAMB	DEPTH																						
D202	COUNCIL	950 x 2150	A	HM	P	F4	HM	P	50	50	172	00	T									•											
D203	INDIGENOUS CLASSROOM	950 x 2150	A	HM	P	F4	HM	P	50	50	222	00	T									•											
D203.1	STORAGE	950 x 2150	C	HM	P	F1	HM	P	50	50	222																						
D203.2	SEMINAR	950 x 2150	B	HM	P	F4	HM	P	50	50	222	00	T									•											
D205	CLASSROOM 5	950 x 2150	A	HM	P	F4	HM	P	50	50	222	00	T									•											
D206	CLASSROOM 6	950 x 2150	A	HM	P	F4	HM	P	50	50	222	00	T									•											
D207	I.T. ROOM	950 x 2150	A	HM	P	F1	HM	P	50	50	222	60										•											
D208	CLASSROOM 7	950 x 2150	A	HM	P	F4	HM	P	50	50	222	00	T									•											
D209	CLASSROOM 8	950 x 2150	A	HM	P	F4	HM	P	50	50	222	00	T									•											
D210	CLASSROOM 9	950 x 2150	A	HM	P	F4	HM	P	50	50	222	00	T									•											
D211	CLASSROOM 10	950 x 2150	A	HM	P	F4	HM	P	50	50	222	00	T									•											
D212	CLASSROOM 11	950 x 2150	A	HM	P	F4	HM	P	50	50	222	00	T									•											
D213	GENERAL SCIENCE	950 x 2150	A	HM	P	F4	HM	P	50	50	222	30	FIRE LITE									•											
D214A	SCIENCE PREP	950 x 2150	C	HM	P	F1	HM	P	50	50	222	30	FIRE LITE									•											
D214B	SCIENCE PREP	950 x 2150	C	HM	P	F1	HM	P	50	50	222		T									•											
D214C	SCIENCE PREP	950 x 2150	C	HM	P	F1	HM	P	50	50	222		T									•											
D215A	GENERAL SCIENCE	950 x 2150	A	HM	P	F4	HM	P	50	50	222	30	FIRE LITE									•											
D215B	GENERAL SCIENCE	950 x 2150	A	HM	P	F4	HM	P	50	50	222	30	FIRE LITE									•											
D216A	SCIENCE PREP	950 x 2150	C	HM	P	F1	HM	P	50	50	222	30	FIRE LITE									•											
D216B	SCIENCE PREP	950 x 2150	C	HM	P	F1	HM	P	50	50	222		T									•											
D216C	SCIENCE PREP	950 x 2150	C	HM	P	F1	HM	P	50	50	222		T									•											
D217A	GENERAL SCIENCE	950 x 2150	A	HM	P	F4	HM	P	50	50	222	30	FIRE LITE									•											
D217B	GENERAL SCIENCE	950 x 2150	A	HM	P	F4	HM	P	50	50	222	30	FIRE LITE									•											
D218	WASHROOM	950 x 2150	A	HM	P	F1	HM	P	50	50	222	00										•											
D219	WASHROOM	950 x 2150	A	HM	P	F1	HM	P	50	50	222	00										•											
D220	BARRIER FREE WASHROOM	1050 x 2150	A	HM	P	F1	HM	P	50	50	222	00										•											
D222	CUST.	950 x 2150	C	HM	P	F1	HM	P	50	50	172	00	T									•											
D224	FINE ART CLASSROOM	950 x 2150	A	HM	P	F4	HM	P	50	50	222	00	T									•											
D225	MEDIA ARTS & DRAMA	950 x 2150	D	HM	P	F1	HM	P	50	50	222	00	T									•											
D225.1	STORAGE	1200 x 2250	E	WSC	PLAM								T																				S/S HARDWARE TO OBC FOR BF ACCESSIBILITY (PROTRUDING HARDWARE). PROVIDE TRACK MOUNTED STOP TO SUIT DOOR LOCATION (MIN. CLEAR OPENING 900mm) PROVIDE LATCH (COORD. W/ HARDWARE SUPPLIER)
D225.2	SOUND EDIT.	950 x 2150	C	HM	P	F1	HM	P	50	50	172		T																				
D225.3	CONTROL ROOM	950 x 2150	C	HM	P	F1	HM	P	50	50	172	60	FIRE LITE									•											
D226	ACADEMIC STORAGE	950 x 2150	C	HM	P	F1	HM	P	50	50	222	00										•											
D227	MACH. ROOM	950 x 2150	A	HM	P	F1	HM	P	50	50	222	60										•											
D228	RESOURCE	950 x 2150	D	HM	P	F1	HM	P	50	50	222	00	T									•											
D229	MECHANICAL ELECTRICAL	2 - 1050 x 2150	A	HM	P	F2	HM	P	50	50	222	60										•											
D230	I.T. ROOM	950 x 2150	A	HM	P	F1	HM	P	50	50	222	60										•											
D231	STAFF WASHROOM	950 x 2150	A	HM	P	F1	HM	P	50	50	222	60										•											
D232	STAFF WASHROOM	950 x 2150	A	HM	P	F1	HM	P	50	50	222	60										•											
D234	CUST.	950 x 2150	C	HM	P	F1	HM	P	50	50	222	00	T									•											
D236	ELEM. CLASSROOM 3	950 x 2150	A	HM	P	F4	HM	P	50	50	222	00	T									•											
D237	ELEM. CLASSROOM 4	950 x 2150	A	HM	P	F4	HM	P	50	50	222	00	T									•											
D238	ELEM. CLASSROOM 5	950 x 2150	A	HM	P	F4	HM	P	50	50	222	00	T									•											
D240	ELEM. CLASSROOM 6	950 x 2150	A	HM	P	F4	HM	P	50	50	222	00	T									•											
D241	ELEM. CLASSROOM 7	950 x 2150	A	HM	P	F4	HM	P	50	50	222	00	T									•											
D242	ELEM. CLASSROOM 8	950 x 2150	A	HM	P	F4	HM	P	50	50	222	00	T									•											
D243	ELEM. CLASSROOM 9	950 x 2150	A	HM	P	F4	HM	P	50	50	222	00	T									•											
D243.1	STORAGE	950 x 2150	C	HM	P	F1	HM	P	50	50	172																						
D244	RESOURCE	950 x 2150	D	HM	P	F1	HM	P	50	50	222	00	T									•											
D245	TEACHER PREP.	950 x 2150	C	HM	P	F1	HM	P	50	50	222	00	T									•											
D246	TEACHER PREP.	950 x 2150	C	HM	P	F1	HM	P	50	50	222	00	T									•											
D248	CLASSROOM 13	950 x 2150	A	HM	P	F4	HM	P	50	50	222	00	T									•											
D249A	CLASSROOM 12	950 x 2150	A	HM	P	F4	HM	P	50	50	222	00	T									•											
D249B	CLASSROOM 12	950 x 2150	D	HM	P	F1	HM	P	50	50	172		T									•											
D250A	THE HIVE	950 x 2150	D	HM	P	F1	HM	P	50	50	222	00	T									•											
D250B	THE HIVE	950 x 2150	D	HM	P	F1	HM	P	50	50	172		T									•											
D251A	LEARNING COMMONS	950 x 2150	D	HM	P	F1	HM	P	50	50	222	00	T									•											
D251B	LEARNING COMMONS	950 x 2150	D	HM	P	F1	HM	P	50	50	222	00	T									•											
D251C	LEARNING COMMONS	750 x 2150	A	HM	P	F1	HM	P	50	50	222																						
D251.1	SEMINAR	950 x 2150	B	HM	P	F4	HM	P	50	50	172		T									•											
DS201	STAIR 1	2 - 1050 x 2150	D	HM	P	F2	HM	P	50	50	172	60	FIRE LITE									•											
DS202	STAIR 2	2 - 1050 x 2150	D	HM	P	F2	HM	P	50	50	172	60	FIRE LITE									•											
DS203	STAIR 3	2 - 1050 x 2150	D	HM	P	F2	HM	P	50	50	172	60	FIRE LITE									•											
DS204	STAIR 4	2 - 1050 x 2150	D	HM	P	F2	HM	P	50	50	172	60	FIRE LITE									•											
DS205	STAIR 5	2 - 1050 x 2150	D	HM	P	F2	HM	P	50	50	172	60	FIRE LITE									•											


NOTES:


UNIVERSAL WASHROOM DOOR PACKAGE TO INCLUDES:
- POWER DOOR OPERATOR
- OCCUPIED LIGHT
- POWER DOOR OPENER BUTTONS
- PUSH TO LOCK
- PUSH TO UN-LOCK
- ELECTRIC STRIKE
- EMERGENCY CALL SYSTEM WITH AUDIBLE & VISUAL SIGNAL DEVICES INSIDE & OUTSIDE OF THE WASHROOM
- EMERGENCY SIGN

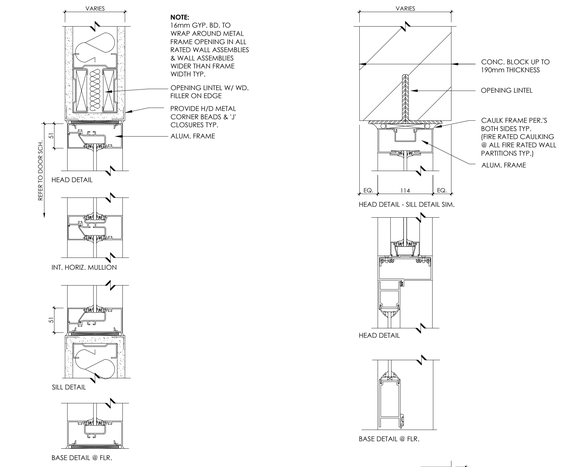

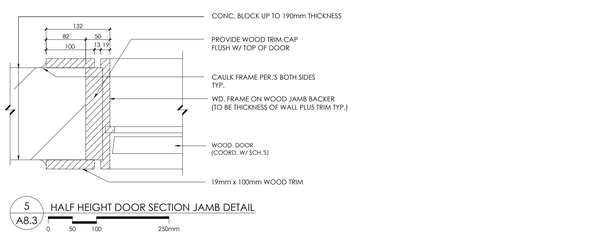

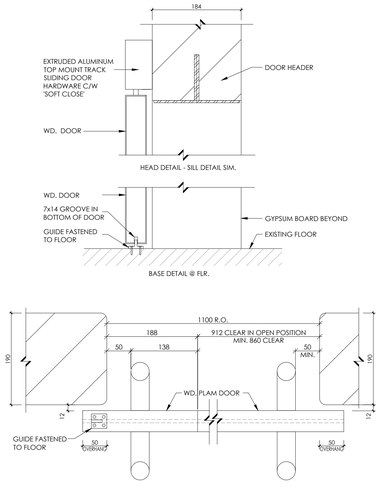

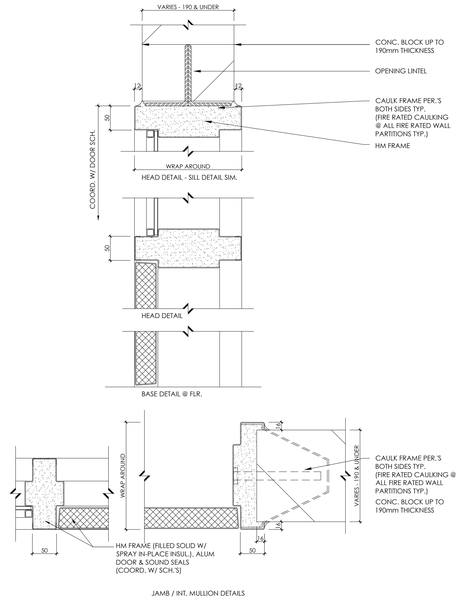

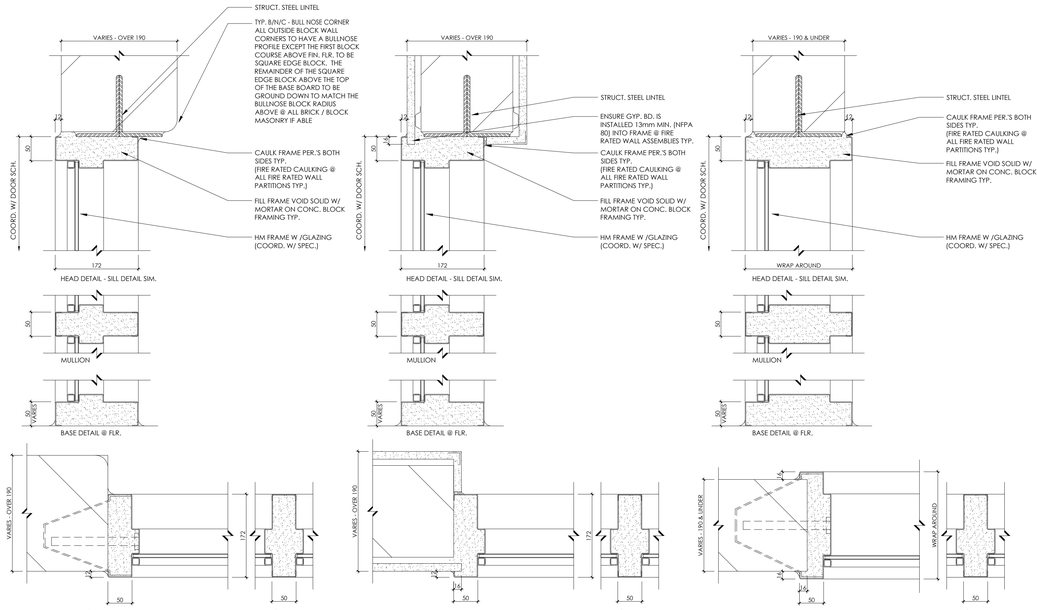

REVISIONS

NO.	DATE	PARTICULAR
1	2022.06.06	ISSUED FOR 80% CLASS B COSTING
2	2022.08.18	ISSUED FOR SPA
3	2022.09.22	ISSUED FOR OWNERS REVIEW - 98% SET
4	2022.12.16	ISSUED FOR 2nd SPA SUBMISSION
5	2023.01.31	ISSUED FOR TENDER
6	2023.02.22	ISSUED FOR ADDENDUM 9
7	2023.08.23	ISSUED FOR CONVENIENCE
8	2023.11.20	ISSUED FOR PERMIT COMMENTS
9	2024.01.24	ISSUED FOR SI#03
10	2024.02.15	ISSUED FOR PCN#008
11	2024.03.04	ISSUED FOR PCN#009
12	2024.03.10	ISSUED FOR SI#004
13	2024.05.14	ISSUED FOR SI#006
14	2024.07.22	ISSUED FOR SI#008
15	2024.08.07	ISSUED FOR SI#009
16	2024.10.02	ISSUED FOR PCN#15
17	2025.04.11	ISSUED FOR PCN#019
18	2025.05.01	ISSUED FOR CO#07
19	2025.05.28	ISSUED FOR PCN#20 - CO#010
20	2025.07.31	ISSUED FOR SI#013
21	2025.08.06	ISSUED FOR SI#014
22	2025.08.15	ISSUED FOR PCN#25 - CO#017
23	2025.08.25	ISSUED FOR PCN#27 - CO#021
24	2025.09.02	ISSUED FOR PCN#29
25	2025.09.02	ISSUED FOR SI#20 - CO#018
26	2025.09.08	ISSUED FOR PCN#31
27	2025.09.09	ISSUED FOR PCN#32 - CO#022
28	2025.09.10	ISSUED FOR PCN#33
29	2025.09.11	ISSUED FOR SI#022
30	2025.09.15	ISSUED FOR SI#023
31	2025.09.16	ISSUED FOR PCN #35 - CO#023
32	2025.09.30	ISSUED FOR PCN #37 - CO#029
33	2025.09.30	ISSUED FOR PCN #38 - CO#025
34	2025.10.06	ISSUED FOR PCN #39 - CO#024
35	2025.10.20	ISSUED FOR PCN #40R1
36	2025.10.30	ISSUED FOR PCN#041
37	2025.10.23	ISSUED FOR PCN #42
38	2025.11.21	ISSUED FOR PCN#021/R1 - CO12 CD#006
39	2025.11.14	ISSUED FOR PCN#043
40	2025.11.26	ISSUED FOR PCN#043R1
41	2025.12.03	ISSUED FOR PCN#044 - CO#026
42	2026.02.04	ISSUED FOR RECORD SET UP TO CO#27

NOTES:

KEY PLAN:

Reproduction of drawings and related documents in whole or in part is forbidden without written permission of the Ventin Group.

All dimensions and measurements must be checked and verified by the General Contractor

Near North District School Board

CLIENT:
NEAR NORTH DISTRICT SCHOOL BOARD
NNDSB Tender # 2023-015

PROJECT:
NEW PARRY SOUND K-12 SCHOOL & CHILDCARE

PARRY SOUND HIGH SCHOOL SITE

111 ISABELLA STREET
PARRY SOUND, ONTARIO

ORIGINAL PAGE SIZE ARCH E1 - 30" x 42"
KEY TO DETAIL LOCATION:
A - A - DETAIL NO.
B - B - DETAIL NO. ORIGIN

+VG ARCHITECTS
THE VENTIN GROUP LTD

DOOR SCHEDULE - SECOND FLOOR & INTERIOR FRAME DETAILS

A8.3

Plot Date: Feb 03, 2026 - 5:41pm By: jkelly
Filename: K:\1VG-Brantford\Near North DSB Parry Sound School\2211\1Drawings\Wd-Current\NN-A8.1.dwg
DRAWN BY : KH
CHECKED BY : EB

ALUM. WINDOW / CURTAIN WALL SCH. NOTES

IT IS THE RESPONSIBILITY OF THE WINDOW, CURTAIN WALL & HARDWARE MANUFACTURER TRADES TO CO-ORDINATE & EXECUTE THEIR WORK TOGETHER.

DIMENSIONS INDICATED ARE R.O. - VERIFY ALL OPENING DIMENSIONS ON SITE PRIOR TO FABRICATION & ORDERING

COORD. W/ TYP. DOOR & WINDOW DETAILS PROVIDED

1. COORD. W/ FLR. PLANS ON LIFE SAFETY DWG.(S) FOR FIRE SEPARATIONS REQ.'D FIRE RESISTANCE RATINGS FOR EXPOSURE SITUATIONS; HM FRAMING TO BE IMPLEMENTED BEHIND OPENING FRAMING TO NEAREST VERT. &/OR HORIZ. FRAMING MEMBER.
(DOOR & FRAME / SCREEN SCH. NOTES 1&2 APPLICABLE)

2. COORD. W/ BUILDING ELEVATIONS A3 SERIES DRAWINGS & FLOOR PLANS A2 SERIES DRAAWINGS FOR LOCATIONS & QUANTITY OF WINDOWS & CURTAIN WALLS

GENERAL NOTES:

FRAMES:
(COORD. W/ SPEC.'S)

FINISH:
CLEAR ANODIZED, DURANAR, DURANAR XL EXT., DURACRON INT.

GLAZING:
(COORD. W/ SPEC.'S)

OPERATORS:
INTEGRAL AWNING STYLE OPERATOR C/W HAND CRANK UNLESS OTHERWISE INDICATED, COORD. W/ ELEV.'S FOR OPERATOR LOCATIONS & DIRECTIONS / SWING
(COORD. W/ SPEC.'S)

SOUND / ACOUSTIC RATINGS:
COORD. W/ WALL TYPES FOR SOUND RATINGS (STC) & FLR. PLANS FOR WALL TYPE LOCATIONS. ALL OPENINGS & GLAZING THAT REQUIRE SOUND RATINGS TO HAVE SOUND PROOFING, SEALS @ PER.'S, DOUBLE GLAZING. ALL SHIM VOIDS FILLED SOLID W/ SOUND BATT INSUL.

ALL GLAZING LOWER THAN 1070mm A/F/F (MAIN FLR. LEVELS, STAIR LANDINGS, ETC.) THAT IS NOT PROTECTED BY SOME TYPE OF INTERIOR GUARD, TO BE DESIGNED TO WITHSTAND THE LOADING ON GUARDS AS PER OBC SB-13; WHERE THE DIFFERENCE IN ELEV. BETWEEN THE ADJACENT GROUND OR FLR. LEVEL IS MORE THAN 600mm TYP. COORD. W/ GLASS & GLAZING 8800 SECTION

ALL GLASS AND GLAZING LOCATED IN A FIRE RATED WALL SYSTEM / ASSEMBLY OR EXPOSURE SITUATIONS TO BE FIRE RATED GLASS / GLAZING.

ALL GLASS AND GLAZING, CONTRACTOR SHALL VERIFY AND PROVIDE THICKNESS TO BE CONFIRMED BY MANUFACTURER FOR THE ASSEMBLY IN WHICH THE GLAZING IS INSTALLED, TO BE SUBMITTED IN SHOP DRAWINGS STAMPED BY A PROFESSIONAL ENGINEER BEFORE ANY MANUFACTURING. GLAZING TAPE TO BE AS PER MANUFACTURER'S WRITTEN RECOMMENDATIONS.

ALL OPENING CLOSURES (INCLUDING BUT LIMITED TO: ENTRANCE FRAMES, CURTAIN WALL FRAMES, WINDOW FRAMES, GLAZING / SPANDREL & SOLID INFILL PANEL, ETC.) SHALL BE DESIGNED TO SAFELY WITHSTAND ALL APPLICABLE LOADS AND SHALL MEET THE STANDARDS OF THE LATEST ONTARIO BUILDING CODE AS CURRENTLY AMENDED.

THIS INCLUDES, BUT LIMITED TO, WIND LOADS, NEGATIVE PRESSURE, DEFLECTION, THERMAL MOVEMENT, LOADS ON GUARDS (WHERE CLOSURE IS REQUIRED TO BE DESIGNED AS A GUARD), ETC.

PROVIDE SHOP DRAWINGS FOR REVIEW SIGNED AND SEALED BY A PROFESSIONAL ENGINEER FOR REVIEW AND APPROVAL. COORDINATE SUBMITTALS WITH SPECIFICATIONS.

CURTAIN WALL LEGEND

DATUM — A/F/F LEVEL (ABOVE FINISHED FLOOR)


W# — WINDOW #


HATCH IDENTIFICATION MARKER LEGEND


- VISION GLAZING (DOUBLE INSUL. UNIT)
- SPANDREL GLAZING W/ INSUL. METAL BACKPAN (LIGHT COLOUR)
- MULLION CAP
- BUTT JOINT MULLION

GENERAL NOTES

- CONTRACTOR TO VERIFY ALL OPENINGS ON SITE PRIOR TO FABRICATION
- COORD. W/ BLDG. ELEVATIONS & FLR. PLANS FOR LOCATIONS & QUANTITY OF CURTAIN WALLS
- COORD. W/ BLDG. ELEVATIONS FOR LOCATIONS WHERE OPERATOR LOCATIONS ARE REVERSED & OR UNITS ARE MIRROR IMAGES OF UNITS SHOWN ON THIS SCH.
- SHOP DWG.'S TO BE IN DIMENSION UNITS AS ILLUSTRATED ON THIS DWG. OR THEY WILL BE REJECTED (IMPERIAL & METRIC BOTH SHOWN IS ACCEPTABLE)

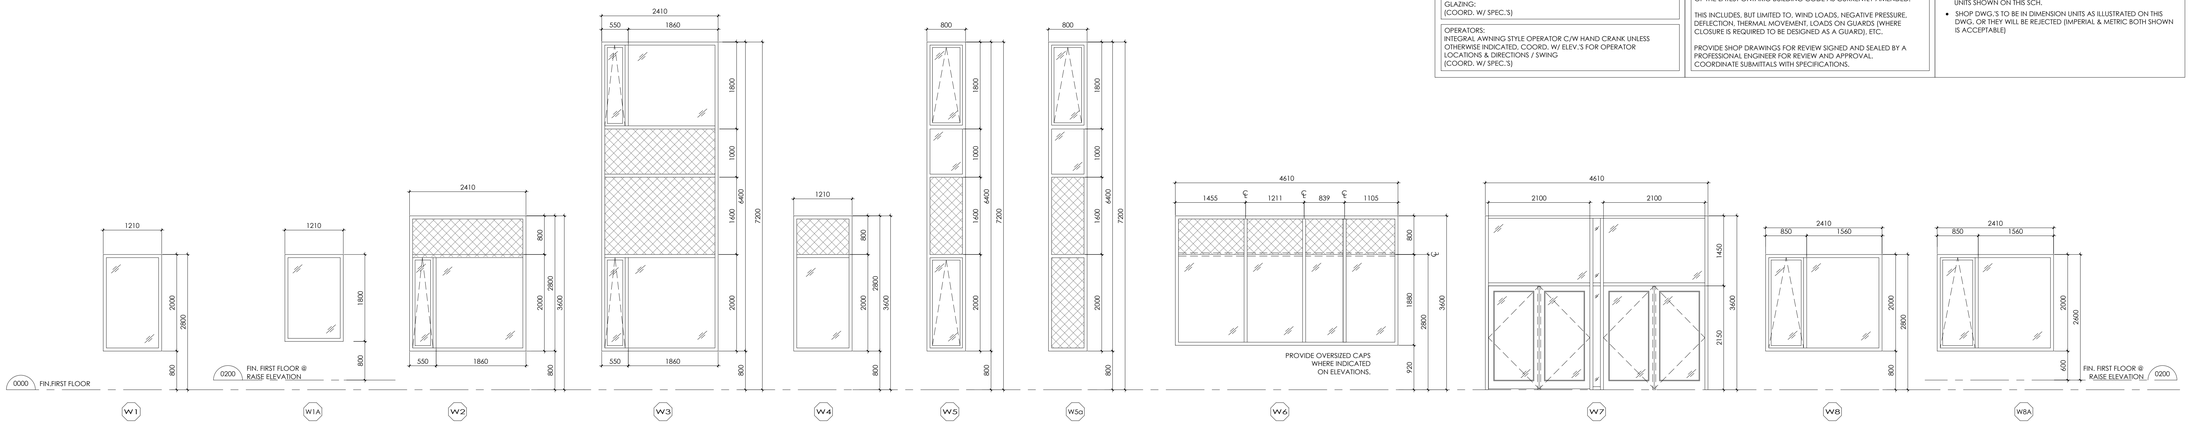

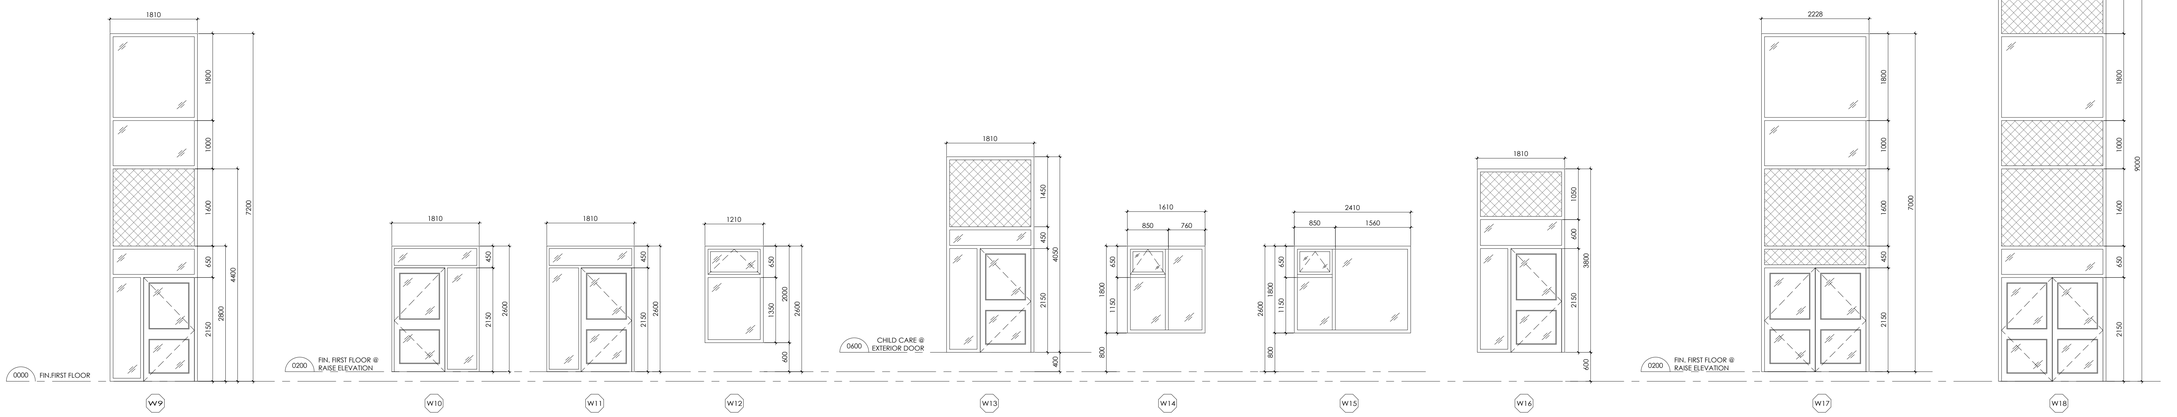

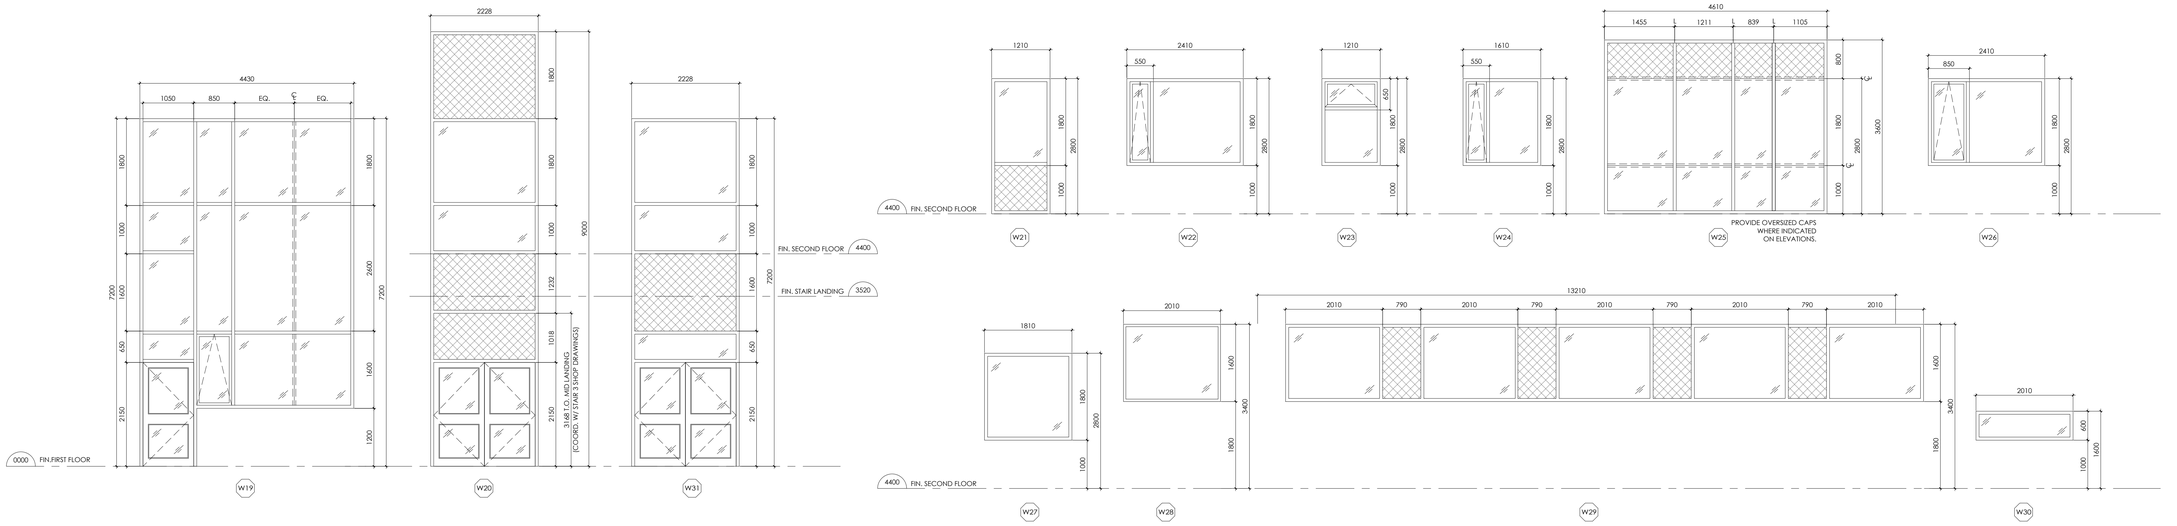

REVISIONS

NO.	DATE	PARTICULAR
1	2022.06.06	ISSUED FOR 80% CLASS B COSTING
2	2022.08.18	ISSUED FOR SPA
3	2022.09.22	ISSUED FOR OWNERS REVIEW - 98% SET
4	2022.12.16	ISSUED FOR 2nd SPA SUBMISSION
5	2023.01.31	ISSUED FOR TENDER
6	2023.02.22	ISSUED FOR ADDENDUM 9
7	2023.08.23	ISSUED FOR CONVENIENCE
8	2023.11.20	ISSUED FOR PERMIT COMMENTS
9	2024.01.24	ISSUED FOR SI#03
10	2024.02.15	ISSUED FOR PCN#008
11	2024.03.04	ISSUED FOR PCN#009
12	2024.03.10	ISSUED FOR SI#004
13	2024.05.14	ISSUED FOR SI#006
14	2024.07.22	ISSUED FOR SI#008
15	2024.08.07	ISSUED FOR SI#009
16	2024.10.02	ISSUED FOR PCN#15
17	2025.04.11	ISSUED FOR PCN#019
18	2025.05.01	ISSUED FOR CO#07
19	2025.05.28	ISSUED FOR PCN#20 - CO#010
20	2025.07.31	ISSUED FOR SI#013
21	2025.08.06	ISSUED FOR SI#014
22	2025.08.15	ISSUED FOR PCN#25 - CO#017
23	2025.08.25	ISSUED FOR PCN#27 - CO#021
24	2025.09.02	ISSUED FOR PCN#29
25	2025.09.02	ISSUED FOR SI#20 - CO#018
26	2025.09.08	ISSUED FOR PCN#31
27	2025.09.09	ISSUED FOR PCN#32 - CO#022
28	2025.09.10	ISSUED FOR PCN#33
29	2025.09.11	ISSUED FOR SI#022
30	2025.09.15	ISSUED FOR SI#023
31	2025.09.16	ISSUED FOR PCN #35 - CO#023
32	2025.09.30	ISSUED FOR PCN #37 - CO#029
33	2025.09.30	ISSUED FOR PCN #38 - CO#025
34	2025.10.06	ISSUED FOR PCN #39 - CO#024
35	2025.10.20	ISSUED FOR PCN #40#1
36	2025.10.30	ISSUED FOR PCN#041
37	2025.10.23	ISSUED FOR PCN #42
38	2025.11.21	ISSUED FOR PCN#021/R1 - CO12 CD#006
39	2025.11.14	ISSUED FOR PCN#043
40	2025.11.26	ISSUED FOR PCN#043R1
41	2025.12.03	ISSUED FOR PCN#044 - CO#026
42	2026.02.04	ISSUED FOR RECORD SET UP TO CO#27

NOTES:

KEY PLAN:

All dimensions and measurements must be checked and verified by the General Contractor

Reproduction of drawings and related documents in whole or in part is forbidden without written permission of the Ventin Group.

Filename: K:\VG-Brantford\Near North DSB Parry Sound School-22111\Drawings\Arch Current\A8.4.dwg

Plot Date: Feb 05, 2026 - 5:41pm By: Kelly

Near North District School Board

CLIENT:
NEAR NORTH DISTRICT SCHOOL BOARD
NNDSB Tender # 2023-015

PROJECT:
NEW PARRY SOUND K-12 SCHOOL & CHILDCARE

PARRY SOUND HIGH SCHOOL SITE

111 ISABELLA STREET
PARRY SOUND, ONTARIO

ORIGINAL PAGE SIZE ARCH E1 - 30" x 42"
KEY TO DETAIL LOCATION:
(A) A - DETAIL NO.
(B) B - DETAIL NO. ORIGIN


+VG ARCHITECTS
THE VENTIN GROUP LTD

CURTAINWALL SCHEDULE

A8.4


DRAWN BY : KH

CHECKED BY : EB/AM

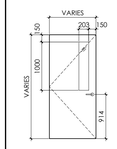DOOR TYPE SCHEDULE		
TYPE	A	B
ELEVATION	RESERVED	
	RESERVED	EXTERIOR / INTERIOR

DOOR SCHEDULE											
NO.	LOCATION	SIZE	RATING	DOOR				FRAME				REMARKS
				TYPE	MATL	FINISH	GLASS	MATL	FINISH	HEAD	JAMB	* REFER TO PLANS FOR DOOR SWING COORDINATION
001	POD A TO EXT.	1016 x 2150 x 45	N/A	B	INS. MTL	P/PTD.	YES	ALUM.	ANOD.	63	63	HARDWARE TYPE A. SEE HARDWARE SCHEDULE.
002	POD B TO EXT.	1016 x 2150 x 45	N/A	B	INS. MTL	P/PTD.	YES	ALUM.	ANOD.	63	63	HARDWARE TYPE A. SEE HARDWARE SCHEDULE.
003	POD A TO POD B	965 x 2150 x 45	N/A	B	WOOD	P/PTD.	YES	P.STL.	P/PTD.	50	50	HARDWARE TYPE B. SEE HARDWARE SCHEDULE.

HARDWARE SCHEDULE						
DOOR TYPE	HARDWARE	MODEL NO.	FINISH	MANUFACTURER	QTY.	REMARKS
TYPE A	CONTINUOUS HINGE	112XY - EPT - DH	628	IVES	1	
	EXIT DEVICE	CD-QEL-3549A-NL-OP x 4'	SP28	VON DUPRIN	1	
	CYLINDER	PREMIUM CORE	626	BEST	1	
	LEVER SET	MK-195L	26D	MARKS	1	
	LOCKSET	MK-195RAB	26D	MARKS	1	
	OVERHEAD CONCEALED DOOR STAY	GJ1105 ADJ x DW	630	GLYNN JOHNSON	1	
	THRESHOLD	625A x DW	628	ZERO INTERNATIONAL	1	
	DOOR SWEEP	8192D xDW	628	ZERO INTERNATIONAL	1	
	PERIMETER SEAL	475AA	628	ZERO INTERNATIONAL	1	
TYPE B	HINGES	3CB1HW 114 x 101	630	IVES	3	
	LEVER HANDLE SET	MK-195N	26D	MARKS	1	
	LOCKSET	MK-195RAB	26D	MARKS	1	
	DOOR STOP	FS439	630	IVES	1	
	SURFACE MOUNTED CLOSER	1461	689	LCN		

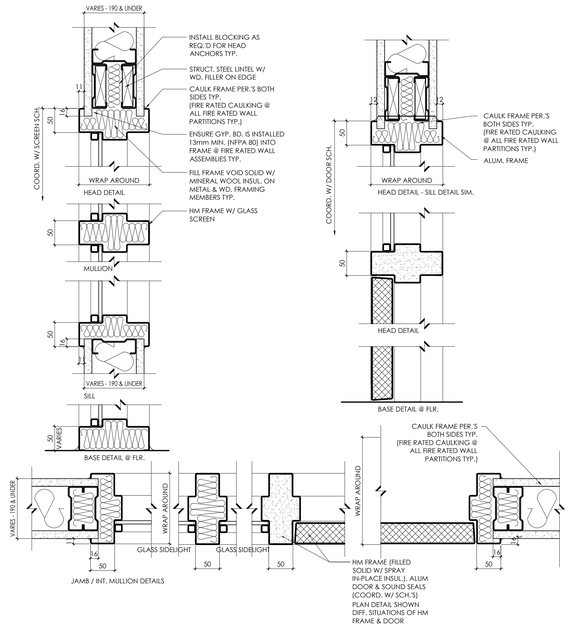

A8.# ALUM. & HM. SCREEN SECTION & PLAN DETAILS

0 50 100 200mm

REVISIONS

NO.	DATE	PARTICULAR
1	2022.06.06	ISSUED FOR 80% CLASS B COSTING
2	2022.08.18	ISSUED FOR SPA
3	2022.09.22	ISSUED FOR OWNERS REVIEW - 98% SET
4	2022.12.16	ISSUED FOR 2nd SPA SUBMISSION
5	2023.01.31	ISSUED FOR TENDER
6	2023.02.22	ISSUED FOR ADDENDUM 9
7	2023.08.23	ISSUED FOR CONVENIENCE
8	2023.11.20	ISSUED FOR PERMIT COMMENTS
9	2024.01.24	ISSUED FOR SI#03
10	2024.02.15	ISSUED FOR PCN#008
11	2024.03.04	ISSUED FOR PCN#009
12	2024.03.10	ISSUED FOR SI#004
13	2024.05.14	ISSUED FOR SI#006
14	2024.07.22	ISSUED FOR SI#008
15	2024.08.07	ISSUED FOR SI#009
16	2024.10.02	ISSUED FOR PCN#15
17	2025.04.11	ISSUED FOR PCN#019
18	2025.05.01	ISSUED FOR CO#07
19	2025.05.28	ISSUED FOR PCN#20 - CO#010
20	2025.07.31	ISSUED FOR SI#013
21	2025.08.06	ISSUED FOR SI#014
22	2025.08.15	ISSUED FOR PCN#25 - CO#017
23	2025.08.25	ISSUED FOR PCN#27 - CO#021
24	2025.09.02	ISSUED FOR PCN#29
25	2025.09.02	ISSUED FOR SI#20 - CO#018
26	2025.09.08	ISSUED FOR PCN#31
27	2025.09.09	ISSUED FOR PCN#32 - CO#022
28	2025.09.10	ISSUED FOR PCN#33
29	2025.09.11	ISSUED FOR SI#022
30	2025.09.15	ISSUED FOR SI#023
31	2025.09.16	ISSUED FOR PCN #35 - CO#023
32	2025.09.30	ISSUED FOR PCN #37 - CO#029
33	2025.09.30	ISSUED FOR PCN #38 - CO#025
34	2025.10.06	ISSUED FOR PCN #39 - CO#024
35	2025.10.20	ISSUED FOR PCN #40R1
36	2025.10.30	ISSUED FOR PCN#041
37	2025.10.23	ISSUED FOR PCN #42
38	2025.11.21	ISSUED FOR PCN#021/R1 - CO12 CO#006
39	2025.11.14	ISSUED FOR PCN#043
40	2025.11.26	ISSUED FOR PCN#043R1
41	2025.12.03	ISSUED FOR PCN#044 - CO#026
42	2026.02.04	ISSUED FOR RECORD SET UP TO CO#27

NOTES:

KEY PLAN:

All dimensions and measurements must be checked and verified by the General Contractor

Reproduction of drawings and related documents in whole or in part is forbidden without written permission of the Ventin Group.

Near North District School Board

CLIENT:
NEAR NORTH DISTRICT SCHOOL BOARD
NNDSB Tender # 2023-015

PROJECT:
NEW PARRY SOUND K-12 SCHOOL & CHILDCARE

PARRY SOUND HIGH SCHOOL SITE

111 ISABELLA STREET
PARRY SOUND, ONTARIO

ORIGINAL PAGE SIZE ARCH E1 - 30" x 42"

KEY TO DETAIL LOCATION:
A - DETAIL NO.
B - DETAIL NO. ORIGIN


+VG ARCHITECTS
THE VENTIN GROUP LTD


HEX PODS - DOOR SCHEDULE (CASH ALLOWANCE)

A8.5

DRAWN BY :
CHECKED BY :

Last Date: Feb 03, 2026 - 5:42pm By Jkelly
Filename: K:\VG-Brantford\Near North DSB Parry Sound School\2211\1Drawings\Wd+Cement\Mstr-A8.5_HEX Pod Door Schedule.dwg

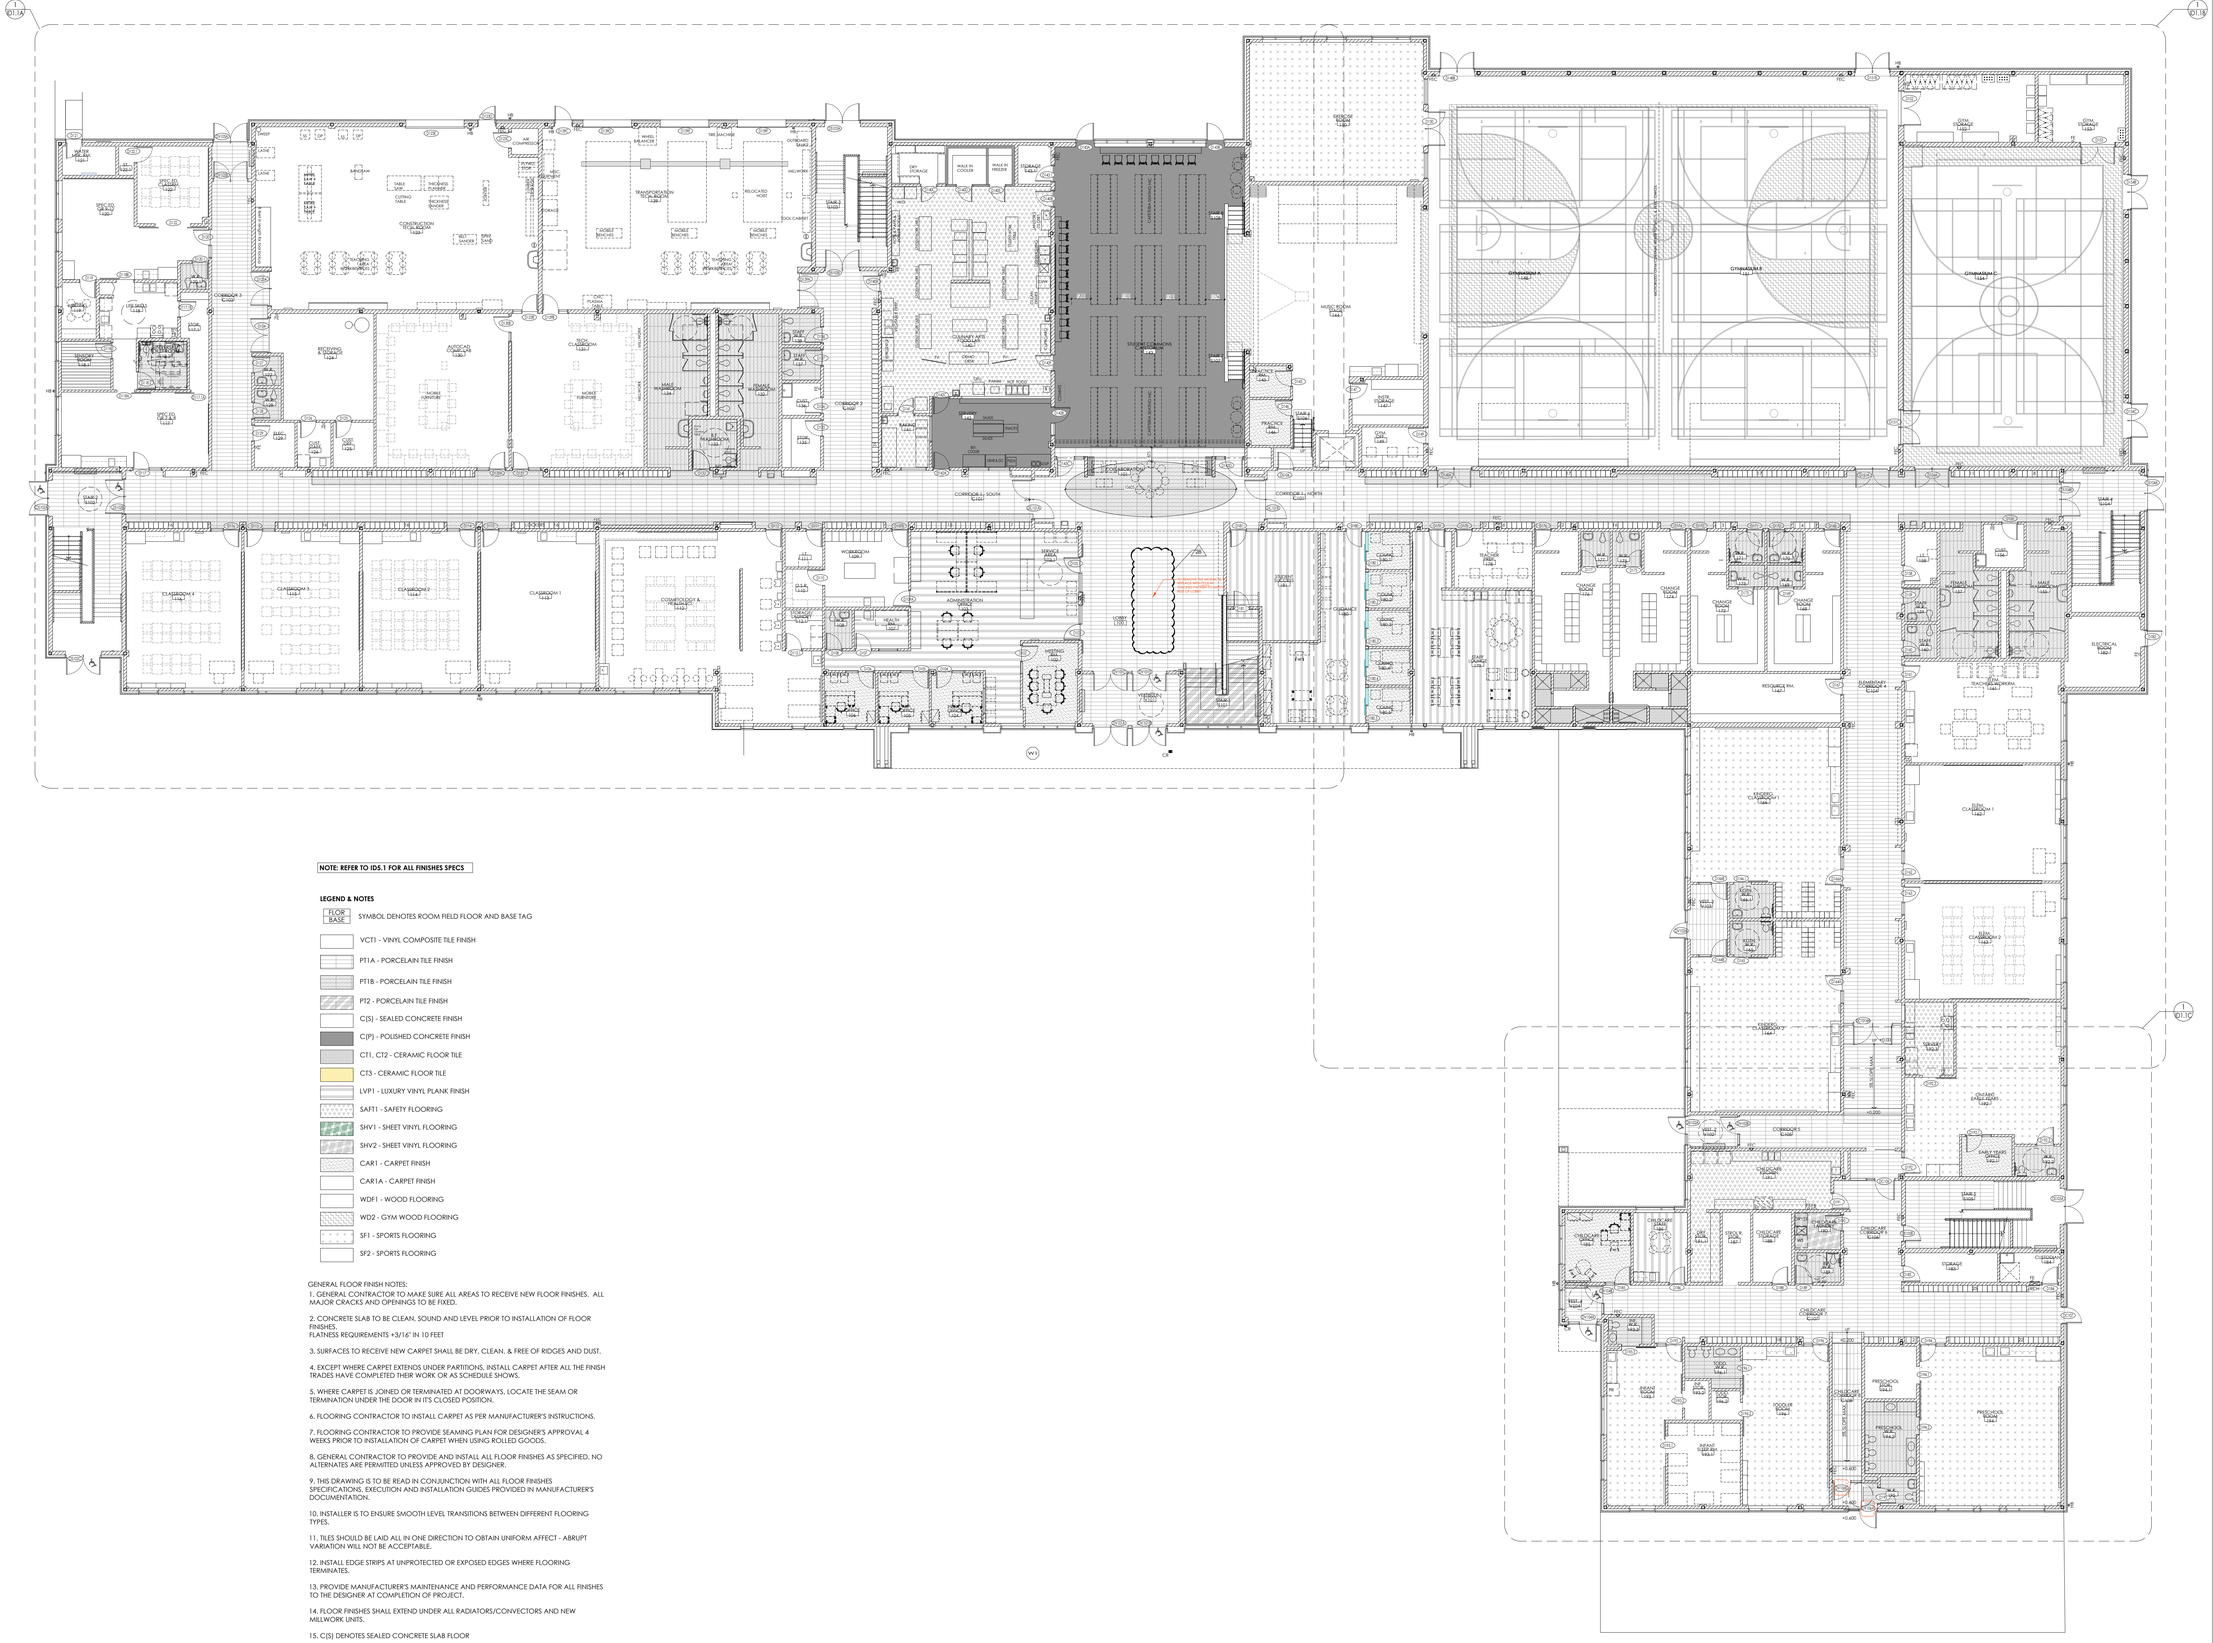
1 / D1.1A
1 / D1.1B
1 / D1.1C
GYMNASIUM A
GYMNASIUM B
GYMNASIUM C
STUDENT COMMONS
CAFETERIA SEATING AREA
CLASSROOM 1
CLASSROOM 2
CLASSROOM 3
CLASSROOM 4

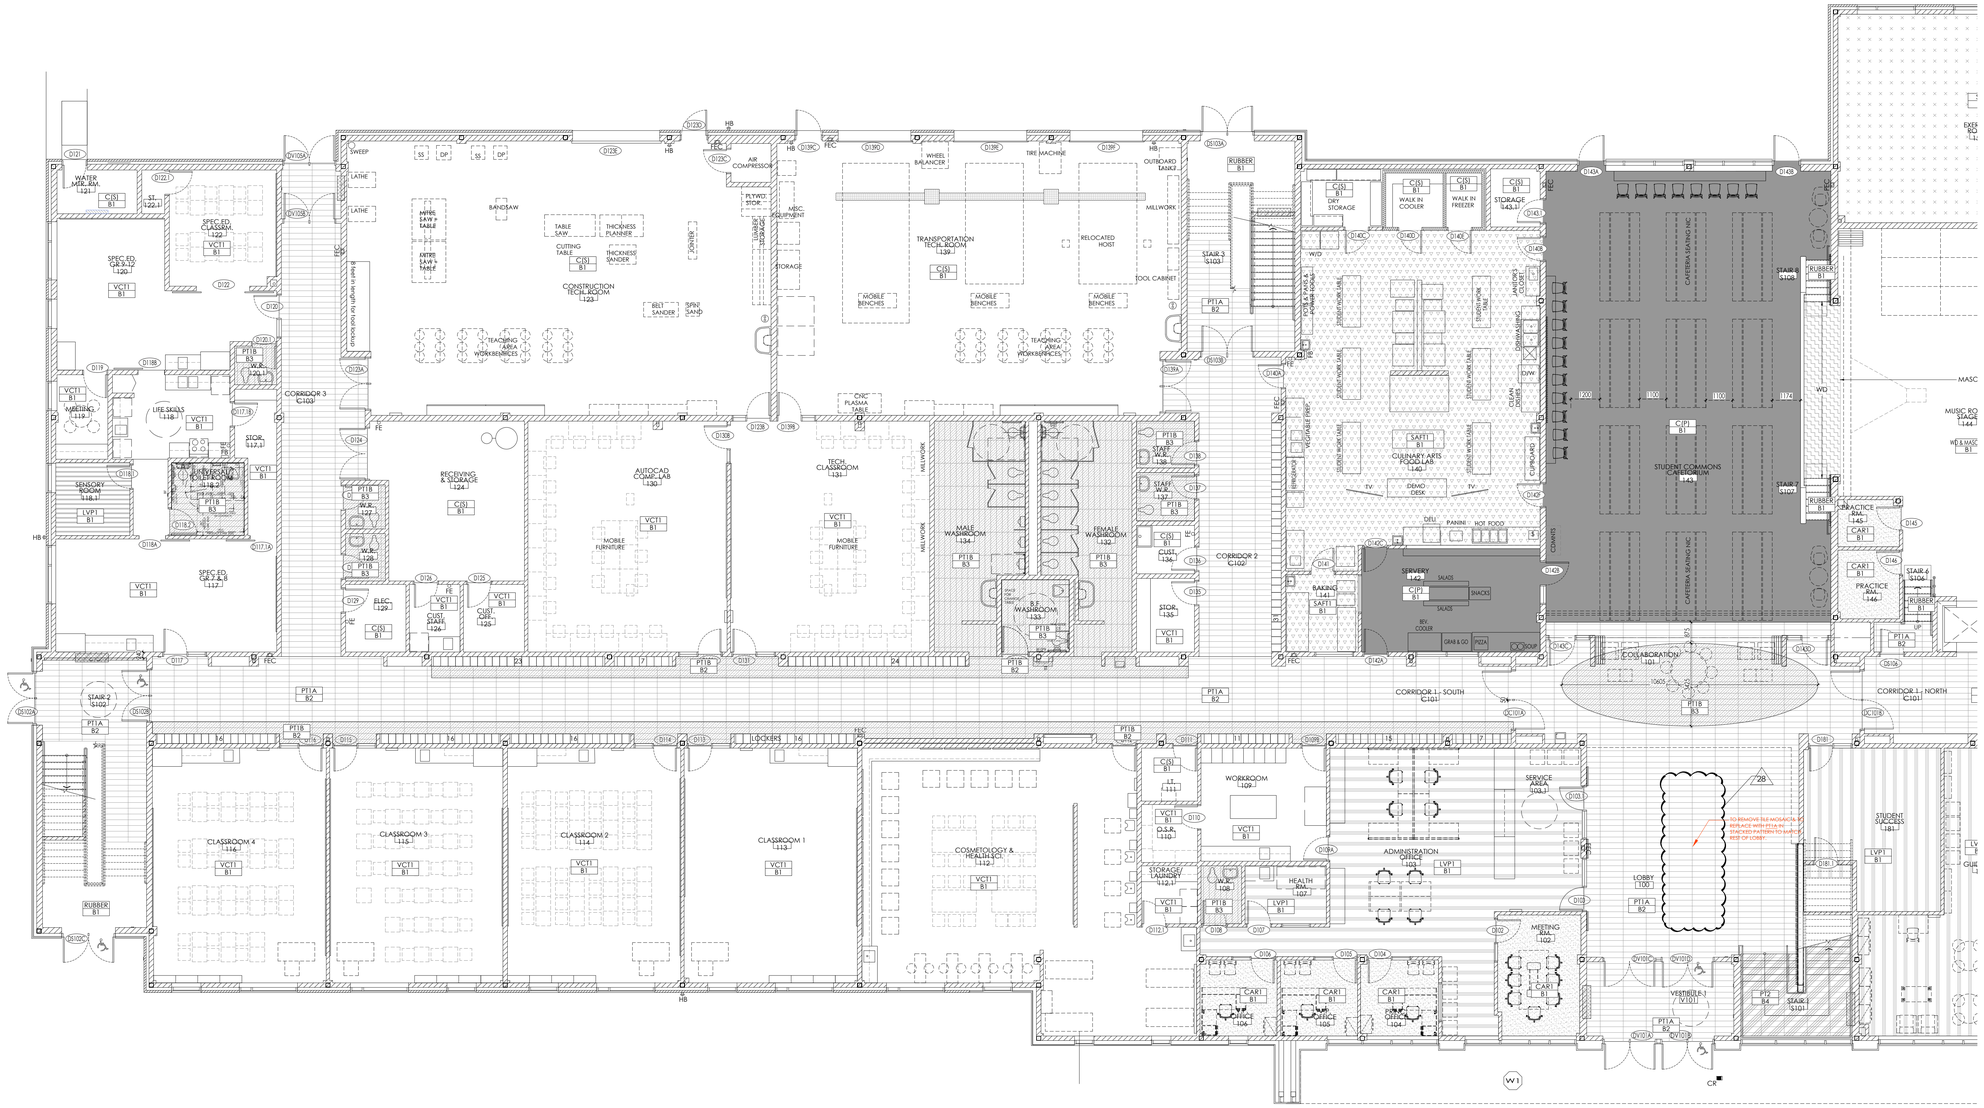

1 / ID1.1A FIRST FLOOR - FLOOR FINISHES PLAN - SOUTH WING


0 1 2 5m

REVISIONS

NO.	DATE	PARTICULAR
1	2022.06.06	ISSUED FOR 80% CLASS B COSTING
2	2022.08.18	ISSUED FOR SPA
3	2022.09.22	ISSUED FOR OWNERS REVIEW - 98% SET
4	2022.12.16	ISSUED FOR 2nd SPA SUBMISSION
5	2023.01.31	ISSUED FOR TENDER
6	2023.02.22	ISSUED FOR ADDENDUM 9
7	2023.08.23	ISSUED FOR CONVENIENCE
8	2023.11.20	ISSUED FOR PERMIT COMMENTS
9	2024.01.24	ISSUED FOR SI#03
10	2024.02.15	ISSUED FOR PCN#008
11	2024.03.04	ISSUED FOR PCN#009
12	2024.03.10	ISSUED FOR SI#004
13	2024.05.14	ISSUED FOR SI#006
14	2024.07.22	ISSUED FOR SI#008
15	2024.08.07	ISSUED FOR SI#009
16	2024.10.02	ISSUED FOR PCN#15
17	2025.04.11	ISSUED FOR PCN#019
18	2025.05.01	ISSUED FOR CO#07
19	2025.05.28	ISSUED FOR PCN#20 - CO#010
20	2025.07.31	ISSUED FOR SI#013
21	2025.08.06	ISSUED FOR SI#014
22	2025.08.15	ISSUED FOR PCN#25 - CO#017
23	2025.08.25	ISSUED FOR PCN#27 - CO#021
24	2025.09.02	ISSUED FOR PCN#29
25	2025.09.02	ISSUED FOR SI#20 - CO#018
26	2025.09.08	ISSUED FOR PCN#31
27	2025.09.09	ISSUED FOR PCN#32 - CO#022
28	2025.09.10	ISSUED FOR SI#33
29	2025.09.11	ISSUED FOR SI#022
30	2025.09.15	ISSUED FOR SI#023
31	2025.09.16	ISSUED FOR PCN #35 - CO#023
32	2025.09.30	ISSUED FOR PCN #37 - CO#029
33	2025.09.30	ISSUED FOR PCN #38 - CO#025
34	2025.10.06	ISSUED FOR PCN #39 - CO#024
35	2025.10.20	ISSUED FOR PCN #4081
36	2025.10.30	ISSUED FOR PCN#041
37	2025.10.23	ISSUED FOR PCN #42
38	2025.11.21	ISSUED FOR PCN#021/R1 - CO12 CD#006
39	2025.11.14	ISSUED FOR PCN#043
40	2025.11.26	ISSUED FOR PCN#043R1
41	2025.12.03	ISSUED FOR PCN#044 - CO#026
42	2026.02.04	ISSUED FOR RECORD SET UP TO CO#27

NOTES:

KEY PLAN:

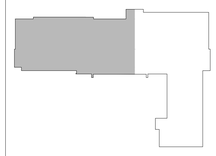

Reproduction of drawings and related documents in whole or in part is forbidden without written permission of the Ventin Group.

All dimensions and measurements must be checked and verified by the General Contractor

Near North District School Board

CLIENT:
NEAR NORTH DISTRICT SCHOOL BOARD
NNDSB Tender # 2023-015

PROJECT:
NEW PARRY SOUND K-12 SCHOOL & CHILDCARE

PARRY SOUND HIGH SCHOOL SITE

111 ISABELLA STREET
PARRY SOUND, ONTARIO

ORIGINAL PAGE SIZE ARCH E1 - 30" x 42"

KEY TO DETAIL LOCATION:
A - DETAIL NO.
B - DETAIL NO. ORIGIN


+VG ARCHITECTS
THE VENTIN GROUP LTD

FIRST FLOOR - FLOOR FINISHES PLAN - SOUTH WING

ID1.1A

DRAWN BY : PS/KH CHECKED BY : EB

Plot Date: Feb 05, 2026 - 5:43pm By: jkelly Filename: K:\1VG-Brantford\Near North DSB Parry Sound School-22111\Drawings\Wd-Current\NN - ID1.1_Level 1 Floor Finish Plan.dwg

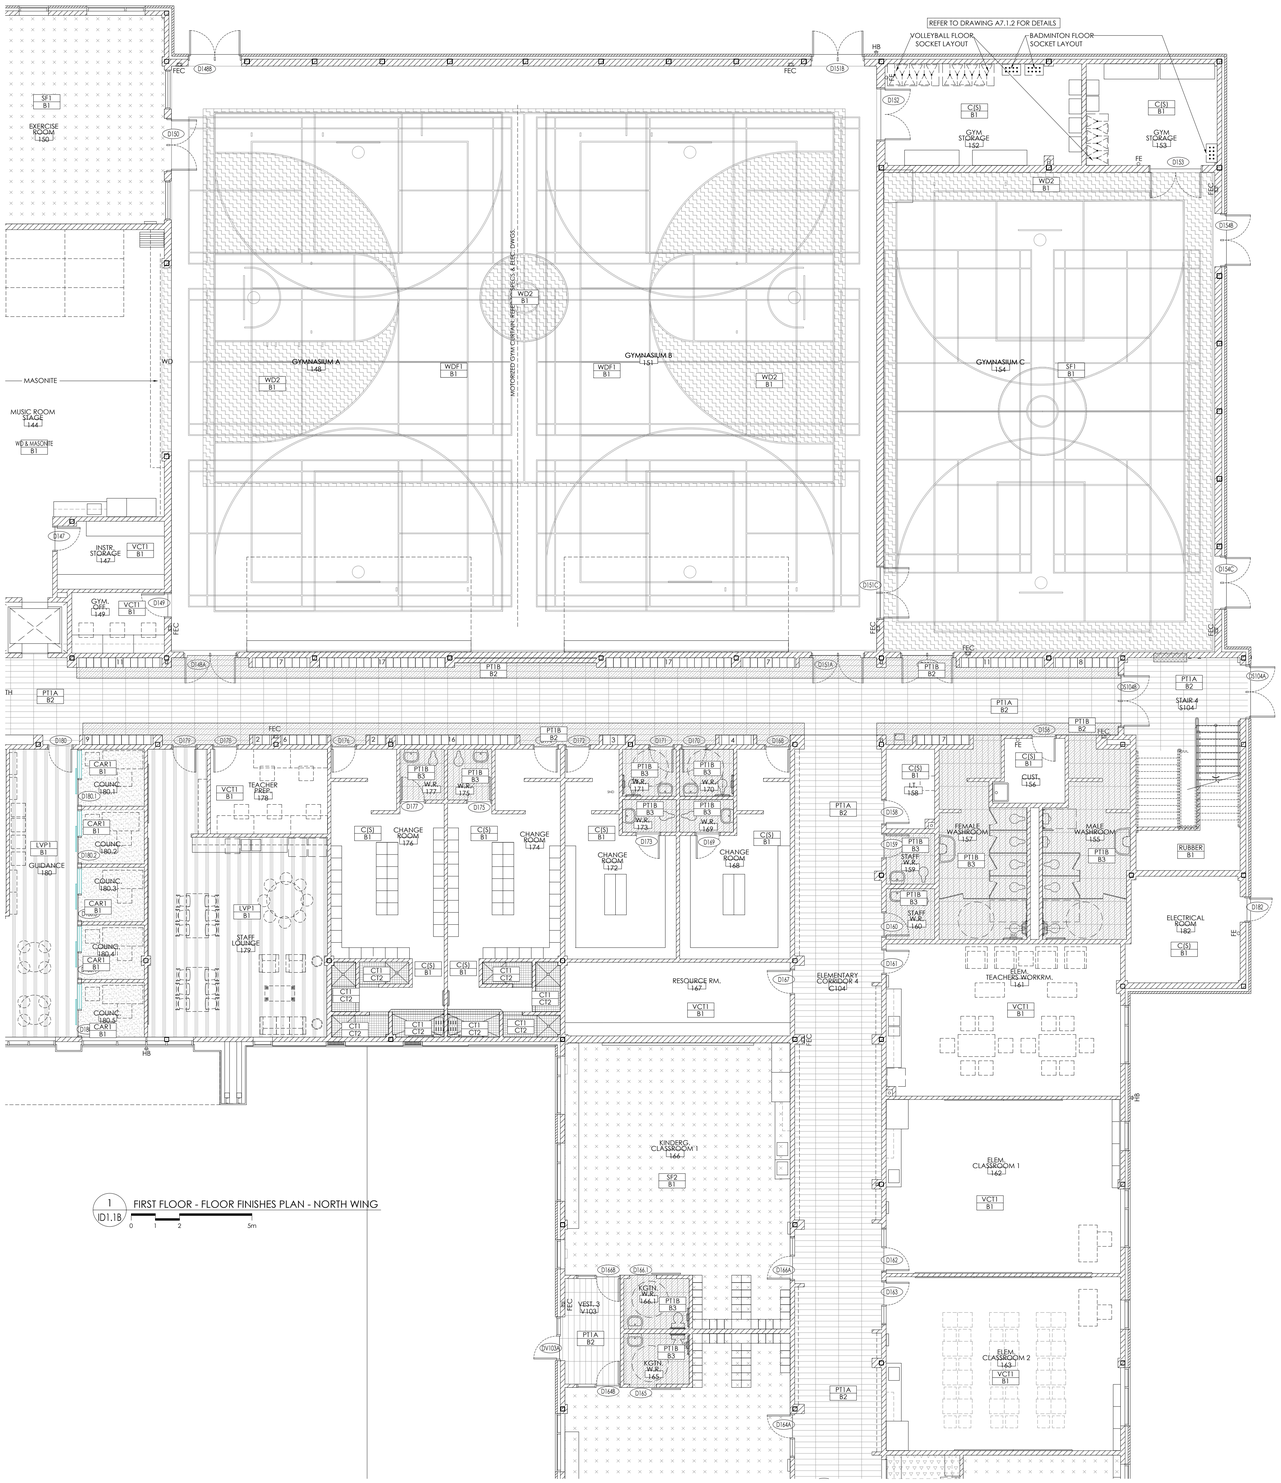


REVISIONS

NO.	DATE	PARTICULAR
1	2022.06.06	ISSUED FOR 80% CLASS B COSTING
2	2022.08.18	ISSUED FOR SPA
3	2022.09.22	ISSUED FOR OWNERS REVIEW - 98% SET
4	2022.12.16	ISSUED FOR 2nd SPA SUBMISSION
5	2023.01.31	ISSUED FOR TENDER
6	2023.02.22	ISSUED FOR ADDENDUM 9
7	2023.08.23	ISSUED FOR CONVENIENCE
8	2023.11.20	ISSUED FOR PERMIT COMMENTS
9	2024.01.24	ISSUED FOR SI#03
10	2024.02.15	ISSUED FOR PCN#008
11	2024.03.04	ISSUED FOR PCN#009
12	2024.03.10	ISSUED FOR SI#004
13	2024.05.14	ISSUED FOR SI#006
14	2024.07.22	ISSUED FOR SI#008
15	2024.08.07	ISSUED FOR SI#009
16	2024.10.02	ISSUED FOR PCN#15
17	2025.04.11	ISSUED FOR PCN#019
18	2025.05.01	ISSUED FOR CO#07
19	2025.05.28	ISSUED FOR PCN#20 - CO#010
20	2025.07.31	ISSUED FOR SI#013
21	2025.08.06	ISSUED FOR SI#014
22	2025.08.15	ISSUED FOR PCN#25 - CO#017
23	2025.08.25	ISSUED FOR PCN#27 - CO#021
24	2025.09.02	ISSUED FOR PCN#29
25	2025.09.02	ISSUED FOR SI#20 - CO#018
26	2025.09.08	ISSUED FOR PCN#31
27	2025.09.09	ISSUED FOR PCN#32 - CO#022
28	2025.09.10	ISSUED FOR PCN#33
29	2025.09.11	ISSUED FOR SI#022
30	2025.09.15	ISSUED FOR SI#023
31	2025.09.16	ISSUED FOR PCN #35 - CO#023
32	2025.09.30	ISSUED FOR PCN #37 - CO#029
33	2025.09.30	ISSUED FOR PCN #38 - CO#025
34	2025.10.06	ISSUED FOR PCN #39 - CO#024
35	2025.10.20	ISSUED FOR PCN #40R1
36	2025.10.30	ISSUED FOR PCN#041
37	2025.10.23	ISSUED FOR PCN #42
38	2025.11.21	ISSUED FOR PCN#021/R1 - CO12 CD#006
39	2025.11.14	ISSUED FOR PCN#043
40	2025.11.26	ISSUED FOR PCN#043R1
41	2025.12.03	ISSUED FOR PCN#044 - CO#026
42	2026.02.04	ISSUED FOR RECORD SET UP TO CO#27

NOTES:

KEY PLAN:

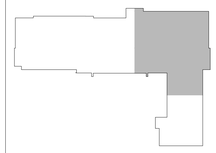

All dimensions and measurements must be checked and verified by the General Contractor

Reproduction of drawings and related documents in whole or in part is forbidden without written permission of the Ventin Group.

Near North District School Board

CLIENT:
NEAR NORTH DISTRICT SCHOOL BOARD
NND5B Tender # 2023-015

PROJECT:
NEW PARRY SOUND K-12 SCHOOL & CHILDCARE

PARRY SOUND HIGH SCHOOL SITE

111 ISABELLA STREET
PARRY SOUND, ONTARIO

ORIGINAL PAGE SIZE ARCH E1 - 30" x 42"

KEY TO DETAIL LOCATION:
(A) A - DETAIL NO.
(B) B - DETAIL NO. ORIGIN

+VG ARCHITECTS
THE VENTIN GROUP LTD

NORTH

FIRST FLOOR - FLOOR FINISHES PLAN - NORTH WING

ID1.1B

DRAWN BY : PS/KH CHECKED BY : EB

Plot Date: Feb 03, 2026 - 5:43pm By: jkelly Filename: K:\1VG-Brantford\Near North DSB-Parry Sound School\2211\Drawings\Wd-Current\NN - ID1.1 Level 1 Floor Finish Plan.dwg



1 / ID1.1C FIRST FLOOR - FLOOR FINISHES PLAN - CHILDCARE WING

0 1 2 5m

REVISIONS

NO.	DATE	PARTICULAR
1	2022.06.06	ISSUED FOR 80% CLASS B COSTING
2	2022.08.18	ISSUED FOR SPA
3	2022.09.22	ISSUED FOR OWNERS REVIEW - 98% SET
4	2022.12.16	ISSUED FOR 2nd SPA SUBMISSION
5	2023.01.31	ISSUED FOR TENDER
6	2023.02.22	ISSUED FOR ADDENDUM 9
7	2023.08.23	ISSUED FOR CONVENIENCE
8	2023.11.20	ISSUED FOR PERMIT COMMENTS
9	2024.01.24	ISSUED FOR SI#03
10	2024.02.15	ISSUED FOR PCN#008
11	2024.03.04	ISSUED FOR PCN#009
12	2024.03.10	ISSUED FOR SI#004
13	2024.05.14	ISSUED FOR SI#006
14	2024.07.22	ISSUED FOR SI#008
15	2024.08.07	ISSUED FOR SI#009
16	2024.10.02	ISSUED FOR PCN#15
17	2025.04.11	ISSUED FOR PCN#019
18	2025.05.01	ISSUED FOR CO#07
19	2025.05.28	ISSUED FOR PCN#20 - CO#010
20	2025.07.31	ISSUED FOR SI#013
21	2025.08.06	ISSUED FOR SI#014
22	2025.08.15	ISSUED FOR PCN#25 - CO#017
23	2025.08.25	ISSUED FOR PCN#27 - CO#021
24	2025.09.02	ISSUED FOR PCN#29
25	2025.09.02	ISSUED FOR SI#20 - CO#018
26	2025.09.08	ISSUED FOR PCN#31
27	2025.09.09	ISSUED FOR PCN#32 - CO#022
28	2025.09.10	ISSUED FOR PCN#33
29	2025.09.11	ISSUED FOR SI#022
30	2025.09.15	ISSUED FOR SI#023
31	2025.09.16	ISSUED FOR PCN #35 - CO#023
32	2025.09.30	ISSUED FOR PCN #37 - CO#029
33	2025.09.30	ISSUED FOR PCN #38 - CO#025
34	2025.10.06	ISSUED FOR PCN #39 - CO#024
35	2025.10.20	ISSUED FOR PCN #4081
36	2025.10.30	ISSUED FOR PCN#041
37	2025.10.23	ISSUED FOR PCN #42
38	2025.11.21	ISSUED FOR PCN#021/R1 - CO12 CD#006
39	2025.11.14	ISSUED FOR PCN#043
40	2025.11.26	ISSUED FOR PCN#043R1
41	2025.12.03	ISSUED FOR PCN#044 - CO#026
42	2026.02.04	ISSUED FOR RECORD SET UP TO CO#27

NOTES:

KEY PLAN:



All dimensions and measurements must be checked and verified by the General Contractor

Reproduction of drawings and related documents in whole or in part is forbidden without written permission of the VentinGroup.

Near North District School Board

CLIENT:
NEAR NORTH DISTRICT SCHOOL BOARD
NNDSB Tender # 2023-015

PROJECT:
NEW PARRY SOUND K-12 SCHOOL & CHILDCARE

PARRY SOUND HIGH SCHOOL SITE

111 ISABELLA STREET
PARRY SOUND, ONTARIO

ORIGINAL PAGE SIZE ARCH E1 - 30" x 42"

KEY TO DETAIL LOCATION:
(A) A - DETAIL NO.
(B) B - DETAIL NO. ORIGIN

+VG ARCHITECTS
THE VENTIN GROUP LTD


CN

FIRST FLOOR - FLOOR FINISHES PLAN - CHILDCARE WING

ID1.1C

DRAWN BY : PS/KH CHECKED BY : EB

Plot Date: Feb 03, 2026 - 5:43pm By: jkelly Filename: K:\1VG-Brantford\Near North DSB Parry Sound School-22111\Drawings\WIP\Current\NN - ID1.1_Level 1 Floor Finish Plan.dwg

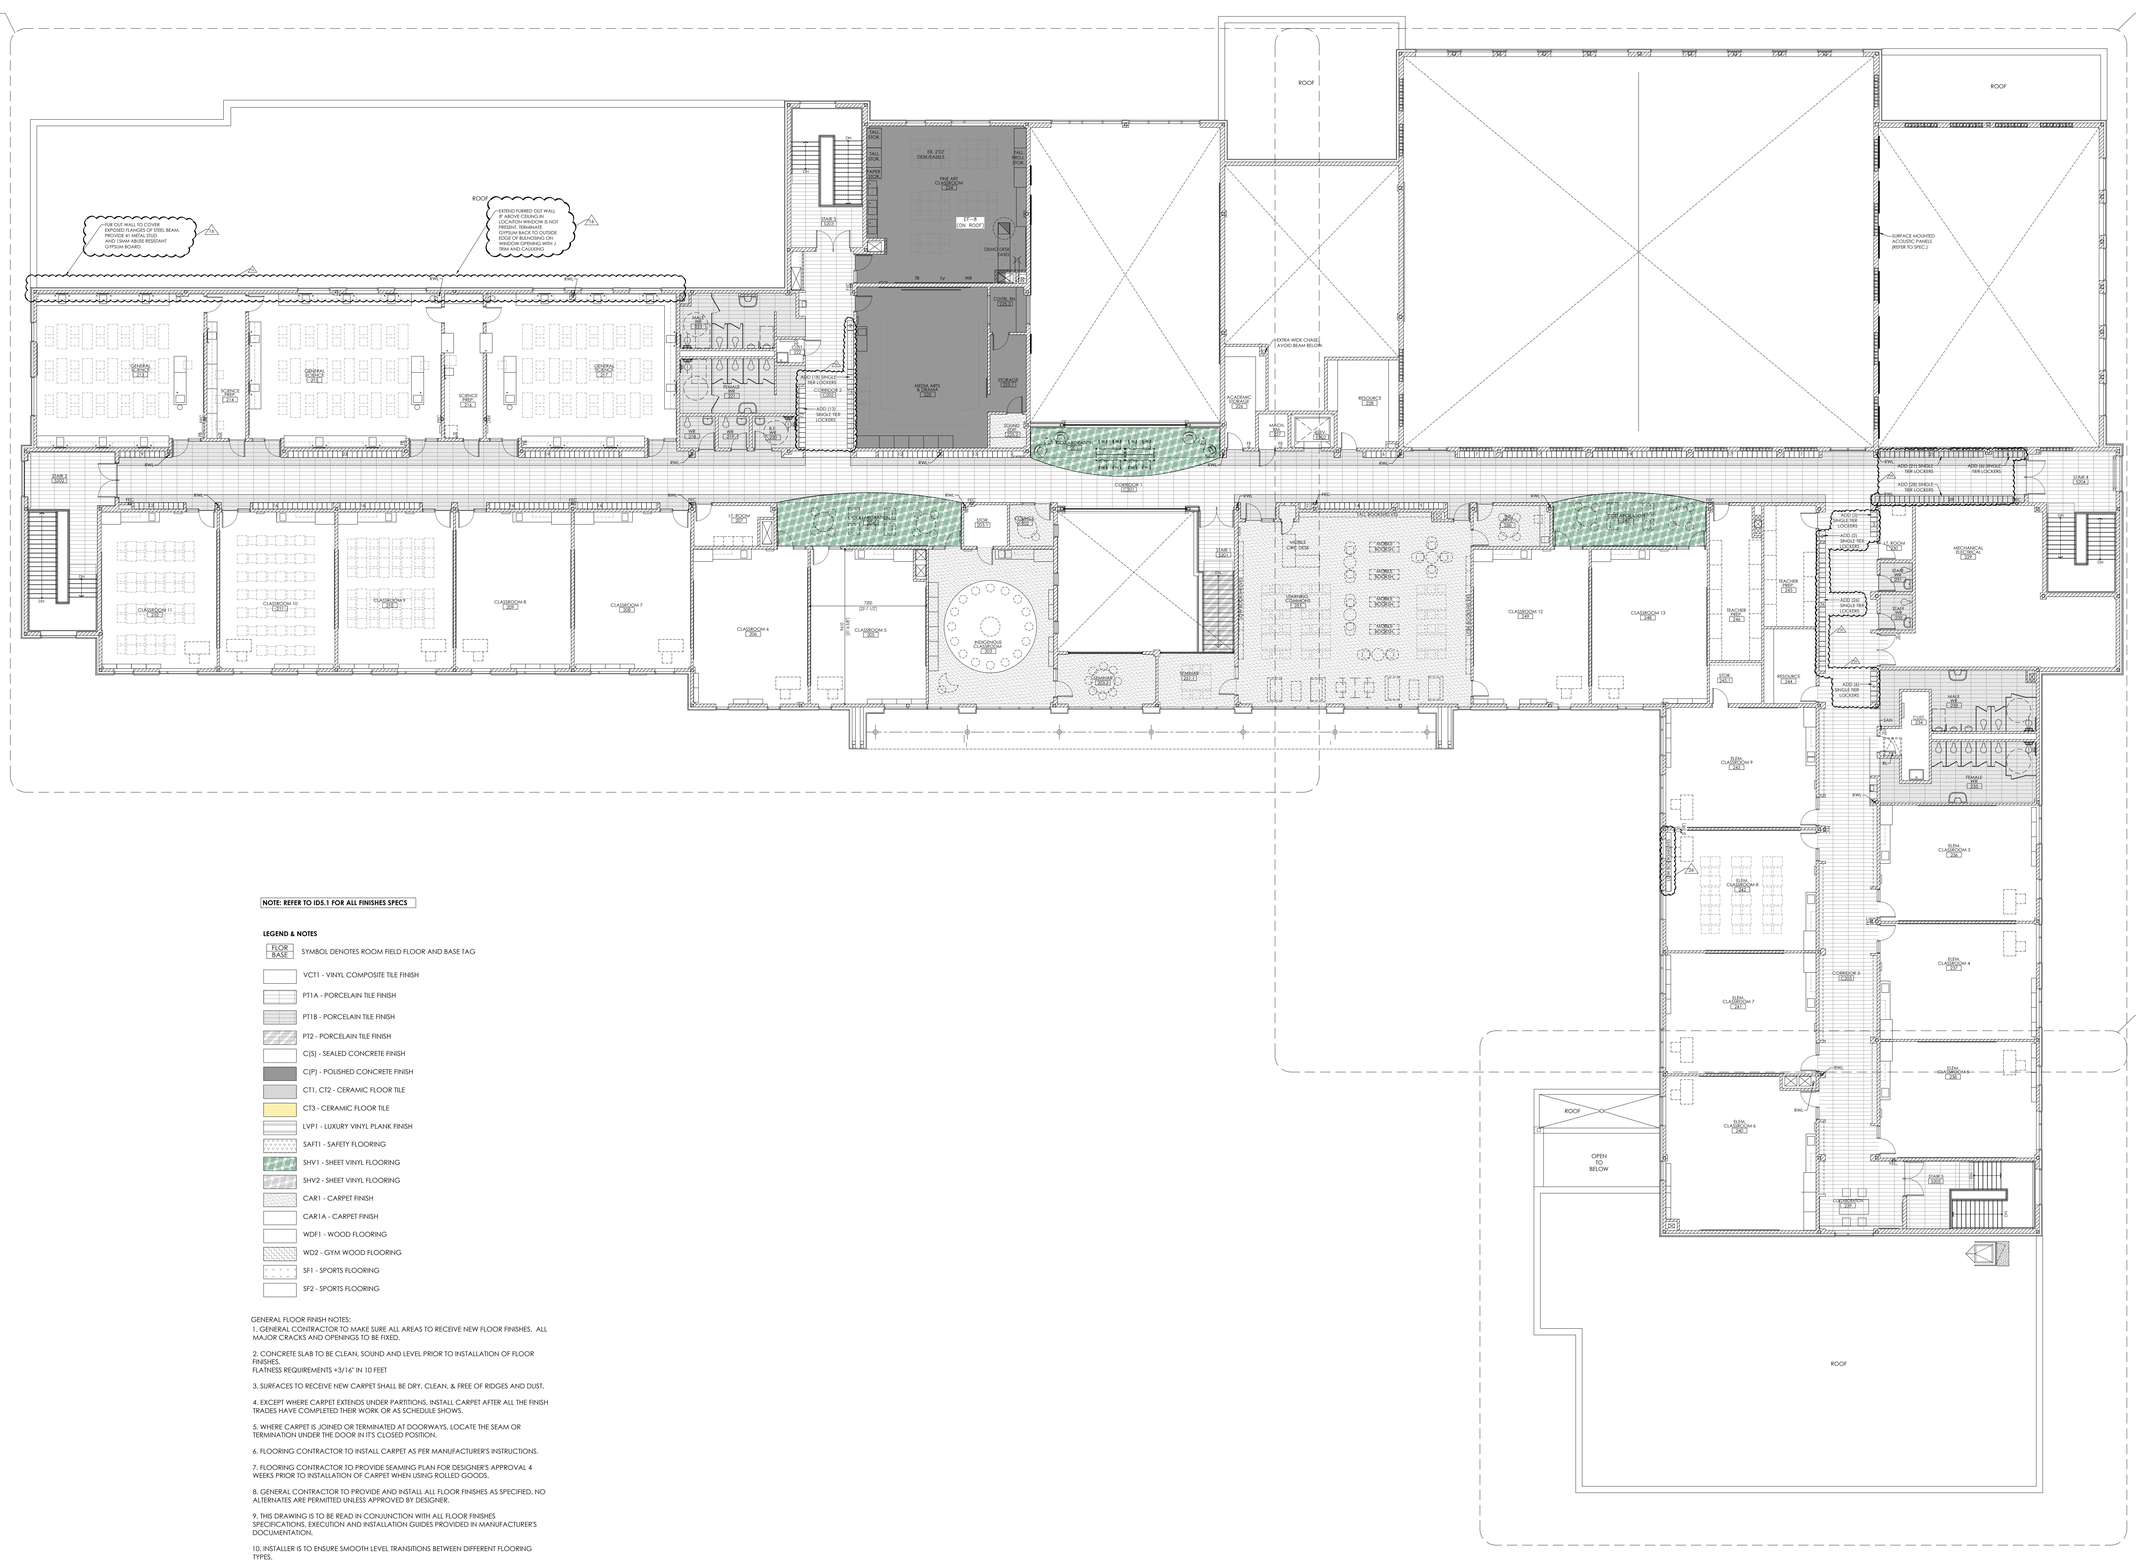

NOTE: REFER TO ID5.1 FOR ALL FINISHES SPECS

LEGEND & NOTES

FLOOR / BASE	SYMBOL DENOTES ROOM FIELD FLOOR AND BASE TAG
	VCT1 - VINYL COMPOSITE TILE FINISH
	PT1A - PORCELAIN TILE FINISH
	PT1B - PORCELAIN TILE FINISH
	PT2 - PORCELAIN TILE FINISH
	C(S) - SEALED CONCRETE FINISH
	C(P) - POLISHED CONCRETE FINISH
	CT1, CT2 - CERAMIC FLOOR TILE
	CT3 - CERAMIC FLOOR TILE
	LVP1 - LUXURY VINYL PLANK FINISH
	SAFT1 - SAFETY FLOORING
	SHV1 - SHEET VINYL FLOORING
	SHV2 - SHEET VINYL FLOORING
	CAR1 - CARPET FINISH
	CAR1A - CARPET FINISH
	WDF1 - WOOD FLOORING
	WD2 - GYM WOOD FLOORING
	SF1 - SPORTS FLOORING
	SF2 - SPORTS FLOORING

GENERAL FLOOR FINISH NOTES:

1. GENERAL CONTRACTOR TO MAKE SURE ALL AREAS TO RECEIVE NEW FLOOR FINISHES. ALL MAJOR CRACKS AND OPENINGS TO BE FIXED.

2. CONCRETE SLAB TO BE CLEAN, SOUND AND LEVEL PRIOR TO INSTALLATION OF FLOOR FINISHES.
FLATNESS REQUIREMENTS +3/16" IN 10 FEET

3. SURFACES TO RECEIVE NEW CARPET SHALL BE DRY, CLEAN, & FREE OF RIDGES AND DUST.

4. EXCEPT WHERE CARPET EXTENDS UNDER PARTITIONS, INSTALL CARPET AFTER ALL THE FINISH TRADES HAVE COMPLETED THEIR WORK OR AS SCHEDULE SHOWS.

5. WHERE CARPET IS JOINED OR TERMINATED AT DOORWAYS, LOCATE THE SEAM OR TERMINATION UNDER THE DOOR IN IT'S CLOSED POSITION.

6. FLOORING CONTRACTOR TO INSTALL CARPET AS PER MANUFACTURER'S INSTRUCTIONS.

7. FLOORING CONTRACTOR TO PROVIDE SEAMING PLAN FOR DESIGNER'S APPROVAL 4 WEEKS PRIOR TO INSTALLATION OF CARPET WHEN USING ROLLED GOODS.

8. GENERAL CONTRACTOR TO PROVIDE AND INSTALL ALL FLOOR FINISHES AS SPECIFIED. NO ALTERNATES ARE PERMITTED UNLESS APPROVED BY DESIGNER.

9. THIS DRAWING IS TO BE READ IN CONJUNCTION WITH ALL FLOOR FINISHES SPECIFICATIONS, EXECUTION AND INSTALLATION GUIDES PROVIDED IN MANUFACTURER'S DOCUMENTATION.

10. INSTALLER IS TO ENSURE SMOOTH LEVEL TRANSITIONS BETWEEN DIFFERENT FLOORING TYPES.

11. TILES SHOULD BE LAID ALL IN ONE DIRECTION TO OBTAIN UNIFORM AFFECT - ABRUPT VARIATION WILL NOT BE ACCEPTABLE.

12. INSTALL EDGE STRIPS AT UNPROTECTED OR EXPOSED EDGES WHERE FLOORING TERMINATES.

13. PROVIDE MANUFACTURER'S MAINTENANCE AND PERFORMANCE DATA FOR ALL FINISHES TO THE DESIGNER AT COMPLETION OF PROJECT.

14. FLOOR FINISHES SHALL EXTEND UNDER ALL RADIATORS/CONVECTORS AND NEW MILLWORK UNITS.


15. C(S) DENOTES SEALED CONCRETE SLAB FLOOR

REVISIONS

NO.	DATE	PARTICULAR
1	2022.06.06	ISSUED FOR 80% CLASS B COSTING
2	2022.08.18	ISSUED FOR SPA
3	2022.09.22	ISSUED FOR OWNERS REVIEW - 98% SET
4	2022.12.16	ISSUED FOR 2nd SPA SUBMISSION
5	2023.01.31	ISSUED FOR TENDER
6	2023.02.22	ISSUED FOR ADDENDUM 9
7	2023.08.23	ISSUED FOR CONVENIENCE
8	2023.11.20	ISSUED FOR PERMIT COMMENTS
9	2024.01.24	ISSUED FOR SI#03
10	2024.02.15	ISSUED FOR PCN#008
11	2024.03.04	ISSUED FOR PCN#009
12	2024.03.10	ISSUED FOR SI#004
13	2024.05.14	ISSUED FOR SI#006
14	2024.07.22	ISSUED FOR SI#008
15	2024.08.07	ISSUED FOR SI#009
16	2024.10.02	ISSUED FOR PCN#15
17	2025.04.11	ISSUED FOR PCN#019
18	2025.05.01	ISSUED FOR CO#07
19	2025.05.28	ISSUED FOR PCN#20 - CO#010
20	2025.07.31	ISSUED FOR SI#013
21	2025.08.06	ISSUED FOR SI#014
22	2025.08.15	ISSUED FOR PCN#25 - CO#017
23	2025.08.25	ISSUED FOR PCN#27 - CO#021
24	2025.09.02	ISSUED FOR PCN#29
25	2025.09.02	ISSUED FOR SI#20 - CO#018
26	2025.09.08	ISSUED FOR PCN#31
27	2025.09.09	ISSUED FOR PCN#32 - CO#022
28	2025.09.10	ISSUED FOR PCN#33
29	2025.09.11	ISSUED FOR SI#022
30	2025.09.15	ISSUED FOR SI#023
31	2025.09.16	ISSUED FOR PCN #35 - CO#023
32	2025.09.30	ISSUED FOR PCN #37 - CO#029
33	2025.09.30	ISSUED FOR PCN #38 - CO#025
34	2025.10.06	ISSUED FOR PCN #39 - CO#024
35	2025.10.20	ISSUED FOR PCN #40R1
36	2025.10.30	ISSUED FOR PCN#041
37	2025.10.23	ISSUED FOR PCN #42
38	2025.11.21	ISSUED FOR PCN#021/R1 - CO12 CO#006
39	2025.11.14	ISSUED FOR PCN#043
40	2025.11.26	ISSUED FOR PCN#043R1
41	2025.12.03	ISSUED FOR PCN#044 - CO#026
42	2026.02.04	ISSUED FOR RECORD SET UP TO CO#27

NOTES:

KEY PLAN:

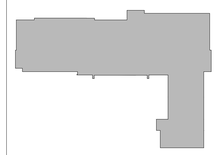

All dimensions and measurements must be checked and verified by the General Contractor

Reproduction of drawings and related documents in whole or in part is forbidden without written permission of the VentinGroup.

Plot Date: Feb 03, 2026 - 5:44pm By: jkelly
Filename: K:\1VG-Brantford\Near North DSB Parry Sound School\2211\1Drawings\Vol-Current\NN - ID1.2, Level 2 Floor Finish Plan.dwg

CLIENT:
NEAR NORTH DISTRICT SCHOOL BOARD
NNDSB Tender # 2023-015

PROJECT:
NEW PARRY SOUND K-12 SCHOOL & CHILDCARE

PARRY SOUND HIGH SCHOOL SITE

111 ISABELLA STREET
PARRY SOUND, ONTARIO


ORIGINAL PAGE SIZE ARCH E1 - 30" x 42"
KEY TO DETAIL LOCATION:
A - DETAIL NO.
B - DETAIL NO. ORIGIN

+VG ARCHITECTS
THE VENTIN GROUP LTD

SECOND FLOOR - OVERALL FLOOR FINISHES PLAN & LEGEND

ID1.2

DRAWN BY : PS/KH CHECKED BY : EB

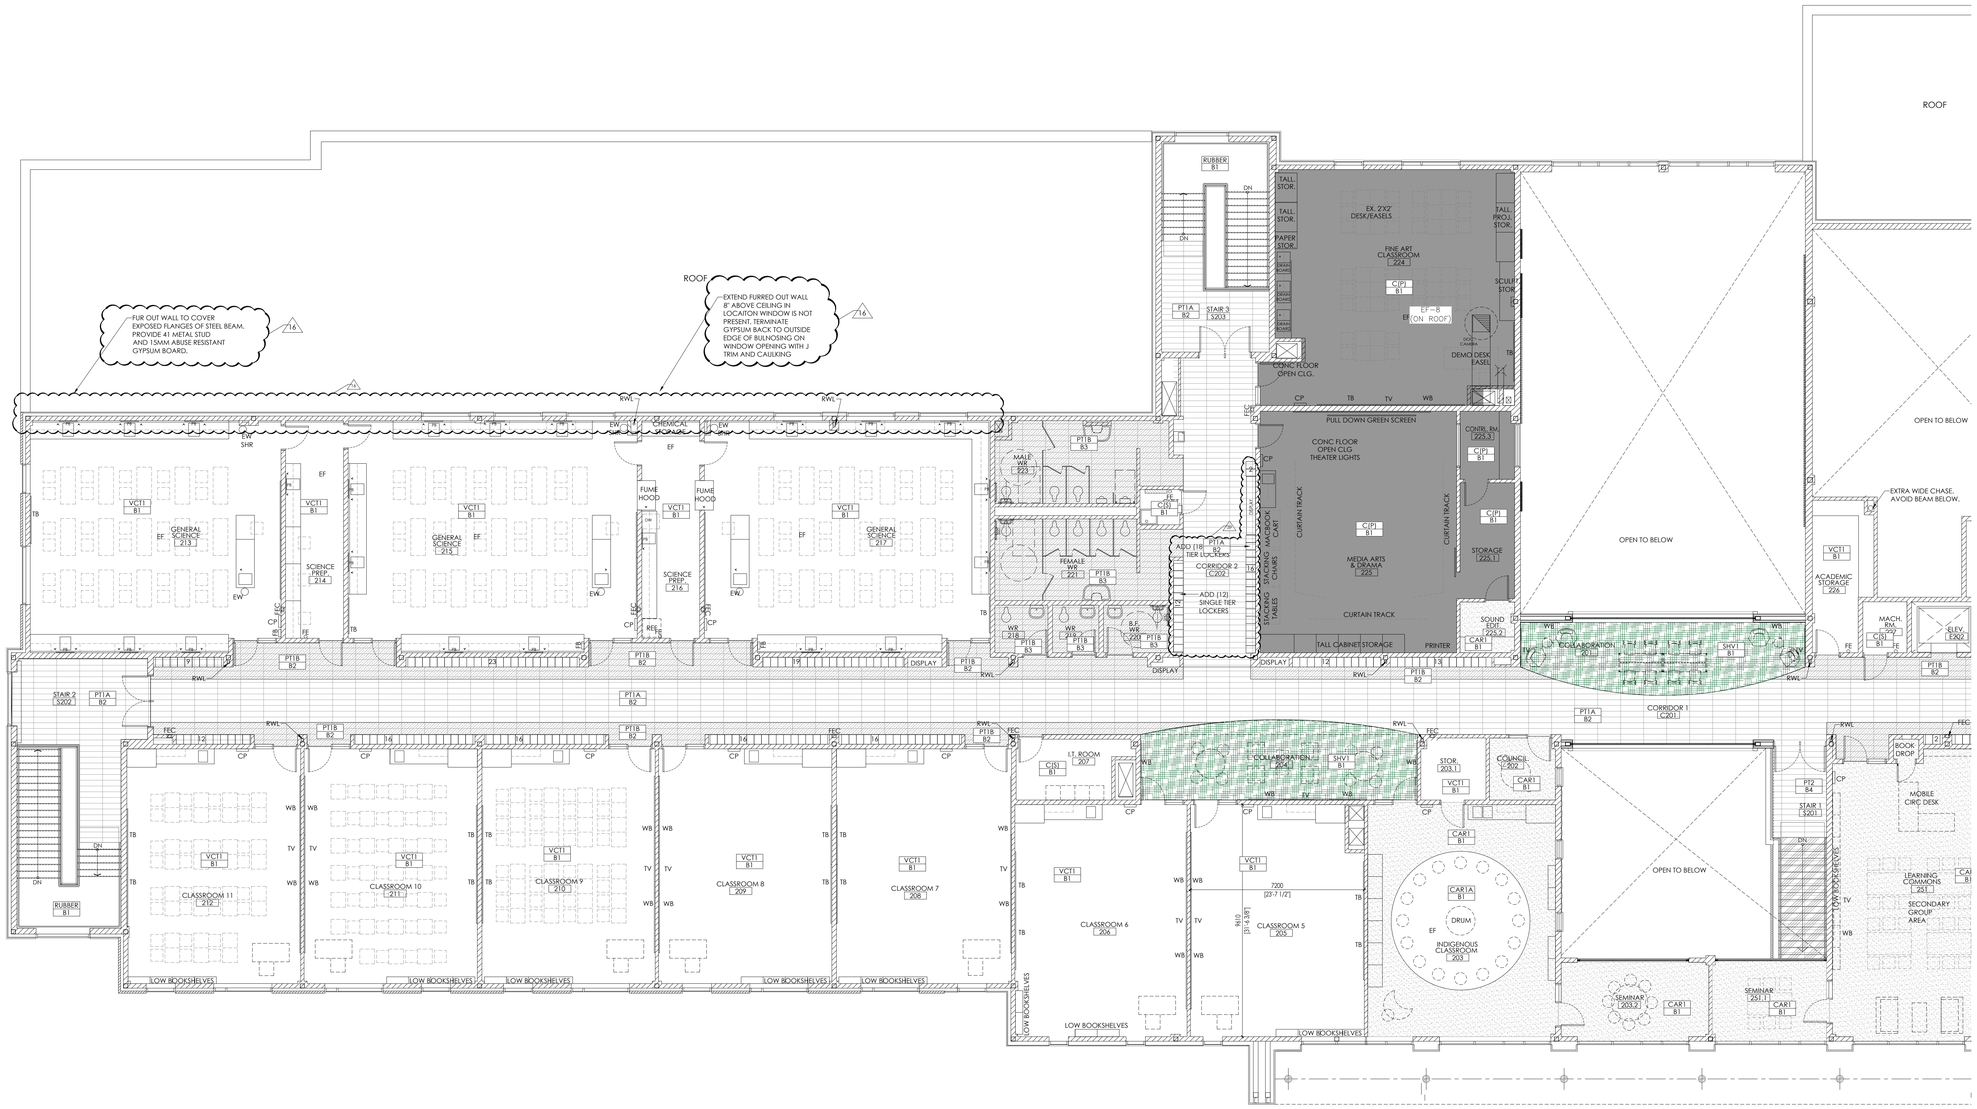

1 / ID1.1A SECOND FLOOR - FLOOR FINISHES PLAN - SOUTH WING


0 1 2 5m

REVISIONS

NO.	DATE	PARTICULAR
1	2022.06.06	ISSUED FOR 80% CLASS B COSTING
2	2022.08.18	ISSUED FOR SPA
3	2022.09.22	ISSUED FOR OWNERS REVIEW - 98% SET
4	2022.12.16	ISSUED FOR 2nd SPA SUBMISSION
5	2023.01.31	ISSUED FOR TENDER
6	2023.02.22	ISSUED FOR ADDENDUM 9
7	2023.08.23	ISSUED FOR CONVENIENCE
8	2023.11.20	ISSUED FOR PERMIT COMMENTS
9	2024.01.24	ISSUED FOR SI#03
10	2024.02.15	ISSUED FOR PCN#008
11	2024.03.04	ISSUED FOR PCN#009
12	2024.03.10	ISSUED FOR SI#004
13	2024.05.14	ISSUED FOR SI#006
14	2024.07.22	ISSUED FOR SI#008
15	2024.08.07	ISSUED FOR SI#009
16	2024.10.02	ISSUED FOR PCN#15
17	2025.04.11	ISSUED FOR PCN#019
18	2025.05.01	ISSUED FOR CO#07
19	2025.05.28	ISSUED FOR PCN#20 - CO#010
20	2025.07.31	ISSUED FOR SI#013
21	2025.08.06	ISSUED FOR SI#014
22	2025.08.15	ISSUED FOR PCN#25 - CO#017
23	2025.08.25	ISSUED FOR PCN#27 - CO#021
24	2025.09.02	ISSUED FOR PCN#29
25	2025.09.02	ISSUED FOR SI#20 - CO#018
26	2025.09.08	ISSUED FOR PCN#31
27	2025.09.09	ISSUED FOR PCN#32 - CO#022
28	2025.09.10	ISSUED FOR PCN#33
29	2025.09.11	ISSUED FOR SI#022
30	2025.09.15	ISSUED FOR SI#023
31	2025.09.16	ISSUED FOR PCN #35 - CO#023
32	2025.09.30	ISSUED FOR PCN #37 - CO#029
33	2025.09.30	ISSUED FOR PCN #38 - CO#025
34	2025.10.06	ISSUED FOR PCN #39 - CO#024
35	2025.10.20	ISSUED FOR PCN #40R1
36	2025.10.30	ISSUED FOR PCN#041
37	2025.10.23	ISSUED FOR PCN #42
38	2025.11.21	ISSUED FOR PCN#021/R1 - CO12 CO#006
39	2025.11.14	ISSUED FOR PCN#043
40	2025.11.26	ISSUED FOR PCN#043R1
41	2025.12.03	ISSUED FOR PCN#044 - CO#026
42	2026.02.04	ISSUED FOR RECORD SET UP TO CO#27

NOTES:

KEY PLAN:

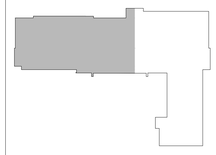

All dimensions and measurements must be checked and verified by the General Contractor

Reproduction of drawings and related documents in whole or in part is forbidden without written permission of the Ventin Group.

CLIENT:
NEAR NORTH DISTRICT SCHOOL BOARD
NNDSB Tender # 2023-015

PROJECT:
NEW PARRY SOUND K-12 SCHOOL & CHILDCARE

PARRY SOUND HIGH SCHOOL SITE

111 ISABELLA STREET
PARRY SOUND, ONTARIO

ORIGINAL PAGE SIZE ARCH E1 - 30" x 42"

KEY TO DETAIL LOCATION:
(A) A - DETAIL NO.
(B) B - DETAIL NO. ORIGIN


+VG ARCHITECTS
THE VENTIN GROUP LTD

SECOND FLOOR - FLOOR FINISHES PLAN - SOUTH WING

ID1.2A

DRAWN BY : PS/KH CHECKED BY : EB

Plot Date: Feb 03, 2026 - 5:44pm By: kelly Filename: K:\TVG-Brantford\Near North DSB-Parry Sound School\2211\Drawings\Wd-Current\NN - ID1.2_Level 2 Floor Finish Plan.dwg

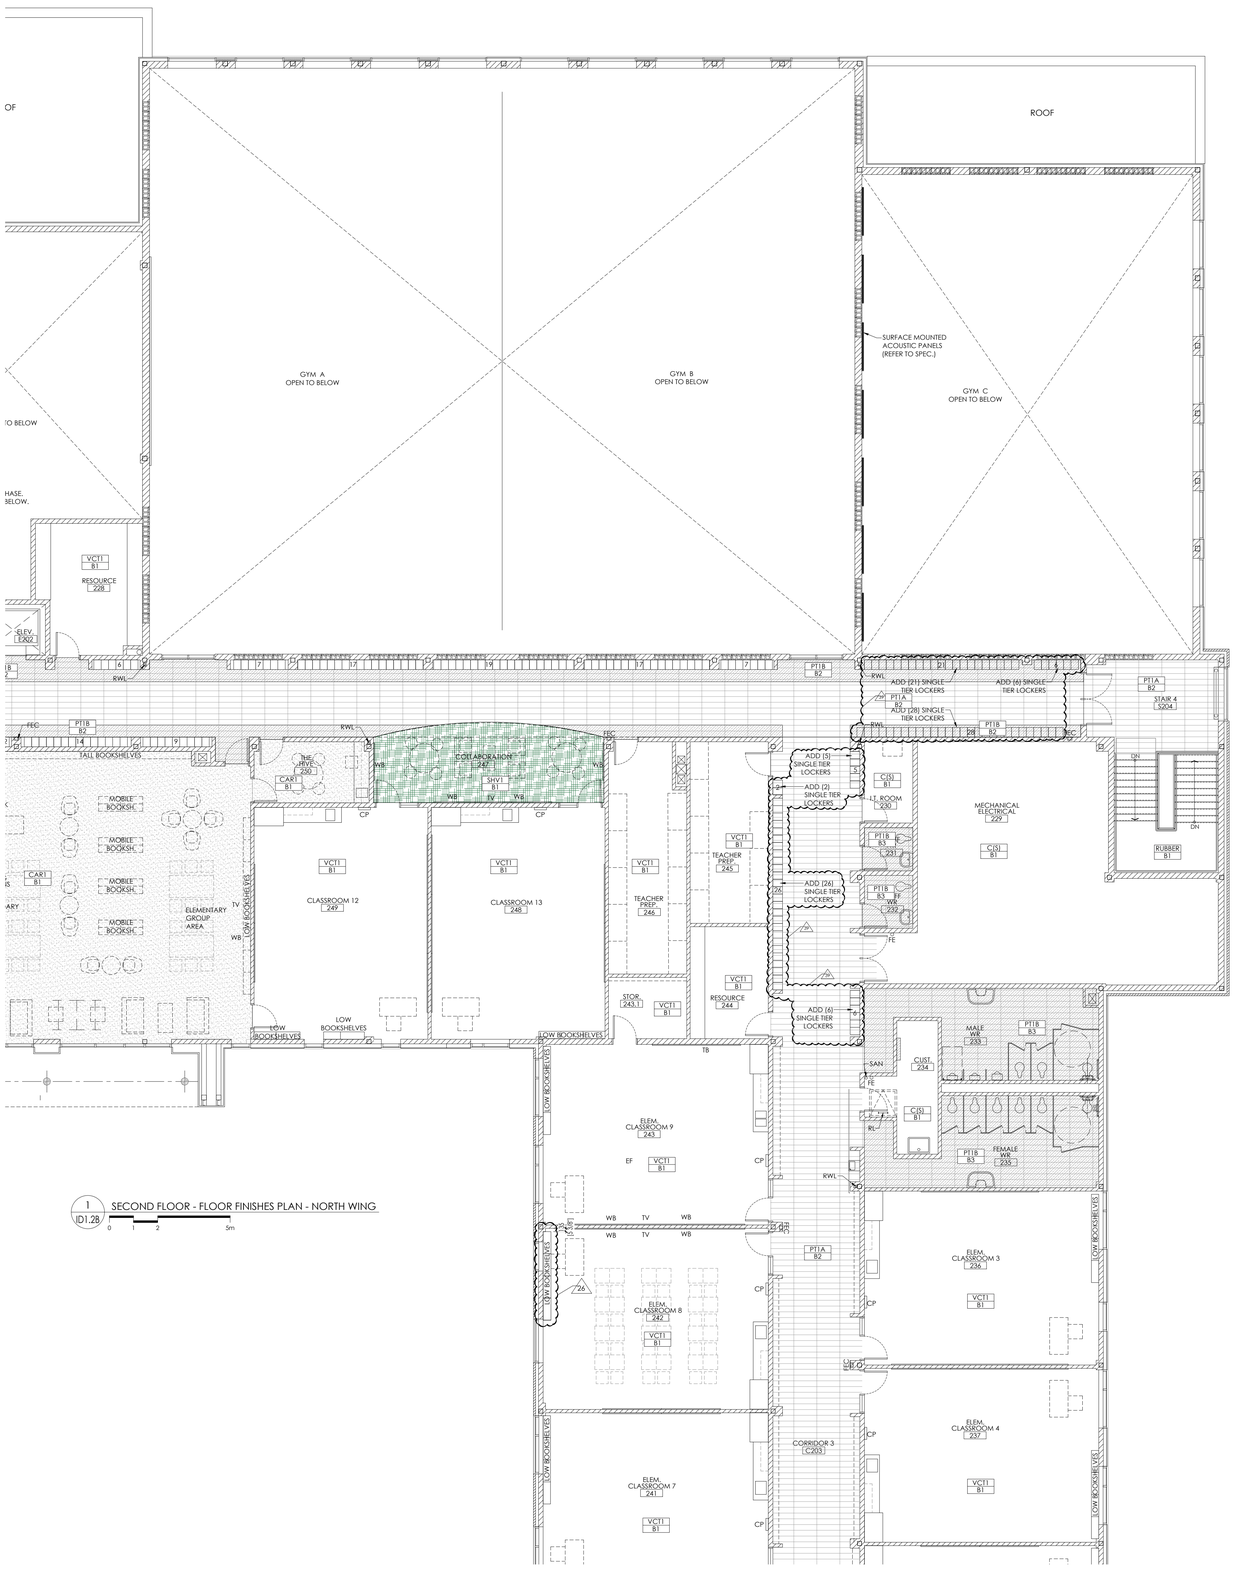

1 SECOND FLOOR - FLOOR FINISHES PLAN - NORTH WING
ID1.2B
0 1 2 5m

REVISIONS


NO.	DATE	PARTICULAR
1	2022.06.06	ISSUED FOR 80% CLASS B COSTING
2	2022.08.18	ISSUED FOR SPA
3	2022.09.22	ISSUED FOR OWNERS REVIEW - 98% SET
4	2022.12.16	ISSUED FOR 2nd SPA SUBMISSION
5	2023.01.31	ISSUED FOR TENDER
6	2023.02.22	ISSUED FOR ADDENDUM 9
7	2023.08.23	ISSUED FOR CONVENIENCE
8	2023.11.20	ISSUED FOR PERMIT COMMENTS
9	2024.01.24	ISSUED FOR SI#03
10	2024.02.15	ISSUED FOR PCN#008
11	2024.03.04	ISSUED FOR PCN#009
12	2024.03.10	ISSUED FOR SI#004
13	2024.05.14	ISSUED FOR SI#006
14	2024.07.22	ISSUED FOR SI#008
15	2024.08.07	ISSUED FOR SI#009
16	2024.10.02	ISSUED FOR PCN#15
17	2025.04.11	ISSUED FOR PCN#019
18	2025.05.01	ISSUED FOR CO#07
19	2025.05.28	ISSUED FOR PCN#20 - CO#010
20	2025.07.31	ISSUED FOR SI#013
21	2025.08.06	ISSUED FOR SI#014
22	2025.08.15	ISSUED FOR PCN#25 - CO#017
23	2025.08.25	ISSUED FOR PCN#27 - CO#021
24	2025.09.02	ISSUED FOR PCN#29
25	2025.09.02	ISSUED FOR SI#20 - CO#018
26	2025.09.08	ISSUED FOR PCN#31
27	2025.09.09	ISSUED FOR PCN#32 - CO#022
28	2025.09.10	ISSUED FOR PCN#33
29	2025.09.11	ISSUED FOR SI#022
30	2025.09.15	ISSUED FOR SI#023
31	2025.09.16	ISSUED FOR PCN #35 - CO#023
32	2025.09.30	ISSUED FOR PCN #37 - CO#029
33	2025.09.30	ISSUED FOR PCN #38 - CO#025
34	2025.10.06	ISSUED FOR PCN #39 - CO#024
35	2025.10.20	ISSUED FOR PCN #40R1
36	2025.10.30	ISSUED FOR PCN#041
37	2025.10.23	ISSUED FOR PCN #42
38	2025.11.21	ISSUED FOR PCN#021/R1 - CO12 CD#006
39	2025.11.14	ISSUED FOR PCN#043
40	2025.11.26	ISSUED FOR PCN#043R1
41	2025.12.03	ISSUED FOR PCN#044 - CO#026
42	2026.02.04	ISSUED FOR RECORD SET UP TO CO#27

All dimensions and measurements must be checked and verified by the General Contractor

Reproduction of drawings and related documents in whole or in part is forbidden without written permission of the Ventin Group.

NOTES:

KEY PLAN:

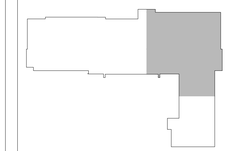

Near North District School Board

CLIENT:
NEAR NORTH DISTRICT SCHOOL BOARD
NNDSB Tender # 2023-015

PROJECT:
NEW PARRY SOUND K-12 SCHOOL & CHILDCARE

PARRY SOUND HIGH SCHOOL SITE

111 ISABELLA STREET
PARRY SOUND, ONTARIO

ORIGINAL PAGE SIZE ARCH E1 - 30" x 42"
KEY TO DETAIL LOCATION:
(A) A - DETAIL NO.
(B) B - DETAIL NO. ORIGIN


+VG ARCHITECTS
THE VENTIN GROUP LTD

SECOND FLOOR - FLOOR FINISHES PLAN - NORTH WING

ID1.2B

DRAWN BY : PS/KH CHECKED BY : EB

Plot Date: Feb 03, 2026 - 5:44pm By: jkelly Filename: K:\VG-Brantford\Near North DSB Parry Sound School\22111\Drawings\Wed-Current\NN - ID1.2_Level 2 Floor Finish Plan.dwg

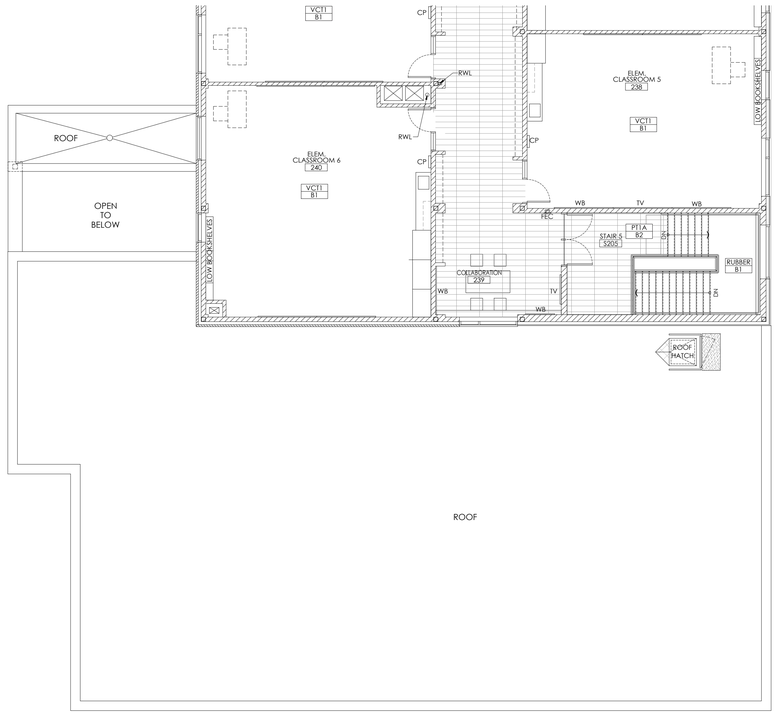

1 / ID1.2C SECOND FLOOR - FLOOR FINISHES PLAN - CHILDCARE WING

0 1 2 5m

REVISIONS

NO.	DATE	PARTICULAR
1	2022.06.06	ISSUED FOR 80% CLASS B COSTING
2	2022.08.18	ISSUED FOR SPA
3	2022.09.22	ISSUED FOR OWNERS REVIEW - 98% SET
4	2022.12.16	ISSUED FOR 2nd SPA SUBMISSION
5	2023.01.31	ISSUED FOR TENDER
6	2023.02.22	ISSUED FOR ADDENDUM 9
7	2023.08.23	ISSUED FOR CONVENIENCE
8	2023.11.20	ISSUED FOR PERMIT COMMENTS
9	2024.01.24	ISSUED FOR SI#03
10	2024.02.15	ISSUED FOR PCN#008
11	2024.03.04	ISSUED FOR PCN#009
12	2024.03.10	ISSUED FOR SI#004
13	2024.05.14	ISSUED FOR SI#006
14	2024.07.22	ISSUED FOR SI#008
15	2024.08.07	ISSUED FOR SI#009
16	2024.10.02	ISSUED FOR PCN#15
17	2025.04.11	ISSUED FOR PCN#019
18	2025.05.01	ISSUED FOR CO#07
19	2025.05.28	ISSUED FOR PCN#20 - CO#010
20	2025.07.31	ISSUED FOR SI#013
21	2025.08.06	ISSUED FOR SI#014
22	2025.08.15	ISSUED FOR PCN#25 - CO#017
23	2025.08.25	ISSUED FOR PCN#27 - CO#021
24	2025.09.02	ISSUED FOR PCN#29
25	2025.09.02	ISSUED FOR SI#20 - CO#018
26	2025.09.08	ISSUED FOR PCN#31
27	2025.09.09	ISSUED FOR PCN#32 - CO#022
28	2025.09.10	ISSUED FOR PCN#33
29	2025.09.11	ISSUED FOR SI#022
30	2025.09.15	ISSUED FOR SI#023
31	2025.09.16	ISSUED FOR PCN #35 - CO#023
32	2025.09.30	ISSUED FOR PCN #37 - CO#029
33	2025.09.30	ISSUED FOR PCN #38 - CO#025
34	2025.10.06	ISSUED FOR PCN #39 - CO#024
35	2025.10.20	ISSUED FOR PCN #40R1
36	2025.10.30	ISSUED FOR PCN#041
37	2025.10.23	ISSUED FOR PCN #42
38	2025.11.21	ISSUED FOR PCN#021/R1 - CO12 CD#006
39	2025.11.14	ISSUED FOR PCN#043
40	2025.11.26	ISSUED FOR PCN#043R1
41	2025.12.03	ISSUED FOR PCN#044 - CO#026
42	2026.02.04	ISSUED FOR RECORD SET UP TO CO#27

NOTES:

KEY PLAN:



All dimensions and measurements must be checked and verified by the General Contractor

Reproduction of drawings and related documents in whole or in part is forbidden without written permission of the Ventin Group.

Near North District School Board

CLIENT:
NEAR NORTH DISTRICT SCHOOL BOARD
NNDSB Tender # 2023-015

PROJECT:
NEW PARRY SOUND K-12 SCHOOL & CHILDCARE

PARRY SOUND HIGH SCHOOL SITE

111 ISABELLA STREET
PARRY SOUND, ONTARIO

ORIGINAL PAGE SIZE ARCH E1 - 30" x 42"
KEY TO DETAIL LOCATION:
A - DETAIL NO.
B - DETAIL NO. ORIGIN

+VG ARCHITECTS
THE VENTIN GROUP LTD

CN

SECOND FLOOR - FLOOR FINISHES PLAN - CHILDCARE WING

ID1.2C

DRAWN BY : PS/KH CHECKED BY : EB

Plot Date: Feb 03, 2026 - 5:44pm By jkelly Filename: K:\1VG-Brantford\Near North DSB Parry Sound School\2211\Drawings\Wd-Current\NN - ID1.2_Level 2 Floor Finish Plan.dwg



NOTE:

- REFER TO ID5.1 FOR ALL FINISHES SPECS
- CORRIDORS, WASHROOMS, SERVICE ROOMS, MECH./ELEC. ROOMS, LOWER 4.4m OF GYM & GYM STORAGE ROOMS TO HAVE SPECIAL COATING (WATER-BASED EPOXY) PAINT.
- PLACEHOLDERS FOR MURALS SHOULD BE PAINTED IN BASE WALL COLOR.
- ON FOLDING PARTITION, USE VINYL WALL COVERING AS A BASE. REFER TO ID5.1 FOR SPECS

GENERAL WALL FINISH NOTES:

1. PAINTING CONTRACTOR SHALL PROVIDE ALL MATERIALS, LABOUR, EQUIPMENT, AND SERVICES AS NECESSARY FOR A SOLID INSTALLATION TO COMPLETE WORK AS INDICATED ON ENCLOSED PLANS

2. DELIVER ALL PAINT TO SITE IN MANUFACTURERS LABELED AND SEALED CONTAINERS. LABELS SHALL GIVE MANUFACTURER'S NAME, BRAND, BATCH NUMBER, COLOUR OF PAINT WITH PRINTED INSTRUCTIONS TO REDUCING, THIN ONLY IN ACCORDANCE WITH PRINTED INSTRUCTIONS OF THE MANUFACTURER.

3. STORE ALL MATERIALS ON-SITE , IN SPACE AS DESIGNATED BY BUILDING MANAGER. SUCH STORAGE PLACE SHALL BE KEPT CLEAN. REMOVE ANY OILY RAGS, WASTE ETC., FROM THE BUILDING EVERY NIGHT TO TAKE EVERY PRECAUTION TO AVOID THE DANGER OF FIRE. IN NO CASE SHALL AMOUNT OF MATERIALS STORED EXCEED THAT PERMITTED BY LOCAL LAW.

4. ALL SURFACES FOR PAINT FINISH SHALL BE SANDED, FILLED, SANDED SMOOTH AND PREPARED AS REQUIRED TO ACCEPT ONE COAT PRIMER AND 2 COATS PAINTED FINISH.

5. PAINTING CONTRACTOR SHALL CONFIRM ALL COLOURS, FINISHES, AND MATERIALS SPECIFIED.

6. PAINTING CONTRACTOR SHALL PREPARE A 8-1/2" X 11" PULL DOWN OF EACH PAINT COLOUR SPECIFIED FOR APPROVAL BY DESIGN CONSULTANT PRIOR TO PROCESSING WITH THE WORK.

7. ALL MATERIALS TO HAVE A FLAME SPREAD RATING AS REQUIRED BY THE LOCAL BUILDING CODE. CONTRACTOR TO PROVIDE FLAME SPREAD RATING FOR ANY APPROVED ALTERNATIVES.

8. PRIOR TO PREPARATION OF WALL TO ACCEPT NEW FINISES, REMOVE COVER PLATES, SURFACE HARDWARE, ETC., AND REINSTALL IN SATISFACTORY CONDITION UPON COMPLETION.

9. PAINT ONLY WHEN SURFACES ARE CLEAN, DRY, AND SMOOTH. EACH COAT OF PAINT SHALL BE WALL BRUSHED ON, WORKED EVENLY AND ALLOWED TO DRY AT LEAST 24 HOURS PRIOR TO SUBSEQUENT COAT APPLICATION.[1]DENOTES FRAME FINISH TYPE

10. FINISHED WORK SHALL BE UNIFORM, OR APPROVED COLOUR, SMOOTH AND FREE FROM RUNS, SAGS, CLOGGING OR EXCESS FLOODING. MAKE EDGE OF PAINT ADJOINING OTHER MATERIALS OR COLOURS, SHARP AND CLEAN WITHOUT OVERLAPPING. WHERE GLOSS ENAMEL IS USED, LIGHTLY SAND UNDERCOAT TO OBTAIN A SMOOTH FINISH.

11. AT COMPLETION, TOUCH-UP AND RESTORE SURFACES WHERE DAMAGED, AND LEAVE FINISHED SURFACES IN GOOD CONDITION.

12. ALL REVEALS TO BE PAINTED AS PER WALL FINISHES PLAN.

WALL — DENOTES WALL FINISH TYPE
DOOR
FRAME — DENOTES DOOR FINISH TYPE

TBD - DENOTES "TO BE DETERMINED"

(P#) ACCENT PAINT - WALLS

(PT#) PORCELAIN TILE - WALLS

(MEL#) MELAMINE - MILLWORK CABINETRY


(PLAM#) PLASTIC LAMINATE - MILLWORK COUNTER TOPS

REVISIONS

NO.	DATE	PARTICULAR
1	2022.06.06	ISSUED FOR 80% CLASS B COSTING
2	2022.08.18	ISSUED FOR SPA
3	2022.09.22	ISSUED FOR OWNERS REVIEW - 98% SET
4	2022.12.16	ISSUED FOR 2nd SPA SUBMISSION
5	2023.01.31	ISSUED FOR TENDER
6	2023.02.22	ISSUED FOR ADDENDUM 9
7	2023.08.23	ISSUED FOR CONVENIENCE
8	2023.11.20	ISSUED FOR PERMIT COMMENTS
9	2024.01.24	ISSUED FOR SI#03
10	2024.02.15	ISSUED FOR PCN#008
11	2024.03.04	ISSUED FOR PCN#009
12	2024.03.10	ISSUED FOR SI#004
13	2024.05.14	ISSUED FOR SI#006
14	2024.07.22	ISSUED FOR SI#008
15	2024.08.07	ISSUED FOR SI#009
16	2024.10.02	ISSUED FOR PCN#15
17	2025.04.11	ISSUED FOR PCN#019
18	2025.05.01	ISSUED FOR CO#07
19	2025.05.28	ISSUED FOR PCN#20 - CO#010
20	2025.07.31	ISSUED FOR SI#013
21	2025.08.06	ISSUED FOR SI#014
22	2025.08.15	ISSUED FOR PCN#25 - CO#017
23	2025.08.25	ISSUED FOR PCN#27 - CO#021
24	2025.09.02	ISSUED FOR PCN#29
25	2025.09.02	ISSUED FOR SI#20 - CO#018
26	2025.09.08	ISSUED FOR PCN#31
27	2025.09.09	ISSUED FOR PCN#32 - CO#022
28	2025.09.10	ISSUED FOR SI#33
29	2025.09.11	ISSUED FOR SI#022
30	2025.09.15	ISSUED FOR SI#023
31	2025.09.16	ISSUED FOR PCN #35 - CO#023
32	2025.09.30	ISSUED FOR PCN #37 - CO#029
33	2025.09.30	ISSUED FOR PCN #38 - CO#025
34	2025.10.06	ISSUED FOR PCN #39 - CO#024
35	2025.10.20	ISSUED FOR PCN #40R1
36	2025.10.30	ISSUED FOR PCN#041
37	2025.10.23	ISSUED FOR PCN #42
38	2025.11.21	ISSUED FOR PCN#021/R1 - CO12 CD#006
39	2025.11.14	ISSUED FOR PCN#043
40	2025.11.26	ISSUED FOR PCN#043R1
41	2025.12.03	ISSUED FOR PCN#044 - CO#026
42	2026.02.04	ISSUED FOR RECORD SET UP TO CO#27

NOTES:

KEY PLAN:

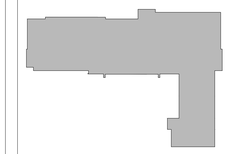

Reproduction of drawings and related documents in whole or in part is forbidden without written permission of the Ventin Group.

All dimensions and measurements must be checked and verified by the General Contractor

Near North District School Board

CLIENT:
NEAR NORTH DISTRICT SCHOOL BOARD
NNDSB Tender # 2023-015

PROJECT:
NEW PARRY SOUND K-12 SCHOOL & CHILDCARE

PARRY SOUND HIGH SCHOOL SITE

111 ISABELLA STREET
PARRY SOUND, ONTARIO

ORIGINAL PAGE SIZE ARCH E1 - 30" x 42"

KEY TO DETAIL LOCATION:
(A) A - DETAIL NO.
(B) B - DETAIL NO. ORIGIN


+VG ARCHITECTS
THE VENTIN GROUP LTD

FIRST FLOOR - OVERALL WALL FINISHES PLAN & LEGEND

ID2.1

DRAWN BY : PS/KH CHECKED BY : EB

Plot Date: Feb 03, 2026 - 5:45pm By: jkelly Filename: K:\1VG-Brantford\Near North DSB Parry Sound School\2211\1Drawings\Wall Finish Plan.dwg

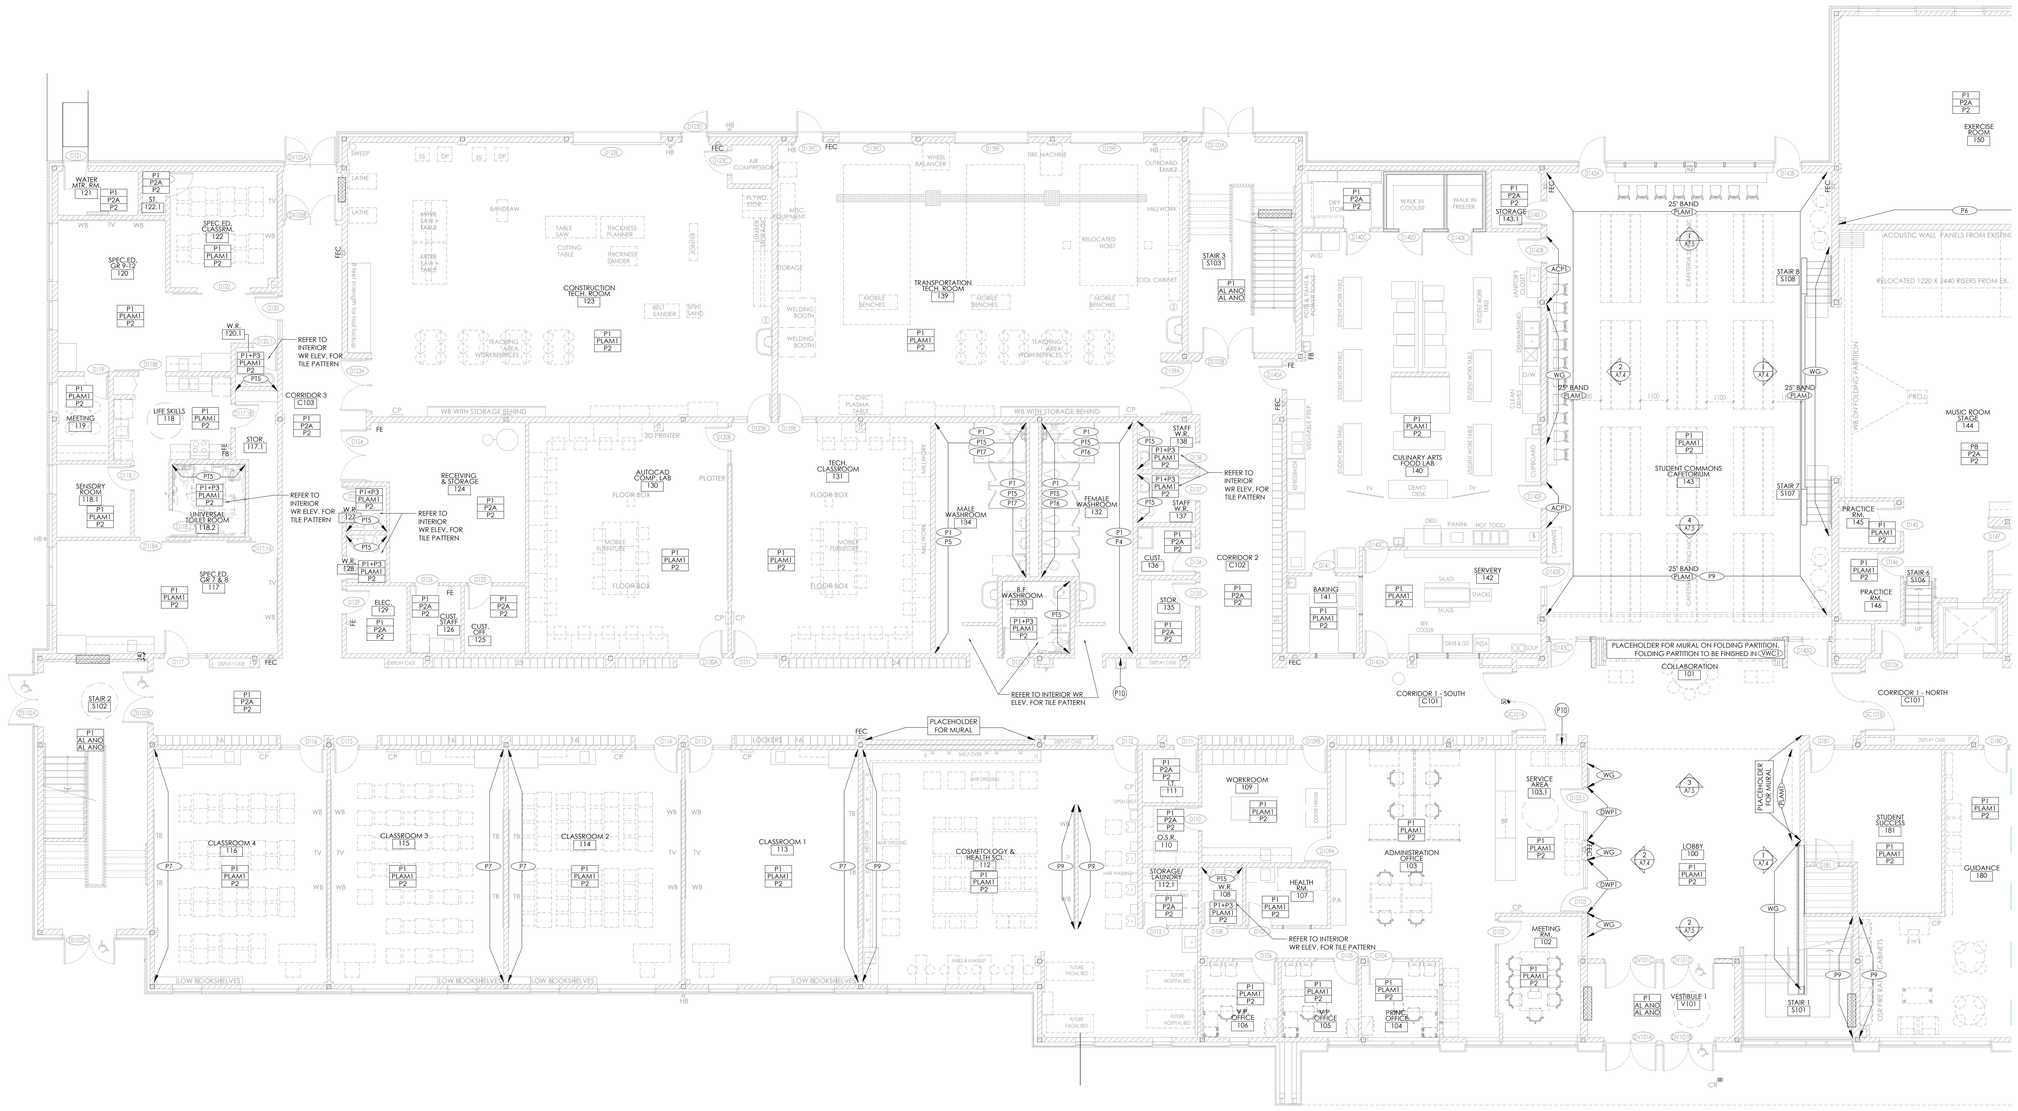

1 / ID2.1A FIRST FLOOR - WALL FINISHES PLAN - SOUTH WING


0 1 2 5m

REVISIONS

NO.	DATE	PARTICULAR
1	2022.06.06	ISSUED FOR 80% CLASS B COSTING
2	2022.08.18	ISSUED FOR SPA
3	2022.09.22	ISSUED FOR OWNERS REVIEW - 98% SET
4	2022.12.16	ISSUED FOR 2nd SPA SUBMISSION
5	2023.01.31	ISSUED FOR TENDER
6	2023.02.22	ISSUED FOR ADDENDUM 9
7	2023.08.23	ISSUED FOR CONVENIENCE
8	2023.11.20	ISSUED FOR PERMIT COMMENTS
9	2024.01.24	ISSUED FOR SI#03
10	2024.02.15	ISSUED FOR PCN#008
11	2024.03.04	ISSUED FOR PCN#009
12	2024.03.10	ISSUED FOR SI#004
13	2024.05.14	ISSUED FOR SI#006
14	2024.07.22	ISSUED FOR SI#008
15	2024.08.07	ISSUED FOR SI#009
16	2024.10.02	ISSUED FOR PCN#15
17	2025.04.11	ISSUED FOR PCN#019
18	2025.05.01	ISSUED FOR CO#07
19	2025.05.28	ISSUED FOR PCN#20 - CO#010
20	2025.07.31	ISSUED FOR SI#013
21	2025.08.06	ISSUED FOR SI#014
22	2025.08.15	ISSUED FOR PCN#25 - CO#017
23	2025.08.25	ISSUED FOR PCN#27 - CO#021
24	2025.09.02	ISSUED FOR PCN#29
25	2025.09.02	ISSUED FOR SI#20 - CO#018
26	2025.09.08	ISSUED FOR PCN#31
27	2025.09.09	ISSUED FOR PCN#32 - CO#022
28	2025.09.10	ISSUED FOR PCN#33
29	2025.09.11	ISSUED FOR SI#022
30	2025.09.15	ISSUED FOR SI#023
31	2025.09.16	ISSUED FOR PCN #35 - CO#023
32	2025.09.30	ISSUED FOR PCN #37 - CO#019
33	2025.09.30	ISSUED FOR PCN #38 - CO#025
34	2025.10.06	ISSUED FOR PCN #39 - CO#024
35	2025.10.20	ISSUED FOR PCN #40#1
36	2025.10.30	ISSUED FOR PCN#041
37	2025.10.23	ISSUED FOR PCN #42
38	2025.11.21	ISSUED FOR PCN#021/R1 - CO12 CD#006
39	2025.11.14	ISSUED FOR PCN#043
40	2025.11.26	ISSUED FOR PCN#043R1
41	2025.12.03	ISSUED FOR PCN#044 - CO#026
42	2026.02.04	ISSUED FOR RECORD SET UP TO CO#27

NOTES:

KEY PLAN:

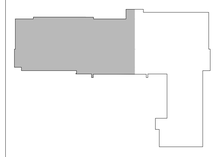

Reproduction of drawings and related documents in whole or in part is forbidden without written permission of The Ventin Group.

All dimensions and measurements must be checked and verified by the General Contractor

Near North District School Board

CLIENT:
NEAR NORTH DISTRICT SCHOOL BOARD
NNDSB Tender # 2023-015

PROJECT:
NEW PARRY SOUND K-12 SCHOOL & CHILDCARE

PARRY SOUND HIGH SCHOOL SITE

111 ISABELLA STREET
PARRY SOUND, ONTARIO

ORIGINAL PAGE SIZE ARCH E1 - 30" x 42"
KEY TO DETAIL LOCATION:
A - DETAIL NO.
B - DETAIL NO. ORIGIN

+VG ARCHITECTS
THE VENTIN GROUP LTD


CN

FIRST FLOOR - WALL FINISHES PLAN - SOUTH WING

ID2.1A

DRAWN BY : PS/KH CHECKED BY : EB

Plot Date: Feb 03, 2026 - 5:45pm By: jkelly Filename: K:\1VG-Brantford\Near North DSB Parry Sound School\221111\Drawings\Wd-Content\NN - ID2.1_Level 1 Wall Finish Plan.dwg

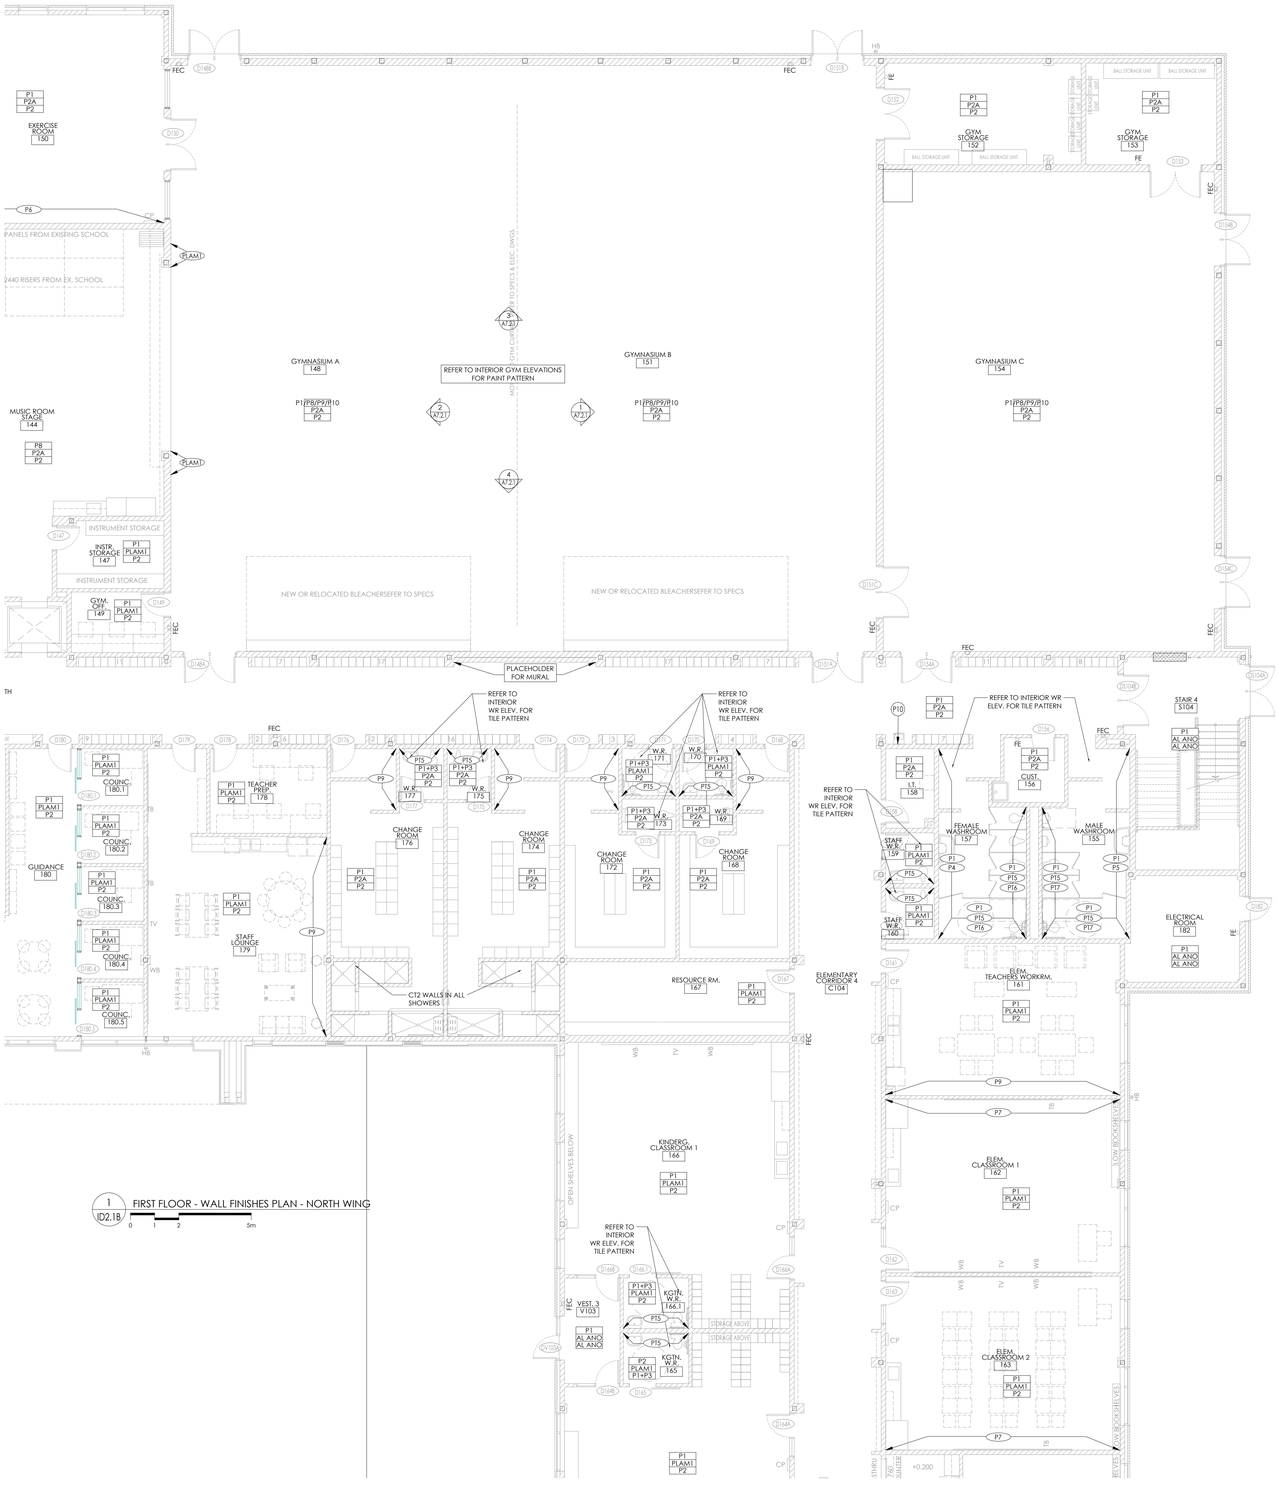

1 ID2.1B FIRST FLOOR - WALL FINISHES PLAN - NORTH WING

0 1 2 5m

REVISIONS


NO.	DATE	PARTICULAR
1	2022.06.06	ISSUED FOR 80% CLASS B COSTING
2	2022.08.18	ISSUED FOR SPA
3	2022.09.22	ISSUED FOR OWNERS REVIEW - 98% SET
4	2022.12.16	ISSUED FOR 2nd SPA SUBMISSION
5	2023.01.31	ISSUED FOR TENDER
6	2023.02.22	ISSUED FOR ADDENDUM 9
7	2023.08.23	ISSUED FOR CONVENIENCE
8	2023.11.20	ISSUED FOR PERMIT COMMENTS
9	2024.01.24	ISSUED FOR SI#03
10	2024.02.15	ISSUED FOR PCN#008
11	2024.03.04	ISSUED FOR PCN#009
12	2024.03.10	ISSUED FOR SI#004
13	2024.05.14	ISSUED FOR SI#006
14	2024.07.22	ISSUED FOR SI#008
15	2024.08.07	ISSUED FOR SI#009
16	2024.10.02	ISSUED FOR PCN#15
17	2025.04.11	ISSUED FOR PCN#019
18	2025.05.01	ISSUED FOR CO#07
19	2025.05.28	ISSUED FOR PCN#20 - CO#010
20	2025.07.31	ISSUED FOR SI#013
21	2025.08.06	ISSUED FOR SI#014
22	2025.08.15	ISSUED FOR PCN#25 - CO#017
23	2025.08.25	ISSUED FOR PCN#27 - CO#021
24	2025.09.02	ISSUED FOR PCN#29
25	2025.09.02	ISSUED FOR SI#20 - CO#018
26	2025.09.08	ISSUED FOR PCN#31
27	2025.09.09	ISSUED FOR PCN#32 - CO#022
28	2025.09.10	ISSUED FOR PCN#33
29	2025.09.11	ISSUED FOR SI#022
30	2025.09.15	ISSUED FOR SI#023
31	2025.09.16	ISSUED FOR PCN #35 - CO#023
32	2025.09.30	ISSUED FOR PCN #37 - CO#029
33	2025.09.30	ISSUED FOR PCN #38 - CO#025
34	2025.10.06	ISSUED FOR PCN #39 - CO#024
35	2025.10.20	ISSUED FOR PCN #40R1
36	2025.10.30	ISSUED FOR PCN#041
37	2025.10.23	ISSUED FOR PCN #42
38	2025.11.21	ISSUED FOR PCN#021/R1 - CO12 CD#006
39	2025.11.14	ISSUED FOR PCN#043
40	2025.11.26	ISSUED FOR PCN#043R1
41	2025.12.03	ISSUED FOR PCN#044 - CO#026
42	2026.02.04	ISSUED FOR RECORD SET UP TO CO#27

Reproduction of drawings and related documents in whole or in part is forbidden without written permission of the Ventin Group.

All dimensions and measurements must be checked and verified by the General Contractor

NOTES:

KEY PLAN:

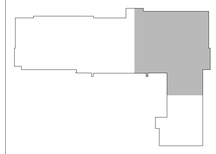

Near North District School Board

CLIENT:
NEAR NORTH DISTRICT SCHOOL BOARD
NNDSB Tender # 2023-015

PROJECT:
NEW PARRY SOUND K-12 SCHOOL & CHILDCARE

PARRY SOUND HIGH SCHOOL SITE

111 ISABELLA STREET
PARRY SOUND, ONTARIO

ORIGINAL PAGE SIZE ARCH E1 - 30" x 42"

KEY TO DETAIL LOCATION:
(A) A - DETAIL NO.
(B) B - DETAIL NO. ORIGIN

+VG ARCHITECTS
THE VENTIN GROUP LTD

CN

FIRST FLOOR - WALL FINISHES PLAN - NORTH WING

ID2.1B

DRAWN BY : PS/KH CHECKED BY : EB

Plot Date: Feb 03, 2026 - 5:45pm By: jkelly Filename: K:\1VG-Brantford\Near North DSB Parry Sound School\2211\Drawings\Wd-Current\NN - ID2.1_Level 1 Wall Finish Plan.dwg



1 FIRST FLOOR - WALL FINISHES PLAN - CHILDCARE WING
ID2.1C
0 1 2 5m

REVISIONS

NO.	DATE	PARTICULAR
1	2022.06.06	ISSUED FOR 80% CLASS B COSTING
2	2022.08.18	ISSUED FOR SPA
3	2022.09.22	ISSUED FOR OWNERS REVIEW - 98% SET
4	2022.12.16	ISSUED FOR 2nd SPA SUBMISSION
5	2023.01.31	ISSUED FOR TENDER
6	2023.02.22	ISSUED FOR ADDENDUM 9
7	2023.08.23	ISSUED FOR CONVENIENCE
8	2023.11.20	ISSUED FOR PERMIT COMMENTS
9	2024.01.24	ISSUED FOR SI#03
10	2024.02.15	ISSUED FOR PCN#008
11	2024.03.04	ISSUED FOR PCN#009
12	2024.03.10	ISSUED FOR SI#004
13	2024.05.14	ISSUED FOR SI#006
14	2024.07.22	ISSUED FOR SI#008
15	2024.08.07	ISSUED FOR SI#009
16	2024.10.02	ISSUED FOR PCN#15
17	2025.04.11	ISSUED FOR PCN#019
18	2025.05.01	ISSUED FOR CO#07
19	2025.05.28	ISSUED FOR PCN#20 - CO#010
20	2025.07.31	ISSUED FOR SI#013
21	2025.08.06	ISSUED FOR SI#014
22	2025.08.15	ISSUED FOR PCN#25 - CO#017
23	2025.08.25	ISSUED FOR PCN#27 - CO#021
24	2025.09.02	ISSUED FOR PCN#29
25	2025.09.02	ISSUED FOR SI#20 - CO#018
26	2025.09.08	ISSUED FOR PCN#31
27	2025.09.09	ISSUED FOR PCN#32 - CO#022
28	2025.09.10	ISSUED FOR PCN#33
29	2025.09.11	ISSUED FOR SI#022
30	2025.09.15	ISSUED FOR SI#023
31	2025.09.16	ISSUED FOR PCN #35 - CO#023
32	2025.09.30	ISSUED FOR PCN #37 - CO#029
33	2025.09.30	ISSUED FOR PCN #38 - CO#025
34	2025.10.06	ISSUED FOR PCN #39 - CO#024
35	2025.10.20	ISSUED FOR PCN #4081
36	2025.10.30	ISSUED FOR PCN#041
37	2025.10.23	ISSUED FOR PCN #42
38	2025.11.21	ISSUED FOR PCN#021/R1 - CO12 CD#006
39	2025.11.14	ISSUED FOR PCN#043
40	2025.11.26	ISSUED FOR PCN#043R1
41	2025.12.03	ISSUED FOR PCN#044 - CO#026
42	2026.02.04	ISSUED FOR RECORD SET UP TO CO#27

NOTES:

KEY PLAN:



All dimensions and measurements must be checked and verified by the General Contractor

Reproduction of drawings and related documents in whole or in part is forbidden without written permission of the Ventin Group.

Plot Date: Feb 03, 2026 - 5:45pm By: jkelly
Filename: K:\VG-Brantford\Near North DSB Parry Sound School\2211\Drawings\Wd Current\NN - ID2.1_Level 1 Wall Finish Plan.dwg

Near North District School Board

CLIENT:
NEAR NORTH DISTRICT SCHOOL BOARD
NNDSB Tender # 2023-015

PROJECT:
NEW PARRY SOUND K-12 SCHOOL & CHILDCARE

PARRY SOUND HIGH SCHOOL SITE

111 ISABELLA STREET
PARRY SOUND, ONTARIO


ORIGINAL PAGE SIZE ARCH E1 - 30" x 42"
KEY TO DETAIL LOCATION:
A - DETAIL NO.
B - DETAIL NO. ORIGIN

+VG ARCHITECTS
THE VENTIN GROUP LTD

FIRST FLOOR - WALL FINISHES PLAN - CHILDCARE WING

ID2.1C

DRAWN BY : PS/KH CHECKED BY : EB

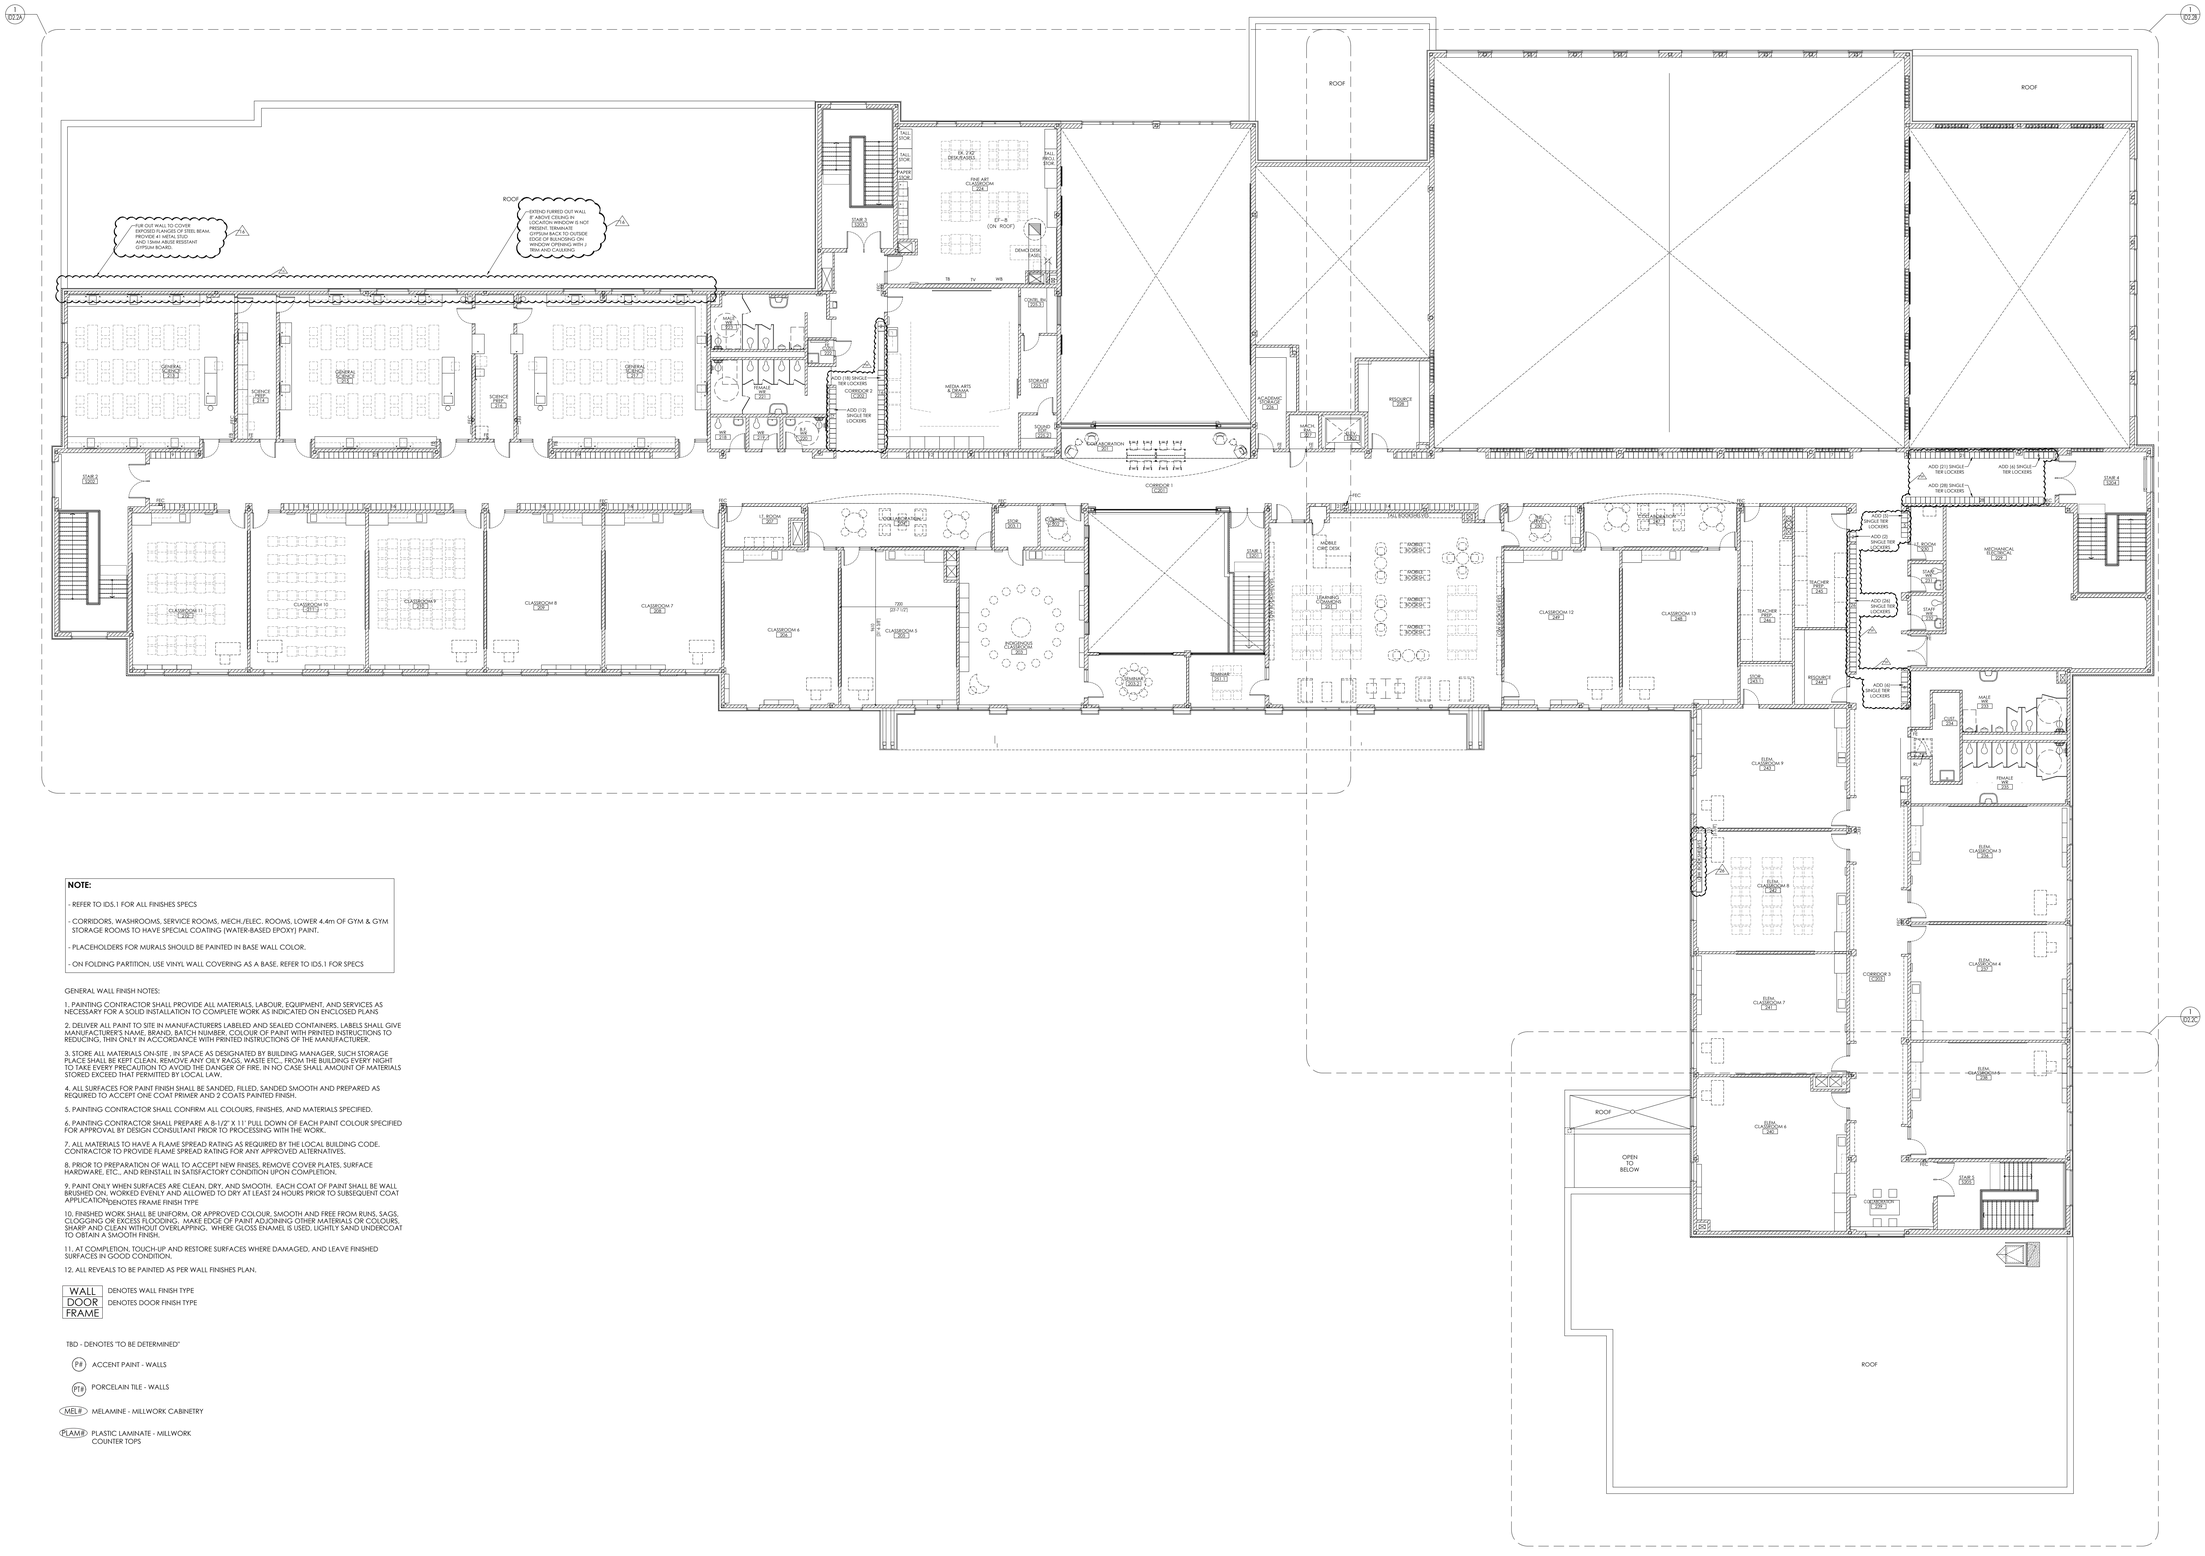

NOTE:

- REFER TO ID5.1 FOR ALL FINISHES SPECS
- CORRIDORS, WASHROOMS, SERVICE ROOMS, MECH./ELEC. ROOMS, LOWER 4.4m OF GYM & GYM STORAGE ROOMS TO HAVE SPECIAL COATING (WATER-BASED EPOXY) PAINT.
- PLACEHOLDERS FOR MURALS SHOULD BE PAINTED IN BASE WALL COLOR.
- ON FOLDING PARTITION, USE VINYL WALL COVERING AS A BASE. REFER TO ID5.1 FOR SPECS

GENERAL WALL FINISH NOTES:

1. PAINTING CONTRACTOR SHALL PROVIDE ALL MATERIALS, LABOUR, EQUIPMENT, AND SERVICES AS NECESSARY FOR A SOLID INSTALLATION TO COMPLETE WORK AS INDICATED ON ENCLOSED PLANS

2. DELIVER ALL PAINT TO SITE IN MANUFACTURERS LABELED AND SEALED CONTAINERS, LABELS SHALL GIVE MANUFACTURER'S NAME, BRAND, BATCH NUMBER, COLOUR OF PAINT WITH PRINTED INSTRUCTIONS TO REDUCING, THIN ONLY IN ACCORDANCE WITH PRINTED INSTRUCTIONS OF THE MANUFACTURER

3. STORE ALL MATERIALS ON-SITE , IN SPACE AS DESIGNATED BY BUILDING MANAGER. SUCH STORAGE PLACE SHALL BE KEPT CLEAN. REMOVE ANY OILY RAGS, WASTE ETC., FROM THE BUILDING EVERY NIGHT TO TAKE EVERY PRECAUTION TO AVOID THE DANGER OF FIRE; IN NO CASE SHALL AMOUNT OF MATERIALS STORED EXCEED THAT PERMITTED BY LOCAL LAW.

4. ALL SURFACES FOR PAINT FINISH SHALL BE SANDED, FILLED, SANDED SMOOTH AND PREPARED AS REQUIRED TO ACCEPT ONE COAT PRIMER AND 2 COATS PAINTED FINISH.

5. PAINTING CONTRACTOR SHALL CONFIRM ALL COLOURS, FINISHES, AND MATERIALS SPECIFIED.

6. PAINTING CONTRACTOR SHALL PREPARE A 8-1/2" X 11" PULL DOWN OF EACH PAINT COLOUR SPECIFIED FOR APPROVAL BY DESIGN CONSULTANT PRIOR TO PROCESSING WITH THE WORK.

7. ALL MATERIALS TO HAVE A FLAME SPREAD RATING AS REQUIRED BY THE LOCAL BUILDING CODE. CONTRACTOR TO PROVIDE FLAME SPREAD RATING FOR ANY APPROVED ALTERNATIVES.

8. PRIOR TO PREPARATION OF WALL TO ACCEPT NEW FINISES, REMOVE COVER PLATES, SURFACE HARDWARE, ETC., AND REINSTALL IN SATISFACTORY CONDITION UPON COMPLETION.

9. PAINT ONLY WHEN SURFACES ARE CLEAN, DRY, AND SMOOTH. EACH COAT OF PAINT SHALL BE WELL BRUSHED ON, WORKED EVENLY AND ALLOWED TO DRY AT LEAST 24 HOURS PRIOR TO SUBSEQUENT COAT APPLICATION[1]DENOTES FRAME FINISH TYPE

10. FINISHED WORK SHALL BE UNIFORM, OR APPROVED COLOUR, SMOOTH AND FREE FROM RUNS, SAGS, CLOGGING OR EXCESS FLOODING. MAKE EDGE OF PAINT ADJOINING OTHER MATERIALS OR COLOURS, SHARP AND CLEAN WITHOUT OVERLAPPING. WHERE GLOSS ENAMEL IS USED, LIGHTLY SAND UNDERCOAT TO OBTAIN A SMOOTH FINISH.

11. AT COMPLETION, TOUCH-UP AND RESTORE SURFACES WHERE DAMAGED, AND LEAVE FINISHED SURFACES IN GOOD CONDITION.

12. ALL REVEALS TO BE PAINTED AS PER WALL FINISHES PLAN.

WALL — DENOTES WALL FINISH TYPE
DOOR — DENOTES DOOR FINISH TYPE
FRAME

TBD - DENOTES 'TO BE DETERMINED'

(P#) ACCENT PAINT - WALLS

(PT#) PORCELAIN TILE - WALLS

(MEL#) MELAMINE - MILLWORK CABINETRY


(PLAM#) PLASTIC LAMINATE - MILLWORK COUNTER TOPS

REVISIONS

NO.	DATE	PARTICULAR
1	2022.06.06	ISSUED FOR 80% CLASS B COSTING
2	2022.08.18	ISSUED FOR SPA
3	2022.09.22	ISSUED FOR OWNERS REVIEW - 98% SET
4	2022.12.16	ISSUED FOR 2nd SPA SUBMISSION
5	2023.01.31	ISSUED FOR TENDER
6	2023.02.22	ISSUED FOR ADDENDUM 9
7	2023.08.23	ISSUED FOR CONVENIENCE
8	2023.11.20	ISSUED FOR PERMIT COMMENTS
9	2024.01.24	ISSUED FOR SI#03
10	2024.02.15	ISSUED FOR PCN#008
11	2024.03.04	ISSUED FOR PCN#009
12	2024.03.10	ISSUED FOR SI#004
13	2024.05.14	ISSUED FOR SI#006
14	2024.07.22	ISSUED FOR SI#008
15	2024.08.07	ISSUED FOR SI#009
16	2024.10.02	ISSUED FOR PCN#15
17	2025.04.11	ISSUED FOR PCN#019
18	2025.05.01	ISSUED FOR CO#07
19	2025.05.28	ISSUED FOR PCN#20 - CO#010
20	2025.07.31	ISSUED FOR SI#013
21	2025.08.06	ISSUED FOR SI#014
22	2025.08.15	ISSUED FOR PCN#25 - CO#017
23	2025.08.25	ISSUED FOR PCN#27 - CO#021
24	2025.09.02	ISSUED FOR PCN#29
25	2025.09.02	ISSUED FOR SI#20 - CO#018
26	2025.09.08	ISSUED FOR PCN#31
27	2025.09.09	ISSUED FOR PCN#32 - CO#022
28	2025.09.10	ISSUED FOR PCN#33
29	2025.09.11	ISSUED FOR SI#022
30	2025.09.15	ISSUED FOR SI#023
31	2025.09.16	ISSUED FOR PCN #35 - CO#023
32	2025.09.30	ISSUED FOR PCN #37 - CO#029
33	2025.09.30	ISSUED FOR PCN #38 - CO#025
34	2025.10.06	ISSUED FOR PCN #39 - CO#024
35	2025.10.20	ISSUED FOR PCN #40R1
36	2025.10.30	ISSUED FOR PCN#041
37	2025.10.23	ISSUED FOR PCN #42
38	2025.11.21	ISSUED FOR PCN#021/R1 - CO12 CD#006
39	2025.11.14	ISSUED FOR PCN#043
40	2025.11.26	ISSUED FOR PCN#043R1
41	2025.12.03	ISSUED FOR PCN#044 - CO#026
42	2026.02.04	ISSUED FOR RECORD SET UP TO CO#27

NOTES:

KEY PLAN:

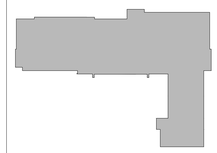

All dimensions and measurements must be checked and verified by the General Contractor

Reproduction of drawings and related documents in whole or in part is forbidden without written permission of the VentinGroup.

Plot Date: Feb 03, 2026 - 5:46pm By jkelly
Filename: K:\1VG-Brantford\Near North DSB Parry Sound School\2211\1Ddrawings\WG-Current\NN - ID2.2 Level 2 Wall Finish Plan.dwg

CLIENT:
NEAR NORTH DISTRICT SCHOOL BOARD
NNDSB Tender # 2023-015

PROJECT:
NEW PARRY SOUND K-12 SCHOOL & CHILDCARE

PARRY SOUND HIGH SCHOOL SITE

111 ISABELLA STREET
PARRY SOUND, ONTARIO


ORIGINAL PAGE SIZE ARCH E1 - 30" x 42"
KEY TO DETAIL LOCATION:
(A) A - DETAIL NO.
(B) B - DETAIL NO. ORIGIN

+VG ARCHITECTS
THE VENTIN GROUP LTD

SECOND FLOOR - OVERALL WALL FINISHES PLAN & LEGEND

ID2.2

DRAWN BY : PS/KH CHECKED BY : EB

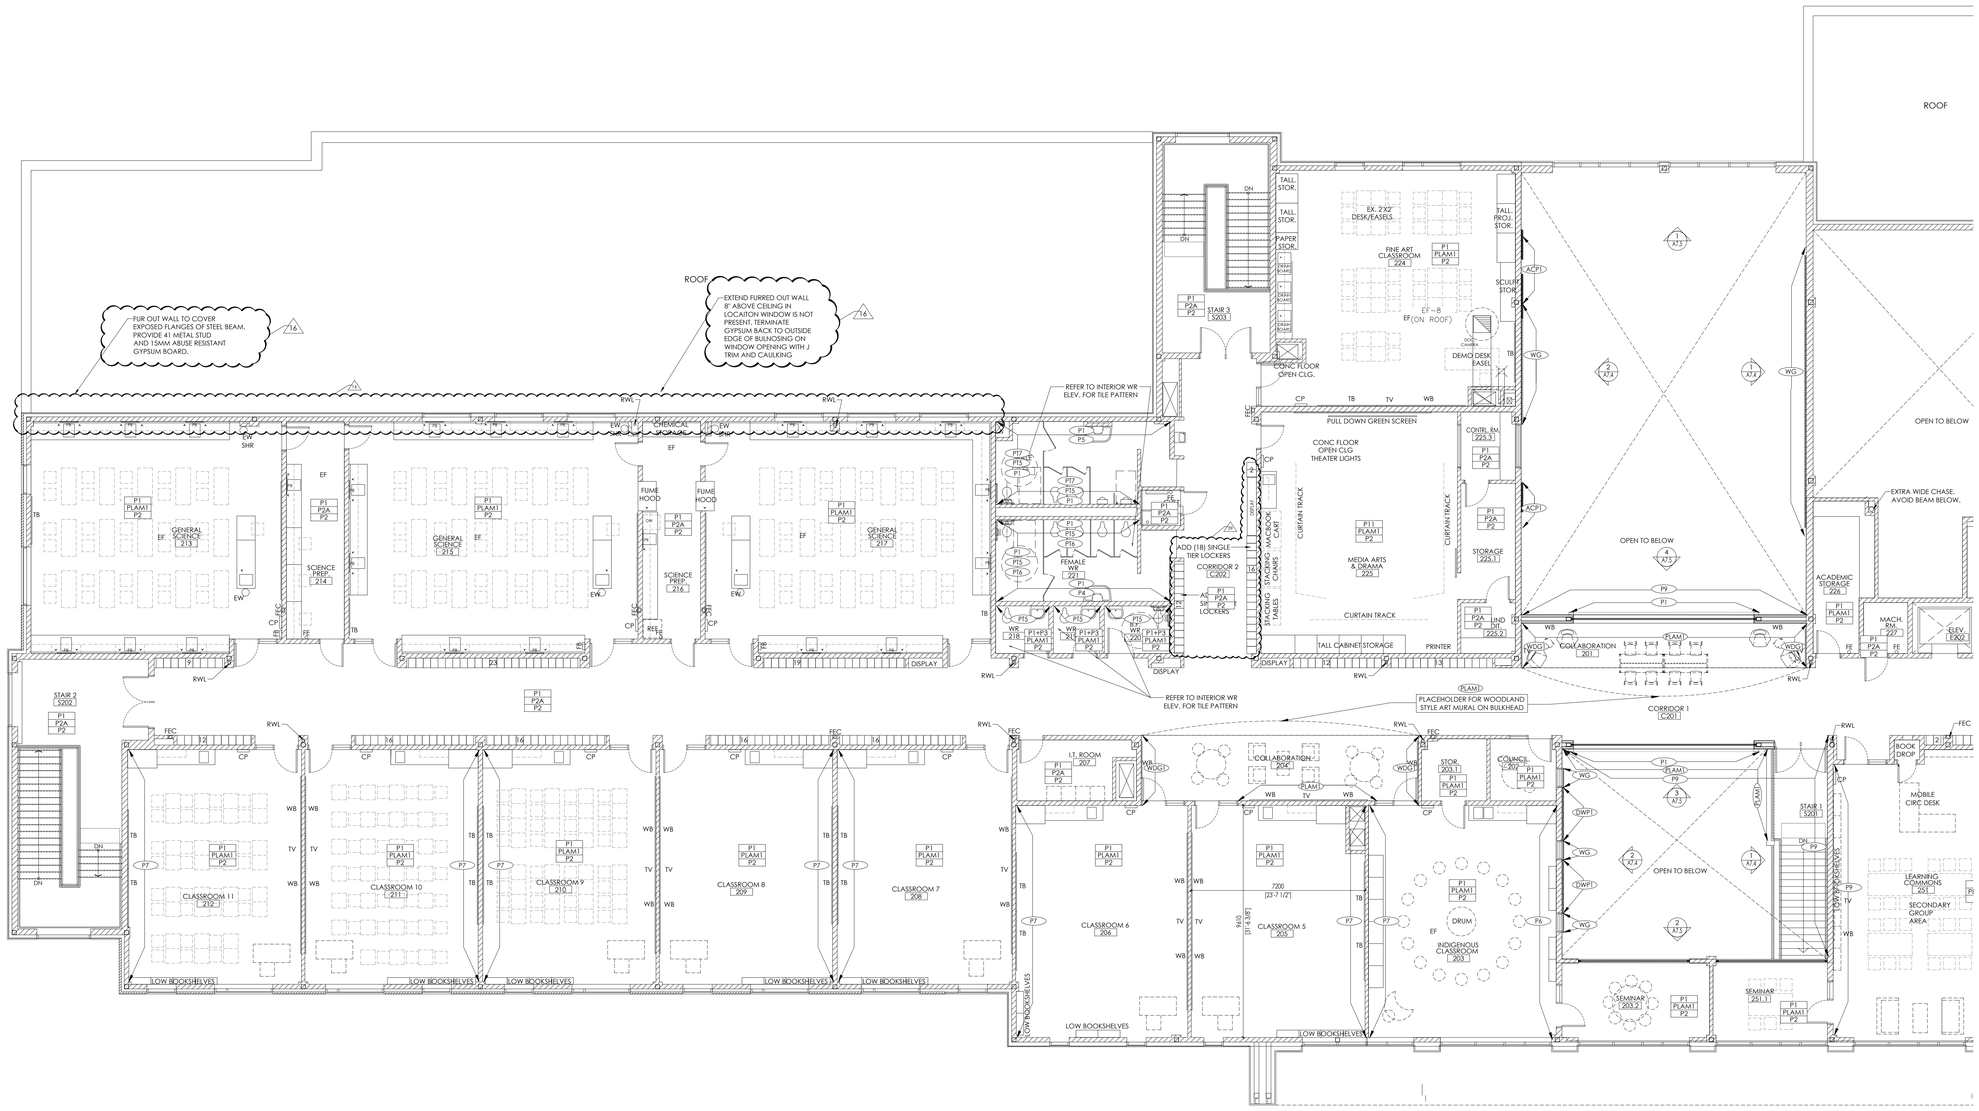

1 / ID2.2A SECOND FLOOR - WALL FINISH PLAN - SOUTH WING


0 1 2 5m

REVISIONS

NO.	DATE	PARTICULAR
1	2022.06.06	ISSUED FOR 80% CLASS B COSTING
2	2022.08.18	ISSUED FOR SPA
3	2022.09.22	ISSUED FOR OWNERS REVIEW - 98% SET
4	2022.12.16	ISSUED FOR 2nd SPA SUBMISSION
5	2023.01.31	ISSUED FOR TENDER
6	2023.02.22	ISSUED FOR ADDENDUM 9
7	2023.08.23	ISSUED FOR CONVENIENCE
8	2023.11.20	ISSUED FOR PERMIT COMMENTS
9	2024.01.24	ISSUED FOR SI#03
10	2024.02.15	ISSUED FOR PCN#008
11	2024.03.04	ISSUED FOR PCN#009
12	2024.03.10	ISSUED FOR SI#004
13	2024.05.14	ISSUED FOR SI#006
14	2024.07.22	ISSUED FOR SI#008
15	2024.08.07	ISSUED FOR SI#009
16	2024.10.02	ISSUED FOR PCN#15
17	2025.04.11	ISSUED FOR PCN#019
18	2025.05.01	ISSUED FOR CO#07
19	2025.05.28	ISSUED FOR PCN#20 - CO#010
20	2025.07.31	ISSUED FOR SI#013
21	2025.08.06	ISSUED FOR SI#014
22	2025.08.15	ISSUED FOR PCN#25 - CO#017
23	2025.08.25	ISSUED FOR PCN#27 - CO#021
24	2025.09.02	ISSUED FOR PCN#29
25	2025.09.02	ISSUED FOR SI#20 - CO#018
26	2025.09.08	ISSUED FOR PCN#31
27	2025.09.09	ISSUED FOR PCN#32 - CO#022
28	2025.09.10	ISSUED FOR SI#33
29	2025.09.11	ISSUED FOR SI#022
30	2025.09.15	ISSUED FOR SI#023
31	2025.09.16	ISSUED FOR PCN #35 - CO#023
32	2025.09.30	ISSUED FOR PCN #37 - CO#029
33	2025.09.30	ISSUED FOR PCN #38 - CO#025
34	2025.10.06	ISSUED FOR PCN #39 - CO#024
35	2025.10.20	ISSUED FOR PCN #4081
36	2025.10.30	ISSUED FOR PCN#041
37	2025.10.23	ISSUED FOR PCN #42
38	2025.11.21	ISSUED FOR PCN#021/R1 - CO12 CD#006
39	2025.11.14	ISSUED FOR PCN#043
40	2025.11.26	ISSUED FOR PCN#043R1
41	2025.12.03	ISSUED FOR PCN#044 - CO#026
42	2026.02.04	ISSUED FOR RECORD SET UP TO CO#27

NOTES:

KEY PLAN:

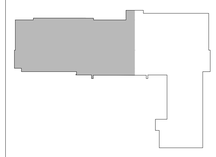

Reproduction of drawings and related documents in whole or in part is forbidden without written permission of the Ventin Group.

All dimensions and measurements must be checked and verified by the General Contractor

Near North District School Board

CLIENT:
NEAR NORTH DISTRICT SCHOOL BOARD
NNDSB Tender # 2023-015

PROJECT:
NEW PARRY SOUND K-12 SCHOOL & CHILDCARE

PARRY SOUND HIGH SCHOOL SITE

111 ISABELLA STREET
PARRY SOUND, ONTARIO

ORIGINAL PAGE SIZE ARCH E1 - 30" x 42"

KEY TO DETAIL LOCATION:
A / B A - DETAIL NO.
B - DETAIL NO. ORIGIN


+VG ARCHITECTS
THE VENTIN GROUP LTD

SECOND FLOOR - WALL FINISHES PLAN - SOUTH WING

ID2.2A

DRAWN BY : PS/KH CHECKED BY : EB

Plot Date: Feb 03, 2026 - 5:46pm By: jkelly Filename: K:\1VG-Brantford\Near North DSB Parry Sound School\2111 Drawings\Wd-Current\NN - ID2.2_Level 2 Wall Finish Plan.dwg

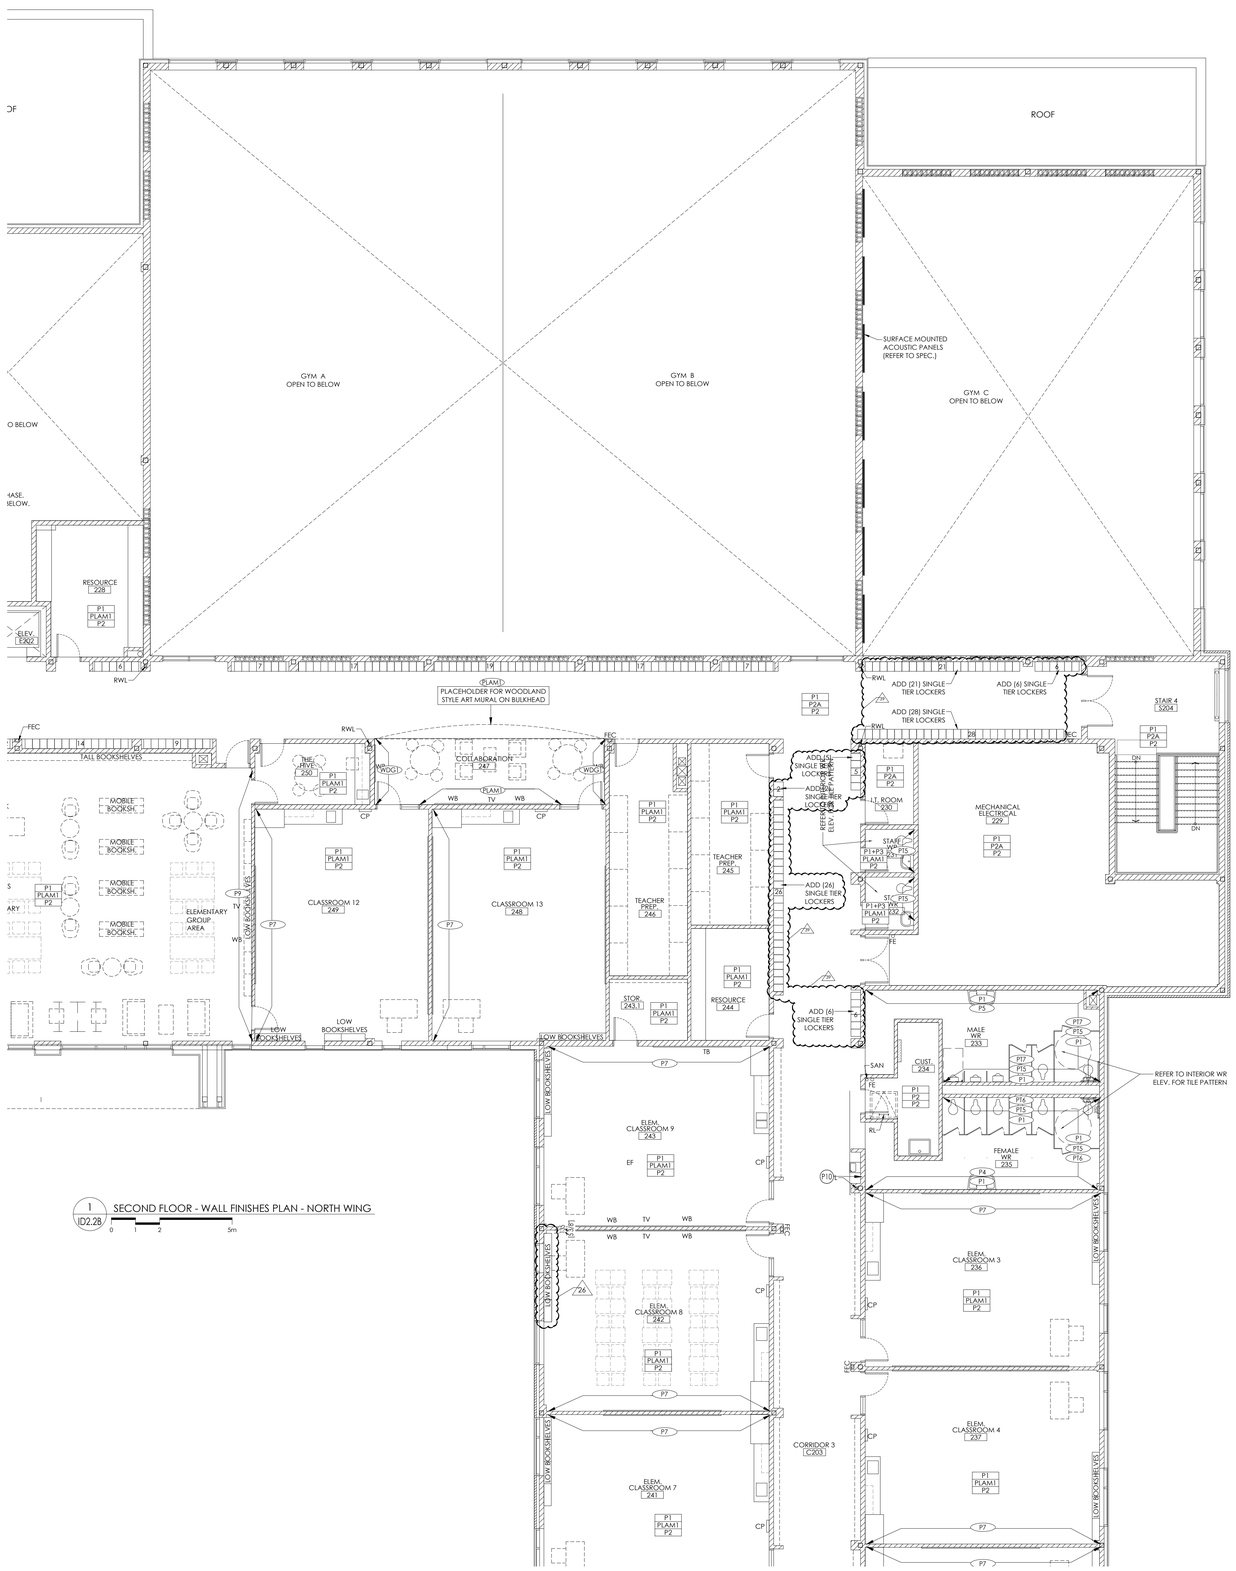

1 ID2.2B SECOND FLOOR - WALL FINISHES PLAN - NORTH WING

0 1 2 5m

REVISIONS


NO.	DATE	PARTICULAR
1	2022.06.06	ISSUED FOR 80% CLASS B COSTING
2	2022.08.18	ISSUED FOR SPA
3	2022.09.22	ISSUED FOR OWNERS REVIEW - 98% SET
4	2022.12.16	ISSUED FOR 2nd SPA SUBMISSION
5	2023.01.31	ISSUED FOR TENDER
6	2023.02.22	ISSUED FOR ADDENDUM 9
7	2023.08.23	ISSUED FOR CONVENIENCE
8	2023.11.20	ISSUED FOR PERMIT COMMENTS
9	2024.01.24	ISSUED FOR SI#03
10	2024.02.15	ISSUED FOR PCN#008
11	2024.03.04	ISSUED FOR PCN#009
12	2024.03.10	ISSUED FOR SI#004
13	2024.05.14	ISSUED FOR SI#006
14	2024.07.22	ISSUED FOR SI#008
15	2024.08.07	ISSUED FOR SI#009
16	2024.10.02	ISSUED FOR PCN#15
17	2025.04.11	ISSUED FOR PCN#019
18	2025.05.01	ISSUED FOR CO#07
19	2025.05.28	ISSUED FOR PCN#20 - CO#010
20	2025.07.31	ISSUED FOR SI#013
21	2025.08.06	ISSUED FOR SI#014
22	2025.08.15	ISSUED FOR PCN#25 - CO#017
23	2025.08.25	ISSUED FOR PCN#27 - CO#021
24	2025.09.02	ISSUED FOR PCN#29
25	2025.09.02	ISSUED FOR SI#20 - CO#018
26	2025.09.08	ISSUED FOR PCN#31
27	2025.09.09	ISSUED FOR PCN#32 - CO#022
28	2025.09.10	ISSUED FOR PCN#33
29	2025.09.11	ISSUED FOR SI#022
30	2025.09.15	ISSUED FOR SI#023
31	2025.09.16	ISSUED FOR PCN #35 - CO#023
32	2025.09.30	ISSUED FOR PCN #37 - CO#029
33	2025.09.30	ISSUED FOR PCN #38 - CO#025
34	2025.10.06	ISSUED FOR PCN #39 - CO#024
35	2025.10.20	ISSUED FOR PCN #40R1
36	2025.10.30	ISSUED FOR PCN#041
37	2025.10.23	ISSUED FOR PCN #42
38	2025.11.21	ISSUED FOR PCN#021/R1 - CO12 CD#006
39	2025.11.14	ISSUED FOR PCN#043
40	2025.11.26	ISSUED FOR PCN#043R1
41	2025.12.03	ISSUED FOR PCN#044 - CO#026
42	2026.02.04	ISSUED FOR RECORD SET UP TO CO#27

All dimensions and measurements must be checked and verified by the General Contractor

Reproduction of drawings and related documents in whole or in part is forbidden without written permission of the Ventin Group.

NOTES:

KEY PLAN:

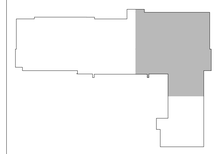

Near North District School Board

CLIENT:
NEAR NORTH DISTRICT SCHOOL BOARD
NNDSB Tender # 2023-015

PROJECT:
NEW PARRY SOUND K-12 SCHOOL & CHILDCARE

PARRY SOUND HIGH SCHOOL SITE

111 ISABELLA STREET
PARRY SOUND, ONTARIO

ORIGINAL PAGE SIZE ARCH E1 - 30" x 42"
KEY TO DETAIL LOCATION:
A A - DETAIL NO.
B B - DETAIL NO. ORIGIN


+VG ARCHITECTS
THE VENTIN GROUP LTD

SECOND FLOOR - WALL FINISHES PLAN - NORTH WING

ID2.2B

DRAWN BY : PS/KH CHECKED BY : EB

Plot Date: Feb 03, 2026 - 5:46pm By: jkelly Filename: K:\1VG-Brantford\Near North DSB Parry Sound School\2111\Drawings\Wall Content\NN - ID2.2_Level 2 Wall Finish Plan.dwg

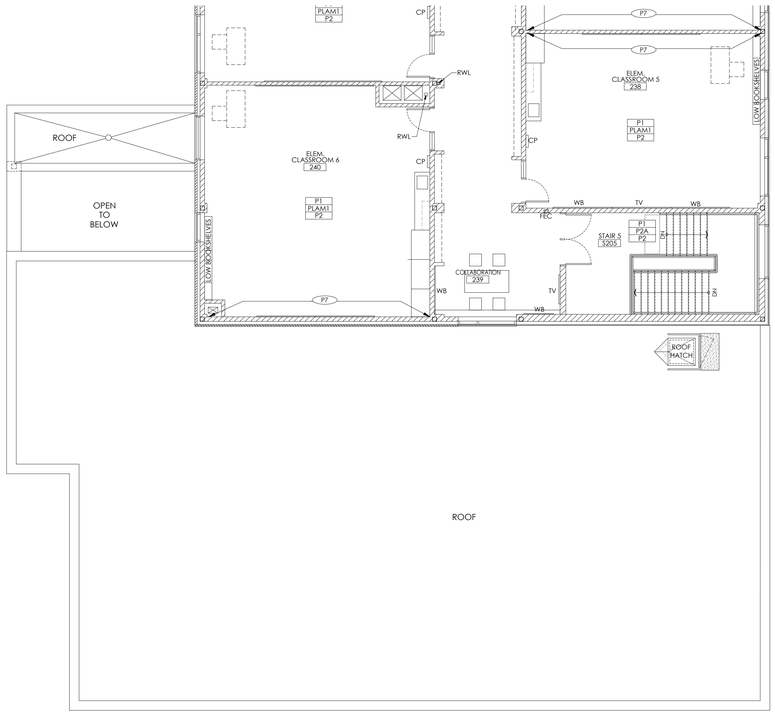

1 / ID2.2C SECOND FLOOR - WALL FINISHES PLAN - CHILDCARE WING

0 1 2 5m

REVISIONS

NO.	DATE	PARTICULAR
1	2022.06.06	ISSUED FOR 80% CLASS B COSTING
2	2022.08.18	ISSUED FOR SPA
3	2022.09.22	ISSUED FOR OWNERS REVIEW - 98% SET
4	2022.12.16	ISSUED FOR 2nd SPA SUBMISSION
5	2023.01.31	ISSUED FOR TENDER
6	2023.02.22	ISSUED FOR ADDENDUM 9
7	2023.08.23	ISSUED FOR CONVENIENCE
8	2023.11.20	ISSUED FOR PERMIT COMMENTS
9	2024.01.24	ISSUED FOR SI#03
10	2024.02.15	ISSUED FOR PCN#008
11	2024.03.04	ISSUED FOR PCN#009
12	2024.03.10	ISSUED FOR SI#004
13	2024.05.14	ISSUED FOR SI#006
14	2024.07.22	ISSUED FOR SI#008
15	2024.08.07	ISSUED FOR SI#009
16	2024.10.02	ISSUED FOR PCN#15
17	2025.04.11	ISSUED FOR PCN#019
18	2025.05.01	ISSUED FOR CO#07
19	2025.05.28	ISSUED FOR PCN#20 - CO#010
20	2025.07.31	ISSUED FOR SI#013
21	2025.08.06	ISSUED FOR SI#014
22	2025.08.15	ISSUED FOR PCN#25 - CO#017
23	2025.08.25	ISSUED FOR PCN#27 - CO#021
24	2025.09.02	ISSUED FOR PCN#29
25	2025.09.02	ISSUED FOR SI#20 - CO#018
26	2025.09.08	ISSUED FOR PCN#31
27	2025.09.09	ISSUED FOR PCN#32 - CO#022
28	2025.09.10	ISSUED FOR PCN#33
29	2025.09.11	ISSUED FOR SI#022
30	2025.09.15	ISSUED FOR SI#023
31	2025.09.16	ISSUED FOR PCN #35 - CO#023
32	2025.09.30	ISSUED FOR PCN #37 - CO#029
33	2025.09.30	ISSUED FOR PCN #38 - CO#025
34	2025.10.06	ISSUED FOR PCN #39 - CO#024
35	2025.10.20	ISSUED FOR PCN #40R1
36	2025.10.30	ISSUED FOR PCN#041
37	2025.10.23	ISSUED FOR PCN #42
38	2025.11.21	ISSUED FOR PCN#021/R1 - CO12 CD#006
39	2025.11.14	ISSUED FOR PCN#043
40	2025.11.26	ISSUED FOR PCN#043R1
41	2025.12.03	ISSUED FOR PCN#044 - CO#026
42	2026.02.04	ISSUED FOR RECORD SET UP TO CO#27

NOTES:

KEY PLAN:



All dimensions and measurements must be checked and verified by the General Contractor.

Reproduction of drawings and related documents in whole or in part is forbidden without written permission of the Ventin Group.

Near North District School Board

CLIENT:
NEAR NORTH DISTRICT SCHOOL BOARD
NNDSB Tender # 2023-015

PROJECT:
NEW PARRY SOUND K-12 SCHOOL & CHILDCARE

PARRY SOUND HIGH SCHOOL SITE

111 ISABELLA STREET
PARRY SOUND, ONTARIO

ORIGINAL PAGE SIZE ARCH E1 - 30" x 42"
KEY TO DETAIL LOCATION:
A - DETAIL NO.
B - DETAIL NO. ORIGIN

+VG ARCHITECTS
THE VENTIN GROUP LTD

CN

SECOND FLOOR - WALL FINISHES PLAN - CHILDCARE WNG

ID2.2C

DRAWN BY : PS/KH CHECKED BY : EB

Plot Date: Feb 03, 2026 - 5:46pm By jkelly Filename: K:\1VG-Brantford\Near North DSB Parry Sound School\2211\Drawings\Wd-Current\NN - ID2.2_Level 2 Wall Finish Plan.dwg



1 ID4.1 FIRST FLOOR - OVERALL MILLWORK PLAN & LEGEND
0 10 20 50mm

1 ID4.1A

1 ID4.1B

1 ID4.1C

AT CULINARY ART FOOD LAB, SERVERY, BAKING ROOM FOR ALL THE FOOD SERVICE EQUIPMENT REFER TO FS DRAWINGS.

FOR TECH ROOM EQUIPMENT DISCONNECTION /RELOCATION /REINSTALLATION FROM EXISTING SCHOOL IS IN CONTRACT

GENERAL MILLWORK NOTES:

1. ALL CONTRACTORS SHALL CONFIRM ALL COLOURS, FINISHES, HARDWARE AND MATERIALS REQUIRED TO PERFORM THE WORK SPECIFIED.
2. PRIOR TO FABRICATION OF MILLWORK THE CONTRACTOR MUST SUBMIT SHOP DRAWINGS AND STAIN SAMPLES FOR APPROVAL BY DESIGN CONSULTANT.
3. LOCATION OF SEAMS ON WORK SURFACES SHALL BE APPROVED BY DESIGNER.
4. WHERE MELAMINE COMPOSITE PANEL CONSTRUCTION IS USED, FINISH ALL EDGES WITH 3mm PVC EDGING TO MATCH INCLUDING WOOD GRAIN.
5. MILLWORK CONTRACTOR SHALL CO-ORDINATE INSTALLATION OF MILLWORK THROUGH THE GENERAL CONTRACTOR TO ENSURE THAT ALL REQUIRED BLOCKING IS PROVIDED IN DESIGNATED WALLS TO ACCOMMODATE THE LIVE WEIGHT REQUIRED OF ALL MILLWORK COMPONENTS AND EQUIPMENT.
6. ALL MILLWORK TO BE CONSTRUCTED TO SPECIFICATIONS AS PER THE LATEST EDITION OF THE "ARCHITECTURAL WOODWORK MANUFACTURER'S ASSOCIATION OF CANADA (AWMAC).

MILLWORK NOTES:

COUNTERTOPS:

- POSTFORMED PLAM ON 19mm PLYWD. SUBSTRATE. CAULK ALL PERIMETERS OF COUNTER WHERE THERE IS NO BACK SPLASH
- NON-DRIP EDGE AT SINK LOCATIONS. PROVIDE END/SIDE SPLASH AT ALL END LOCATIONS & BACKSPLASH AS REQUIRED WHERE PERMITS AT COUNTERTOPS THAT CONTAIN SINKS & WHERE SHOWN ON ELEV.'S

CASEWORK:
(PLAM W/ 3mm PVC EDGE WHERE EXP.'D)

- 19mm PLYWD. BACK, BOTTOM, GABLES (INTERMEDIATE & END), TOP(S), SHELVING, DOORS, DRAWER FRONTS, FACEPLATES, KICK PLATES, REMOVABLE PANELS, GUSSET SUPPORTS, SUPPORT CLEATS, BLOCKING, FIXED PANELS, LIGHT VALANCES & ALL OTHER PIECES NOT NOTED WITHIN THIS LEGEND
- 16mm PLYWD. DRAWER BOXES C/W FULL EXTENSION SLIDES
- PROVIDE 2 LAYERS OF 19mm PLYWD. TO COMPOSE SHELF FOR MICROWAVE LOCATIONS

GENERAL:

- PROVIDE ALL CUT-OUTS & ACCESS PANELS IN MILLWORK AS REQ.'D FOR ELEC. & MECH. ACCESS / CONNECTIONS.
- PROVIDE ALL SUPPORT BLOCKING FOR COUNTERTOPS & MILLWORK AS REQ.'D
- COORD. W/ REFLECTED CEILING PLANS FOR BULKHEAD LOCATIONS & DEPTH
- COORD. W/ SPEC.'S FOR HARDWARE
- ALL STEEL SUPPORTING MEMBERS TO BE PTD. TYP.
- FULL EXTENSION DRAWER SLIDES TYP.

HATCH IDENTIFICATION MARKER LEGEND


- MILLWORK IN CONTRACT
- UPPER MILLWORK IN CONTRACT
- LAMINATE WINDOW SILLS - REFER TO WALL SECTIONS FOR WINDOW SILL DETAILS
- ITEMS NOT IN CONTRACT - N/I/C
- ELEVATION REFERENCE
- INTERIOR ELEVATION REFERENCE
- DETAIL REFERENCE

REVISIONS

NO.	DATE	PARTICULAR
1	2022.06.06	ISSUED FOR 80% CLASS B COSTING
2	2022.08.18	ISSUED FOR SPA
3	2022.09.22	ISSUED FOR OWNERS REVIEW - 98% SET
4	2022.12.16	ISSUED FOR 2nd SPA SUBMISSION
5	2023.01.31	ISSUED FOR TENDER
6	2023.02.22	ISSUED FOR ADDENDUM 9
7	2023.08.23	ISSUED FOR CONVENIENCE
8	2023.11.20	ISSUED FOR PERMIT COMMENTS
9	2024.01.24	ISSUED FOR SI#03
10	2024.02.15	ISSUED FOR PCN#008
11	2024.03.04	ISSUED FOR PCN#009
12	2024.03.10	ISSUED FOR SI#004
13	2024.05.14	ISSUED FOR SI#006
14	2024.07.22	ISSUED FOR SI#008
15	2024.08.07	ISSUED FOR SI#009
16	2024.10.02	ISSUED FOR PCN#15
17	2025.04.11	ISSUED FOR PCN#019
18	2025.05.01	ISSUED FOR CO#07
19	2025.05.28	ISSUED FOR PCN#20 - CO#010
20	2025.07.31	ISSUED FOR SI#013
21	2025.08.06	ISSUED FOR SI#014
22	2025.08.15	ISSUED FOR PCN#25 - CO#017
23	2025.08.25	ISSUED FOR PCN#27 - CO#021
24	2025.09.02	ISSUED FOR PCN#29
25	2025.09.02	ISSUED FOR SI#20 - CO#018
26	2025.09.08	ISSUED FOR PCN#31
27	2025.09.09	ISSUED FOR PCN#32 - CO#022
28	2025.09.10	ISSUED FOR PCN#33
29	2025.09.11	ISSUED FOR SI#022
30	2025.09.15	ISSUED FOR SI#023
31	2025.09.16	ISSUED FOR PCN #35 - CO#023
32	2025.09.30	ISSUED FOR PCN #37 - CO#029
33	2025.09.30	ISSUED FOR PCN #38 - CO#025
34	2025.10.06	ISSUED FOR PCN #39 - CO#024
35	2025.10.20	ISSUED FOR PCN #40R1
36	2025.10.30	ISSUED FOR PCN#041
37	2025.10.23	ISSUED FOR PCN #42
38	2025.11.21	ISSUED FOR PCN#021/R1 - CO12 CO#006
39	2025.11.14	ISSUED FOR PCN#043
40	2025.11.26	ISSUED FOR PCN#043R1
41	2025.12.03	ISSUED FOR PCN#044 - CO#026
42	2026.02.04	ISSUED FOR RECORD SET UP TO CO#27

NOTES:

KEY PLAN:

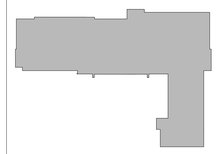

All dimensions and measurements must be checked and verified by the General Contractor

Reproduction of drawings and related documents in whole or in part is forbidden without written permission of the Ventin Group.

Near North District School Board

CLIENT:
NEAR NORTH DISTRICT SCHOOL BOARD
NNDSB Tender # 2023-015

PROJECT:
NEW PARRY SOUND K-12 SCHOOL & CHILDCARE

PARRY SOUND HIGH SCHOOL SITE

111 ISABELLA STREET
PARRY SOUND, ONTARIO

ORIGINAL PAGE SIZE ARCH E1 - 30" x 42"

KEY TO DETAIL LOCATION:
A - DETAIL NO.
B - DETAIL NO. ORIGIN


+VG ARCHITECTS
THE VENTIN GROUP LTD

FIRST FLOOR - OVERALL MILLWORK PLAN, LEGEND & NOTES

ID4.1

DRAWN BY : NK/PS/KH CHECKED BY : EB

Plot Date: Feb 03, 2026 - 5:48pm By: jkelly Filename: K:\TVG-Brantford\Near North DSB-Parry Sound School\21111\Drawings\Wd Current\NN - ID4.1 Level 1 Millwork Plan.dwg

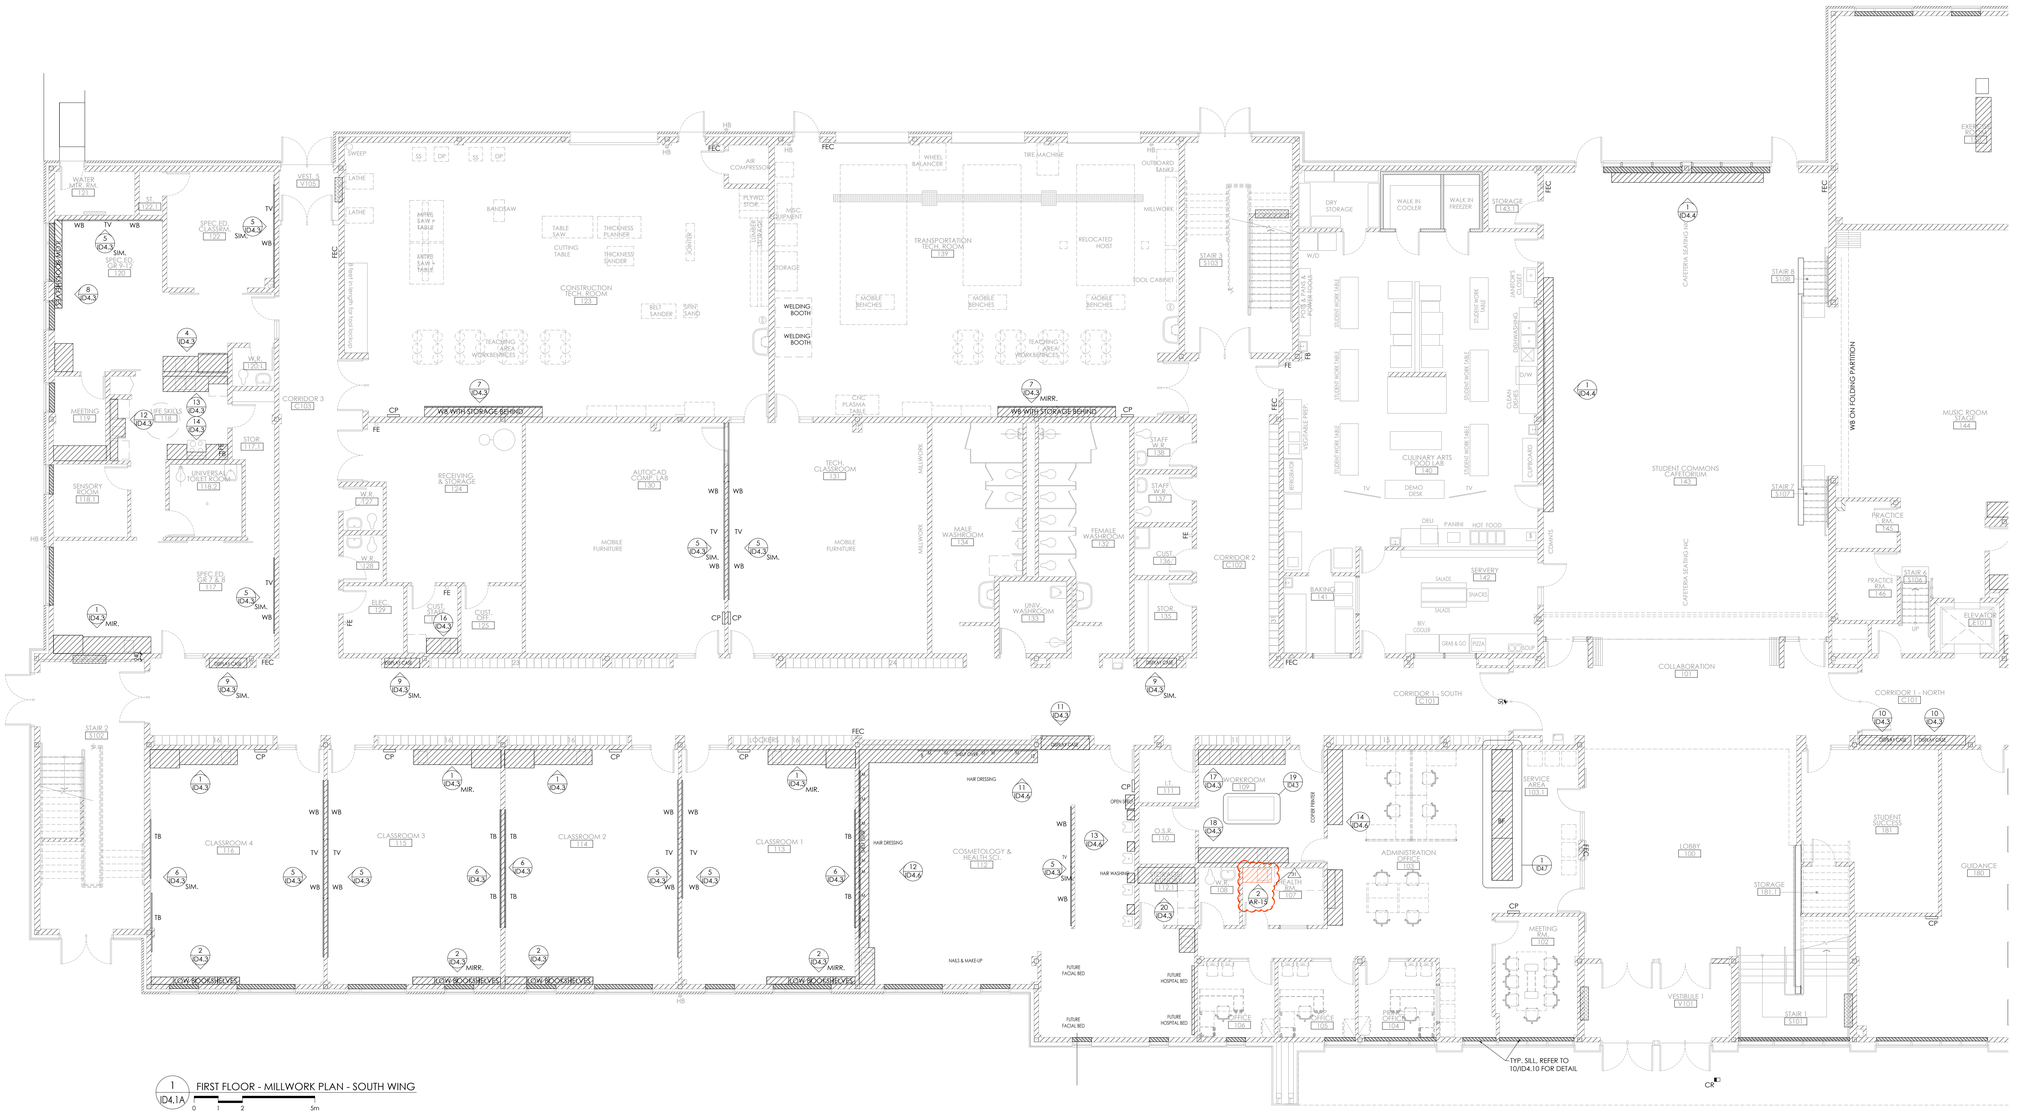

1 ID4.1A FIRST FLOOR - MILLWORK PLAN - SOUTH WING


0 1 2 5m

REVISIONS

NO.	DATE	PARTICULAR
1	2022.06.06	ISSUED FOR 80% CLASS B COSTING
2	2022.08.18	ISSUED FOR SPA
3	2022.09.22	ISSUED FOR OWNERS REVIEW - 98% SET
4	2022.12.16	ISSUED FOR 2nd SPA SUBMISSION
5	2023.01.31	ISSUED FOR TENDER
6	2023.02.22	ISSUED FOR ADDENDUM 9
7	2023.08.23	ISSUED FOR CONVENIENCE
8	2023.11.20	ISSUED FOR PERMIT COMMENTS
9	2024.01.24	ISSUED FOR SI#03
10	2024.02.15	ISSUED FOR PCN#008
11	2024.03.04	ISSUED FOR PCN#009
12	2024.03.10	ISSUED FOR SI#004
13	2024.05.14	ISSUED FOR SI#006
14	2024.07.22	ISSUED FOR SI#008
15	2024.08.07	ISSUED FOR SI#009
16	2024.10.02	ISSUED FOR PCN#15
17	2025.04.11	ISSUED FOR PCN#019
18	2025.05.01	ISSUED FOR CO#07
19	2025.05.28	ISSUED FOR PCN#20 - CO#010
20	2025.07.31	ISSUED FOR SI#013
21	2025.08.06	ISSUED FOR SI#014
22	2025.08.15	ISSUED FOR PCN#25 - CO#017
23	2025.08.25	ISSUED FOR PCN#27 - CO#021
24	2025.09.02	ISSUED FOR PCN#29
25	2025.09.02	ISSUED FOR SI#20 - CO#018
26	2025.09.08	ISSUED FOR PCN#31
27	2025.09.09	ISSUED FOR PCN#32 - CO#022
28	2025.09.10	ISSUED FOR PCN#33
29	2025.09.11	ISSUED FOR SI#022
30	2025.09.15	ISSUED FOR SI#023
31	2025.09.16	ISSUED FOR PCN #35 - CO#023
32	2025.09.30	ISSUED FOR PCN #37 - CO#029
33	2025.09.30	ISSUED FOR PCN #38 - CO#025
34	2025.10.06	ISSUED FOR PCN #39 - CO#024
35	2025.10.20	ISSUED FOR PCN #4081
36	2025.10.30	ISSUED FOR PCN#041
37	2025.10.23	ISSUED FOR PCN #42
38	2025.11.21	ISSUED FOR PCN#021/R1 - CO12 CD#006
39	2025.11.14	ISSUED FOR PCN#043
40	2025.11.26	ISSUED FOR PCN#043R1
41	2025.12.03	ISSUED FOR PCN#044 - CO#026
42	2026.02.04	ISSUED FOR RECORD SET UP TO CO#27

NOTES:

KEY PLAN:

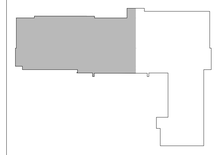

All dimensions and measurements must be checked and verified by the General Contractor

Reproduction of drawings and related documents in whole or in part is forbidden without written permission of the Ventin Group.

CLIENT:
NEAR NORTH DISTRICT SCHOOL BOARD
NNDSB Tender # 2023-015

PROJECT:
NEW PARRY SOUND K-12 SCHOOL & CHILDCARE

PARRY SOUND HIGH SCHOOL SITE

111 ISABELLA STREET
PARRY SOUND, ONTARIO

ORIGINAL PAGE SIZE ARCH E1 - 30" x 42"

KEY TO DETAIL LOCATION:
A - A - DETAIL NO.
B - B - DETAIL NO. ORIGIN


+VG ARCHITECTS
THE VENTIN GROUP LTD

FIRST FLOOR - MILLWORK PLAN - SOUTH WING

ID4.1A

DRAWN BY : NK/PS/KH CHECKED BY : EB

Plot Date: Feb 03, 2026 - 5:48pm By: jkelly Filename: IC:\TVG-Brantford\Near North DSB Parry Sound School-22111\Drawings\Wd-Current\NN - ID4.1_Level 1 Millwork Plan.dwg

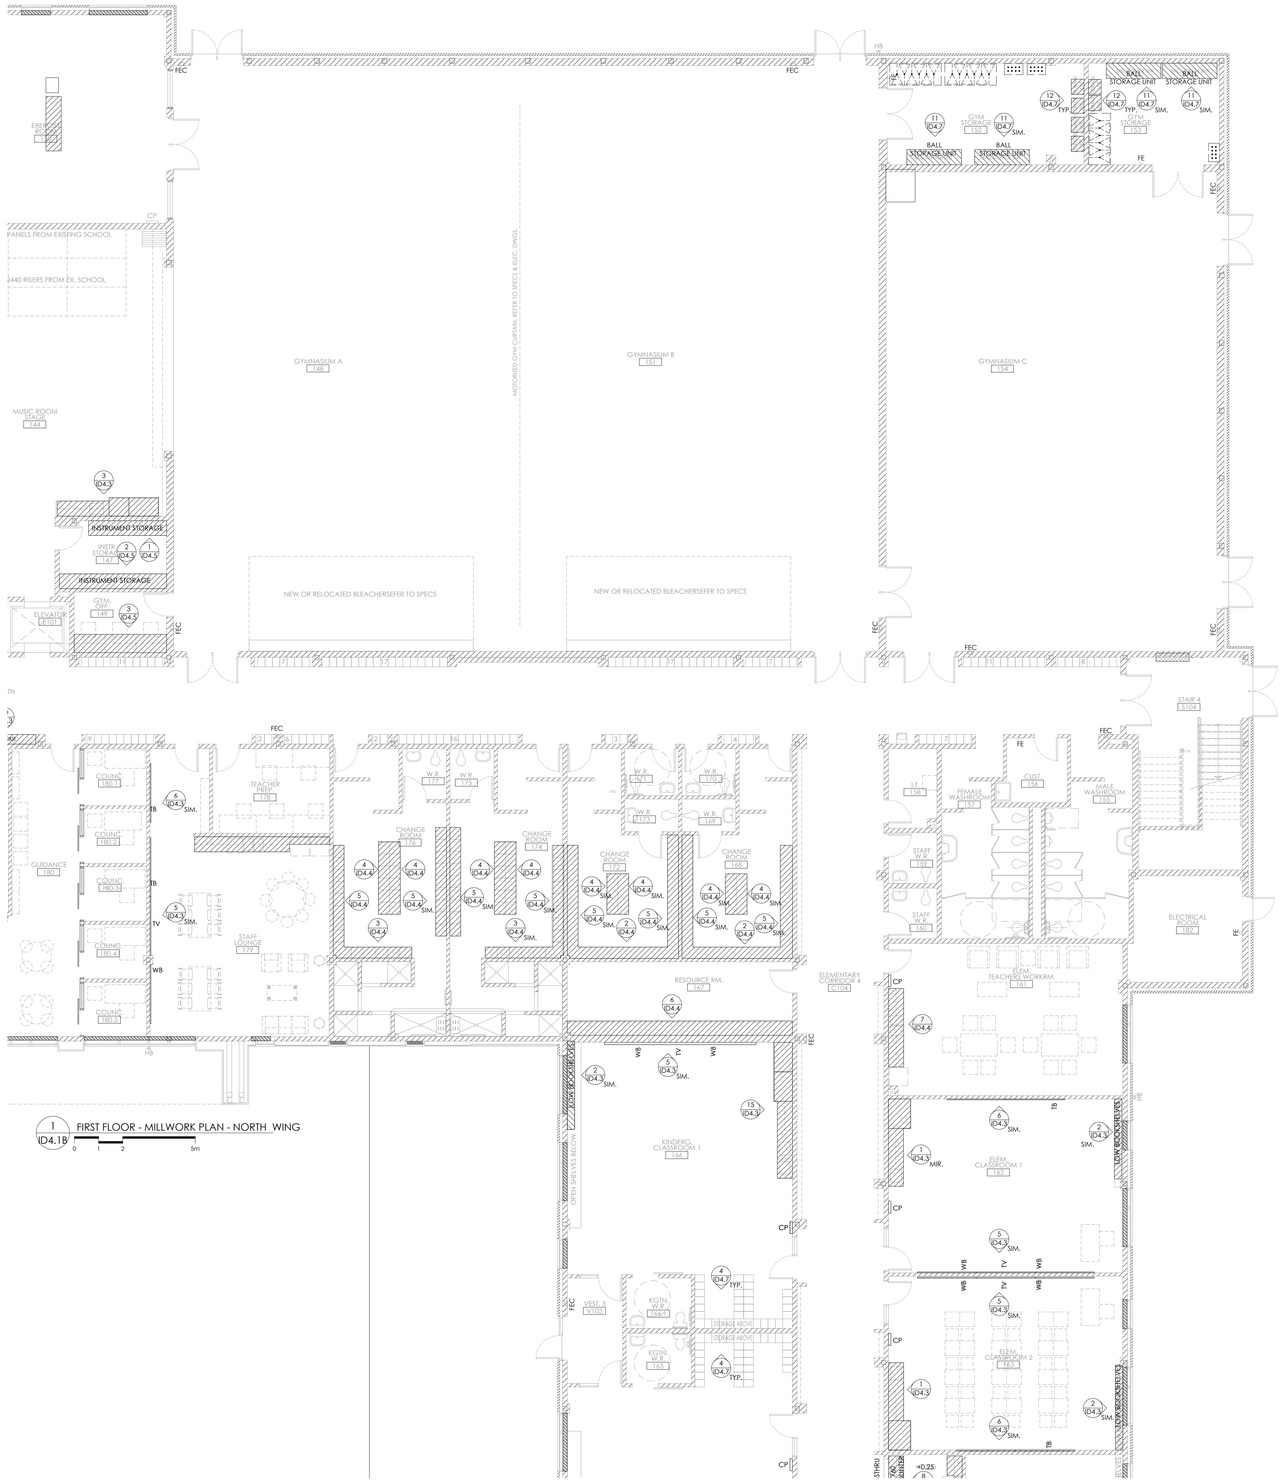


REVISIONS

NO.	DATE	PARTICULAR
1	2022.06.06	ISSUED FOR 80% CLASS B COSTING
2	2022.08.18	ISSUED FOR SPA
3	2022.09.22	ISSUED FOR OWNERS REVIEW - 98% SET
4	2022.12.16	ISSUED FOR 2nd SPA SUBMISSION
5	2023.01.31	ISSUED FOR TENDER
6	2023.02.22	ISSUED FOR ADDENDUM 9
7	2023.08.23	ISSUED FOR CONVENIENCE
8	2023.11.20	ISSUED FOR PERMIT COMMENTS
9	2024.01.24	ISSUED FOR SI#03
10	2024.02.15	ISSUED FOR PCN#008
11	2024.03.04	ISSUED FOR PCN#009
12	2024.03.10	ISSUED FOR SI#004
13	2024.05.14	ISSUED FOR SI#006
14	2024.07.22	ISSUED FOR SI#008
15	2024.08.07	ISSUED FOR SI#009
16	2024.10.02	ISSUED FOR PCN#15
17	2025.04.11	ISSUED FOR PCN#019
18	2025.05.01	ISSUED FOR CO#07
19	2025.05.28	ISSUED FOR PCN#20 - CO#010
20	2025.07.31	ISSUED FOR SI#013
21	2025.08.06	ISSUED FOR SI#014
22	2025.08.15	ISSUED FOR PCN#25 - CO#017
23	2025.08.25	ISSUED FOR PCN#27 - CO#021
24	2025.09.02	ISSUED FOR PCN#29
25	2025.09.02	ISSUED FOR SI#20 - CO#018
26	2025.09.08	ISSUED FOR PCN#31
27	2025.09.09	ISSUED FOR PCN#32 - CO#022
28	2025.09.10	ISSUED FOR PCN#33
29	2025.09.11	ISSUED FOR SI#022
30	2025.09.15	ISSUED FOR SI#023
31	2025.09.16	ISSUED FOR PCN #35 - CO#023
32	2025.09.30	ISSUED FOR PCN #37 - CO#029
33	2025.09.30	ISSUED FOR PCN #38 - CO#025
34	2025.10.06	ISSUED FOR PCN #39 - CO#024
35	2025.10.20	ISSUED FOR PCN #40R1
36	2025.10.30	ISSUED FOR PCN#041
37	2025.10.23	ISSUED FOR PCN #42
38	2025.11.21	ISSUED FOR PCN#021/R1 - CO12 CD#006
39	2025.11.14	ISSUED FOR PCN#043
40	2025.11.26	ISSUED FOR PCN#043R1
41	2025.12.03	ISSUED FOR PCN#044 - CO#026
42	2026.02.04	ISSUED FOR RECORD SET UP TO CO#27

NOTES:

KEY PLAN:

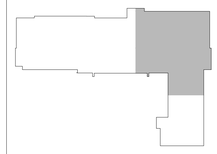

All dimensions and measurements must be checked and verified by the General Contractor

Reproduction of drawings and related documents in whole or in part is forbidden without written permission of the Ventin Group.

Near North District School Board

CLIENT:
NEAR NORTH DISTRICT SCHOOL BOARD
NNDSB Tender # 2023-015

PROJECT:
NEW PARRY SOUND K-12 SCHOOL & CHILDCARE

PARRY SOUND HIGH SCHOOL SITE

111 ISABELLA STREET
PARRY SOUND, ONTARIO

ORIGINAL PAGE SIZE ARCH E1 - 30" x 42"

KEY TO DETAIL LOCATION:
A - DETAIL NO.
B - DETAIL NO. ORIGIN

+VG ARCHITECTS
THE VENTIN GROUP LTD

FIRST FLOOR - MILLWORK PLAN - NORTH WING

ID4.1B

DRAWN BY : NK/PS/KH CHECKED BY : EB

Plot Date: Feb 03, 2026 - 5:49pm By: jkelly Filename: IC:\VG-Brantford\Near North DSB Parry Sound School\2111\Drawings\Wd-Current\NN - ID4.1_Level 1 Millwork Plan.dwg



1 ID4.1C FIRST FLOOR - MILLWORK PLAN - CHILDCARE WING

0 1 2 5m

REVISIONS

NO.	DATE	PARTICULAR
1	2022.06.06	ISSUED FOR 80% CLASS B COSTING
2	2022.08.18	ISSUED FOR SPA
3	2022.09.22	ISSUED FOR OWNERS REVIEW - 98% SET
4	2022.12.16	ISSUED FOR 2nd SPA SUBMISSION
5	2023.01.31	ISSUED FOR TENDER
6	2023.02.22	ISSUED FOR ADDENDUM 9
7	2023.08.23	ISSUED FOR CONVENIENCE
8	2023.11.20	ISSUED FOR PERMIT COMMENTS
9	2024.01.24	ISSUED FOR SI#03
10	2024.02.15	ISSUED FOR PCN#008
11	2024.03.04	ISSUED FOR PCN#009
12	2024.03.10	ISSUED FOR SI#004
13	2024.05.14	ISSUED FOR SI#006
14	2024.07.22	ISSUED FOR SI#008
15	2024.08.07	ISSUED FOR SI#009
16	2024.10.02	ISSUED FOR PCN#15
17	2025.04.11	ISSUED FOR PCN#019
18	2025.05.01	ISSUED FOR CO#07
19	2025.05.28	ISSUED FOR PCN#20 - CO#010
20	2025.07.31	ISSUED FOR SI#013
21	2025.08.06	ISSUED FOR SI#014
22	2025.08.15	ISSUED FOR PCN#25 - CO#017
23	2025.08.25	ISSUED FOR PCN#27 - CO#021
24	2025.09.02	ISSUED FOR PCN#29
25	2025.09.02	ISSUED FOR SI#20 - CO#018
26	2025.09.08	ISSUED FOR PCN#31
27	2025.09.09	ISSUED FOR PCN#32 - CO#022
28	2025.09.10	ISSUED FOR SI#33
29	2025.09.11	ISSUED FOR SI#022
30	2025.09.15	ISSUED FOR SI#023
31	2025.09.16	ISSUED FOR PCN #35 - CO#023
32	2025.09.30	ISSUED FOR PCN #37 - CO#029
33	2025.09.30	ISSUED FOR PCN #38 - CO#025
34	2025.10.06	ISSUED FOR PCN #39 - CO#024
35	2025.10.20	ISSUED FOR PCN #40R1
36	2025.10.30	ISSUED FOR PCN#041
37	2025.10.23	ISSUED FOR PCN #42
38	2025.11.21	ISSUED FOR PCN#021/R1 - CO12 CO#006
39	2025.11.14	ISSUED FOR PCN#043
40	2025.11.26	ISSUED FOR PCN#043R1
41	2025.12.03	ISSUED FOR PCN#044 - CO#026
42	2026.02.04	ISSUED FOR RECORD SET UP TO CO#27

NOTES:

KEY PLAN:



All dimensions and measurements must be checked and verified by the General Contractor

Reproduction of drawings and related documents in whole or in part is forbidden without written permission of the Ventin Group.

Near North District School Board

CLIENT:
NEAR NORTH DISTRICT SCHOOL BOARD
NNDSB Tender # 2023-015

PROJECT:
NEW PARRY SOUND K-12 SCHOOL & CHILDCARE

PARRY SOUND HIGH SCHOOL SITE

111 ISABELLA STREET
PARRY SOUND, ONTARIO

ORIGINAL PAGE SIZE ARCH E1 - 30" x 42"
KEY TO DETAIL LOCATION:
A - DETAIL NO.
B - DETAIL NO. ORIGIN


+VG ARCHITECTS
THE VENTIN GROUP LTD


FIRST FLOOR - MILLWORK PLAN - CHILDCARE WING

ID4.1C

DRAWN BY : NK/PS/KH CHECKED BY : EB

Plot Date: Feb 03, 2026 - 5:49pm By jkelly
Filename: K:\1VG-Brantford\Near North DSB Parry Sound School\2211\Drawings\Wd-Current\NN - ID4.1_Level 1 Millwork Plan.dwg

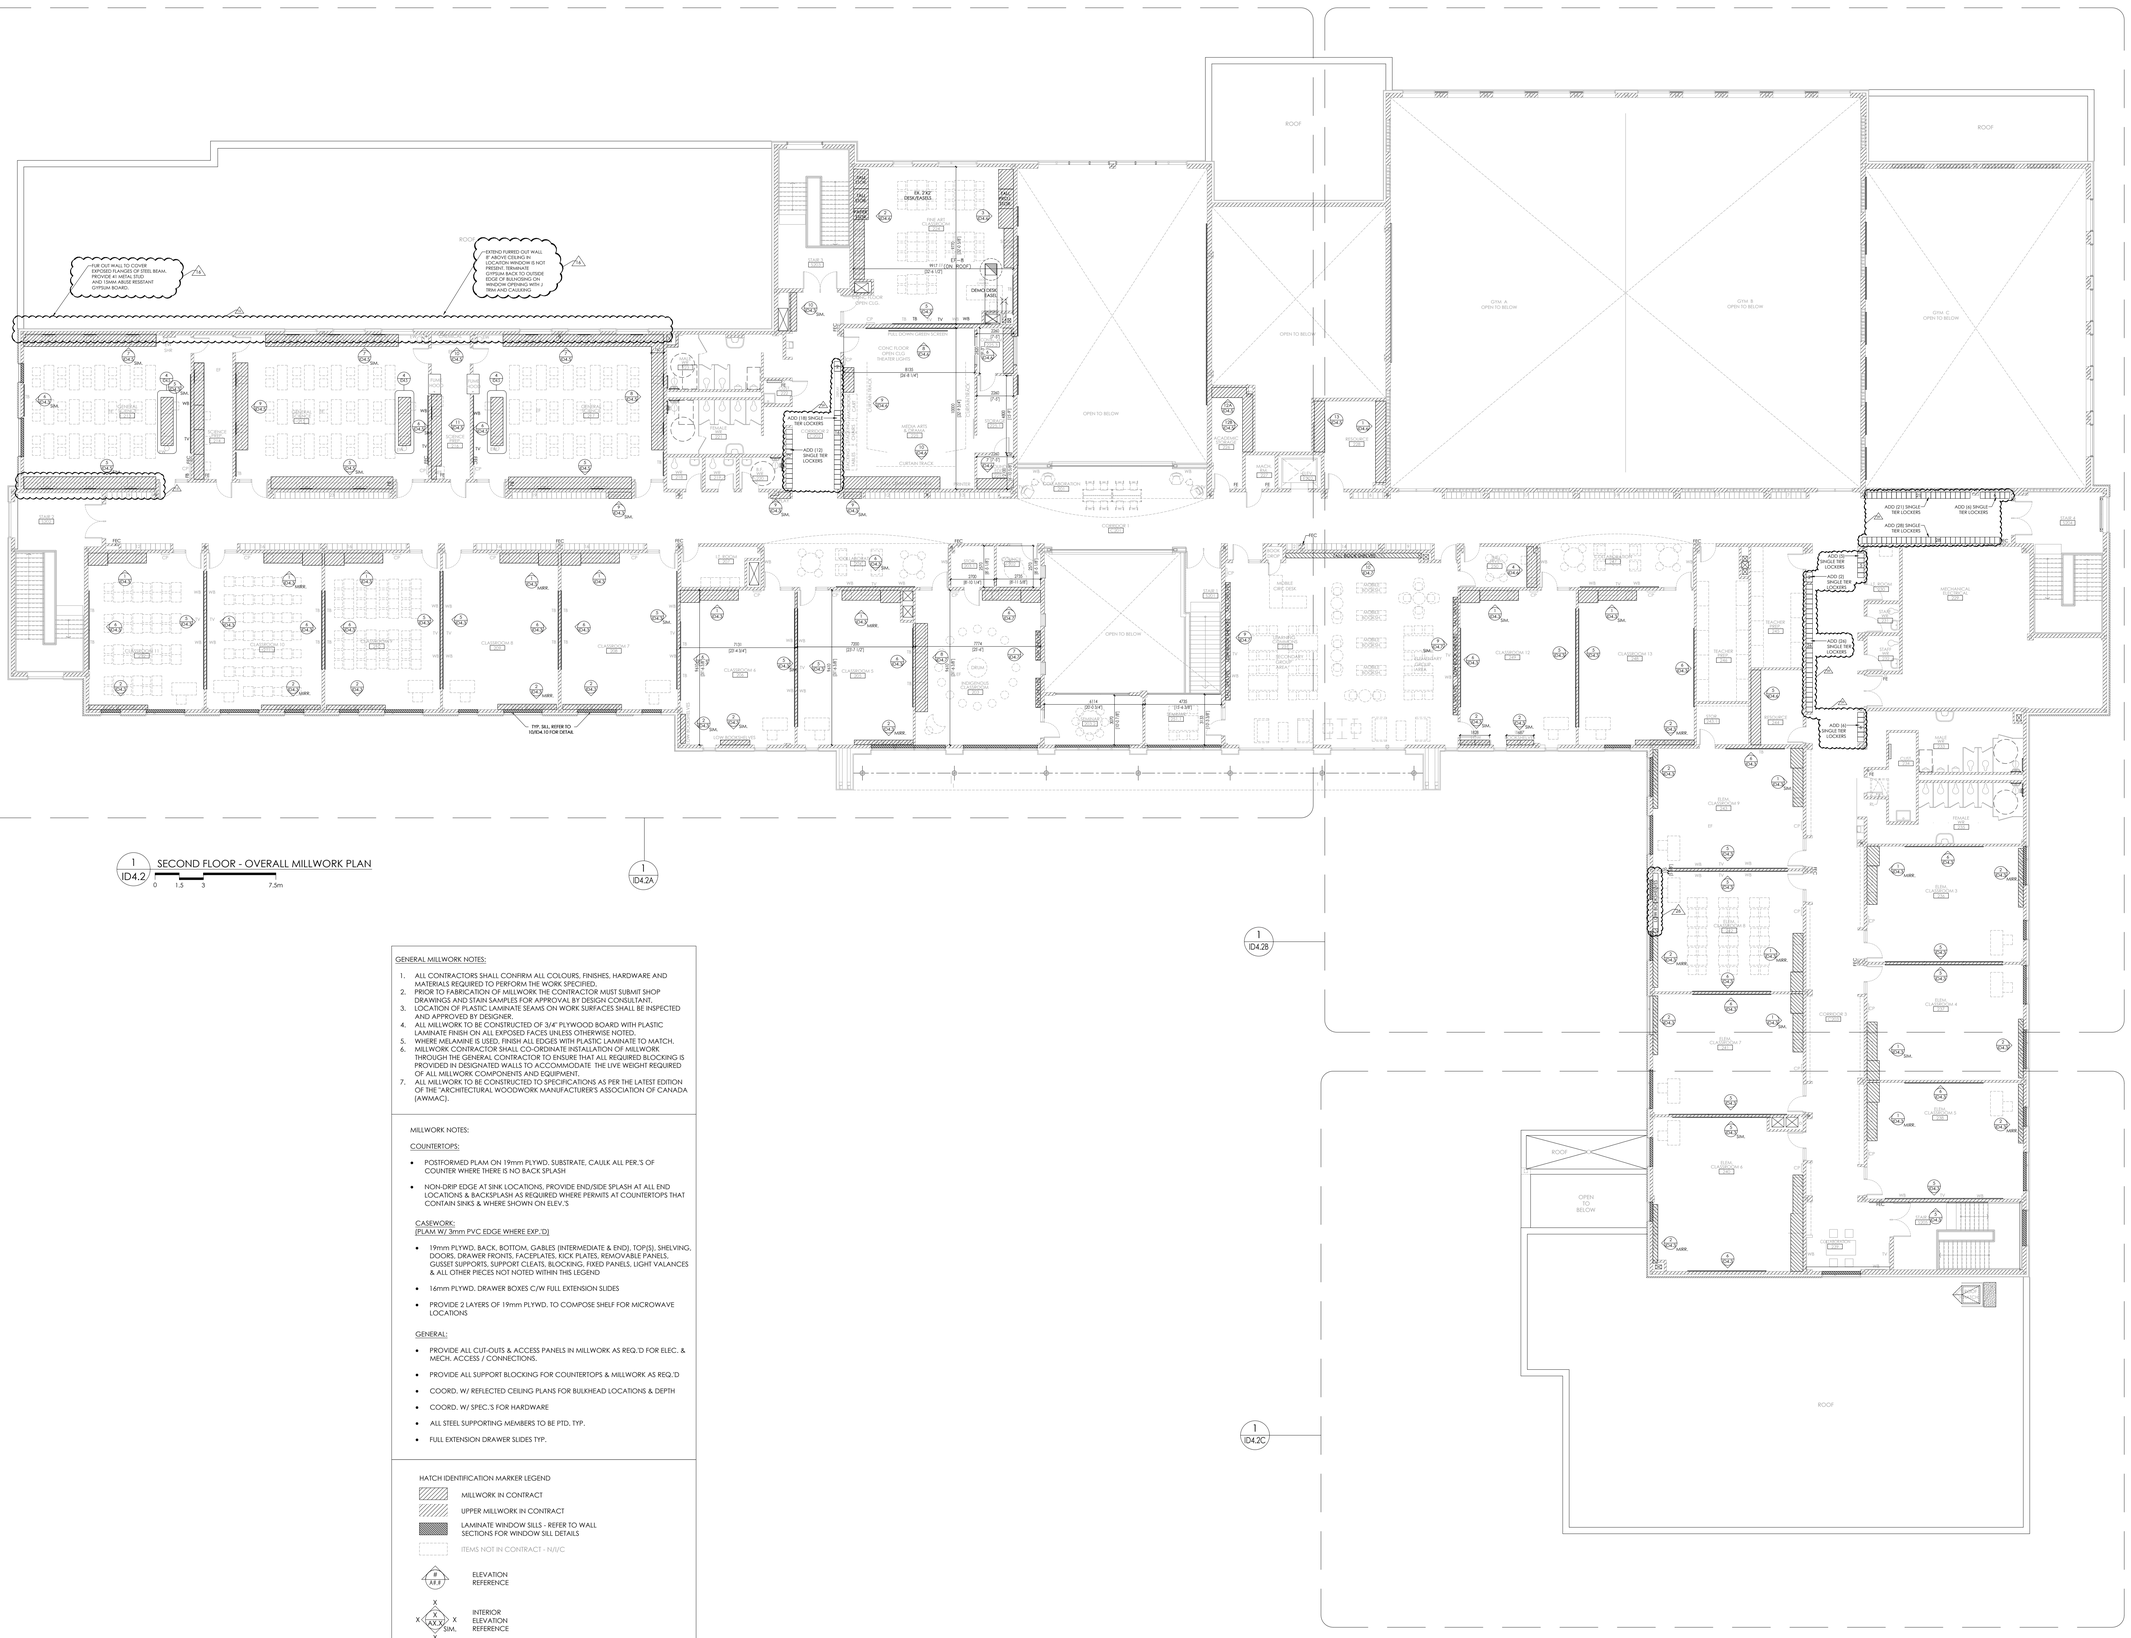
ROOF
GYM A
OPEN TO BELOW
GYM B
OPEN TO BELOW
GYM C
OPEN TO BELOW
OPEN TO BELOW

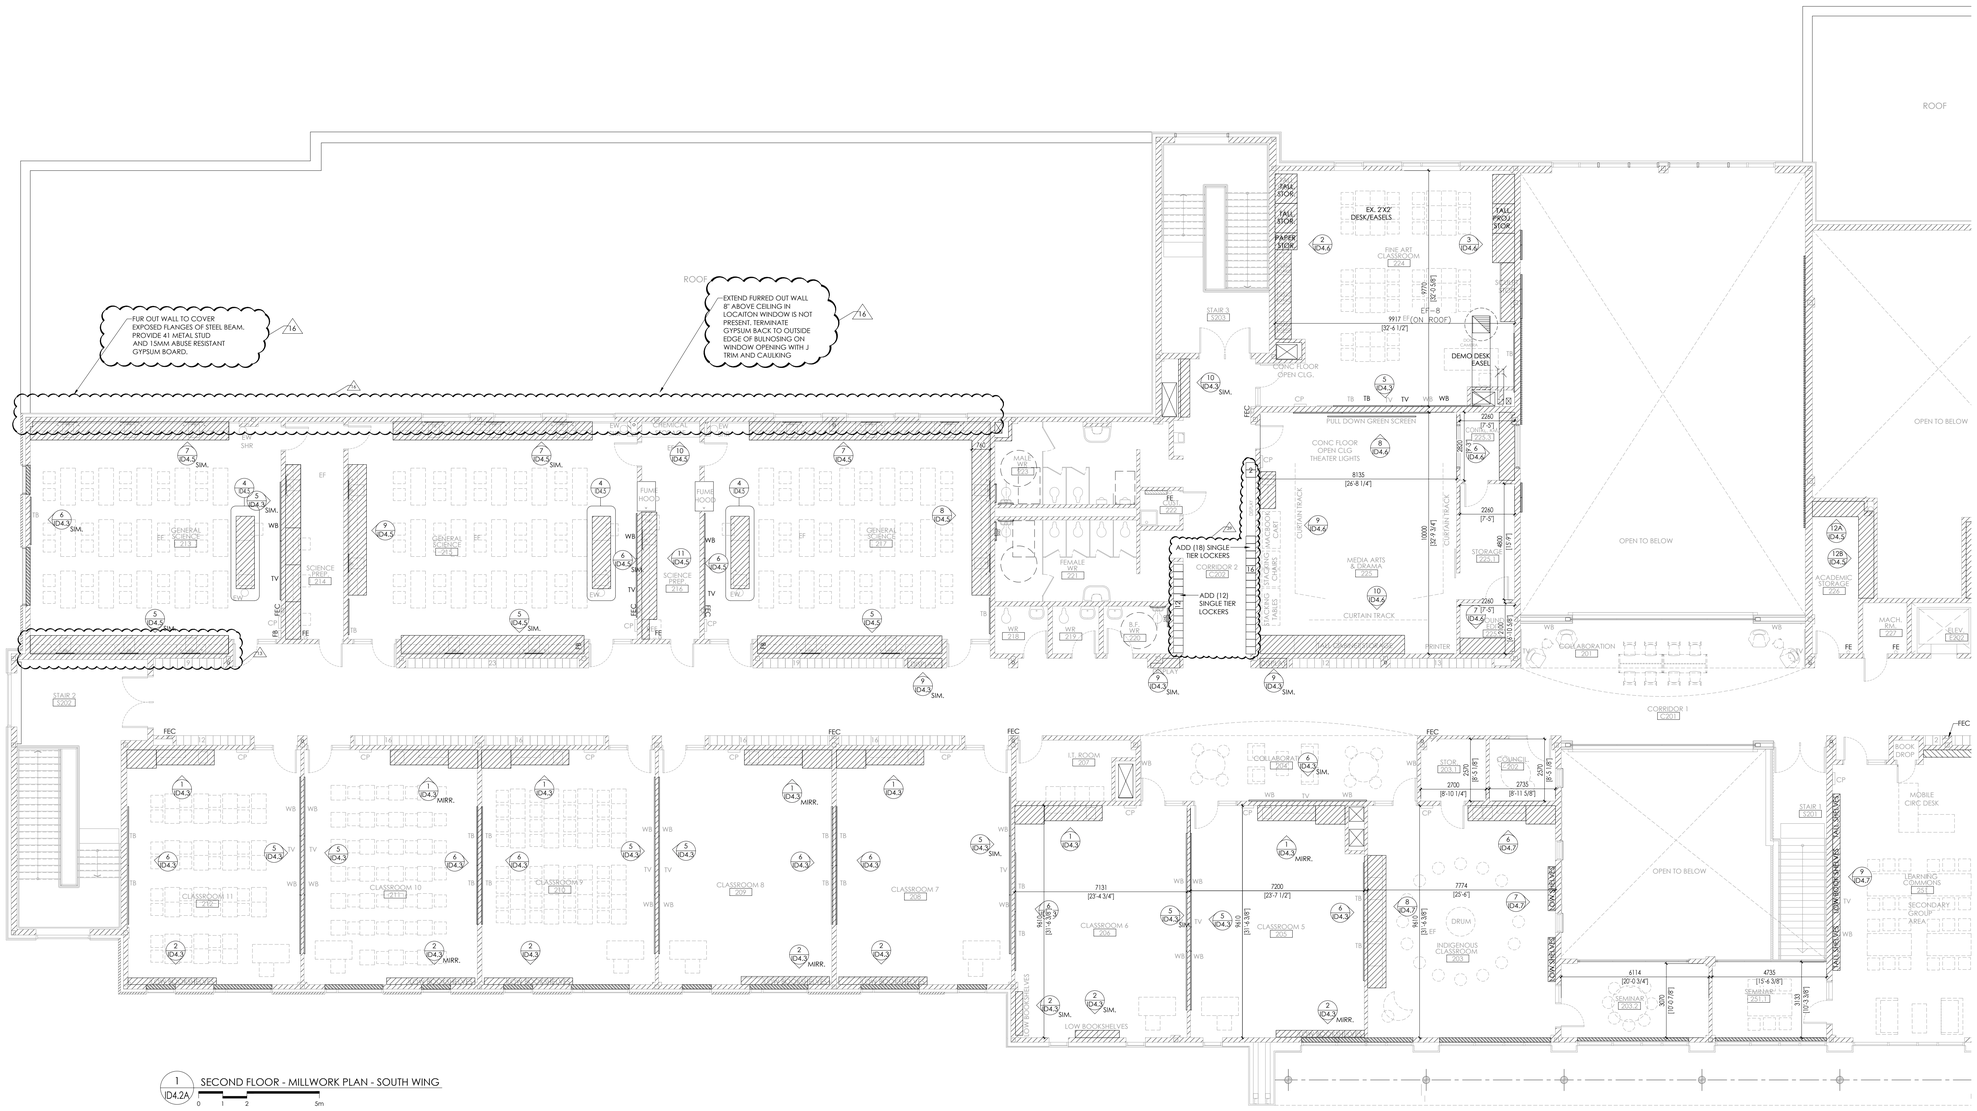

1 ID4.2A SECOND FLOOR - MILLWORK PLAN - SOUTH WING


0 1 2 5m

REVISIONS

NO.	DATE	PARTICULAR
1	2022.06.06	ISSUED FOR 80% CLASS B COSTING
2	2022.08.18	ISSUED FOR SPA
3	2022.09.22	ISSUED FOR OWNERS REVIEW - 98% SET
4	2022.12.16	ISSUED FOR 2nd SPA SUBMISSION
5	2023.01.31	ISSUED FOR TENDER
6	2023.02.22	ISSUED FOR ADDENDUM 9
7	2023.08.23	ISSUED FOR CONVENIENCE
8	2023.11.20	ISSUED FOR PERMIT COMMENTS
9	2024.01.24	ISSUED FOR SI#03
10	2024.02.15	ISSUED FOR PCN#008
11	2024.03.04	ISSUED FOR PCN#009
12	2024.03.10	ISSUED FOR SI#004
13	2024.05.14	ISSUED FOR SI#006
14	2024.07.22	ISSUED FOR SI#008
15	2024.08.07	ISSUED FOR SI#009
16	2024.10.02	ISSUED FOR PCN#15
17	2025.04.11	ISSUED FOR PCN#019
18	2025.05.01	ISSUED FOR CO#07
19	2025.05.28	ISSUED FOR PCN#20 - CO#010
20	2025.07.31	ISSUED FOR SI#013
21	2025.08.06	ISSUED FOR SI#014
22	2025.08.15	ISSUED FOR PCN#25 - CO#017
23	2025.08.25	ISSUED FOR PCN#27 - CO#021
24	2025.09.02	ISSUED FOR PCN#29
25	2025.09.02	ISSUED FOR SI#20 - CO#018
26	2025.09.08	ISSUED FOR PCN#31
27	2025.09.09	ISSUED FOR PCN#32 - CO#022
28	2025.09.10	ISSUED FOR PCN#33
29	2025.09.11	ISSUED FOR SI#022
30	2025.09.15	ISSUED FOR SI#023
31	2025.09.16	ISSUED FOR PCN #35 - CO#023
32	2025.09.30	ISSUED FOR PCN #37 - CO#029
33	2025.09.30	ISSUED FOR PCN #38 - CO#025
34	2025.10.06	ISSUED FOR PCN #39 - CO#024
35	2025.10.20	ISSUED FOR PCN #40R1
36	2025.10.30	ISSUED FOR PCN#041
37	2025.10.23	ISSUED FOR PCN #42
38	2025.11.21	ISSUED FOR PCN#021/R1 - CO12 CD#006
39	2025.11.14	ISSUED FOR PCN#043
40	2025.11.26	ISSUED FOR PCN#043R1
41	2025.12.03	ISSUED FOR PCN#044 - CO#026
42	2026.02.04	ISSUED FOR RECORD SET UP TO CO#27

NOTES:

KEY PLAN:

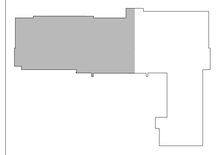

All dimensions and measurements must be checked and verified by the General Contractor

Reproduction of drawings and related documents in whole or in part is forbidden without written permission of the Ventin Group.

CLIENT:
NEAR NORTH DISTRICT SCHOOL BOARD
NNDSB Tender # 2023-015

PROJECT:
NEW PARRY SOUND K-12 SCHOOL & CHILDCARE

PARRY SOUND HIGH SCHOOL SITE

111 ISABELLA STREET
PARRY SOUND, ONTARIO

ORIGINAL PAGE SIZE ARCH E1 - 30" x 42"
KEY TO DETAIL LOCATION:
A - DETAIL NO.
B - DETAIL NO. ORIGIN


+VG ARCHITECTS
THE VENTIN GROUP LTD

SECOND FLOOR - MILLWORK PLAN - SOUTH WING

ID4.2A

DRAWN BY : PS/KH CHECKED BY : EB

Plot Date: Feb 03, 2026 - 5:51 pm By: jkelly Filename: K:\1VG-Stanford\Near North DSB Parry Sound School\2211\Drawings\Wed-Current\NN - ID4.2 Level 2 Millwork Plan.dwg

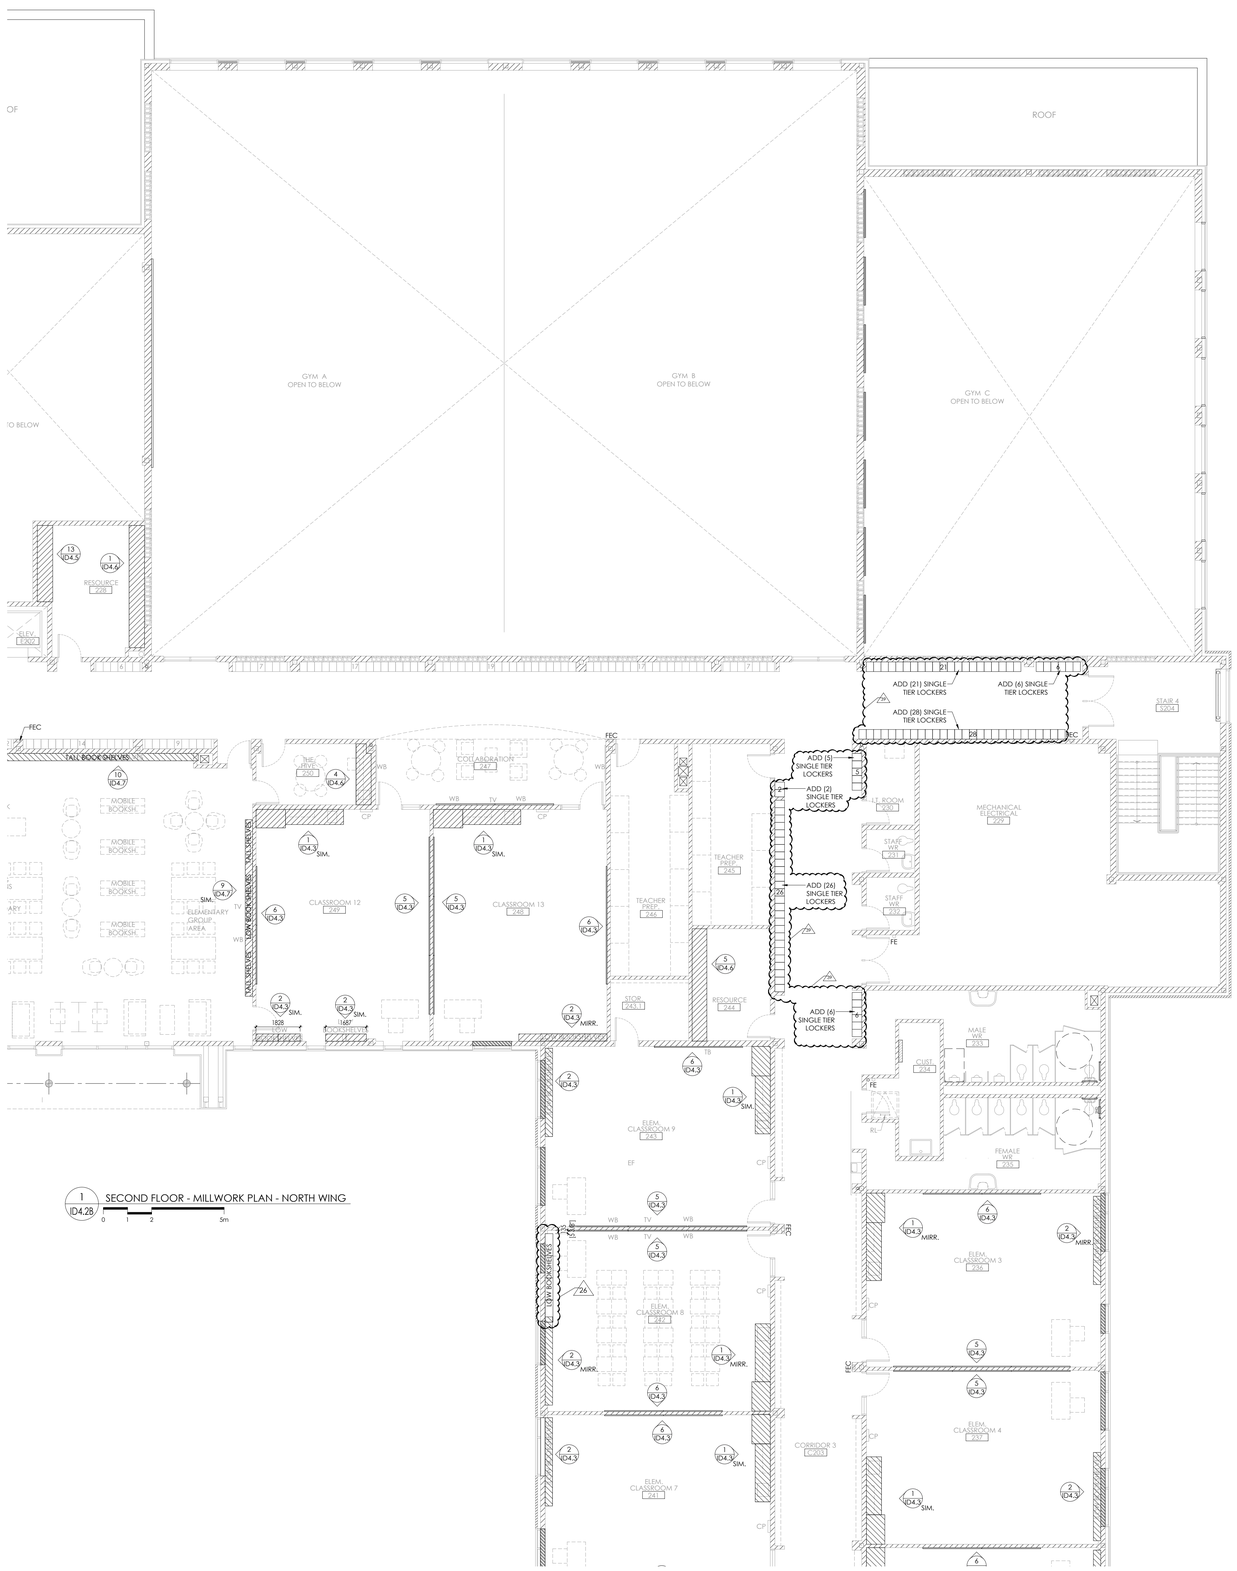

REVISIONS


NO.	DATE	PARTICULAR
1	2022.06.06	ISSUED FOR 80% CLASS B COSTING
2	2022.08.18	ISSUED FOR SPA
3	2022.09.22	ISSUED FOR OWNERS REVIEW - 98% SET
4	2022.12.16	ISSUED FOR 2nd SPA SUBMISSION
5	2023.01.31	ISSUED FOR TENDER
6	2023.02.22	ISSUED FOR ADDENDUM 9
7	2023.08.23	ISSUED FOR CONVENIENCE
8	2023.11.20	ISSUED FOR PERMIT COMMENTS
9	2024.01.24	ISSUED FOR SI#03
10	2024.02.15	ISSUED FOR PCN#008
11	2024.03.04	ISSUED FOR PCN#009
12	2024.03.10	ISSUED FOR SI#004
13	2024.05.14	ISSUED FOR SI#006
14	2024.07.22	ISSUED FOR SI#008
15	2024.08.07	ISSUED FOR SI#009
16	2024.10.02	ISSUED FOR PCN#15
17	2025.04.11	ISSUED FOR PCN#019
18	2025.05.01	ISSUED FOR CO#07
19	2025.05.28	ISSUED FOR PCN#20 - CO#010
20	2025.07.31	ISSUED FOR SI#013
21	2025.08.06	ISSUED FOR SI#014
22	2025.08.15	ISSUED FOR PCN#25 - CO#017
23	2025.08.25	ISSUED FOR PCN#27 - CO#021
24	2025.09.02	ISSUED FOR PCN#29
25	2025.09.02	ISSUED FOR SI#20 - CO#018
26	2025.09.08	ISSUED FOR PCN#31
27	2025.09.09	ISSUED FOR PCN#32 - CO#022
28	2025.09.10	ISSUED FOR PCN#33
29	2025.09.11	ISSUED FOR SI#022
30	2025.09.15	ISSUED FOR SI#023
31	2025.09.16	ISSUED FOR PCN #35 - CO#023
32	2025.09.30	ISSUED FOR PCN #37 - CO#029
33	2025.09.30	ISSUED FOR PCN #38 - CO#025
34	2025.10.06	ISSUED FOR PCN #39 - CO#024
35	2025.10.20	ISSUED FOR PCN #40R1
36	2025.10.30	ISSUED FOR PCN#041
37	2025.10.23	ISSUED FOR PCN #42
38	2025.11.21	ISSUED FOR PCN#021/R1 - CO12 CD#006
39	2025.11.14	ISSUED FOR PCN#043
40	2025.11.26	ISSUED FOR PCN#043R1
41	2025.12.03	ISSUED FOR PCN#044 - CO#026
42	2026.02.04	ISSUED FOR RECORD SET UP TO CO#27

All dimensions and measurements must be checked and verified by the General Contractor

Reproduction of drawings and related documents in whole or in part is forbidden without written permission of the Ventin Group.

NOTES:

KEY PLAN:

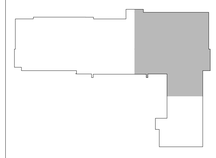

Near North District School Board

CLIENT:
NEAR NORTH DISTRICT SCHOOL BOARD
NNDSB Tender # 2023-015

PROJECT:
NEW PARRY SOUND K-12 SCHOOL & CHILDCARE

PARRY SOUND HIGH SCHOOL SITE

111 ISABELLA STREET
PARRY SOUND, ONTARIO

ORIGINAL PAGE SIZE ARCH E1 - 30" x 42"
KEY TO DETAIL LOCATION:
A - DETAIL NO.
B - DETAIL NO. ORIGIN


+VG ARCHITECTS
THE VENTIN GROUP LTD

SECOND FLOOR - MILLWORK PLAN - NORTH WING

ID4.2B

DRAWN BY : PS/KH CHECKED BY : EB

Plot Date: Feb 03, 2026 - 5:51pm By: jkelly Filename: K:\VG-Brantford\Near North DSB Parry Sound School\2111\Drawings\Wd-Current\NN - ID4.2_Level 2 Millwork Plan.dwg

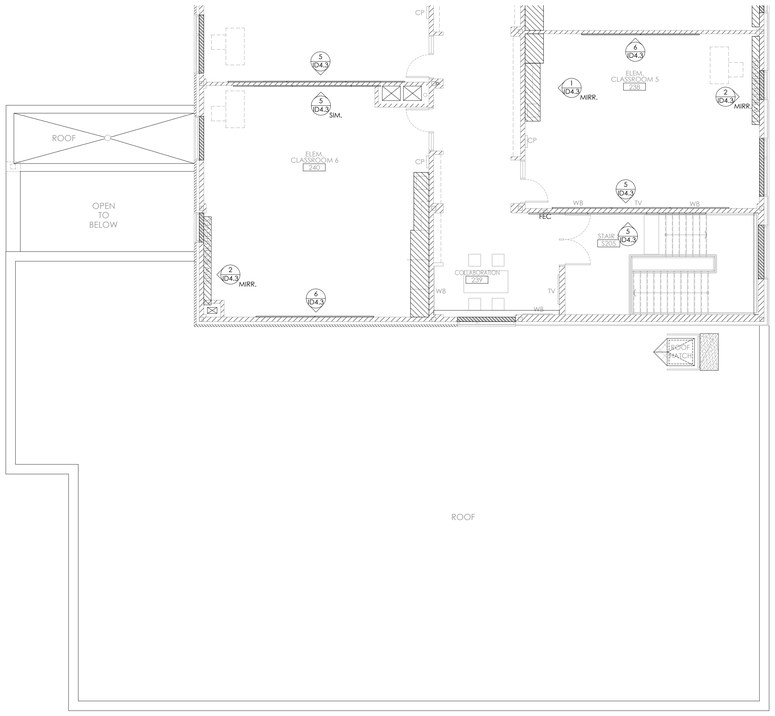

1 ID4.2C SECOND FLOOR - MILLWORK PLAN - NORTH WING

0 1 2 5m

REVISIONS

NO.	DATE	PARTICULAR
1	2022.06.06	ISSUED FOR 80% CLASS B COSTING
2	2022.08.18	ISSUED FOR SPA
3	2022.09.22	ISSUED FOR OWNERS REVIEW - 98% SET
4	2022.12.16	ISSUED FOR 2nd SPA SUBMISSION
5	2023.01.31	ISSUED FOR TENDER
6	2023.02.22	ISSUED FOR ADDENDUM 9
7	2023.08.23	ISSUED FOR CONVENIENCE
8	2023.11.20	ISSUED FOR PERMIT COMMENTS
9	2024.01.24	ISSUED FOR SI#03
10	2024.02.15	ISSUED FOR PCN#008
11	2024.03.04	ISSUED FOR PCN#009
12	2024.03.10	ISSUED FOR SI#004
13	2024.05.14	ISSUED FOR SI#006
14	2024.07.22	ISSUED FOR SI#008
15	2024.08.07	ISSUED FOR SI#009
16	2024.10.02	ISSUED FOR PCN#15
17	2025.04.11	ISSUED FOR PCN#019
18	2025.05.01	ISSUED FOR CO#07
19	2025.05.28	ISSUED FOR PCN#20 - CO#010
20	2025.07.31	ISSUED FOR SI#013
21	2025.08.06	ISSUED FOR SI#014
22	2025.08.15	ISSUED FOR PCN#25 - CO#017
23	2025.08.25	ISSUED FOR PCN#27 - CO#021
24	2025.09.02	ISSUED FOR PCN#29
25	2025.09.02	ISSUED FOR SI#20 - CO#018
26	2025.09.08	ISSUED FOR PCN#31
27	2025.09.09	ISSUED FOR PCN#32 - CO#022
28	2025.09.10	ISSUED FOR PCN#33
29	2025.09.11	ISSUED FOR SI#022
30	2025.09.15	ISSUED FOR SI#023
31	2025.09.16	ISSUED FOR PCN #35 - CO#023
32	2025.09.30	ISSUED FOR PCN #37 - CO#029
33	2025.09.30	ISSUED FOR PCN #38 - CO#025
34	2025.10.06	ISSUED FOR PCN #39 - CO#024
35	2025.10.20	ISSUED FOR PCN #40R1
36	2025.10.30	ISSUED FOR PCN#041
37	2025.10.23	ISSUED FOR PCN #42
38	2025.11.21	ISSUED FOR PCN#021/R1 - CO12 CD#006
39	2025.11.14	ISSUED FOR PCN#043
40	2025.11.26	ISSUED FOR PCN#043R1
41	2025.12.03	ISSUED FOR PCN#044 - CO#026
42	2026.02.04	ISSUED FOR RECORD SET UP TO CO#27

NOTES:

KEY PLAN:



All dimensions and measurements must be checked and verified by the General Contractor

Reproduction of drawings and related documents in whole or in part is forbidden without written permission of the Ventin Group.

Near North District School Board

CLIENT:
NEAR NORTH DISTRICT SCHOOL BOARD
NNDSB Tender # 2023-015

PROJECT:
NEW PARRY SOUND K-12 SCHOOL & CHILDCARE

PARRY SOUND HIGH SCHOOL SITE

111 ISABELLA STREET
PARRY SOUND, ONTARIO

ORIGINAL PAGE SIZE ARCH E1 - 30" x 42"
KEY TO DETAIL LOCATION:
(A / B) A - DETAIL NO.
B - DETAIL NO. ORIGIN

+VG ARCHITECTS
THE VENTIN GROUP LTD


CN

SECOND FLOOR - MILLWORK PLAN - CHILDCARE WING

ID4.2C


DRAWN BY : PS/KH CHECKED BY : EB

Plot Date: Feb 03, 2026 - 5:52pm By jkelly Filename: K:\1VG-Brantford\Near North DSB Parry Sound School\2211\1Drawings\Wd-Current\NN - ID4.2_Level 2 Millwork Plan.dwg

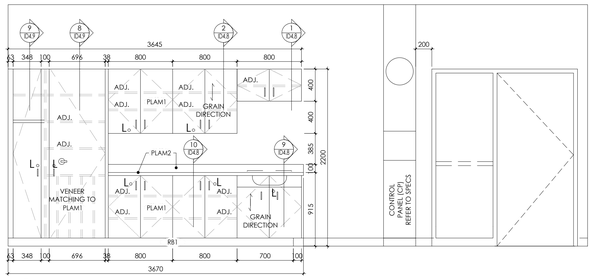


1 ID4.3 TYP. CLASSROOM MILLWORK ELEV.

0 300 600 1500mm

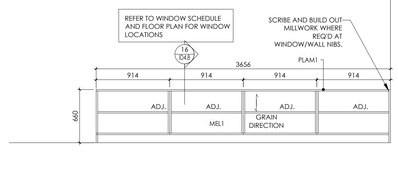


2 ID4.3 TYP. CLASSROOM LOW SHELVES ELEV.

0 300 600 1500mm

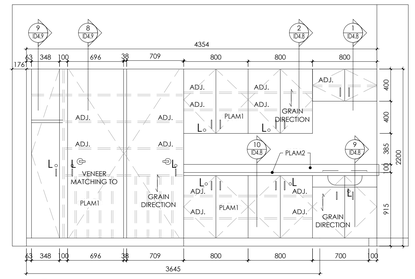


3 ID4.3 MUSIC RM 144 MILLWORK ELEV.

0 300 600 1500mm

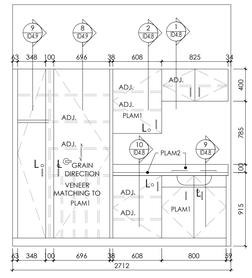


4 ID4.3 SPEC. ED 120 MILLWORK ELEV.

0 300 600 1500mm

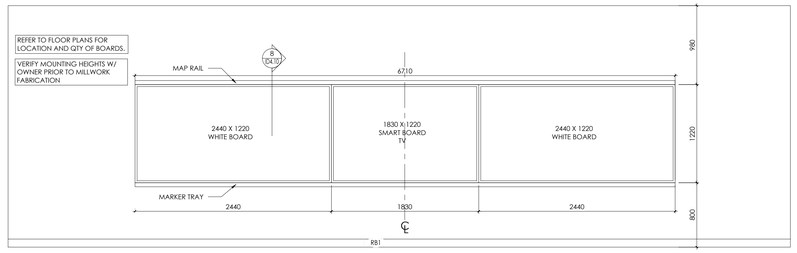


5 ID4.3 TYP. CLASSROOM WHITEBOARD WALL ELEV.

0 300 600 1500mm

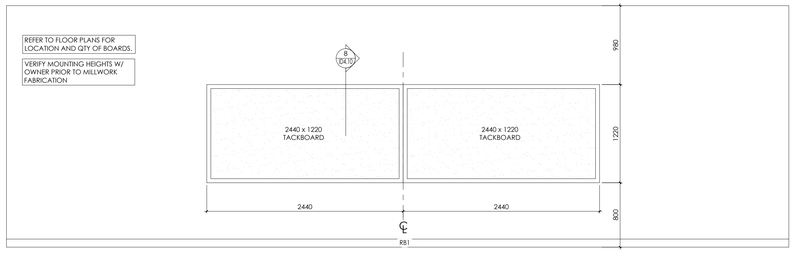


6 ID4.3 TYP. CLASSROOM TACKBOARD WALL ELEV.

0 300 600 1500mm

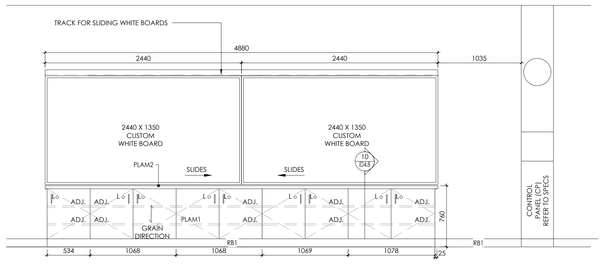


7 ID4.3 TECH ROOMS 123, 139 WHT. BD. STORAGE ELEV.

0 300 600 1500mm

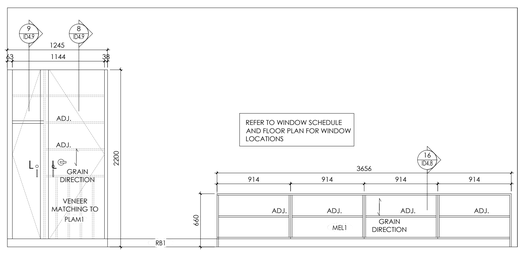


8 ID4.3 SPEC. ED. 120 MILLWORK ELEV.

0 300 600 1500mm

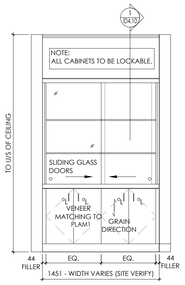


9 ID4.3 DISPLAY CASE ELEVATION

0 300 600 1500mm

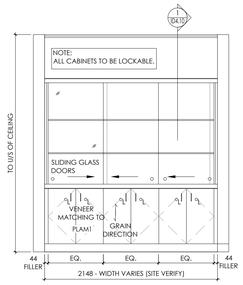


10 ID4.3 DISPLAY CASE ELEVATION

0 300 600 1500mm

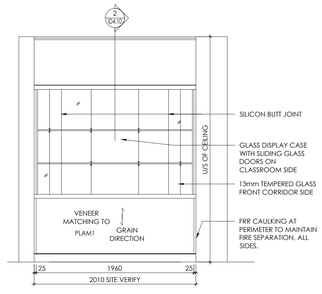


11B ID4.3 COSMETOLOGY CORR 101 DISPLAY CASE ELEVATION

0 300 600 1500mm

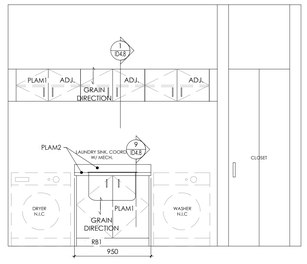


12 ID4.3 TRAINING KITCHEN 118 - LAUNDRY ELEV.

0 300 600 1500mm

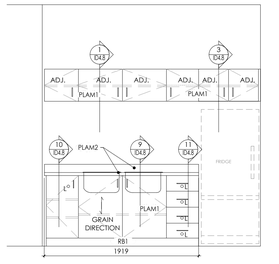


13 ID4.3 TRAINING KITCHEN 118 - ELEV.

0 300 600 1500mm

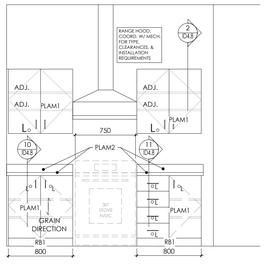


14 ID4.3 TRAINING KITCHEN 118 - ELEV.

0 300 600 1500mm

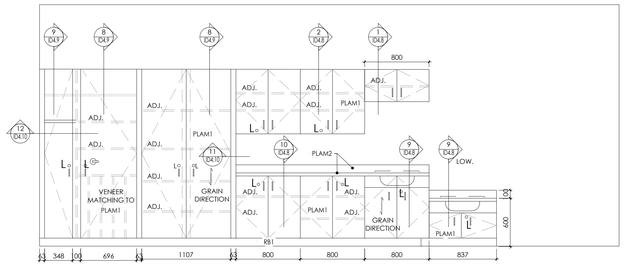


15 ID4.3 KINDERGARTEN 166 - MILLWORK ELEV.

0 300 600 1500mm

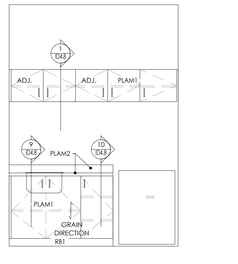


16 ID4.3 CUST. STAFF 126 MILLWORK ELEV.

0 300 600 1500mm

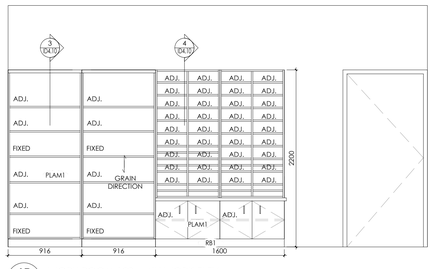


17 ID4.3 WORK ROOM 109 - MILLWORK ELEV.

0 300 600 1500mm

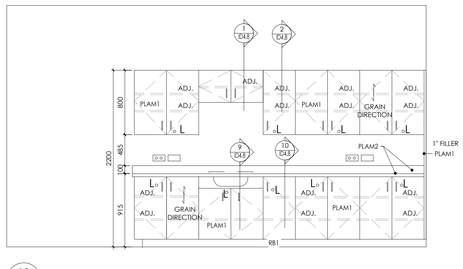

18 ID4.3 WORK ROOM 109 - MILLWORK ELEV.

0 300 600 1500mm

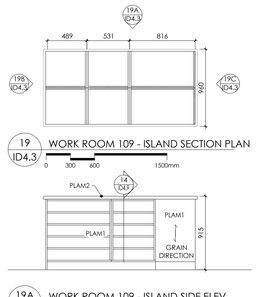


19 ID4.3 WORK ROOM 109 - ISLAND SECTION PLAN

0 300 600 1500mm

19A ID4.3 WORK ROOM 109 - ISLAND SIDE ELEV.

0 300 600 1500mm

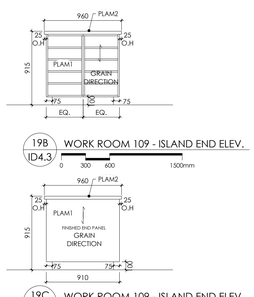


19B ID4.3 WORK ROOM 109 - ISLAND END ELEV.

0 300 600 1500mm

19C ID4.3 WORK ROOM 109 - ISLAND END ELEV.

0 300 600 1500mm

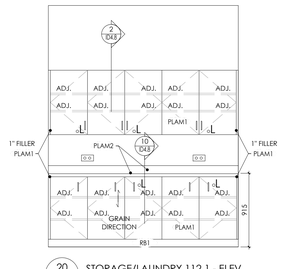

20 ID4.3 STORAGE/LAUNDRY 112.1 - ELEV.

0 300 600 1500mm

REVISIONS

NO.	DATE	PARTICULAR
1	2022.06.06	ISSUED FOR 80% CLASS B COSTING
2	2022.08.18	ISSUED FOR SPA
3	2022.09.22	ISSUED FOR OWNERS REVIEW - 98% SET
4	2022.12.16	ISSUED FOR 2nd SPA SUBMISSION
5	2023.01.31	ISSUED FOR TENDER
6	2023.02.22	ISSUED FOR ADDENDUM 9
7	2023.08.23	ISSUED FOR CONVENIENCE
8	2023.11.20	ISSUED FOR PERMIT COMMENTS
9	2024.01.24	ISSUED FOR SI#03
10	2024.02.15	ISSUED FOR PCN#008
11	2024.03.04	ISSUED FOR PCN#009
12	2024.03.10	ISSUED FOR SI#004
13	2024.05.14	ISSUED FOR SI#006
14	2024.07.22	ISSUED FOR SI#008
15	2024.08.07	ISSUED FOR SI#009
16	2024.10.02	ISSUED FOR PCN#15
17	2025.04.11	ISSUED FOR PCN#019
18	2025.05.01	ISSUED FOR CO#07
19	2025.05.28	ISSUED FOR PCN#20 - CO#010
20	2025.07.31	ISSUED FOR SI#013
21	2025.08.06	ISSUED FOR SI#014
22	2025.08.15	ISSUED FOR PCN#25 - CO#017
23	2025.08.25	ISSUED FOR PCN#27 - CO#021
24	2025.09.02	ISSUED FOR PCN#29
25	2025.09.02	ISSUED FOR SI#20 - CO#018
26	2025.09.08	ISSUED FOR PCN#31
27	2025.09.09	ISSUED FOR PCN#32 - CO#022
28	2025.09.10	ISSUED FOR PCN#33
29	2025.09.11	ISSUED FOR SI#022
30	2025.09.15	ISSUED FOR SI#023
31	2025.09.16	ISSUED FOR PCN #35 - CO#023
32	2025.09.30	ISSUED FOR PCN #37 - CO#029
33	2025.09.30	ISSUED FOR PCN #38 - CO#025
34	2025.10.06	ISSUED FOR PCN #39 - CO#024
35	2025.10.20	ISSUED FOR PCN #40R1
36	2025.10.30	ISSUED FOR PCN#041
37	2025.10.23	ISSUED FOR PCN #42
38	2025.11.21	ISSUED FOR PCN#021/R1 - CO12 CD#006
39	2025.11.14	ISSUED FOR PCN#043
40	2025.11.26	ISSUED FOR PCN#043R1
41	2025.12.03	ISSUED FOR PCN#044 - CO#026
42	2026.02.04	ISSUED FOR RECORD SET UP TO CO#27

NOTES:

KEY PLAN:

All dimensions and measurements must be checked and verified by the General Contractor

Reproduction of drawings and related documents in whole or in part is forbidden without written permission of the Ventin Group.

Near North District School Board

CLIENT:
NEAR NORTH DISTRICT SCHOOL BOARD
NNDSB Tender # 2023-015

PROJECT:
NEW PARRY SOUND K-12 SCHOOL & CHILDCARE

PARRY SOUND HIGH SCHOOL SITE

111 ISABELLA STREET
PARRY SOUND, ONTARIO

ORIGINAL PAGE SIZE ARCH E1 - 30" x 42"

KEY TO DETAIL LOCATION:
(A) A - DETAIL NO.
(B) B - DETAIL NO. ORIGIN

VG ARCHITECTS
THE VENTIN GROUP LTD

MILLWORK ELEVATIONS


ID4.3

Plot Date: Feb 03, 2026 - 5:52pm By: jkelly


Filename: K:\VG-Brantford\Near North DSB Parry Sound School\2211\Drawings\WD-Current\NN - ID4.3_Millwork Elevations.jpg

DRAWN BY : NK/PS


CHECKED BY : EB

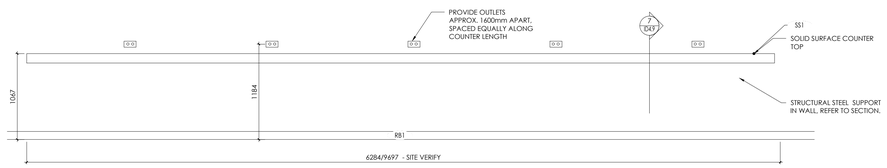


1 ID4.4 CAFETORIUM 143 - LAPTOP STAND UP COUNTER
0 300 600 1500mm

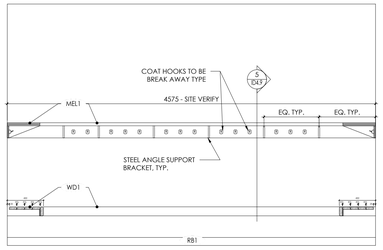


2 ID4.4 CHANGEROOM BENCH ELEV. TYP.
0 300 600 1500mm

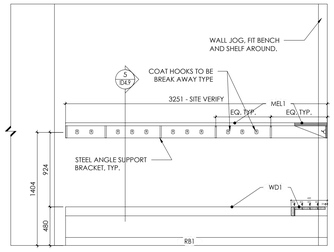


3 ID4.4 CHANGEROOM BENCH ELEV. TYP.
0 300 600 1500mm

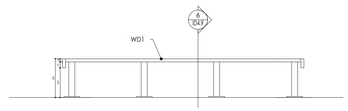


4 ID4.4 CHANGEROOM BENCH ELEV. TYP.
0 300 600 1500mm

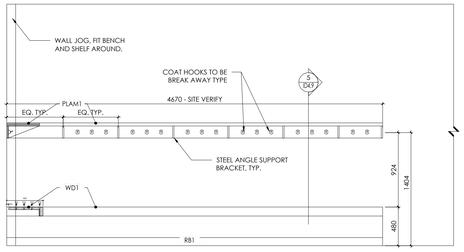


5 ID4.4 CHANGEROOM BENCH ELEV. TYP.
0 300 600 1500mm

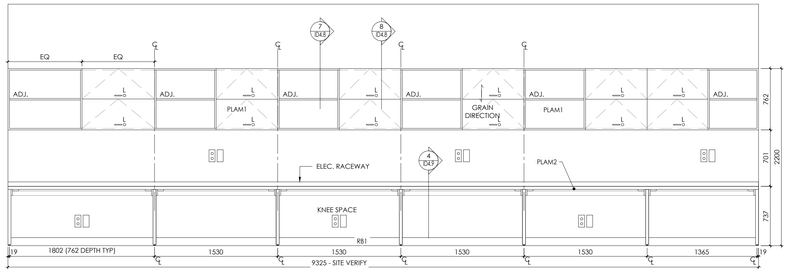


6 ID4.4 RESOURCE ROOM 167 - MILLWORK ELEV.
0 300 600 1500mm

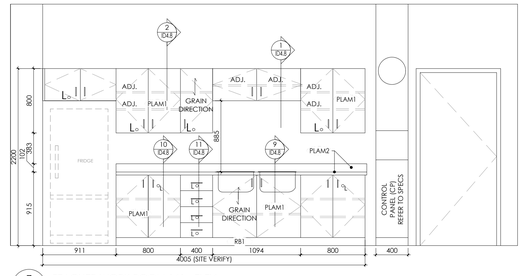


7 ID4.4 TEACHER WORK ROOM 161- ELEV.
0 300 600 1500mm

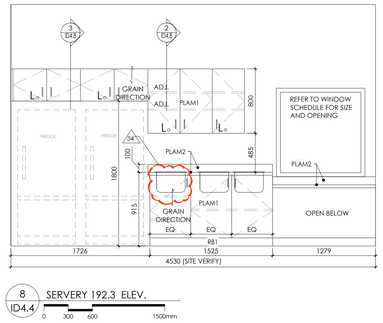


8 ID4.4 SERVERY 192.3 ELEV.
0 300 600 1500mm

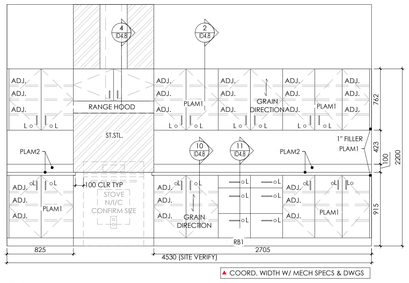


9 ID4.4 SERVERY 192.3 ELEV.
0 300 600 1500mm

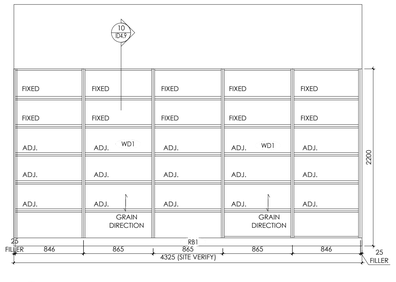


10 ID4.4 DRY STORAGE 191.1 ELEV.
0 300 600 1500mm

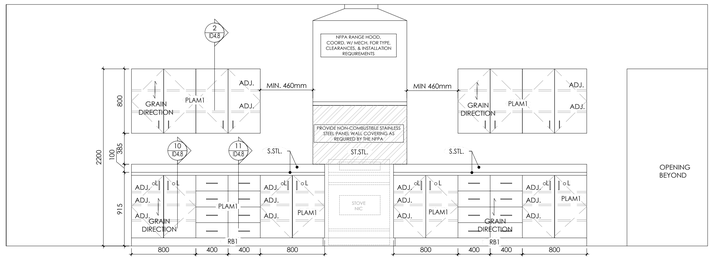


11 ID4.4 CHILDCARE KITCHEN 191
0 300 600 1500mm

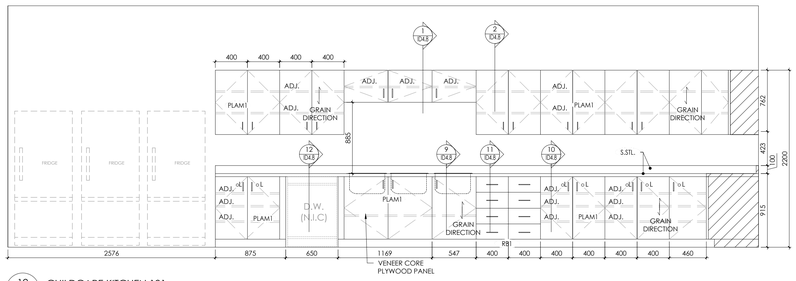


12 ID4.4 CHILDCARE KITCHEN 191
0 300 600 1500mm

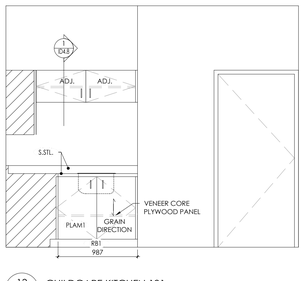


13 ID4.4 CHILDCARE KITCHEN 191
0 300 600 1500mm

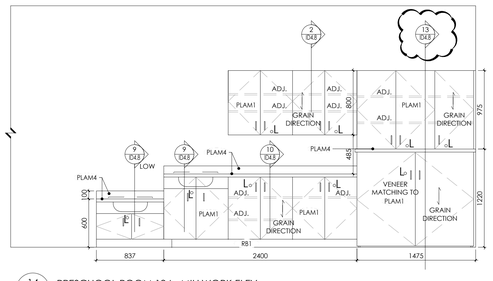


14 ID4.4 PRESCHOOL ROOM 194 - MILLWORK ELEV.
0 300 600 1500mm

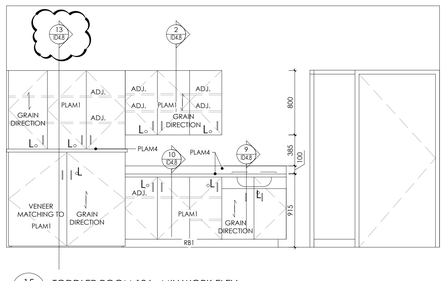


15 ID4.4 TODDLER ROOM 196 - MILLWORK ELEV.
0 300 600 1500mm

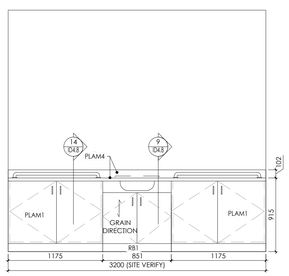


16 ID4.4 PRESCHOOL WR 194.2
0 300 600 1500mm

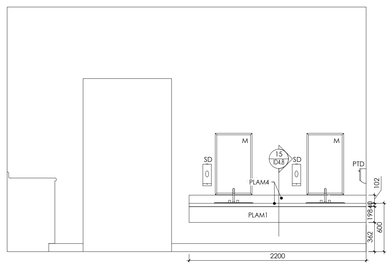


17 ID4.4 PRESCHOOL WR 194.2
0 300 600 1500mm

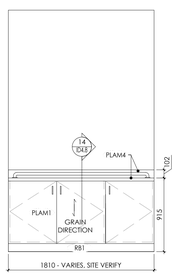

18 ID4.4 TODDLER WR 196.1
0 300 600 1500mm

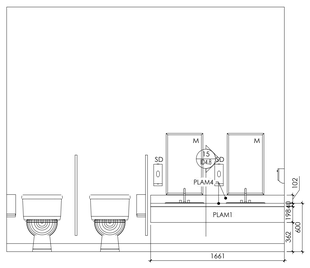

19 ID4.4 TODDLER WR 196.1
0 300 600 1500mm

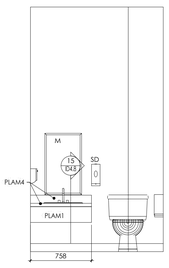

20 ID4.4 INFANT WR 197.3
0 300 600 1500mm

REVISIONS

NO.	DATE	PARTICULAR
1	2022.06.06	ISSUED FOR 80% CLASS B COSTING
2	2022.08.18	ISSUED FOR SPA
3	2022.09.22	ISSUED FOR OWNERS REVIEW - 98% SET
4	2022.12.16	ISSUED FOR 2nd SPA SUBMISSION
5	2023.01.31	ISSUED FOR TENDER
6	2023.02.22	ISSUED FOR ADDENDUM 9
7	2023.08.23	ISSUED FOR CONVENIENCE
8	2023.11.20	ISSUED FOR PERMIT COMMENTS
9	2024.01.24	ISSUED FOR SI#03
10	2024.02.15	ISSUED FOR PCN#008
11	2024.03.04	ISSUED FOR PCN#009
12	2024.03.10	ISSUED FOR SI#004
13	2024.05.14	ISSUED FOR SI#006
14	2024.07.22	ISSUED FOR SI#008
15	2024.08.07	ISSUED FOR SI#009
16	2024.10.02	ISSUED FOR PCN#15
17	2025.04.11	ISSUED FOR PCN#019
18	2025.05.01	ISSUED FOR CO#07
19	2025.05.28	ISSUED FOR PCN#20 - CO#010
20	2025.07.31	ISSUED FOR SI#013
21	2025.08.06	ISSUED FOR SI#014
22	2025.08.15	ISSUED FOR PCN#25 - CO#017
23	2025.08.25	ISSUED FOR PCN#27 - CO#021
24	2025.09.02	ISSUED FOR PCN#29
25	2025.09.02	ISSUED FOR SI#20 - CO#018
26	2025.09.08	ISSUED FOR PCN#31
27	2025.09.09	ISSUED FOR PCN#32 - CO#022
28	2025.09.10	ISSUED FOR PCN#33
29	2025.09.11	ISSUED FOR SI#022
30	2025.09.15	ISSUED FOR SI#023
31	2025.09.16	ISSUED FOR PCN #35 - CO#023
32	2025.09.30	ISSUED FOR PCN #37 - CO#029
33	2025.09.30	ISSUED FOR PCN #38 - CO#025
34	2025.10.06	ISSUED FOR PCN #39 - CO#024
35	2025.10.20	ISSUED FOR PCN #40R1
36	2025.10.30	ISSUED FOR PCN#041
37	2025.10.23	ISSUED FOR PCN #42
38	2025.11.21	ISSUED FOR PCN#021/R1 - CO12 CD#006
39	2025.11.14	ISSUED FOR PCN#043
40	2025.11.26	ISSUED FOR PCN#043R1
41	2025.12.03	ISSUED FOR PCN#044 - CO#026
42	2026.02.04	ISSUED FOR RECORD SET UP TO CO#27

NOTES:

KEY PLAN:

Reproduction of drawings and related documents in whole or in part is forbidden without written permission of the Ventin Group.

All dimensions and measurements must be checked and verified by the General Contractor

Near North District School Board

CLIENT:
NEAR NORTH DISTRICT SCHOOL BOARD
NNDSB Tender # 2023-015

PROJECT:
NEW PARRY SOUND K-12 SCHOOL & CHILDCARE

PARRY SOUND HIGH SCHOOL SITE

111 ISABELLA STREET
PARRY SOUND, ONTARIO

ORIGINAL PAGE SIZE ARCH E1 - 30" x 42"

KEY TO DETAIL LOCATION:
(A / B) A - DETAIL NO. B - DETAIL NO. ORIGIN


+VG ARCHITECTS
THE VENTIN GROUP LTD

MILLWORK ELEVATIONS

ID4.4


DRAWN BY : NK/PS CHECKED BY : EB

Plot Date: Feb 03, 2026 - 5:53pm By: jkelly Filename: K:\1VG-Brantford\Near North DSB Parry Sound School\21111\Drawings\Wd-Current\1VN - ID4.3_Millwork Elevations_IK.dwg

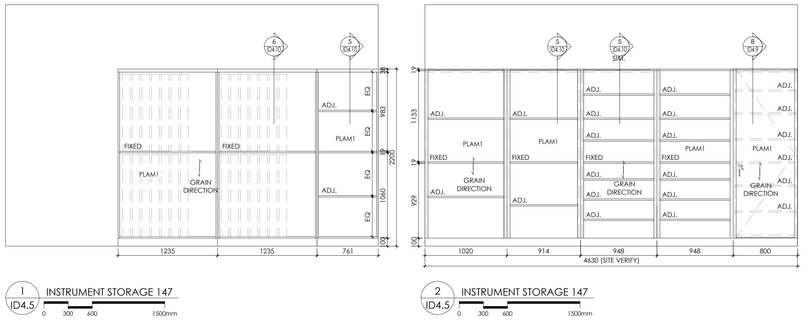


1 ID4.5 INSTRUMENT STORAGE 147
0 300 600 1500mm


2 ID4.5 INSTRUMENT STORAGE 147
0 300 600 1500mm

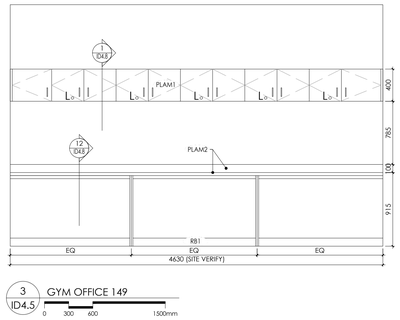


3 ID4.5 GYM OFFICE 149
0 300 600 1500mm

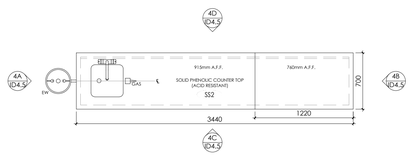


4 ID4.5 SCIENCE TEACHER DESK DETAIL PLAN
0 300 600 1500mm

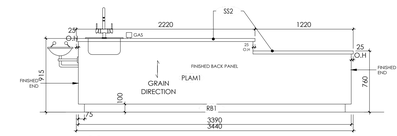


4C ID4.5 SCIENCE DESK ELEV.
0 300 600 1500mm

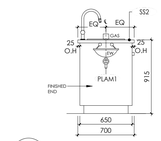


4A ID4.5 SCIENCE DESK ELEV.
0 300 600 1500mm

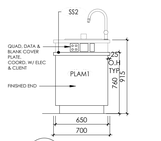

4B ID4.5 SCIENCE DESK ELEV.
0 300 600 1500mm

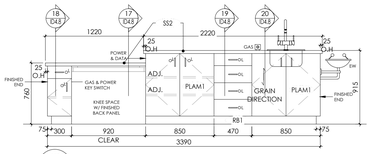


4D ID4.5 SCIENCE DESK ELEV.
0 300 600 1500mm

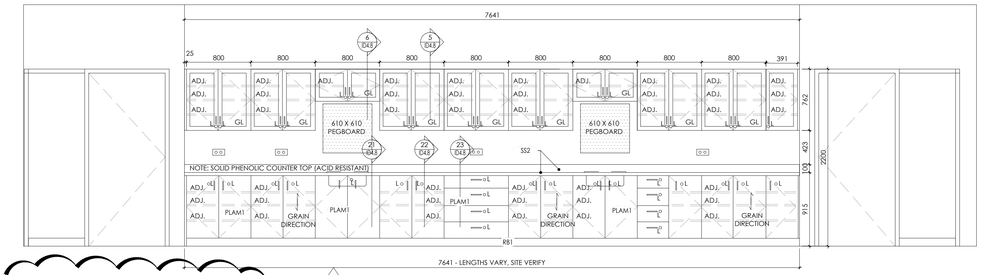

5 ID4.5 GENERAL SCIENCE 215 & 217
0 300 600 1500mm

13


▲ COORD. WIDTH W/ MECH SPECS & DWGS

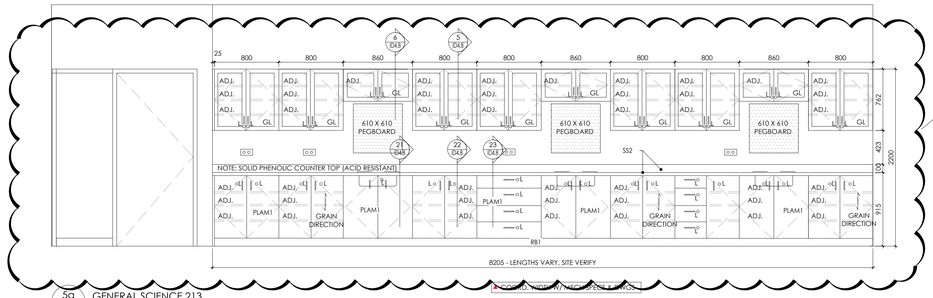


5a ID4.5 GENERAL SCIENCE 213
0 300 600 1500mm


13

▲ COORD. WIDTH W/ MECH SPECS & DWGS

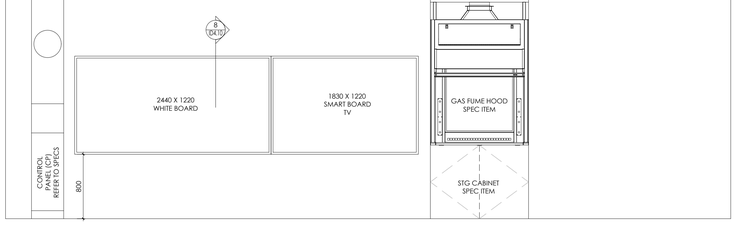


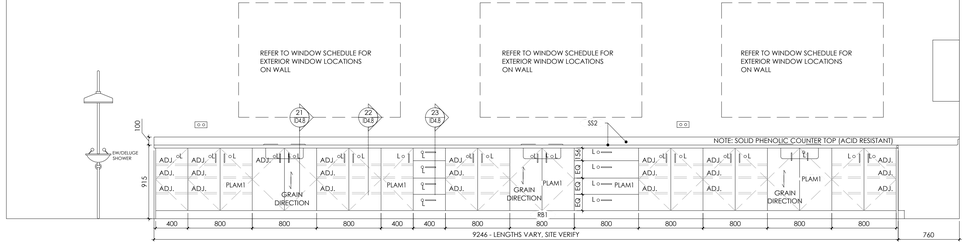


6 ID4.5 GENERAL SCIENCE 217
0 300 600 1500mm

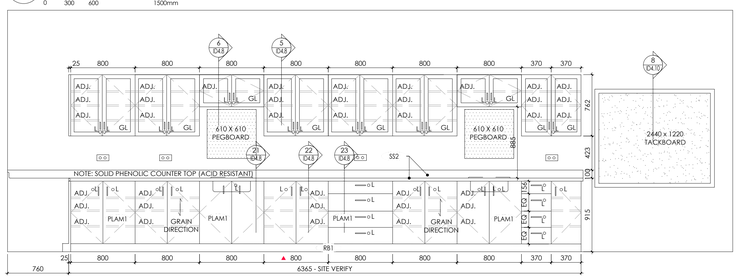

7 ID4.5 GENERAL SCIENCE 213,215 & 217
0 300 600 1500mm

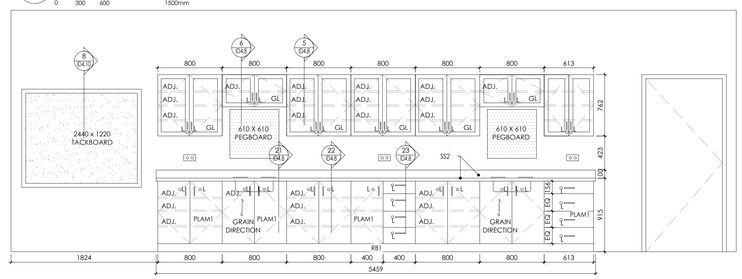


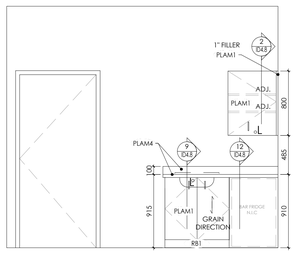

10 ID4.5 CHILDCARE STAFF 186
0 300 600 1500mm


8 ID4.5 GENERAL SCIENCE 217
0 300 600 1500mm

▲ COORD. WIDTH W/ MECH SPECS & DWGS

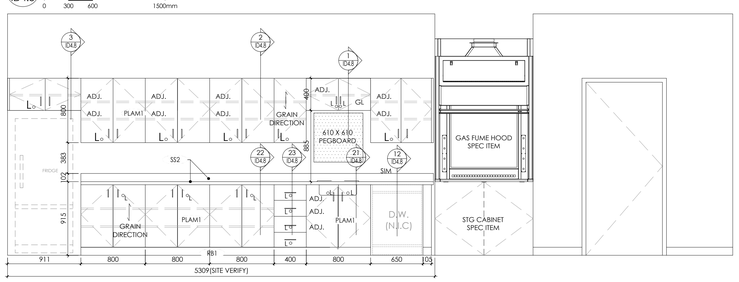


11 ID4.5 SCIENCE PREP 216
0 300 600 1500mm

9 ID4.5 GENERAL SCIENCE 215
0 300 600 1500mm

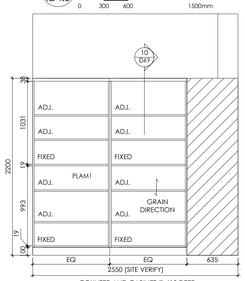


COUNTER AND CABINET @ 610 DEEP

12A ID4.5 ACADEMIC STORAGE 226
0 300 600 1500mm

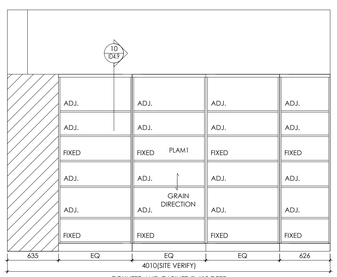

COUNTER AND CABINET @ 610 DEEP

12B ID4.5 ACADEMIC STORAGE 226
0 300 600 1500mm

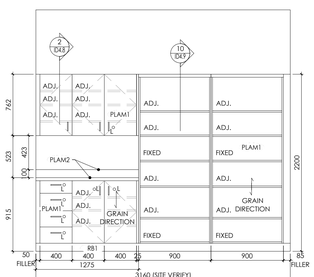

COUNTER AND CABINET @ 610 DEEP

13 ID4.5 RESOURCE 228
0 300 600 1500mm

REVISIONS

NO.	DATE	PARTICULAR
1	2022.06.06	ISSUED FOR 80% CLASS B COSTING
2	2022.08.18	ISSUED FOR SPA
3	2022.09.22	ISSUED FOR OWNERS REVIEW - 98% SET
4	2022.12.16	ISSUED FOR 2nd SPA SUBMISSION
5	2023.01.31	ISSUED FOR TENDER
6	2023.02.22	ISSUED FOR ADDENDUM 9
7	2023.08.23	ISSUED FOR CONVENIENCE
8	2023.11.20	ISSUED FOR PERMIT COMMENTS
9	2024.01.24	ISSUED FOR SI#03
10	2024.02.15	ISSUED FOR PCN#008
11	2024.03.04	ISSUED FOR PCN#009
12	2024.03.10	ISSUED FOR SI#004
13	2024.05.14	ISSUED FOR SI#006
14	2024.07.22	ISSUED FOR SI#008
15	2024.08.07	ISSUED FOR SI#009
16	2024.10.02	ISSUED FOR PCN#15
17	2025.04.11	ISSUED FOR PCN#019
18	2025.05.01	ISSUED FOR CO#07
19	2025.05.28	ISSUED FOR PCN#20 - CO#010
20	2025.07.31	ISSUED FOR SI#013
21	2025.08.06	ISSUED FOR SI#014
22	2025.08.15	ISSUED FOR PCN#25 - CO#017
23	2025.08.25	ISSUED FOR PCN#27 - CO#021
24	2025.09.02	ISSUED FOR PCN#29
25	2025.09.02	ISSUED FOR SI#20 - CO#018
26	2025.09.08	ISSUED FOR PCN#31
27	2025.09.09	ISSUED FOR PCN#32 - CO#022
28	2025.09.10	ISSUED FOR PCN#33
29	2025.09.11	ISSUED FOR SI#022
30	2025.09.15	ISSUED FOR SI#023
31	2025.09.16	ISSUED FOR PCN #35 - CO#023
32	2025.09.30	ISSUED FOR PCN #37 - CO#029
33	2025.09.30	ISSUED FOR PCN #38 - CO#025
34	2025.10.06	ISSUED FOR PCN #39 - CO#024
35	2025.10.20	ISSUED FOR PCN #40R1
36	2025.10.30	ISSUED FOR PCN#041
37	2025.10.23	ISSUED FOR PCN #42
38	2025.11.21	ISSUED FOR PCN#021/R1 - CO12 CD#006
39	2025.11.14	ISSUED FOR PCN#043
40	2025.11.26	ISSUED FOR PCN#043R1
41	2025.12.03	ISSUED FOR PCN#044 - CO#026
42	2026.02.04	ISSUED FOR RECORD SET UP TO CO#27

NOTES:

KEY PLAN:

Reproduction of drawings and related documents in whole or in part is forbidden without written permission of The Ventin Group.

All dimensions and measurements must be checked and verified by the General Contractor

Plot Date: Feb 03, 2026 - 5:53pm By: jkelly Filename: K:\VG-Brantford\Near North D38 Parry Sound School\22111\Drawings\Wd-Current\NN - ID4.3_Millwork Elevations_JK.dwg

Near North District School Board

CLIENT:
NEAR NORTH DISTRICT SCHOOL BOARD
NNDSB Tender # 2023-015

PROJECT:
NEW PARRY SOUND K-12 SCHOOL & CHILDCARE

PARRY SOUND HIGH SCHOOL SITE

111 ISABELLA STREET
PARRY SOUND, ONTARIO


ORIGINAL PAGE SIZE ARCH E1 - 30" x 42"
KEY TO DETAIL LOCATION:
(A) A - DETAIL NO.
(B) B - DETAIL NO. ORIGIN

+VG ARCHITECTS
THE VENTIN GROUP LTD

MILLWORK ELEVATIONS

ID4.5


DRAWN BY : NK/PS CHECKED BY : EB

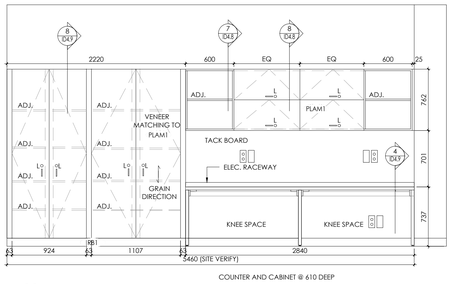

COUNTER AND CABINET @ 610 DEEP


1 ID4.6 RESOURCE 228

0 300 600 1500mm

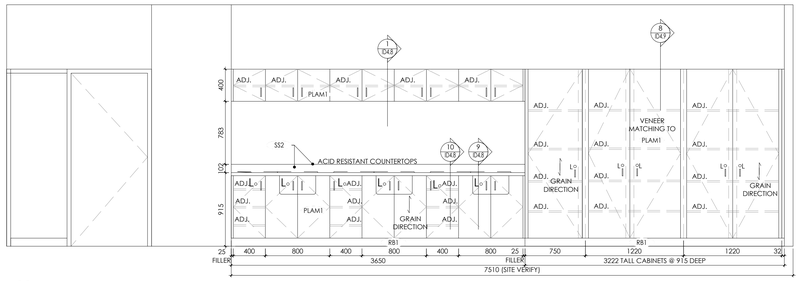


2 ID4.6 FINE ART CLASS. 224

0 300 600 1500mm

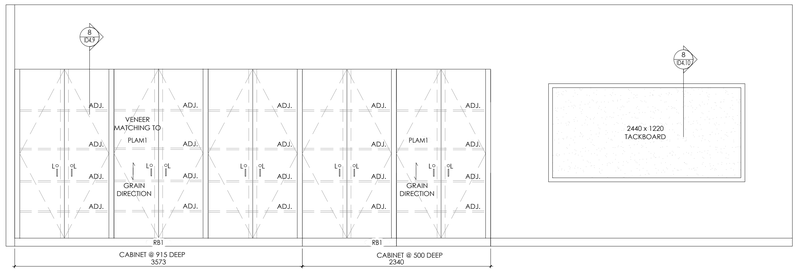


3 ID4.6 FINE ART CLASS. 224

0 300 600 1500mm

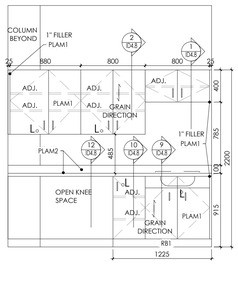

4 ID4.6 THE HIVE 250


0 300 600 1500mm

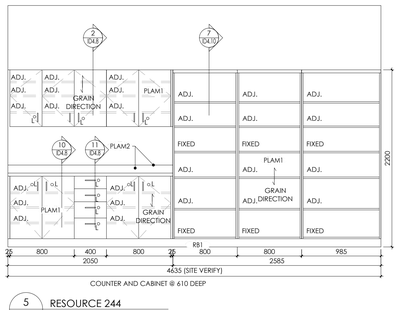

COUNTER AND CABINET @ 610 DEEP


5 ID4.6 RESOURCE 244

0 300 600 1500mm

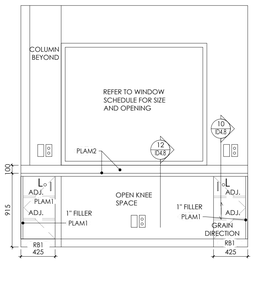


6 ID4.6 CONTROL ROOM 225.3

0 300 600 1500mm

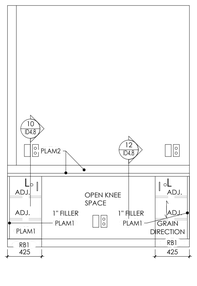


7 ID4.6 SOUND EDIT 225.2

0 300 600 1500mm

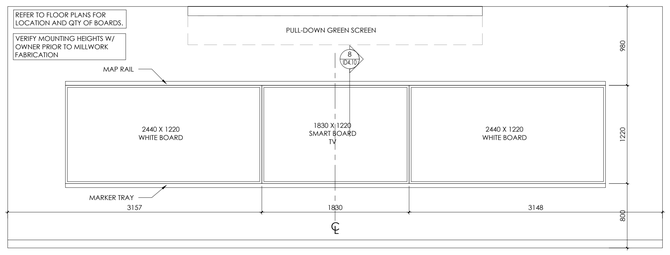


8 ID4.6 MEDIA ARTS & DRAMA 225

0 300 600 1500mm

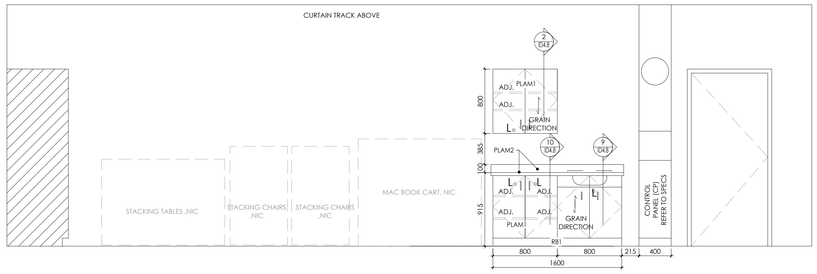


9 ID4.6 MEDIA ARTS & DRAMA 225

0 300 600 1500mm

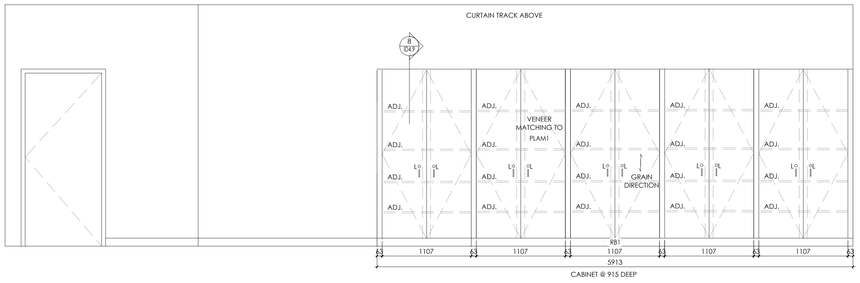


10 ID4.6 MEDIA ARTS & DRAMA 225

0 300 600 1500mm

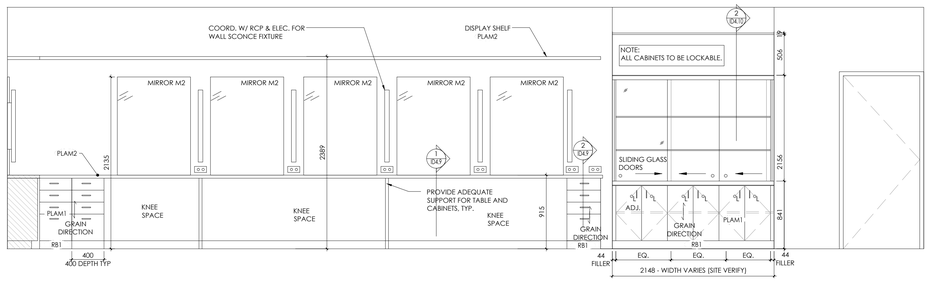


11 ID4.6 COSMETOLOGY 112

0 300 600 1500mm

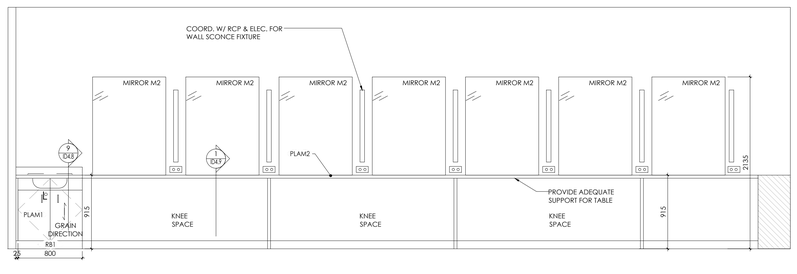


12 ID4.6 COSMETOLOGY 112

0 300 600 1500mm

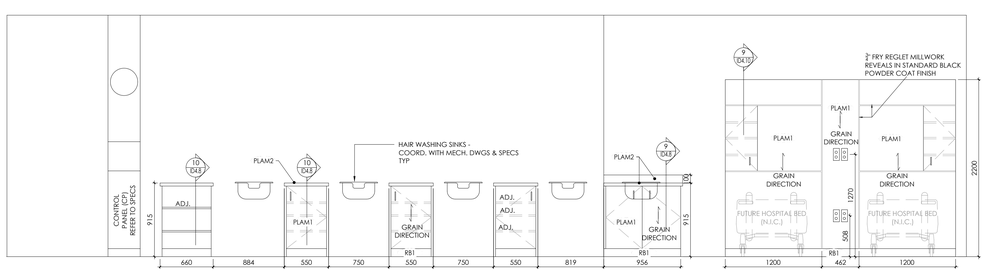

13 ID4.6 COSMETOLOGY 112

0 300 600 1500mm

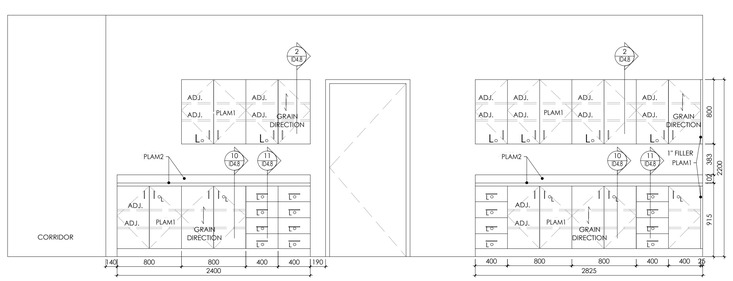

14 ID4.6 ADMIN. OFFICE 103 - STORAGE ELEV.

0 300 600 1500mm

REVISIONS

NO.	DATE	PARTICULAR
1	2022.06.06	ISSUED FOR 80% CLASS B COSTING
2	2022.08.18	ISSUED FOR SPA
3	2022.09.22	ISSUED FOR OWNERS REVIEW - 98% SET
4	2022.12.16	ISSUED FOR 2nd SPA SUBMISSION
5	2023.01.31	ISSUED FOR TENDER
6	2023.02.22	ISSUED FOR ADDENDUM 9
7	2023.08.23	ISSUED FOR CONVENIENCE
8	2023.11.20	ISSUED FOR PERMIT COMMENTS
9	2024.01.24	ISSUED FOR SI#03
10	2024.02.15	ISSUED FOR PCN#008
11	2024.03.04	ISSUED FOR PCN#009
12	2024.03.10	ISSUED FOR SI#004
13	2024.05.14	ISSUED FOR SI#006
14	2024.07.22	ISSUED FOR SI#008
15	2024.08.07	ISSUED FOR SI#009
16	2024.10.02	ISSUED FOR PCN#15
17	2025.04.11	ISSUED FOR PCN#019
18	2025.05.01	ISSUED FOR CO#07
19	2025.05.28	ISSUED FOR PCN#20 - CO#010
20	2025.07.31	ISSUED FOR SI#013
21	2025.08.06	ISSUED FOR SI#014
22	2025.08.15	ISSUED FOR PCN#25 - CO#017
23	2025.08.25	ISSUED FOR PCN#27 - CO#021
24	2025.09.02	ISSUED FOR PCN#29
25	2025.09.02	ISSUED FOR SI#20 - CO#018
26	2025.09.08	ISSUED FOR PCN#31
27	2025.09.09	ISSUED FOR PCN#32 - CO#022
28	2025.09.10	ISSUED FOR PCN#33
29	2025.09.11	ISSUED FOR SI#022
30	2025.09.15	ISSUED FOR SI#023
31	2025.09.16	ISSUED FOR PCN #35 - CO#023
32	2025.09.30	ISSUED FOR PCN #37 - CO#029
33	2025.09.30	ISSUED FOR PCN #38 - CO#025
34	2025.10.06	ISSUED FOR PCN #39 - CO#024
35	2025.10.20	ISSUED FOR PCN #40#1
36	2025.10.30	ISSUED FOR PCN#041
37	2025.10.23	ISSUED FOR PCN #42
38	2025.11.21	ISSUED FOR PCN#021/R1 - CO12 CD#006
39	2025.11.14	ISSUED FOR PCN#043
40	2025.11.26	ISSUED FOR PCN#043R1
41	2025.12.03	ISSUED FOR PCN#044 - CO#026
42	2026.02.04	ISSUED FOR RECORD SET UP TO CO#27

NOTES:

KEY PLAN:

All dimensions and measurements must be checked and verified by the General Contractor

Reproduction of drawings and related documents in whole or in part is forbidden without written permission of the VentinGroup.

Near North District School Board

CLIENT:
NEAR NORTH DISTRICT SCHOOL BOARD
NNDSB Tender # 2023-015

PROJECT:
NEW PARRY SOUND K-12 SCHOOL & CHILDCARE

PARRY SOUND HIGH SCHOOL SITE

111 ISABELLA STREET
PARRY SOUND, ONTARIO

ORIGINAL PAGE SIZE ARCH E1 - 30" x 42"

KEY TO DETAIL LOCATION:
A - DETAIL NO.
B - DETAIL NO. ORIGIN


+VG ARCHITECTS
THE VENTIN GROUP LTD

MILLWORK ELEVATIONS

ID4.6


DRAWN BY : NK/PS CHECKED BY : EB

Plot Date: Feb 03, 2026 - 5:53pm By: jkelly Filename: K:\VG-Brantford\Near North DSB Parry Sound School\2211\Drawings\Wrk-Current\VN - ID4.3_Millwork Elevations.JK.dwg

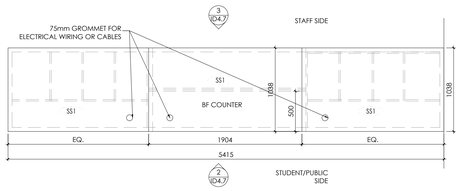


1 ID4.7 ADMIN. OFFICE 103 - RECEPTION DESK PLAN

0 300 600 1500mm

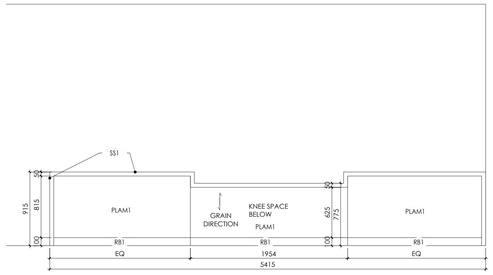


2 ID4.7 ADMIN. OFFICE 103 - RECEPTION DESK ELEV.

0 300 600 1500mm

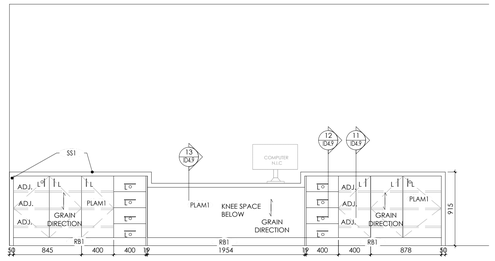


3 ID4.7 ADMIN. OFFICE 103 - RECEPTION DESK ELEV.

0 300 600 1500mm

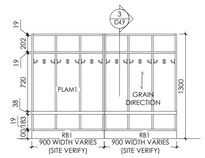


4 ID4.7 TYP. KINDERGARTEN CUBBY ELEV.

0 300 600 1500mm

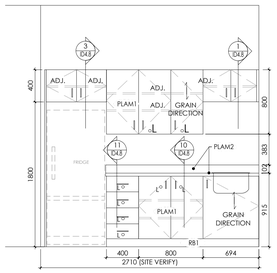


5 ID4.7 INFANT ROOM 193

0 300 600 1500mm

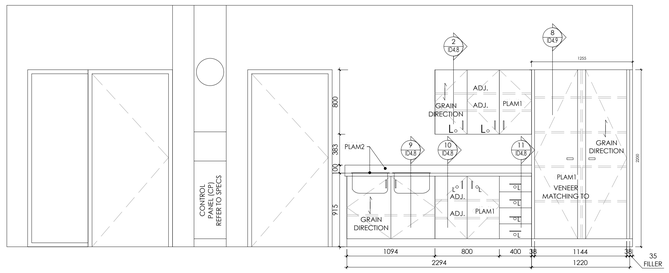


6 ID4.7 INDIGENOUS CLASSROOM 203 - WEST ELEV.

0 300 600 1500mm

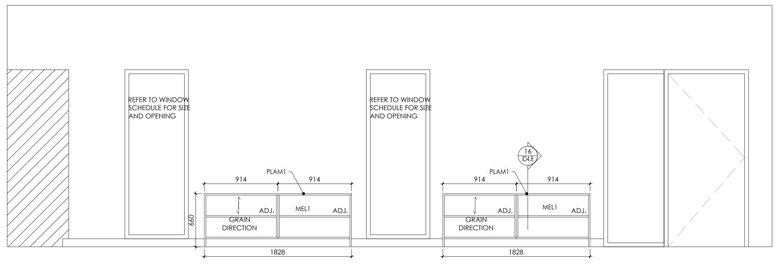


7 ID4.7 INDIGENOUS CLASSROOM 203 - NORTH ELEV

0 300 600 1500mm

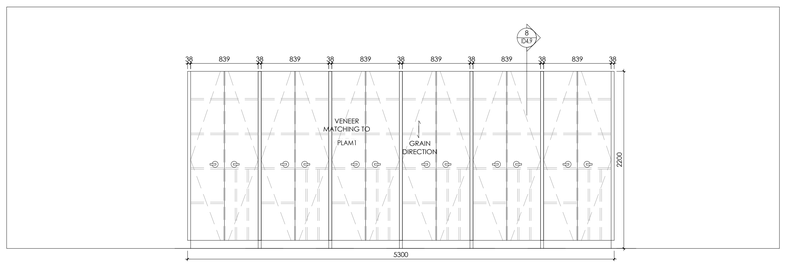

8 ID4.7 INDIGENOUS CLASSROOM 203 - EAST ELEV.

0 300 600 1500mm

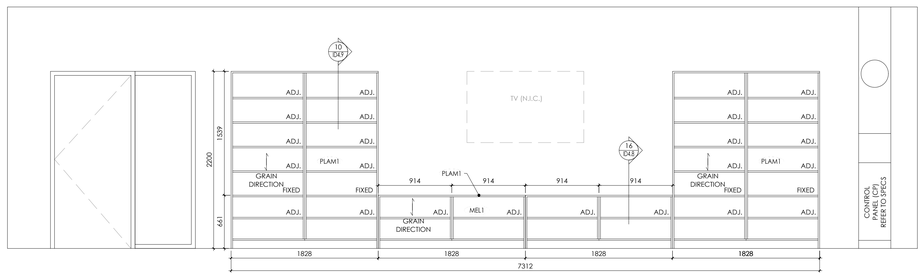

9 ID4.7 LEARNING COMMONS 251 - BOOK SHELVES

0 300 600 1500mm

10 ID4.7 LEARNING COMMONS 251 - BOOK SHELVES


0 300 600 1500mm

11 ID4.7 TYP. BALL STORAGE UNIT ELEVATION


0 300 600 1500mm

12 ID4.7 GYM STORAGE UNIT ELEVATION

0 300 600 1500mm

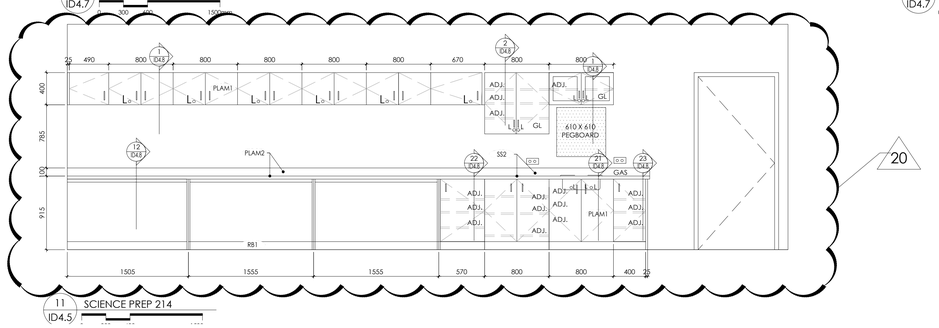

11 ID4.5/ SCIENCE PREP 214

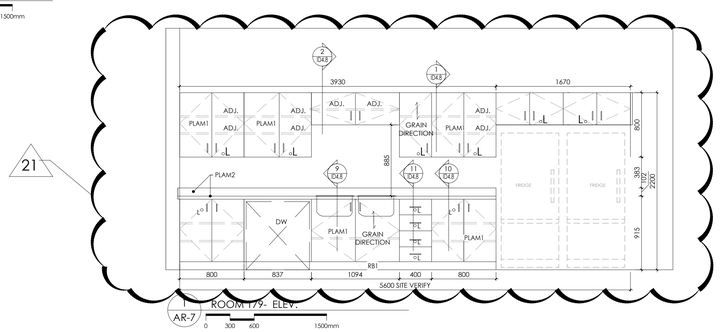

1 AR-7 ROOM 179 - ELEV.

0 300 600 1500mm

REVISIONS

NO.	DATE	PARTICULAR
1	2022.06.06	ISSUED FOR 80% CLASS B COSTING
2	2022.08.18	ISSUED FOR SPA
3	2022.09.22	ISSUED FOR OWNERS REVIEW - 98% SET
4	2022.12.16	ISSUED FOR 2nd SPA SUBMISSION
5	2023.01.31	ISSUED FOR TENDER
6	2023.02.22	ISSUED FOR ADDENDUM 9
7	2023.08.23	ISSUED FOR CONVENIENCE
8	2023.11.20	ISSUED FOR PERMIT COMMENTS
9	2024.01.24	ISSUED FOR SI#03
10	2024.02.15	ISSUED FOR PCN#008
11	2024.03.04	ISSUED FOR PCN#009
12	2024.03.10	ISSUED FOR SI#004
13	2024.05.14	ISSUED FOR SI#006
14	2024.07.22	ISSUED FOR SI#008
15	2024.08.07	ISSUED FOR SI#009
16	2024.10.02	ISSUED FOR PCN#15
17	2025.04.11	ISSUED FOR PCN#019
18	2025.05.01	ISSUED FOR CO#07
19	2025.05.28	ISSUED FOR PCN#20 - CO#010
20	2025.07.31	ISSUED FOR SI#013
21	2025.08.06	ISSUED FOR SI#014
22	2025.08.15	ISSUED FOR PCN#25 - CO#017
23	2025.08.25	ISSUED FOR PCN#27 - CO#021
24	2025.09.02	ISSUED FOR PCN#29
25	2025.09.02	ISSUED FOR SI#20 - CO#018
26	2025.09.08	ISSUED FOR PCN#31
27	2025.09.09	ISSUED FOR PCN#32 - CO#022
28	2025.09.10	ISSUED FOR PCN#33
29	2025.09.11	ISSUED FOR SI#022
30	2025.09.15	ISSUED FOR SI#023
31	2025.09.16	ISSUED FOR PCN #35 - CO#023
32	2025.09.30	ISSUED FOR PCN #37 - CO#029
33	2025.09.30	ISSUED FOR PCN #38 - CO#025
34	2025.10.06	ISSUED FOR PCN #39 - CO#024
35	2025.10.20	ISSUED FOR PCN #4081
36	2025.10.30	ISSUED FOR PCN#041
37	2025.10.23	ISSUED FOR PCN #42
38	2025.11.21	ISSUED FOR PCN#021/R1 - CO12 CD#006
39	2025.11.14	ISSUED FOR PCN#043
40	2025.11.26	ISSUED FOR PCN#043R1
41	2025.12.03	ISSUED FOR PCN#044 - CO#026
42	2026.02.04	ISSUED FOR RECORD SET UP TO CO#27

NOTES:

KEY PLAN:

All dimensions and measurements must be checked and verified by the General Contractor

Reproduction of drawings and related documents in whole or in part is forbidden without written permission of the Ventin Group.

Near North District School Board

CLIENT:
NEAR NORTH DISTRICT SCHOOL BOARD
NNDSB Tender # 2023-015

PROJECT:
NEW PARRY SOUND K-12 SCHOOL & CHILDCARE

PARRY SOUND HIGH SCHOOL SITE

111 ISABELLA STREET
PARRY SOUND, ONTARIO

ORIGINAL PAGE SIZE ARCH E1 - 30" x 42"
KEY TO DETAIL LOCATION:
(A) A - DETAIL NO.
(B) B - DETAIL NO. ORIGIN


+VG ARCHITECTS
THE VENTIN GROUP LTD

MILLWORK ELEVATIONS


ID4.7

Plot Date: Feb 03, 2026 - 5:53pm By: jkelly
Filename: K:\1VG-Brantford-Near North DSB Parry Sound School\2211\1Drawings\1WG-Current\NN - ID4.3_Millwork Elevations-JK.dwg


DRAWN BY : NK/PS CHECKED BY : EB

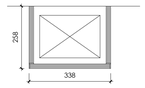


4 ID4.8 RANGE HOOD EXHAUST DETAIL
0 100 200 500mm

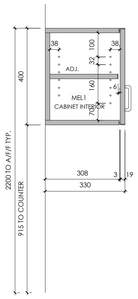


1 ID4.8 UPPER CABINET
0 100 200 500mm

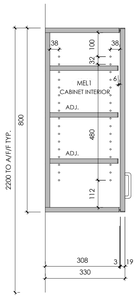


2 ID4.8 FULL UPPER WITH DOOR
0 100 200 500mm

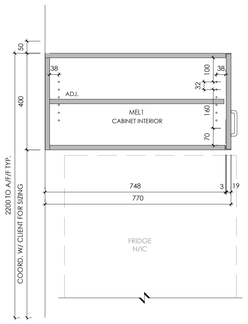


3 ID4.8 UPPER AT FRIDGE
0 100 200 500mm

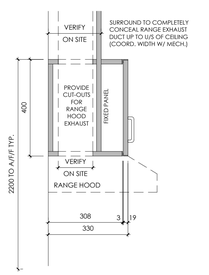


4 ID4.8 UPPER AT RANGE HOOD
0 100 200 500mm

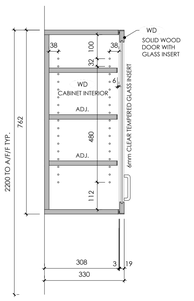


5 ID4.8 UPPER W/ GLASS DOOR
0 100 200 500mm

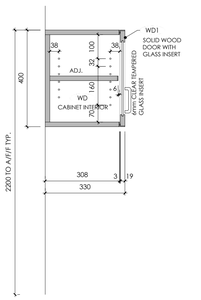


6 ID4.8 UPPER @ SINK, FRIDGE W/ GLASS DOOR
0 100 200 500mm

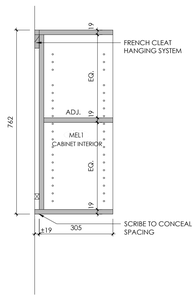


7 ID4.8 OPEN FULL UPPER
0 100 200 500mm

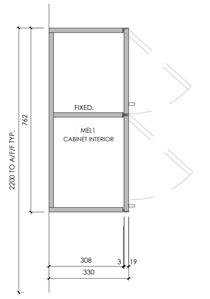


8 ID4.8 OPEN FULL UPPER
0 100 200 500mm

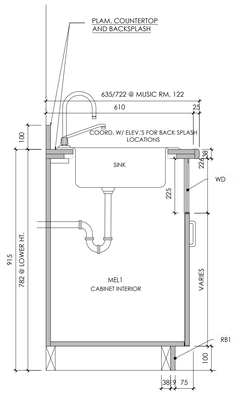


9 ID4.8 BASE @ SINK
0 100 200 500mm

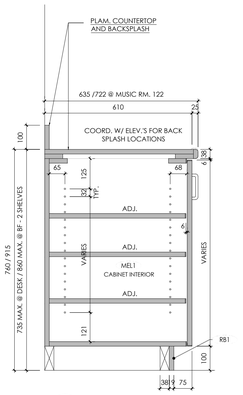


10 ID4.8 BASE WITH/ WITHOUT SHELVES
0 100 200 500mm

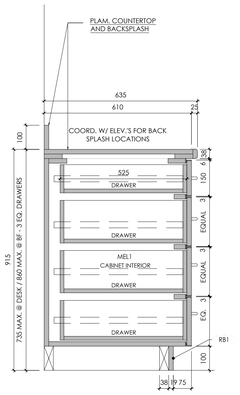


11 ID4.8 BASE WITH DRAWERS
0 100 200 500mm

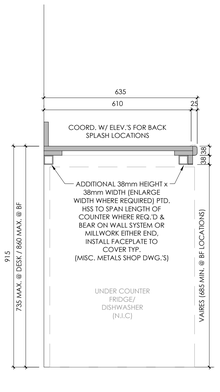


12 ID4.8 BASE @ DISHWASHER/BAR FRIDGE
0 100 200 500mm

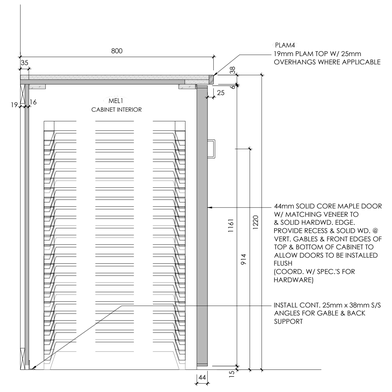


13 ID4.8 COT STORAGE SECTION
0 100 200 500mm

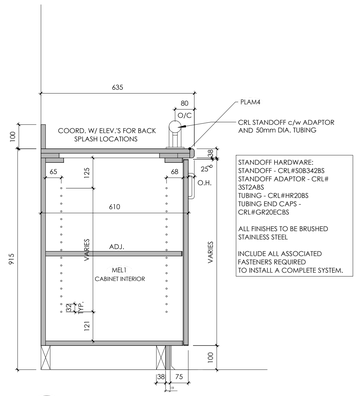


14 ID4.8 CHANGE TABLE SECTION
0 100 200 500mm

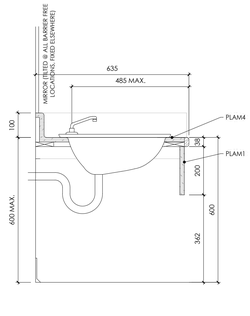


15 ID4.8 INFANT, TODDLER, PRESCHOOL LAVATORY
0 100 200 500mm

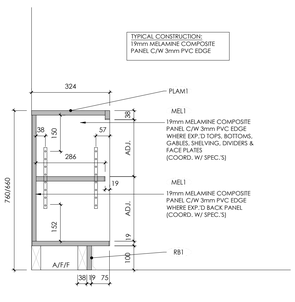


16 ID4.8 LOW SHELF SECTION
0 100 200 500mm

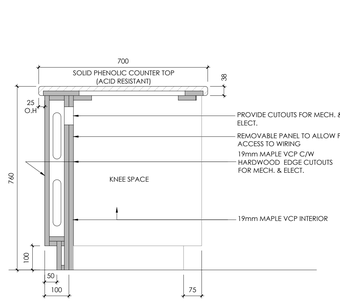


17 ID4.8 SCIENCE DESK SECTION @ KNEE SPACE
0 100 200 500mm

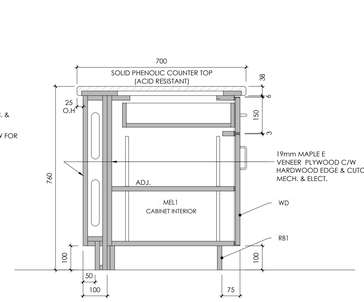


18 ID4.8 SCIENCE DESK SECTION
0 100 200 500mm

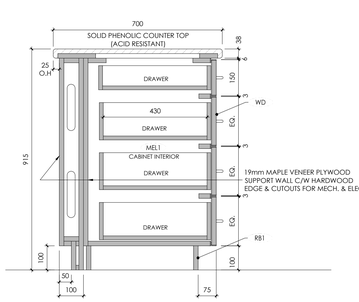


19 ID4.8 SCIENCE DESK SECTION @ DRAWERS
0 100 200 500mm

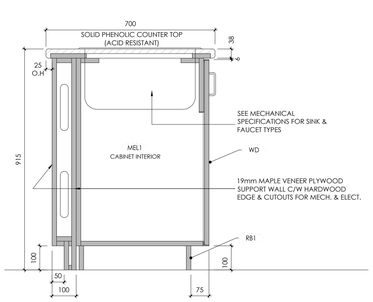


20 ID4.8 SCIENCE DESK SECTION @ SINK
0 100 200 500mm

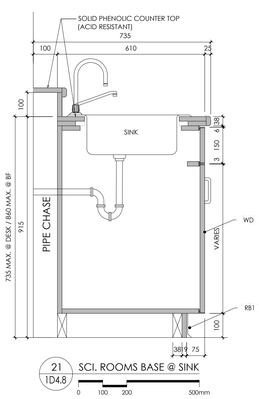

21 ID4.8 SCI. ROOMS BASE @ SINK
0 100 200 500mm

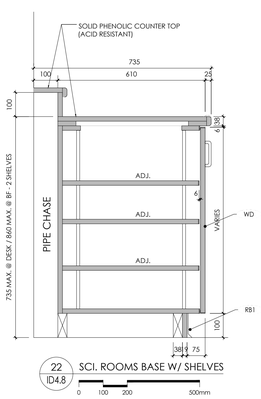

22 ID4.8 SCI. ROOMS BASE W/ SHELVES
0 100 200 500mm

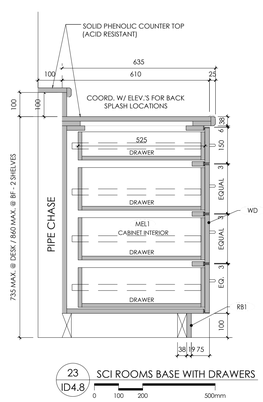

23 ID4.8 SCI ROOMS BASE WITH DRAWERS
0 100 200 500mm

REVISIONS

NO.	DATE	PARTICULAR
1	2022.06.06	ISSUED FOR 80% CLASS B COSTING
2	2022.08.18	ISSUED FOR SPA
3	2022.09.22	ISSUED FOR OWNERS REVIEW - 98% SET
4	2022.12.16	ISSUED FOR 2nd SPA SUBMISSION
5	2023.01.31	ISSUED FOR TENDER
6	2023.02.22	ISSUED FOR ADDENDUM 9
7	2023.08.23	ISSUED FOR CONVENIENCE
8	2023.11.20	ISSUED FOR PERMIT COMMENTS
9	2024.01.24	ISSUED FOR SI#03
10	2024.02.15	ISSUED FOR PCN#008
11	2024.03.04	ISSUED FOR PCN#009
12	2024.03.10	ISSUED FOR SI#004
13	2024.05.14	ISSUED FOR SI#006
14	2024.07.22	ISSUED FOR SI#008
15	2024.08.07	ISSUED FOR SI#009
16	2024.10.02	ISSUED FOR PCN#15
17	2025.04.11	ISSUED FOR PCN#019
18	2025.05.01	ISSUED FOR CO#07
19	2025.05.28	ISSUED FOR PCN#20 - CO#010
20	2025.07.31	ISSUED FOR SI#013
21	2025.08.06	ISSUED FOR SI#014
22	2025.08.15	ISSUED FOR PCN#25 - CO#017
23	2025.08.25	ISSUED FOR PCN#27 - CO#021
24	2025.09.02	ISSUED FOR PCN#29
25	2025.09.02	ISSUED FOR SI#20 - CO#018
26	2025.09.08	ISSUED FOR PCN#31
27	2025.09.09	ISSUED FOR PCN#32 - CO#022
28	2025.09.10	ISSUED FOR PCN#33
29	2025.09.11	ISSUED FOR SI#022
30	2025.09.15	ISSUED FOR SI#023
31	2025.09.16	ISSUED FOR PCN #35 - CO#023
32	2025.09.30	ISSUED FOR PCN #37 - CO#029
33	2025.09.30	ISSUED FOR PCN #38 - CO#025
34	2025.10.06	ISSUED FOR PCN #39 - CO#024
35	2025.10.20	ISSUED FOR PCN #4081
36	2025.10.30	ISSUED FOR PCN#041
37	2025.10.23	ISSUED FOR PCN #42
38	2025.11.21	ISSUED FOR PCN#021/R1 - CO12 CD#006
39	2025.11.14	ISSUED FOR PCN#043
40	2025.11.26	ISSUED FOR PCN#043R1
41	2025.12.03	ISSUED FOR PCN#044 - CO#026
42	2026.02.04	ISSUED FOR RECORD SET UP TO CO#27

NOTES:

KEY PLAN:

Reproduction of drawings and related documents in whole or in part is forbidden without written permission of The Ventin Group.

All dimensions and measurements must be checked and verified by the General Contractor

Near North District School Board

CLIENT:
NEAR NORTH DISTRICT SCHOOL BOARD
NNDSB Tender # 2023-015

PROJECT:
NEW PARRY SOUND K-12 SCHOOL & CHILDCARE

PARRY SOUND HIGH SCHOOL SITE

111 ISABELLA STREET
PARRY SOUND, ONTARIO

ORIGINAL PAGE SIZE ARCH E1 - 30" x 42"
KEY TO DETAIL LOCATION:
A - DETAIL NO.
B - DETAIL NO. ORIGIN


+VG ARCHITECTS
THE VENTIN GROUP LTD

MILLWORK SECTIONS & DETAILS


ID4.8

DRAWN BY : NK/PS CHECKED BY : EB


Plot Date: Feb 03, 2026 - 5:54pm By: jkelly Filename: K:\1VG-Brantford\Near North DSB Parry Sound School\2111\Drawings\Wd Current\NN - ID4.8_Millwork Sections.dwg

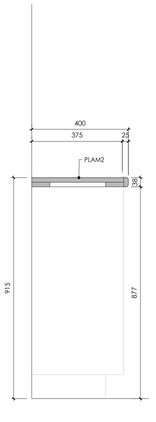


1 COSMETOLOGY OPEN BASE
ID4.9 0 100 200 500mm

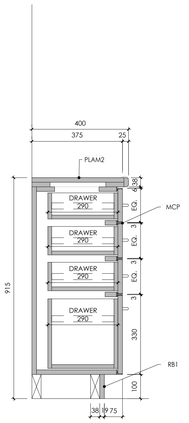


2 COSMETOLOGY BASE W/ DRAWERS
ID4.9 0 100 200 500mm

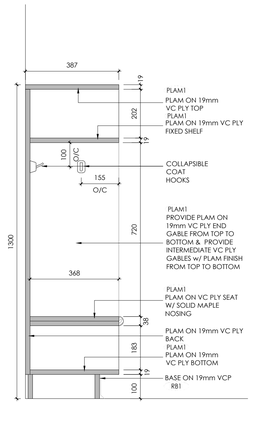


3 TYP. CUBBY SECTION
ID4.9 0 100 200 500mm

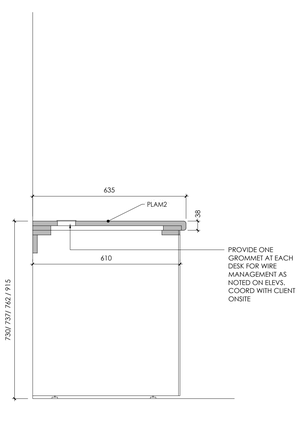


4 DESK W/ GROMMET IN COUNTER
ID4.9 0 100 200 500mm

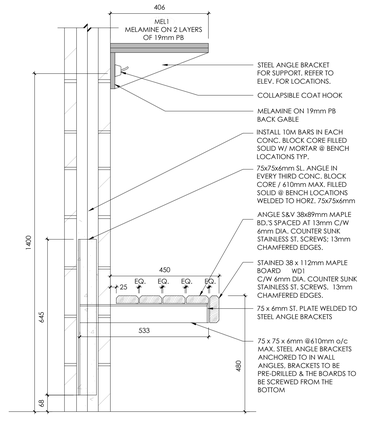

5 TYP. BENCH SECTION
ID4.9 0 100 200 500mm

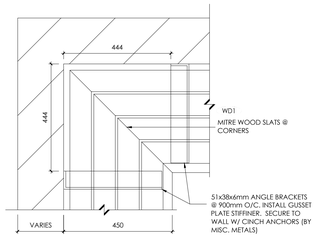

6 TYP. CHANGEROOM BENCH CORNER DETAIL
ID4.9 0 100 200 500mm

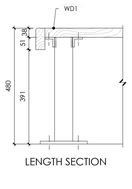

LENGTH SECTION

NOTES:


* 75 X 75 X 3.8 H.S.S. POSTS WELDED TO 200 X 200 X 10 BASE PLATES SECURED TO CONCRETE SLAB WITH WEDGE TYPE EXPANSION ANCHORS.

* SPACE POSTS +/- 900mm O.C.


* WELD 51 X 38 X 6.4 X 1000 LONG STEEL ANGLES BOTH SIDES TO SUPPORT BENCH.

* INSTALL 38 X 89 WOOD SLATS SECURED WITH WOOD SCREWS FROM UNDERSIDE.


6 TYP. CHANGEROOM BENCH SECTION
ID4.9 0 100 200 500mm

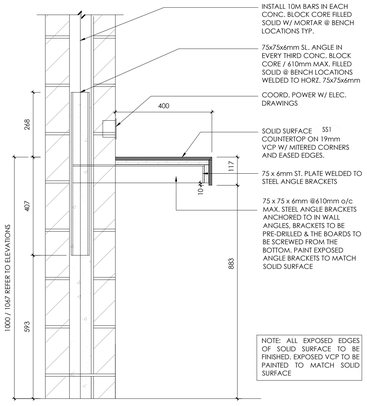


7 LAPTOP STAND UP COUNTER SECTION
ID4.9 0 100 200 500mm

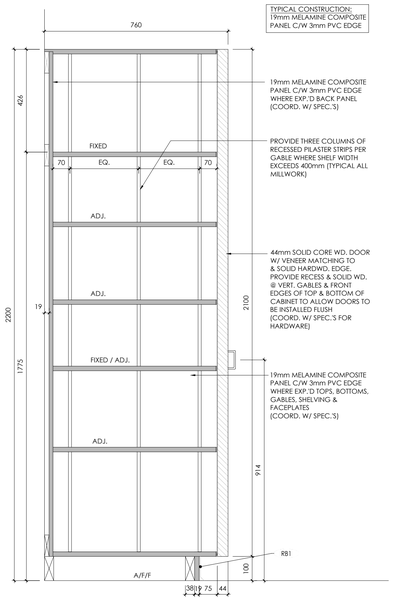


8 CLOSET SECTION DETAIL
ID4.9 0 100 200 500mm

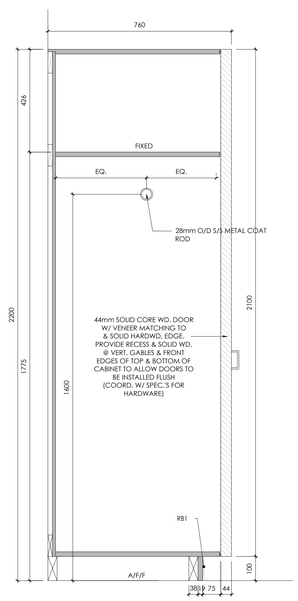


9 CLOSET SECTION DETAIL
ID4.9 0 100 200 500mm

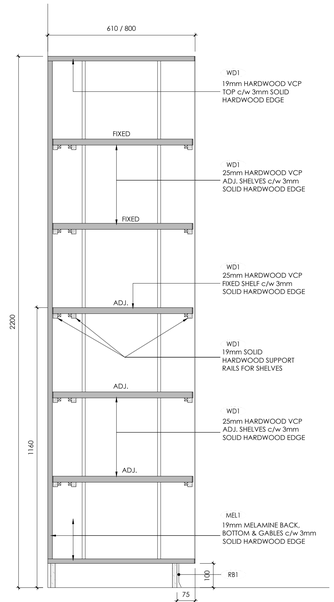


10 OPEN STORAGE SECTION
ID4.9 0 100 200 500mm

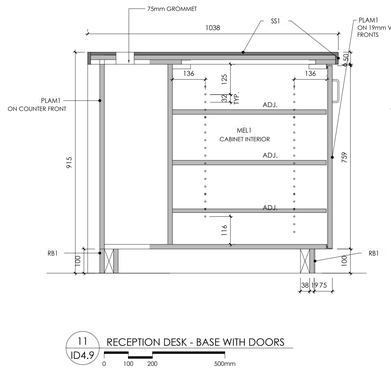


11 RECEPTION DESK - BASE WITH DOORS
ID4.9 0 100 200 500mm

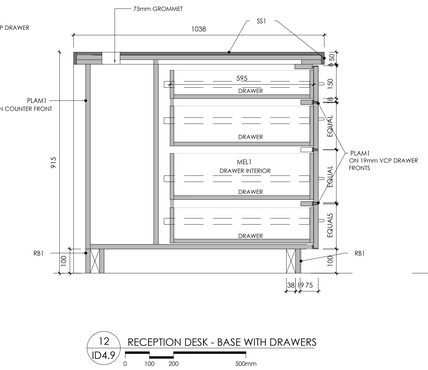

12 RECEPTION DESK - BASE WITH DRAWERS
ID4.9 0 100 200 500mm

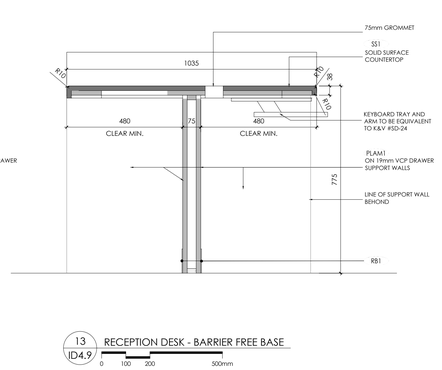

13 RECEPTION DESK - BARRIER FREE BASE
ID4.9 0 100 200 500mm

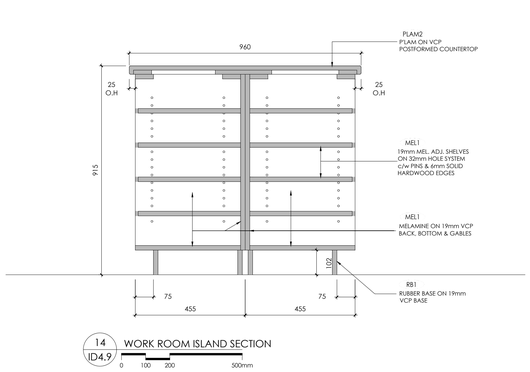

14 WORK ROOM ISLAND SECTION
ID4.9 0 100 200 500mm

REVISIONS

NO.	DATE	PARTICULAR
1	2022.06.06	ISSUED FOR 80% CLASS B COSTING
2	2022.08.18	ISSUED FOR SPA
3	2022.09.22	ISSUED FOR OWNERS REVIEW - 98% SET
4	2022.12.16	ISSUED FOR 2nd SPA SUBMISSION
5	2023.01.31	ISSUED FOR TENDER
6	2023.02.22	ISSUED FOR ADDENDUM 9
7	2023.08.23	ISSUED FOR CONVENIENCE
8	2023.11.20	ISSUED FOR PERMIT COMMENTS
9	2024.01.24	ISSUED FOR SI#03
10	2024.02.15	ISSUED FOR PCN#008
11	2024.03.04	ISSUED FOR PCN#009
12	2024.03.10	ISSUED FOR SI#004
13	2024.05.14	ISSUED FOR SI#006
14	2024.07.22	ISSUED FOR SI#008
15	2024.08.07	ISSUED FOR SI#009
16	2024.10.02	ISSUED FOR PCN#15
17	2025.04.11	ISSUED FOR PCN#019
18	2025.05.01	ISSUED FOR CO#07
19	2025.05.28	ISSUED FOR PCN#20 - CO#010
20	2025.07.31	ISSUED FOR SI#013
21	2025.08.06	ISSUED FOR SI#014
22	2025.08.15	ISSUED FOR PCN#25 - CO#017
23	2025.08.25	ISSUED FOR PCN#27 - CO#021
24	2025.09.02	ISSUED FOR PCN#29
25	2025.09.02	ISSUED FOR SI#20 - CO#018
26	2025.09.08	ISSUED FOR PCN#31
27	2025.09.09	ISSUED FOR PCN#32 - CO#022
28	2025.09.10	ISSUED FOR PCN#33
29	2025.09.11	ISSUED FOR SI#022
30	2025.09.15	ISSUED FOR SI#023
31	2025.09.16	ISSUED FOR PCN #35 - CO#023
32	2025.09.30	ISSUED FOR PCN #37 - CO#029
33	2025.09.30	ISSUED FOR PCN #38 - CO#025
34	2025.10.06	ISSUED FOR PCN #39 - CO#024
35	2025.10.20	ISSUED FOR PCN #4081
36	2025.10.30	ISSUED FOR PCN#041
37	2025.10.23	ISSUED FOR PCN #42
38	2025.11.21	ISSUED FOR PCN#021/R1 - CO12 CD#006
39	2025.11.14	ISSUED FOR PCN#043
40	2025.11.26	ISSUED FOR PCN#043R1
41	2025.12.03	ISSUED FOR PCN#044 - CO#026
42	2026.02.04	ISSUED FOR RECORD SET UP TO CO#27

NOTES:

KEY PLAN:

All dimensions and measurements must be checked and verified by the General Contractor

Reproduction of drawings and related documents in whole or in part is forbidden without written permission of the Ventin Group.

Near North District School Board

CLIENT:
NEAR NORTH DISTRICT SCHOOL BOARD
NNDSB Tender # 2023-015

PROJECT:
NEW PARRY SOUND K-12 SCHOOL & CHILDCARE

PARRY SOUND HIGH SCHOOL SITE

111 ISABELLA STREET
PARRY SOUND, ONTARIO

ORIGINAL PAGE SIZE ARCH E1 - 30" x 42"

KEY TO DETAIL LOCATION:
(A) A - DETAIL NO.
(8) B - DETAIL NO. ORIGIN


+VG ARCHITECTS
THE VENTIN GROUP LTD

MILLWORK SECTIONS & DETAILS


ID4.9

Plot Date: Feb 03, 2026 - 5:54pm By jkelly
Filename: K:\1VG-Brantford\Near North DSB Parry Sound School\2211\Drawings\Wd-Current\NN - ID4.8_Millwork Sections.dwg


DRAWN BY : NK/PS CHECKED BY : EB

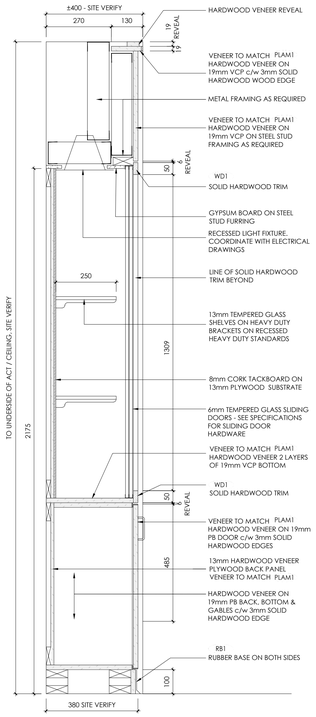


1 DISPLAY CASE SECTION
ID4.10 — 0 100 200 500mm

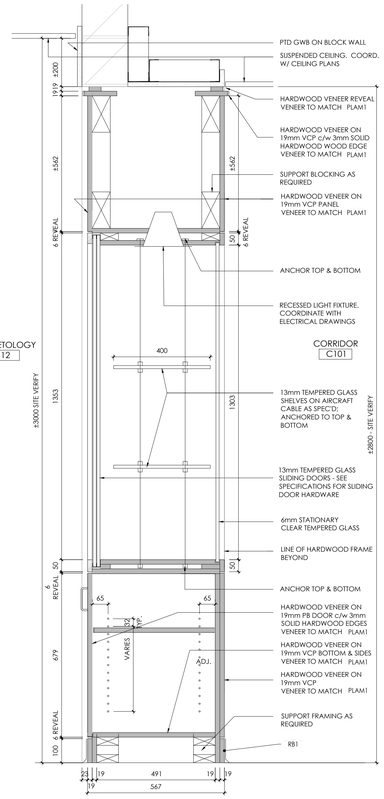


2 COSMETOLOGY DISPLAY CASE SECTION
ID4.10 — 0 100 200 500mm

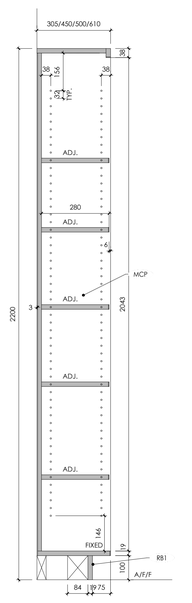


3 TALL OPEN SHELVING
ID4.10 — 0 100 200 500mm

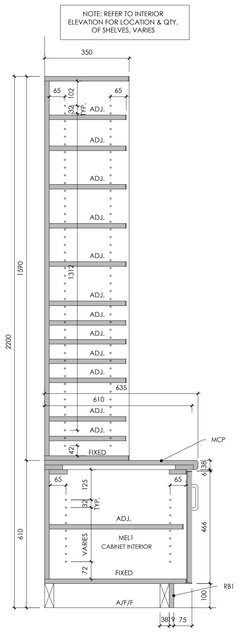


4 MAIL STORAGE SECTION
ID4.10 — 0 100 200 500mm

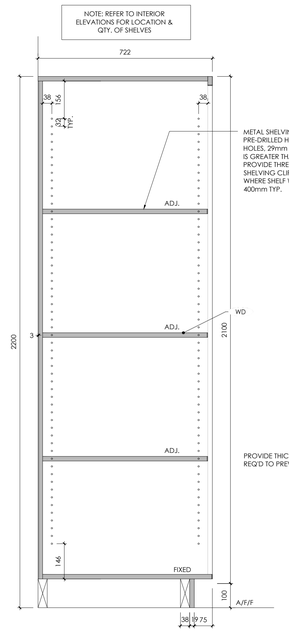


5 OPEN INSTRUMENT STORAGE
ID4.10 — 0 100 200 500mm

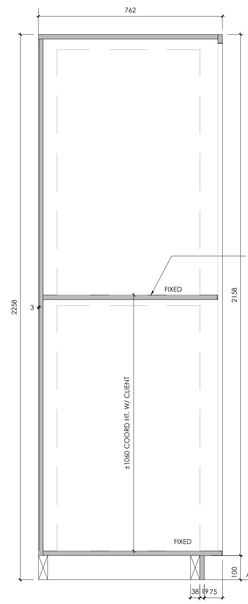


6 INSTRUMENT STORAGE
ID4.10 — 0 100 200 500mm

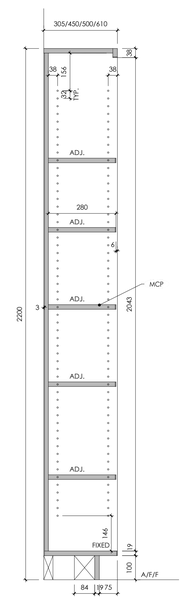


7 OPEN SHELVING
ID4.10 — 0 100 200 500mm

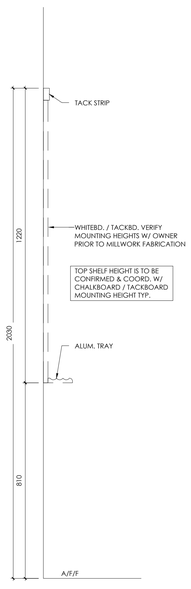


8 WHT BD./TACK BD. SECTION
ID4.10 — 0 100 200 500mm

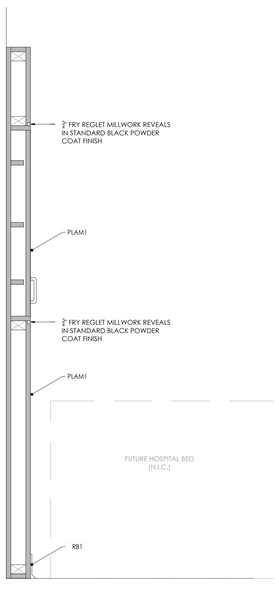


9 COSMETOLOGY 112 - HOSPITAL BED HEAD WALL
ID4.10 — 0 100 200 500mm

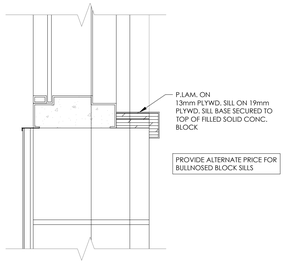


10 TYP. WINDOW SILL DETAIL
ID4.10 — 0 50 100 250mm

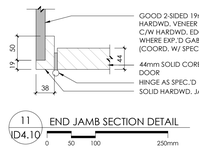


11 END JAMB SECTION DETAIL
ID4.10 — 0 50 100 250mm

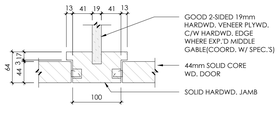

12 DOOR JAMB SECTION DETAIL
ID4.10 — 0 50 100 250mm

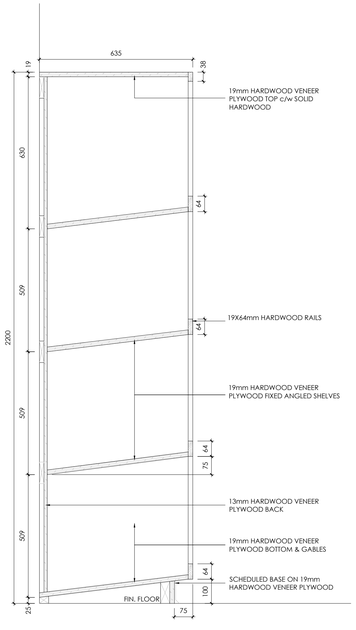

13 GYM STORAGE 152 & 153 - BALL STORAGE UNIT SECTION
ID4.10 — 0 100 200 500mm

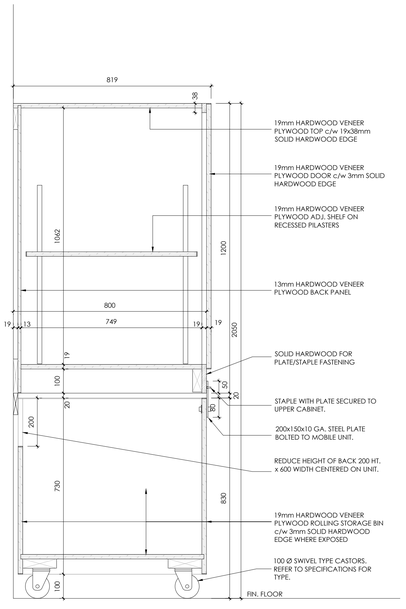

14 GYM STORAGE UNIT SECTION
ID4.10 — 0 100 200 500mm

REVISIONS

NO.	DATE	PARTICULAR
1	2022.06.06	ISSUED FOR 80% CLASS B COSTING
2	2022.08.18	ISSUED FOR SPA
3	2022.09.22	ISSUED FOR OWNERS REVIEW - 98% SET
4	2022.12.16	ISSUED FOR 2nd SPA SUBMISSION
5	2023.01.31	ISSUED FOR TENDER
6	2023.02.22	ISSUED FOR ADDENDUM 9
7	2023.08.23	ISSUED FOR CONVENIENCE
8	2023.11.20	ISSUED FOR PERMIT COMMENTS
9	2024.01.24	ISSUED FOR SI#03
10	2024.02.15	ISSUED FOR PCN#008
11	2024.03.04	ISSUED FOR PCN#009
12	2024.03.10	ISSUED FOR SI#004
13	2024.05.14	ISSUED FOR SI#006
14	2024.07.22	ISSUED FOR SI#008
15	2024.08.07	ISSUED FOR SI#009
16	2024.10.02	ISSUED FOR PCN#15
17	2025.04.11	ISSUED FOR PCN#019
18	2025.05.01	ISSUED FOR CO#07
19	2025.05.28	ISSUED FOR PCN#20 - CO#010
20	2025.07.31	ISSUED FOR SI#013
21	2025.08.06	ISSUED FOR SI#014
22	2025.08.15	ISSUED FOR PCN#25 - CO#017
23	2025.08.25	ISSUED FOR PCN#27 - CO#021
24	2025.09.02	ISSUED FOR PCN#29
25	2025.09.02	ISSUED FOR SI#20 - CO#018
26	2025.09.08	ISSUED FOR PCN#31
27	2025.09.09	ISSUED FOR PCN#32 - CO#022
28	2025.09.10	ISSUED FOR PCN#33
29	2025.09.11	ISSUED FOR SI#022
30	2025.09.15	ISSUED FOR SI#023
31	2025.09.16	ISSUED FOR PCN #35 - CO#023
32	2025.09.30	ISSUED FOR PCN #37 - CO#029
33	2025.09.30	ISSUED FOR PCN #38 - CO#025
34	2025.10.06	ISSUED FOR PCN #39 - CO#024
35	2025.10.20	ISSUED FOR PCN #40#1
36	2025.10.30	ISSUED FOR PCN#041
37	2025.10.23	ISSUED FOR PCN #42
38	2025.11.21	ISSUED FOR PCN#021/R1 - CO12 CO#006
39	2025.11.14	ISSUED FOR PCN#043
40	2025.11.26	ISSUED FOR PCN#043R1
41	2025.12.03	ISSUED FOR PCN#044 - CO#026
42	2026.02.04	ISSUED FOR RECORD SET UP TO CO#27

NOTES:

KEY PLAN:

All dimensions and measurements must be checked and verified by the General Contractor

Reproduction of drawings and related documents in whole or in part is forbidden without written permission of the Ventin Group.

MILLWORK NOTES:

COUNTERTOPS:

- TYPICAL POSTFORMED PLAM ON 19mm PLYWD. SUBSTRATE, CAULK ALL PER.'S OF COUNTER WHERE THERE IS NO BACK SPLASH
- AT SCIENCE ROOMS, SOLID SURFACE ON 19mm PLYWD. SUBSTRATE C/W SOLID SURFACE / INTEGRAL FRONT APRON & BACKSPLASH. CAULK ALL PER.'S OF COUNTER WHERE THERE IS NO BACK SPLASH
- NON-DRIP EDGE AT SINK LOCATIONS. PROVIDE END/SIDE SPLASH AT ALL END LOCATIONS & BACKSPLASH AS REQUIRED WHERE PERMITS AT COUNTERTOPS THAT CONTAIN SINKS & WHEREVER SHOWN ON ELEV.'S

CASEWORK:

1 - PROVIDE TYPICAL CABINETS OF MELAMINE COMPOSITE PANEL CONSTRUCTION W./ 3mm PVC EDGE TO MATCH WOOD GRAIN FINISH WHERE EXPOSED. REFER TO SPECIFICATIONS.

2 - PROVIDE GOOD ONE SIDED MAPLE CONSTRUCTION (GOOD 2 SIDED WHERE EXPOSED) WITH STAINED & VARNISH FINISH AND W./ HARDWD. EDGE TO MATCH AT SCIENCE CLASSROOMS, SCI. PREP ROOMS, GYM STORAGE ROOMS AND WHEREVER ELSEWHERE NOTED ON DRAWINGS. PLYWD. BACK, BOTTOM, GABLES (INTERMEDIATE & END), TOP(S), SHELVING, DRAWER FRONTS, FACEPLATES, KICK PLATES, REMOVABLE PANELS, GUSSET SUPPORTS, SUPPORT CLEATS, BLOCKING, FIXED PANELS, LIGHT VALANCES & ALL OTHER PIECES NOT NOTED WITHIN THIS LEGEND. REFER TO SPECIFICATIONS.

- 16mm PLYWD. DRAWER BOXES C/W FULL EXTENSION SLIDES
- PROVIDE 2 LAYERS OF 19mm PLYWD. TO COMPOSE SHELF FOR MICROWAVE LOCATIONS
- GLASS (GL) SHELVES & ADJ. SHELVING TO BE MOUNTED ON S/S PIN SHELF SUPPORTS.

GENERAL NOTES:

- PROVIDE A FIXED PANEL MADE OF VENEER CORE PLYWOOD BELOW ALL SINKS TO RESIST WATER DAMAGE.
- PROVIDE ALL CUT-OUTS & ACCESS PANELS IN MILLWORK AS REQ.'D FOR ELEC. & MECH. ACCESS / CONNECTIONS.
- PROVIDE ALL SUPPORT BLOCKING FOR COUNTERTOPS & MILLWORK AS REQ.'D
- COORD. W/ REFLECTED CEILING PLANS FOR BULKHEAD LOCATIONS & DEPTH
- COORD. W/ SPEC.'S FOR CABINET HARDWARE
- ALL STEEL SUPPORTING MEMBERS TO BE PTD. TYP.
- FULL EXTENSION DRAWER SLIDES TYP.

Near North District School Board

CLIENT:
NEAR NORTH DISTRICT SCHOOL BOARD
NNDSB Tender # 2023-015

PROJECT:
NEW PARRY SOUND K-12 SCHOOL & CHILDCARE

PARRY SOUND HIGH SCHOOL SITE

111 ISABELLA STREET
PARRY SOUND, ONTARIO

ORIGINAL PAGE SIZE ARCH E1 - 30" x 42"
KEY TO DETAIL LOCATION:
(A) A - DETAIL NO.
(8) B - DETAIL NO. ORIGIN

+VG ARCHITECTS
THE VENTIN GROUP LTD

MILLWORK SECTIONS & DETAILS

ID4.10

Plot Date: Feb 03, 2026 - 5:54pm By: jkelly
Filename: K:\VG-Brantford\Near North DSB Parry Sound School\2211\Drawings\Wd-Content\NN - ID4.8_Millwork Sections.dwg

DRAWN BY : NK/PS
CHECKED BY : EB

FLOOR FINISHES - PORCELAIN TILE

SYMBOL	DESCRIPTION
PT1A	**PORCELAIN TILE FINISH #1 (PT1A): CORRIDOR FLOOR TILE** MANUFACTURER: DALTILE CONTACT: WARREN BOOTH P: 416-568-7255 E: warren.booth@daltile.com SERIES: INDUSTRIAL PARK W/ **STEPWISE TECHNOLOGY** PRODUCT #: IP07 COLOUR: LIGHT GRAY SIZE: 12"X24", UNPOLISHED BASE: INSTALL WITH MATCHING 4" BASE TRANSITION: SCHLUTER SYSTEMS - DILEX-AHK COVE-SHAPED PROFILE - PEWTER (TSG) GROUT: - APPLICATION: CORRIDORS GENERAL NOTES: REFER TO MASTER SPECIFICATION FOR FULL SPEC
PT1B	**PORCELAIN TILE FINISH #1 (PT1B): CORRIDOR ACCENT & WRS** MANUFACTURER: DALTILE CONTACT: WARREN BOOTH P: 416-568-7255 E: warren.booth@daltile.com SERIES: INDUSTRIAL PARK W/ **STEPWISE TECHNOLOGY** PRODUCT #: IP09 COLOUR: CHARCOAL GRAY SIZE: 12"X24", UNPOLISHED BASE: INSTALL WITH MATCHING 4" BASE TRANSITION: SCHLUTER SYSTEMS - DILEX-AHK COVE-SHAPED PROFILE - PEWTER (TSG) GROUT: - APPLICATION: CORRIDORS GENERAL NOTES: REFER TO MASTER SPECIFICATION FOR FULL SPEC
PT2	**PORCELAIN TILE FINISH #2 (PT2): LOBBY STAIR FLOOR TILE** MANUFACTURER: DALTILE CONTACT: WARREN BOOTH P: 416-568-7255 E: warren.booth@daltile.com SERIES: SADDLEBROOKE XT W/ **STEPWISE TECHNOLOGY** PRODUCT #: SD83 COLOUR: OAK TRAIL SIZE: 6"X36" BASE: INSTALL WITH MATCHING 4" BASE TRANSITION: SCHLUTER SYSTEMS - DILEX-AHK COVE-SHAPED PROFILE - PEWTER (TSG) GROUT: - APPLICATION: STAIRS GENERAL NOTES: REFER TO MASTER SPECIFICATION FOR FULL SPEC
CT1	**CERAMIC TILE FINISH #1 (CT1): SHOWER FLOOR TILE** MANUFACTURER: DALTILE CONTACT: WARREN BOOTH P: 416-568-7255 E: warren.booth@daltile.com SERIES: COLOR WHEEL MOSAIC PRODUCT #: 0780 COLOUR: MATTE CHALKBOARD SIZE: 2"X2" BASE: - TRANSITION: SCHLUTER SYSTEMS - DILEX-AHK COVE-SHAPED PROFILE - PEWTER (TSG) GROUT: - APPLICATION: SHOWERS GENERAL NOTES: REFER TO MASTER SPECIFICATION FOR FULL SPEC
CT2	**CERAMIC TILE FINISH #2 (CT2): SHOWER WALL TILE** MANUFACTURER: DALTILE CONTACT: WARREN BOOTH P: 416-568-7255 E: warren.booth@daltile.com SERIES: COLOR WHEEL MOSAIC PRODUCT #: 0782 COLOUR: MATTE SUEDE GRAY SIZE: - BASE: - TRANSITION: SCHLUTER SYSTEMS - DILEX-AHK COVE-SHAPED PROFILE - PEWTER (TSG) GROUT: - APPLICATION: SHOWERS GENERAL NOTES: REFER TO SPECIFICATION. ALTERNATIVE PRODUCTS MUST BE APPROVED PRIOR TO ORDERING.
CT3	**CERAMIC TILE FINISH #3 (CT2): LOBBY ACCENT FLOORING** MANUFACTURER: DALTILE CONTACT: WARREN BOOTH P: 416-568-7255 E: warren.booth@daltile.com SERIES: COLOR WHEEL MOSAIC PRODUCT #: 1012 COLOUR: MUSTARD STRAIGHT JOINT SIZE: 2" x 2" BASE: - TRANSITION: SCHLUTER SYSTEMS - DECO GROUT: MAPEI GROUT COLLECTION - 77 FROST APPLICATION: SHOWERS GENERAL NOTES: REFER TO SPECIFICATION. ALTERNATIVE PRODUCTS MUST BE APPROVED PRIOR TO ORDERING.

WALL BASE

SYMBOL	DESCRIPTION
B1	**WALL BASE FINISH #1 -** MANUFACTURER: TARKETT CONTACT: GREG GIBBONS P: 416-200-4014 E: greg.gibbons@tarkett.com SERIES: COLORMATCH NEUTRAL PRODUCT #: TA5 COLOUR: COLONIAL GRAY CG APPLICATION: RUBBER BASE THROUGHOUT GENERAL NOTES: REFER TO SPECIFICATION. ALTERNATIVE PRODUCTS MUST BE APPROVED PRIOR TO ORDERING.
B2	**PORCELAIN TILE BASE (B2):** MANUFACTURER: DALTILE CONTACT: WARREN BOOTH P: 416-568-7255 E: warren.booth@daltile.com SERIES: INDUSTRIAL PARK W/ STEPWISE TECHNOLOGY PRODUCT #: IP07 COLOUR: LIGHT GRAY SIZE: 4" HIGH TO ALIGN WITH FLOOR GROUT LINES WHERE POSSIBLE APPLICATION: CORRIDORS AT PT1A & PT2 LOCATIONS GENERAL NOTES: REFER TO SPECIFICATION. ALTERNATIVE PRODUCTS MUST BE APPROVED PRIOR TO ORDERING.
B3	**PORCELAIN TILE BASE (B3):** MANUFACTURER: DALTILE CONTACT: WARREN BOOTH P: 416-568-7255 E: warren.booth@daltile.com SERIES: INDUSTRIAL PARK W/ STEPWISE TECHNOLOGY PRODUCT #: IP09 COLOUR: CHARCOAL GRAY SIZE: 4" HIGH TO ALIGN WITH FLOOR GROUT LINES WHERE POSSIBLE APPLICATION: WASHROOMS AT PT1B LOCATIONS GENERAL NOTES: REFER TO SPECIFICATION. ALTERNATIVE PRODUCTS MUST BE APPROVED PRIOR TO ORDERING.
B4	**PORCELAIN TILE BASE (B4):** MANUFACTURER: DALTILE CONTACT: WARREN BOOTH P: 416-568-7255 E: warren.booth@daltile.com SERIES: SADDLEBROOKE XT W/ **STEPWISE TECHNOLOGY** PRODUCT #: SD83 COLOUR: OAK TRAIL SIZE: 4" HIGH TO ALIGN WITH FLOOR GROUT LINES WHERE POSSIBLE APPLICATION: STAIRS AT PT2 LOCATIONS GENERAL NOTES: REFER TO SPECIFICATION. ALTERNATIVE PRODUCTS MUST BE APPROVED PRIOR TO ORDERING.

FLOOR FINISHES - CARPET, RESILIENT & SHEET

SYMBOL	DESCRIPTION
VCT1	**VINYL COMPOSITE TILE (VCT1): CLASSROOMS** MANUFACTURER: ARMSTRONG CONTACT: JULIA OLSEN P: 4647-236-6398 E: jolsen@armstrongflooring.com SERIES: STANDARD EXCELON PRODUCT #: 59234 COLOUR: SILK SIZE: 12"X12" BASE: B1 TRANSITION: - APPLICATION: THROUGHOUT, REFER TO DWGS GENERAL NOTES: REFER TO SPECIFICATION. ALTERNATIVE PRODUCTS MUST BE APPROVED PRIOR TO ORDERING.
LVP1	**LUXURY VINYL PLANK #1 (LVP1): STAFF OFFICE AREAS, CHILDCARE CORRIDORS** MANUFACTURER: FORBO CONTACT: PAULA SWANBOROUGH P: 289-208-0258 E: paula.swanborough@forbo.ca SERIES: ALLURA LVTHG SIZE: 1000mm x 150mm x 4mm thick COLOUR: WHITE AUTUMN OAK COLOUR CODE: W60350 APPLICATION: STAFF AREAS GENERAL NOTES: REFER TO SPECIFICATION. ALTERNATIVE PRODUCTS MUST BE APPROVED PRIOR TO ORDERING.
SAFT1	**SAFETY FLOORING #1 - KITCHEN/SERVERY** MANUFACTURER: FORBO CONTACT: PAULA SWANBOROUGH P: 289-208-0258 E: paula.swanborough@forbo.ca SERIES: eternal step THICKNESS: 2 mm COLOUR: ELEFANT COLOUR CODE: 174952 APPLICATION: SERVERY, KITCHEN, GENERAL NOTES: REFER TO SPECIFICATION. ALTERNATIVE PRODUCTS MUST BE APPROVED PRIOR TO ORDERING.
SHV1	**SHEET VINYL #1 - (SHV1): COLLABORATION AREAS** MANUFACTURER: POLYFLOR COLLECTION: PALLETONE COLOUR: SUNSHINE MEADOW COLOR CODE: 8617 SIZE: SHEET BASE: B1 INSTALLATION: REFER TO FLOOR FINISH PLAN INSTALL AS PER MANUFACTURER'S RECOMMENDATIONS. GENERAL NOTES: REFER TO SPECIFICATION. ALTERNATIVE PRODUCTS MUST BE APPROVED PRIOR TO ORDERING.
SHV2	**SHEET VINYL #2 - (SHV2): CHILDCARE LAUNDRY** MANUFACTURER: POLYFLOR COLLECTION: PALLETONE COLOUR: QUARRYSTONE COLOR CODE: 8639 SIZE: SHEET BASE: B1 INSTALLATION: REFER TO FLOOR FINISH PLAN INSTALL AS PER MANUFACTURER'S RECOMMENDATIONS. GENERAL NOTES: REFER TO SPECIFICATION. ALTERNATIVE PRODUCTS MUST BE APPROVED PRIOR TO ORDERING.
CAR1	**CARPET FINISH #1 (CAR1): ACCENT, LIBRARY & OFFICES** MANUFACTURER: INTERFACE CONTACT: SARA BOUGUEJI P: 416-948-5119 E: sara.bouguej@interface.com COLLECTION: BRIDGE CREEK COLOUR: NATURAL EDGE COLOUR CODE: 107322 SIZE: 50cm x 50cm INSTALLATION: NON-DIRECTIONAL BASE: B1 APPLICATION: FIELD: LEARNING COMMONS, STAFF OFFICES, INDIGENOUS ROOM GENERAL NOTES: REFER TO SPECIFICATION. ALTERNATIVE PRODUCTS MUST BE APPROVED PRIOR TO ORDERING.
CAR1A	**CARPET FINISH #1 (CAR1): ACCENT, INDIGENOUS ROOM** MANUFACTURER: INTERFACE CONTACT: SARA BOUGUEJI P: 416-948-5119 E: sara.bouguej@interface.com COLLECTION: PANOLA MOUNTAIN COLOUR: YELLOW LICHEN COLOUR CODE: 107301 SIZE: 50cm x 50cm INSTALLATION: NON-DIRECTIONAL BASE: - APPLICATION: ACCENT: INDIGENOUS ROOM GENERAL NOTES: REFER TO SPECIFICATION. ALTERNATIVE PRODUCTS MUST BE APPROVED PRIOR TO ORDERING.
RUBBER	**RUBBER FINISH #1 (RUBBER): STAIRS** MANUFACTURER: TARKETT CONTACT: GREG GIBBONS P: 416-200-4014 E: greg.gibbons@tarkett.com COLLECTION: ANGLE FIT STAIR TREADS W/ INTEGRATED RISER PRODUCT: BAMBOO TREAD/RISER PRODUCT CODE: VIBANTR COLOR: COLONIAL GREY CG INSTALLATION: PER PATTERN ON FLOOR FINISH PLAN BASE: B1 APPLICATION: STAIRS GENERAL NOTES: REFER TO SPECIFICATION. ALTERNATIVE PRODUCTS MUST BE APPROVED PRIOR TO ORDERING.

FLOOR FINISHES - SPORTS FLOOR

SYMBOL	DESCRIPTION
WDF1	**WOOD FLOORING #1 (WDF1):** MANUFACTURER: ROBBINS FLOOR CONTACT: - P: - E: - SERIES: BIO CUSHION CLASSIC THICKNESS: - COLOUR: MAPLE COLOR CODE: - APPLICATION: GYMNASIUM GENERAL NOTES: REFER TO SPECIFICATION. ALTERNATIVE PRODUCTS MUST BE APPROVED PRIOR TO ORDERING.
SF1	**SPORT FLOORING #1 (SF1):** MANUFACTURER: GERFLOR CONTACT: JASON HANIFF P: 647-521-5509 E: jason.haniff@gerflor.com SERIES: TARALAY IMPRESSION COMFORT THICKNESS: 3.2 mm COLOUR: HABANA VINALES COLOR CODE: 1070 APPLICATION: TODDLER/DAYCARE AREA/KINDERGARTEN GENERAL NOTES: REFER TO SPECIFICATION. ALTERNATIVE PRODUCTS MUST BE APPROVED PRIOR TO ORDERING.
SF2	**SPORT FLOORING #2 (SF2):** MANUFACTURER: GERFLOR CONTACT: JASON HANIFF P: 647-521-5509 E: jason.haniff@gerflor.com SERIES: Taraflex Sport M Plus THICKNESS: 7 mm COLOUR: MAPLE COLOR CODE: 6381 APPLICATION: ELEMENTARY GYM FLOOR FIELD GENERAL NOTES: REFER TO SPECIFICATION. ALTERNATIVE PRODUCTS MUST BE APPROVED PRIOR TO ORDERING.

PAINT FINISHES

SYMBOL	DESCRIPTION
P1	**PAINT FINISH #1 - FIELD** MANUFACTURER: BENJAMIN MOORE COLOUR: CHANTILLY LACE PRODUCT #: OC-65 GENERAL NOTES: REFER TO SPECIFICATION. ALTERNATIVE PRODUCTS MUST BE APPROVED PRIOR TO ORDERING.
P2	**PAINT FINISH #2 - HM FRAME** MANUFACTURER: BENJAMIN MOORE COLOUR: WHALE GRAY PRODUCT #: 2134-40 GENERAL NOTES: REFER TO SPECIFICATION. ALTERNATIVE PRODUCTS MUST BE APPROVED PRIOR TO ORDERING.
P2A	**PAINT FINISH #2 - HM DOOR** MANUFACTURER: BENJAMIN MOORE COLOUR: WHITESTONE PRODUCT #: 2134-60 GENERAL NOTES: REFER TO SPECIFICATION. ALTERNATIVE PRODUCTS MUST BE APPROVED PRIOR TO ORDERING.
P3	**PAINT FINISH #3 - ACCENT IN SINGLE WRS** MANUFACTURER: BENJAMIN MOORE COLOUR: TRANQUIL BLUE PRODUCT #: 2051-50 GENERAL NOTES: REFER TO SPECIFICATION. ALTERNATIVE PRODUCTS MUST BE APPROVED PRIOR TO ORDERING.
P4	**PAINT FINISH #4 - ACCENT IN FEMALE WRS** MANUFACTURER: BENJAMIN MOORE COLOUR: RASPBERRY BLUSH PRODUCT #: 2008-30 GENERAL NOTES: REFER TO SPECIFICATION. ALTERNATIVE PRODUCTS MUST BE APPROVED PRIOR TO ORDERING.
P5	**PAINT FINISH #5 - ACCENT IN MALE WRS** MANUFACTURER: BENJAMIN MOORE COLOUR: SESAME PRODUCT #: CC-438 GENERAL NOTES: REFER TO SPECIFICATION. ALTERNATIVE PRODUCTS MUST BE APPROVED PRIOR TO ORDERING.
P6	**PAINT FINISH #6 - ACCENT** MANUFACTURER: BENJAMIN MOORE COLOUR: RASPBERRY TRUFFLE PRODUCT #: 2080-10 GENERAL NOTES: REFER TO SPECIFICATION. ALTERNATIVE PRODUCTS MUST BE APPROVED PRIOR TO ORDERING.
P7	**PAINT FINISH #7 - ACCENT IN CLASS ROOMS , INDIGENOUS ROOM** MANUFACTURER: BENJAMIN MOORE COLOUR: NACHO CHEESE PRODUCT #: 2018-40 GENERAL NOTES: REFER TO SPECIFICATION. ALTERNATIVE PRODUCTS MUST BE APPROVED PRIOR TO ORDERING.
P8	**PAINT FINISH #8 - ACCENT AT GYM** MANUFACTURER: BENJAMIN MOORE COLOUR: GRAY OWL PRODUCT #: 2145-30 GENERAL NOTES: REFER TO SPECIFICATION. ALTERNATIVE PRODUCTS MUST BE APPROVED PRIOR TO ORDERING.
P9	**PAINT FINISH #9 - ACCENT IN LOBBY, LEARNING COMMONS, CAFETERIA, GYM** MANUFACTURER: BENJAMIN MOORE COLOUR: BROOKSIDE MOSS PRODUCT #: 2145-30 GENERAL NOTES: REFER TO SPECIFICATION. ALTERNATIVE PRODUCTS MUST BE APPROVED PRIOR TO ORDERING.
P10	**PAINT FINISH #10 - ACCENT AT WATER FOUNTAIN, GYM** MANUFACTURER: BENJAMIN MOORE COLOUR: BUCKLAND BLUE PRODUCT #: HC-151 GENERAL NOTES: REFER TO SPECIFICATION. ALTERNATIVE PRODUCTS MUST BE APPROVED PRIOR TO ORDERING.
P11	**PAINT FINISH #11 - FIELD AT MEDIA, ARTS & DRAMA ROOM** MANUFACTURER: BENJAMIN MOORE COLOUR: BLACK PRODUCT #: 2132-10 GENERAL NOTES: REFER TO SPECIFICATION. ALTERNATIVE PRODUCTS MUST BE APPROVED PRIOR TO ORDERING.

PLASTIC LAMINATE

SYMBOL	DESCRIPTION
PLAM1	**PLASTIC LAMINATE FINISH #1 - MILLWORK/ DOORS** MANUFACTURER: Arborite CONTACT: JANET PAUL P: 905-630-0735 E: Janet.Paul@tafisa.ca COLOUR: BLONDE MODERN CHERRY COLOUR CODE: W46L4LE GENERAL NOTES: REFER TO SPECIFICATION. ALTERNATIVE PRODUCTS MUST BE APPROVED PRIOR TO ORDERING. FIRE RATED GPPL CAN/ULC S102
PLAM2	**PLASTIC LAMINATE FINISH #2 - MILLWORK COUNTERS** MANUFACTURER: ARBORITE CONTACT: JANET BASCOE-SPENCER P: 647-206-2916 E: janet.bascoe-spencer@arborite.com COLOUR: MONOLITH COLOUR CODE: P407 GENERAL NOTES: REFER TO SPECIFICATION. ALTERNATIVE PRODUCTS MUST BE APPROVED PRIOR TO ORDERING.
PLAM3	**NOT IN USE**
PLAM4	**PLASTIC LAMINATE FINISH #4 - CHILDCARE COUNTERS** MANUFACTURER: ARBORITE CONTACT: JANET BASCOE-SPENCER P: 647-206-2916 E: janet.bascoe-spencer@arborite.com COLOUR: CHATEAU COLOUR CODE: P1023 GENERAL NOTES: REFER TO SPECIFICATION. ALTERNATIVE PRODUCTS MUST BE APPROVED PRIOR TO ORDERING.
MEL1	**MELAMINE FINISH #1 -** MANUFACTURER: TAFISA CONTACT: JANET PAUL P: 905-630-0735 E: Janet.Paul@tafisa.ca COLOUR: MOJAVE COLOUR CODE: L546 (A) GENERAL NOTES: REFER TO SPECIFICATION. ALTERNATIVE PRODUCTS MUST BE APPROVED PRIOR TO ORDERING.
RB1	**MILLWORK BASE #1** MANUFACTURER: TARKETT CONTACT: GREG GIBBONS P: 416-200-4014 E: greg.gibbons@tarkett.com SERIES: COLORMATCH NEUTRAL COLOUR: IRON MOUNTAIN COLOUR CODE: TG3 APPLICATION: ALL WALL & MILLWORK BASE THROUGHOUT GENERAL NOTE: REFER TO SPECIFICATION. ALTERNATIVE PRODUCTS MUST BE APPROVED PRIOR TO ORDERING.
WD1	**WOOD STAIN FINISH #1 -** PRODUCT: PLYWOOD W/ EUROPLY MATERIAL TO PREVENT WARPING STAINED TO MATCH ADJACENT PLAM1 OR MEL2.
WD2	**WOOD STAIN FINISH #2 - GYM WOOD FLOORING** PRODUCT: PLYWOOD W/ EUROPLY MATERIAL TO PREVENT WARPING STAINED TO MATCH ADJACENT P6

SOLID SURFACE

SYMBOL	DESCRIPTION
SS1	**SOLID SURFACE #1 - ADMIN DESK** MANUFACTURER: CORIAN CONTACT: DENISE BRADLEY P: 647-631-4839 E: denisebl@4wills.com COLOUR: DESIGNER WHITE GENERAL NOTES: REFER TO SPECIFICATION. ALTERNATIVE PRODUCTS MUST BE APPROVED PRIOR TO ORDERING.
SS2	**SOLID SURFACE #2 - SCIENCE COUNTERS** MANUFACTURER: DURCON (WILSONART) CONTACT: JAN BIBIC P: 416-319-8107 E: bibic@wilsonart.com COLLECTION: SOLICOR-CR CHEMICAL RESISTANT GRADE COLOUR: GRAPHITE GENERAL NOTES: REFER TO SPECIFICATION. ALTERNATIVE PRODUCTS MUST BE APPROVED PRIOR TO ORDERING.

WOOD GRILLE PANEL

SYMBOL	DESCRIPTION
WG	**WOODEN GRILLE PANEL #1 - LOBBY, CAFETERIA & COLLABORATION AREA** MANUFACTURER: ARMSTRONG CONTACT: MEGANREED P: 416-859-2313 E: mereed@armstrongceilings.com SERIES: WOODWORKS GRILLE - FORTE SOLID WALL PANELS PRODUCT #: 6324L4510GAO COLOUR: ANTIQUE OAK SIZE: 12"X48" (or as required) SLAT HEIGHT: 2 1/2" SLAT WIDTH: 1/2" NO. OF SLAT-SPACING: 4 SLATS 1/2" APPLICATION: ACCENT IN LOBBY, CAFETERIA & COLLABORATION AREA, REFER TO DWGS GENERAL NOTES: REFER TO SPECIFICATION. ALTERNATIVE PRODUCTS MUST BE APPROVED PRIOR TO ORDERING. Flame Spread: ASTM E Class A(UL)CAN/ULC S102 MAX THICKNESS 25mm.

ACOUSTIC PANEL

SYMBOL	DESCRIPTION
ACP1	**ACOUSTIC PANEL #1 - CAFETERIA** MANUFACTURER: ARMSTRONG CONTACT: JULIA OLSEN P: 4647-236-6398 E: jolsen@armstrongflooring.com SERIES: INVISACOUSTIC WALLS PRODUCT #: 1212FP COLOUR: UNFINISHED - FIELD PAINTABLE TO BE FINISHED ON SITE IN PAINT FINISH P1 SIZE: 24"X48"X2" APPLICATION: CAFETERIA WALLS REFER TO DWGS GENERAL NOTES: REFER TO SPECIFICATION. ALTERNATIVE PRODUCTS MUST BE APPROVED PRIOR TO ORDERING. Flame Spread: ASTM E 1264; Class A(UL)CAN/ULC S102

PORCELAIN TILE FINISHES - WALLS

SYMBOL	DESCRIPTION
PT3	**NOT IN USE**
PT4	**PORCELAIN TILE FINISH #4 -FIELD IN CHILDCARE WR** MANUFACTURER: OLYMPIA TILE CONTACT: RITE O'HARA P: 416-785-9555 EXT. 1373 E: r.ohara@olympiatile.com SERIES: COLOUR & DIMENSION COLOUR: ARCTIC WHITE MATTE SIZE: 4" x 16" PRODUCT #: QT.CD.ARW.0416.MT BASE: INSTALL WITH MATCHING 4" PT4 BASE TRANSITION: SCHLUTER SYSTEMS - DILEX-AHK COVE-SHAPED PROFILE - PEWTER (TSG) GROUT: MAPEI 38 AVALANCHE GENERAL NOTES: REFER TO SPECIFICATION. ALTERNATIVE PRODUCTS MUST BE APPROVED PRIOR TO ORDERING.
PT5	**PORCELAIN TILE FINISH #5 - WASHROOM WALL TILE** MANUFACTURER: OLYMPIA TILE CONTACT: RITE O'HARA P: 416-785-9555 EXT. 1373 E: r.ohara@olympiatile.com SERIES: COLOUR & DIMENSION COLOUR: SILVER GREY BRIGHT SIZE: 4" x 16" PRODUCT #: QT.CD.SGR.0416.BR BASE: INSTALL WITH MATCHING 4" PT3 BASE TRANSITION: SCHLUTER SYSTEMS - DILEX-AHK COVE-SHAPED PROFILE - PEWTER (TSG) GROUT: MAPEI 93 WARM GRAY GENERAL NOTES: REFER TO SPECIFICATION. ALTERNATIVE PRODUCTS MUST BE APPROVED PRIOR TO ORDERING.
PT6	**PORCELAIN TILE FINISH #6 - FEMALE ACCENT WALL TILE** MANUFACTURER: OLYMPIA TILE CONTACT: RITE O'HARA P: 416-785-9555 EXT. 1373 E: r.ohara@olympiatile.com SERIES: COLOUR & DIMENSION COLOUR: GOLD BRIGHT SIZE: 4" x 16" PRODUCT #: QT.CD.TQS.0416.BR BASE: INSTALL WITH MATCHING 4" PT3 BASE TRANSITION: SCHLUTER SYSTEMS - DILEX-AHK COVE-SHAPED PROFILE - PEWTER (TSG) GROUT: MAPEI 93 WARM GRAY GENERAL NOTES: REFER TO SPECIFICATION. ALTERNATIVE PRODUCTS MUST BE APPROVED PRIOR TO ORDERING.
PT7	**PORCELAIN TILE FINISH #7 - MALE ACCENT WALL TILE** MANUFACTURER: OLYMPIA TILE CONTACT: RITE O'HARA P: 416-785-9555 EXT. 1373 E: r.ohara@olympiatile.com SERIES: COLOUR & DIMENSION COLOUR: DENIM BRIGHT SIZE: 4" x 16" PRODUCT #: QT.CD.PPY.0416.BR BASE: INSTALL WITH MATCHING 4" PT3 BASE TRANSITION: SCHLUTER SYSTEMS - DILEX-AHK COVE-SHAPED PROFILE - PEWTER (TSG) GROUT: MAPEI 93 WARM GRAY GENERAL NOTES: REFER TO SPECIFICATION. ALTERNATIVE PRODUCTS MUST BE APPROVED PRIOR TO ORDERING.

VINYL WALL COVERINGS

SYMBOL	DESCRIPTION
VWC1	**VINYL WALL COVERING #1 - FOLDING PARTITION - MAIN FLOOR CAFE & COLLABORATION AREA** MANUFACTURER: 3M CONTACT: MONIKA SAWICKA P: 647-298-9003 E: msawicka@mmm.com SERIES: 3M DI-NOC ARCHITECTURAL FINISHES MATTE PRODUCT CODE: PW 2305MT PRODUCT COLOR: BROWN, NEUTRAL, WHITE SIZE: 1220mm X 50m SURFACE FINISH: MATTE WOOD SPECIES: HICKORY WOOD TONE: LIGHT GENERAL NOTES: REFER TO SPECIFICATION. ALTERNATIVE PRODUCTS MUST BE APPROVED PRIOR TO ORDERING.

WALL PANELS

SYMBOL	DESCRIPTION
DWP1	**DECORATIVE WALL PANEL #1 - LOBBY WALLS** MANUFACTURER: MODULAR ARTS CONTACT: P: 206-788-4210 E: info@modulararts.com COLOUR: TO BE FINISHED ON SITE IN PAINT FINISH P1 product name: DUNE PANEL SIZE: 32"X32" THICKNESS: 3" GENERAL NOTES: REFER TO SPECIFICATION. ALTERNATIVE PRODUCTS MUST BE APPROVED PRIOR TO ORDERING. Flame Spread Index: ASTM E 84 0 Smoke Development Index: ASTM E 84 50 CAN/ULC S102

WOOD PLANK

SYMBOL	DESCRIPTION
WP	**WOOD PLANK #1 - INDIGENOUS CLASSROOM** MANUFACTURER: ARMSTRONG CONTACT: JULIA OLSEN P: 4647-236-6398 E: jolsen@armstrongflooring.com SERIES: WOODWORKS LINEAR VENEERED PLANKS PRODUCT #: 6640W1 COLOUR: NATURAL VARIATIONS BEECH SIZE: 3 1/2" x 96" THICKNESS: 3/4" SHAPE: PLANK EDGE: PLANK 2" REVEAL APPLICATION: INDIGENOUS CLASSROOM CEILING GENERAL NOTES: REFER TO SPECIFICATION. ALTERNATIVE PRODUCTS MUST BE APPROVED PRIOR TO ORDERING. Flame Spread: Class A: ASTM E84 surface burning characteristics. Flame Spread Index 25 or less. Smoke Developed Index 50 or less. CAN/ULC S102 surface burning characteristics. Flame Spread Rating 25 or less. Smoke Developed Classification 50 or less.

TRANSITION FINISH LEGEND:

SYMBOL	DESCRIPTION
T1	**TRANSITION #1 (T1):** MANUFACTURER: SCHLUTER MODEL: RENO-U (EXACT MODEL TO BE CONFIRMED BY CONTRACTOR) FINISH: BRUSHED STAINLESS STEEL CONDITION: VCT/LVT TO PORCELAIN NOTES: REFER TO FLOOR FINISH PLAN FOR REQUIRED LOCATIONS
T2	**TRANSITION #2 (T2):** MANUFACTURER: TARKETT MODEL: METAL EDGE TRANSITION (CONTRACTOR TO SELECT BETWEEN M1 & M2 OPTIONS FINISH: BLACK CONDITION: PORCELAIN TO CARPET NOTES: REFER TO FLOOR FINISH PLAN FOR REQUIRED LOCATIONS
T3	**TRANSITION #3 (T3):** MANUFACTURER: SCHLUTER MODEL: RENO-T (EXACT MODEL TO BE CONFIRMED BY CONTRACTOR) FINISH: BRUSHED STAINLESS STEEL CONDITION: SF/LVT TO VCT NOTES: REFER TO FLOOR FINISH PLAN FOR REQUIRED LOCATIONS
T4	**TRANSITION #4 (T4):** MANUFACTURER: SCHLUTER MODEL: RENO-K (EXACT MODEL TO BE CONFIRMED BY CONTRACTOR) FINISH: BRUSHED STAINLESS STEEL CONDITION: FLOOR FINISH TO CONCRETE/EPX NOTES: REFER TO FLOOR FINISH PLAN FOR REQUIRED LOCATIONS
T5	**TRANSITION #5 (T5):** MANUFACTURER: TARKETT MODEL: METAL EDGE TRANSITION (CONTRACTOR TO SELECT BETWEEN M1 & M2 OPTIONS FINISH: BLACK CONDITION: LVP TO CARPET NOTES: REFER TO FLOOR FINISH PLAN FOR REQUIRED LOCATIONS

LEGEND & NOTES

FLOOR BASE — SYMBOL DENOTES ROOM FIELD FLOOR AND BASE TAG

TWSI - 305mm x 305mm PORCELAIN TACTILE WARNING STRIP INDICATOR, LOCATED AT ALL STAIRS; TO INDICATE LEVEL CHANGE. AS MANUFACTURED BY ENKESS, ELAN, WITH TRUNCATED DOMES.

CJ — CONTROL JOINTS - COORD. W/ STRUCTURAL FOR LOCATIONS

GENERAL FLOOR FINISH NOTES:

1. GENERAL CONTRACTOR TO MAKE GOOD ALL AREAS TO RECEIVE NEW FLOOR FINISHES. ALL MAJOR CRACKS AND OPENINGS TO BE FIXED.

2. CONCRETE SLAB TO BE CLEAN, SOUND AND LEVEL PRIOR TO INSTALLATION OF FLOOR FINISHES. FLATNESS REQUIREMENTS +3/16" IN 10 FEET

3. SURFACES TO RECEIVE NEW CARPET SHALL BE DRY, CLEAN, & FREE OF RIDGES AND DUST.

4. EXCEPT WHERE CARPET EXTENDS UNDER PARTITIONS, INSTALL CARPET AFTER ALL THE FINISH TRADES HAVE COMPLETED THEIR WORK OR AS SCHEDULE SHOWS.

5. WHERE CARPET IS JOINED OR TERMINATED AT DOORWAYS, LOCATE THE SEAM OR TERMINATION UNDER THE DOOR IN IT'S CLOSED POSITION.

6. FLOORING CONTRACTOR TO INSTALL CARPET AS PER MANUFACTURER'S INSTRUCTIONS.

7. FLOORING CONTRACTOR TO PROVIDE SEAMING PLAN FOR DESIGNER'S APPROVAL 4 WEEKS PRIOR TO INSTALLATION OF CARPET WHEN USING ROLLED GOODS.

8. GENERAL CONTRACTOR TO PROVIDE AND INSTALL ALL FLOOR FINISHES AS SPECIFIED. NO ALTERNATES ARE PERMITTED UNLESS APPROVED BY DESIGNER.

9. THIS DRAWING IS TO BE READ IN CONJUNCTION WITH ALL FLOOR FINISHES SPECIFICATIONS, EXECUTION AND INSTALLATION GUIDES PROVIDED IN MANUFACTURER'S DOCUMENTATION.

10. INSTALLER IS TO ENSURE SMOOTH LEVEL TRANSITIONS BETWEEN DIFFERENT FLOORING TYPES.

11. TILES SHOULD BE LAID ALL IN ONE DIRECTION TO OBTAIN UNIFORM AFFECT - ABRUPT VARIATION WILL NOT BE ACCEPTABLE.

12. INSTALL EDGE STRIPS AT UNPROTECTED OR EXPOSED EDGES WHERE FLOORING TERMINATES.

13. PROVIDE MANUFACTURER'S MAINTENANCE AND PERFORMANCE DATA FOR ALL FINISHES TO THE DESIGNER AT COMPLETION OF PROJECT.

14. FLOOR FINISHES SHALL EXTEND UNDER ALL RADIATORS/CONVECTORS AND NEW MILLWORK UNITS.

15. C(S) DEN



1 ID5.2 VIEW 1 - LOBBY
0 1 2 5m



2 ID5.2 VIEW 2 - LOBBY
0 1 2 5m



3 ID5.2 VIEW 3 - LEARNING COMMONS
0 1 2 5m



4 ID5.2 VIEW 4 - CAFETERIA
0 1 2 5m



5 ID5.2 VIEW 5 - CAFETERIA
0 1 2 5m



6 ID5.2 VIEW 6 - COLLABORATION AREA
0 1 2 5m



7 ID5.2 VIEW 7 - INDIGENEOUS CLASSROOM
0 1 2 5m

VIEWS SHOWN HERE ARE FOR CONCEPTUAL PURPOSE ONLY.
PLEASE REFER TO CONTRACT DRAWINGS & SPECIFICATIONS FOR FINISHES & MATERIALS.

REVISIONS

NO.	DATE	PARTICULAR
1	2022.06.06	ISSUED FOR 80% CLASS B COSTING
2	2022.08.18	ISSUED FOR SPA
3	2022.09.22	ISSUED FOR OWNERS REVIEW - 98% SET
4	2022.12.16	ISSUED FOR 2nd SPA SUBMISSION
5	2023.01.31	ISSUED FOR TENDER
6	2023.02.22	ISSUED FOR ADDENDUM 9
7	2023.08.23	ISSUED FOR CONVENIENCE
8	2023.11.20	ISSUED FOR PERMIT COMMENTS
9	2024.01.24	ISSUED FOR SI#03
10	2024.02.15	ISSUED FOR PCN#008
11	2024.03.04	ISSUED FOR PCN#009
12	2024.03.10	ISSUED FOR SI#004
13	2024.05.14	ISSUED FOR SI#006
14	2024.07.22	ISSUED FOR SI#008
15	2024.08.07	ISSUED FOR SI#009
16	2024.10.02	ISSUED FOR PCN#15
17	2025.04.11	ISSUED FOR PCN#019
18	2025.05.01	ISSUED FOR CO#07
19	2025.05.28	ISSUED FOR PCN#20 - CO#010
20	2025.07.31	ISSUED FOR SI#013
21	2025.08.06	ISSUED FOR SI#014
22	2025.08.15	ISSUED FOR PCN#25 - CO#017
23	2025.08.25	ISSUED FOR PCN#27 - CO#021
24	2025.09.02	ISSUED FOR PCN#29
25	2025.09.02	ISSUED FOR SI#20 - CO#018
26	2025.09.08	ISSUED FOR PCN#31
27	2025.09.09	ISSUED FOR PCN#32 - CO#022
28	2025.09.10	ISSUED FOR PCN#33
29	2025.09.11	ISSUED FOR SI#022
30	2025.09.15	ISSUED FOR SI#023
31	2025.09.16	ISSUED FOR PCN #35 - CO#023
32	2025.09.30	ISSUED FOR PCN #37 - CO#029
33	2025.09.30	ISSUED FOR PCN #38 - CO#025
34	2025.10.06	ISSUED FOR PCN #39 - CO#024
35	2025.10.20	ISSUED FOR PCN #40R1
36	2025.10.30	ISSUED FOR PCN#041
37	2025.10.23	ISSUED FOR PCN #42
38	2025.11.21	ISSUED FOR PCN#021/R1 - CO12 CO#006
39	2025.11.14	ISSUED FOR PCN#043
40	2025.11.26	ISSUED FOR PCN#043R1
41	2025.12.03	ISSUED FOR PCN#044 - CO#026
42	2026.02.04	ISSUED FOR RECORD SET UP TO CO#27

NOTES:

KEY PLAN:

All dimensions and measurements must be checked and verified by the General Contractor

Reproduction of drawings and related documents in whole or in part is forbidden without written permission of The Ventin Group.

Filename: K:\VG-Brantford\Near North DSB Parry Sound School\21111\Drawings\Wd-Current\NN - ID5.2_ID Conceptual 3D Views.dwg

Plot Date: Feb 03, 2026 - 5:55pm By: jkelly

CLIENT:
NEAR NORTH DISTRICT SCHOOL BOARD
NNDSB Tender # 2023-015

PROJECT:
NEW PARRY SOUND K-12 SCHOOL & CHILDCARE

PARRY SOUND HIGH SCHOOL SITE

111 ISABELLA STREET
PARRY SOUND, ONTARIO

ORIGINAL PAGE SIZE ARCH E1 - 30" x 42"

KEY TO DETAIL LOCATION:
A - DETAIL NO.
B - DETAIL NO. ORIGIN

+VG ARCHITECTS
THE VENTIN GROUP LTD

ID CONCEPTUAL 3D VIEWS

ID5.2

DRAWN BY : PS CHECKED BY : -